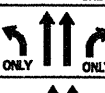
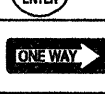
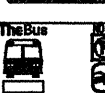
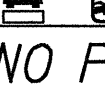
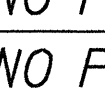
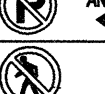
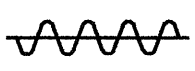
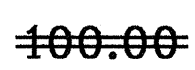


FED. ROAD DIST. NO.	STATE	FED. AID PROJ. NO.	FISCAL YEAR	SHEET NO.	TOTAL SHEETS
HAWAII	HAW.	STP-724(1)	1995	42	42

TRAFFIC SIGN SUMMARY					
SIGN NO.	MESSAGE	QUANTITY			
		10 SQ. FT. OR LESS		GREATER THAN 10 SQ. FT.	
		W/POST	W/O POST	W/POSTS	W/O POSTS
R1-1	STOP	1			
R1-2	YIELD	6			
R2-1(35)	SPEED LIMIT 35			3	4
R3-4		2	2		
R3-4b		2			
R3-11(R)				1	1
R3-38				1	1
R3-39				4	
R3-55		1			
R4-7			2		
R5-1		1			
R6-1(R)			1		
R7-107b		4			
R7-107m	NO PARKING 6AM-6PM WEEKDAYS		2		
R7-107n	NO PARKING ANYTIME SAT & SUN		2		
R7-201a			28		
R8-3a		4	24		
R9-3a		2	2		
R9-3b(R)			2		
R9-3b(L)			2		
R10-7	DO NOT BLOCK INTERSECTION		2		
R16-1	 ITS THE LAW	1	1		
R16-5	UNLICENSED VEHICLES BICYCLES, CYCLES UNDER 5 HP, PEDESTRIANS KEEP OUT FREEWAY			1	1
R17-1	 ON LEFT ARROW ONLY		2		
R17-3	 ON LEFT ARROW ONLY NO U TURN	1	7		
R17-4	 ON LEFT ARROW ONLY NO U TURN		1		
W1-2(R)		1			1
W1-2(R)A					1
W3-3		2			
W4-3					1
W11-2			1		
W11A-2		3			
W13-1(25)	25 M.P.H.		1		
W13-1(25)-A	25 M.P.H.		1		
W13-3(25)	RAMP 25 M.P.H.				1
W18-1	RIGHT LANE EXIT ONLY				2
TOTAL		31	83	10	13

CONSTRUCTION SIGN SUMMARY			
SIGN NO.	MESSAGE	W/POSTS	W/O POST
CG20-2	END CONSTRUCTION	3	3
CW20-1d	ROAD CONSTRUCTION AHEAD	3	2
TOTAL		6	5

LEGEND FOR AS-BUILT POSTINGS	
	Squiggly line for as-built deletion
	Double line for as-built deletion
Roadway	Text for as-built posting

PAVEMENT MARKING SUMMARY	
DESCRIPTION	QUANTITY
PAVEMENT MARKERS	
TYPE A _____	1,564 EA.
TYPE C _____	1,190 EA.
TYPE D _____	16 EA.
TYPE H _____	340 EA.
TAPE - TYPE I OR THERMOPLASTIC EXTRUSION	
4-INCH PAVEMENT STRIPE (WHITE) _____	3,160 L.F.
8-INCH PAVEMENT STRIPE (WHITE) _____	3,560 L.F.
DOUBLE 4-INCH PAVEMENT STRIPE (YELLOW) _____	260 L.F.
TAPE - TYPE II OR THERMOPLASTIC EXTRUSION	
4-INCH PAVEMENT STRIPE (WHITE) _____	11,560 L.F.
4-INCH PAVEMENT STRIPE (YELLOW) _____	11,790 L.F.
8-INCH PAVEMENT STRIPE (WHITE) _____	4,830 L.F.
12-INCH PAVEMENT STRIPE (WHITE) _____	1,665 L.F.
12-INCH PAVEMENT STRIPE (YELLOW) _____	360 L.F.
DOUBLE 4-INCH PAVEMENT STRIPE (YELLOW) _____	570 L.F.
TAPE - TYPE III OR THERMOPLASTIC EXTRUSION	
4-INCH PAVEMENT STRIPE (WHITE) _____	2,240 L.F.
4-INCH PAVEMENT STRIPE (YELLOW) _____	1,140 L.F.
8-INCH PAVEMENT STRIPE (WHITE) _____	1,190 L.F.
12-INCH PAVEMENT STRIPE (WHITE) _____	1,265 L.F.
CROSSWALK MARKINGS _____	80 LANES
PAVEMENT ARROW _____	124 EA.
PAVEMENT WORD _____	5 EA.
PAINT	
ASPHALT CONCRETE CURB (WHITE) _____	80 L.F.
PORTLAND CEMENT CONCRETE CURB (RED) _____	450 L.F.

6/20/95	Revised Traffic Summaries
DATE	REVISION
STATE OF HAWAII DEPARTMENT OF TRANSPORTATION HIGHWAYS DIVISION	
TRAFFIC SUMMARIES	
KAHUAPAANI ST. RESURFACING	
Ulune St. to Salt Lake Blvd.	
Fed. Aid Project No. STP-724(1)	
Date: June, 1995	
SHEET No. T16 OF 16 SHEETS	

AS-BUILT ADD. 42

ORIGINAL PLAN	SURVEY PLOTTED BY	DATE
NOTE BOOK	DESIGNED BY	6/17/95
1/24/95	CHECKED BY	
1/24/95		

FED. ROAD DIST. NO.	STATE	PROJ. NO.	FISCAL YEAR	SHEET NO.	TOTAL SHEETS
HAWAII	HAW.	STP-7241(1)	1995	ADD. 42 5-1	42

DESTINATION SIGN SUMMARY

SIGN NO.	MESSAGE	SIZE	OVERLAY AREA (SQ. FT.)	NEW PANEL AREA (SQ. FT.)	
				W/O POSTS	W/POSTS
D-1	 Honolulu  WEST  Pearl Harbor	10'-0" x 7'-0"	70		
D-2	  WEST Honolulu   Pearl City Pearl Harbor	11'-0" x 7'-0"	77		
D-3	EXIT 1 A 	7'-6" x 6'-0"			45
D-4	 EAST Honolulu 	9'-6" x 5'-0"			47.5
D-5	 EAST Honolulu RIGHT LANE	8'-0" x 6'-0"			48
D-6	Stadium RIGHT LANE	8'-0" x 3'-6"			28
D-7	 Aliamanu Salt Lake Kamehameha Hwy 	13'-0" x 5'-6"			71.5
TOTAL			147		240

REFLECTOR MARKER SUMMARY

TYPE	QUANTITY					
	W/O POST		W/FLEXIBLE DELINEATOR POST (TYPE B)		W/POST	
	YELLOW	WHITE	YELLOW	WHITE	YELLOW	WHITE
RM-2			34	7	4	
RM-3	4				6*	

* *Bi-Directional*

EXPRESSWAY SIGN SUMMARY

SIGN NO.	MESSAGE	SIZE	OVERLAY AREA (SQ. FT.)
E-1(L)	Pearl Harbor ↓	16'-6" x 9'-0"	148.5
E-1(C)	Stadium ½ MILE ↓	13'-6" x 9'-0"	121.5
E-1(R)	78 EAST Honolulu EXIT ↓ ONLY	12'-0" x 9'-0"	108
E-2(L)	Ulune St Aiea ↔	12'-0" x 7'-6"	90
E-2(C)	Halawa Heights Camp Smith ↓ ↓	19'-6" x 7'-6"	146.25
E-2(R)	WEST Pearl City Halawa Valley ↗	21'-6" x 7'-6"	161.25
E-3	↖ Halawa Hts LEFT LANE Pearl Harbor Stadium ↗	19'-6" x 11'-6"	244.25
TOTAL			999.75

6/19/95	Sheet added to Contract Plan Set per Addendum No. 1.
---------	--

<i>DATE</i>	<i>REVISION</i>
-------------	-----------------

STATE OF HAWAII
DEPARTMENT OF TRANSPORTATION
HIGHWAYS DIVISION

TRAFFIC SUMMARIES

KAHUAPAANI ST. RESURFACING

Ulune St. to Salt Lake Blvd.

Fed. Aid Project No. STP-7241(1)

Date: June, 1995

SHEET No. OF SHEETS

ADD. 42 S-1

ORIGINAL PLAN	SURVEY PLOTTED BY	DATE
	DRAWN BY <i>B. Hill</i>	<i>6/19/95</i>
NOTE BOOK	TRACED BY	
<i>Talruby</i>	DESIGNED BY <i>C. Aba</i>	
<i>Ikahitsum2</i>	QUANTITIES BY	
	CHECKED BY	