
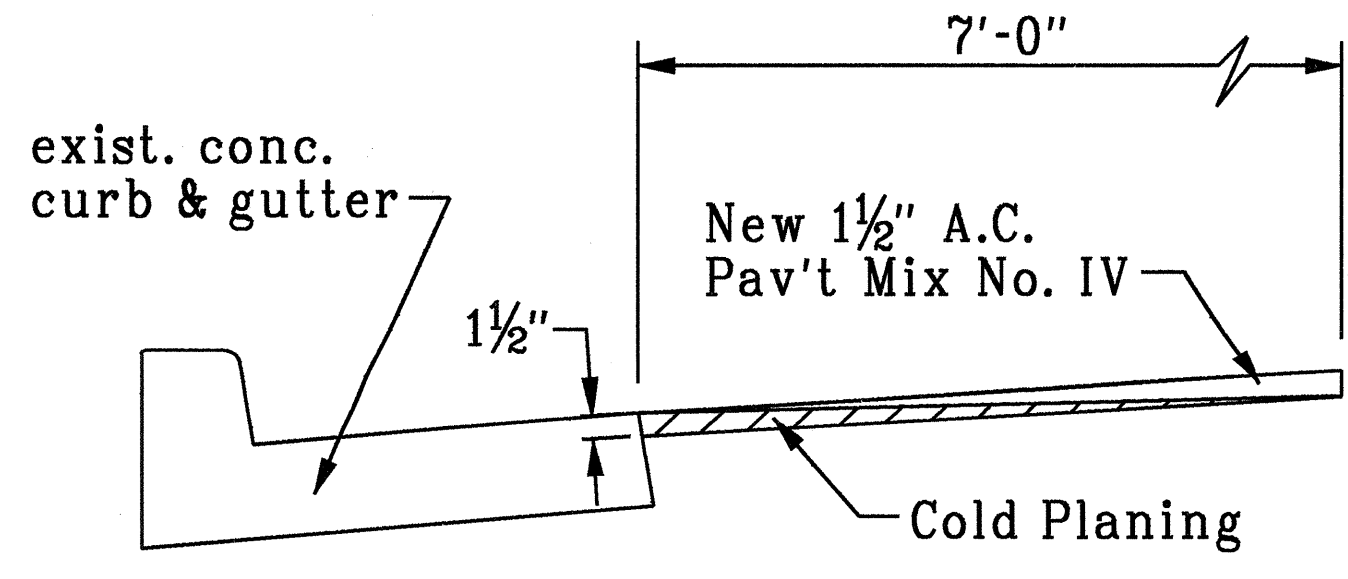
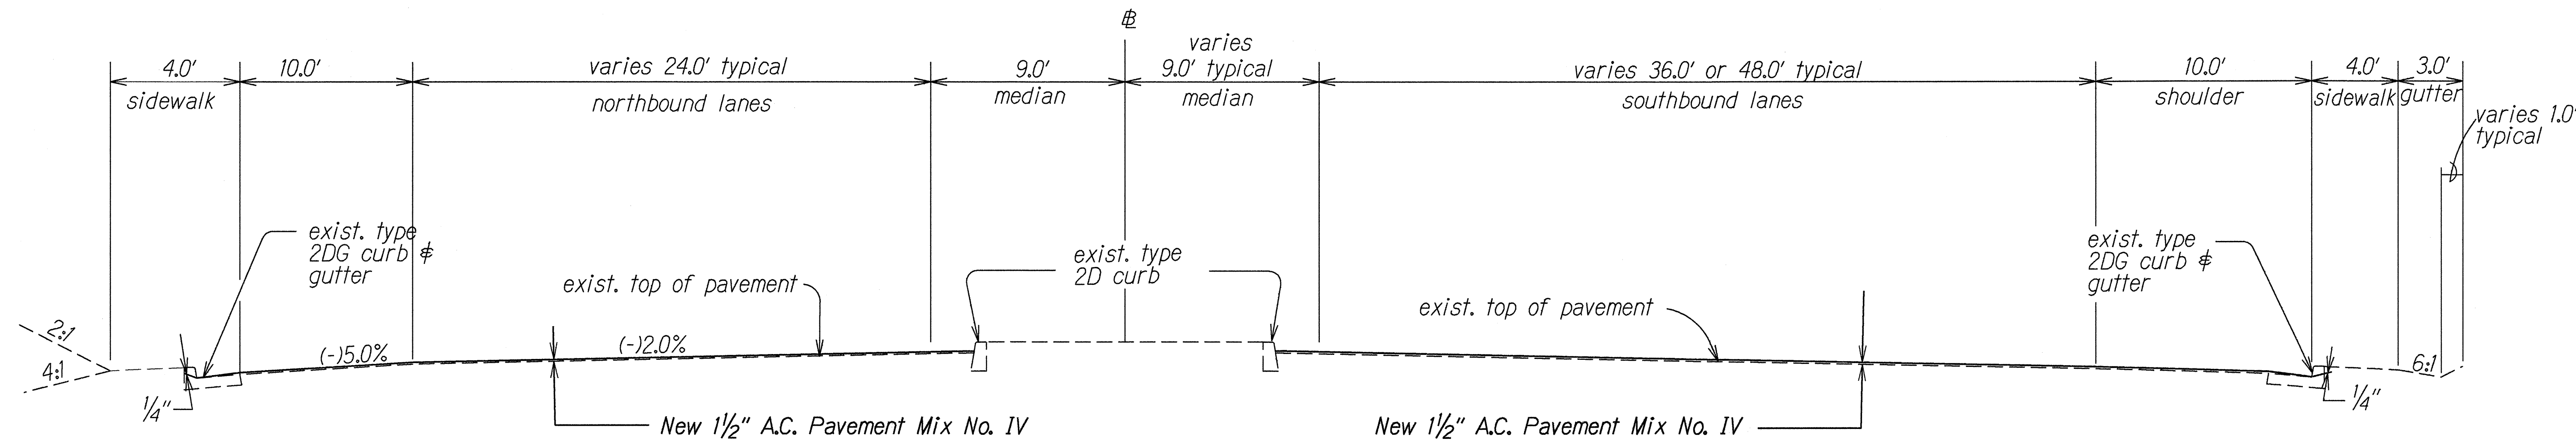


FED. ROAD DIST. NO.	STATE	FED. AID PROJ. NO.	FISCAL YEAR	SHEET NO.	TOTAL SHEETS
HAWAII	HAW.	STP-724(1)	1995	5	42

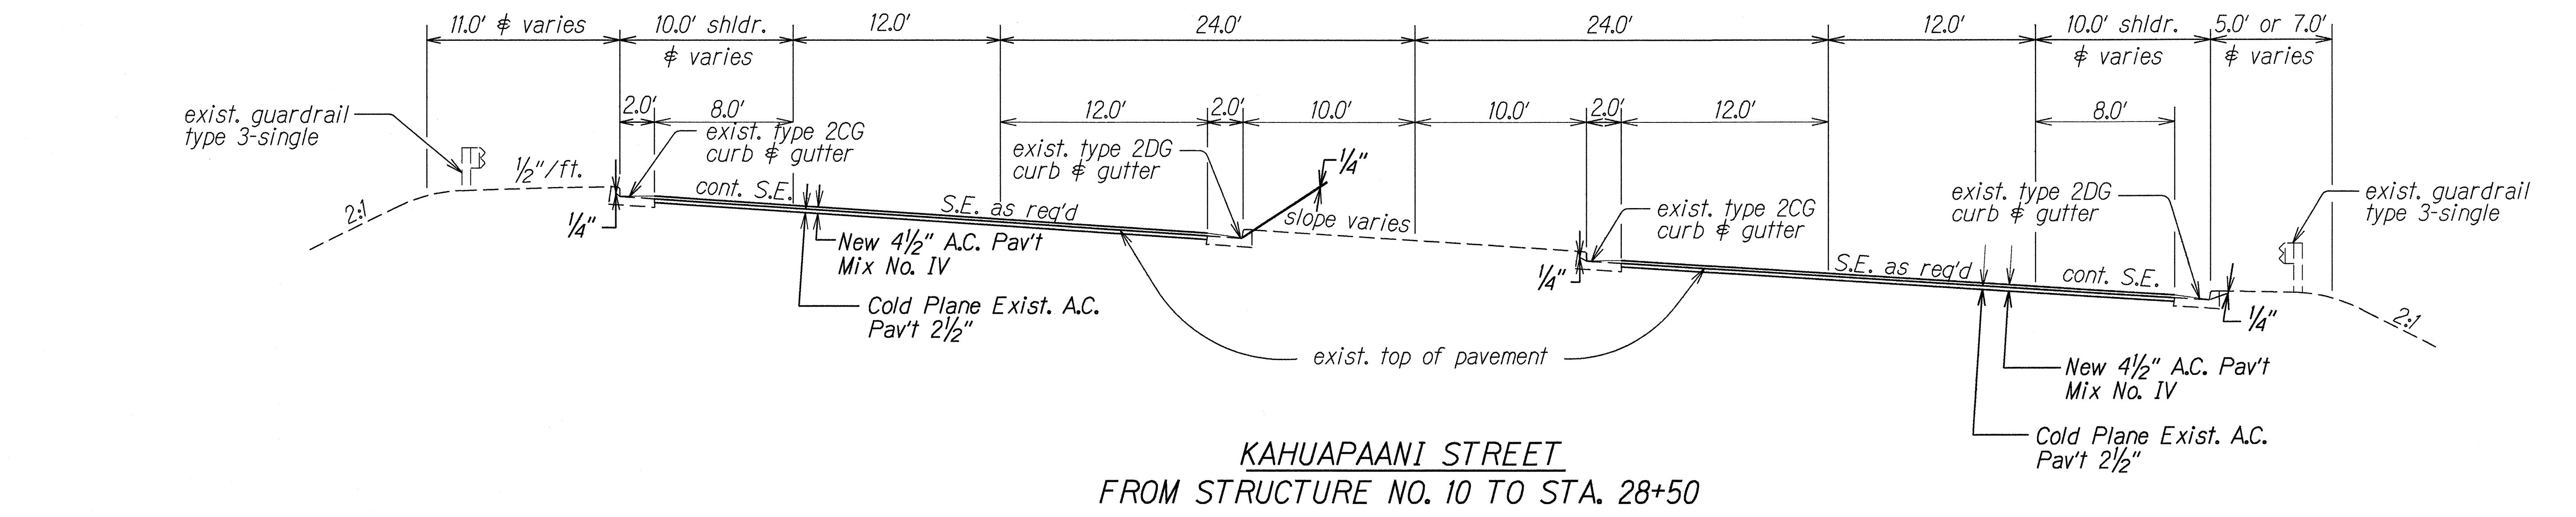

COLD PLANING IN LIEU OF PAVING CONCRETE GUTTERS
KAHUAPAANI ST. ± Sta. 32+80 to 64+50 N.B. & S.B.
 Scale: 1" = 1'-0"

KAHUAPAANI ST. TANGENT SECTION
 ± STA. 36+35.07 TO ± STA. 45+53.16
 Scale: 1/4"=1'-0"

LEGEND FOR AS-BUILT POSTINGS	
	Squiggly line for as-built deletion
	Double line for as-built deletion
Roadway	Text for as-built posting

STATE OF HAWAII
DEPARTMENT OF TRANSPORTATION
HIGHWAYS DIVISION



TYPICAL SECTION
KAHUAPAANI STREET RESURFACING
Ulune Street to Salt Lake Blvd.
Fed. Aid Project No. STP-724(1)
Scale: 1"=5'-0" Date: May, 1995

SHEET No. 1 OF 9 SHEETS

SURVEY PLOTTED BY	DATE
DESIGNED BY	5/15/95
TRACED BY	
NOTE BOOK	
QUANTITIES BY	
CHECKED BY	

"AS-BUILT"

FED. ROAD DIST. NO.	STATE	FED. AID PROJ. NO.	FISCAL YEAR	SHEET NO.	TOTAL SHEETS
HAWAII	HAW.	STP-724(1)	1995	6	42

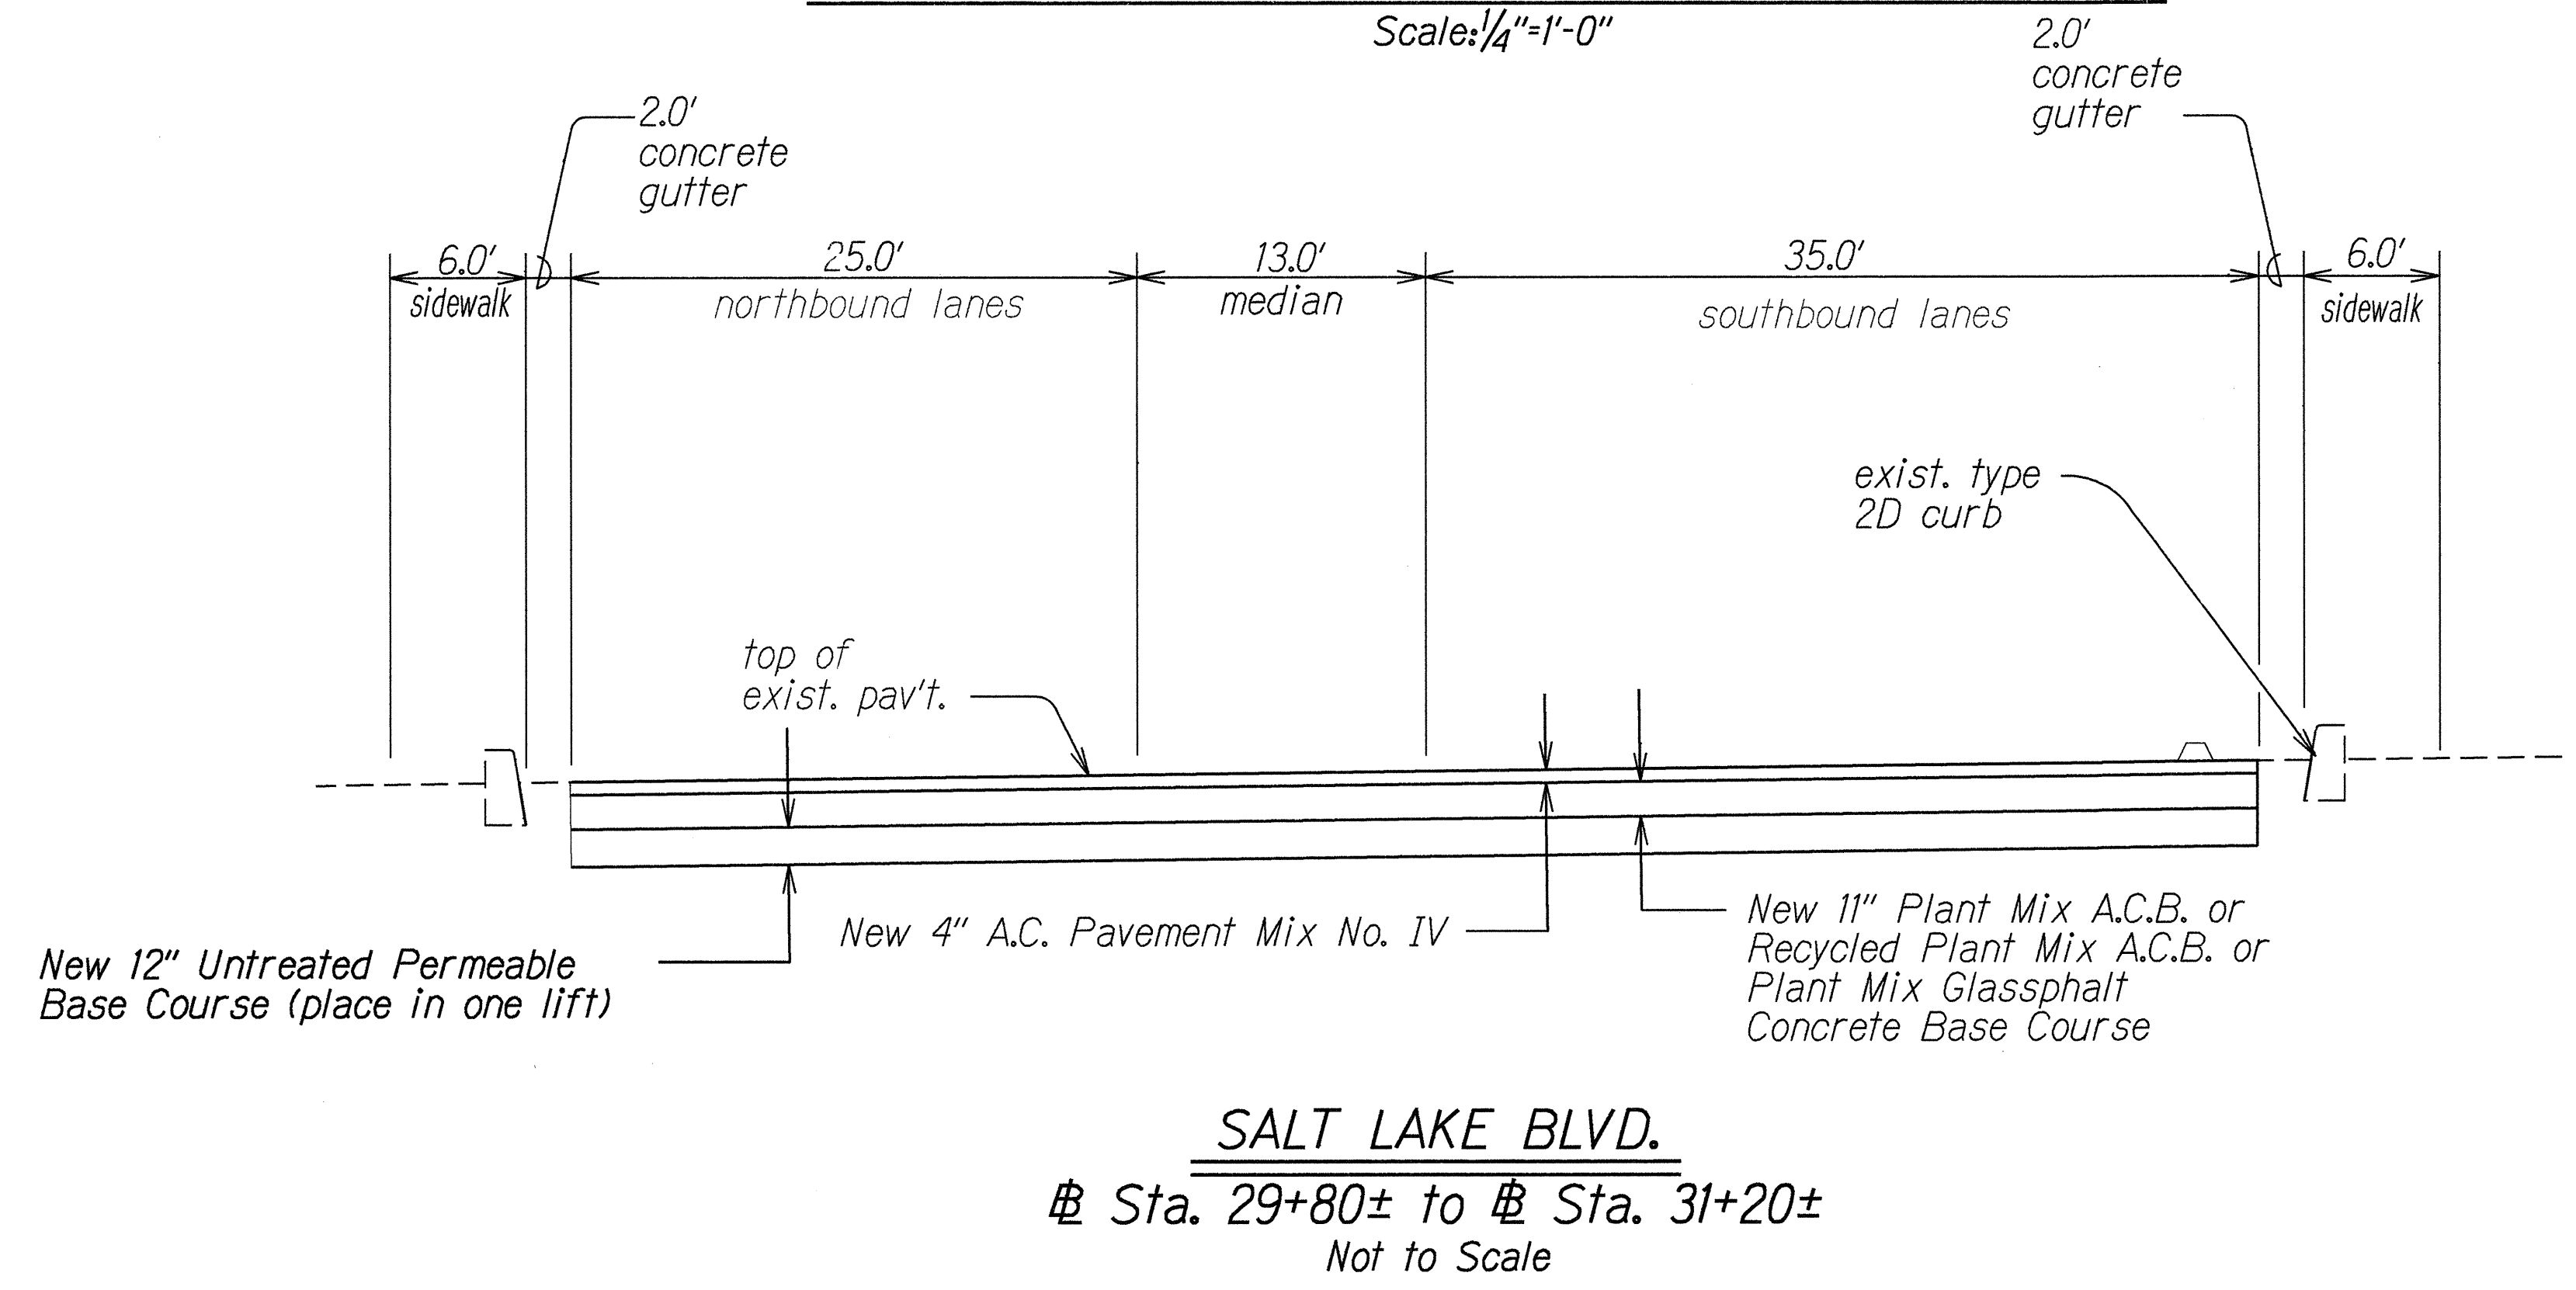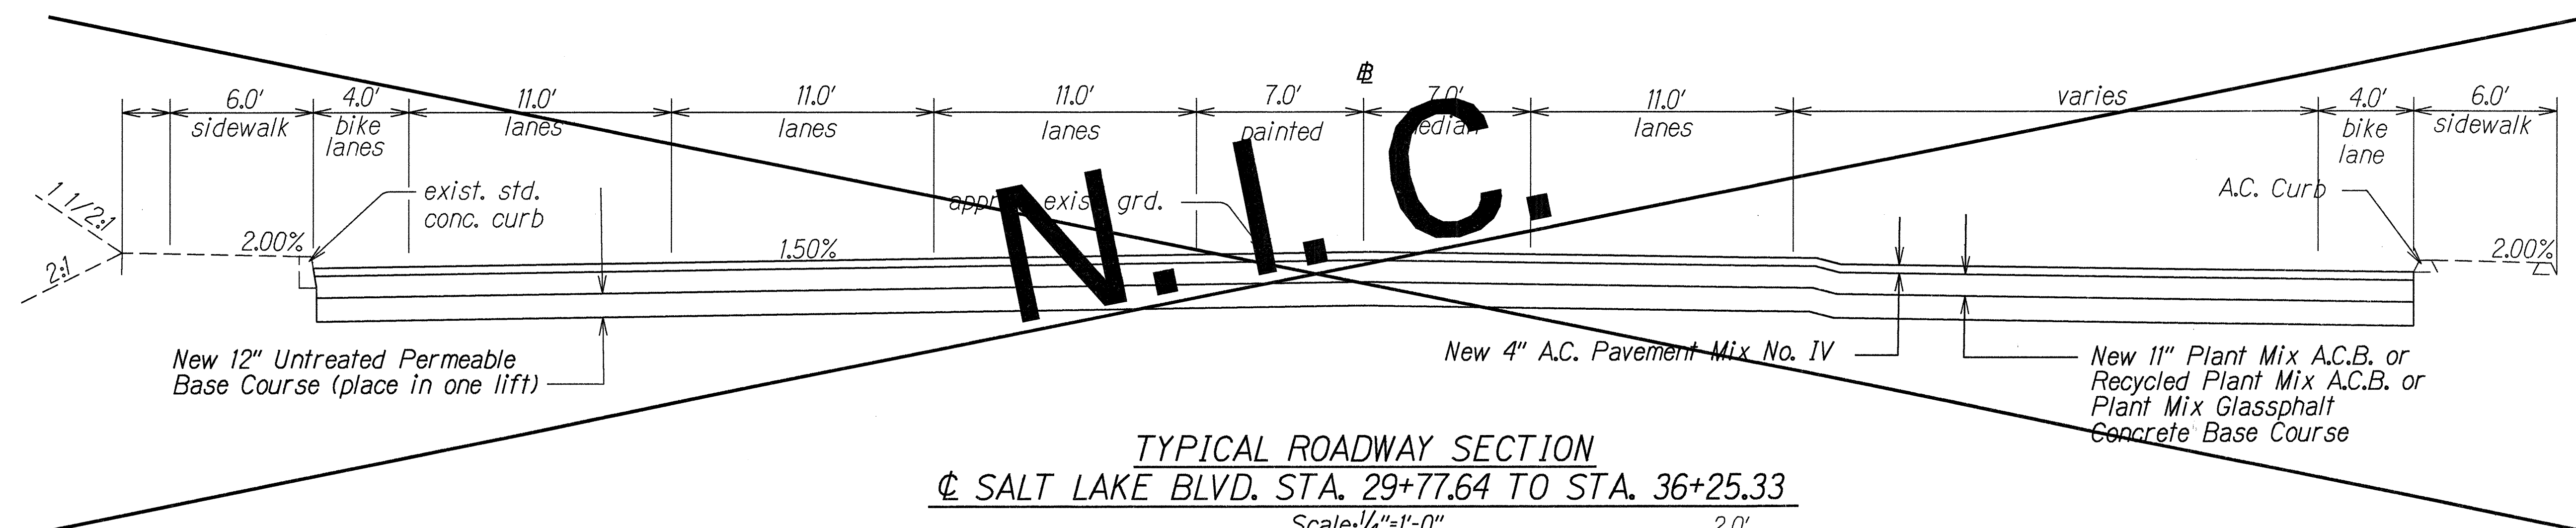

Note: For underdrain detail see Plan Sheet No. ADD. 25.

ORIGINAL PLAN	SURVEY PLATTED BY	DATE
NOTED BOOK	DRAWN BY G. Kawahala	6/22/95
QUANTITIES BY	TRACED BY K. Ng	
CHECKED BY	NOTED BY	

6/22/95	Revised typical sections
DATE	REVISION


STATE OF HAWAII
DEPARTMENT OF TRANSPORTATION
HIGHWAYS DIVISION

TYPICAL SECTIONS
KAHUAPAANI STREET RESURFACING
Ulune Street to Salt Lake Blvd.
Fed. Aid Project No. STP-724(1)


Scale: as shown
Date: May 1995

SHEET No. 2 OF 9 SHEETS


FED. ROAD DIST. NO.	STATE	FED. AID PROJ. NO.	FISCAL YEAR	SHEET NO.	TOTAL SHEETS
HAWAII	HAW.	STP-7241(1)	1995	7	42

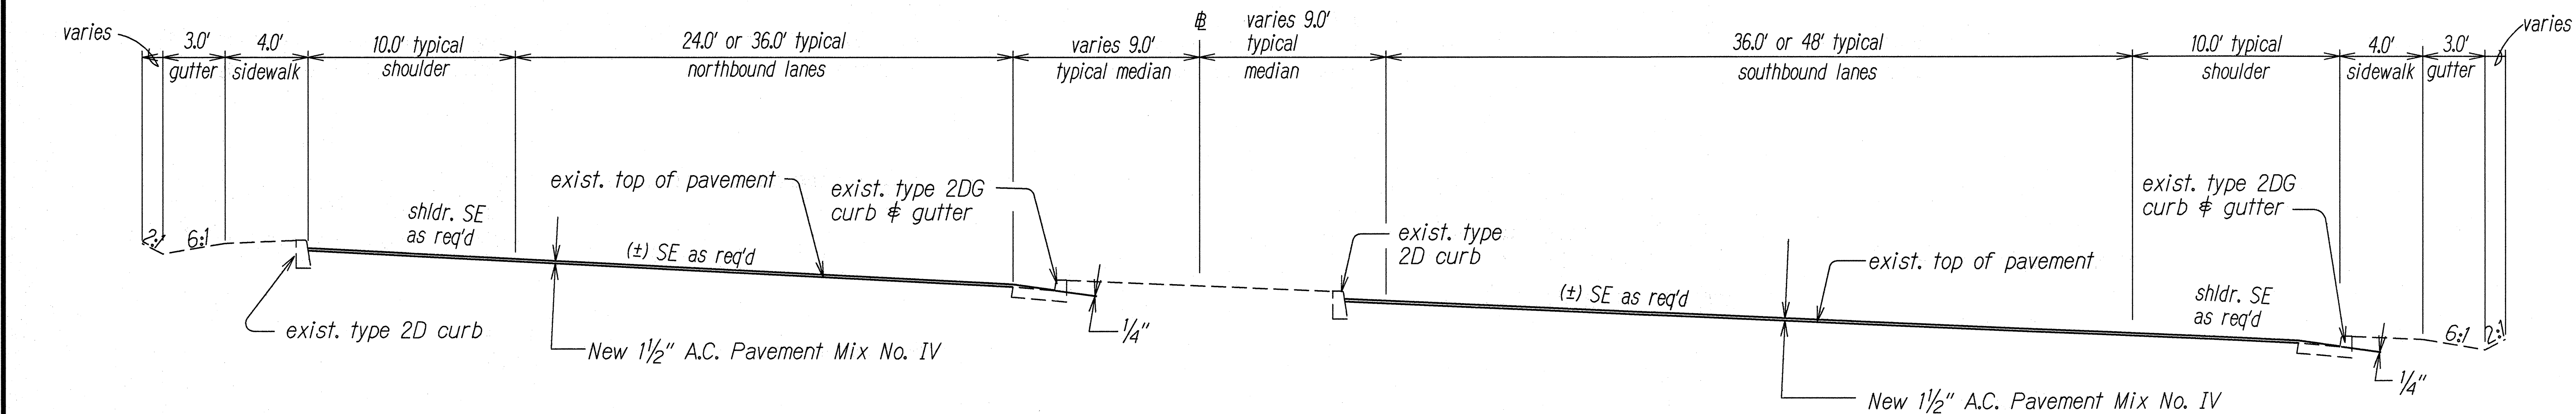

KAHUAPAANI ST. SUPERELEVATED SECTION
 # STA. 32+82.74 TO # STA. 36+35.07
 # STA. 45+53.16 TO # STA. 49+00±
 Scale: 1/4" = 1'-0"

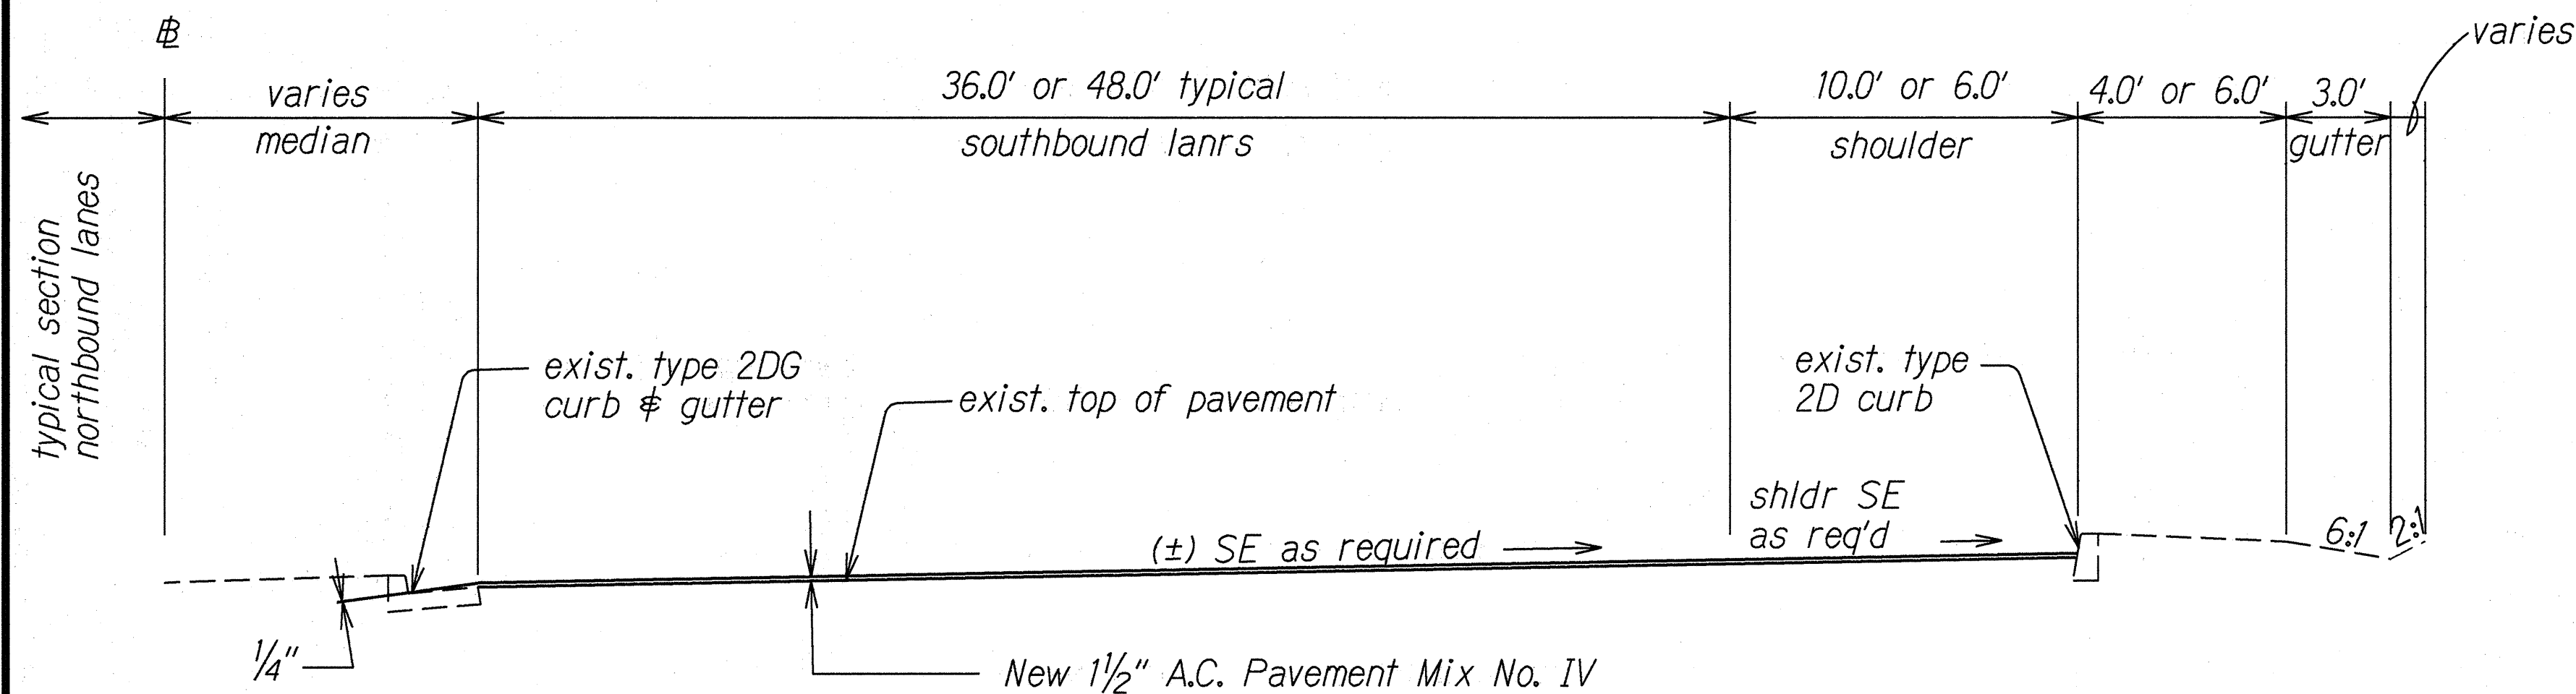

KAHUAPAANI ST. SUPERELEVATED SECTION
 # STA. 49+00± TO # STA. 56+06.74
 Scale: 1/4" = 1'-0"

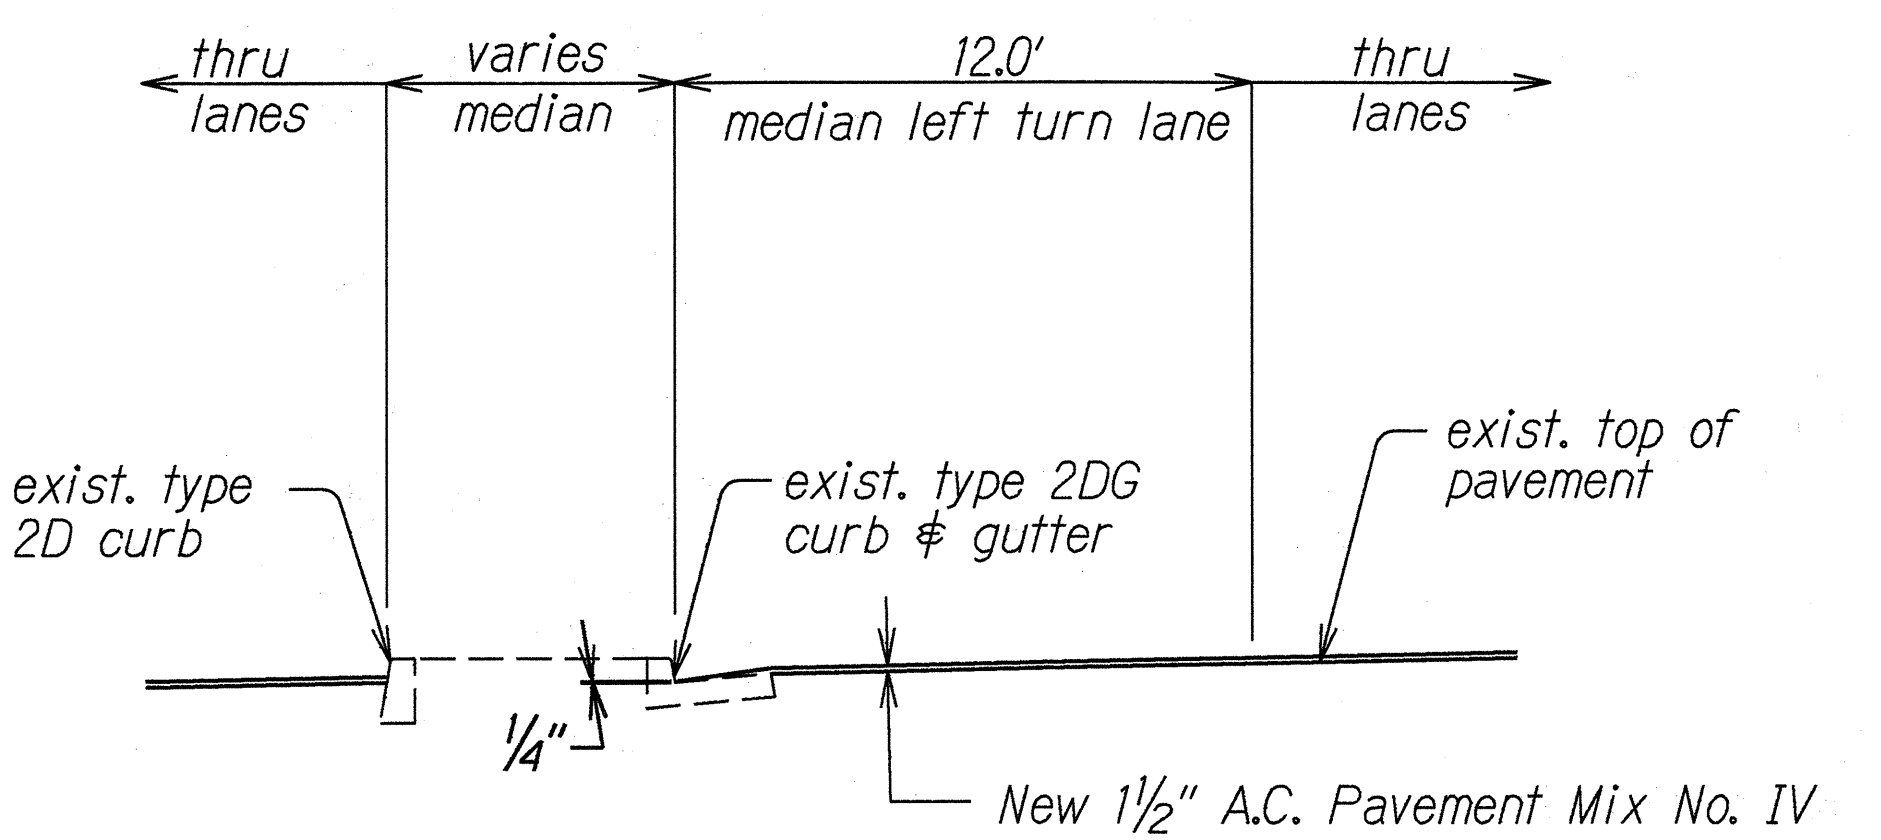

TYPICAL SECTION
AT MEDIAN LEFT TURN LANE
 S.B. LANES - # STA. 44+25 TO # STA. 49+33.96
 N.B. LANES - # STA. 50+64.45 TO # STA. 54+71.74
 Scale: 1/4" = 1'-0"

ORIGINAL PLAN	SURVEY PLOTTED BY	DATE
NOTE BOOK	DRAWN BY	6/12/95
DESIGNED BY	CHECKED BY	
QUANTITIES BY		


STATE OF HAWAII
DEPARTMENT OF TRANSPORTATION
HIGHWAYS DIVISION

TYPICAL SECTION
KAHUAPAANI ST. RESURFACING
Ulune St. to Salt lake Blvd.
Fed. Aid Project No. STP-7241(1)


Scale: as shown
Date: May, 1995

SHEET No. 3 OF 9 SHEETS

FED. ROAD DIST. NO.	STATE	FED. AID PROJ. NO.	FISCAL YEAR	SHEET NO.	TOTAL SHEETS
HAWAII	HAW.	STP-724(1)	1995	8	42

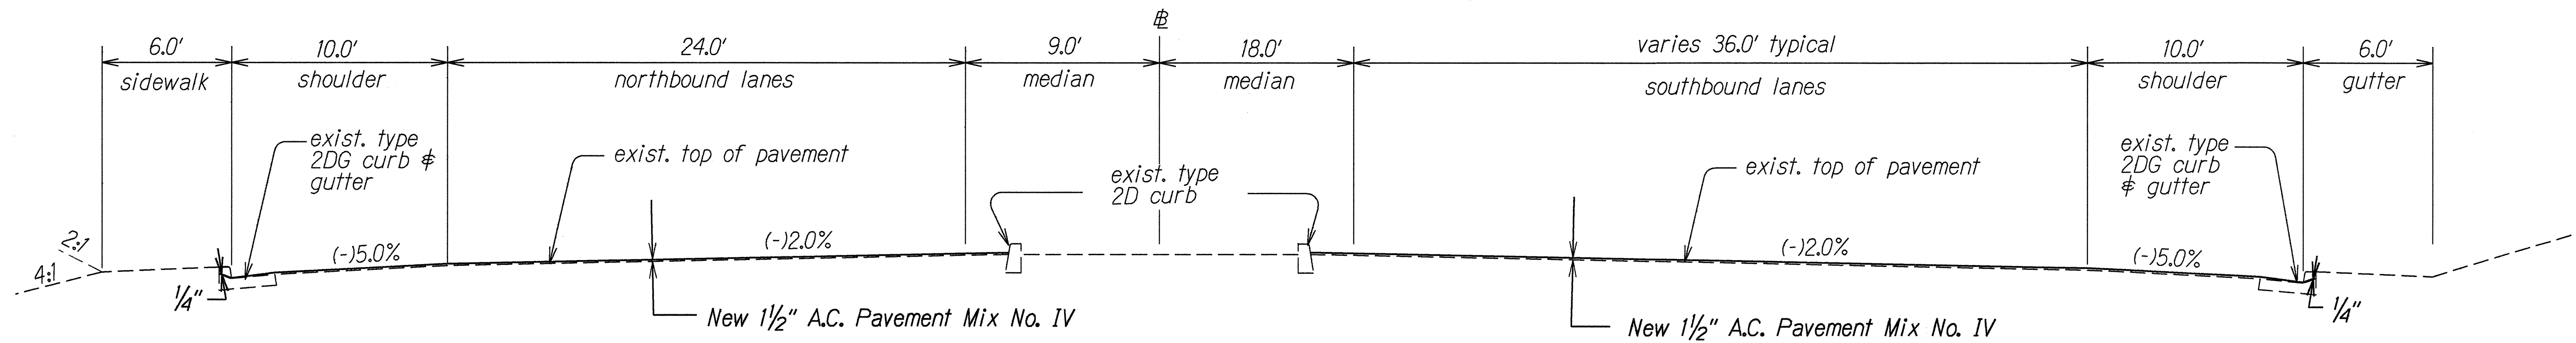

KAHUAPAANI ST. TANGENT SECTION
 ± STA. 56+06.74 TO SALT LAKE BLVD.
 Not to Scale

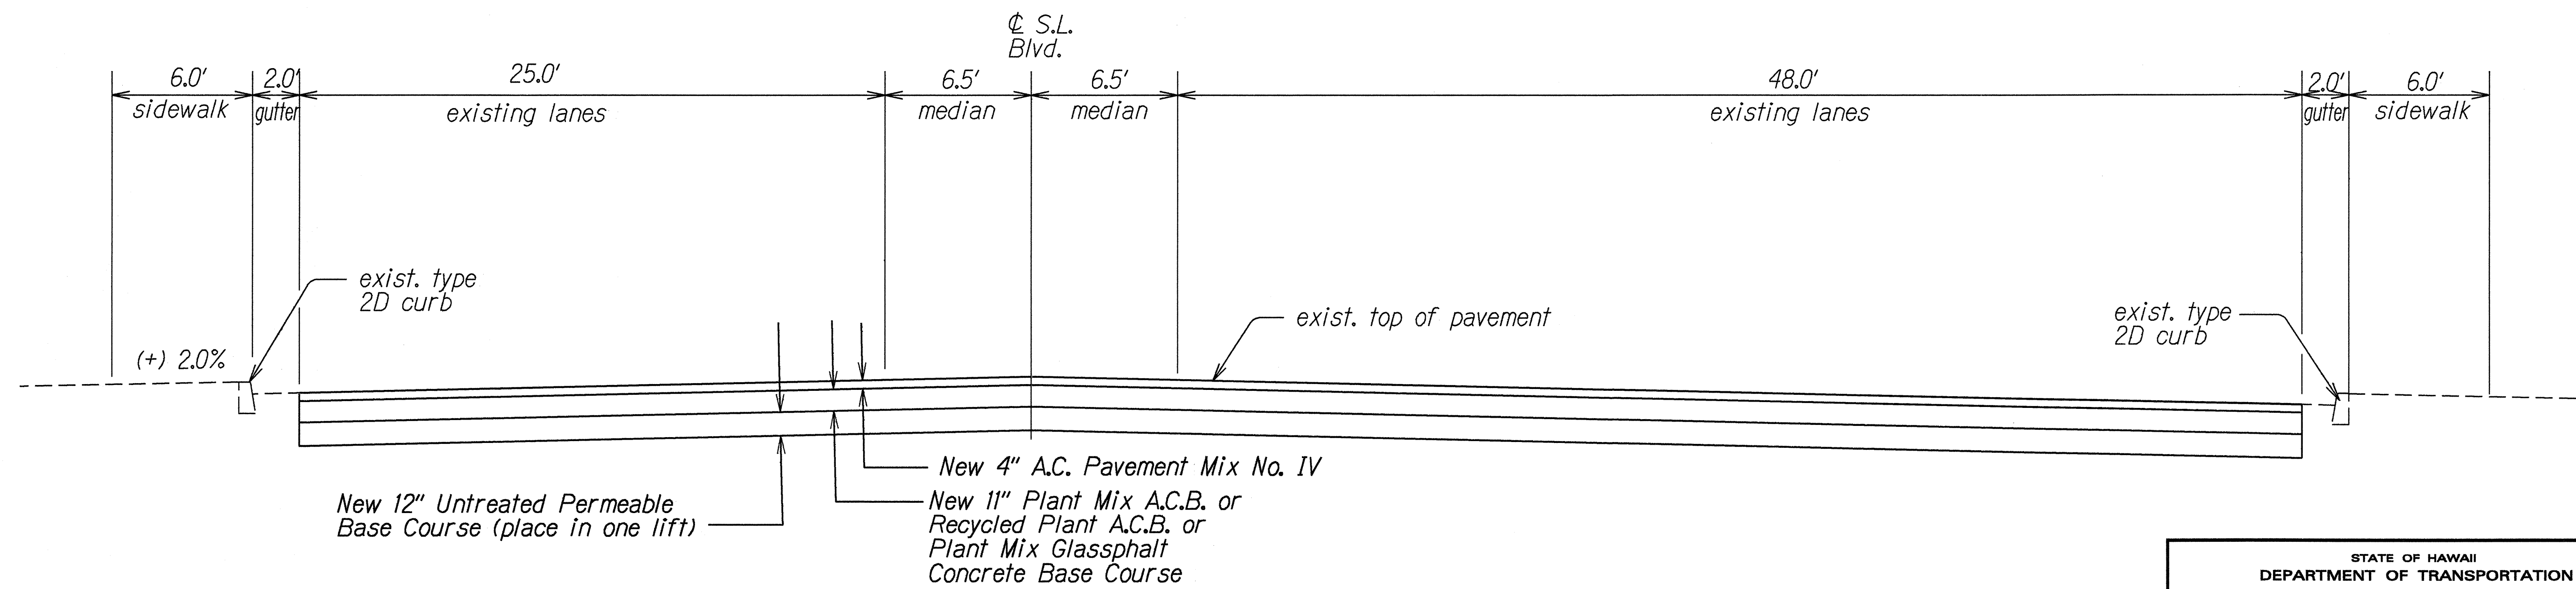

Note: For underdrain detail see Plan Sheet
 No. ADD. 25.

SALT LAKE BLVD. TYPICAL SECTION
 ± Sta. 27+82.39± to ± Sta. 29+80±
 Not to Scale

SURVEY PLATTED BY	DATE
DESIGNED BY	6/22/95
TRACED BY	
NOTED BY	
QUANTITIES BY	
CHECKED BY	

6/22/95	Revised typical sections
DATE	REVISION


STATE OF HAWAII
DEPARTMENT OF TRANSPORTATION
HIGHWAYS DIVISION

TYPICAL SECTION
KAHUAPAANI STREET RESURFACING
Ulune Street to Salt Lake Blvd.
Fed. Aid Project No. STP-724(1)


Scale: As Shown Date: May 1995

SHEET No. 4 OF 9 SHEETS

FED. ROAD DIST. NO.	STATE	FED. AID PROJ. NO.	FISCAL YEAR	SHEET NO.	TOTAL SHEETS
HAWAII	HAW.	STP-724(1)	1995	9	42

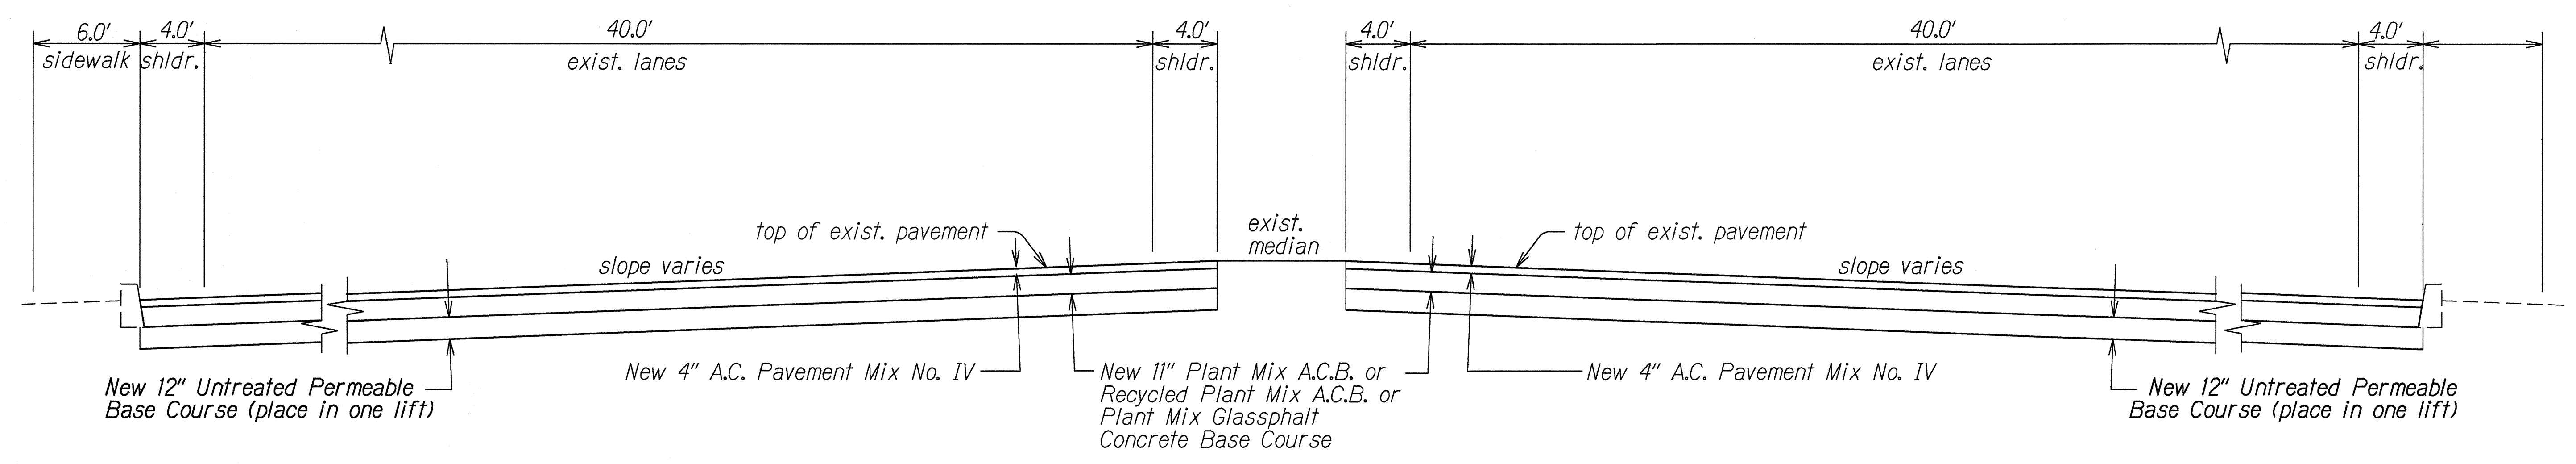

SALT LAKE BLVD.
 ± Sta. 31+20± to ± Sta. 33+30±
 Not to Scale

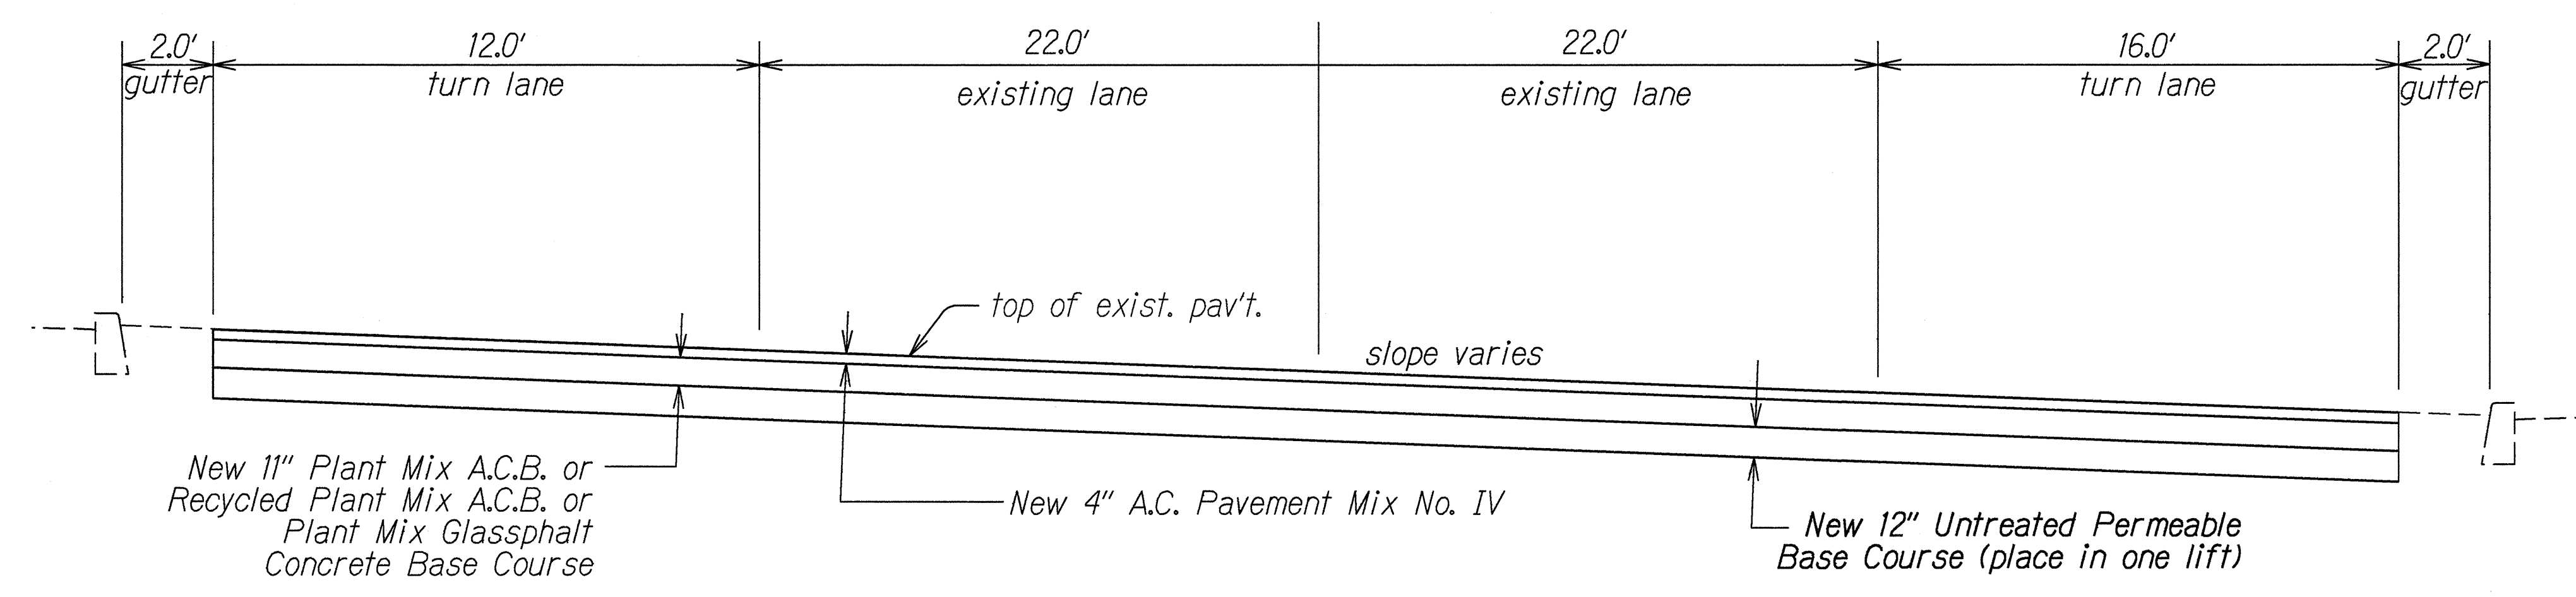

Note: For underdrain detail see Plan Sheet No. ADD. 25.

SALT LAKE BLVD.
 ± Sta. 36+22±
 Not to Scale

ORIGINAL PLAN	DATE
NOTED BY	6/22/95
DESIGNED BY	
CHECKED BY	

6/22/95	Revised typical sections
DATE	REVISION





STATE OF HAWAII
DEPARTMENT OF TRANSPORTATION
HIGHWAYS DIVISION

TYPICAL SECTION
KAHUAPAANI ST. RESURFACING
Ulune St. to Salt Lake Blvd.
Fed Aid Project No. STP-724(1)

Scale: As Shown Date: May 1995

SHEET No. 5 OF 9 SHEETS

FED. ROAD DIST. NO.	STATE	FED. AID PROJ. NO.	FISCAL YEAR	SHEET NO.	TOTAL SHEETS
HAWAII	HAW.	STP-724(1)	1995	10	42

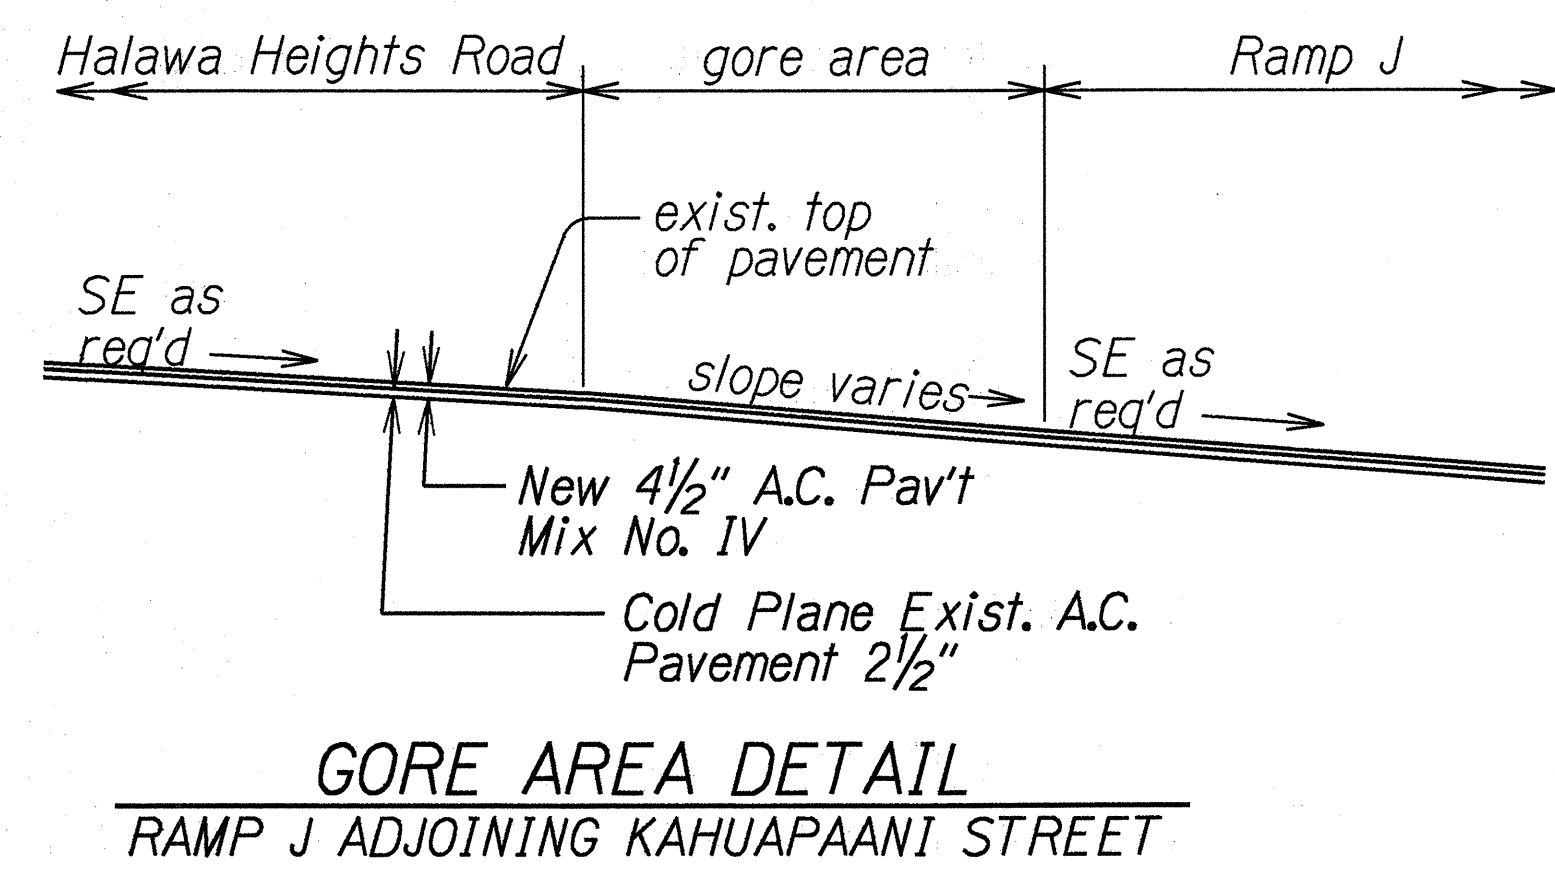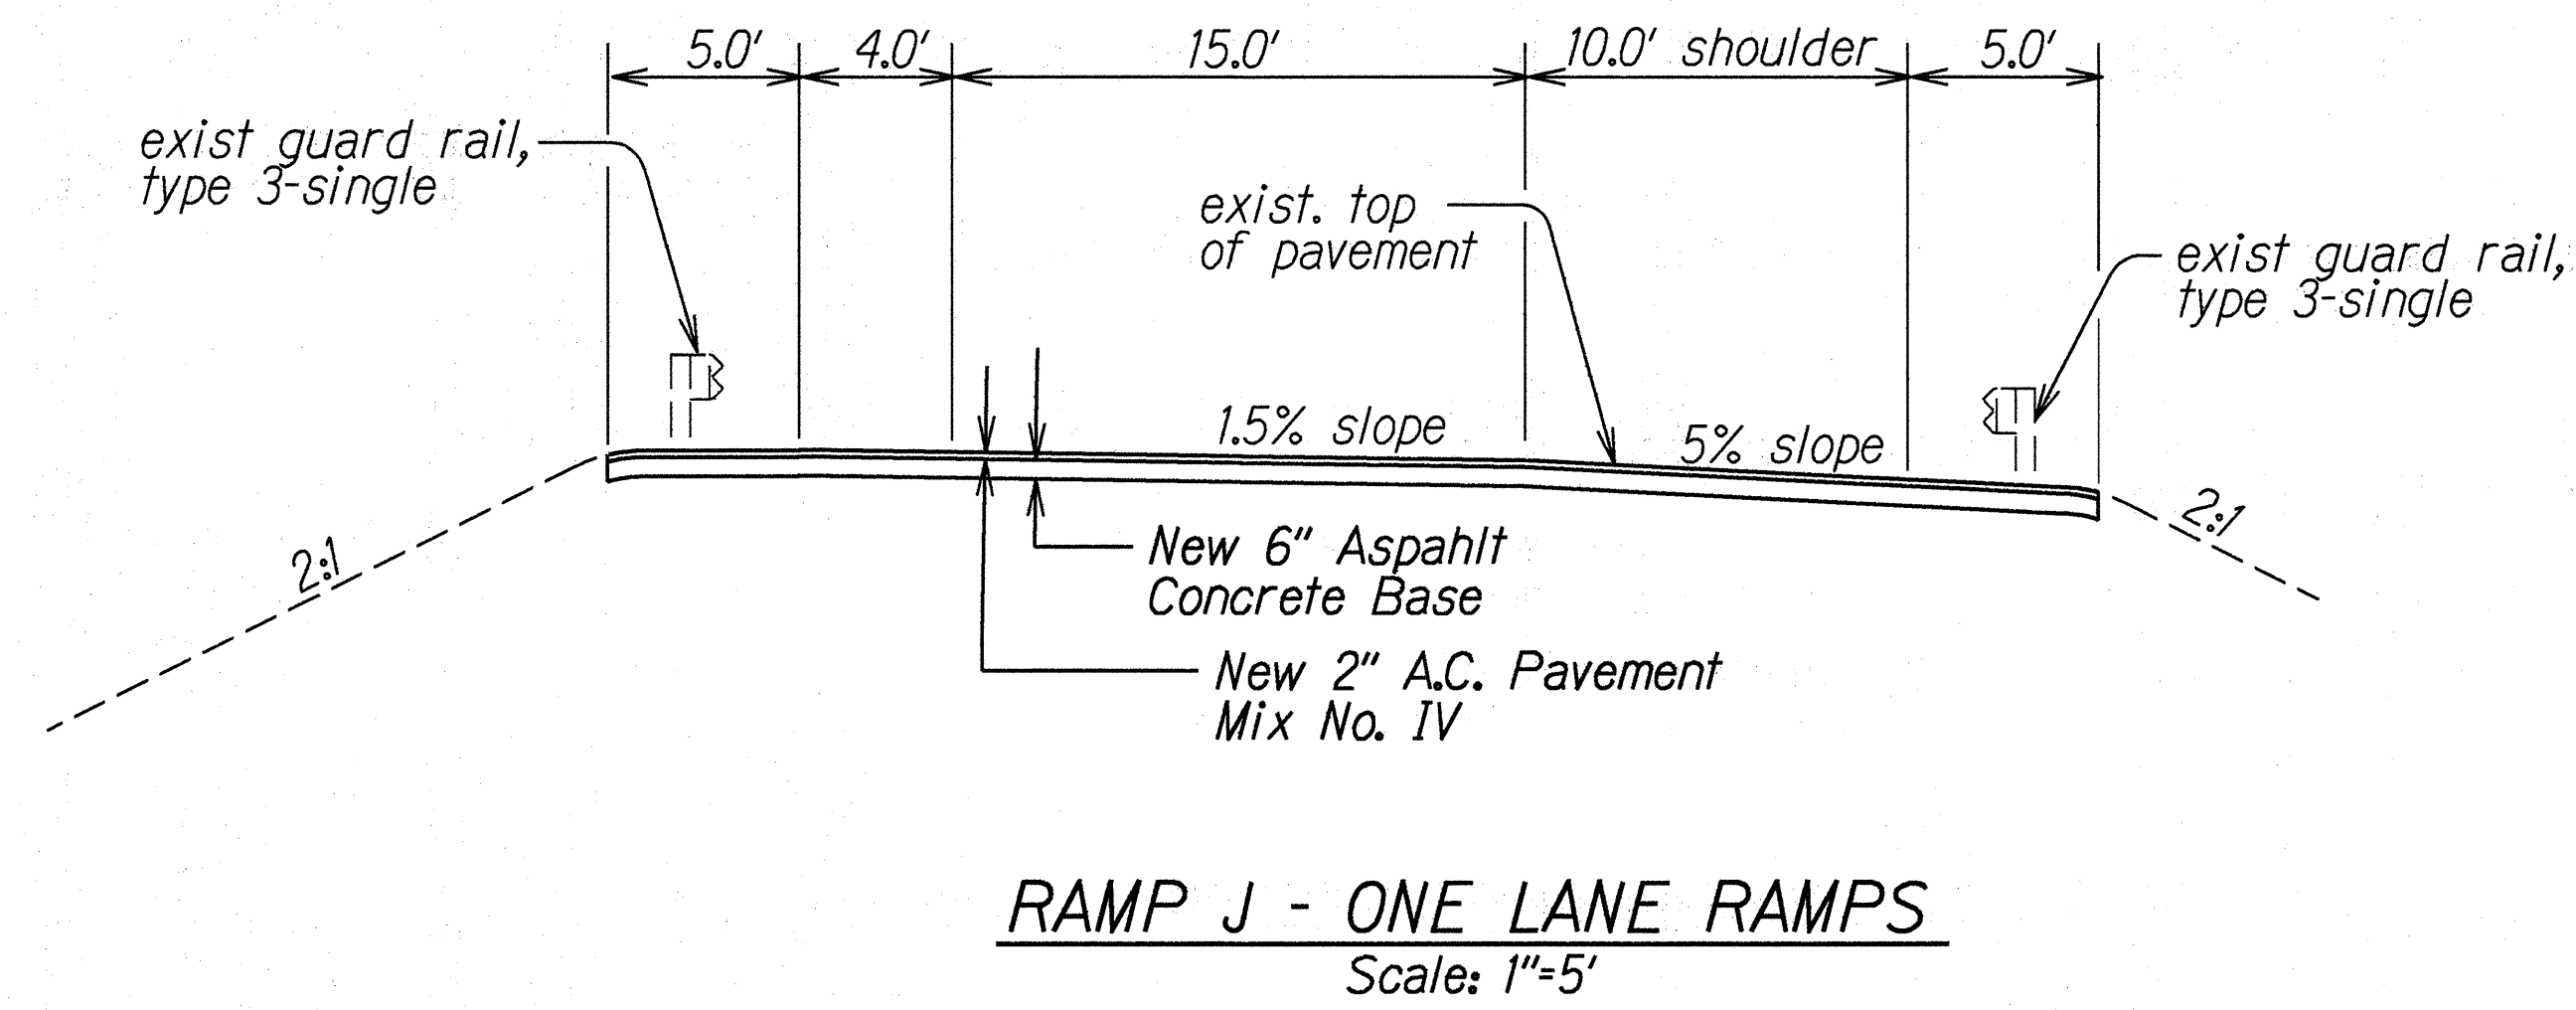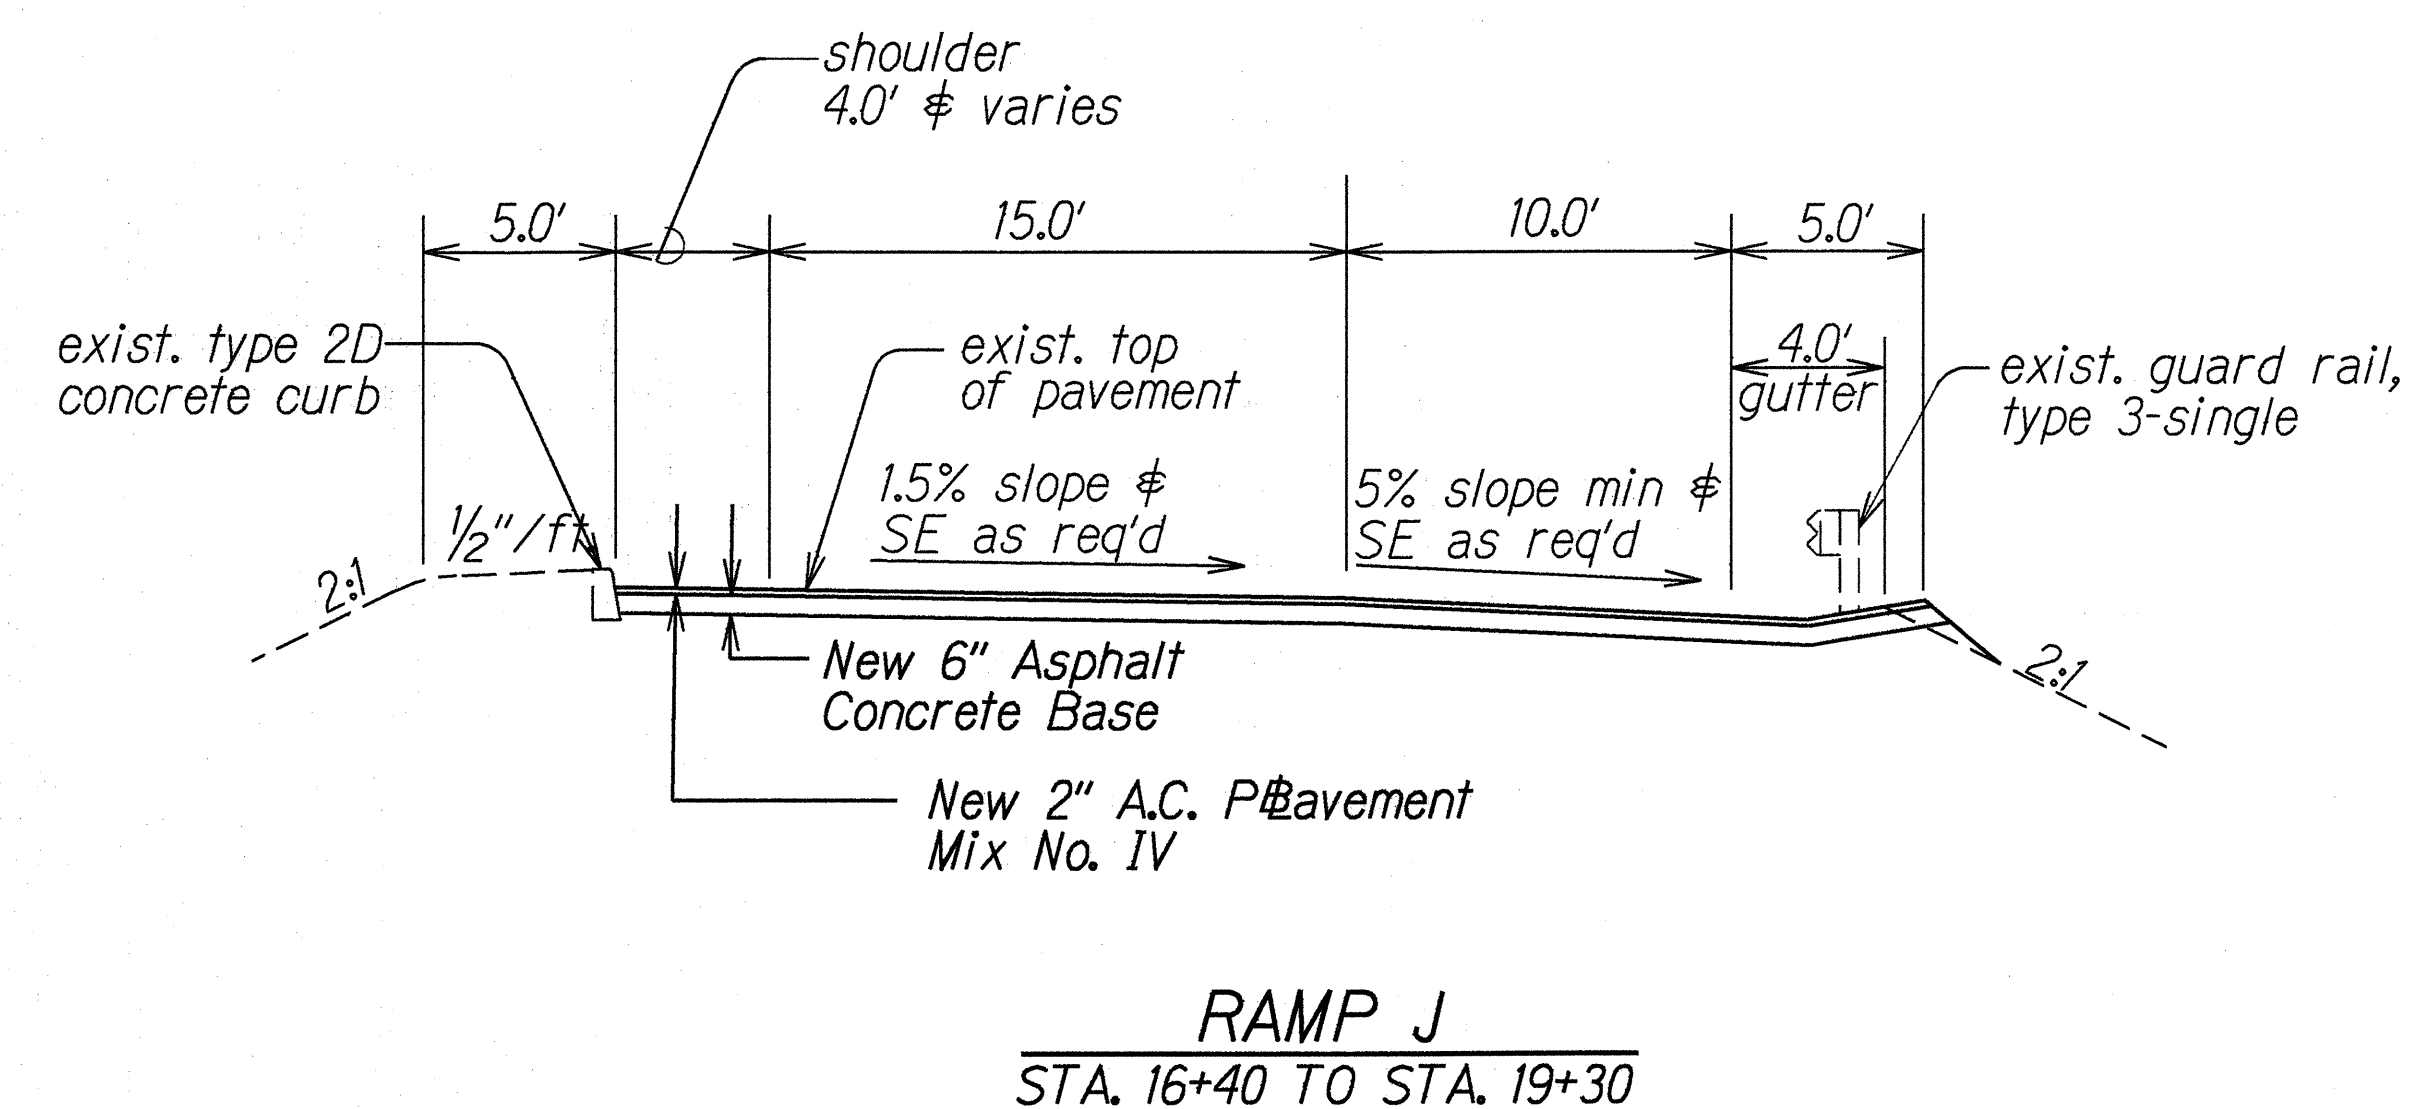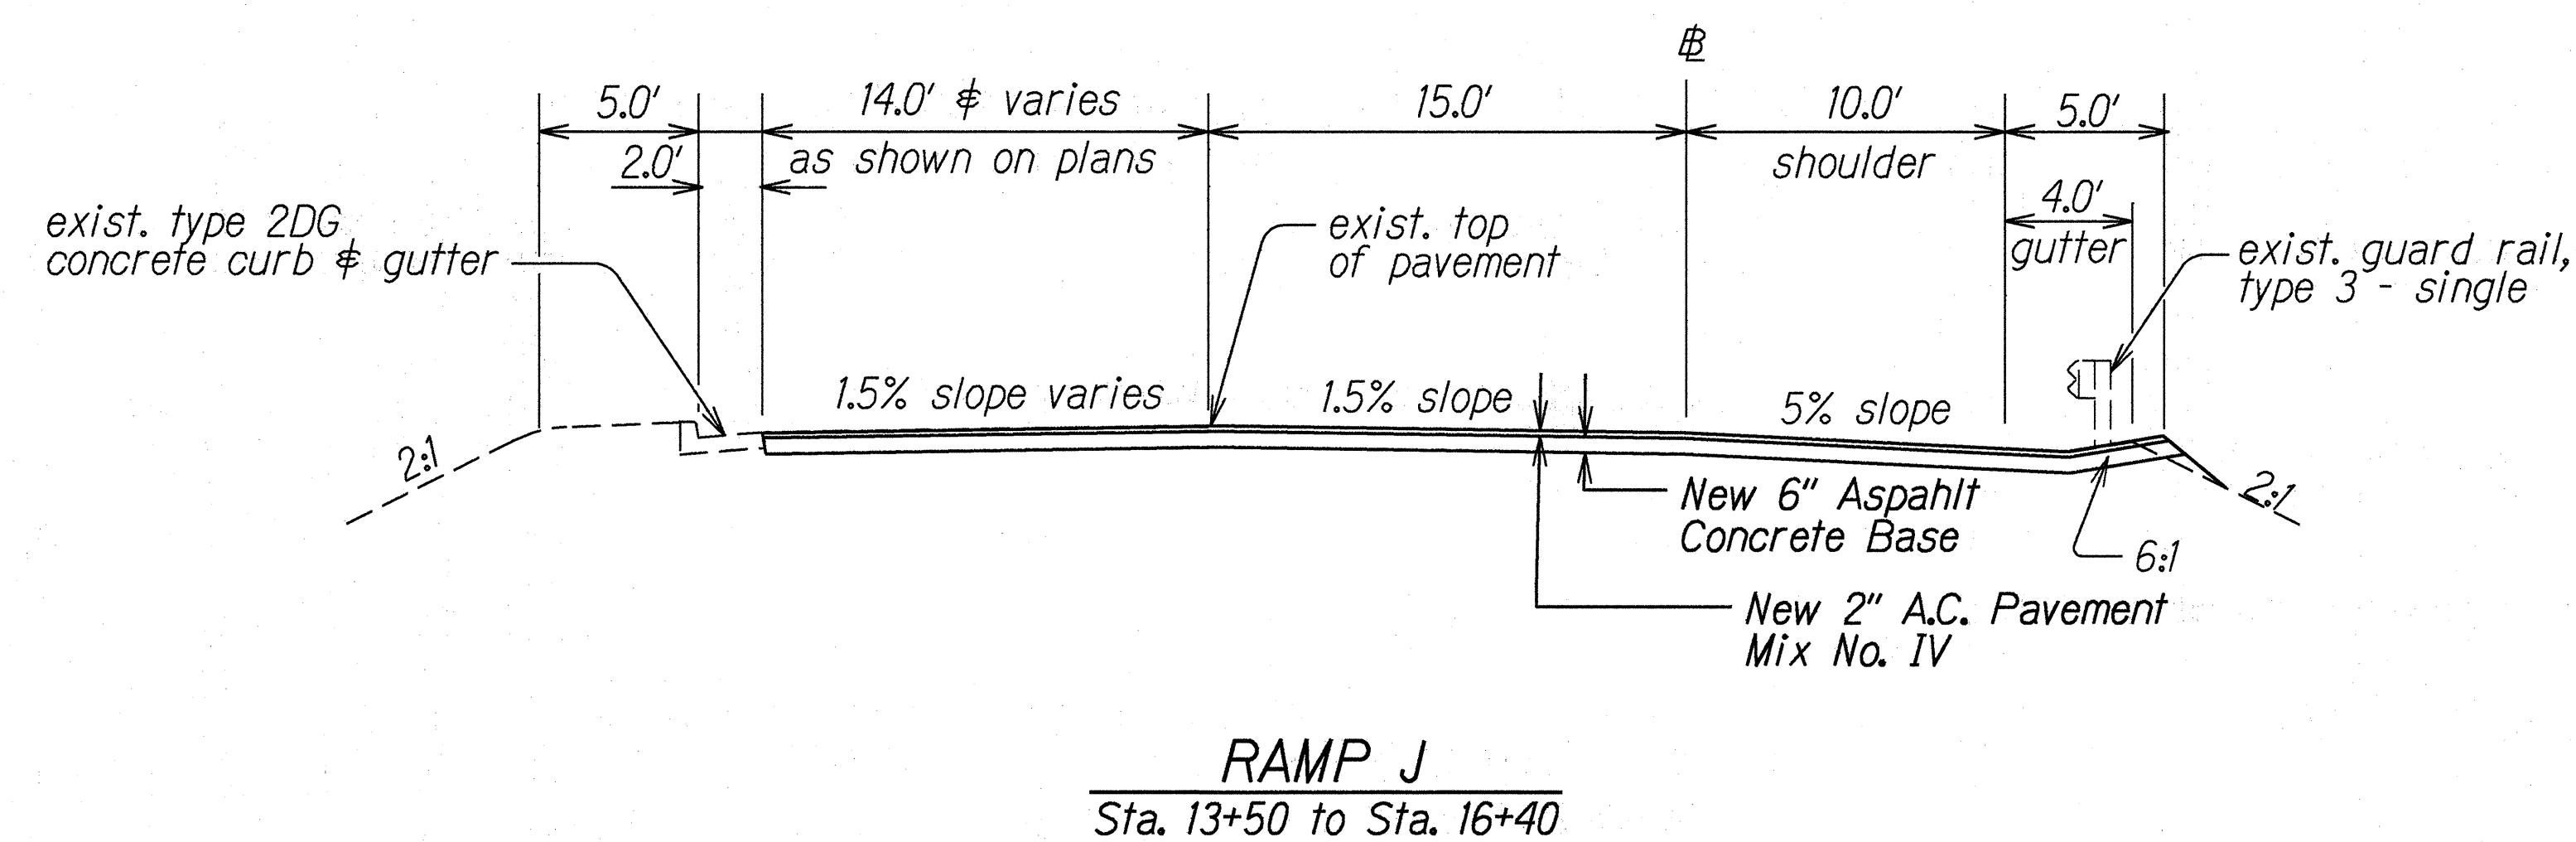

ORIGINAL PLAN	DATE
DRAWN BY G. Kawahala	5/22/95
NOTED BY K. Ng	
QUANTITIES BY	
CHECKED BY	


STATE OF HAWAII
DEPARTMENT OF TRANSPORTATION
HIGHWAYS DIVISION

TYPICAL SECTION
KAHUAPAANI STREET RESURFACING
Ulune Street to Salt Lake Blvd.
Fed. Aid Project No. STP-724(1)


Scale: 1" = 5'-0"
Date: May 1995

SHEET No. 6 OF 9 SHEETS


FED. ROAD DIST. NO.	STATE	FED. AID PROJ. NO.	FISCAL YEAR	SHEET NO.	TOTAL SHEETS
HAWAII	HAW.	STP-724(1)	1995	11	42

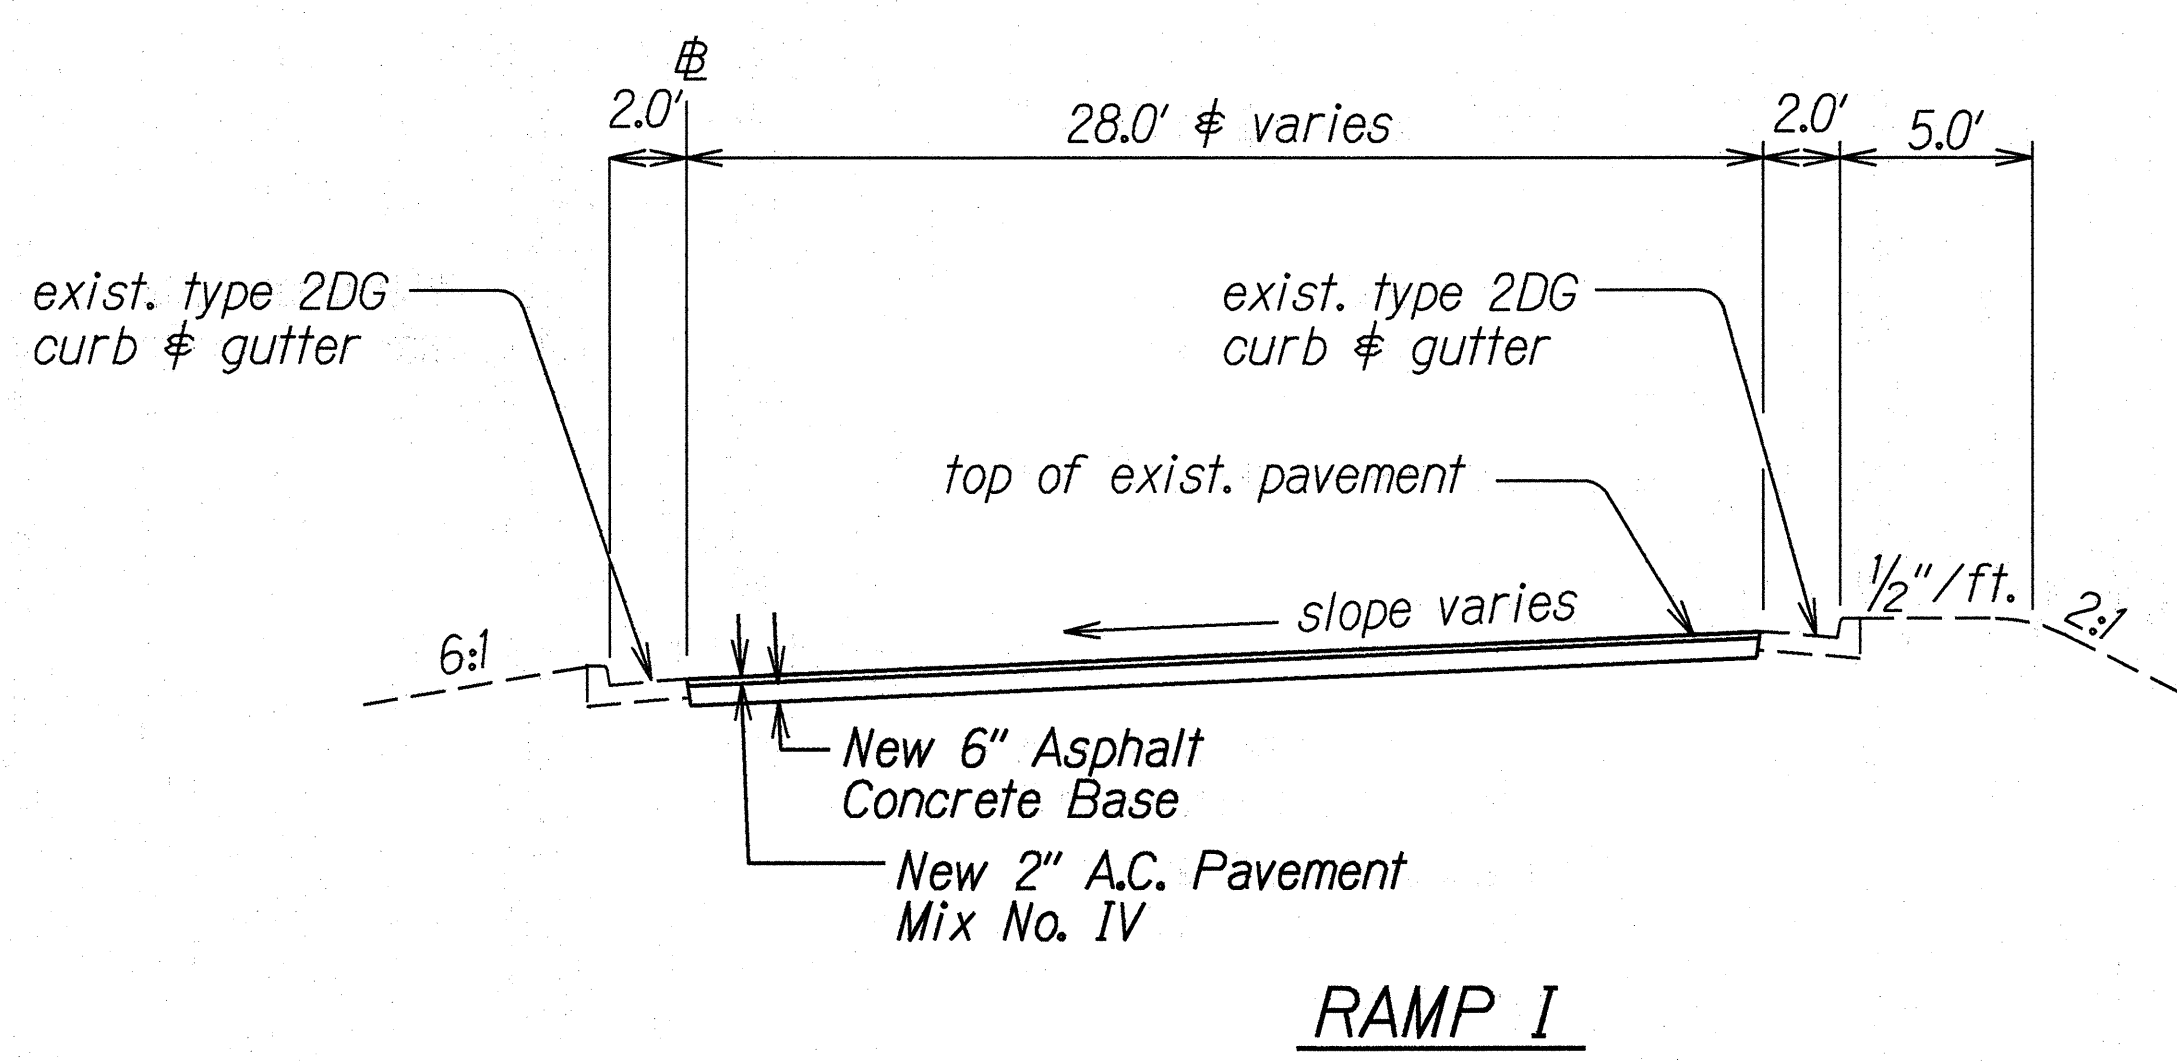

RAMP I

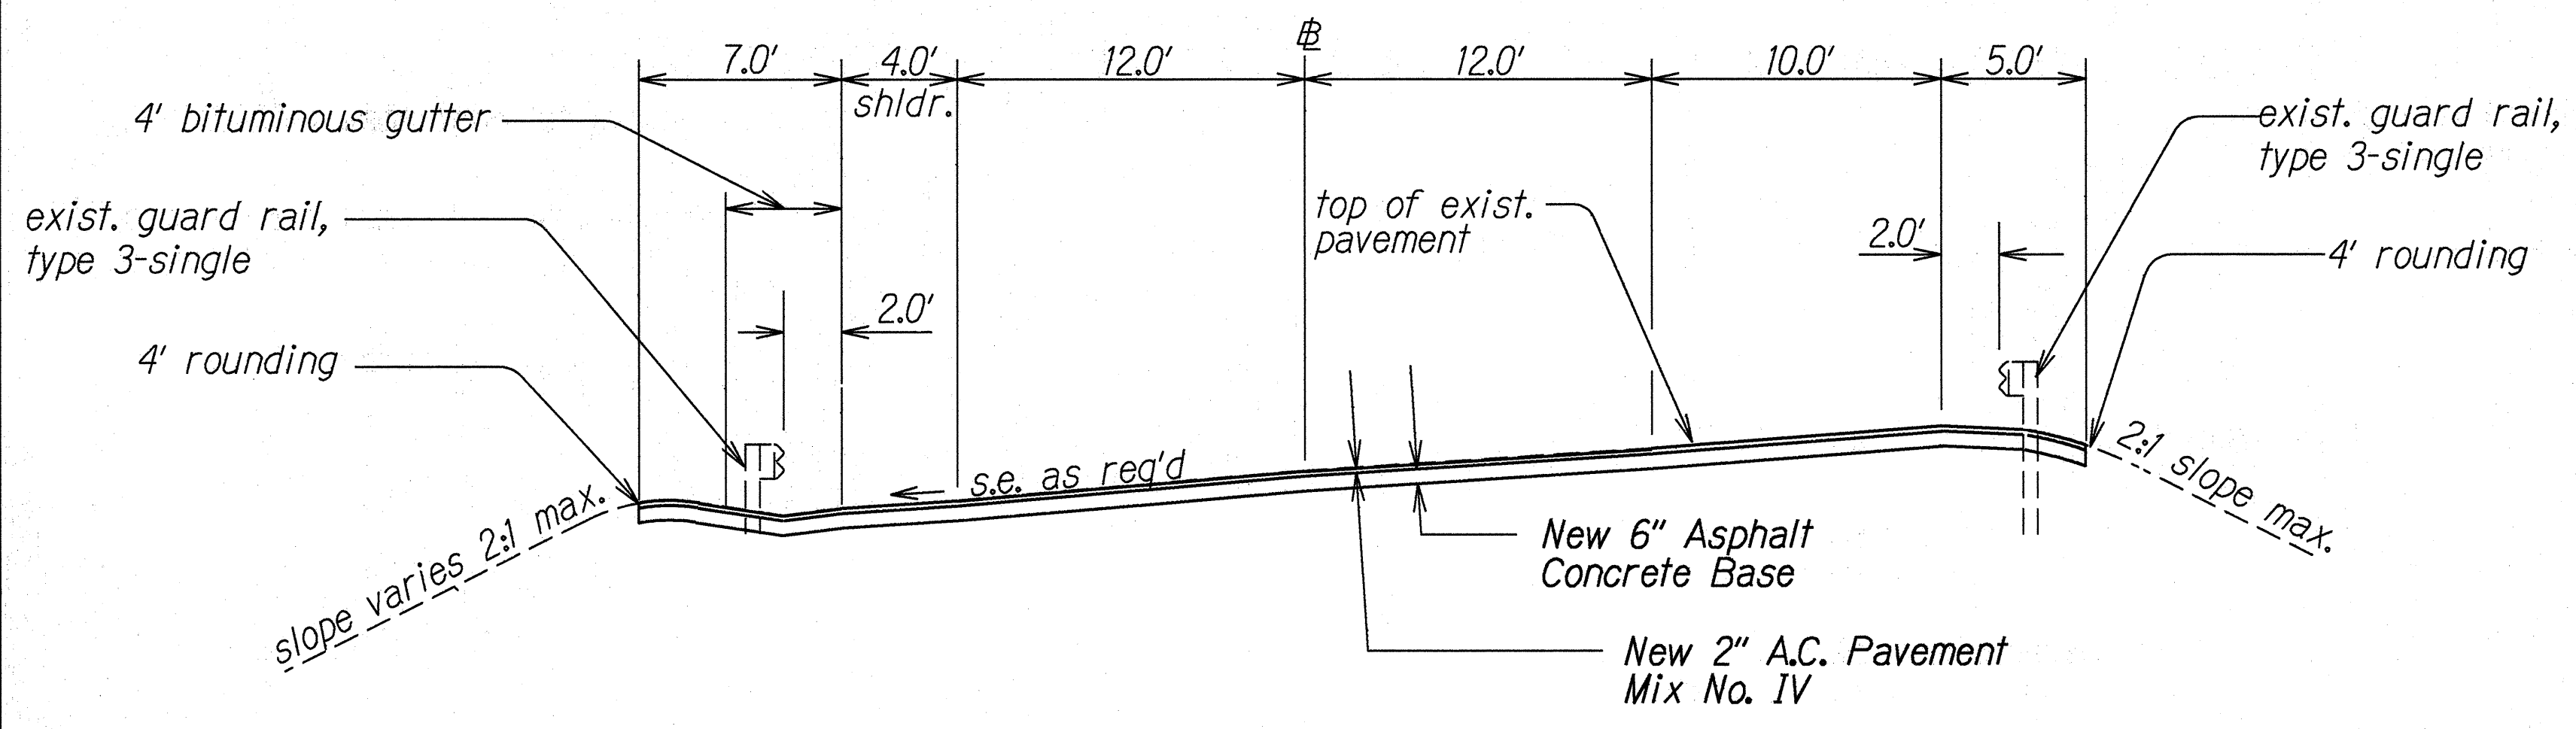

RAMP L
Sta. 14+95 to Sta. 19+44

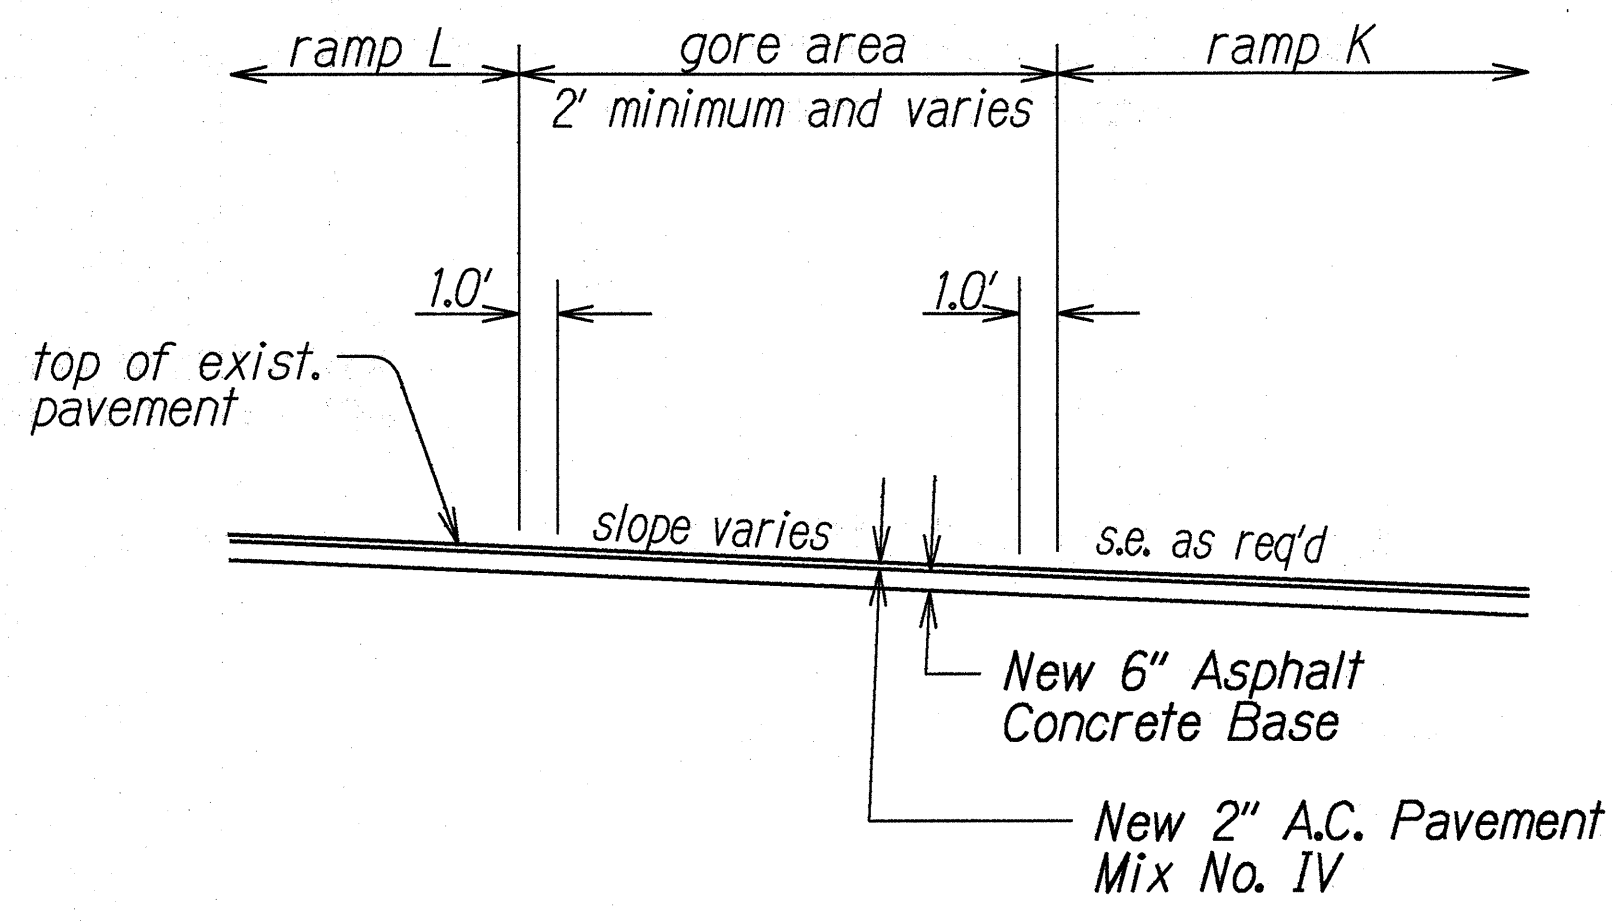

GORE AREA DETAIL
RAMP K & L




SURVEY PLOTTED BY	DATE
DRAWN BY G. Kawanishi	5/22/95
DESIGNED BY K. Ng	
QUANTITIES BY K. Ng	
CHECKED BY K. Ng	

STATE OF HAWAII
DEPARTMENT OF TRANSPORTATION
HIGHWAYS DIVISION

TYPICAL SECTION
KAHUAPAANI STREET RESURFACING
Ulune Street to Salt Lake Blvd.
Fed. Aid Project No. STP-724(1)
Scale: 1"=5'-0" Date: May 1995

SHEET No. 7 OF 9 SHEETS

FED. ROAD DIST. NO.	STATE	FED. AID PROJ. NO.	FISCAL YEAR	SHEET NO.	TOTAL SHEETS
HAWAII	HAW.	STP-724(1)	1995	12	42

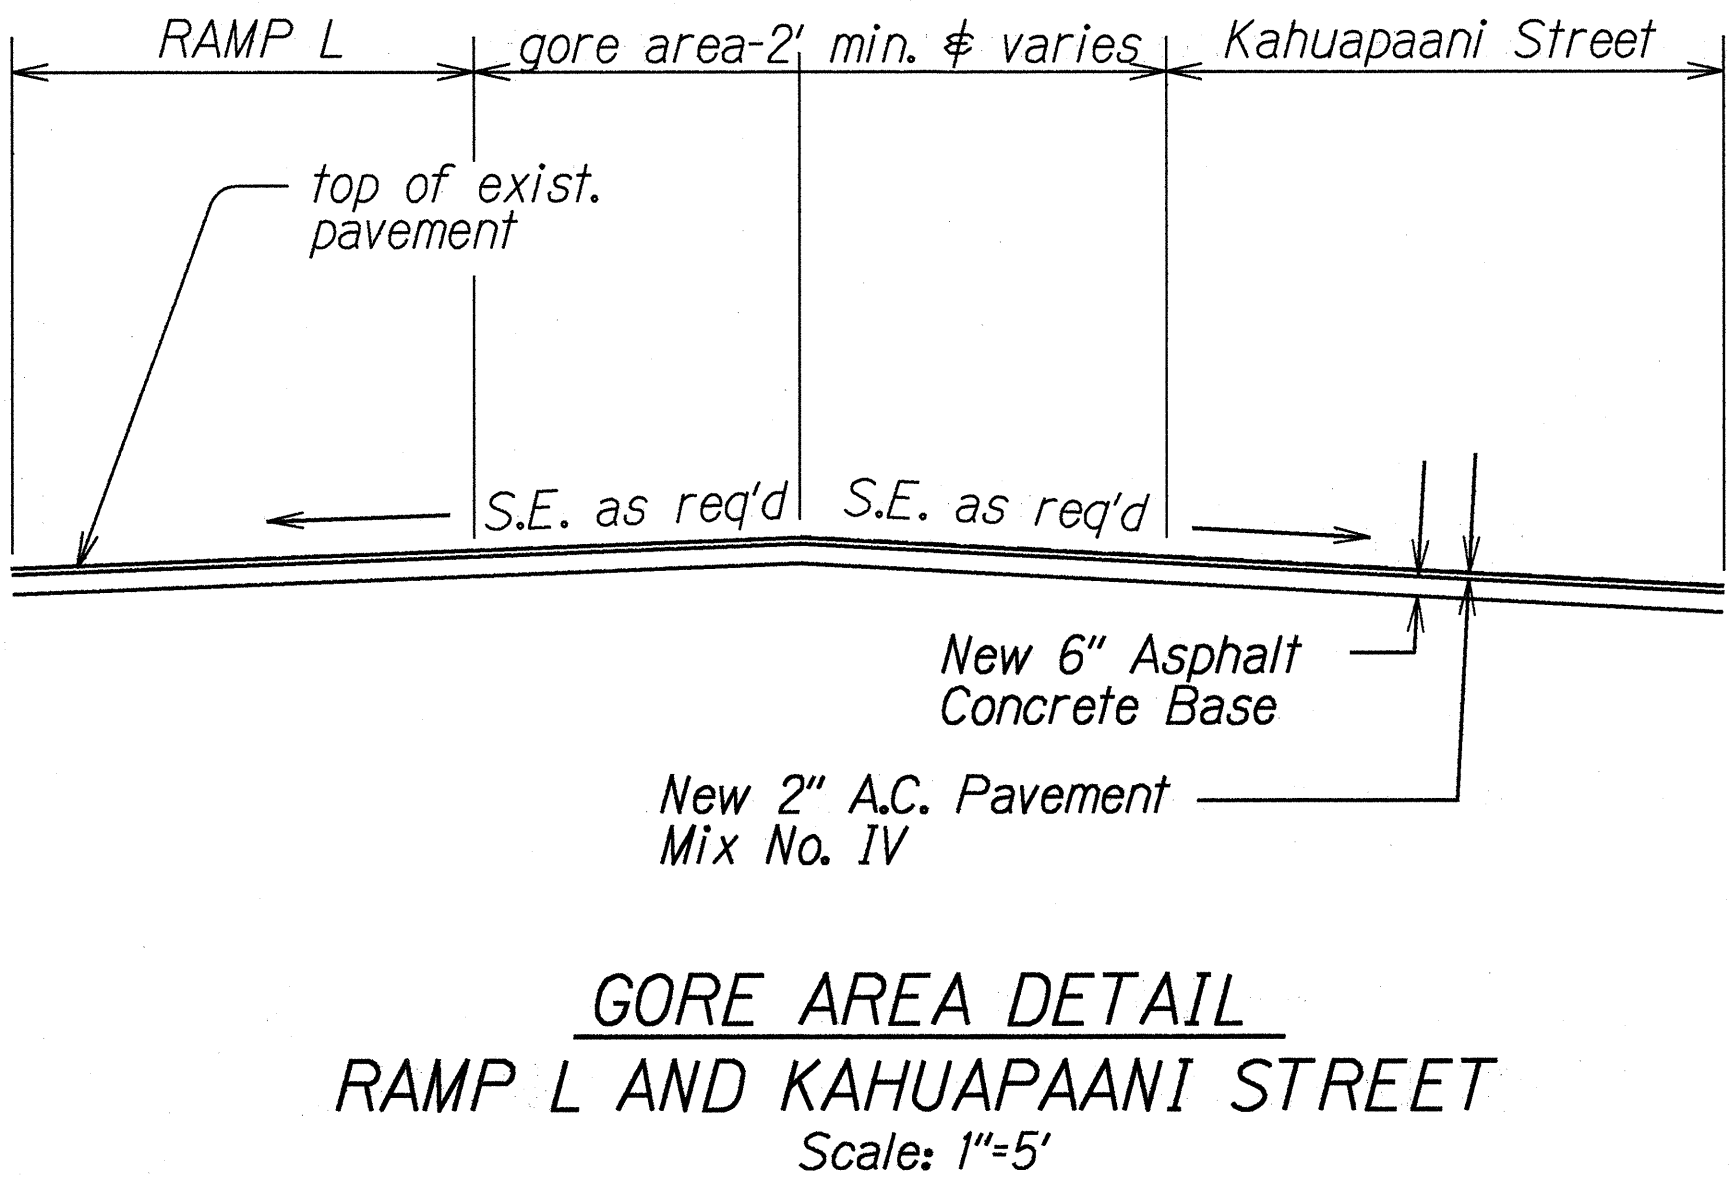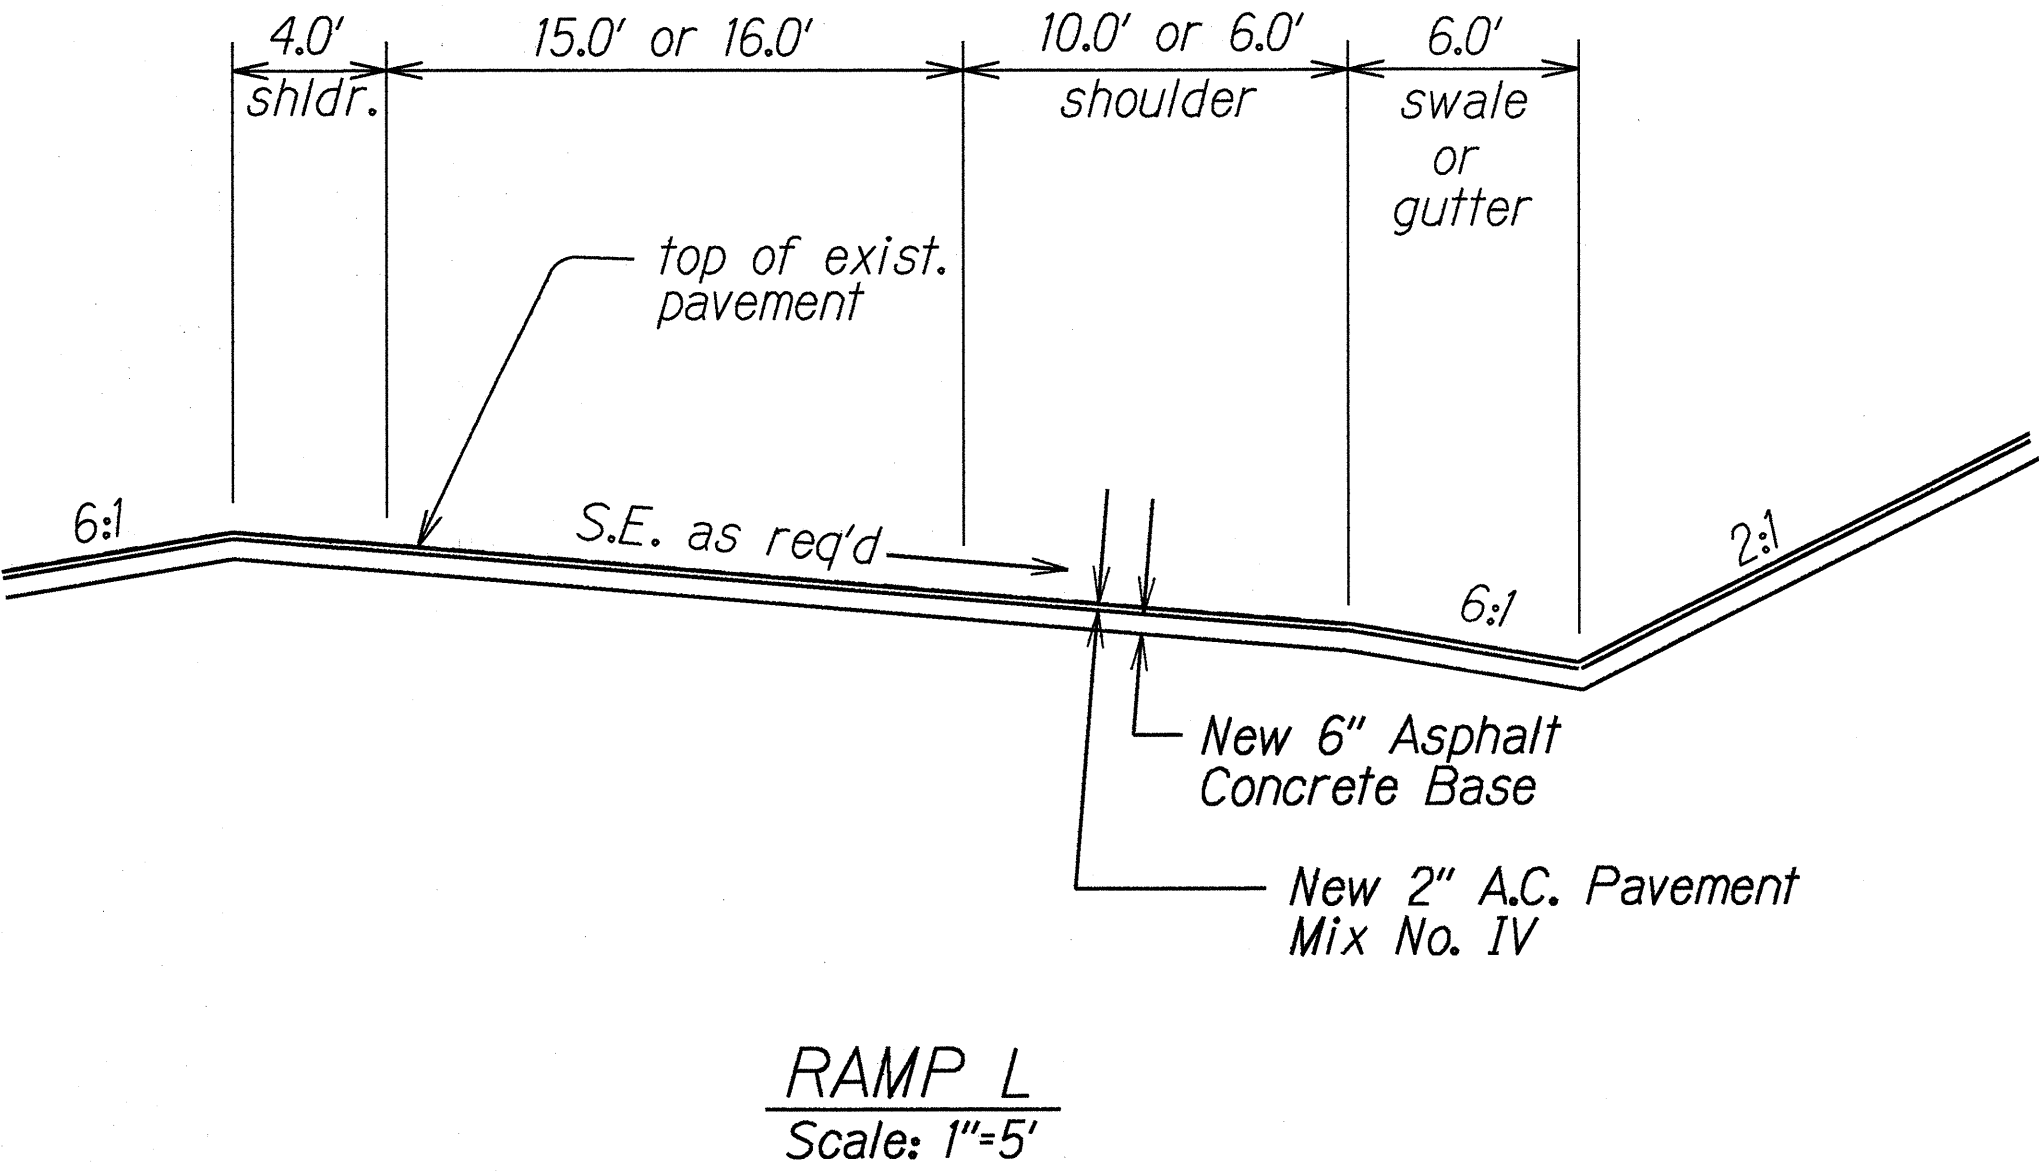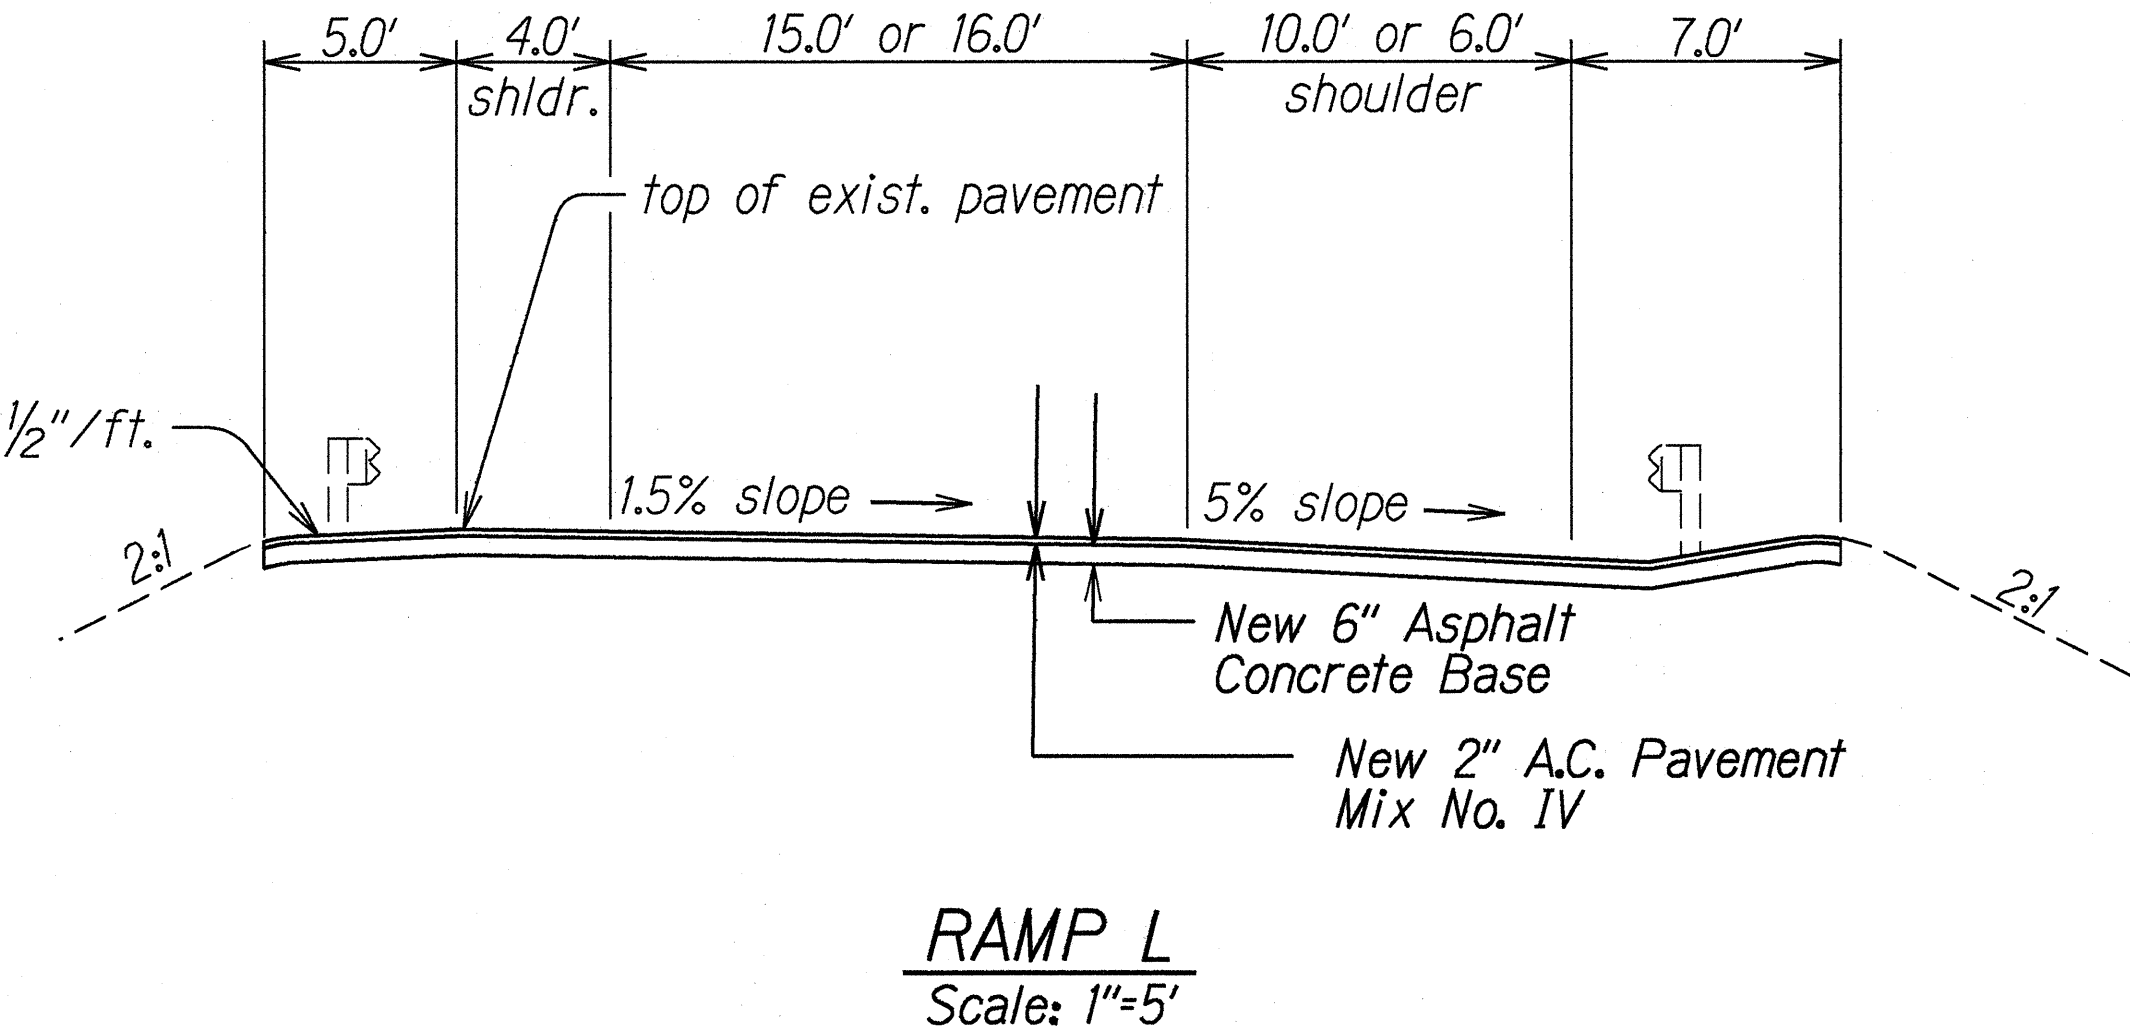


GENERAL PLAN	DATE	5/22/95
DESIGNED BY	TRACED BY	
NOTED BY	QUANTITIES BY	
CHECKED BY		

STATE OF HAWAII
DEPARTMENT OF TRANSPORTATION
HIGHWAYS DIVISION


TYPICAL SECTIONS
KAHUAPAANI ST. RESURFACING
Ulune St. to Salt Lake Blvd.
Fed. Aid Project No. STP-724(1)
Scale: 1"=5'-0" Date: May 1995

SHEET No. 8 OF 9 SHEETS

FED. ROAD DIST. NO.	STATE	FED. AID PROJ. NO.	FISCAL YEAR	SHEET NO.	TOTAL SHEETS
HAWAII	HAW.	STP-724(1)	1995	13	42

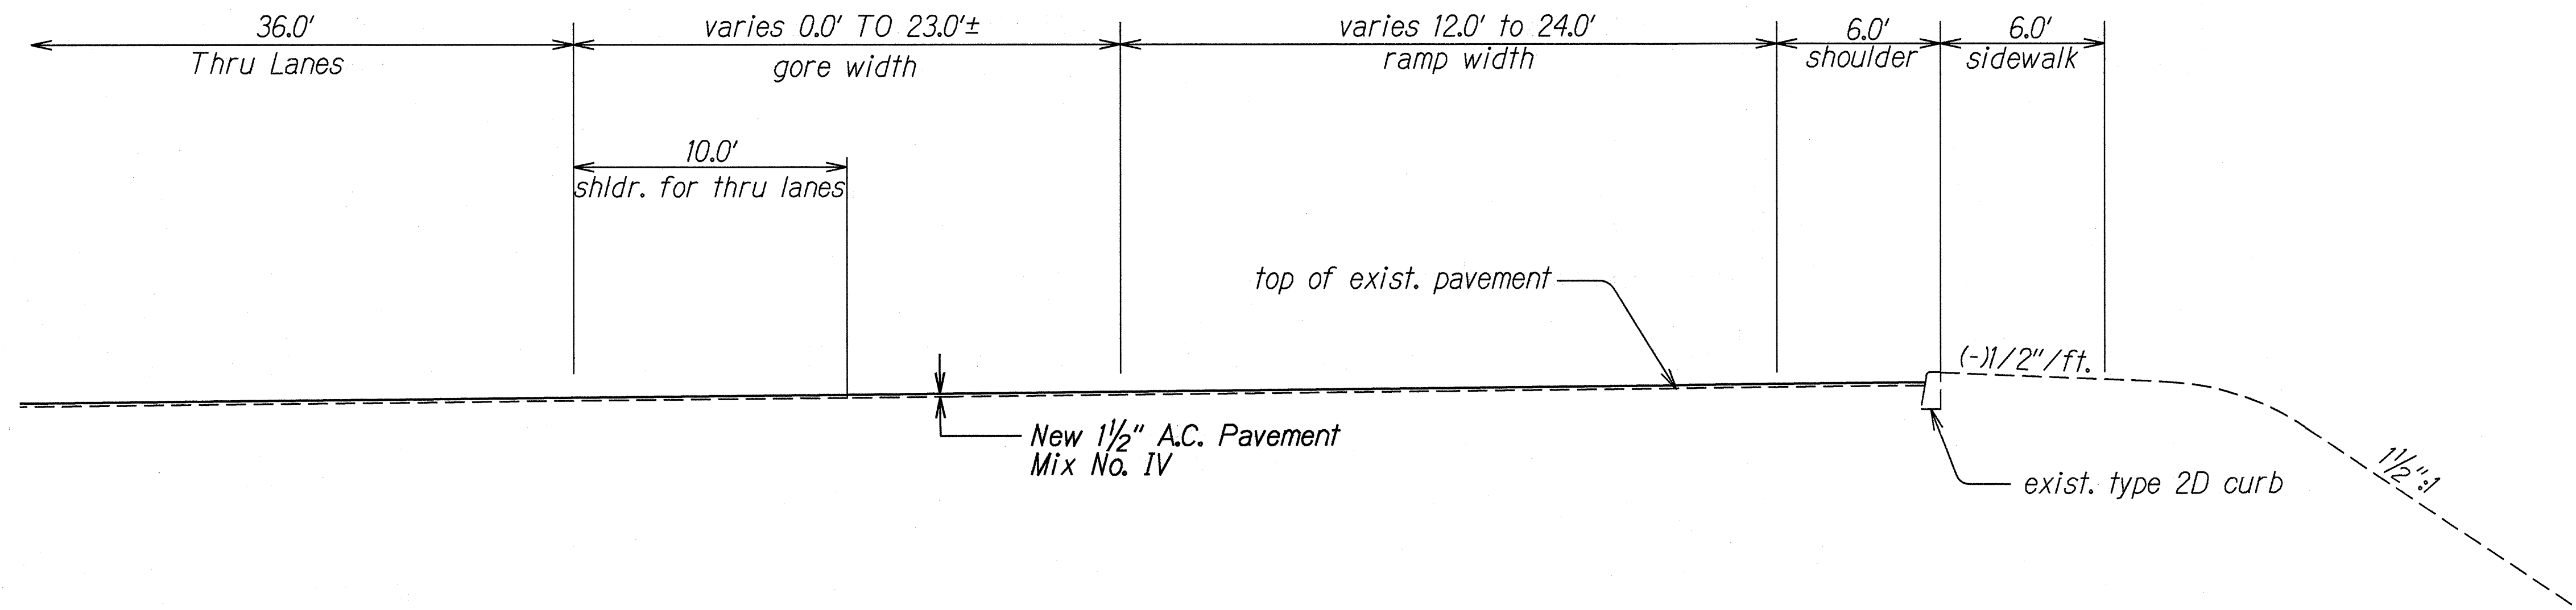

RAMP "HS" TYPICAL SECTION
RAMP "HS" § STA. 2+99.01 TO § STA. 7+00±
Scale: 1/4"=1'-0"

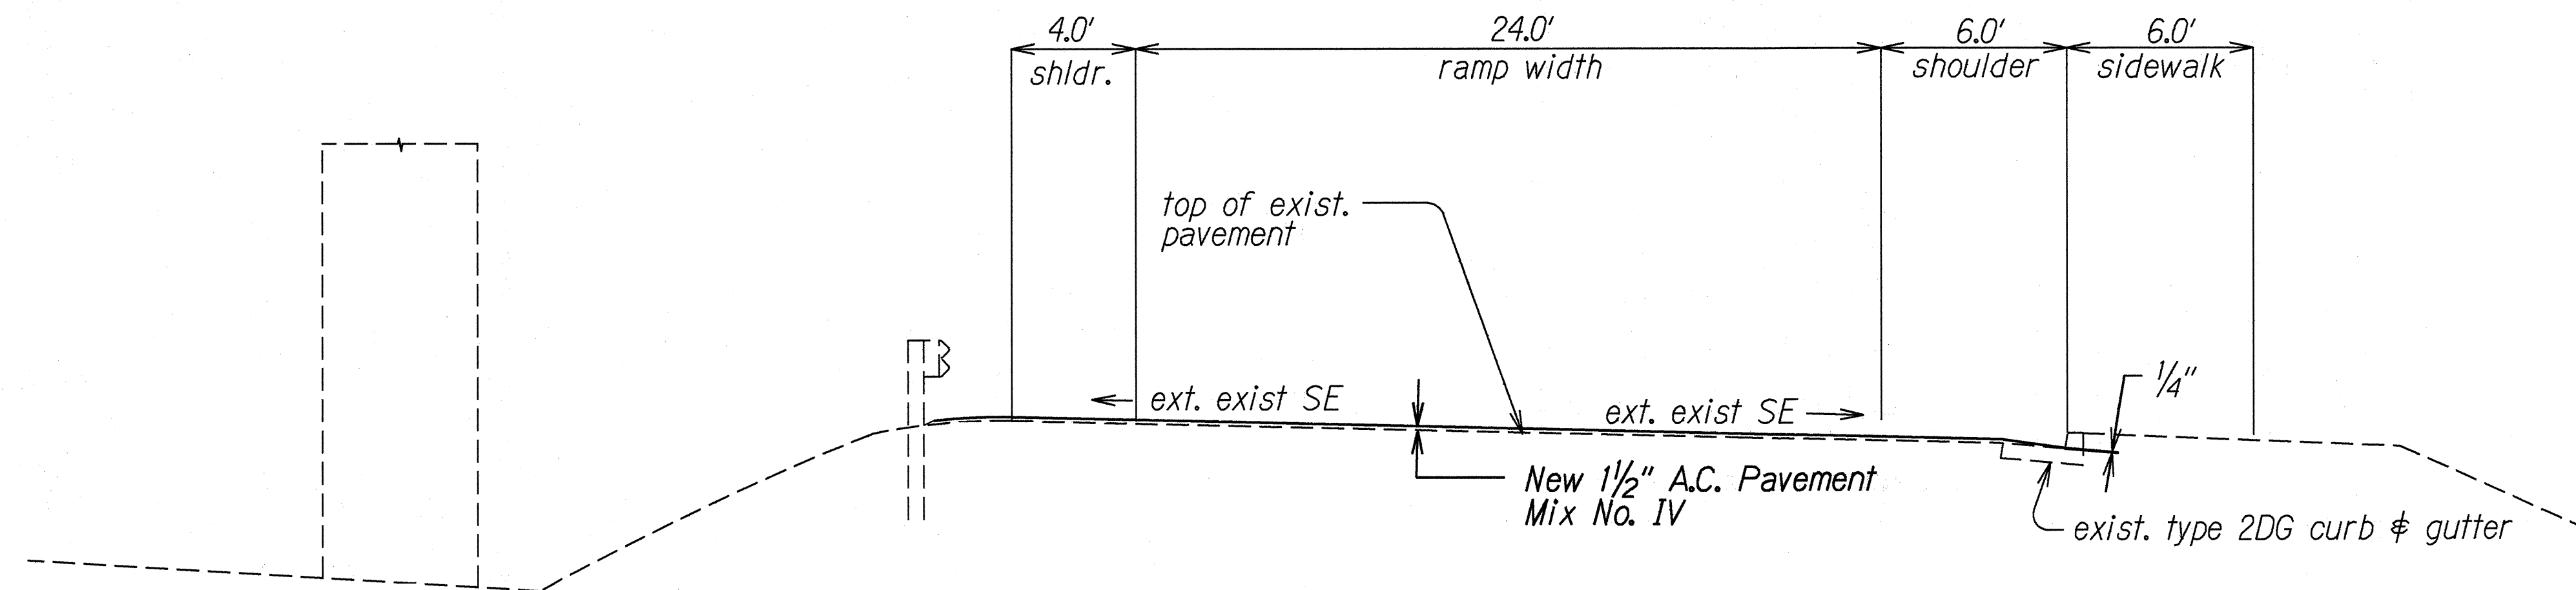

RAMP "HS" TYPICAL SECTION
RAMP "HS" § STA. 7+00± TO § STA. 11+87±
Scale: 1/4"=1'-0"

ORIGINAL PLAN	SURVEY PLOTTED BY	DATE
NOTE BOOK	DRAWN BY G. KAWAHARA	5/22/95
ddm	CHECKED BY K. NG	
5/24/95	QUANTITIES BY	
	CHECKED BY	

STATE OF HAWAII
DEPARTMENT OF TRANSPORTATION
HIGHWAYS DIVISION

TYPICAL SECTION

KAHUAPAANI ST. RESURFACING
Ulune St. to Salt Lake Blvd.
Fed. Aid Project No. STP-724(1)

Scale: as shown Date: May 1995

SHEET No. 9 OF 9 SHEETS