
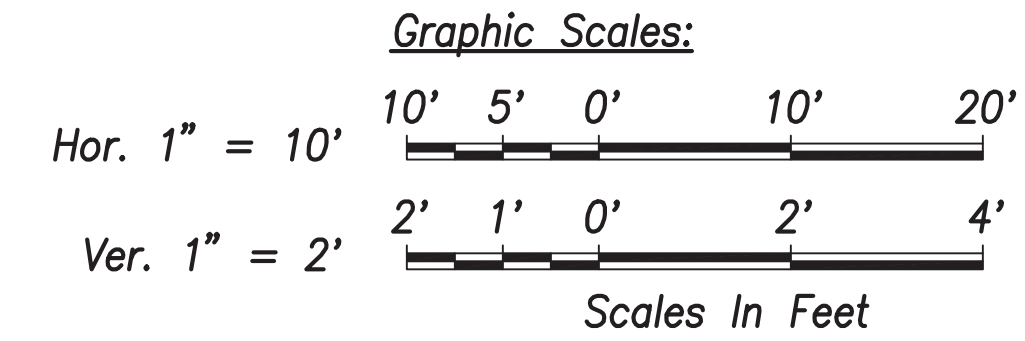
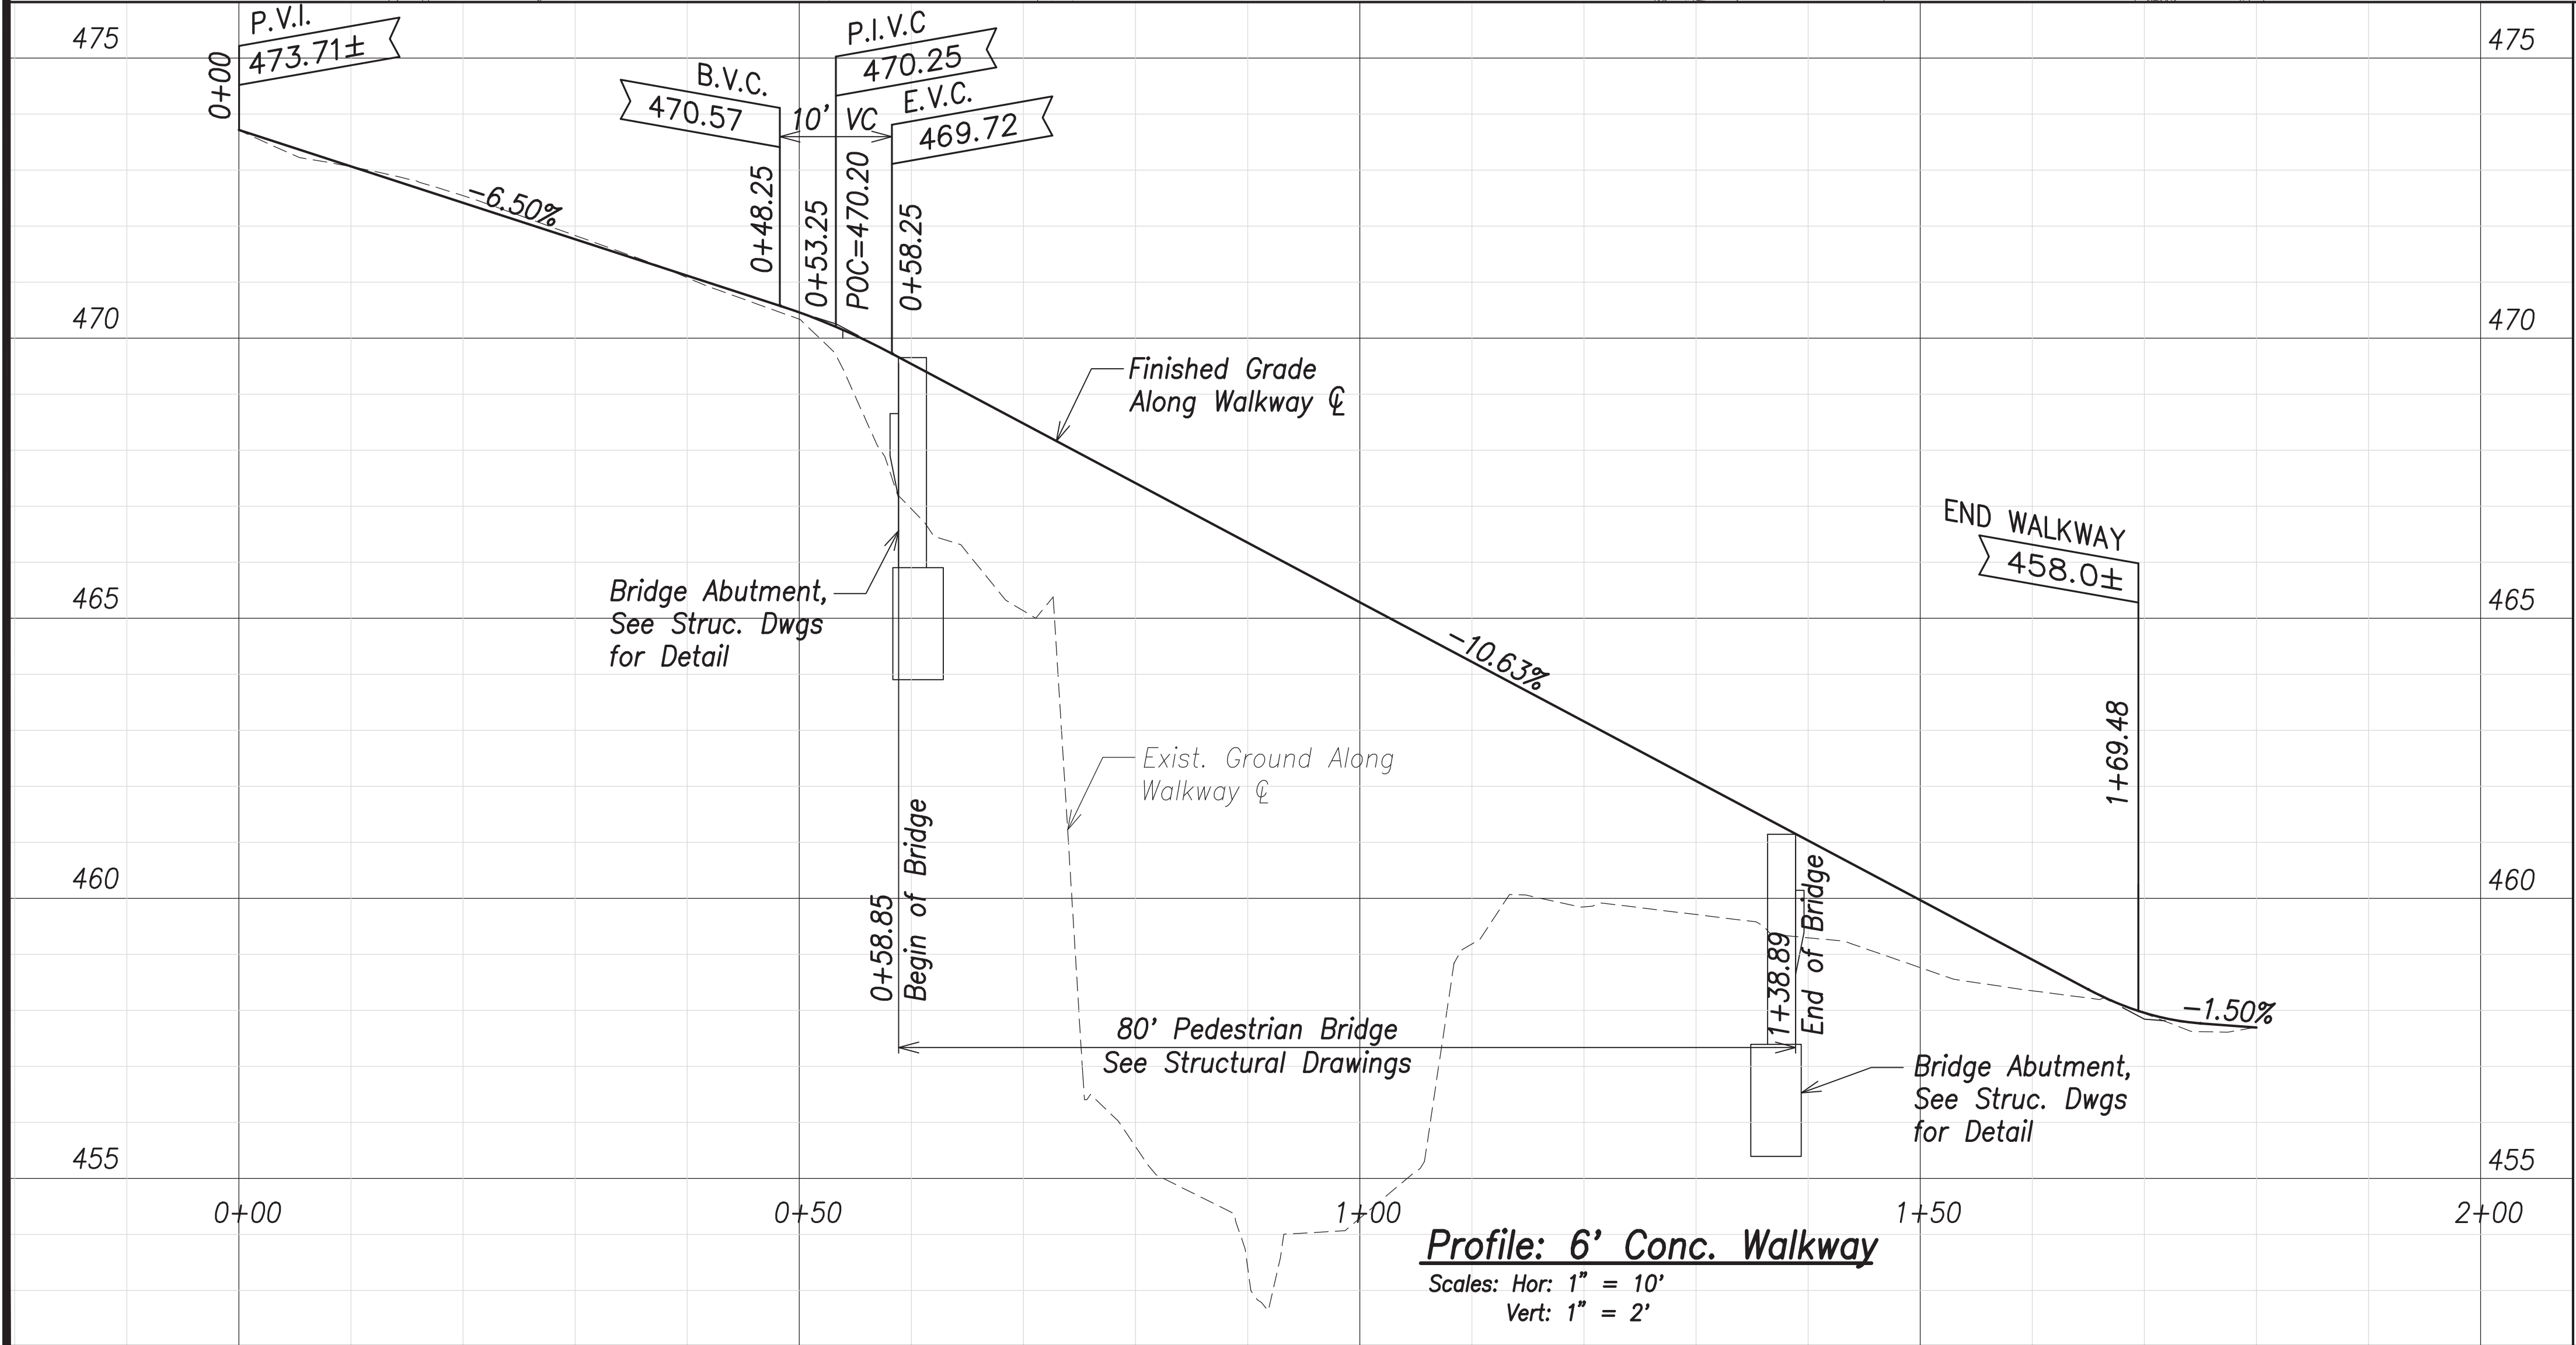


FED. ROAD DIST. NO.	STATE	PROJ. NO.	FISCAL YEAR	SHEET NO.	TOTAL SHEETS
HAWAII	HAW.	7241A-01-13	2016	C.O. 12	36

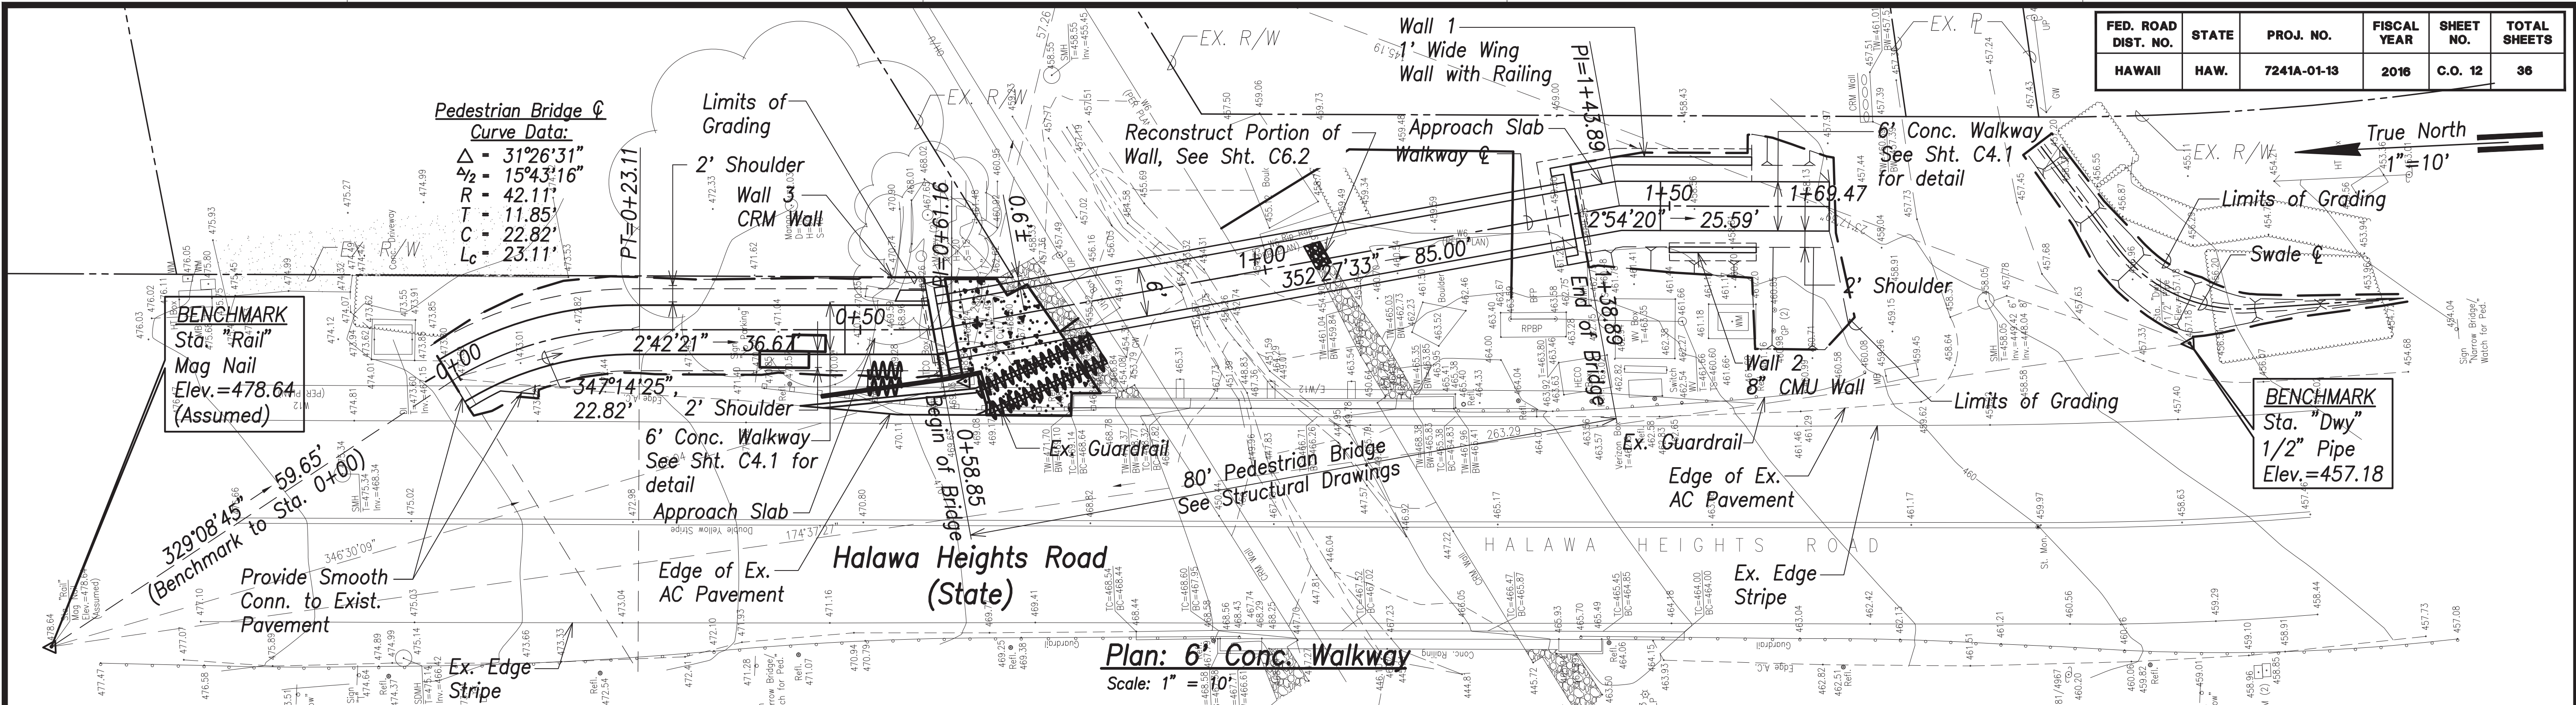

LEGEND FOR AS-BUILT POSTINGS

Squiggly line for as-built deletion

Double line for as-built deletion

Text for as-built posting

7/2/18	C.O.: Revised end of walkway
DATE	REVISION
STATE OF HAWAII DEPARTMENT OF TRANSPORTATION HIGHWAYS DIVISION	
6' CONC. WALKWAY PLAN & PROFILE	
HALAWA HEIGHTS ROAD PEDESTRIAN BRIDGE Proj. No. 7241A-01-13	
Scale: As Shown	Date: April 24, 2017
SHEET No. C5.1 OF 18 SHEETS	

ORIGINAL PLAN	SURVEY PLOTTED BY	DATE
NOTE BOOK	DRAWN BY	
	DESIGNED BY	
	CHECKED BY	