



FED. ROAD DIST. NO.	STATE	PROJ. NO.	FISCAL YEAR	SHEET NO.	TOTAL SHEETS
HAWAII	HAW.	7241A-01-13	2016	C.O. 9	36

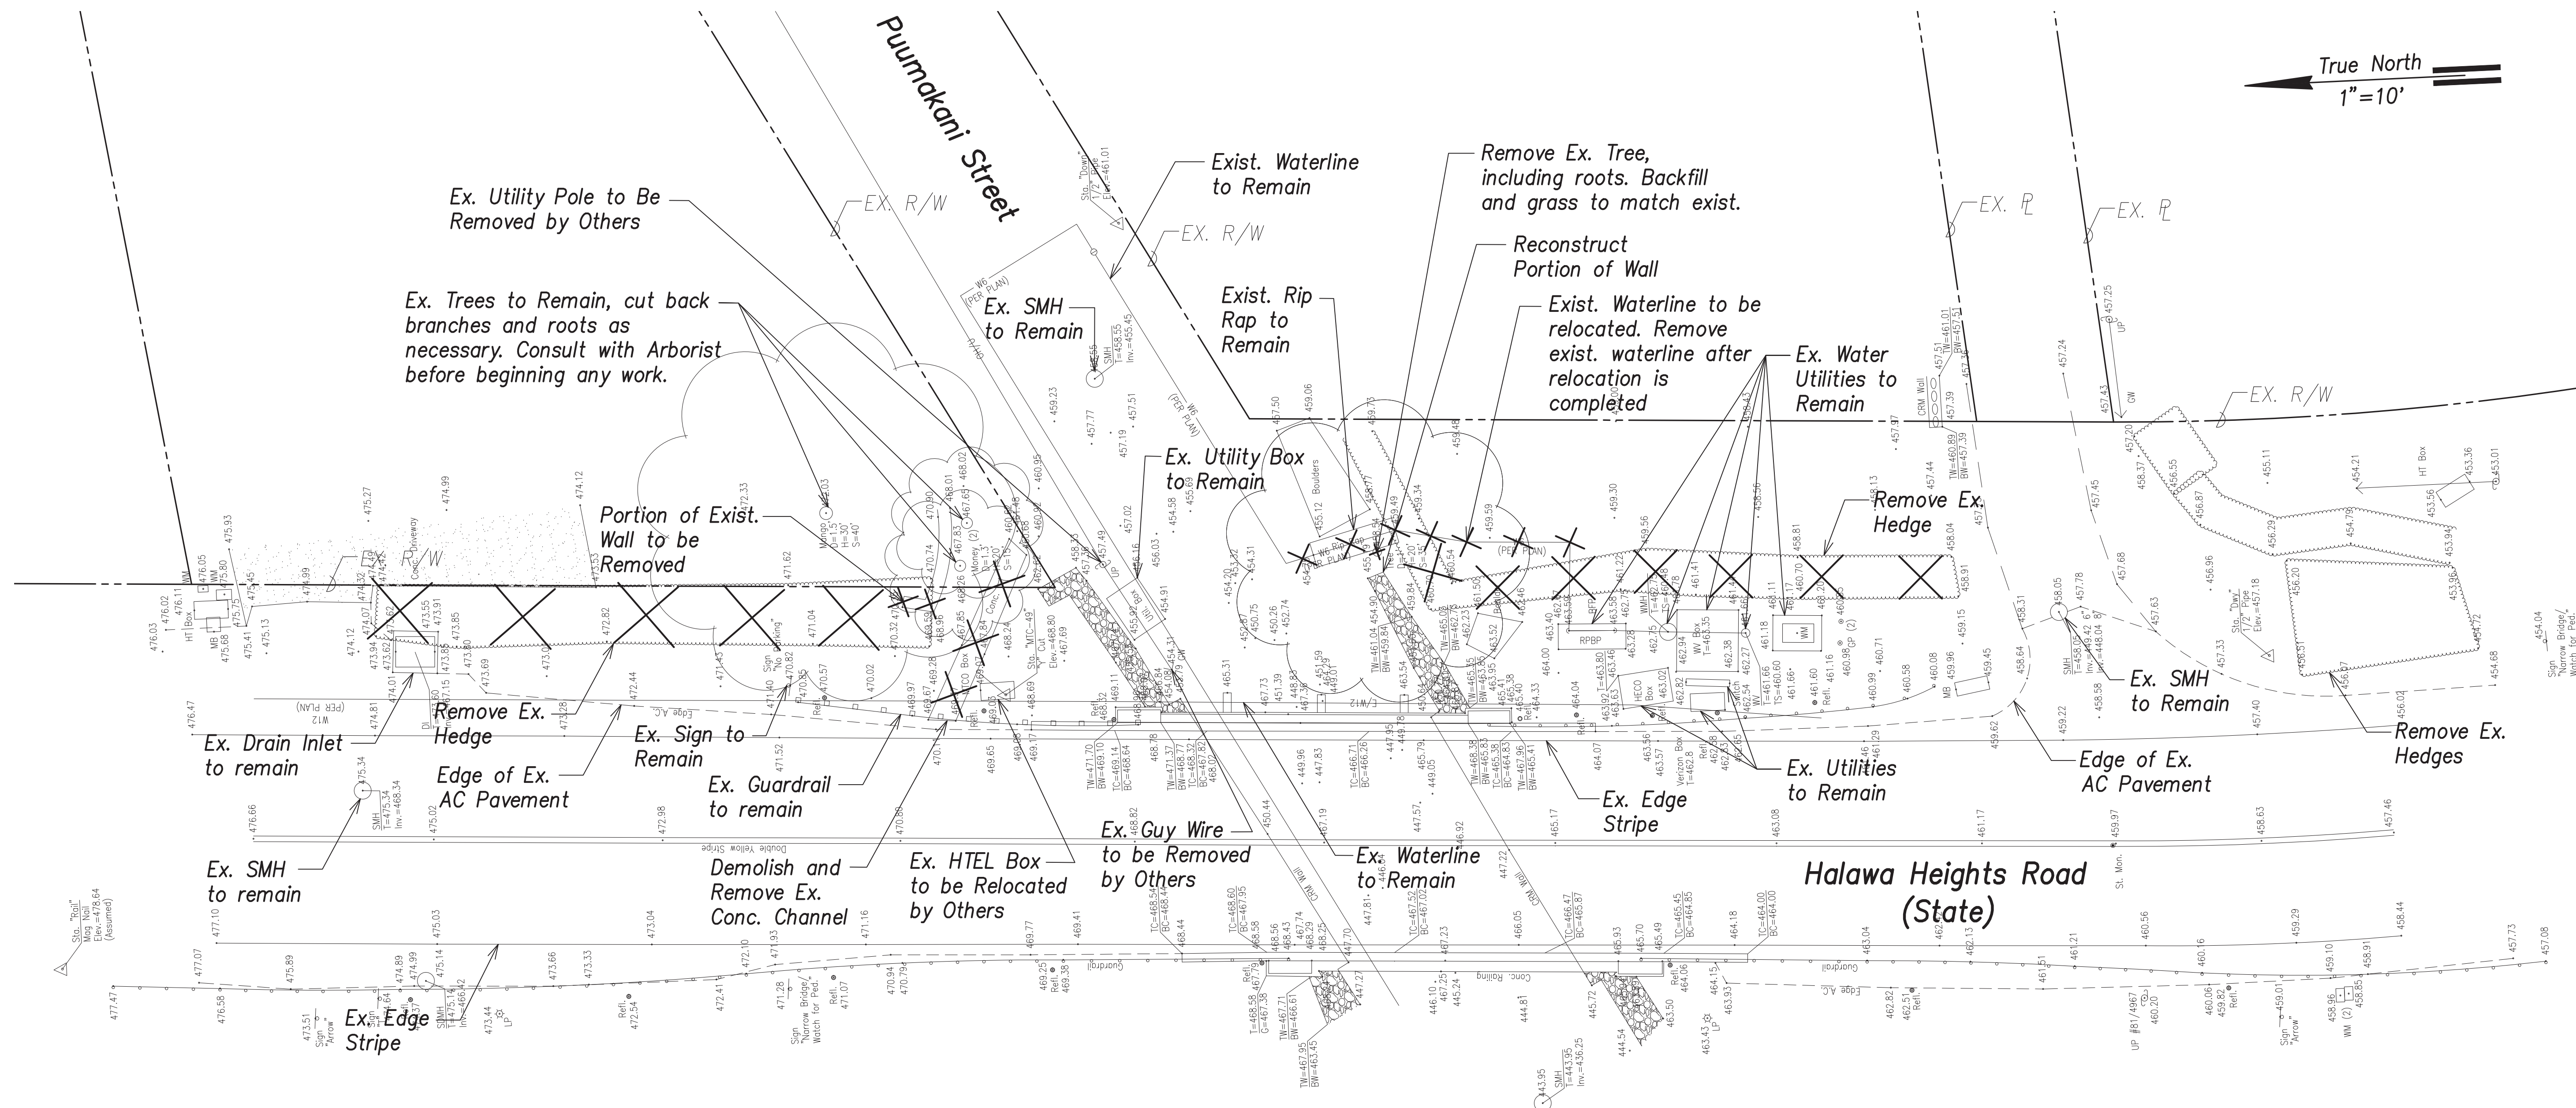

ORIGINAL PLAN	SURVEY PLOTTED BY	DATE
TRACED BY		
DESIGNED BY		
QUANTITY BY		
CHECKED BY		
NO.		

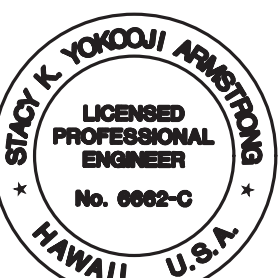

THIS WORK WAS PREPARED BY ME OR UNDER MY SUPERVISION.
DATE OF LICENSE EXPIRY: APR 30, 2019
SIGNATURE: [Signature]

5/30/18	C.O.: Remove exist. 6" waterline
DATE	REVISION
STATE OF HAWAII DEPARTMENT OF TRANSPORTATION HIGHWAYS DIVISION	
DEMOLITION PLAN	
HALAWA HEIGHTS ROAD PEDESTRIAN BRIDGE Proj. No. 7241A-01-13	
Scale: As Shown	Date: April 24, 2017
SHEET No. C2.1 OF 18 SHEETS	