


FED. ROAD DIST. NO.	STATE	PROJ. NO.	FISCAL YEAR	SHEET NO.	TOTAL SHEETS
HAWAII	HAW.	7241A-01-13	2016	16	36


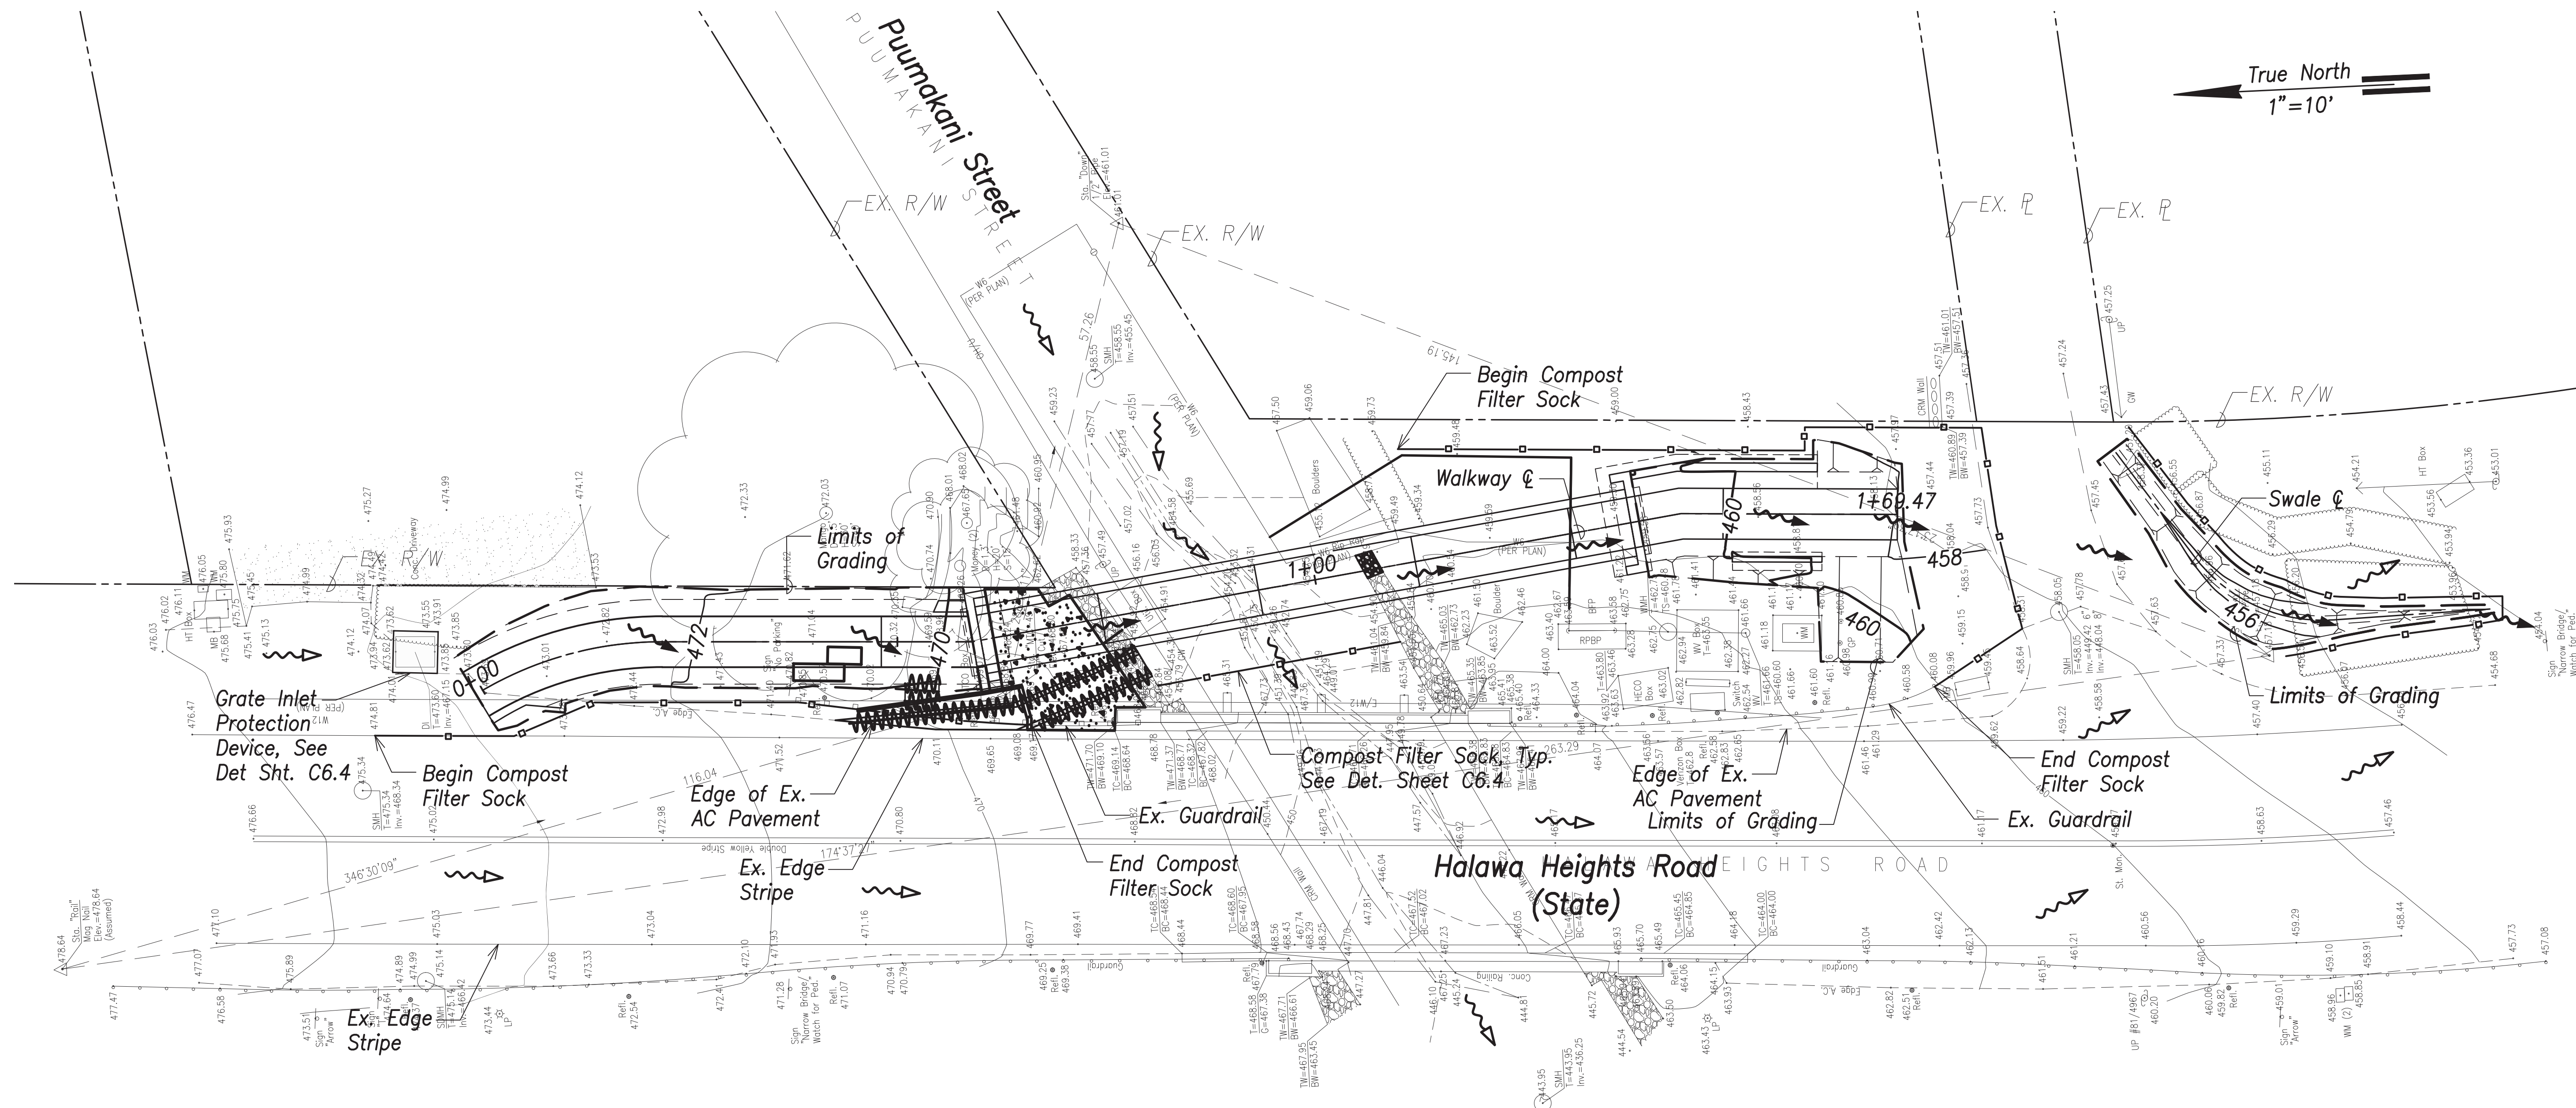


ORIGINAL PLAN	SURVEY PLOTTED BY	DATE
NOTE BOOK	DRAWN BY	
	DESIGNED BY	
	CHECKED BY	

LEGEND:	
— 400 —	Exist. Contours
— 450 —	New Major Contour
— 462 —	New Minor Contour
— — —	Limits of Grading
— — —	Property Line/Right of Way
— — —	Compost Filter Sock
→	Existing Direction of Flow
→	Direction of Flow
• 471.16	Existing Spot Elev.
□	Grate Inlet Protection Device

LEGEND FOR AS-BUILT POSTINGS	
~~~~~	Squiggly line for as-built deletion
==	Double line for as-built deletion
Text	Text for as-built posting

Erosion Control Plan  
Scale: 1" = 10'

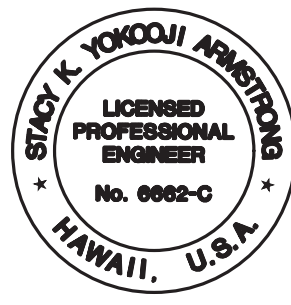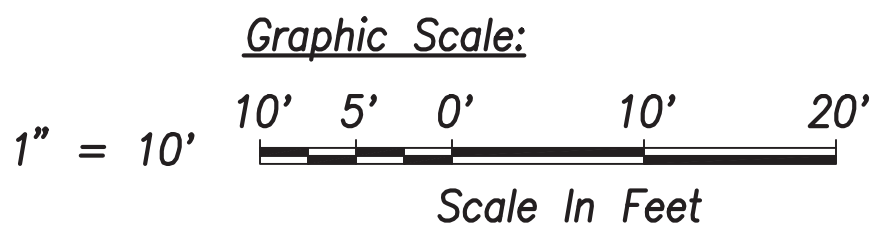

THIS WORK WAS PREPARED BY ME OR UNDER MY SUPERVISION.  
DATE OF LICENSE EXPIRY: APR 30, 2018  
SIGNATURE: [Signature]

STATE OF HAWAII  
DEPARTMENT OF TRANSPORTATION  
HIGHWAYS DIVISION

**EROSION CONTROL PLAN**

HALAWA HEIGHTS ROAD  
PEDESTRIAN BRIDGE  
Proj. No. 7241A-01-13

Scale: As Shown Date: April 24, 2017

SHEET No. C6.3 OF 18 SHEETS

"AS-BUILT"