


| FED. ROAD DIST. NO. | STATE | PROJ. NO.   | FISCAL YEAR | SHEET NO. | TOTAL SHEETS |
|---------------------|-------|-------------|-------------|-----------|--------------|
| HAWAII              | HAW.  | 7241A-01-13 | 2016        | C.O. 8    | 36           |

**LEGEND FOR AS-BUILT POSTINGS**


Squiggly line for as-built deletion

Double line for as-built deletion


Text for as-built posting

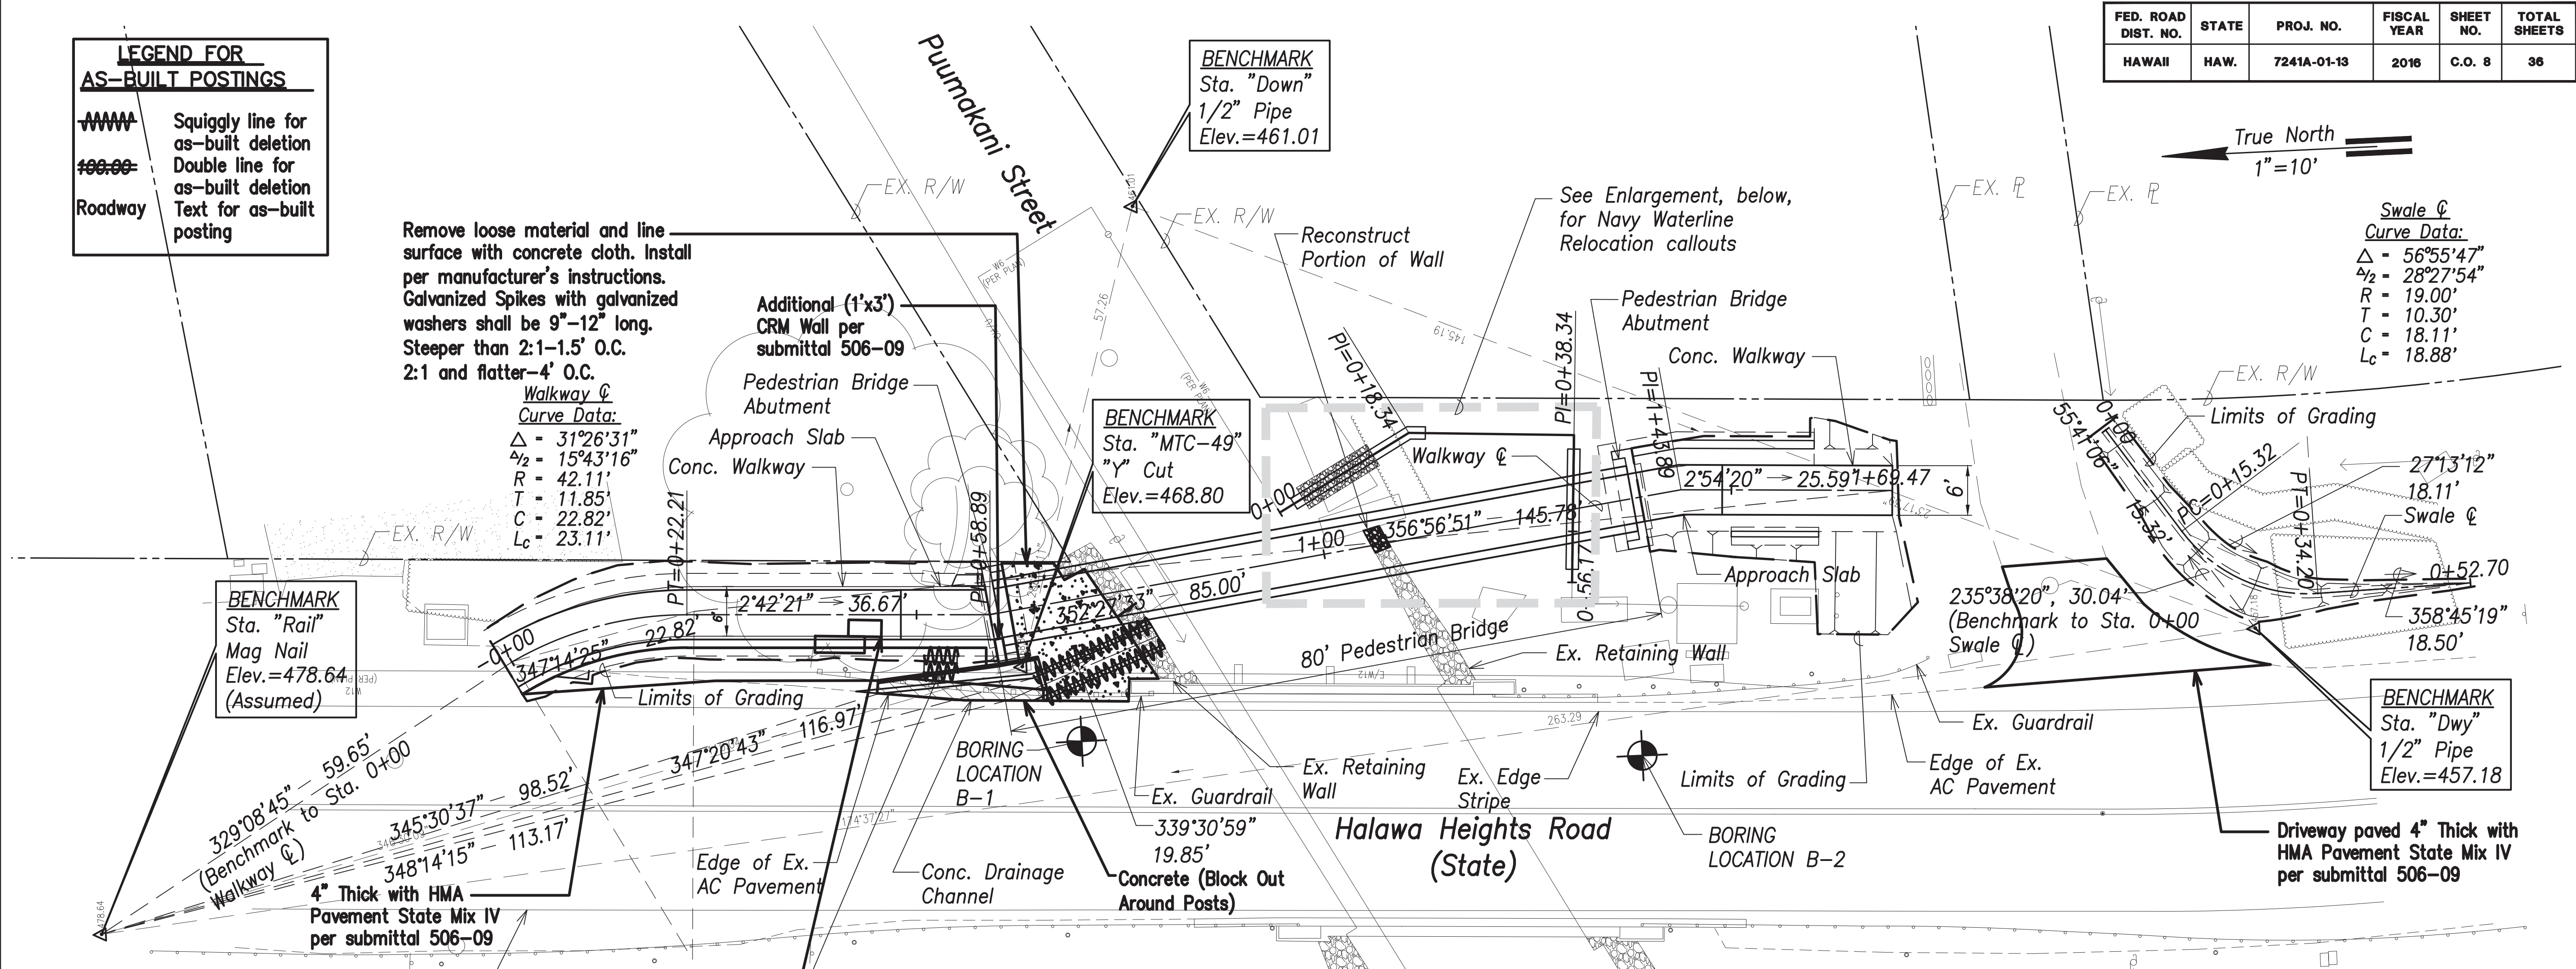

**General Plan**  
Scale: 1" = 10'

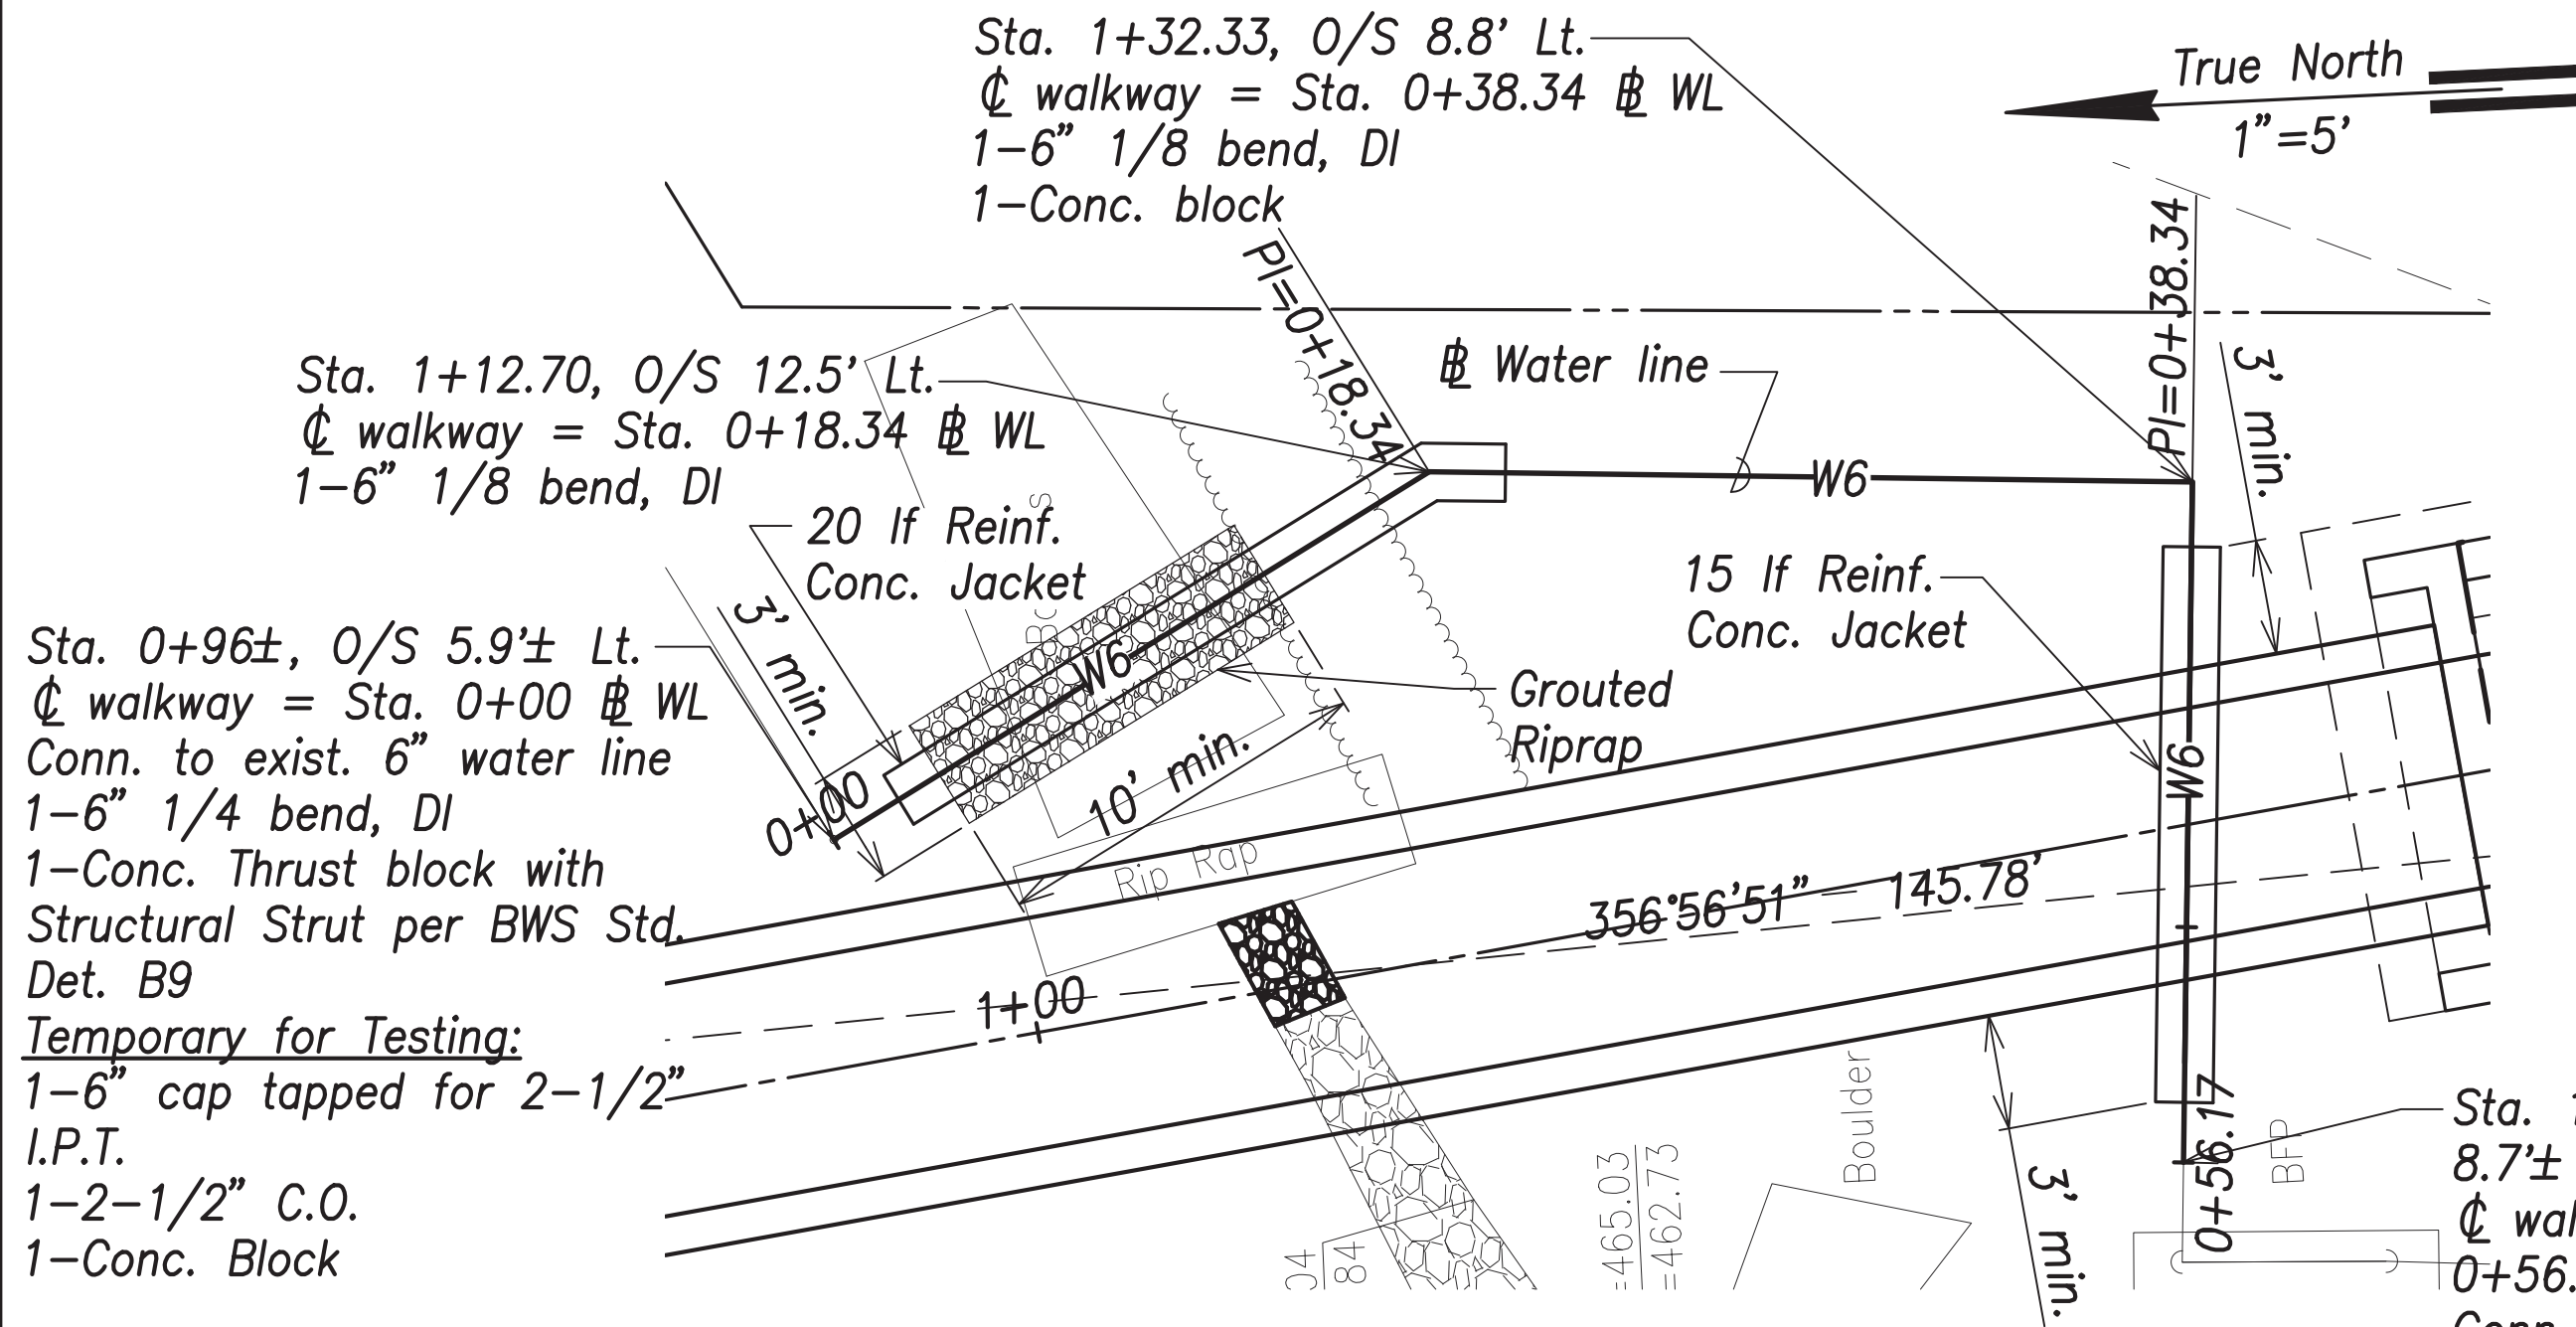

**Enlargement**  
Scale: 1" = 5'

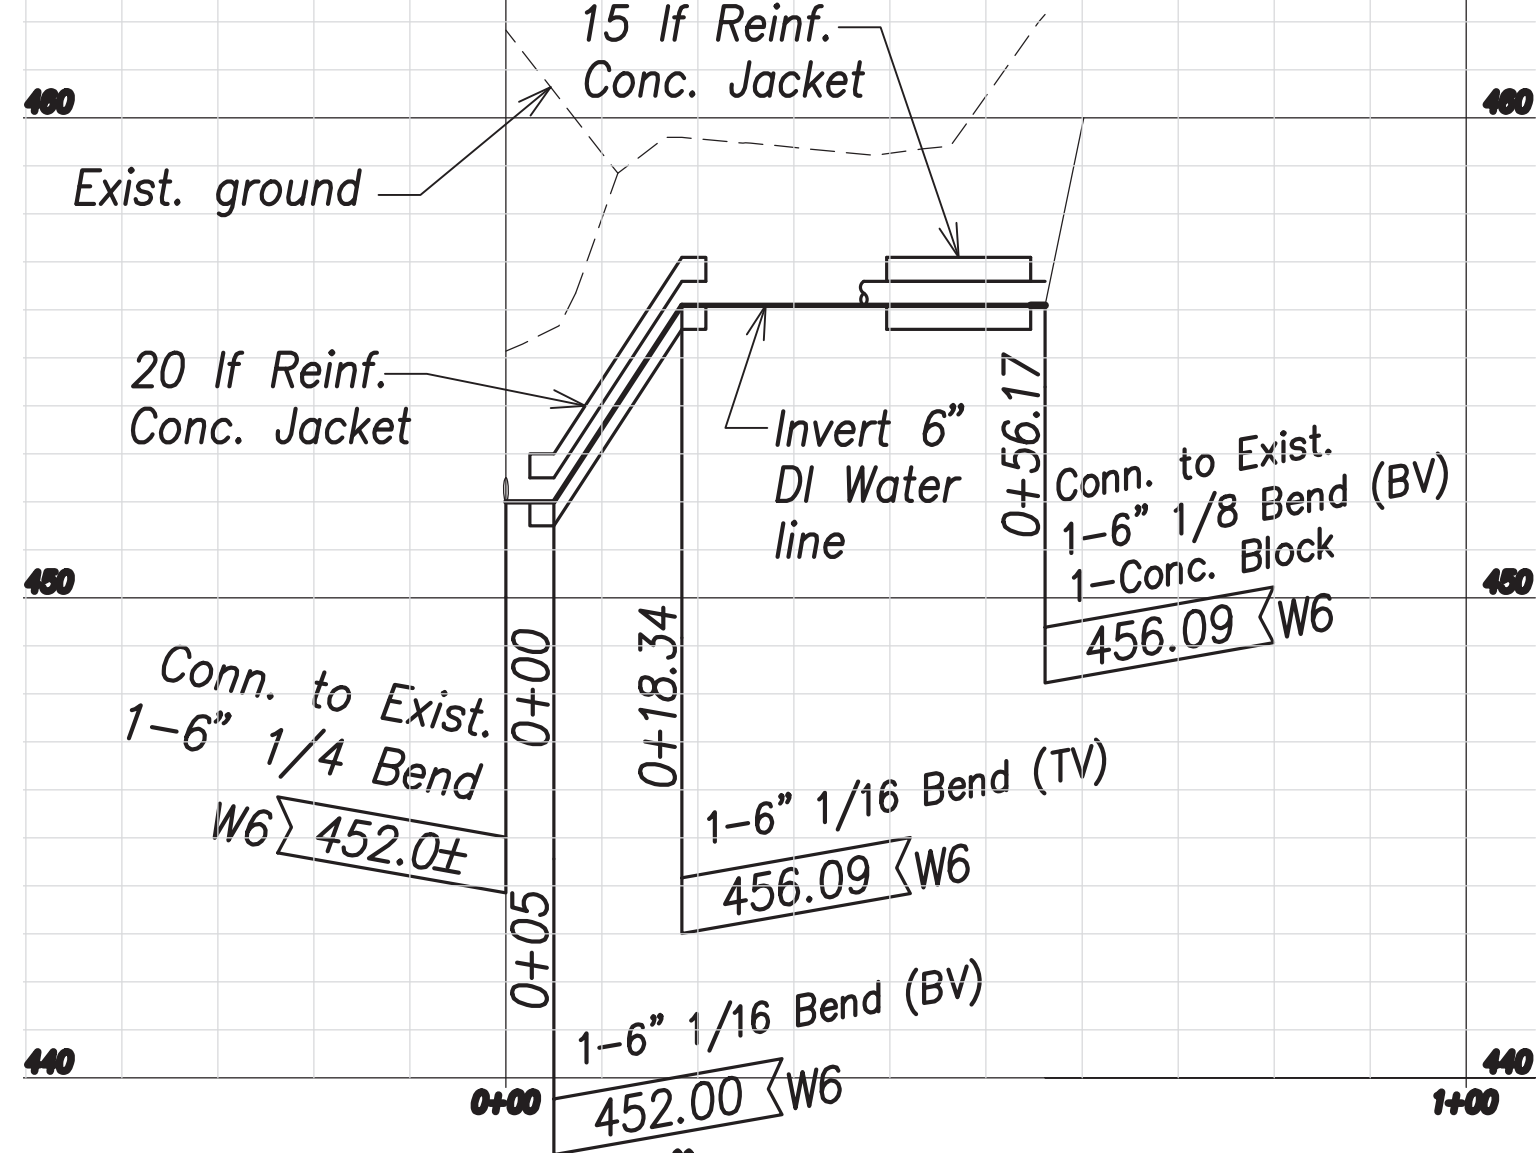

**Relocated 6" Navy Waterline**  
Scale: 1" = 20'

**Note:**  
Contractor to coordinate shutdown of exist. Navy water line with NAVFAC and shall limit outage to 2 days.

|         |                                    |
|---------|------------------------------------|
| 7/2/18  | C.O.: Revised end of walkway       |
| 5/30/18 | C.O.: Relocate exist. 6" waterline |
| DATE    | REVISION                           |

**STATE OF HAWAII  
DEPARTMENT OF TRANSPORTATION  
HIGHWAYS DIVISION**

**GENERAL PLAN**

**HALAWA HEIGHTS ROAD  
PEDESTRIAN BRIDGE**

**Proj. No. 7241A-01-13**

Scale: As Shown Date: April 24, 2017

**SHEET No. C1.1 OF 18 SHEETS**