

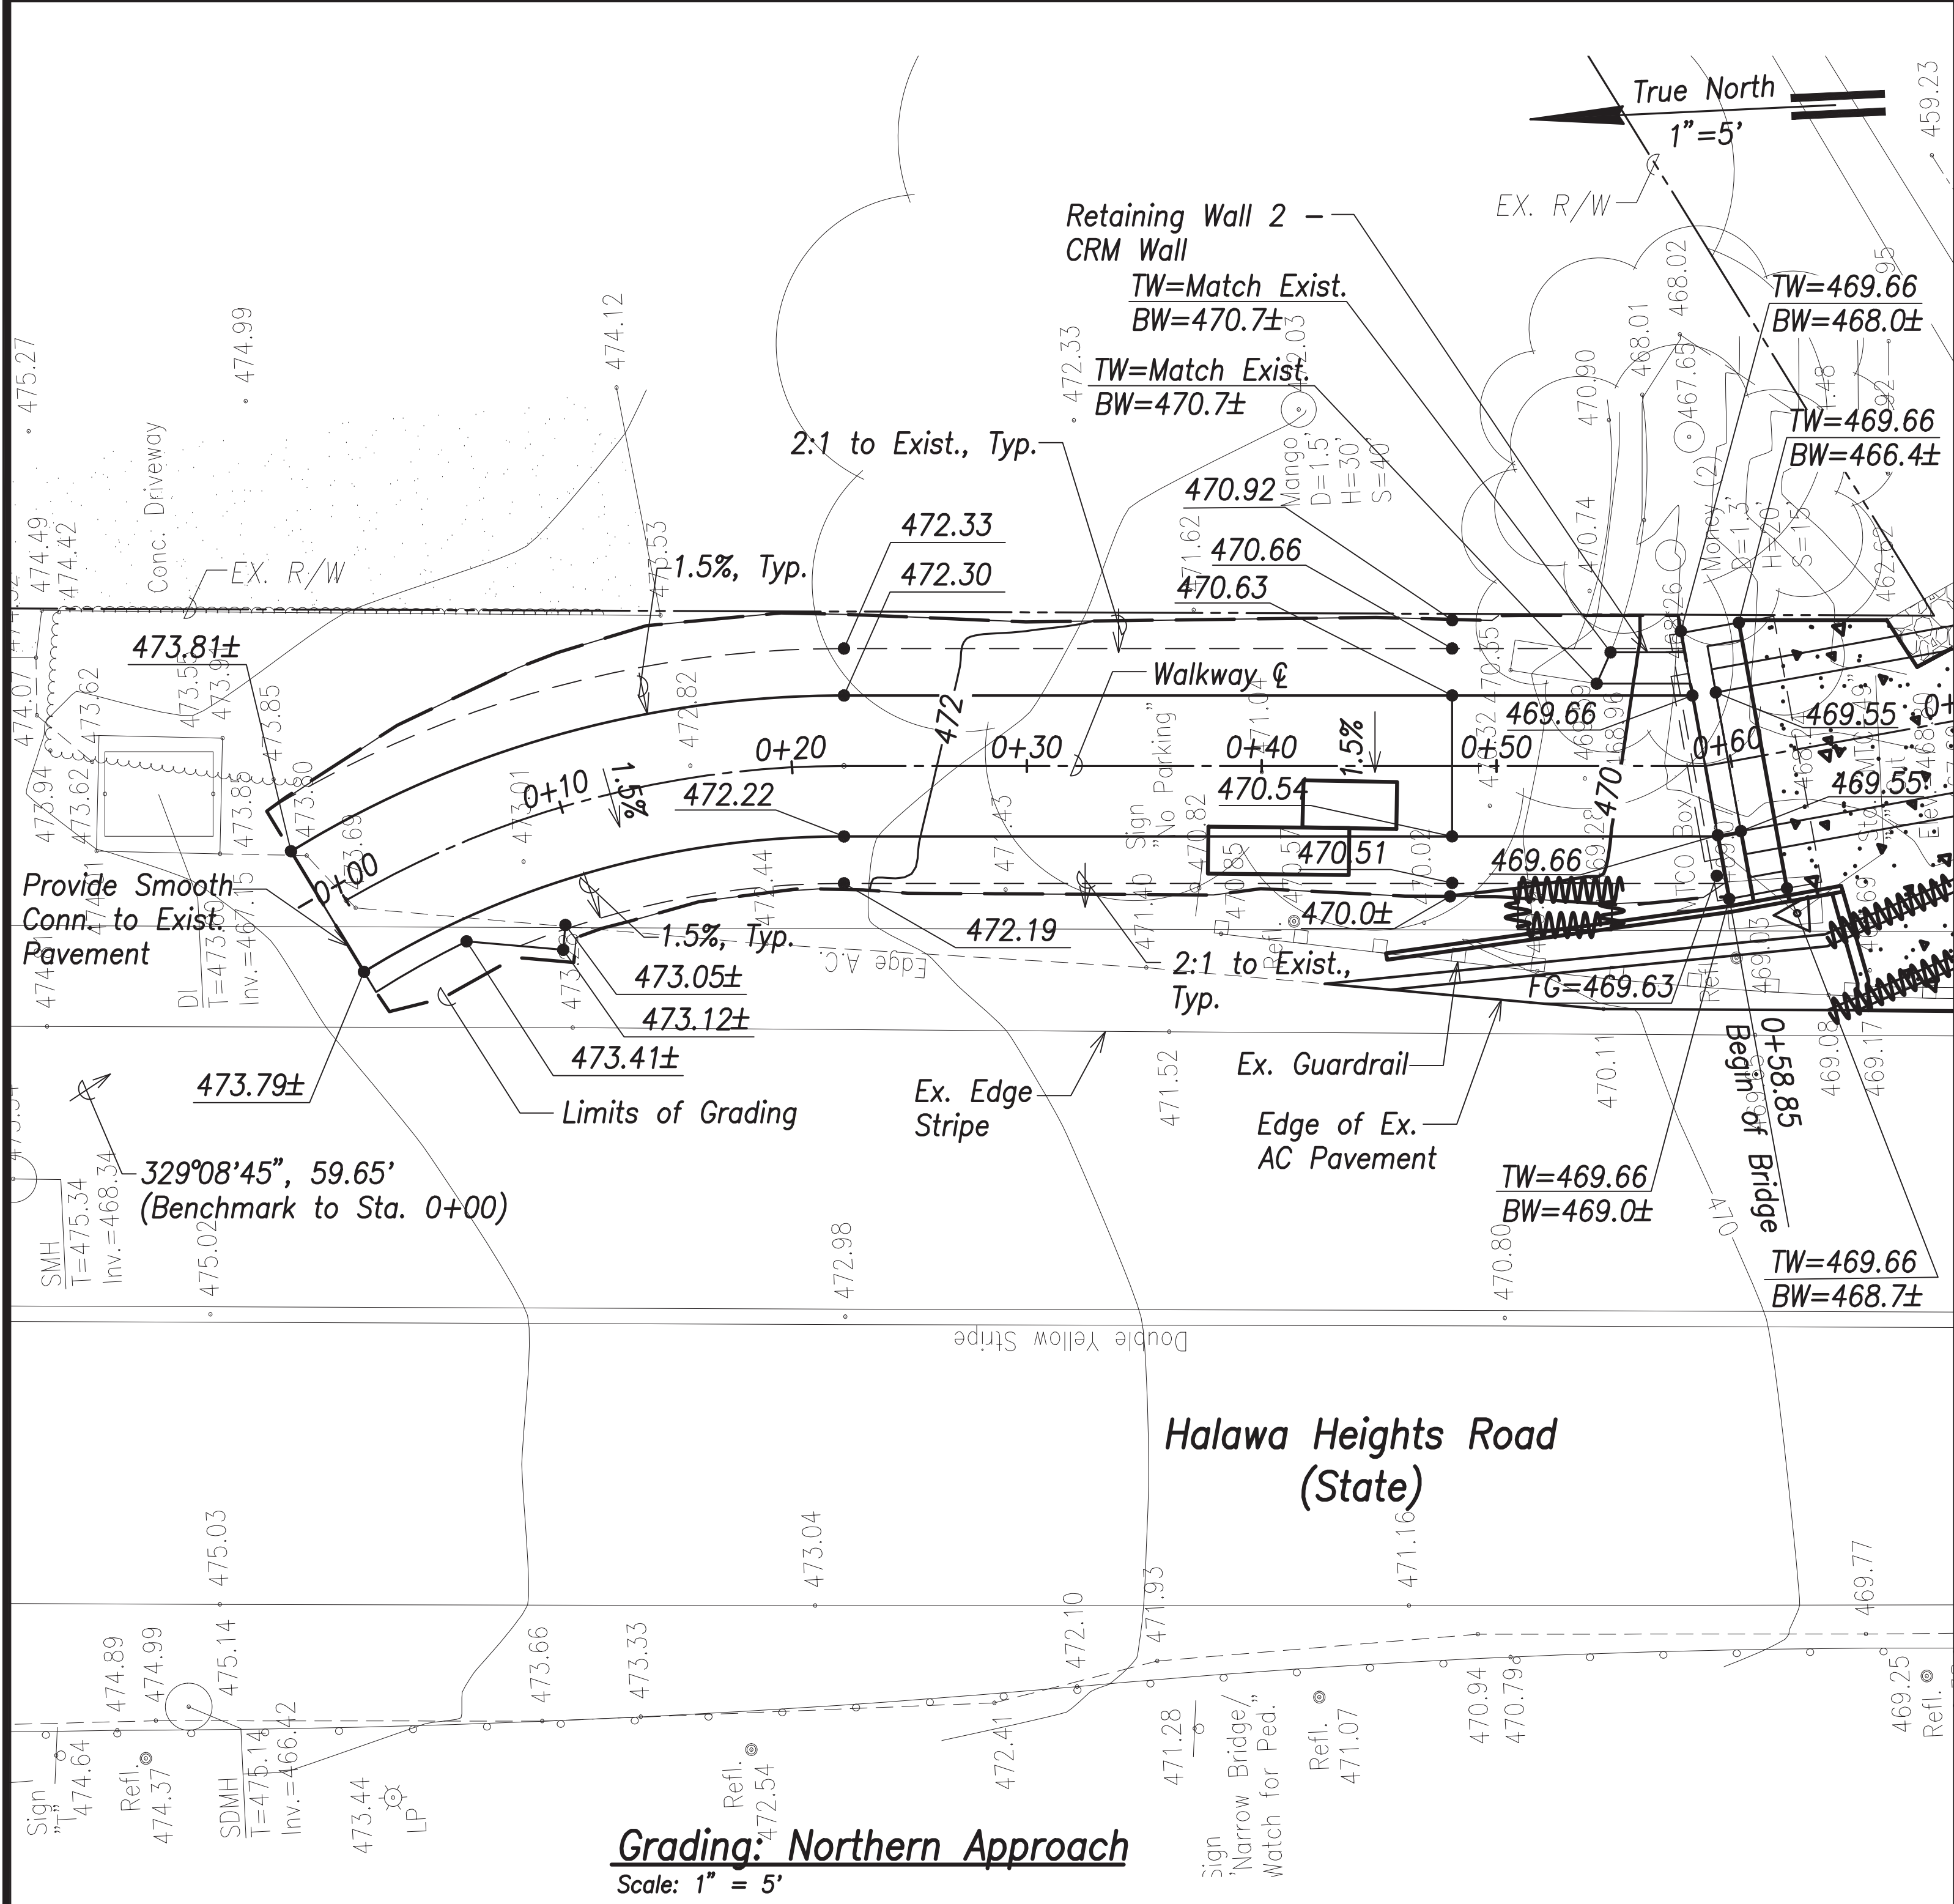


FED. ROAD DIST. NO.	STATE	PROJ. NO.	FISCAL YEAR	SHEET NO.	TOTAL SHEETS
HAWAII	HAW.	7241A-01-13	2016	14	36

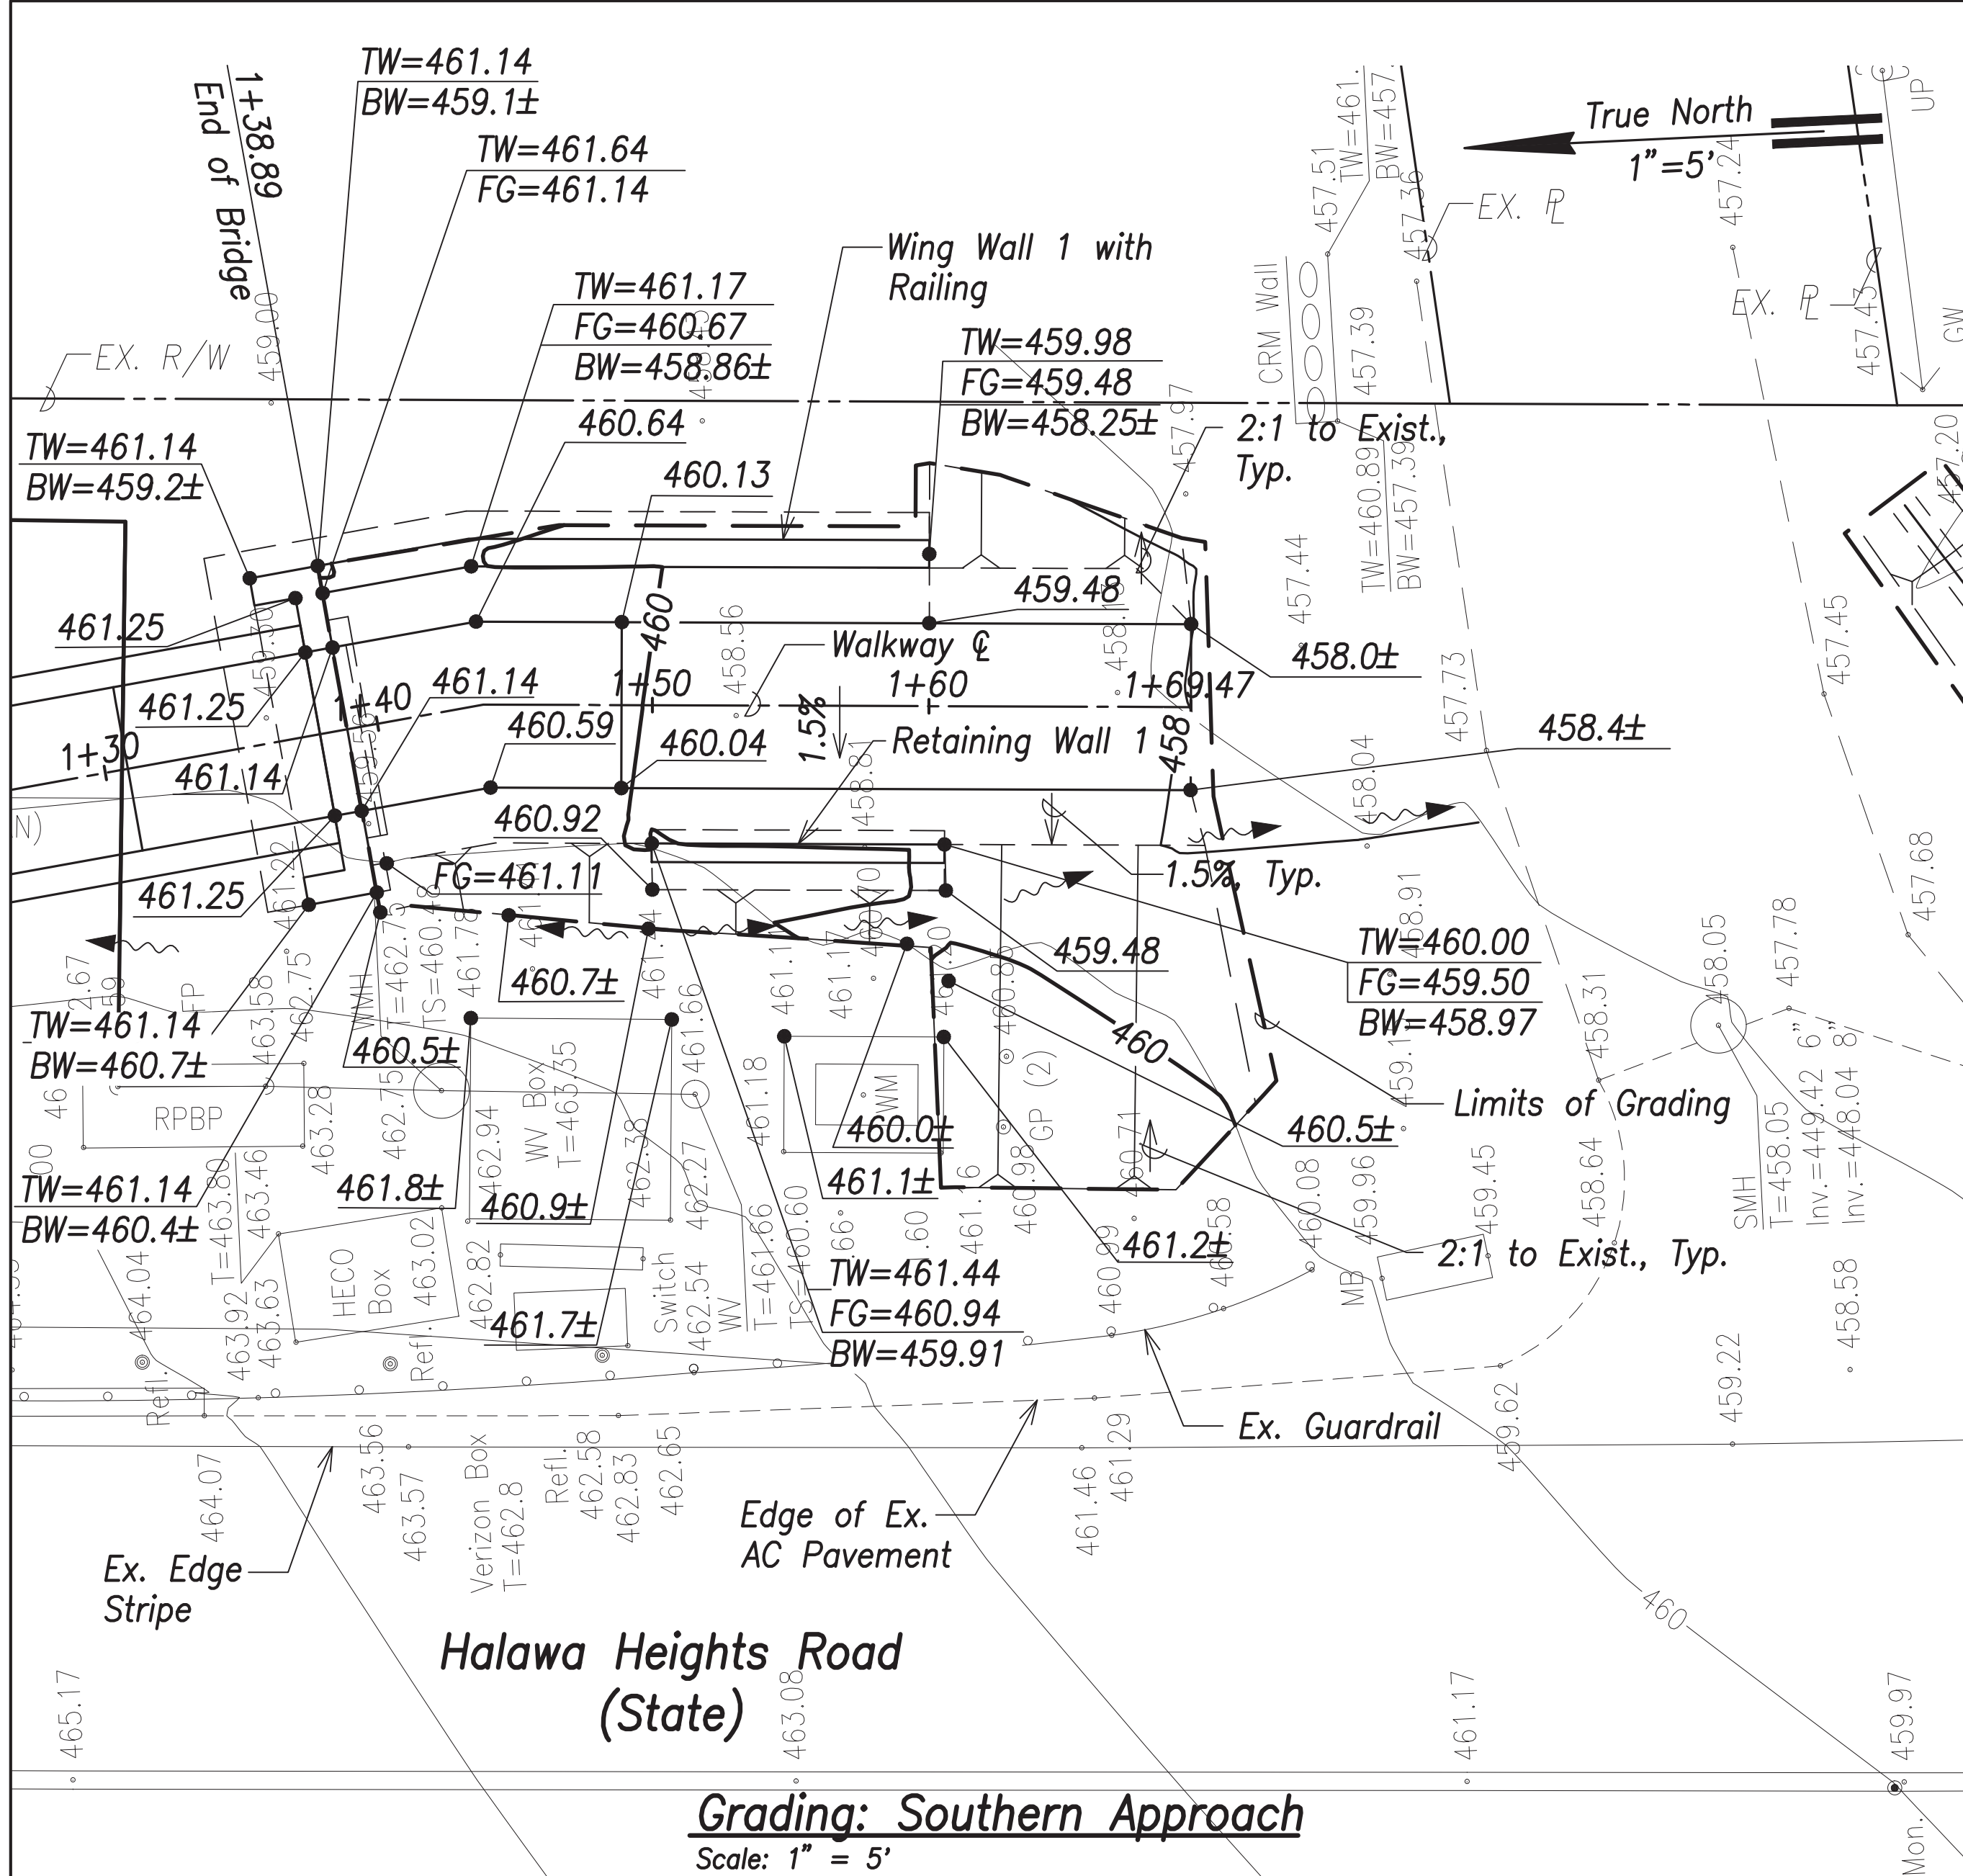

LEGEND:

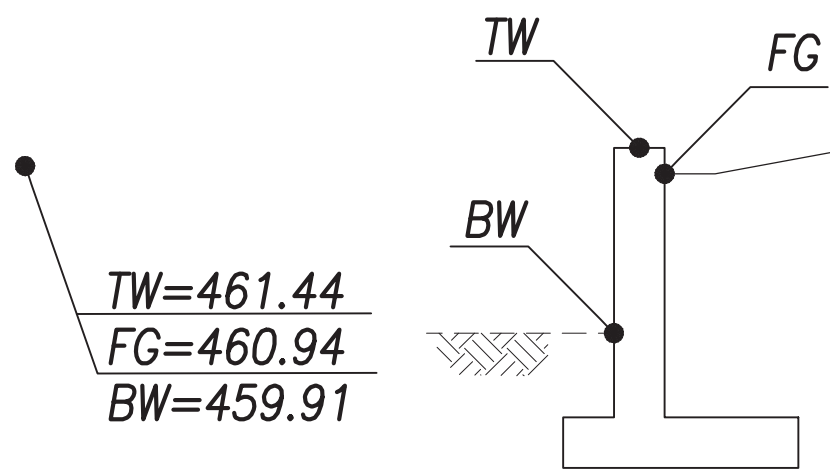


LEGEND FOR AS-BUILT POSTINGS

Squiggly line for as-built deletion

Double line for as-built deletion

Text for as-built posting

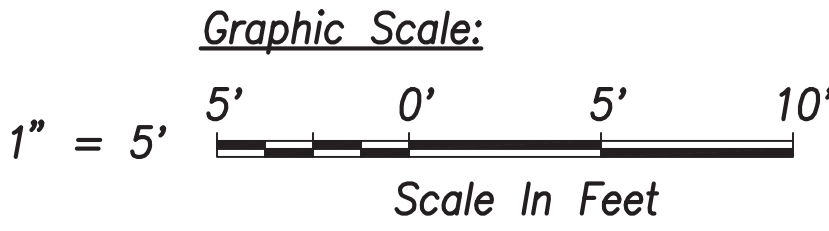

THIS WORK WAS PREPARED BY ME OR UNDER MY SUPERVISION.

SIGNATURE _____ DATE OF LICENSE EXPIRY APR. 30, 2018

1/15/19	C.O.: Revised walkway grading
7/2/18	C.O.: Revised walkway grading
3/30/18	C.O.: Rev. wall spot elevations
DATE	REVISION

STATE OF HAWAII
DEPARTMENT OF TRANSPORTATION
HIGHWAYS DIVISION

GRADING PLAN - 1

HALAWA HEIGHTS ROAD
PEDESTRIAN BRIDGE
Proj. No. 7241A-01-13

Scale: As Shown Date: April 24, 2017

SHEET No. C6.1 OF 18 SHEETS

