



FED. ROAD DIST. NO.	STATE	PROJ. NO.	FISCAL YEAR	SHEET NO.	TOTAL SHEETS
HAWAII	HAW.	7241A-01-13	2016	11	66

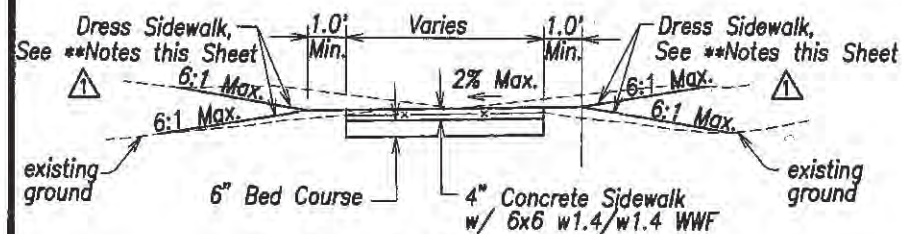


Concrete Sidewalk Detail
Not to Scale

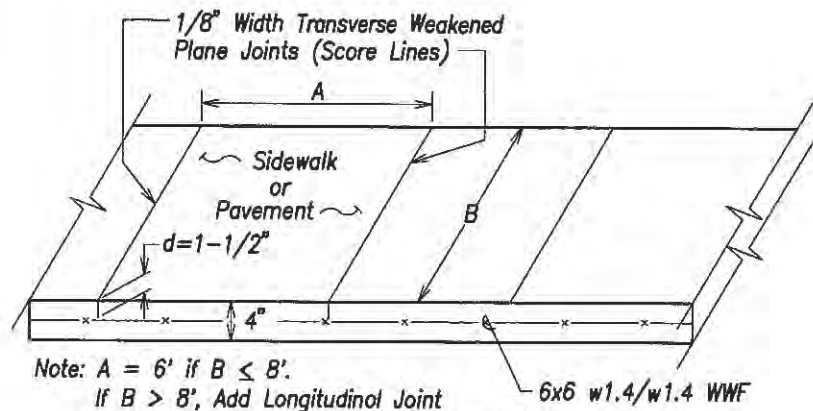


Note: A = 6' if B ≤ 8'.
If B > 8', Add Longitudinal Joint


Sidewalk Contraction Joint Detail
Not to Scale

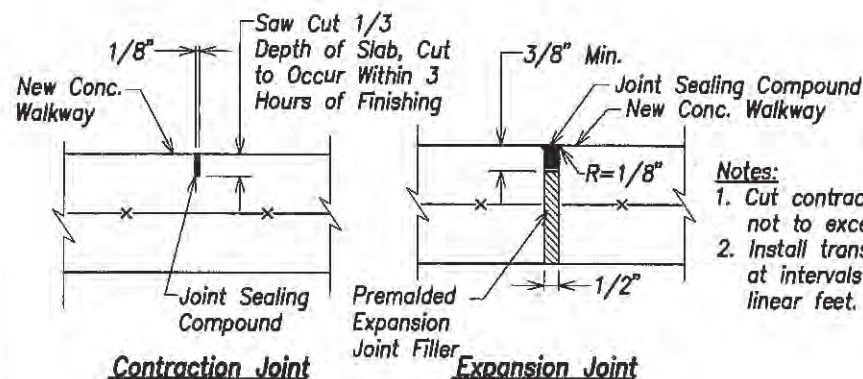


Walkway Contraction And Expansion Joints
Not to Scale

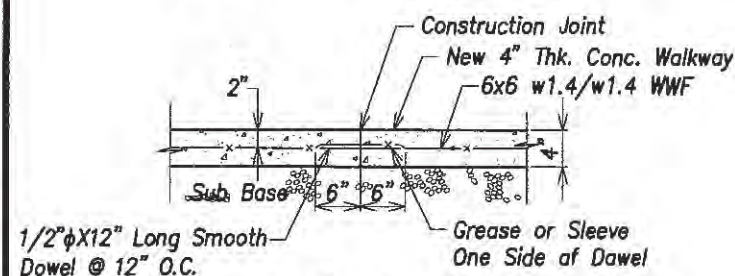


Transverse Construction Joint Detail
Not to Scale

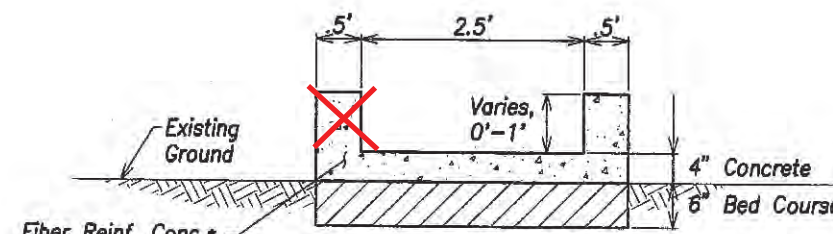


Drainage Channel Section
Not to Scale

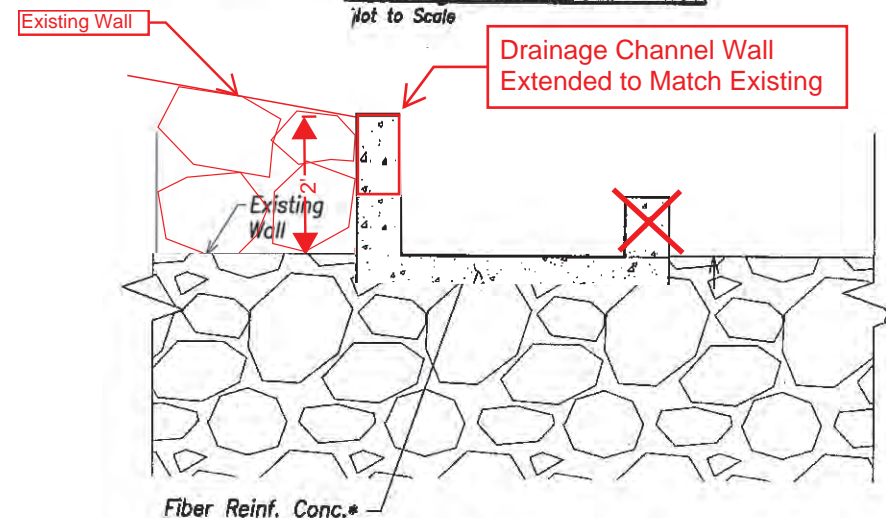

Drainage Channel Outlet
Not to Scale

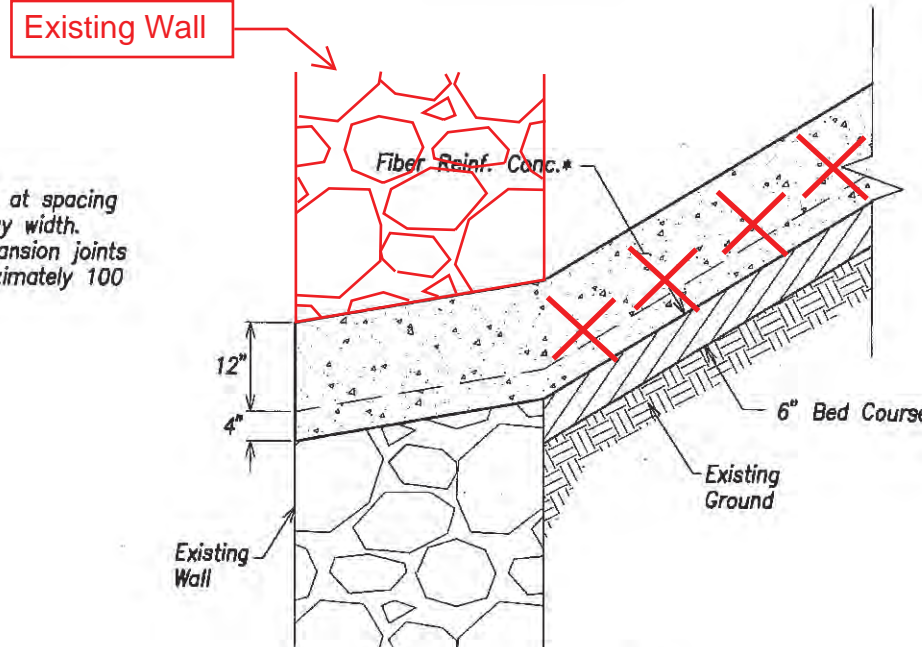

Drainage Channel Profile
Not to Scale

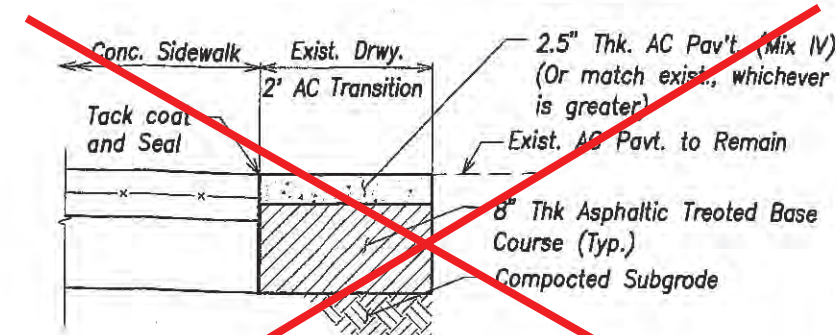

AC Transition to Concrete Pavt. Connection Detail (City)
Not to scale

AS-BUILT DRAWINGS

This certifies that the dimensions and details shown on this sheet reflect the dimensions and details, and specifications as constructed in the field.

KAUKOR CONSTRUCTION CO., INC.

DATE: **07-29-2021**

*Note:
7.5 lbs/cy of Strucx 90/40 Synthetic Fiber or Accepted equal shall be added to the concrete.

****Notes:**

1. Dressing of sidewalk shall consist of clearing, grubbing, grading, reshaping and compacting the area adjacent to the improvement with topsoil as shown on the plans and/or as directed by the Engineer. This work shall be considered incidental to Concrete Sidewalk pay item.
2. Transverse and longitudinal weakened Plane Joints for sidewalk shall be considered incidental to Concrete Sidewalk pay item.
3. Installation of dowels and tie bars, including drilling and epoxy grout shall be incidental to Concrete Sidewalk pay item.

5/17/17	△ Addendum 1: Added notes
DATE	REVISION

STATE OF HAWAII
DEPARTMENT OF TRANSPORTATION
HIGHWAY DIVISION

MISCELLANEOUS DETAILS

HALAWA HEIGHTS ROAD
PEDESTRIAN BRIDGE
Proj. No. 7241A-01-13

Scale: As Shown Date: April 24, 2017

SHEET No. C4.1 OF 18 SHEETS



THIS WORK WAS PREPARED BY ME OR UNDER MY SUPERVISION
DATE: 05/17/2017
SIGNATURE: [Signature]

"AS-BUILT"

ADD.11

The diagram is a plan view of a water main installation. It shows a horizontal main line with several components and dimensions:

- Valve (typ.):** Indicated by a circle with a crosshair at the left end of the main line.
- 10':** Dimension for the distance from the valve to the first Tee.
- Bend (Horizon.):** Indicated by a circle with a crosshair at the first Tee location.
- 10':** Dimension for the distance between the first Tee and the second Tee.
- Tee:** Indicated by a circle with a crosshair at the second Tee location.
- 20' Maximum:** Dimension for the distance between the second Tee and the third Tee.
- Deflection Coupling/ Deflection (Horizon.):** Indicated by a circle with a crosshair at the third Tee location.
- Reinforced Concrete Jacket (potable water only):** Indicated by a shaded rectangular section on the main line.
- End of main:** Indicated by a circle with a crosshair at the right end of the main line.
- Electronic marker:** Indicated by a circle with a crosshair at the left end of the main line.

Plan

The diagram illustrates a trench cross-section. At the bottom is a hatched line representing the ground level. Above it is a circular cross-section of a **Water Pipe**. Surrounding the pipe is a **Pipe cushion**. Above the pipe cushion is a layer of **Backfill material**. An **Electronic Marker** is shown as a small circle within the backfill material, directly above the pipe. The top of the backfill material is indicated by a dashed line. The **Trench Width** is shown as the horizontal distance between the edges of the backfill material. The **Finish Grade** is indicated by a hatched line at the top right. A vertical dimension line on the right side is labeled **See Note 1**. A horizontal dimension line on the left side is labeled **See Note 3**.

Diagram illustrating the cross-section of a trench repair, showing the symmetrical layers and dimensions:


- Symmetrical about** (indicated by a vertical centerline with a double-headed arrow).
- Trench Width *** (indicated by a horizontal dimension line at the top).
- Provide Grassing** (indicated by an arrow pointing to the topsoil layer).
- Restore surface to original condition** (indicated by an arrow pointing to the topsoil layer).
- 4" thick top soil** (indicated by an arrow pointing to the topsoil layer).
- See Note 5** (indicated by an arrow pointing to the topsoil layer).
- Trench backfill material "B"** (indicated by an arrow pointing to the layer below the topsoil).
- See note 6** (indicated by an arrow pointing to the layer below the topsoil).
- Trench backfill material "A"** (indicated by an arrow pointing to the layer below the backfill material "B").
- See note no. 2 (per BWS std.)** (indicated by an arrow pointing to the layer below the backfill material "A").
- Pipe Cushion (per BWS std.)** (indicated by an arrow pointing to the layer below the backfill material "A").
- Pipe Diameter** (indicated by a horizontal dimension line across the pipe).
- PIPE 6"** (indicated by a vertical dimension line at the bottom).
- 3'-0" Min.** (indicated by a vertical dimension line on the left side, representing the total depth of the trench).
- 1'-0"** (indicated by a vertical dimension line on the left side, representing the depth of the backfill material "B" layer).

2:1 max.

to min.

24" Thick layer class 3 rock grouted w/ mortar

Created
Not to Scale

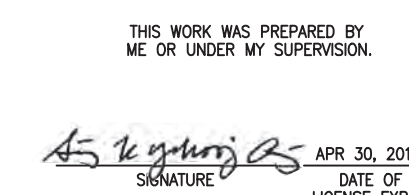

ORIGINAL PLAN	SURVEY PLOTTED BY _____ DATE _____
NOTE BOOK	DRAWN BY _____
	TRACED BY _____
	DESIGNED BY _____
	QUANTITIES BY _____
No. _____	CHECKED BY _____