




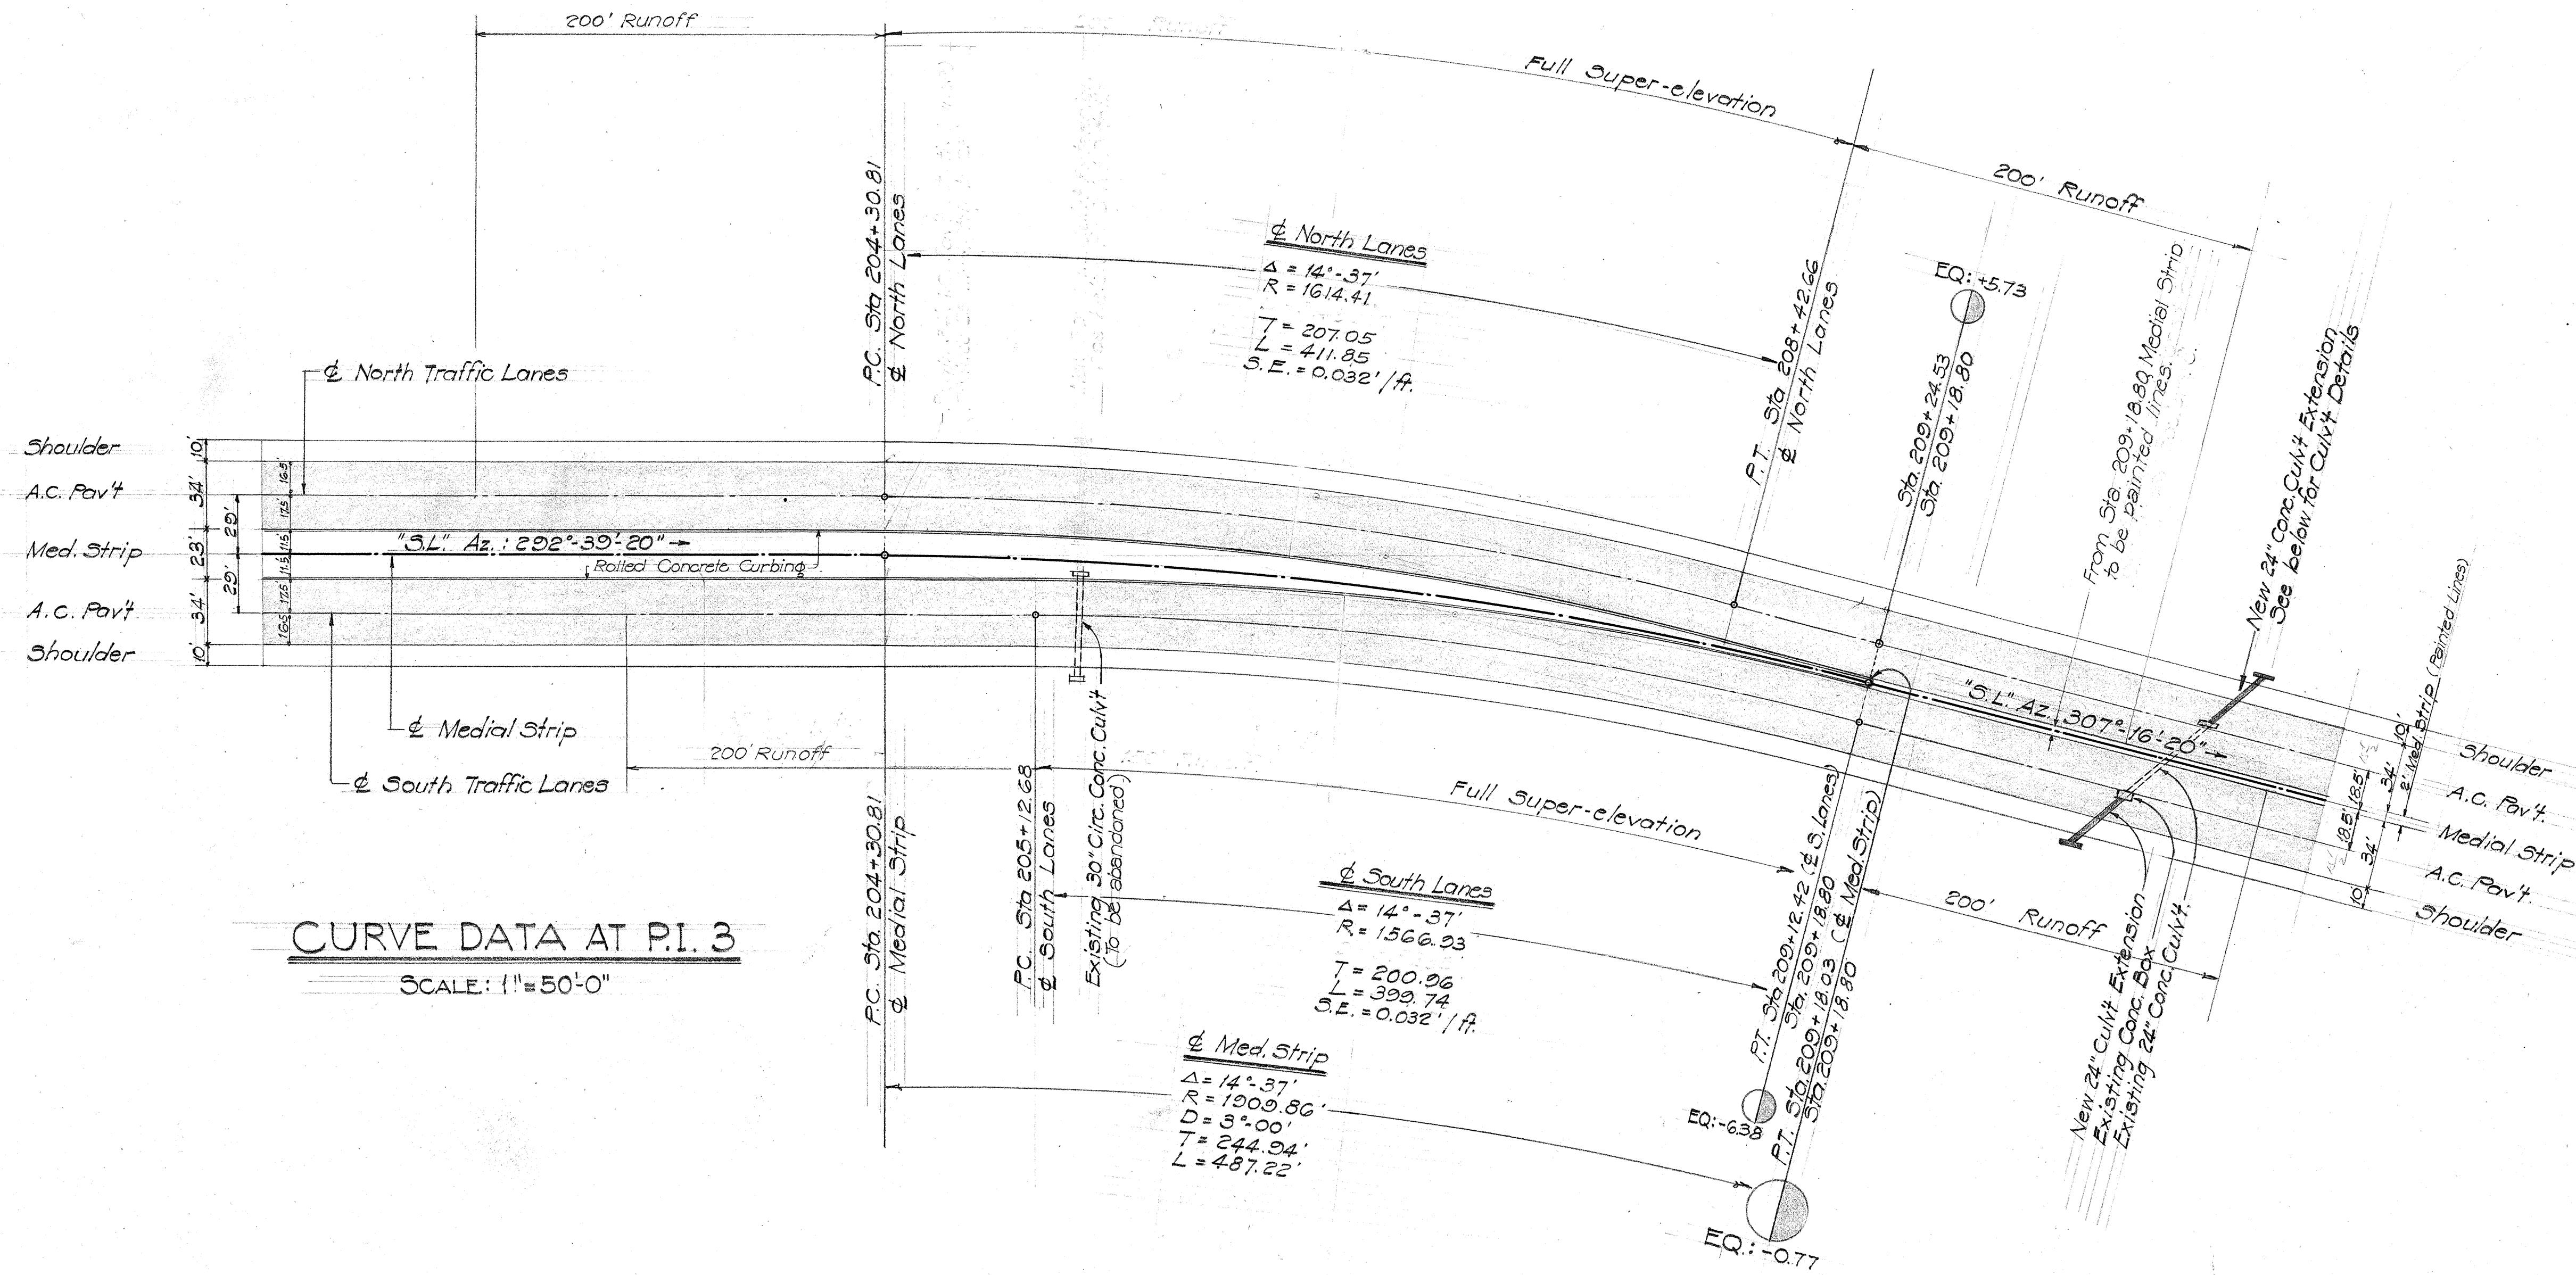

CURVE DATA AT P.I. 3
SCALE: 1"=50'-0"

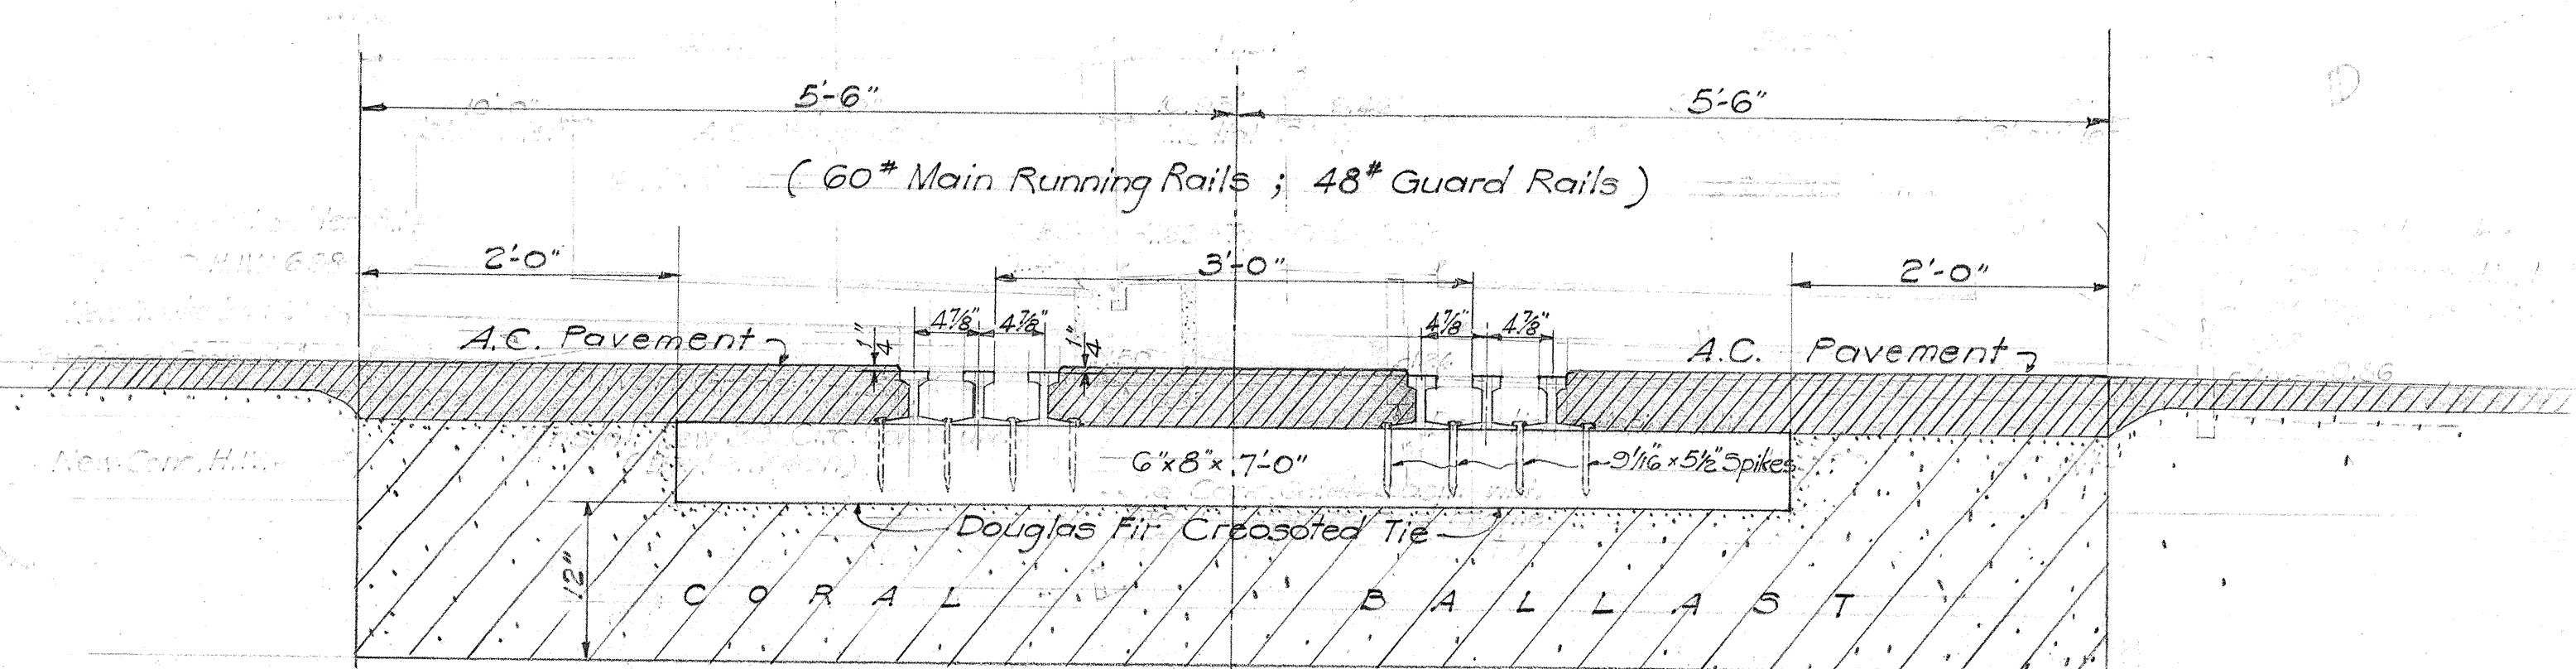

TYPICAL SECTION ~ R.R. CROSSING
SCALE: 1"=1'-0"

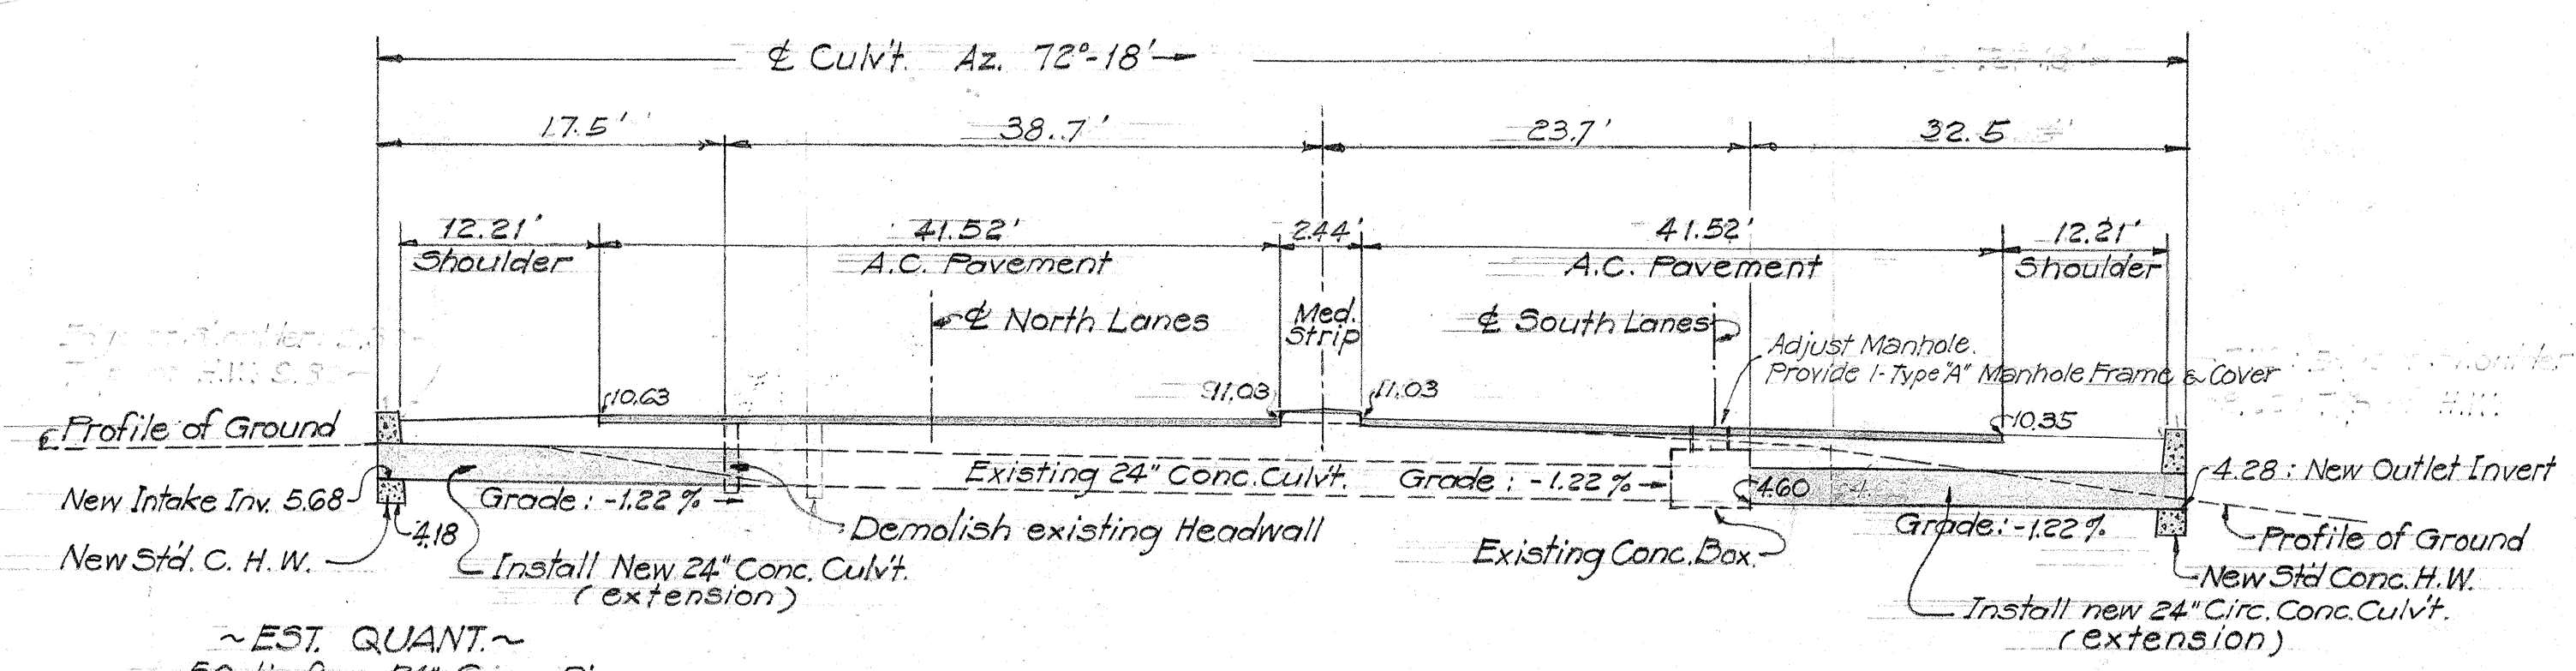

~EST. QUANT.~
50 lin. ft. ~ 24" Conc. Pipe
2 - C.H.W. ~ 2.76 c.y. Class "B" Conc.
84 Lb. Reinf. Steel
Exc. = 35 c.y.

CULVERT DETAIL
SCALE: 1"=10'-0"

TERRITORIAL HIGHWAY DEPARTMENT
TERRITORY OF HAWAII
CURVE DETAIL AT P.I. # 3
& DETAIL OF CULVERTS
KAMEHAMEHA HIGHWAY
FROM PUULOA ROAD TO OAHU PRISON
SN FAP 9-D(4) JULY 19, 1944