
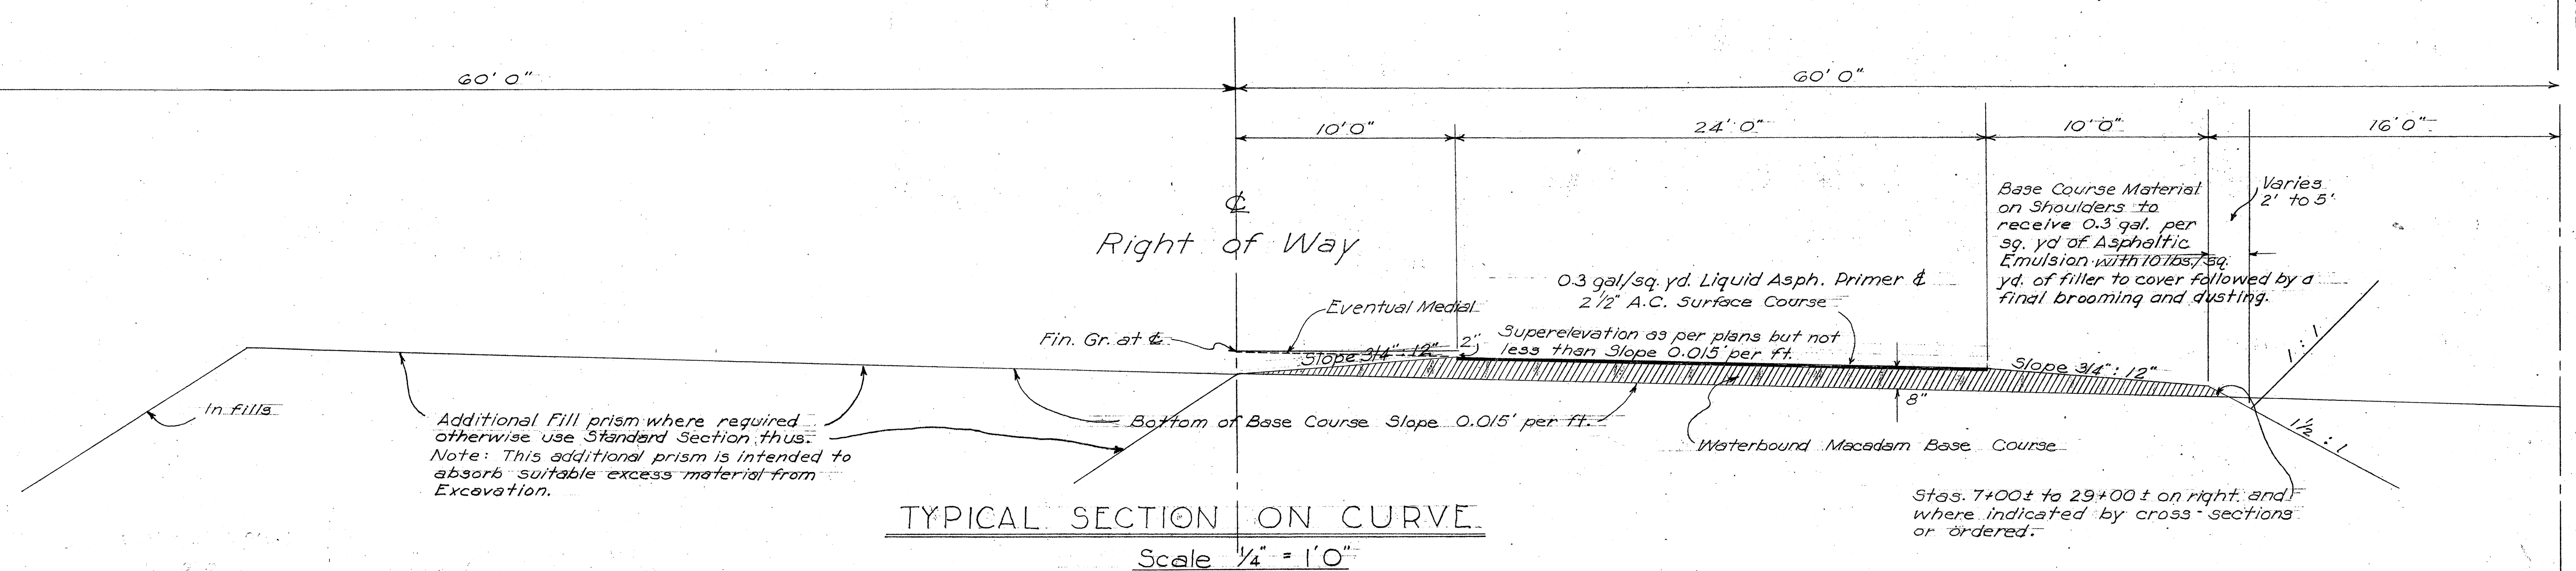


In unpaved sections no base course is required but the entire area in this section shall be finished as required for subgrade to receive base course.

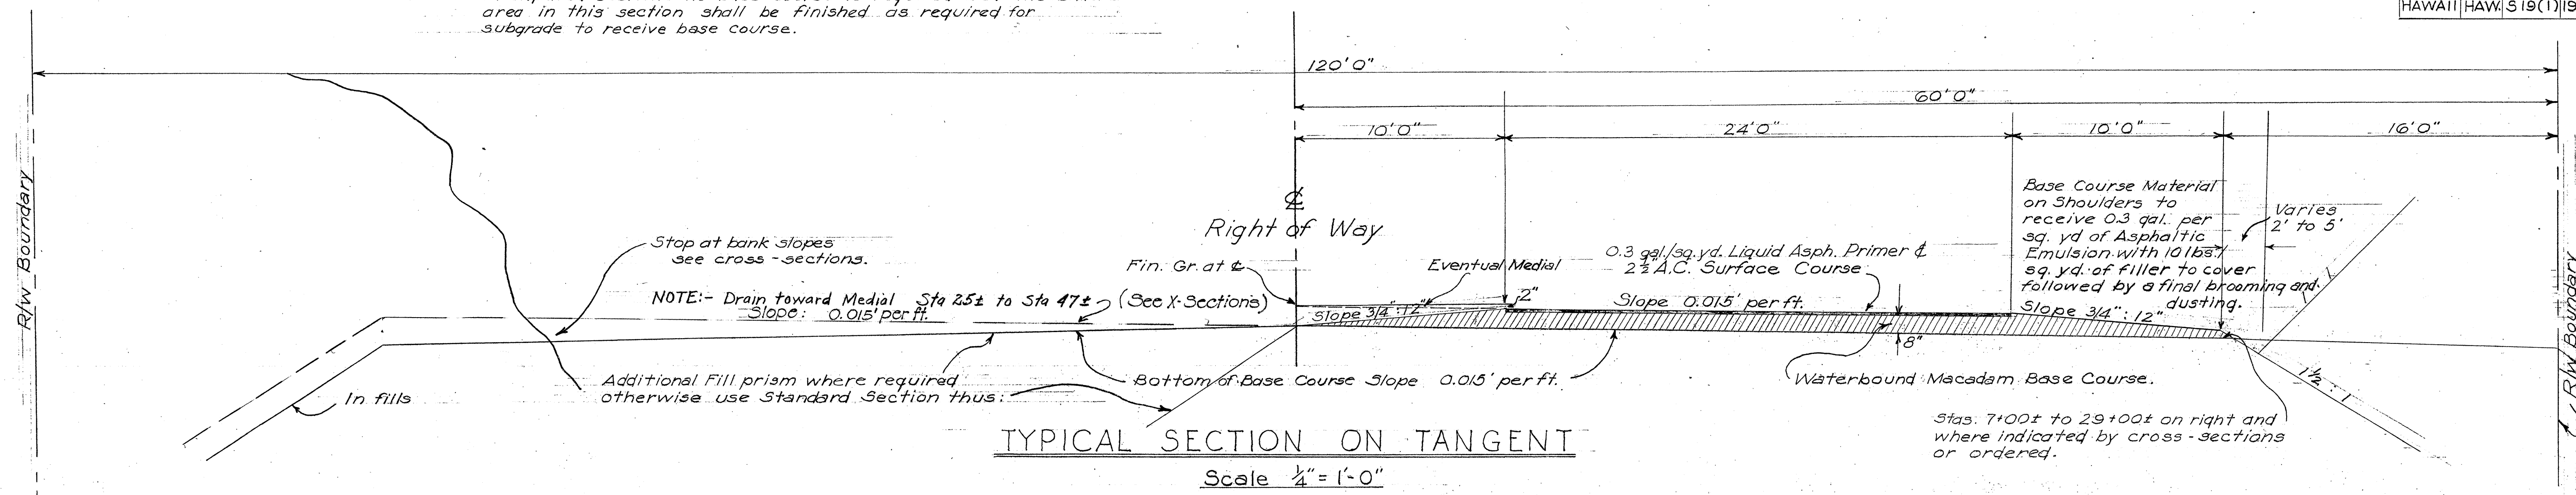

BASE COURSE NOTES:
Waterbound Macadam Base Course the thickness indicated consists of Mineral Aggregate (2 1/2" to 1 1/2") bound with filler (3/8" to No. 100).

ORIGINAL PLAN	DESIGNED BY	DATE
NOTE BOOK	TRACED BY	
	QUANTITIES BY	
	CHECKED BY	
	CHECKED BY	

TERRITORIAL HIGHWAY DEPARTMENT
TERRITORY OF HAWAII
TYPICAL SECTIONS
PUULOA ROAD
PROJECT NO S 19 (1)
October 1946

SHEET No OF SHEETS

5164.2