




FED. ROAD DIST. NO.	STATE	PROJ. NO.	FISCAL YEAR	SHEET NO.	TOTAL SHEETS
HAWAII	HAW.	6600A-01-84M	1984	4	25

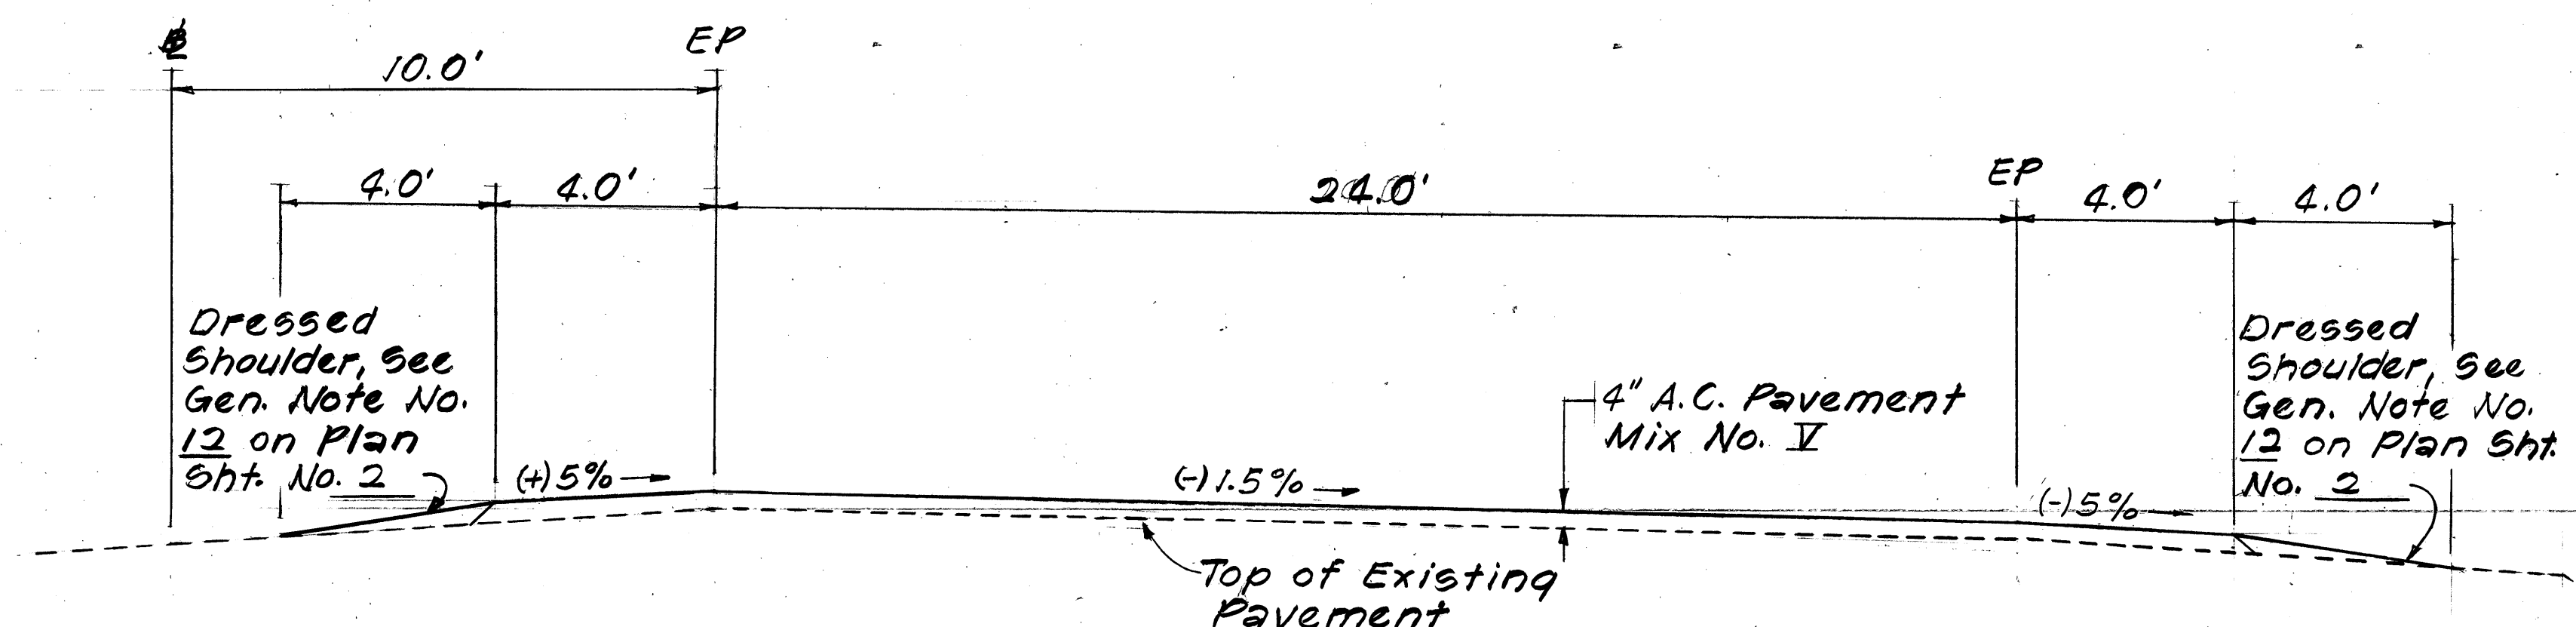


TYPICAL SECTION ~ STA. 5+00 TO STA. 18+75
Scale: 3/8"=1'-0"

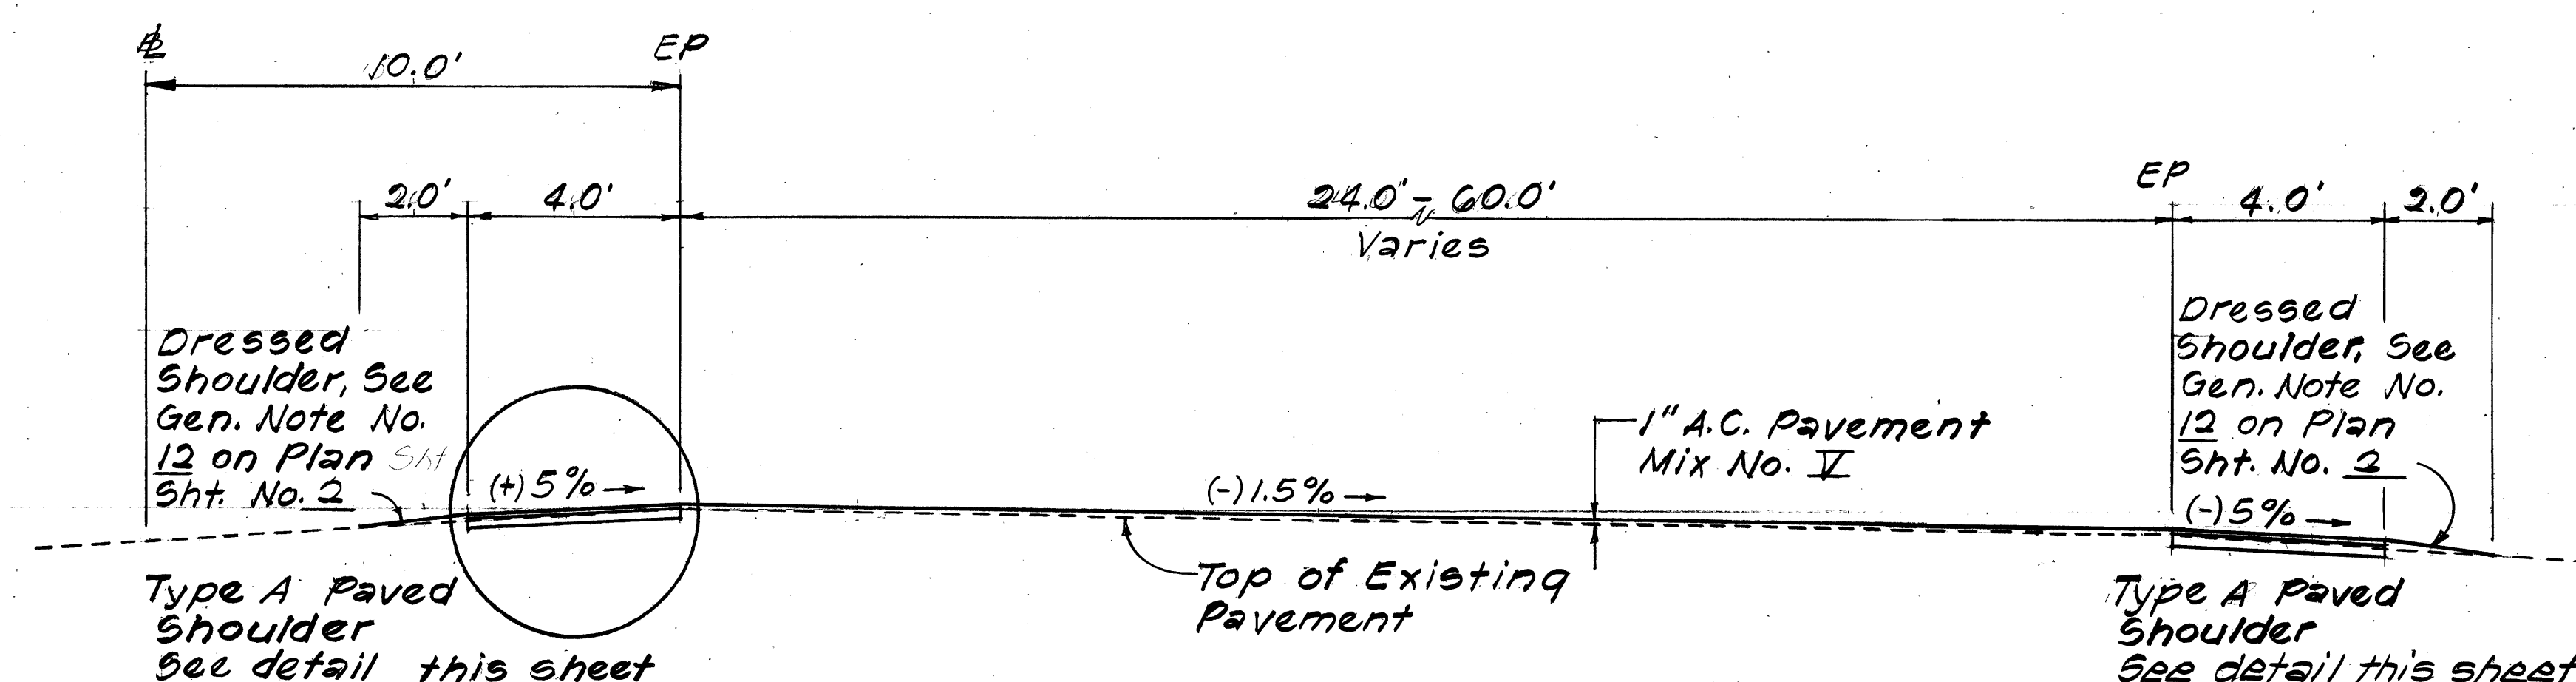


TYPICAL SECTION ~ STA. 19+50 TO STA. 35+00
Scale: 3/8"=1'-0"

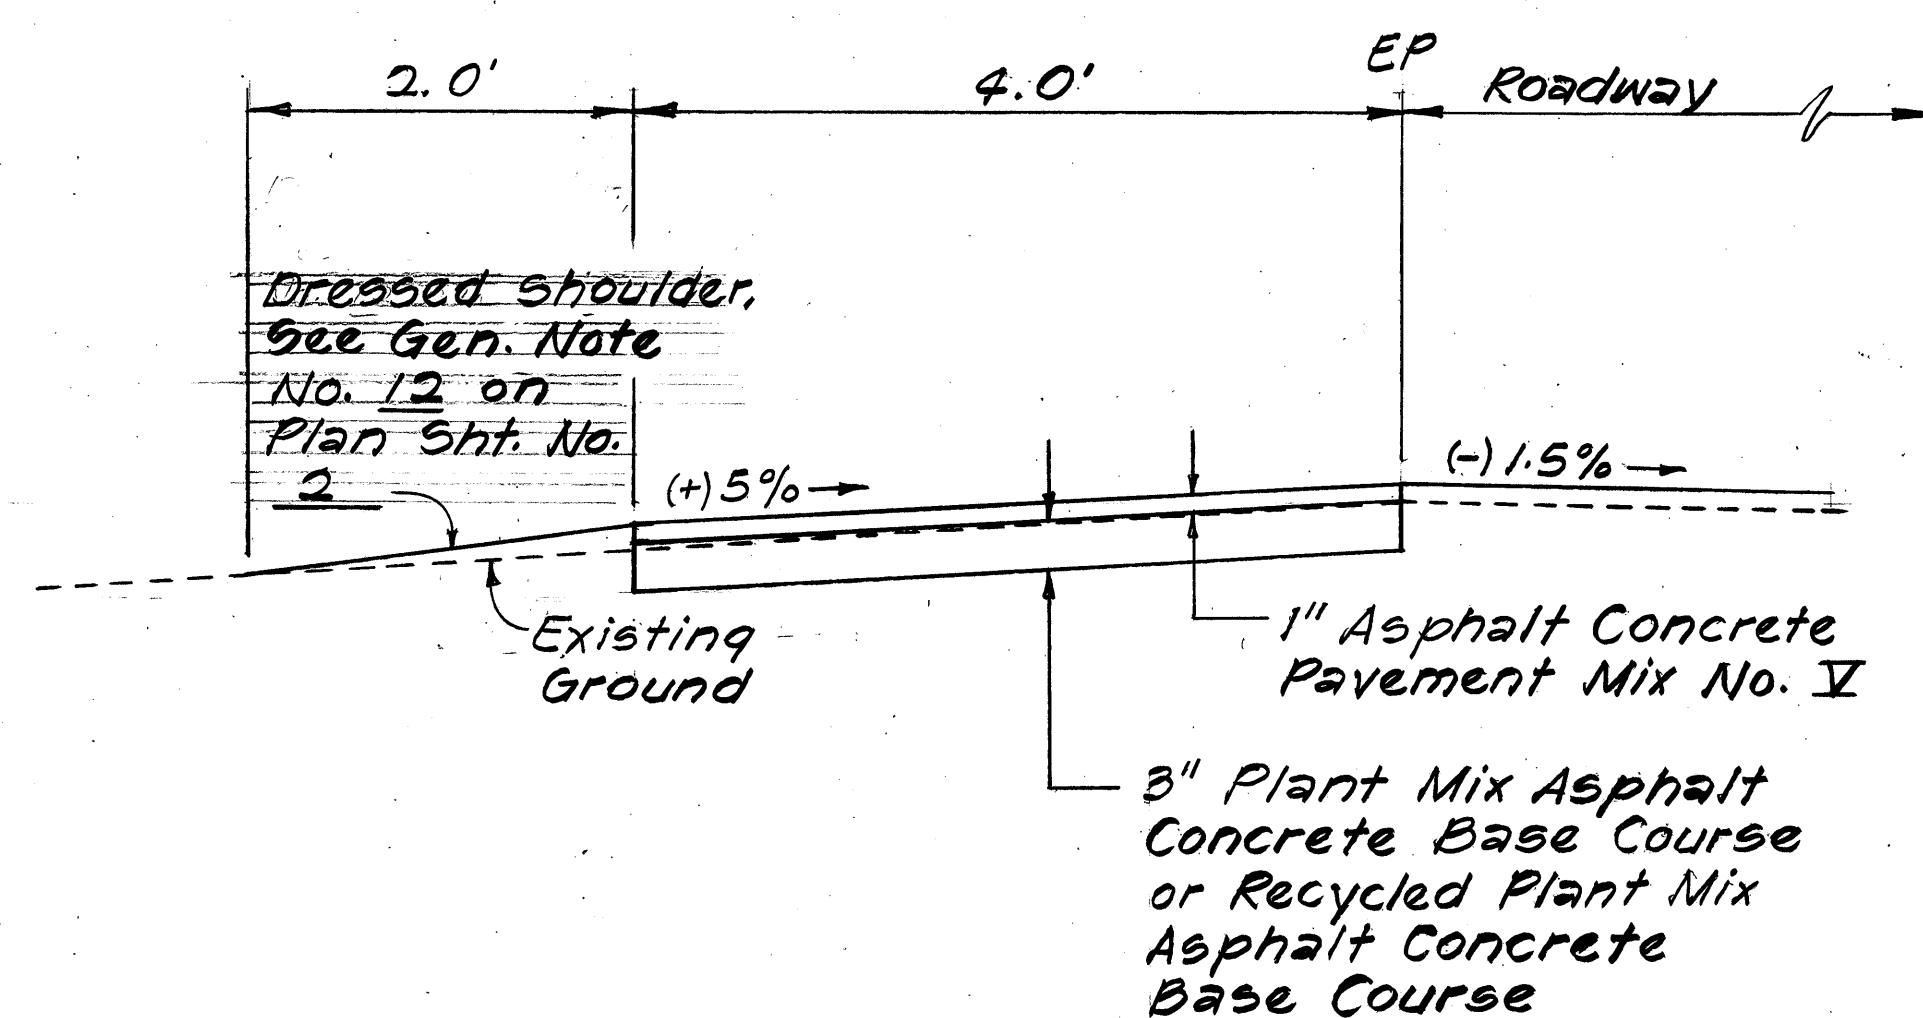


DETAIL ~ TYPE A PAVED SHOULDER
Scale: 1"=1'-0"

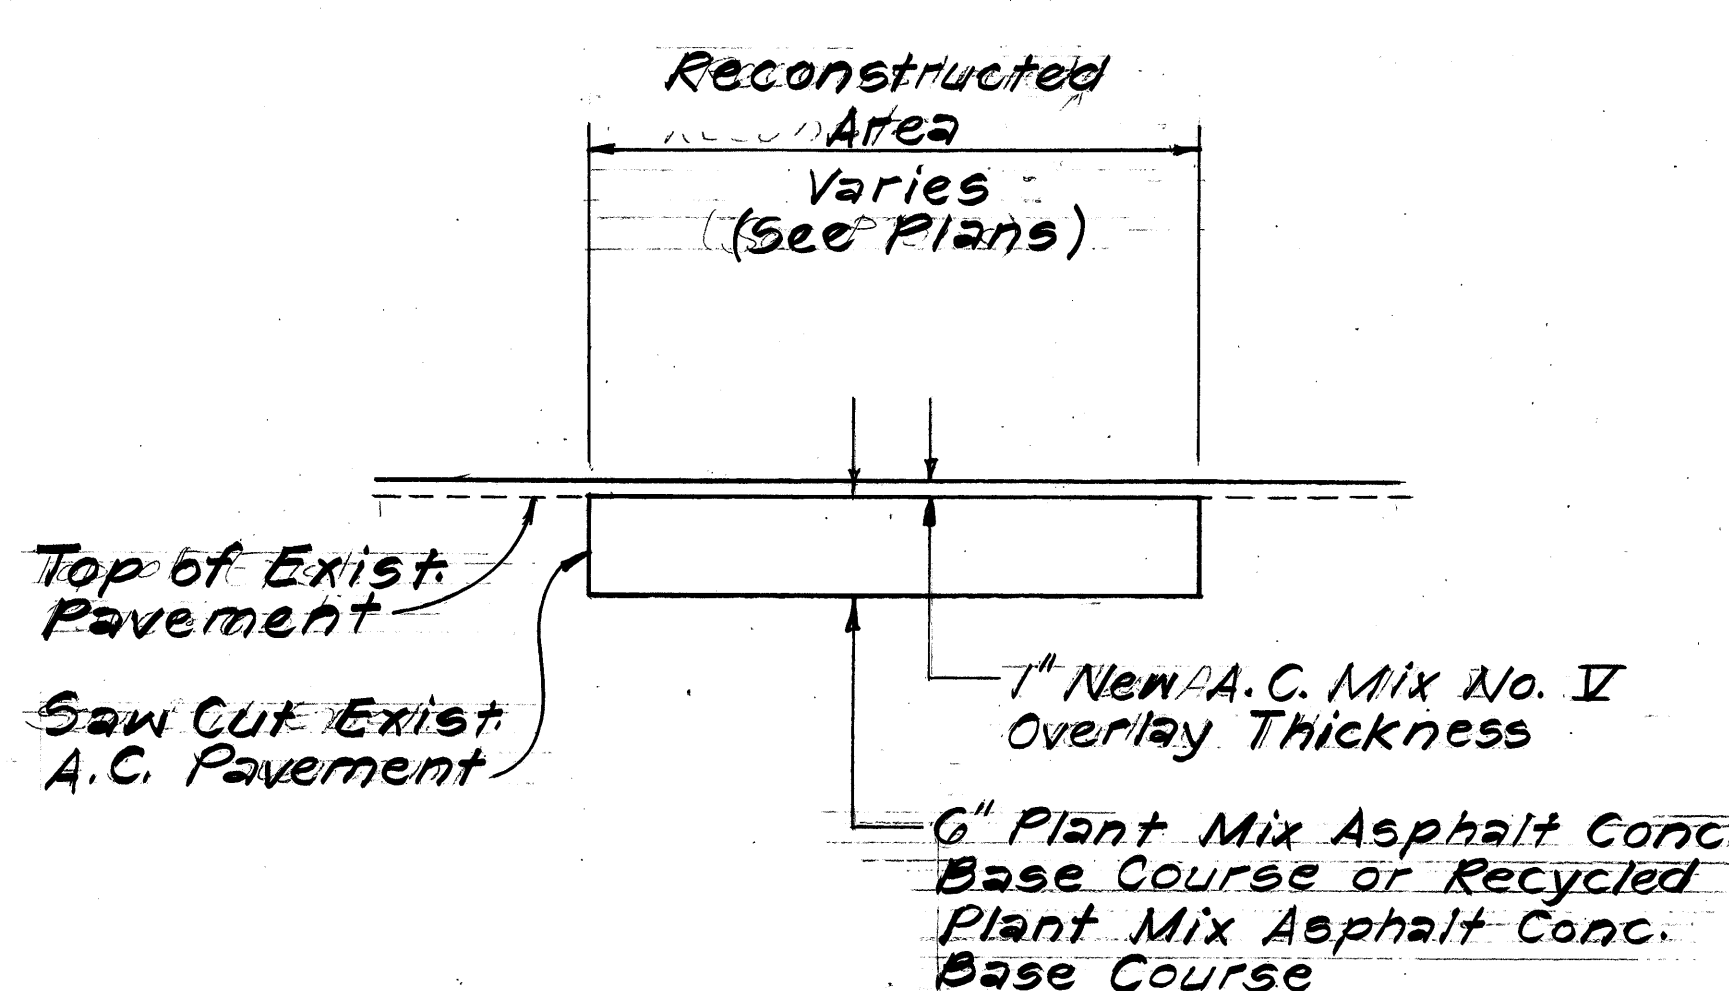


TYPICAL SECTION ~ RECONSTRUCTED AREA
Scale: 1"=1'-0"

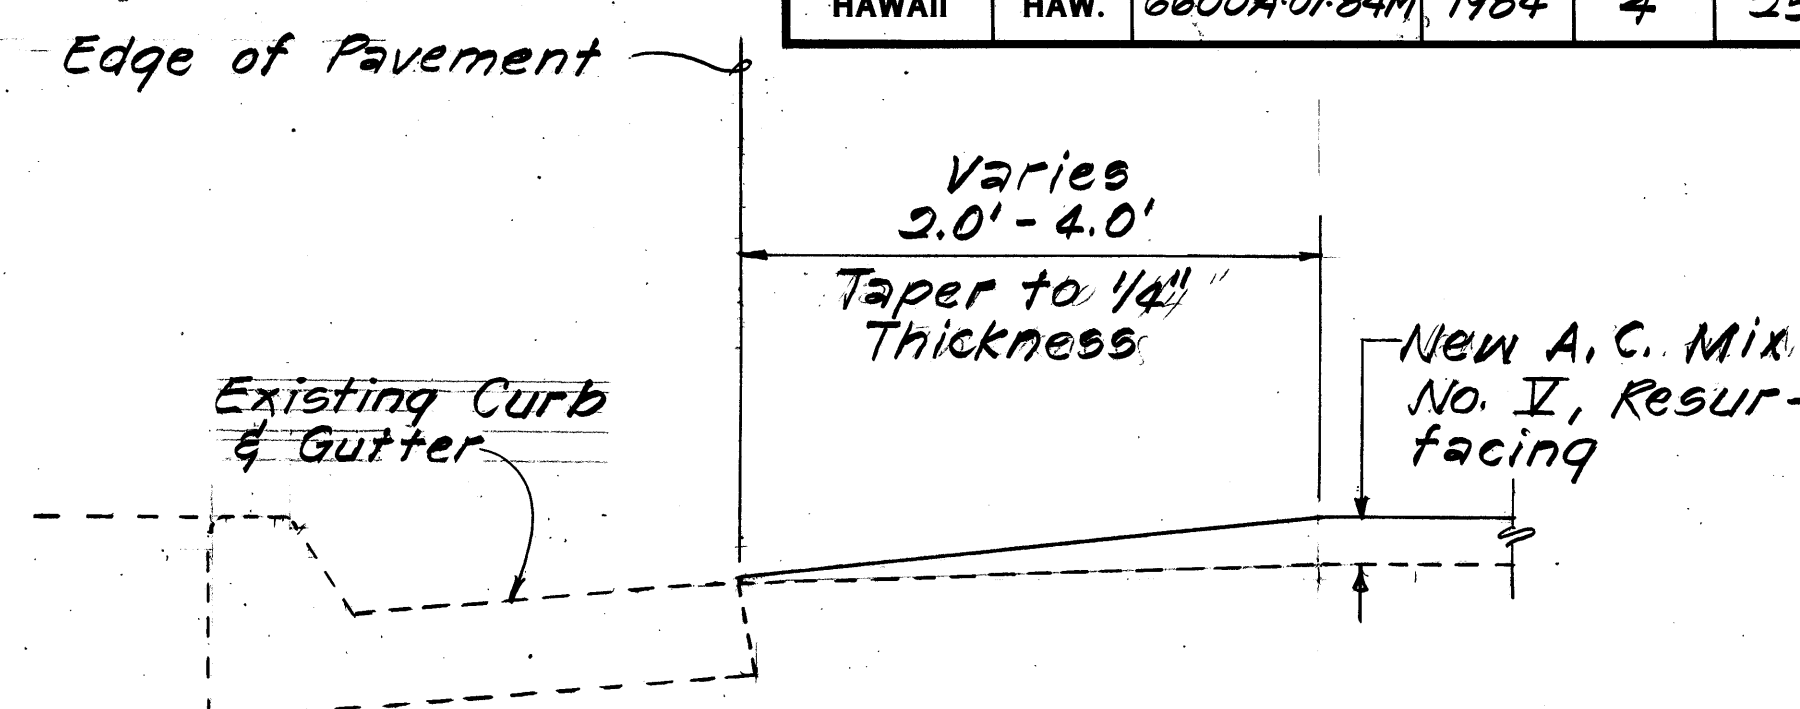

RESURFACING DETAIL AT CURB & GUTTER
Mapunapuna Place
Scale: 1"=1'-0"

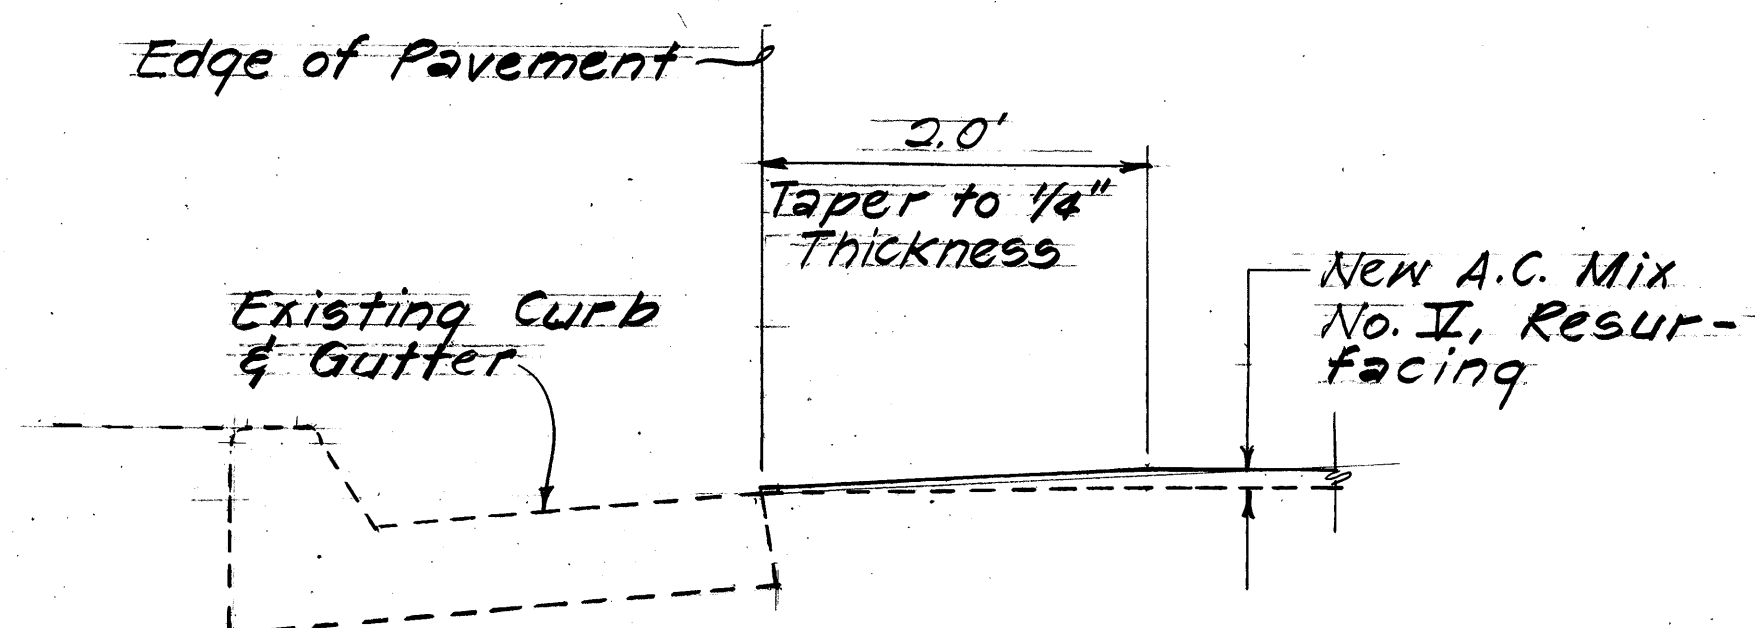


RESURFACING DETAIL AT CURB & GUTTER
Mokumoa Street & Pukoloa Street
Scale: 1"=1'-0"

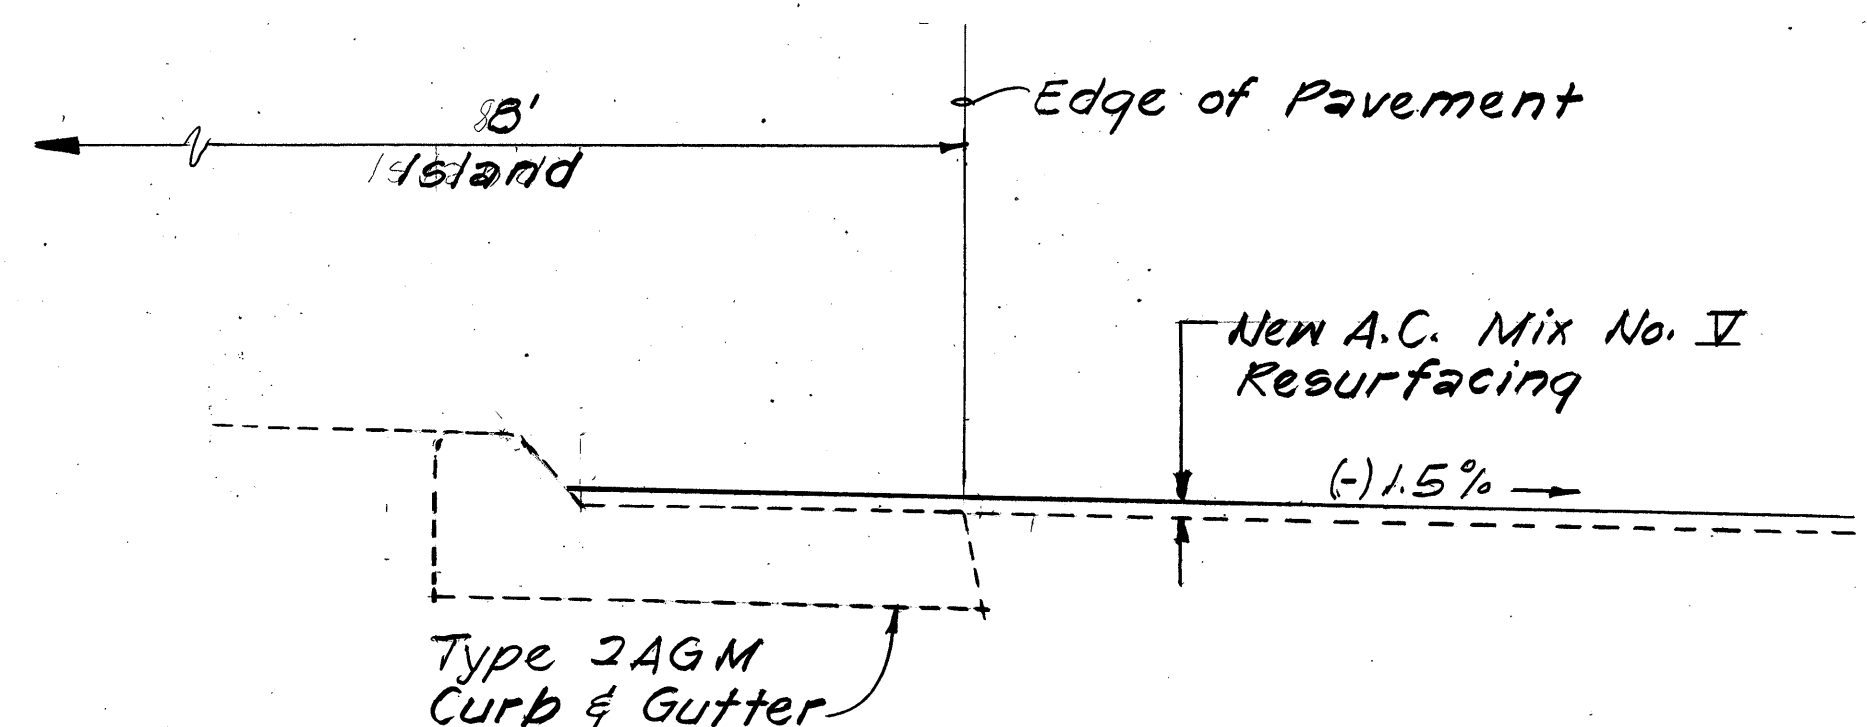


RESURF. DETAIL AT MEDIAN CURB & GUTTER
Puloa Road @ Sta. 37+25 to @ Sta. 38+00
Scale: 1"=1'-0"

STATE OF HAWAII DEPARTMENT OF TRANSPORTATION HIGHWAYS DIVISION
TYPICAL SECTIONS & DETAILS
PULOA ROAD RESURFACING VICINITY OF KILIHAI TO PUKOLOA Project No. 6600A-01-84M Scale: As Shown Date: Apr. 1984 SHEET No. 1 OF 2 SHEETS


FED. ROAD DIST. NO.	STATE	PROJ. NO.	FISCAL YEAR	SHEET NO.	TOTAL SHEETS
HAWAII	HAW.	6600A-01-84M	1984	5	25

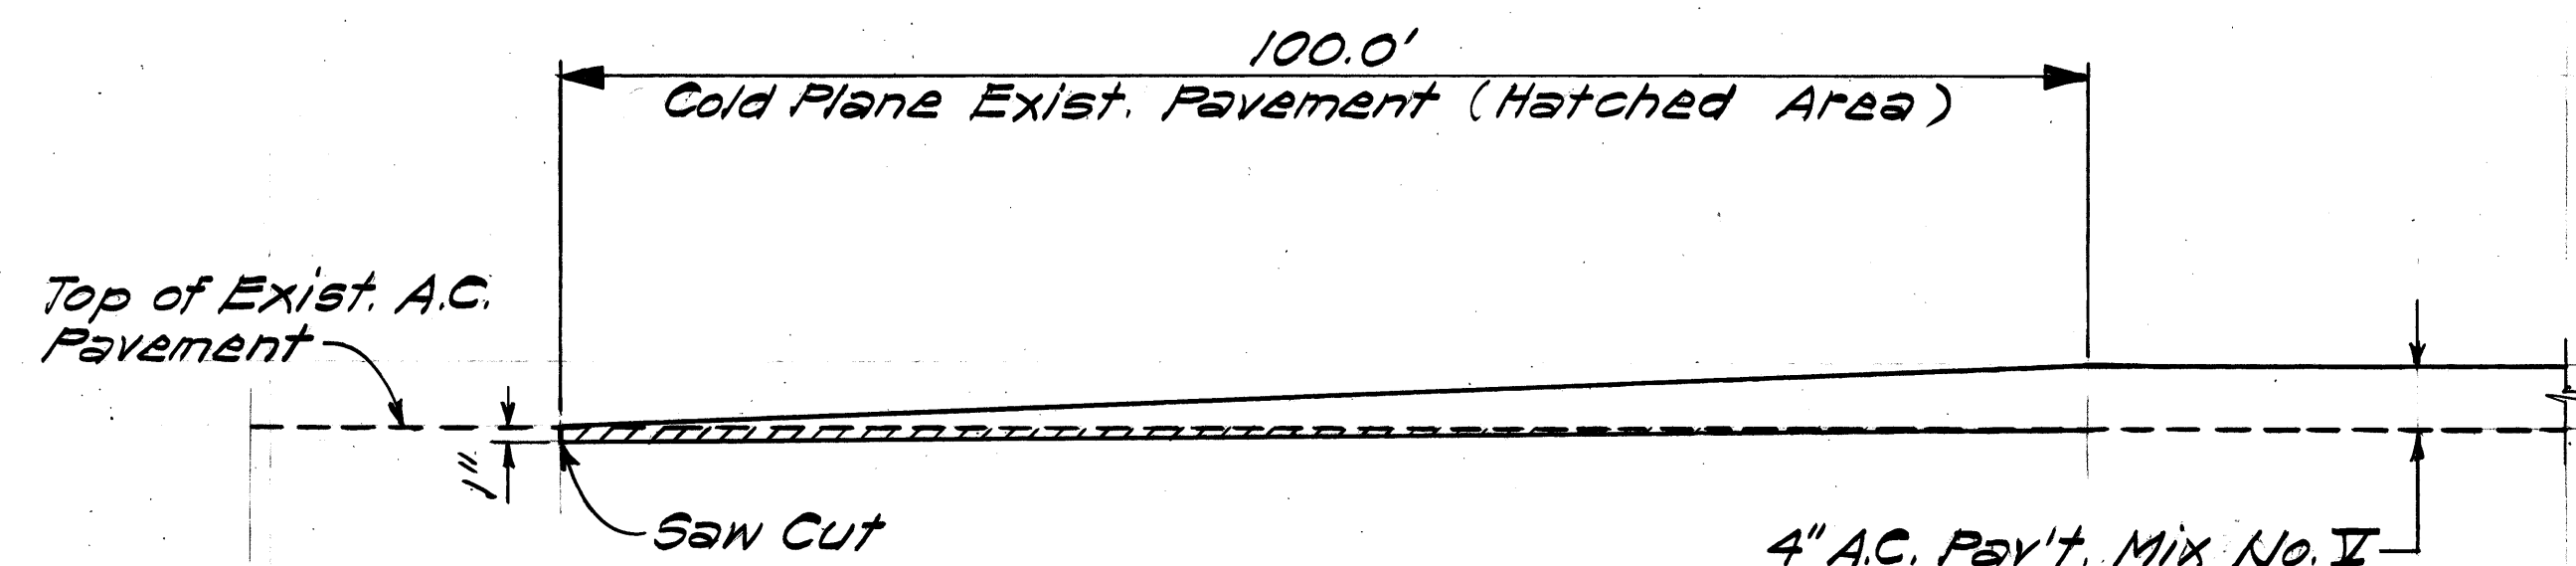


COLD PLANE TRANSITION DETAIL
STA. 5+00 TO # STA. 6+00
Not to Scale

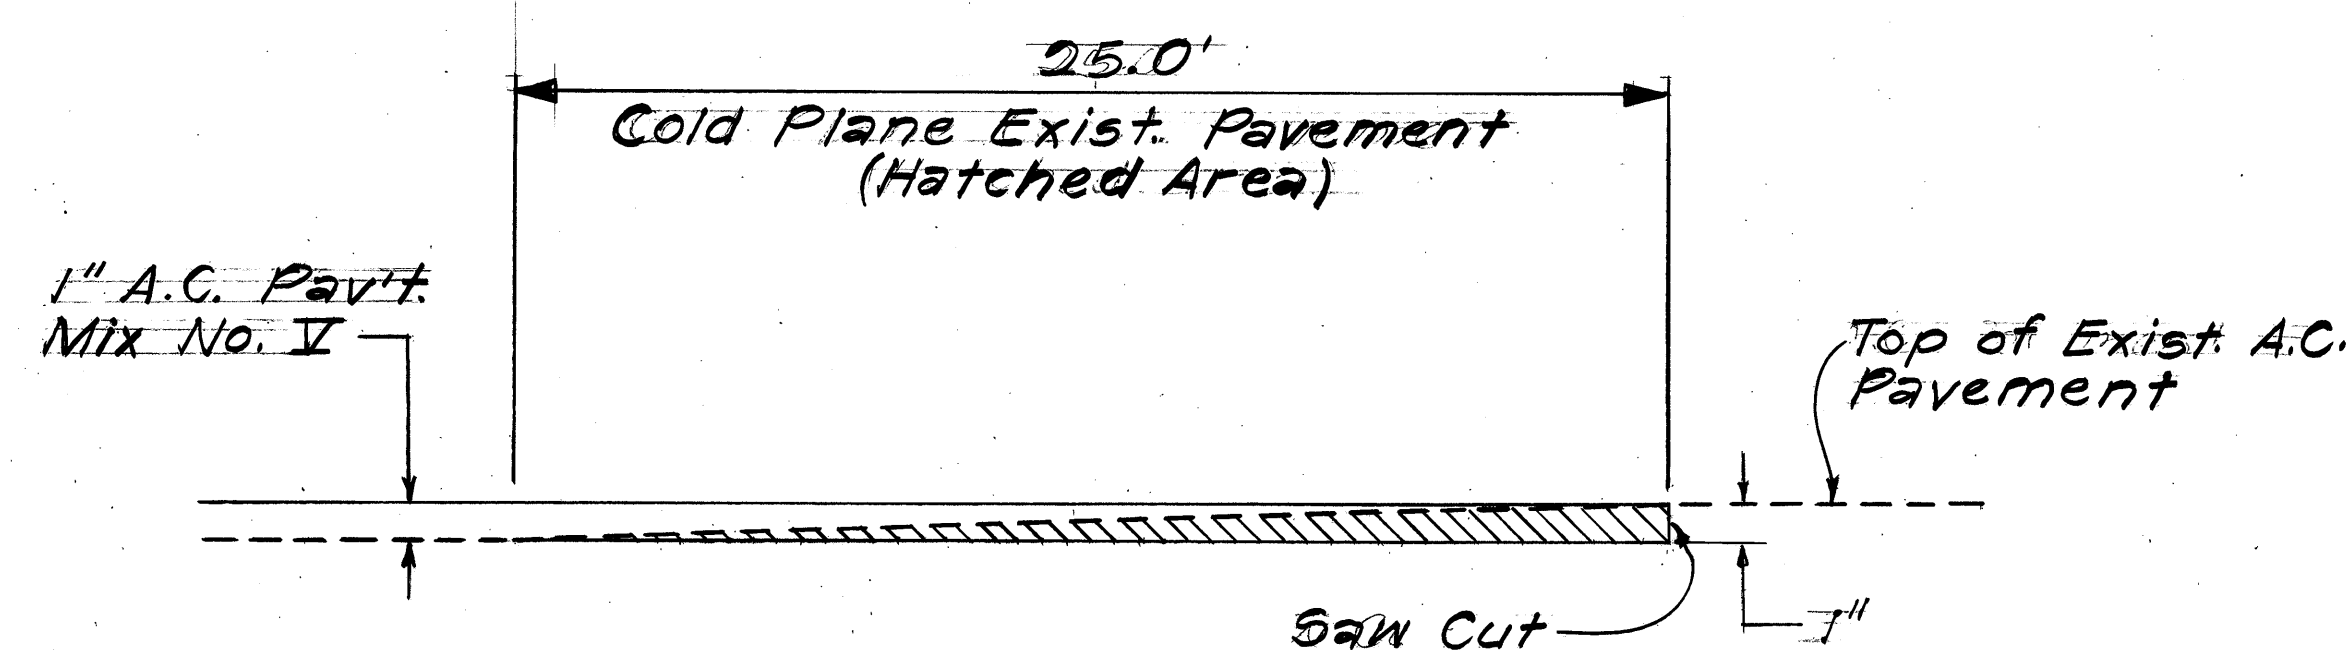


COLD PLANE TRANSITION DETAIL
STA. 37+75 TO # STA. 38+00
Not to Scale

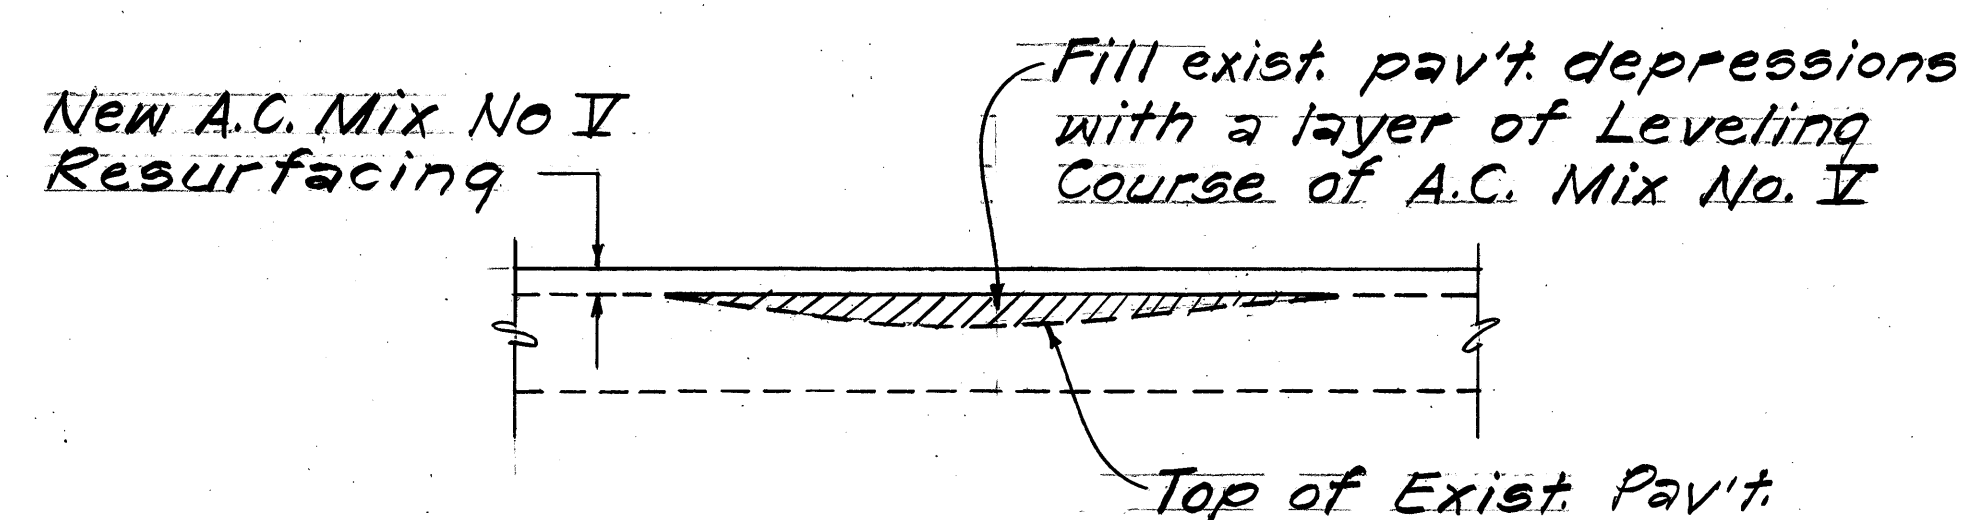


LEVELING COURSE DETAIL
Not to Scale

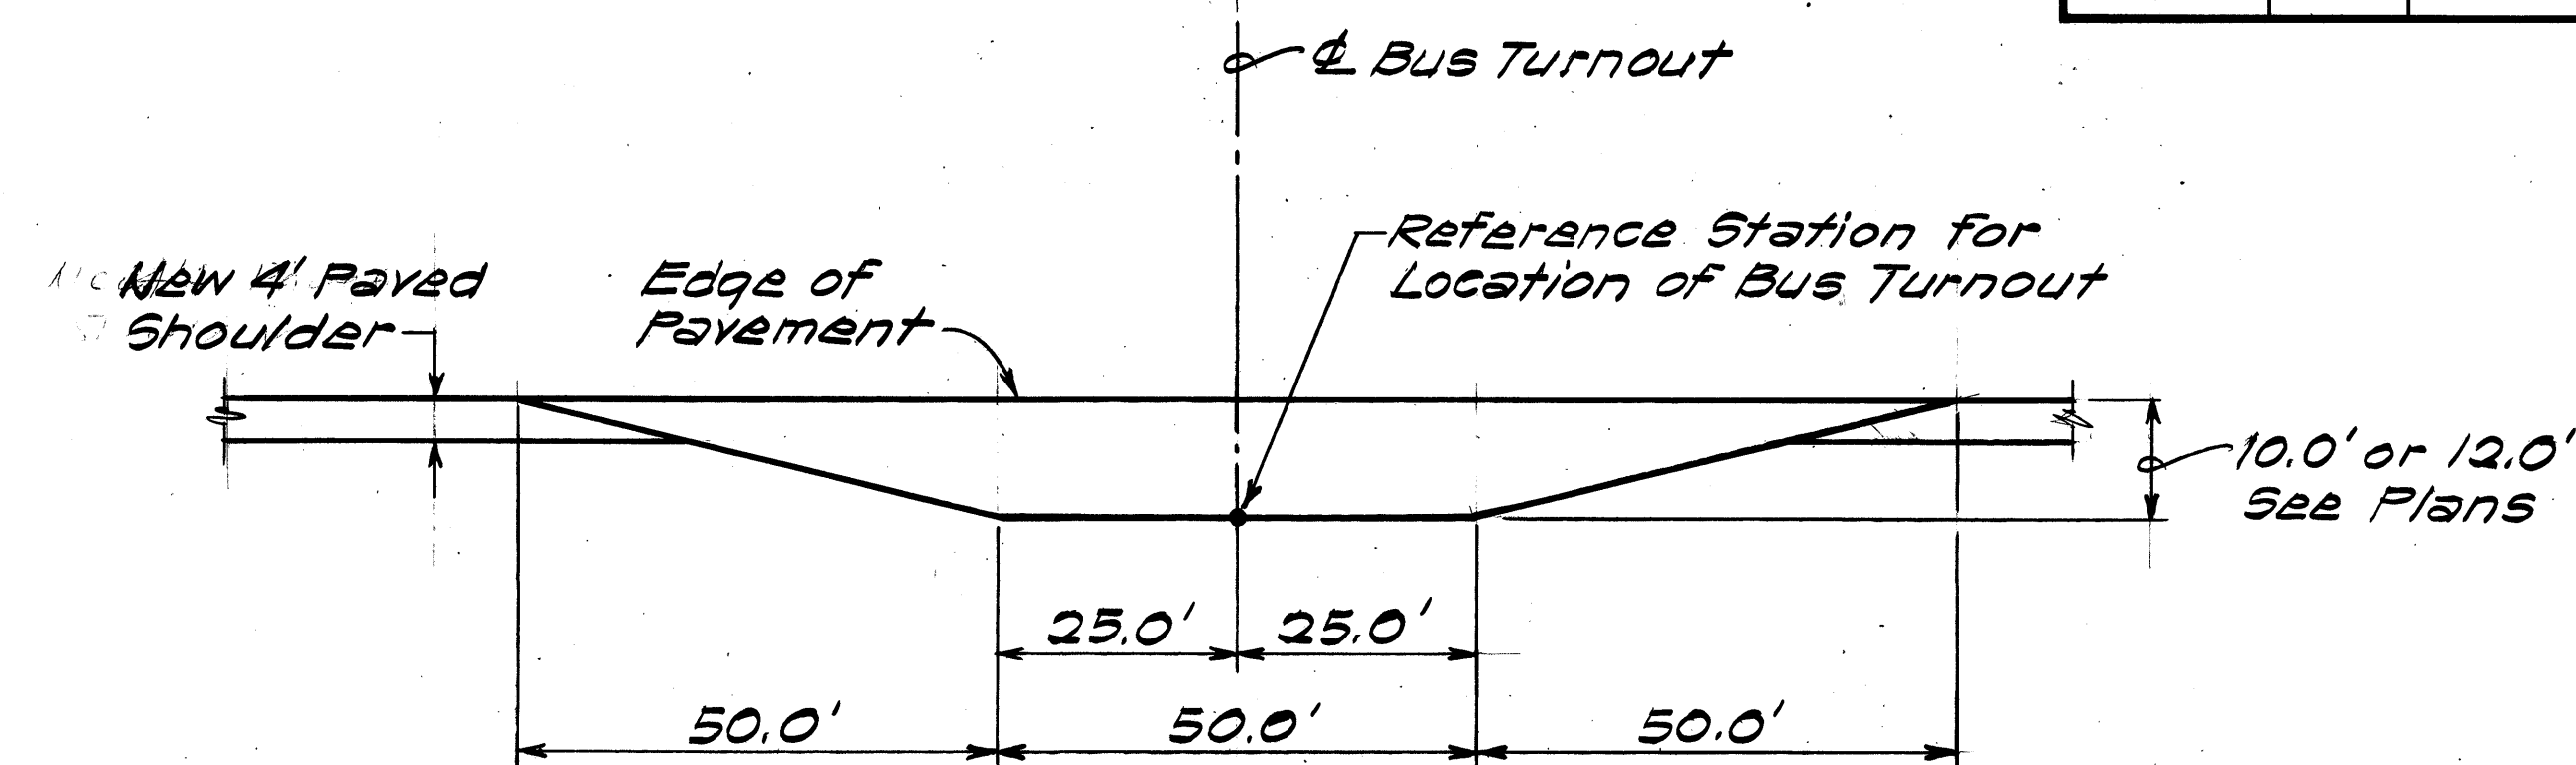

PLAN - BUS TURNOUT
Scale: 1" = 20'

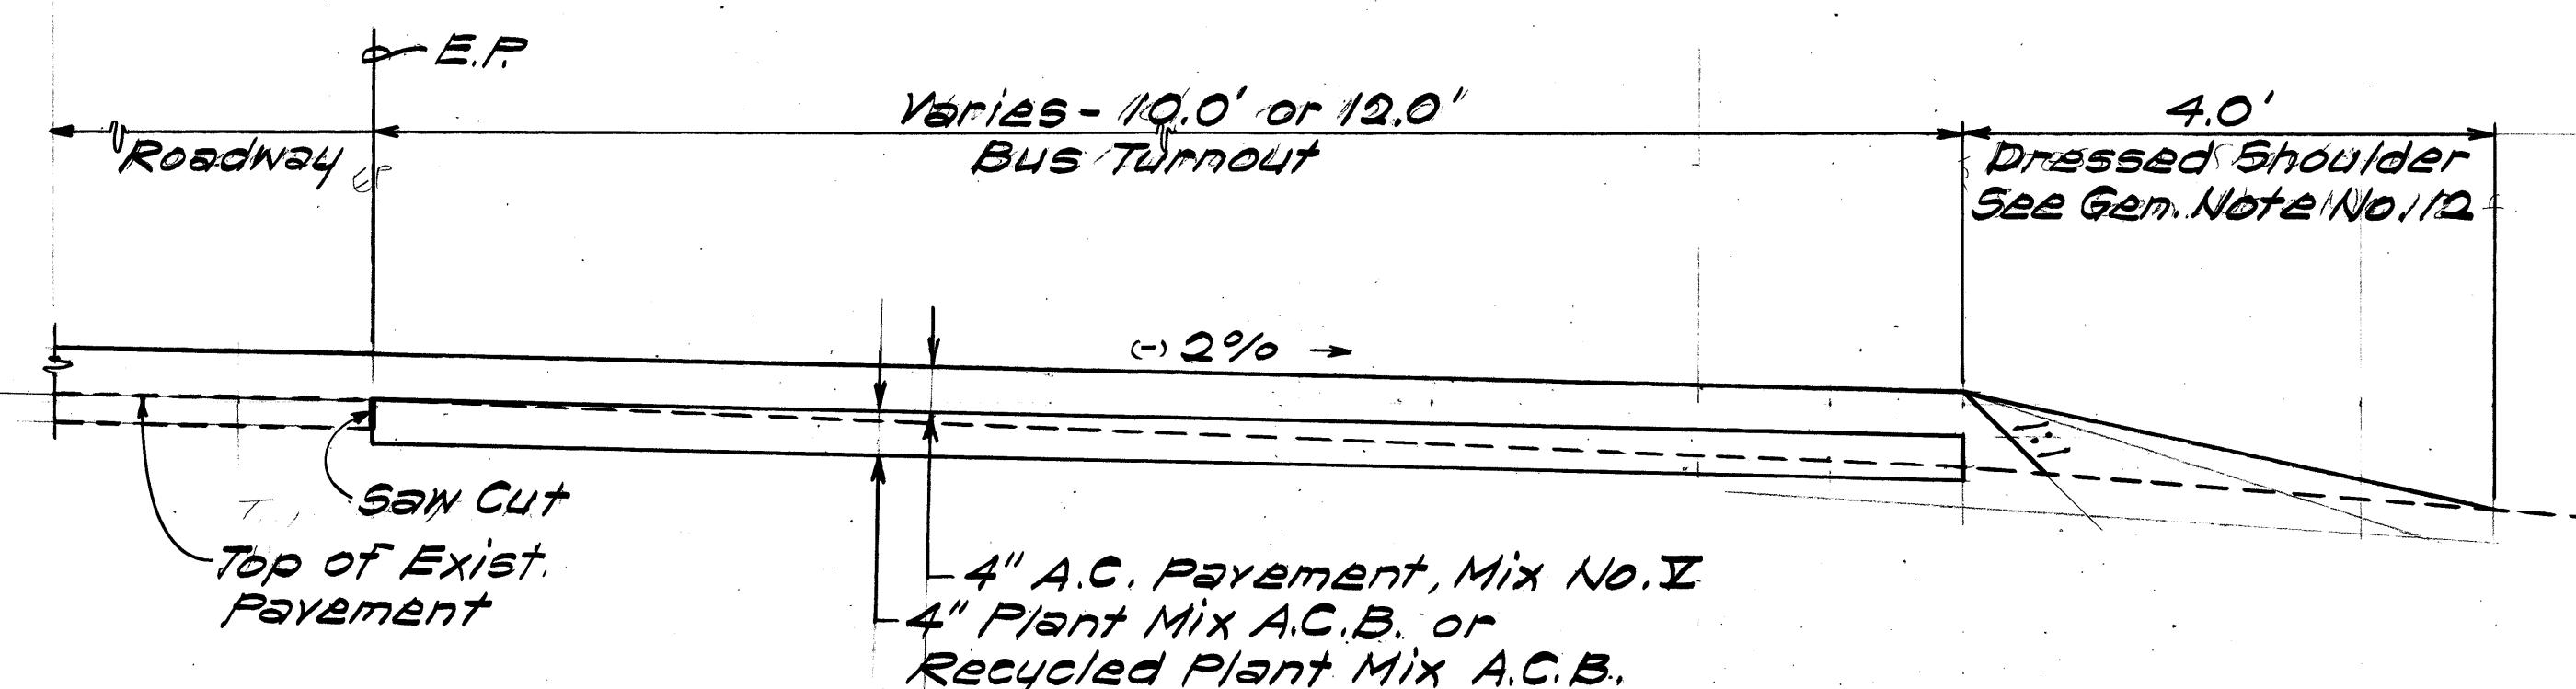

TYPICAL PAVEMENT SECTION AT BUS TURNOUT
STA. 5+00 TO # STA. 18+75
Scale: 3/4" = 1'-0"

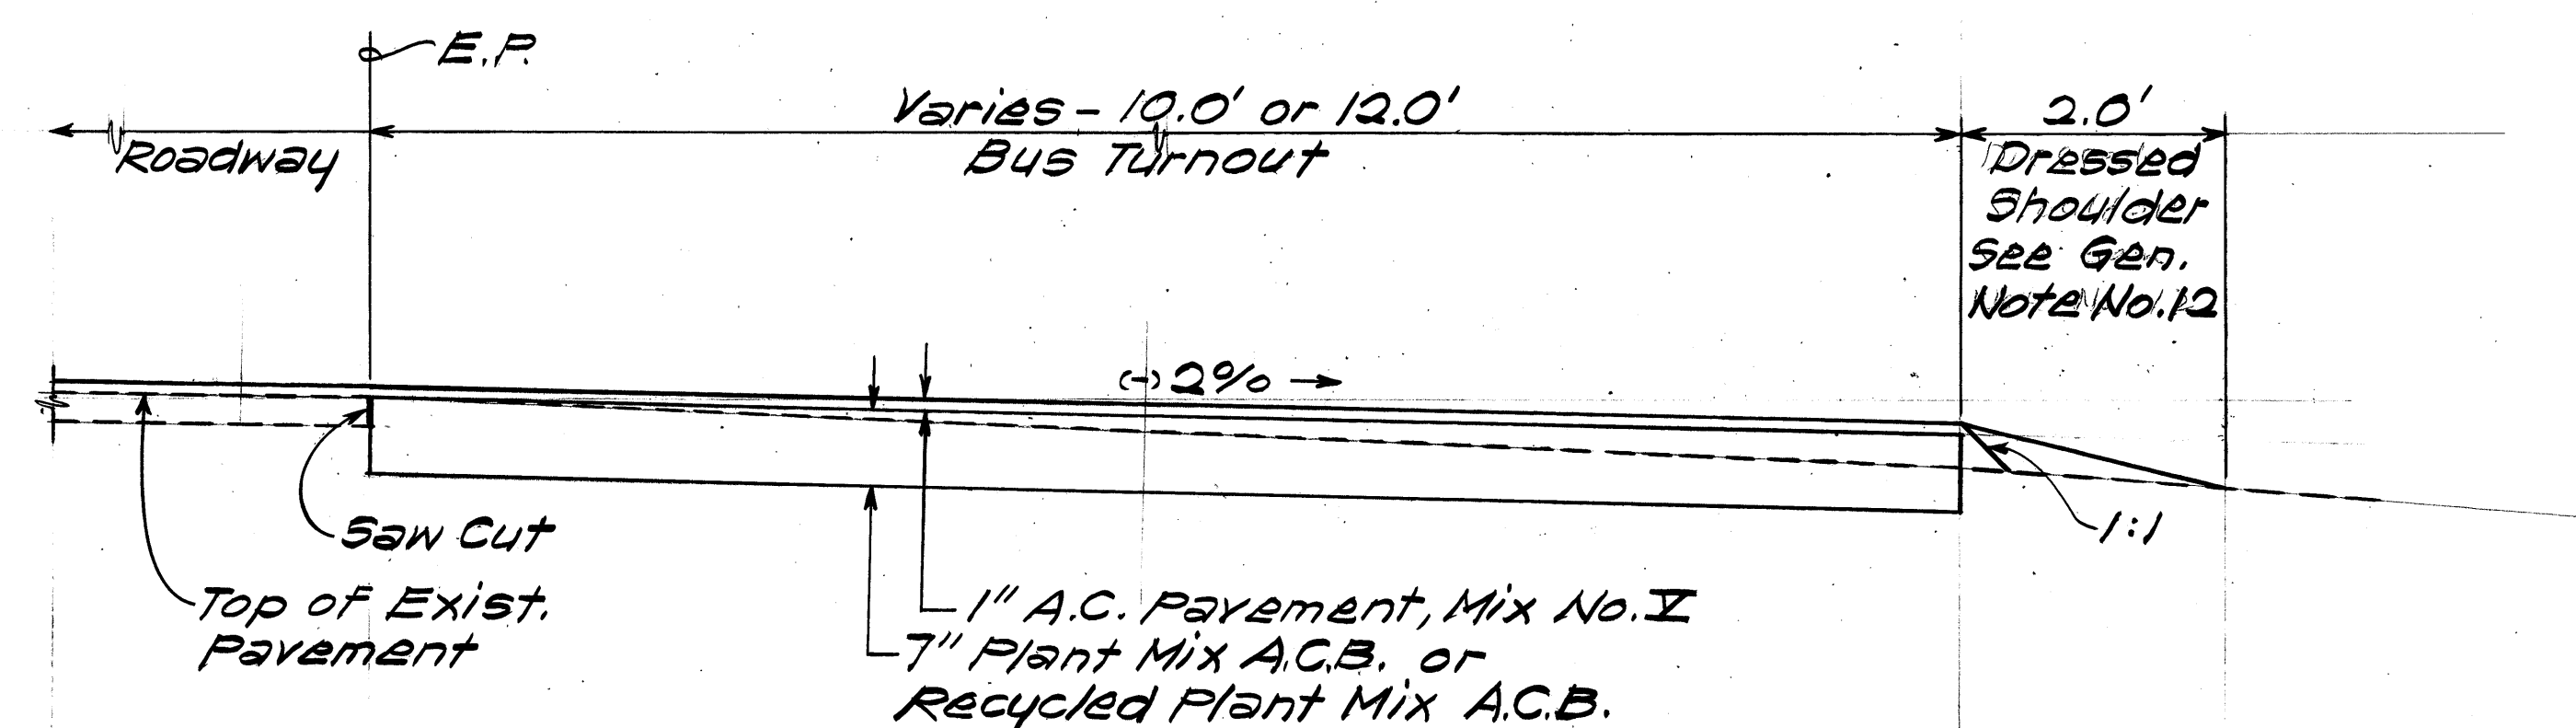

TYPICAL PAVEMENT SECTION AT BUS TURNOUT
STA. 19+50 TO # STA. 38+00
Scale: 3/4" = 1'-0"

STATE OF HAWAII
DEPARTMENT OF TRANSPORTATION
HIGHWAYS DIVISION

TYPICAL SECTIONS & DETAILS

PUULOLOA ROAD RESURFACING
VICINITY OF KILIHAI TO PUKOLOLOA
Project No. 6600A-01-84M
Scale: As Shown Date: Apr, 1984

SHEET No. 2 OF 2 SHEETS