


FED. ROAD DIST. NO.	STATE	PROJ. NO.	FISCAL YEAR	SHEET NO.	TOTAL SHEETS
HAWAII	HAW.	HWY-0-02-97	1998	6	8

Sta. 4+18± o/s 29± Lt.
 # Sta. 4+72± o/s 33± Lt.
 # Sta. 5+31± o/s 33± Lt.
 # Sta. 4+38± o/s 39± Rt.
 # Sta. 5+12± o/s 38± Rt.
 # Sta. 5+68± o/s 38± Rt.
 Install: Deck Drain Downspout

Estimated Quantities
 Deck Drain Downspout (227 L.F.) Lump Sum

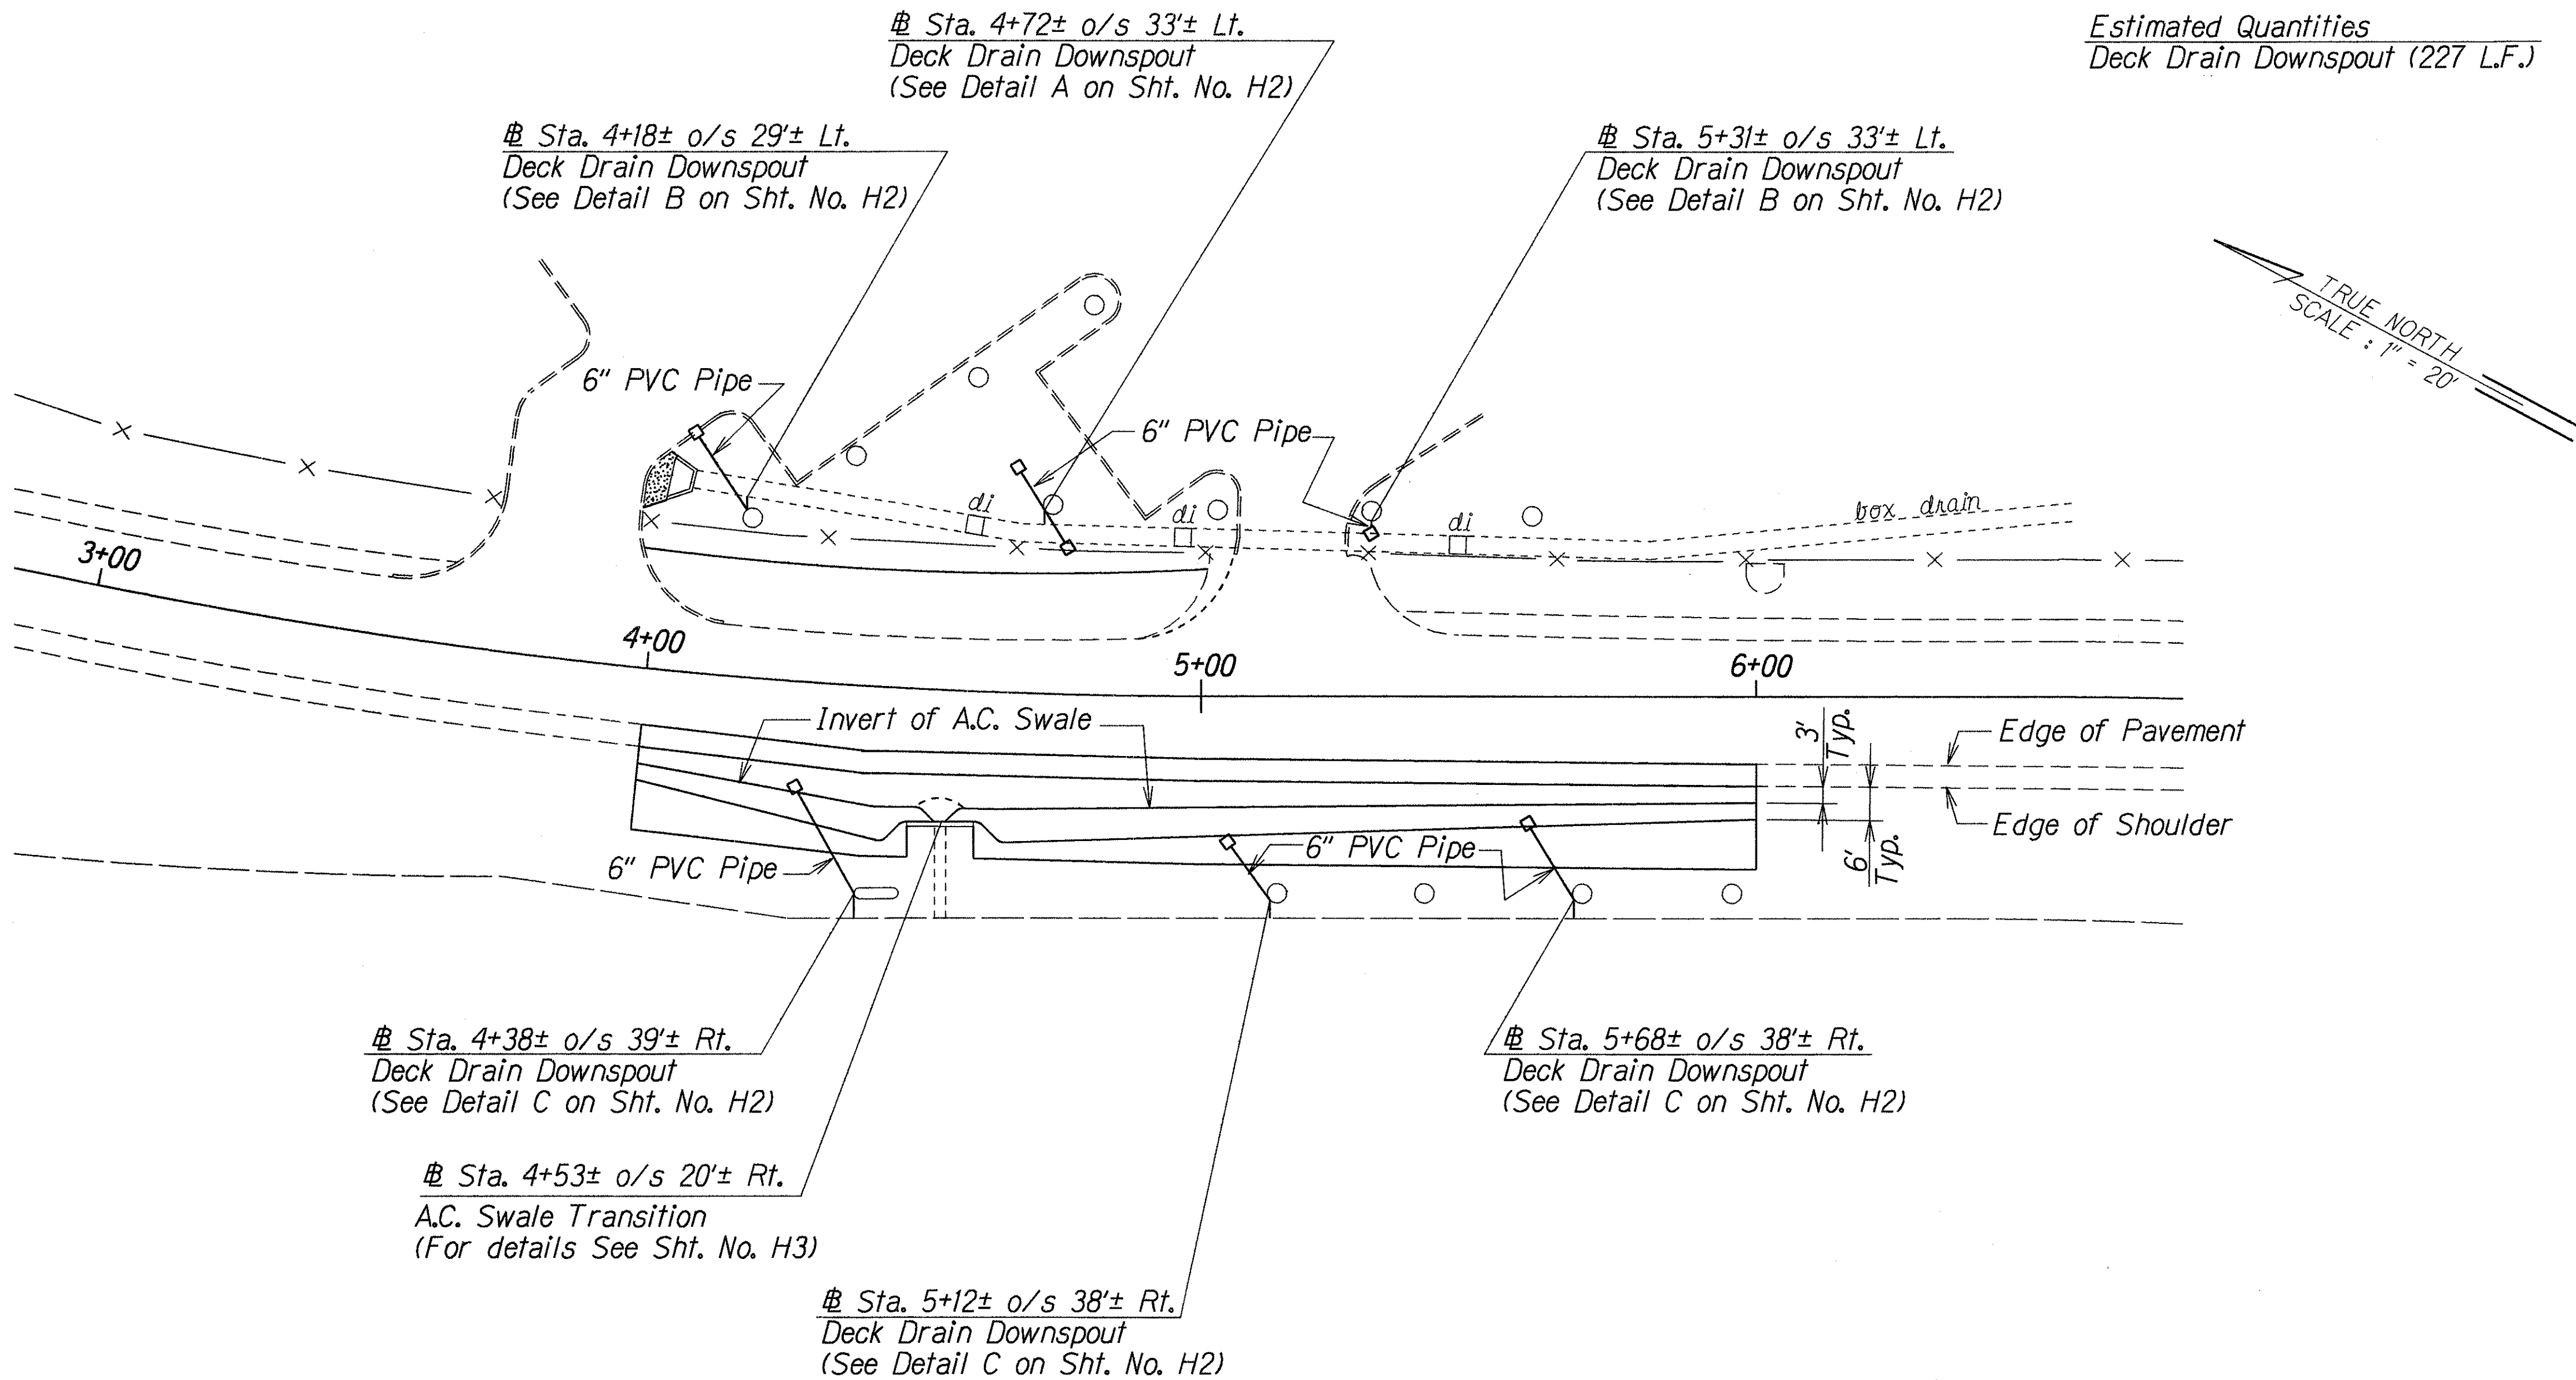

ORIGINAL PLAN	SURVEY PLOTTED BY	DATE
NOTE BOOK	DRAWN BY A. Nomura & R. Sato	5/13/97
DESIGNED BY B. Sakamoto		
CHECKED BY		

LEGEND FOR AS-BUILT POSTINGS	
	Squiggly line for as-built deletion
	Double line for as-built deletion
Roadway	Text for as-built posting

STATE OF HAWAII
 DEPARTMENT OF TRANSPORTATION
 HIGHWAYS DIVISION

DRAINAGE PLAN

PUULOA ROAD
 Park Road Shoulder Improvements
 Project No. HWY-0-02-97

Scale: 1"=20' Date: July 1997

SHEET No. HI OF 3 SHEETS