
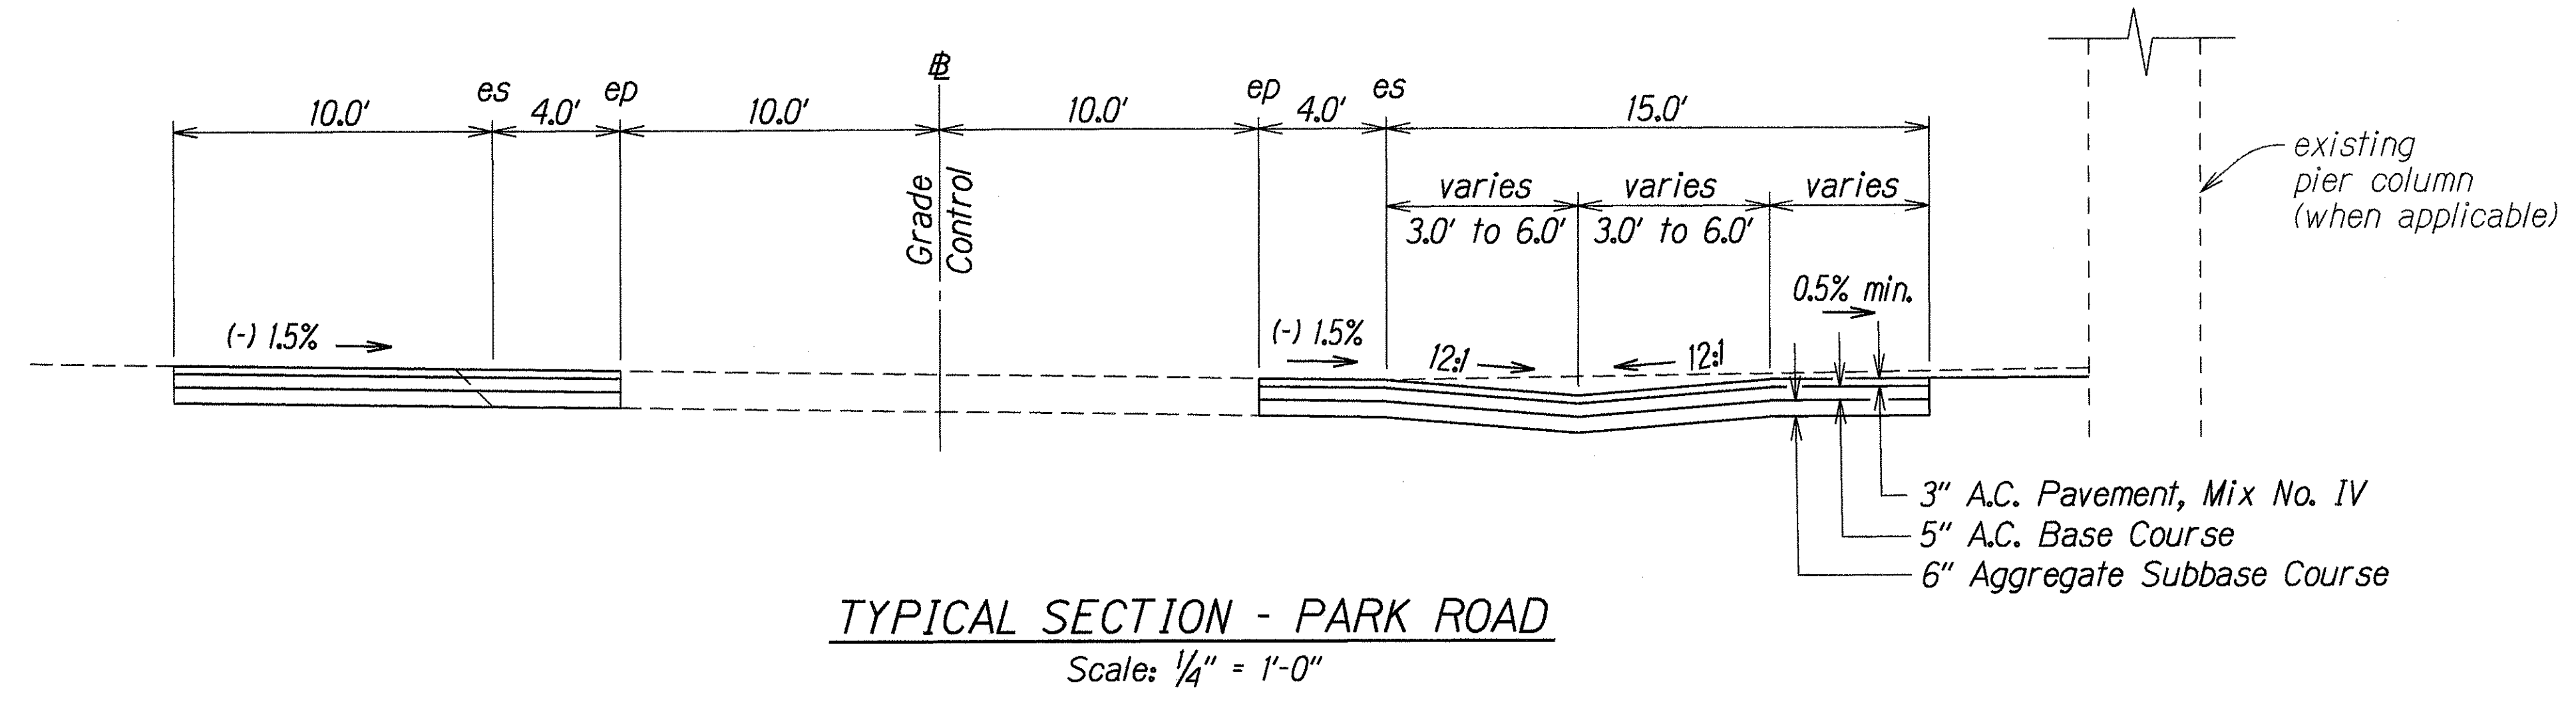


FED. ROAD DIST. NO.	STATE	PROJ. NO.	FISCAL YEAR	SHEET NO.	TOTAL SHEETS
HAWAII	HAW.	HWY-0-02-97	1998	5	8

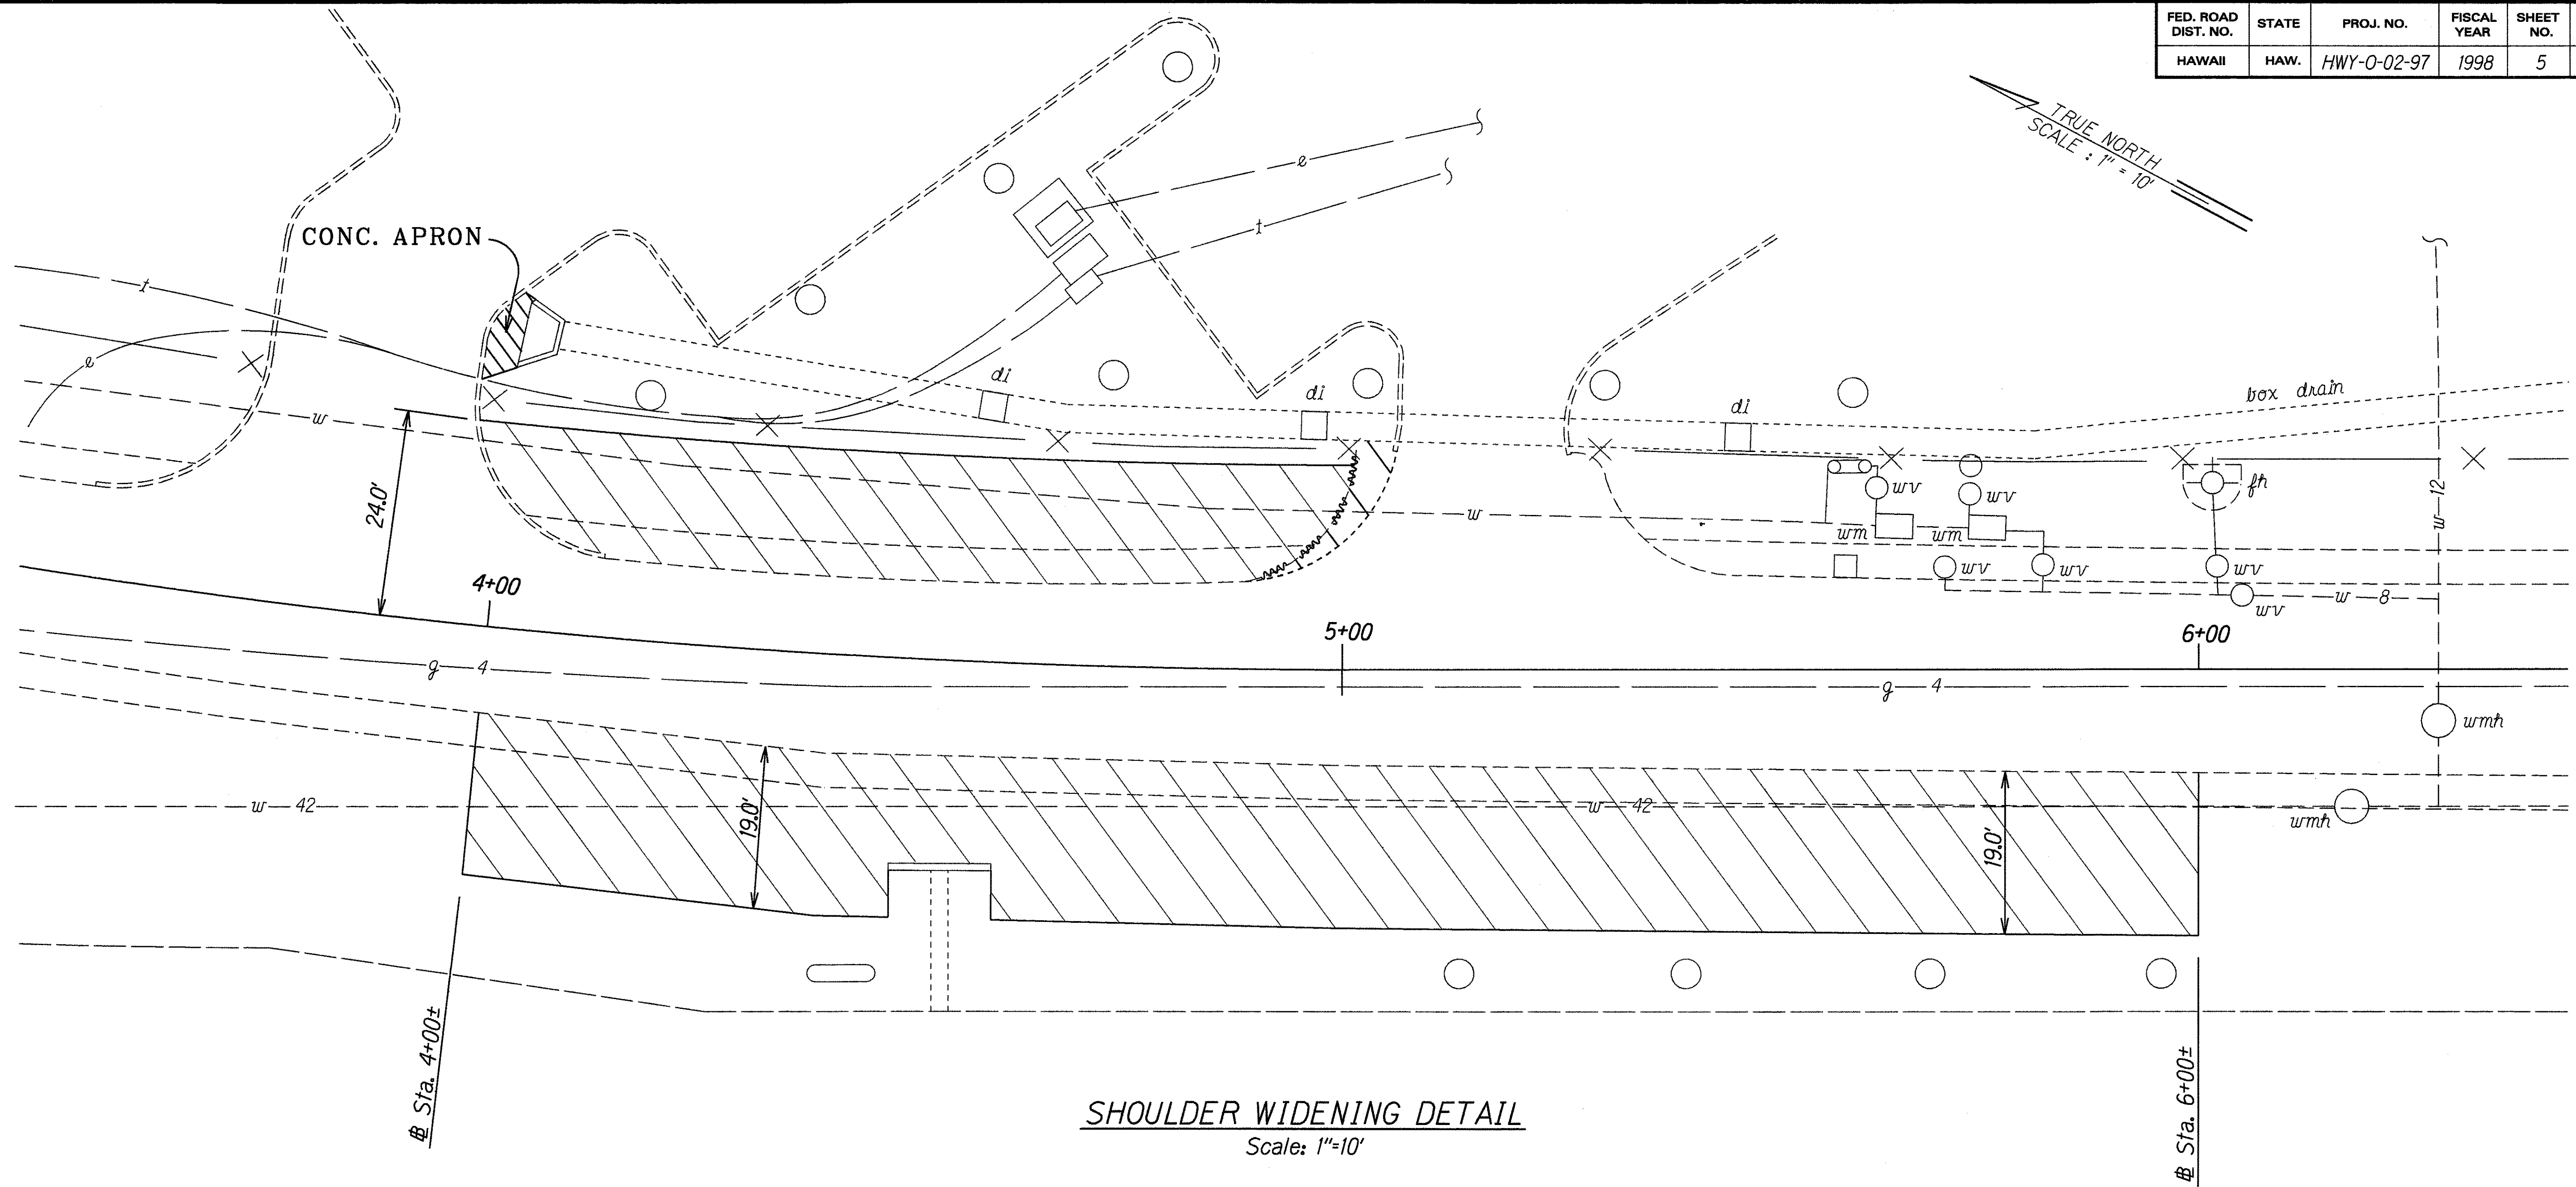

LEGEND FOR AS-BUILT POSTINGS	
	Squiggly line for as-built deletion
	Double line for as-built deletion
Roadway	Text for as-built posting

STATE OF HAWAII
DEPARTMENT OF TRANSPORTATION
HIGHWAYS DIVISION

PAVING DETAIL & TYPICAL SECTION

PUULOA ROAD
Park Road Shoulder Improvements
Project No. HWY-0-02-97

Scale: As Shown Date: Feb., 1997
SHEET No. 1 OF 1 SHEETS

SURVEY PLOTTED BY	DATE
DRAWN BY J. Matsunami	12-30-97
DESIGNED BY C. Yamasaki	
CHECKED BY S. Pundit	
ORIGINAL PLAN	
NOTE BOOK	
004, 000	
004, 000	
004, 000	

"AS-BUILT"