


FED. ROAD DIST. NO.	STATE	PROJ. NO.	FISCAL YEAR	SHEET NO.	TOTAL SHEETS
HAWAII	HAW.	HWY-0-02-97	1998	4	8

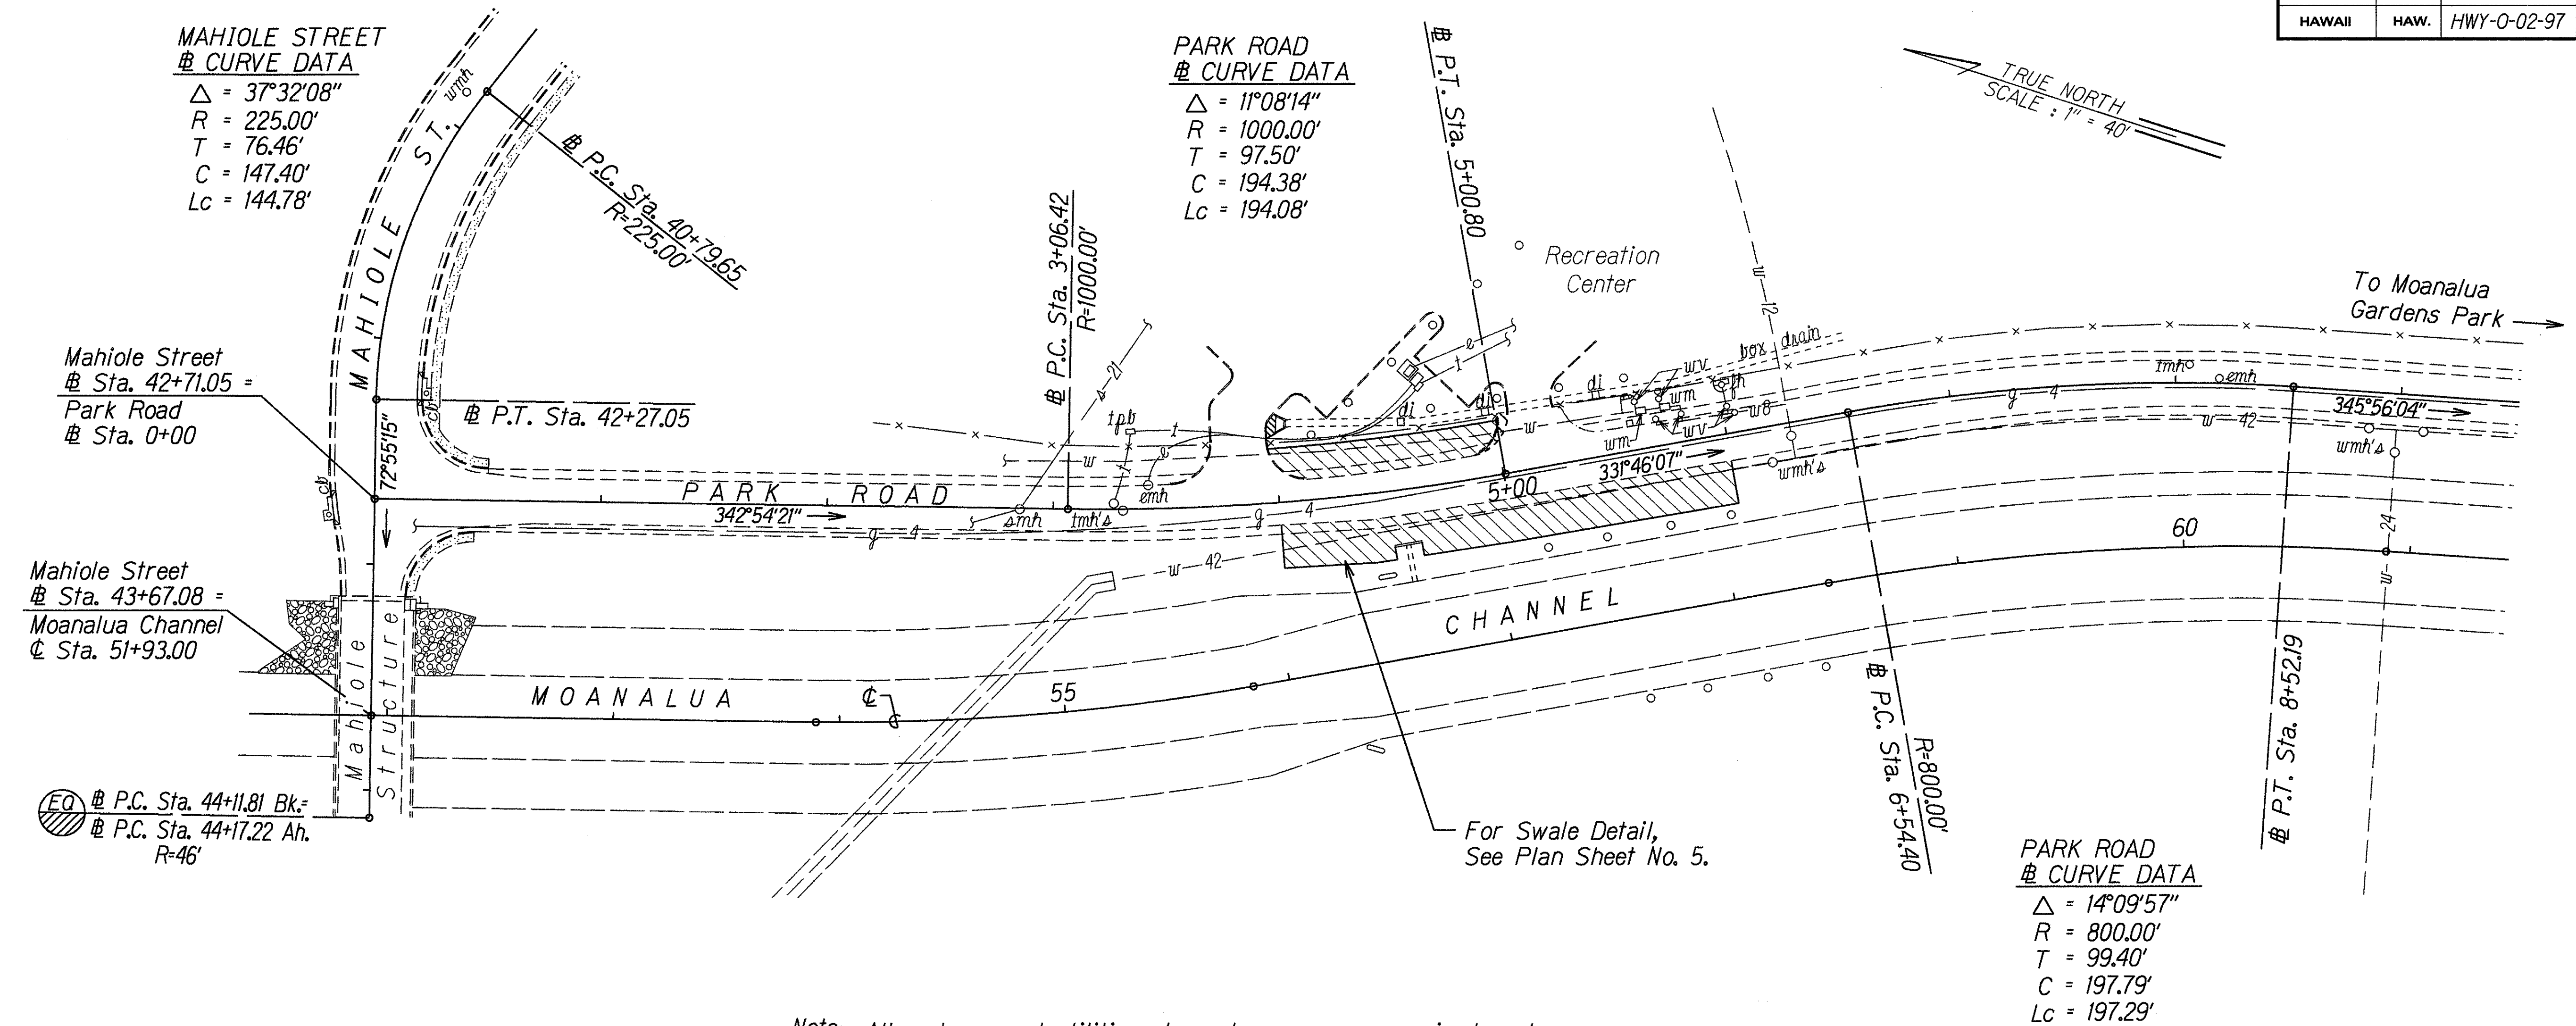

LEGEND

- New Shoulder Area
- Existing Electric Manhole
- Existing Electric Line
- Existing Telephone Manhole
- Existing Telephone Pullbox
- Existing Telephone Line
- Existing Water Manhole
- Existing Water Valve Box
- Existing Water Meter
- Existing Fire Hydrant
- Existing 42" Water Line
- Existing Sewer Manhole
- Existing 21" Sewer Line
- Existing 4" Gas Line
- Existing Catch Basin
- Existing Drop Inlet
- Existing Pier Column
- Existing Fence

Note: All underground utilities shown hereon are approximate only. The Contractor shall be responsible for locating exact locations of all underground utilities prior to beginning road excavation and/or trenching operations.

LEGEND FOR AS-BUILT POSTINGS	
	Squiggly line for as-built deletion
	Double line for as-built deletion
Roadway	Text for as-built posting

STATE OF HAWAII
DEPARTMENT OF TRANSPORTATION
HIGHWAYS DIVISION

ROADWAY PLAN AND LEGEND

PUULOA ROAD
Park Road Shoulder Improvements
Project No. HWY-0-02-97

Scale: As Shown Date: Feb., 1997
SHEET No. 1 OF 1 SHEETS

ORIGINAL PLAN	DATE
SURVEY PLOTTED BY	11-30-97
DRAWN BY	J. Matsunami
NOTED BY	C. Yamasaki
DESIGNED BY	004, jason
CHECKED BY	N. Zoungi

"AS-BUILT"