



PREFIX: G:\DOT\H9601A\Construction\Map\ADDENDUM\
 FILE: CO Sheet 29 Dot96128a.dwg
 CURRENT OPR:
 PREV. OPR:
 BEGIN: 12/01/99
 CURRENT TIME:
 LAST SAVED BY: shu
 LAST MODIFIED: Fri, 30 Mar 2012 - 4:52pm

SURVEY PLOTTED BY	DATE
DRAWN BY	
DESIGNED BY	
QUANTITIES BY	
CHECKED BY	
ORIGINAL PLAN	
NO.	

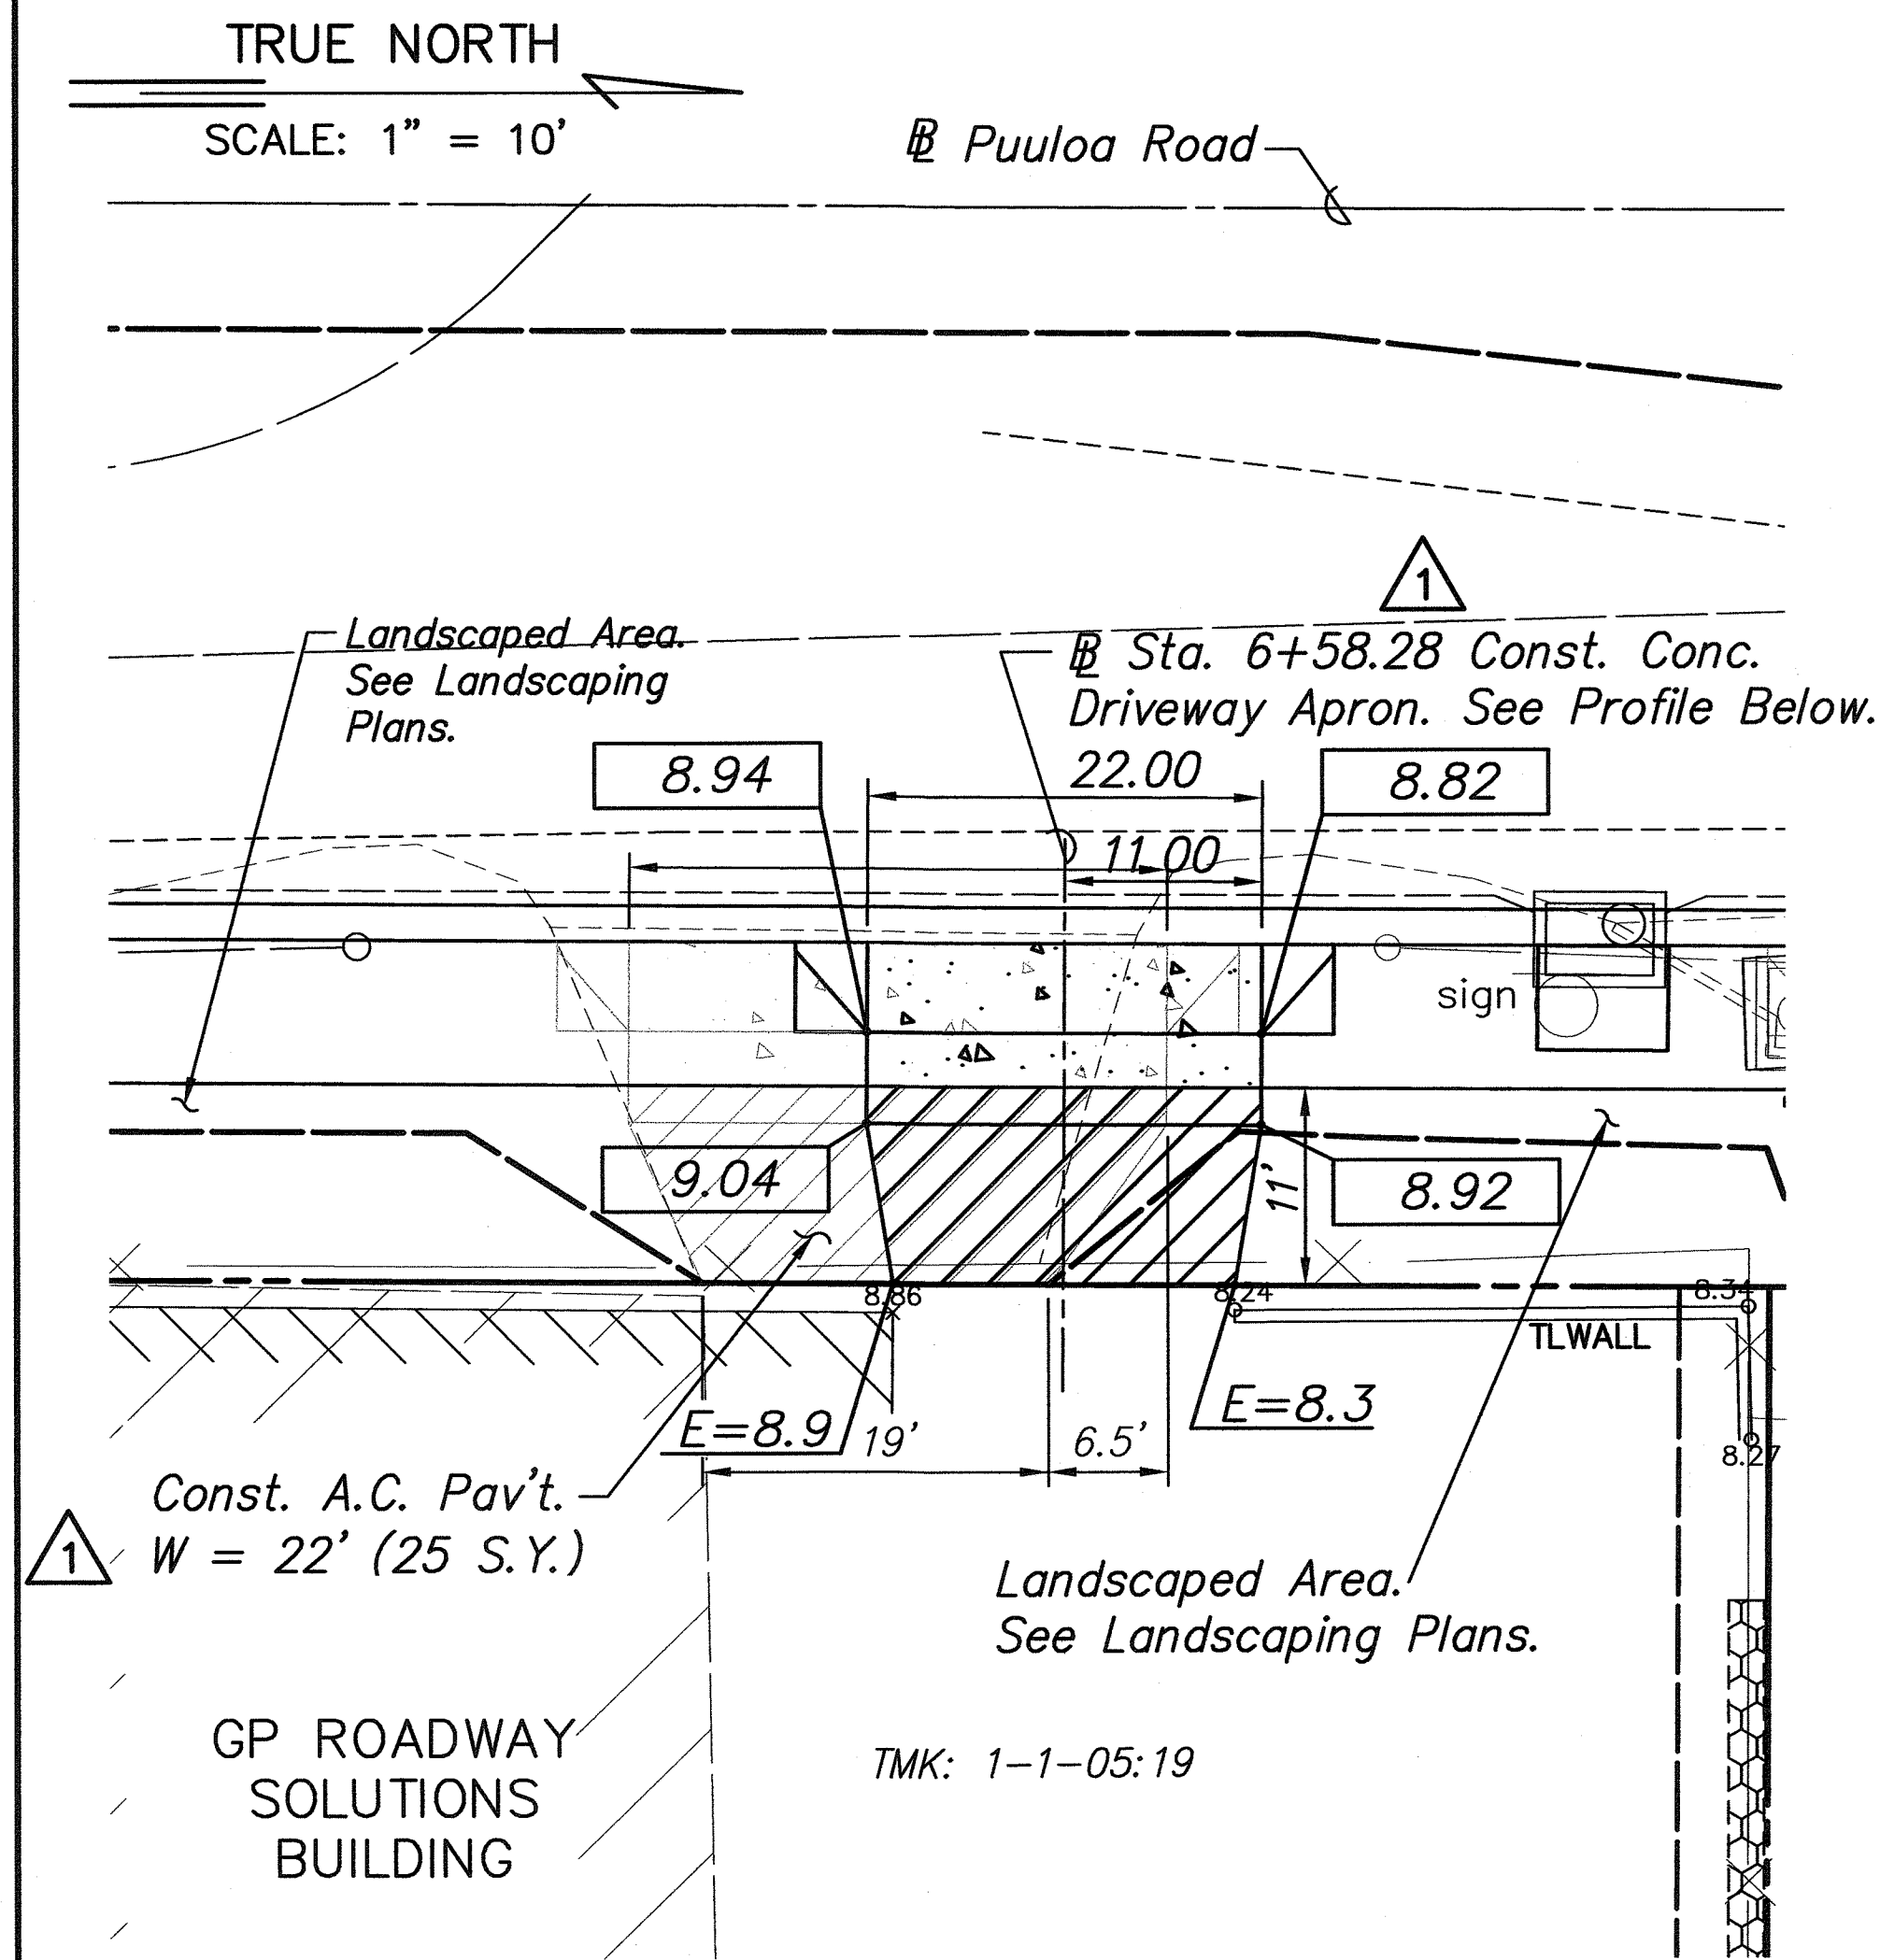


Plan - Sta. 6+58.28 (Right)
Scale: 1" = 10' (Horiz.)

6" Thick Class A Concrete Driveway with 6 x 6 - W2.9 x W2.9 Welded Wire Fabric on 6" Aggregate Subbase Course

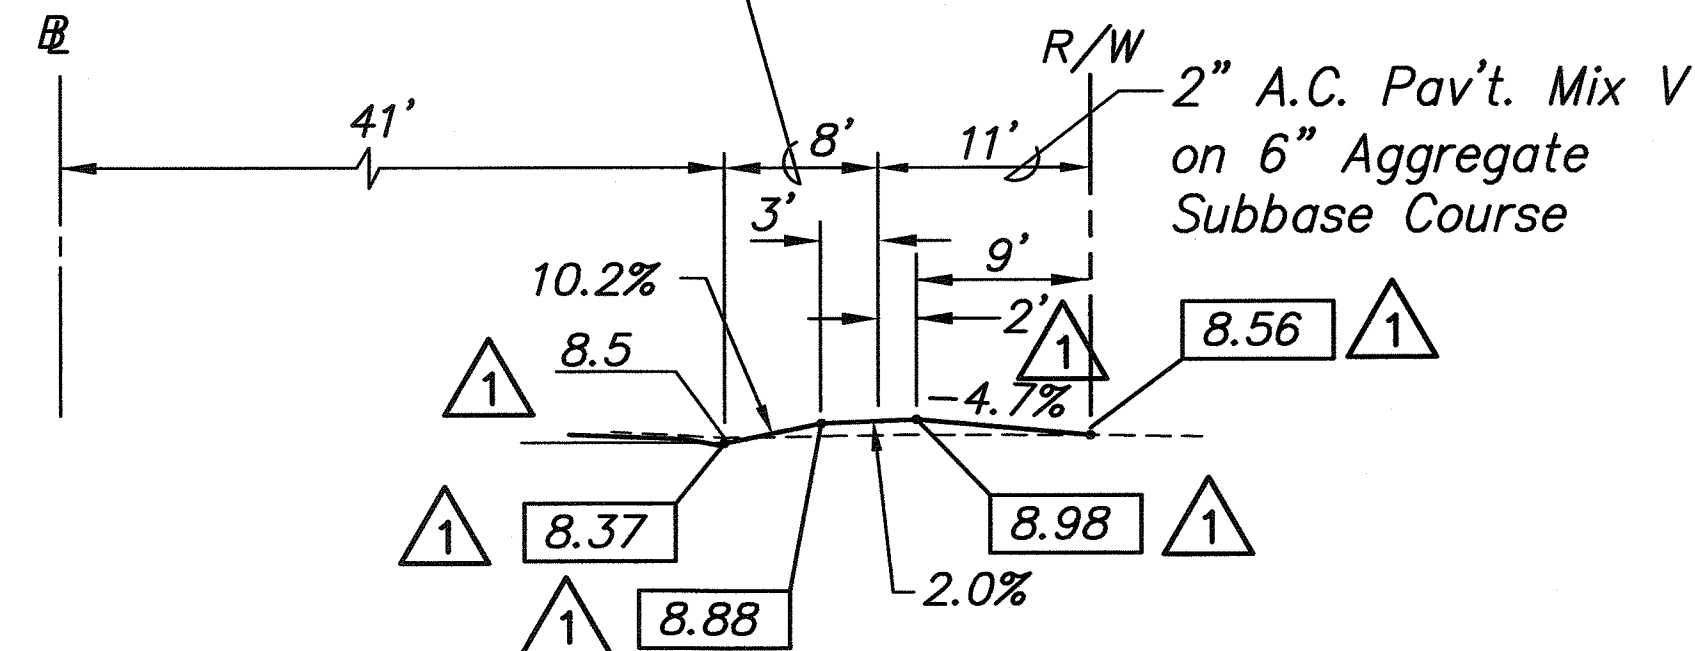


Profile - Sta. 6+58.28 (Right)
Scale: 1" = 10' (Horiz.)
1" = 5' (Vert.)


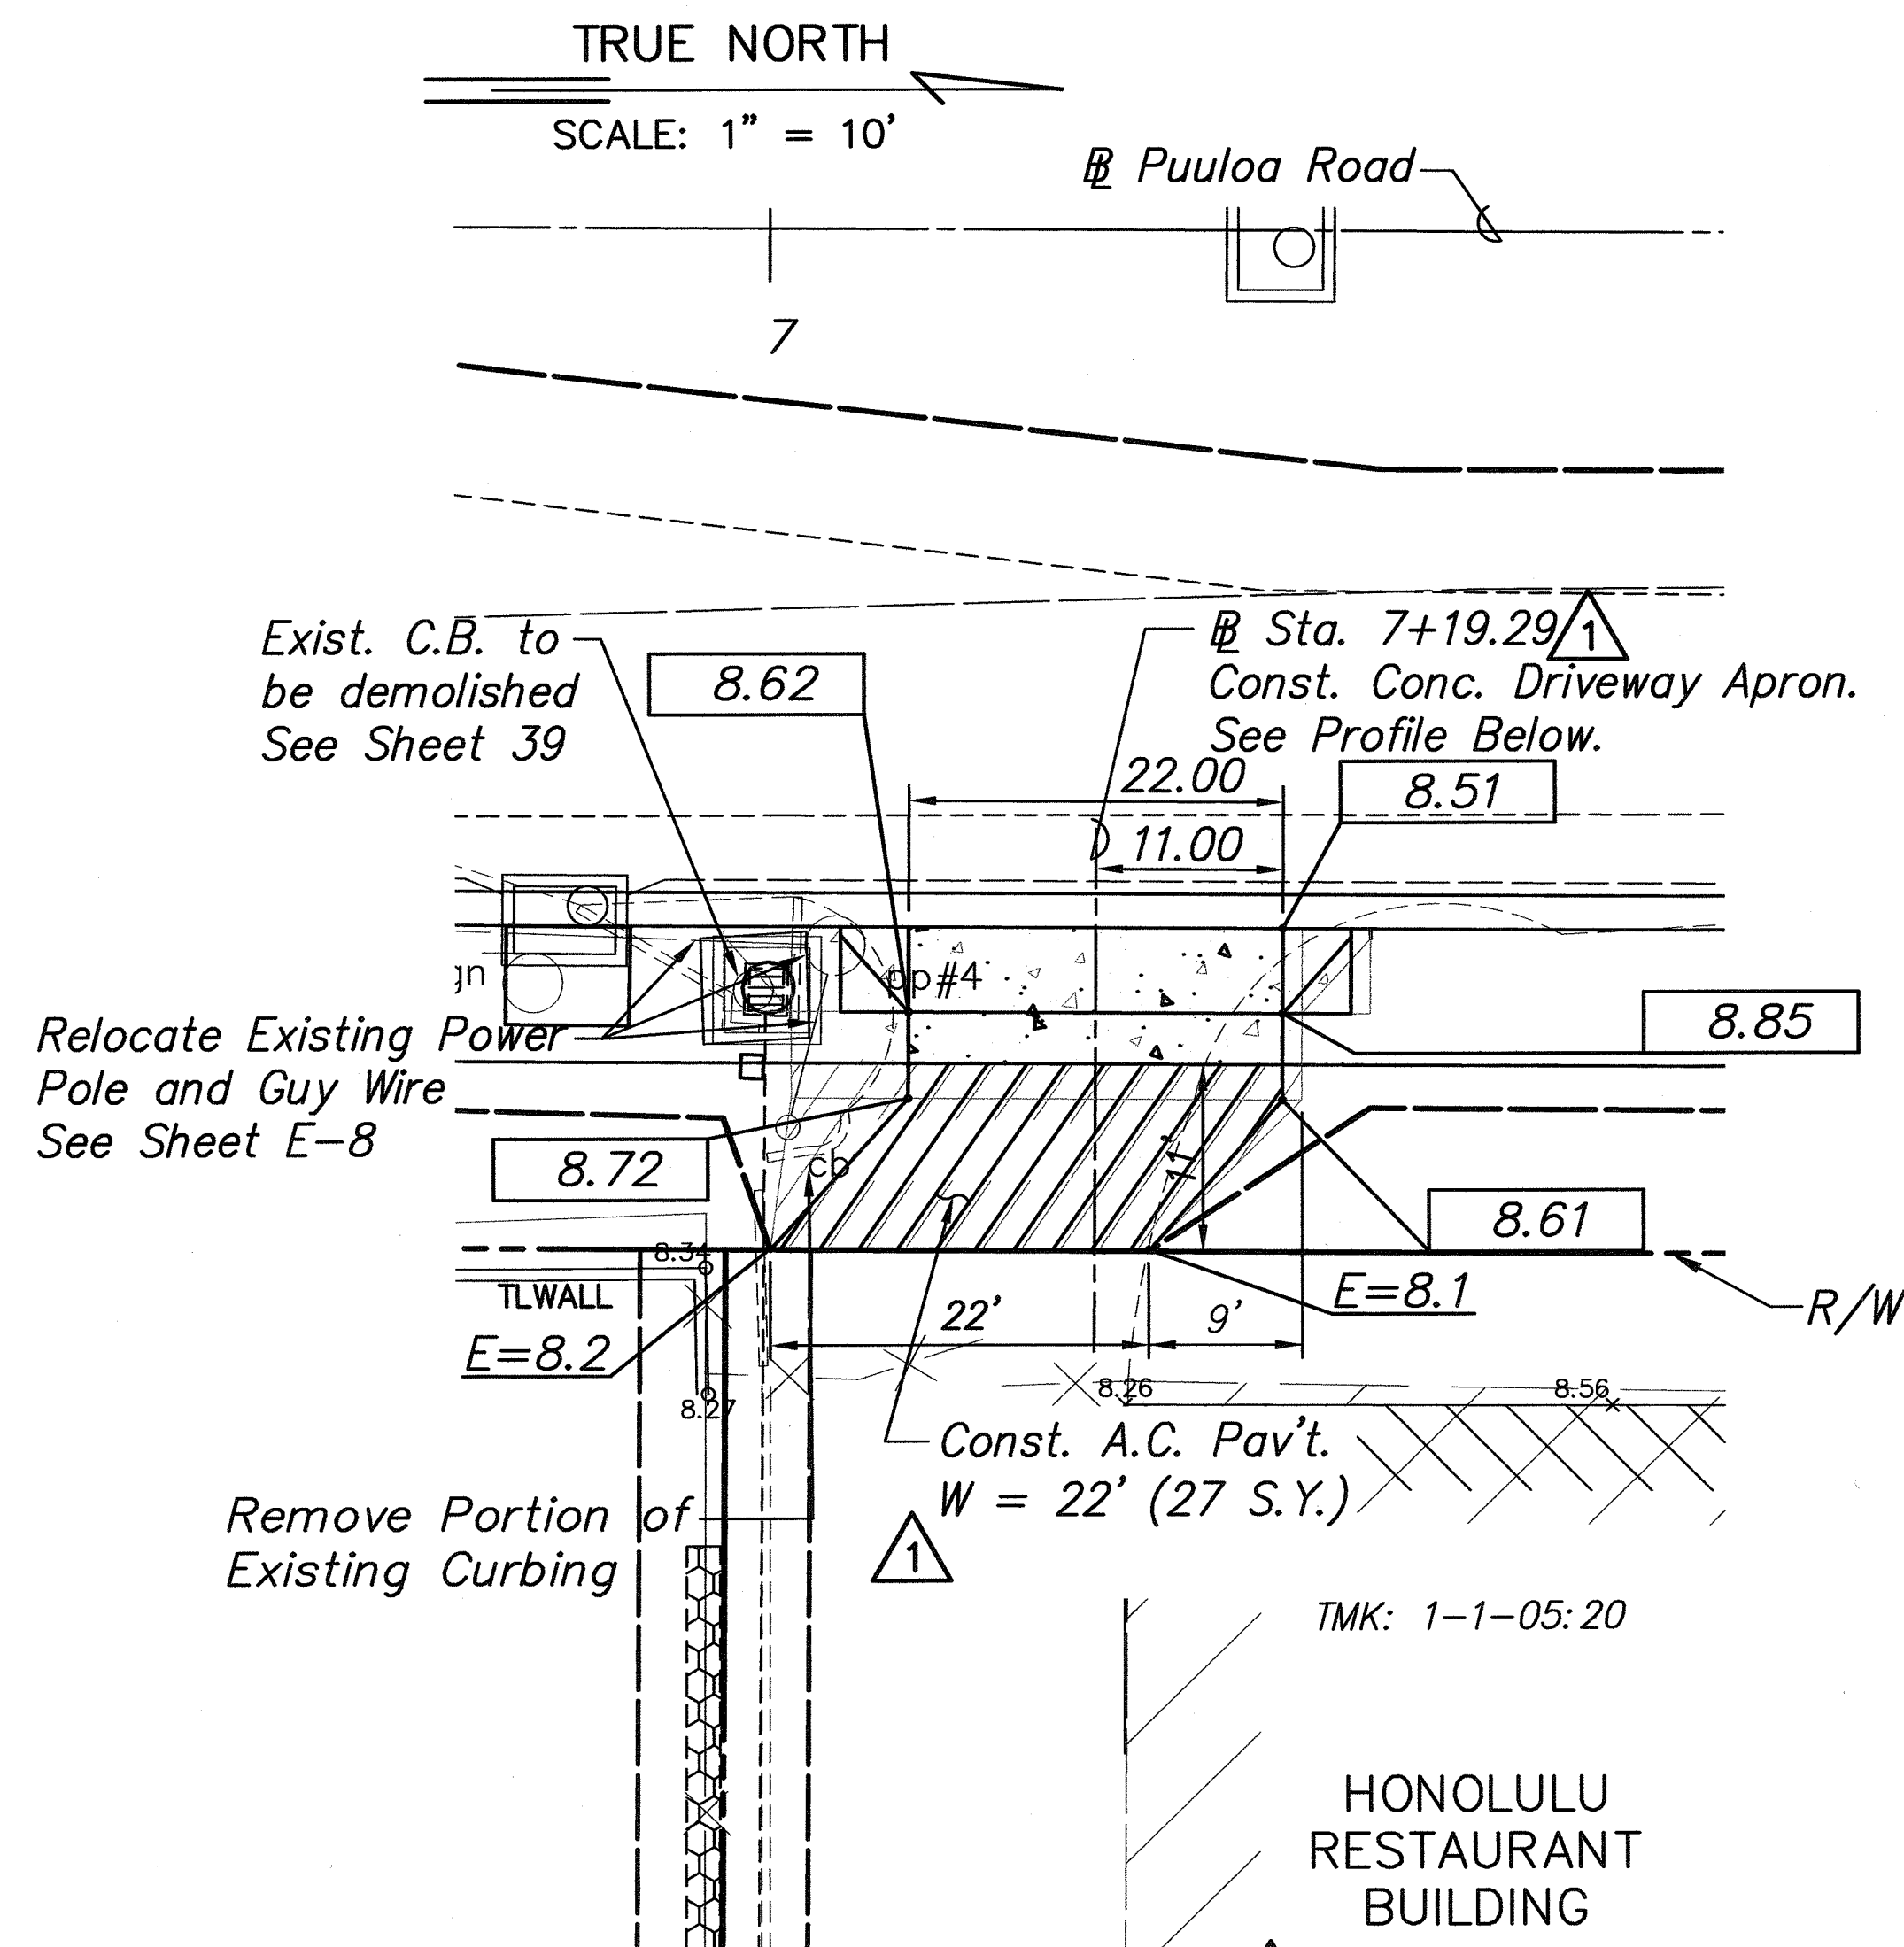


Plan - Sta. 7+19.29 (Right)
Scale: 1" = 10' (Horiz.)

6" Thick Class A Concrete Driveway with 6 x 6 - W2.9 x W2.9 Welded Wire Fabric on 6" Aggregate Subbase Course

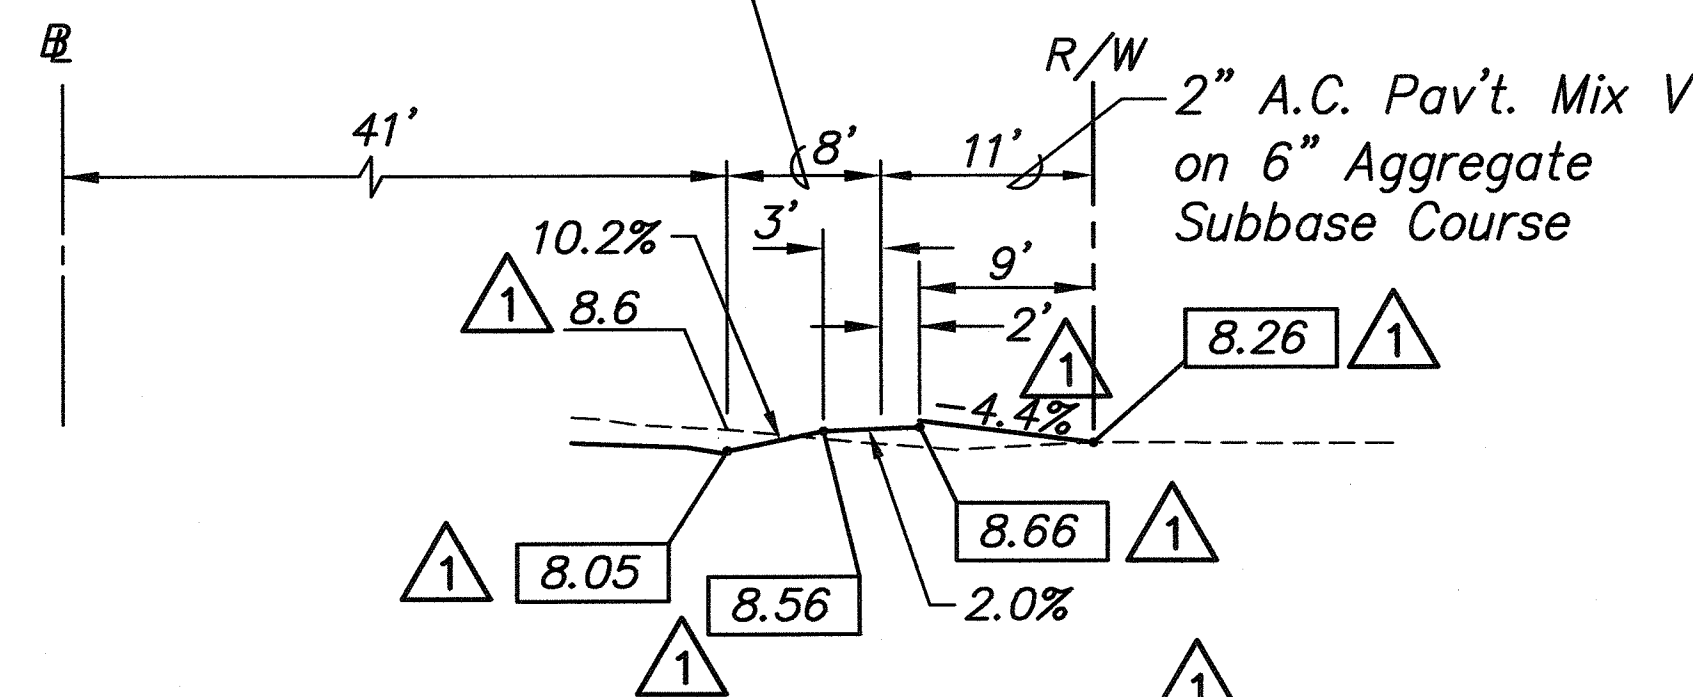

Profile - Sta. 7+19.29 (Right)
Scale: 1" = 10' (Horiz.)
1" = 5' (Vert.)







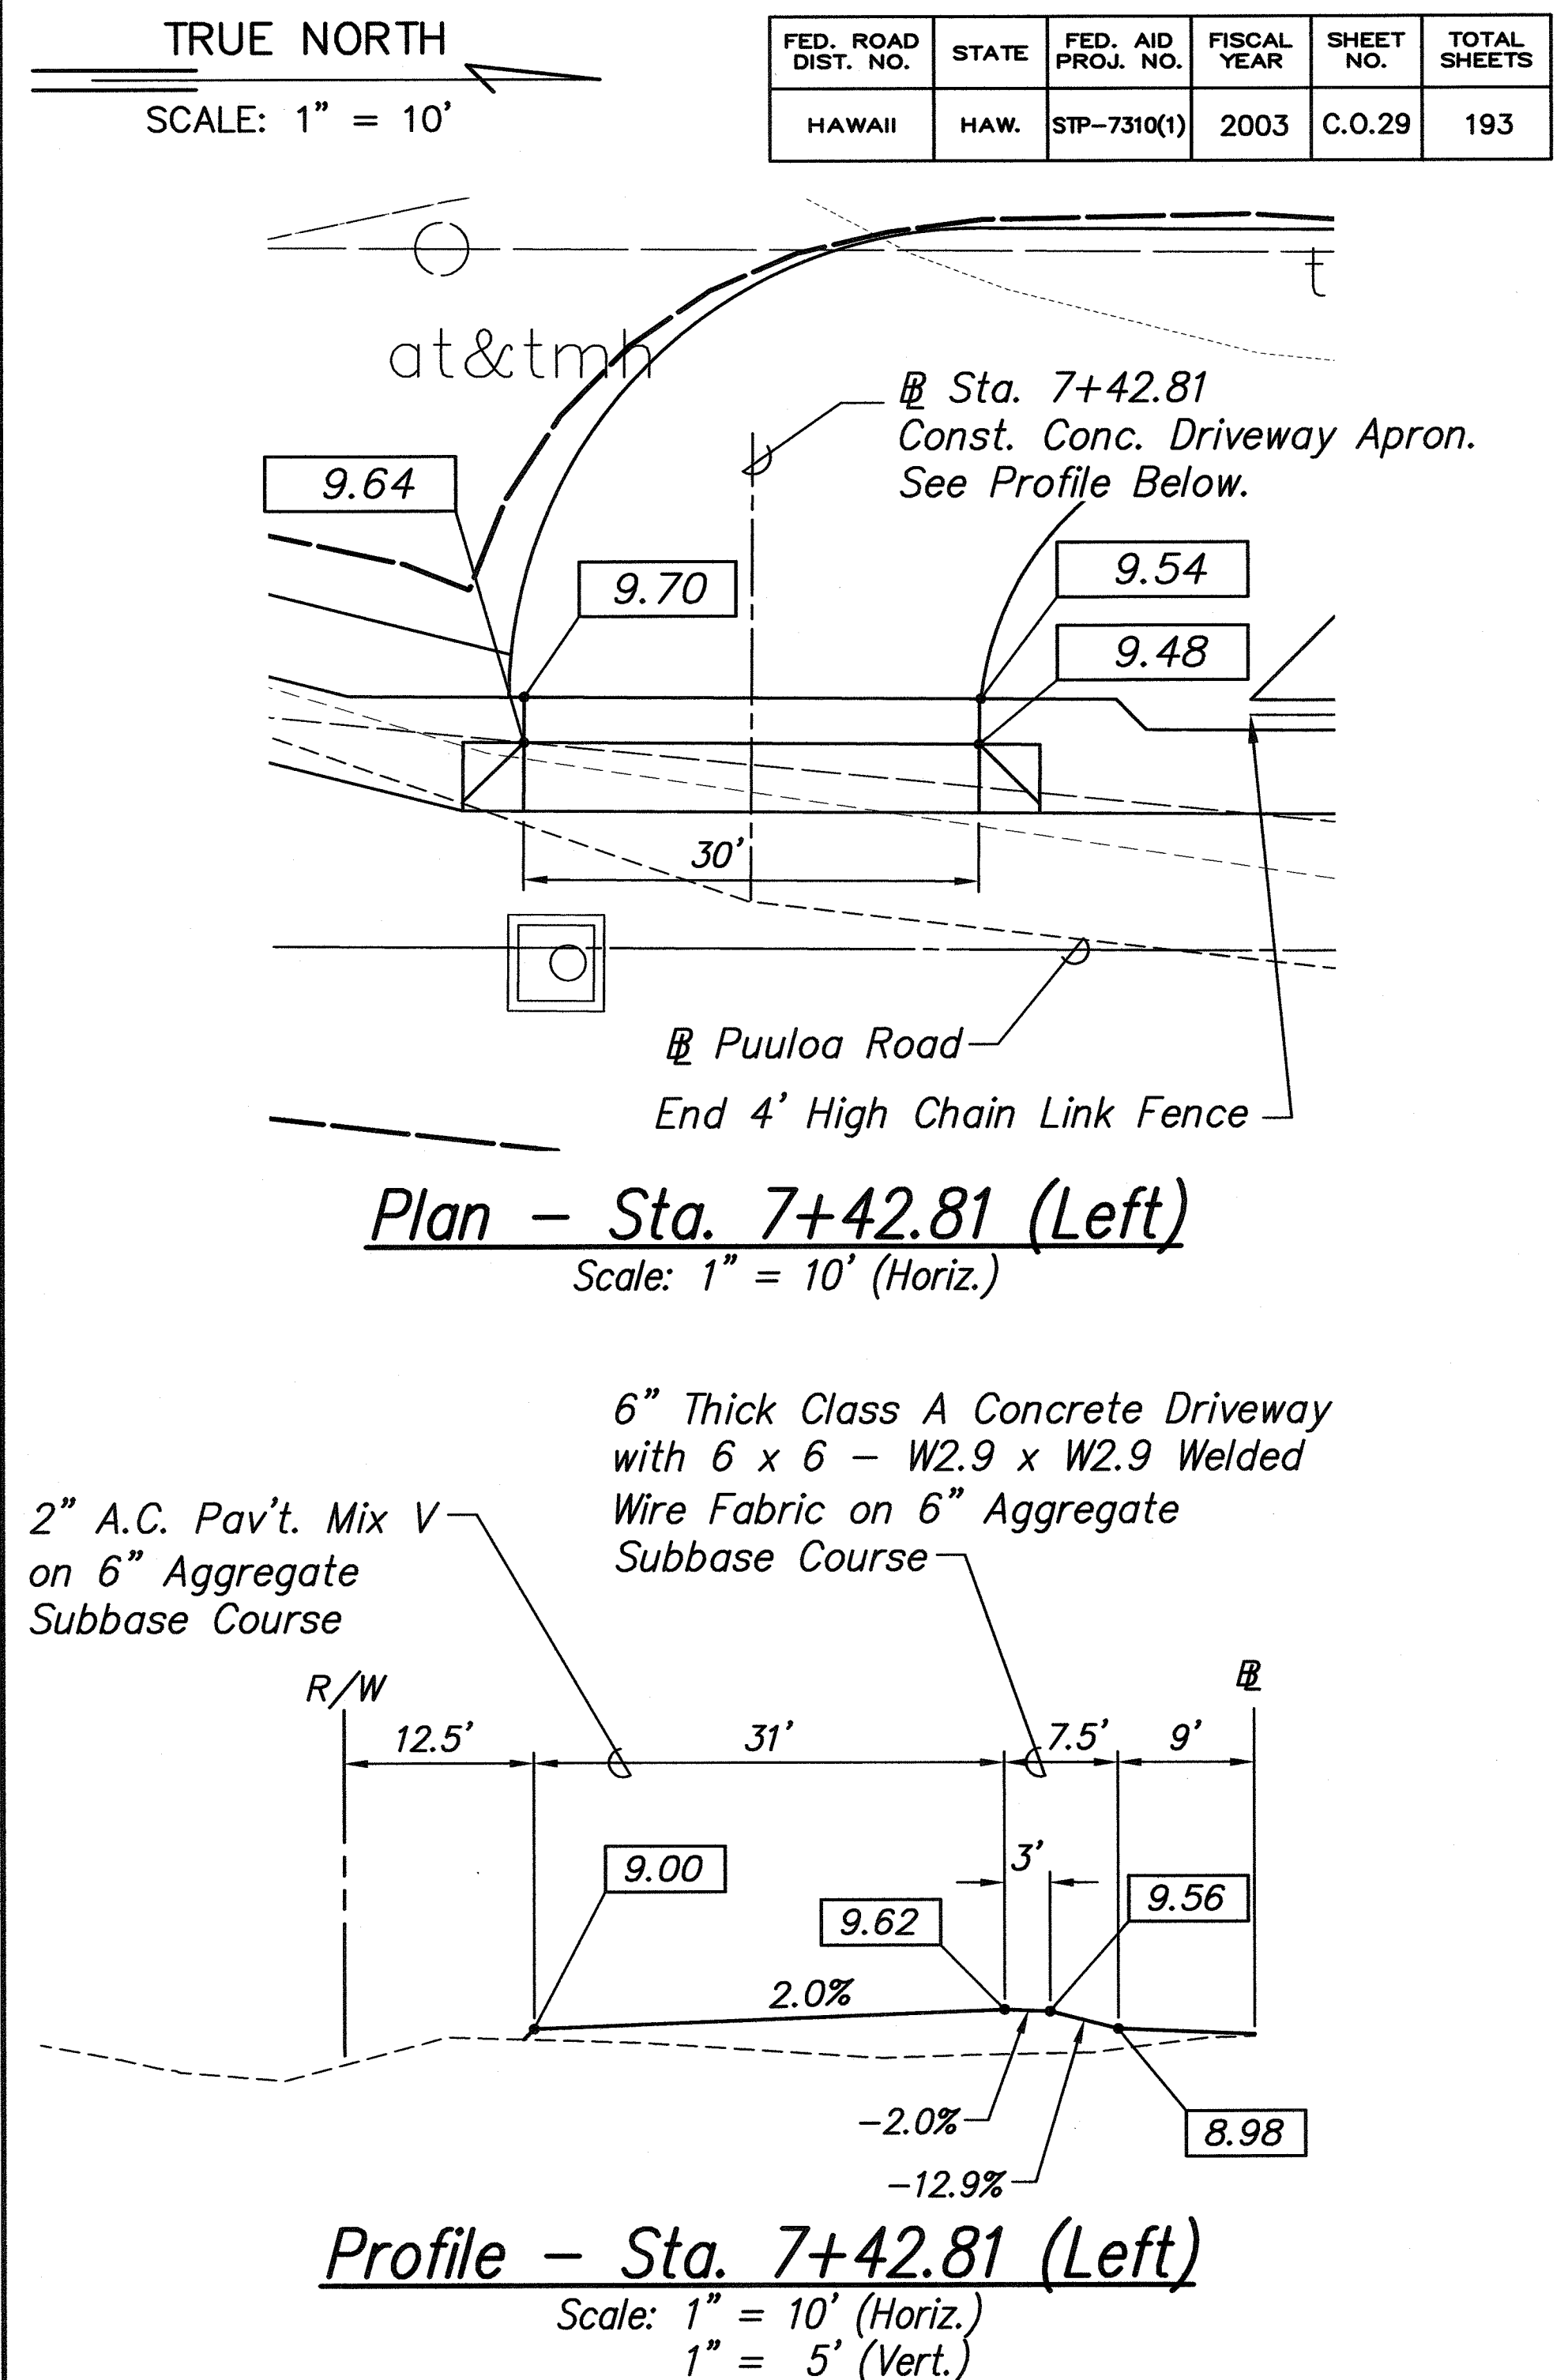
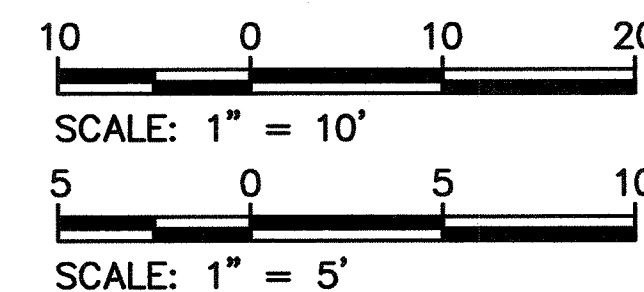


1	12/02/08	Revised curb return grades and stations.	AA
SYMBOL	DATE		BY
KEN C. KAWAHARA LICENSED PROFESSIONAL ENGINEER No. 8148-C HAWAII, U.S.A. THIS WORK WAS PREPARED BY ME OR UNDER MY SUPERVISION. Expiration Date of the License: 04/2011 STATE OF HAWAII DEPARTMENT OF TRANSPORTATION HIGHWAYS DIVISION PROPERTY ADJUSTMENTS STA. 6+49 TO 7+42.81 PUULOA ROAD IMPROVEMENTS Kamehameha Hwy. to Salt Lake Blvd. Federal Aid Project No. STP-7310(1) Scale: As shown Date: May 2003 SHEET NO. 29 OF 193 SHEETS			

P.M.: STY
CURRENT OPR: rgq
PREV. OPR:
CURRENT TIME: May 12, 2003 - 12:15pm
LAST SAVED BY:
LAST MODIFIED: Mon, 12 May 2003 - 12:15pm

PREFIX: C:\RGQ\Dwg\
FILE: Dot96129a.dwg
BEGIN: 12/01/99
SCALE: 1=1


ORIGINAL PLAN	SURVEY PLOTTED BY _____	DATE _____
NOTEBOOK	DRAWN BY _____	_____
	TRACED BY _____	_____
	DESIGNED BY _____	_____
	QUANTITIES BY _____	_____
No. _____	CHECKED BY _____	_____

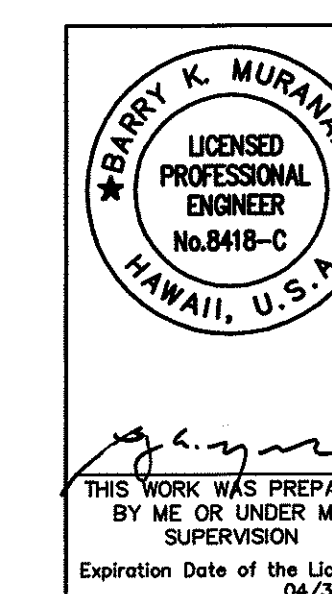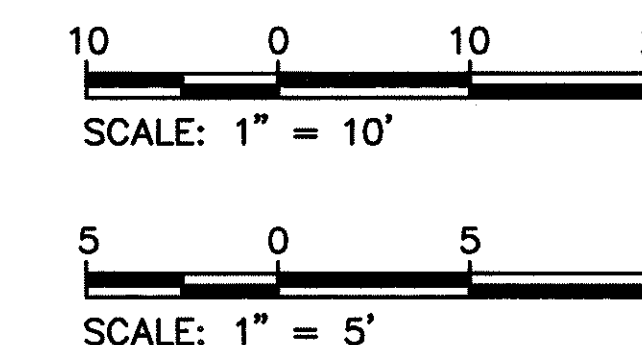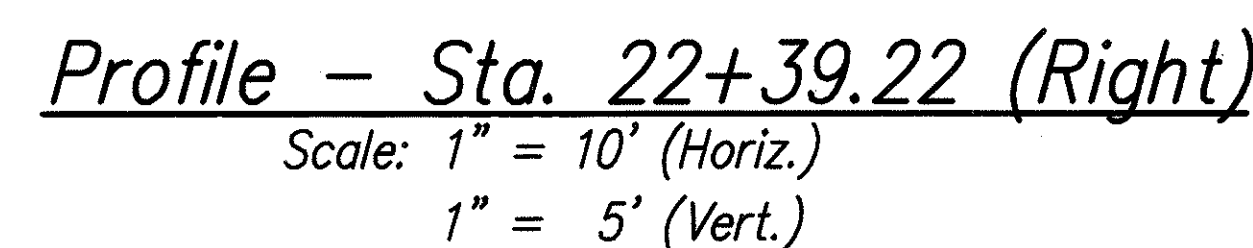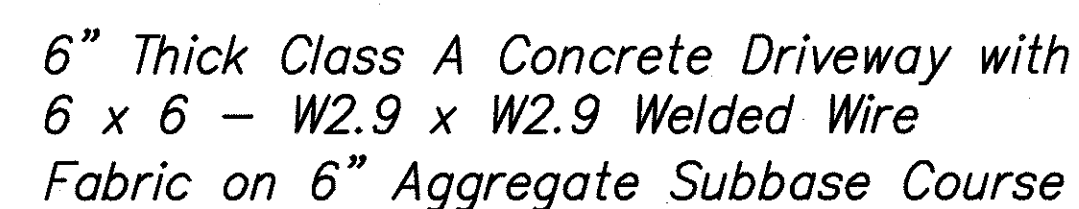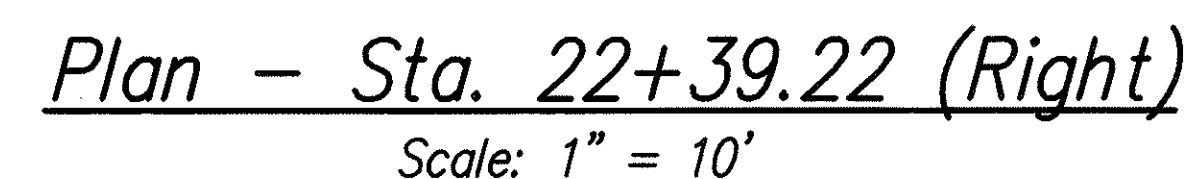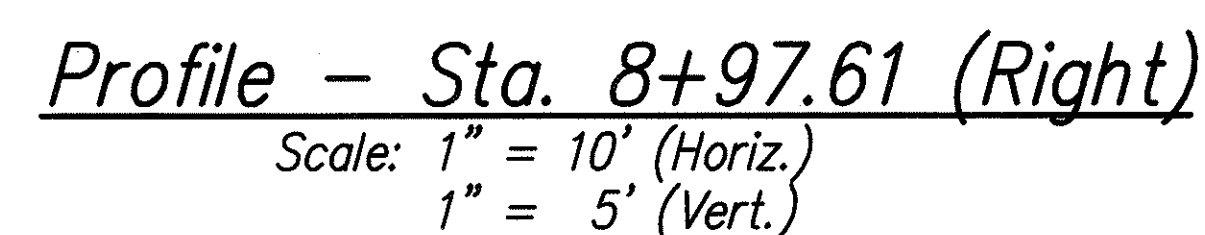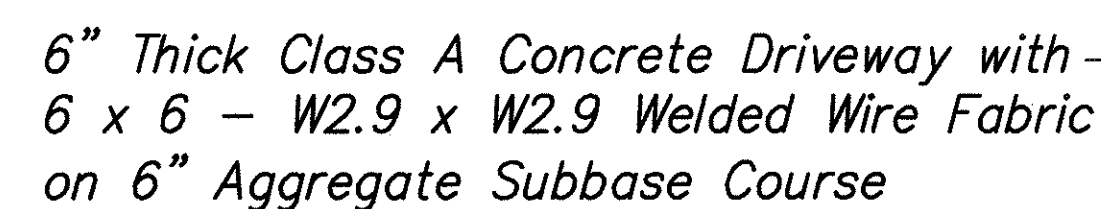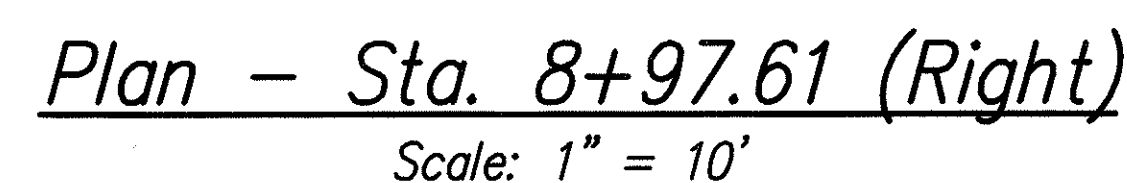


STATE OF HAWAII
DEPARTMENT OF TRANSPORTATION
HIGHWAYS DIVISION
PROPERTY ADJUSTMENTS
STA. 8+97.61 TO 22+39.22
*PUULOA ROAD IMPROVEMENTS
Kamehameha Hwy. to Salt Lake Blvd.
Federal Aid Project No. STP-7310(1)*

Scale: As shown Date: May 2003
SHEET NO. 30 OF 193 SHEETS


FED. ROAD DIST. NO.	STATE	FED. AID PROJ. NO.	FISCAL YEAR	SHEET NO.	TOTAL SHEETS
HAWAII	HAW.	STP-7310(1)	2003	31	193

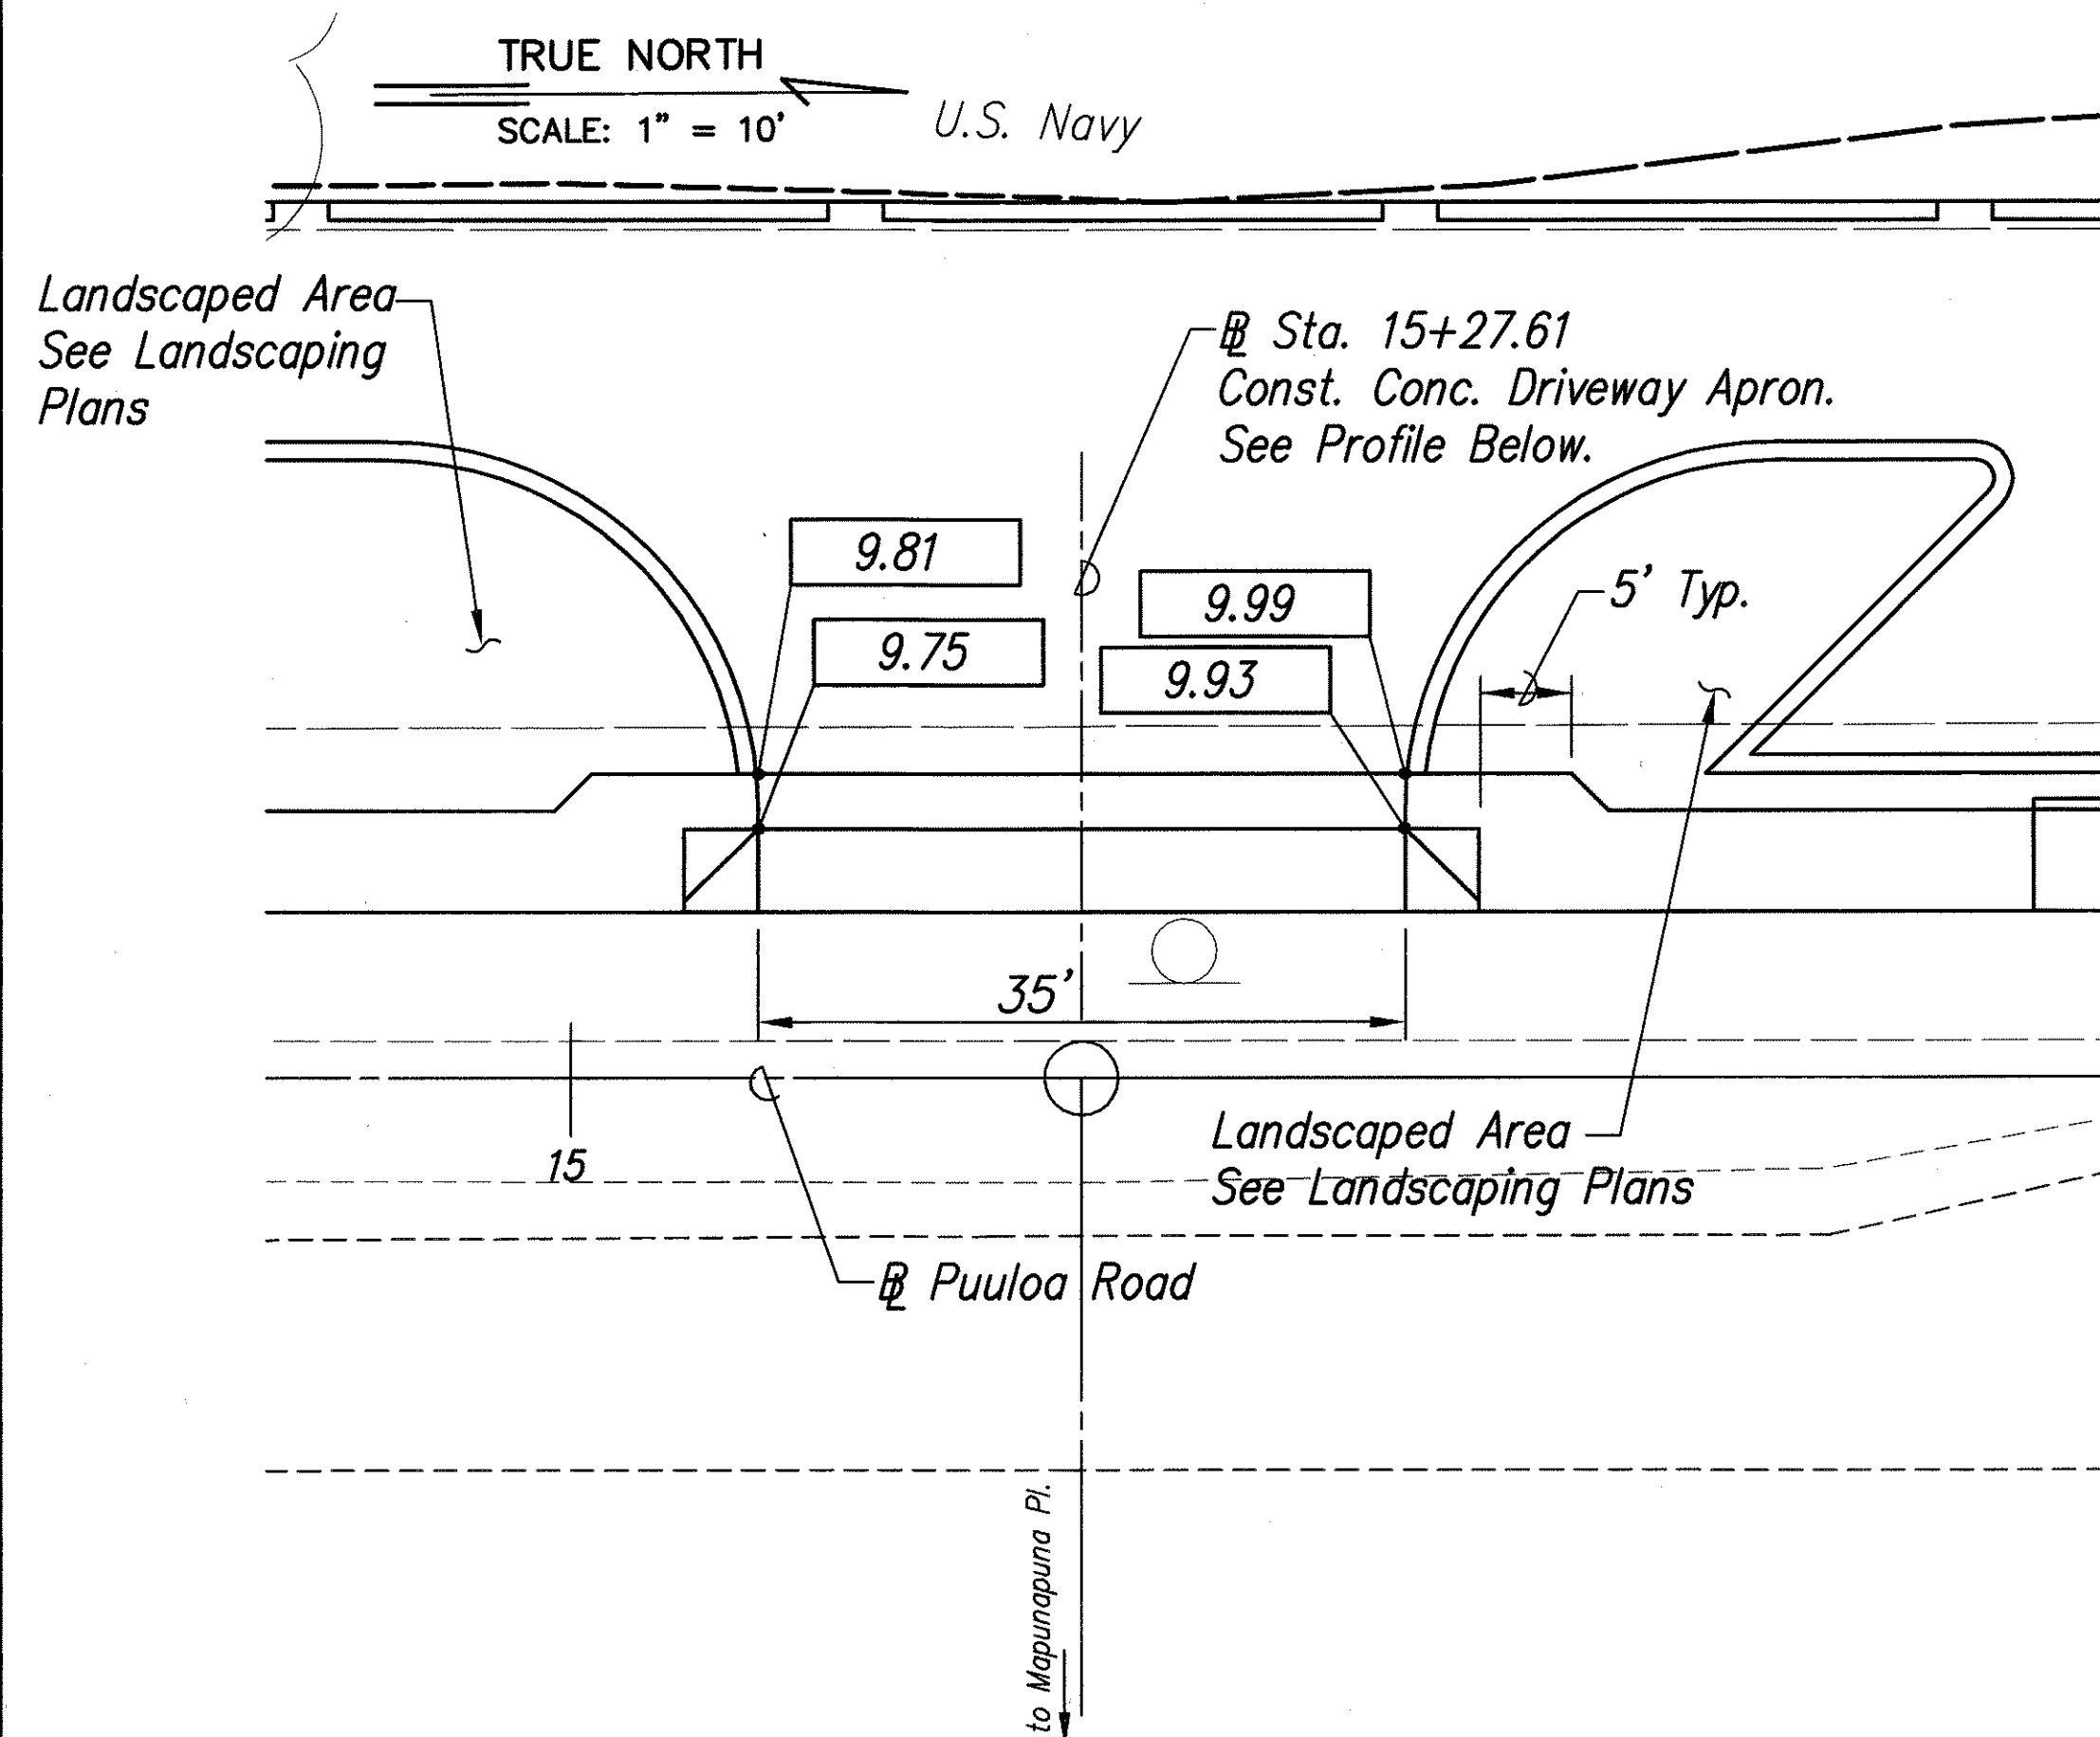


Plan - Sta. 15+27.61 (Left)
SCALE: 1" = 10'

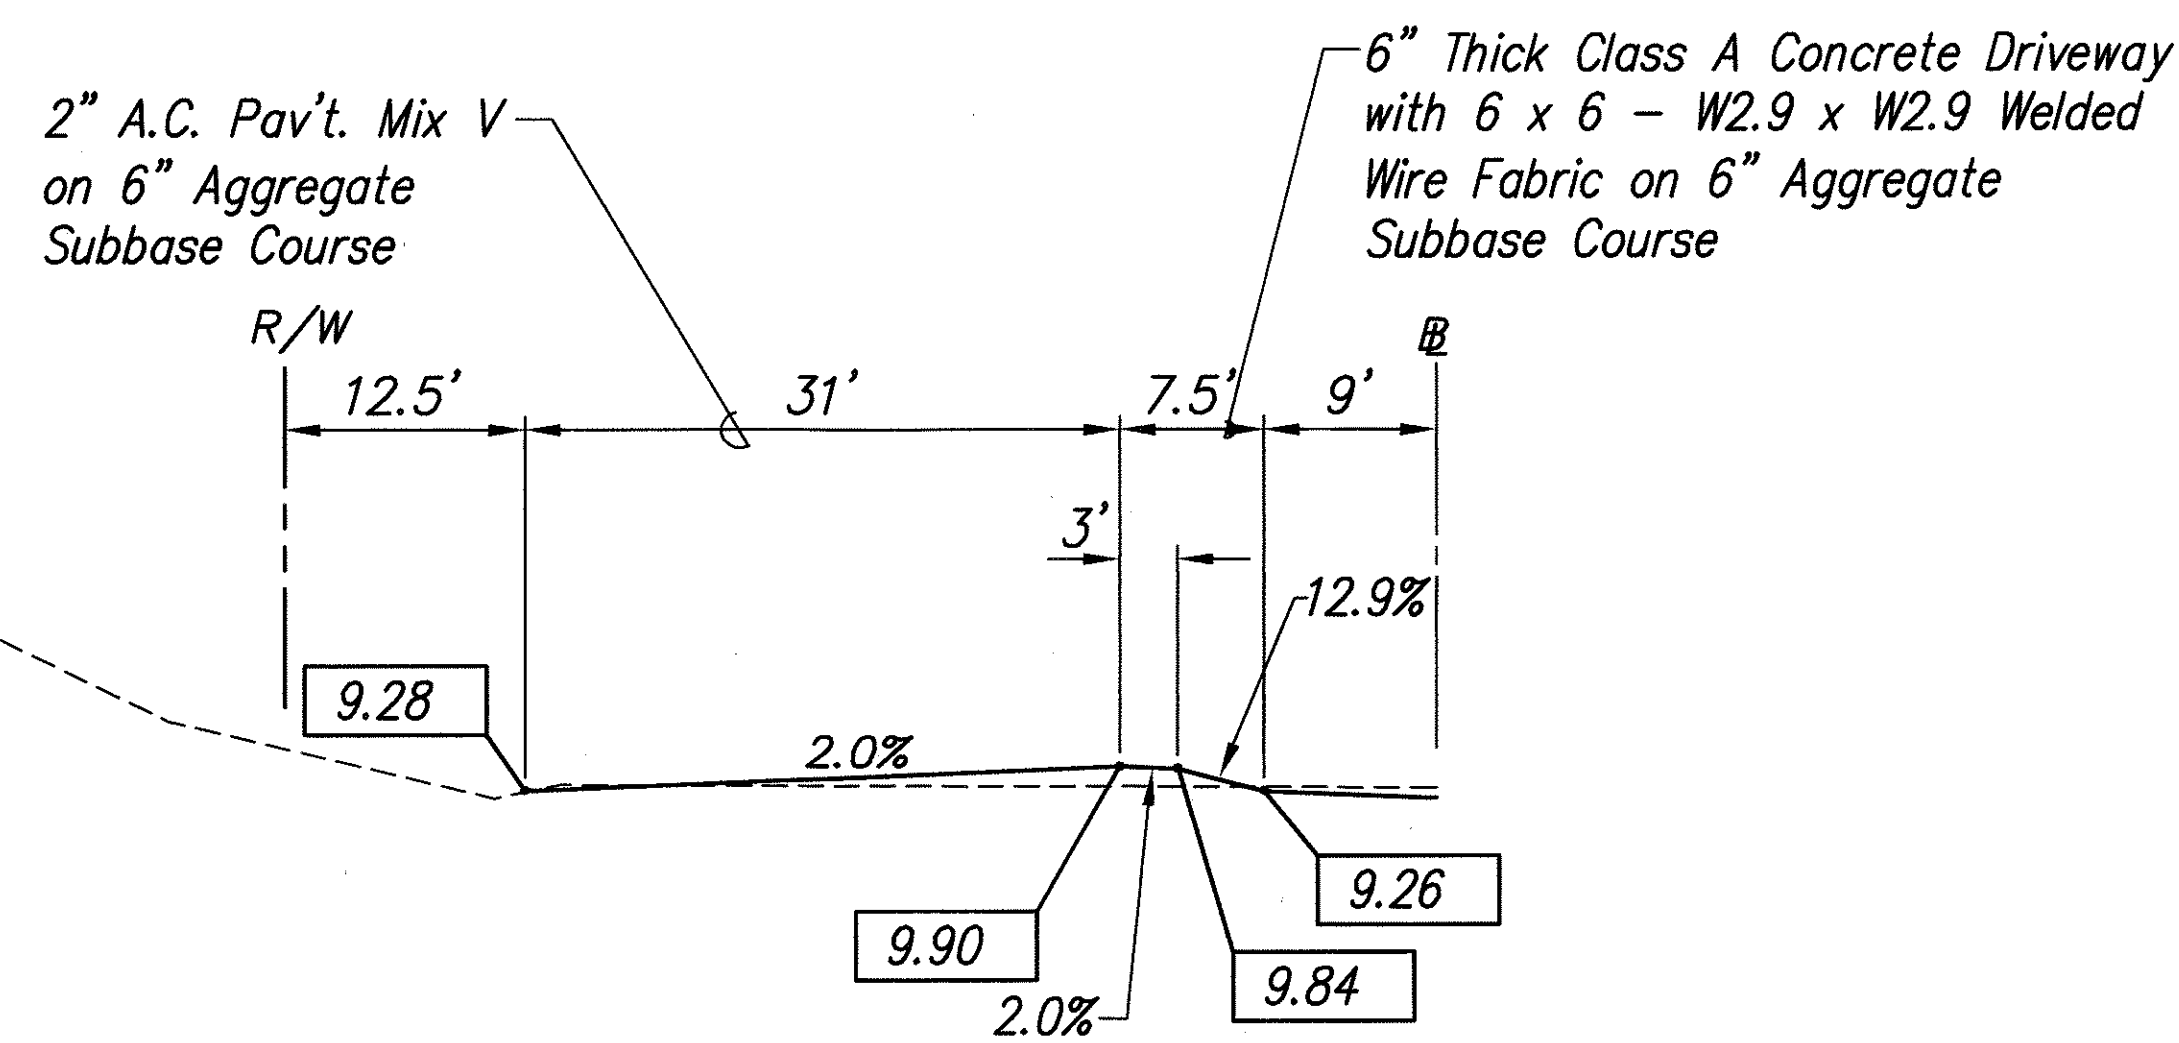




Profile - Sta. 15+27.61 (Left)
Scale: 1" = 10' (Horiz.)
1" = 5' (Vert.)

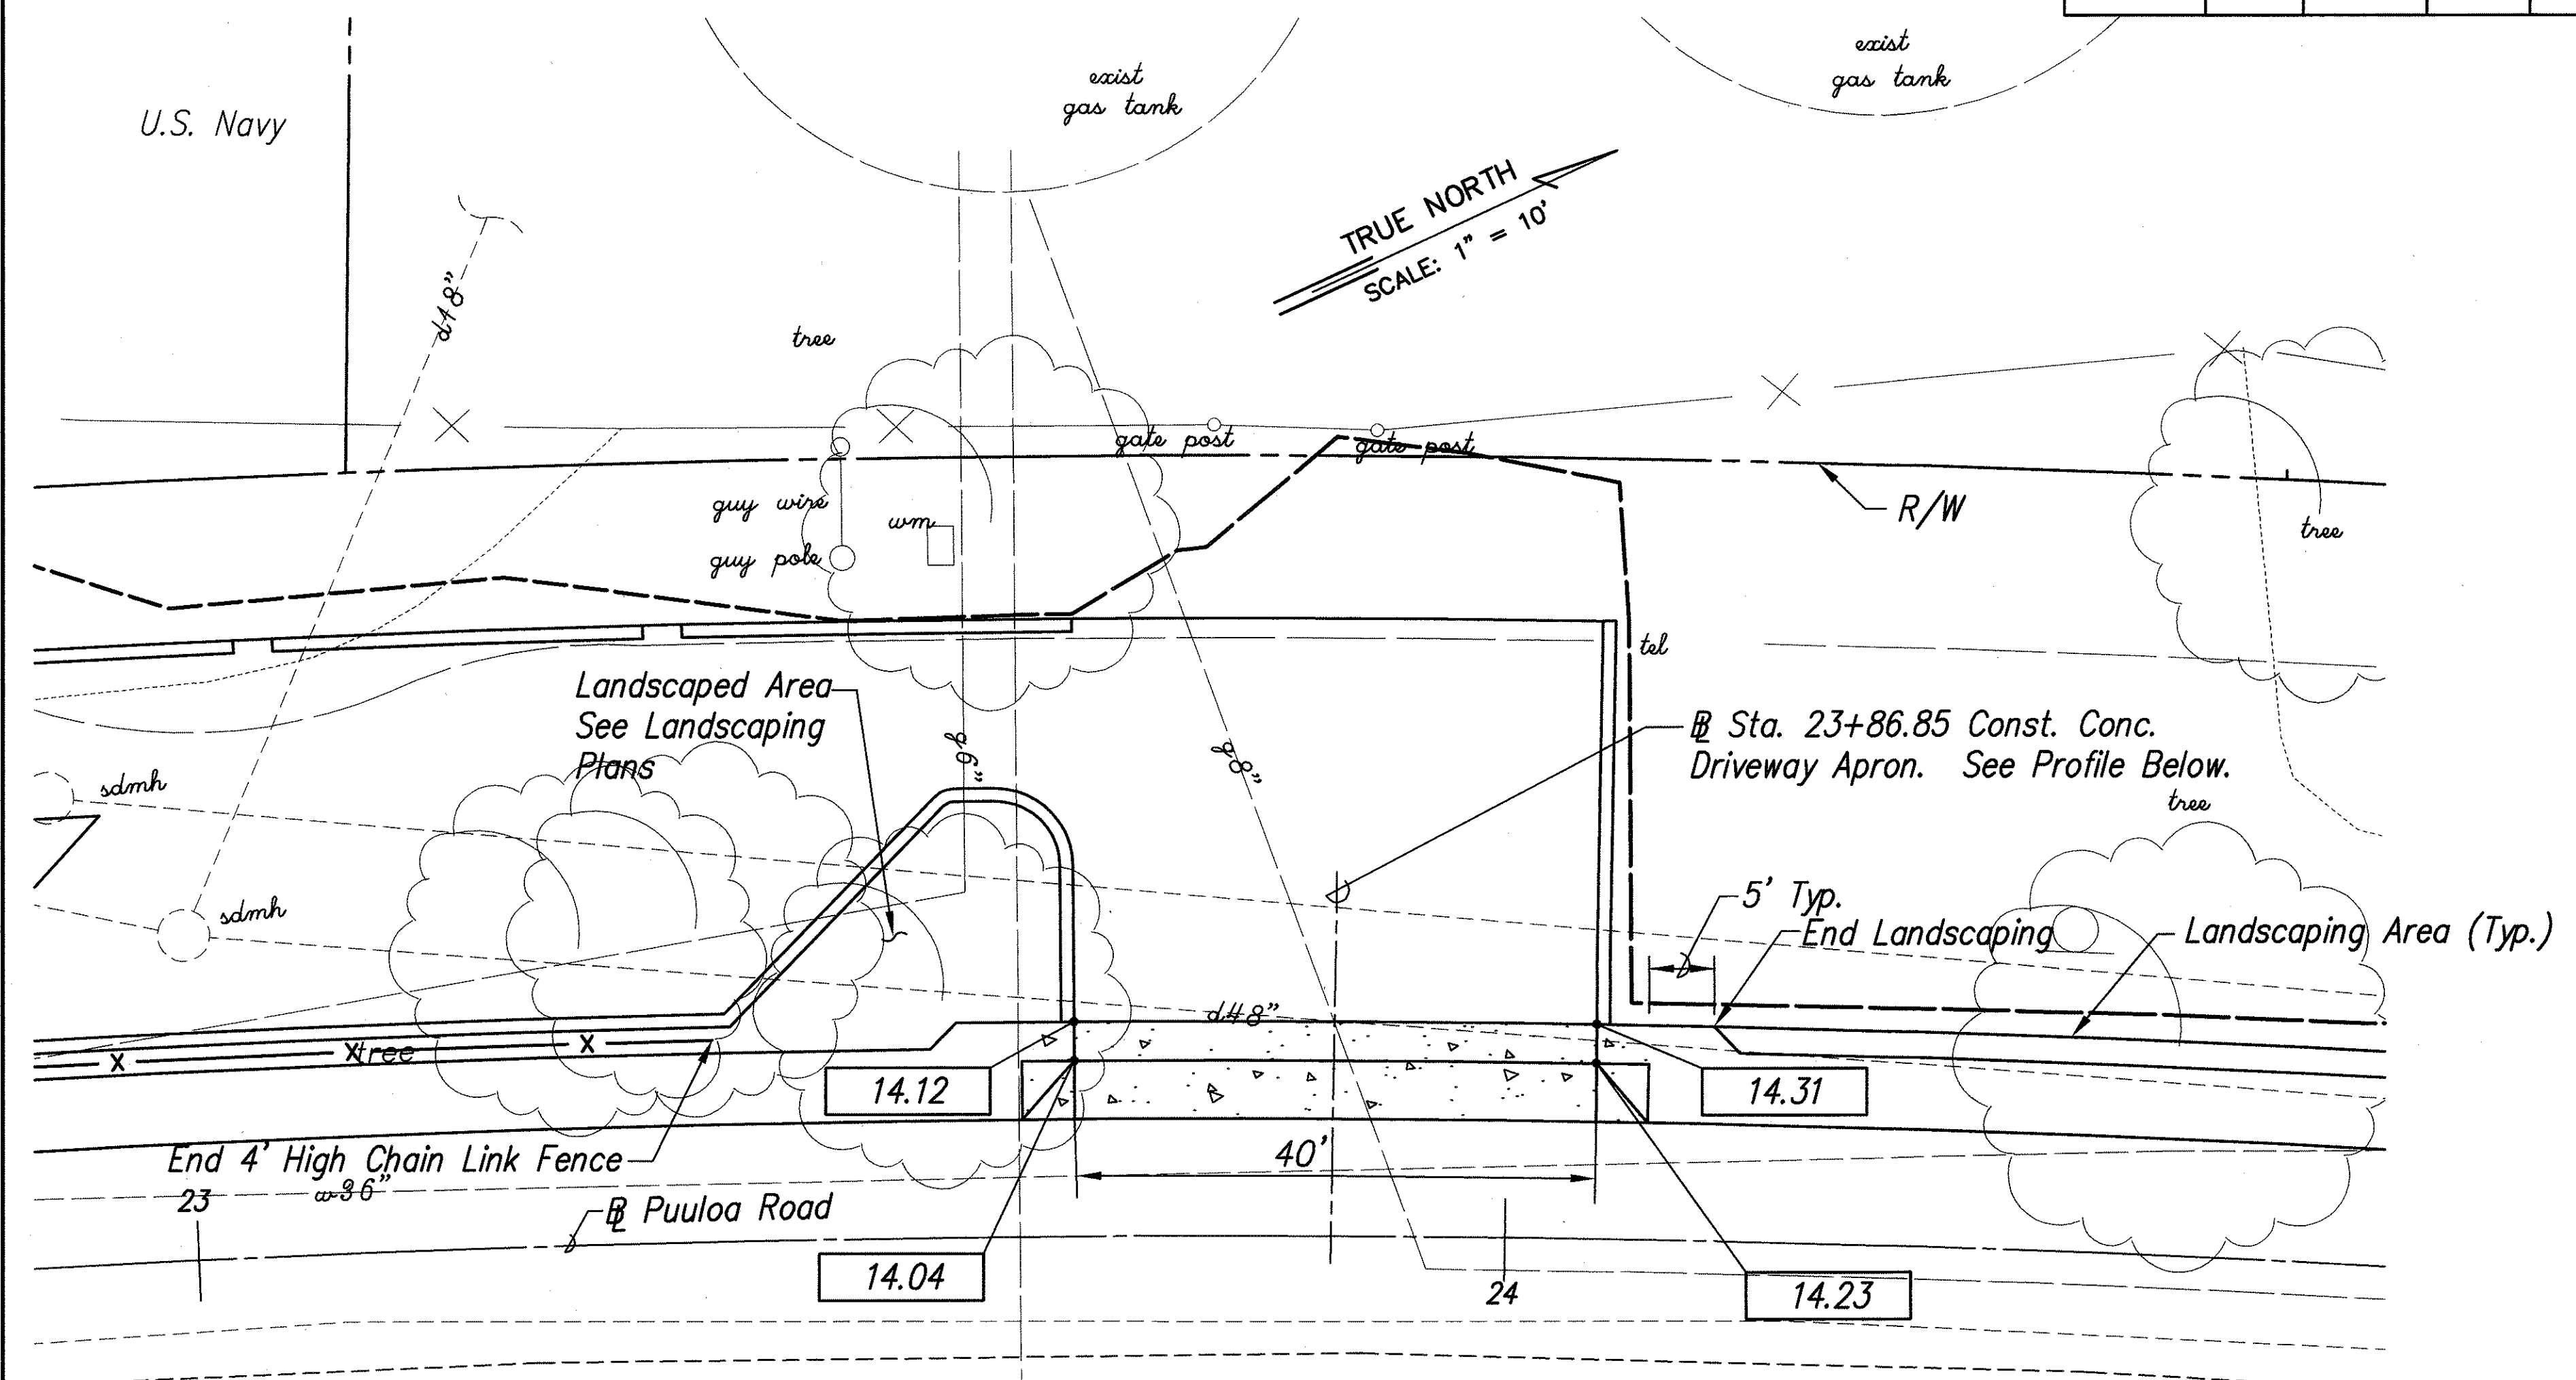

Plan - Sta. 23+86.85 (Left)
SCALE: 1" = 10'

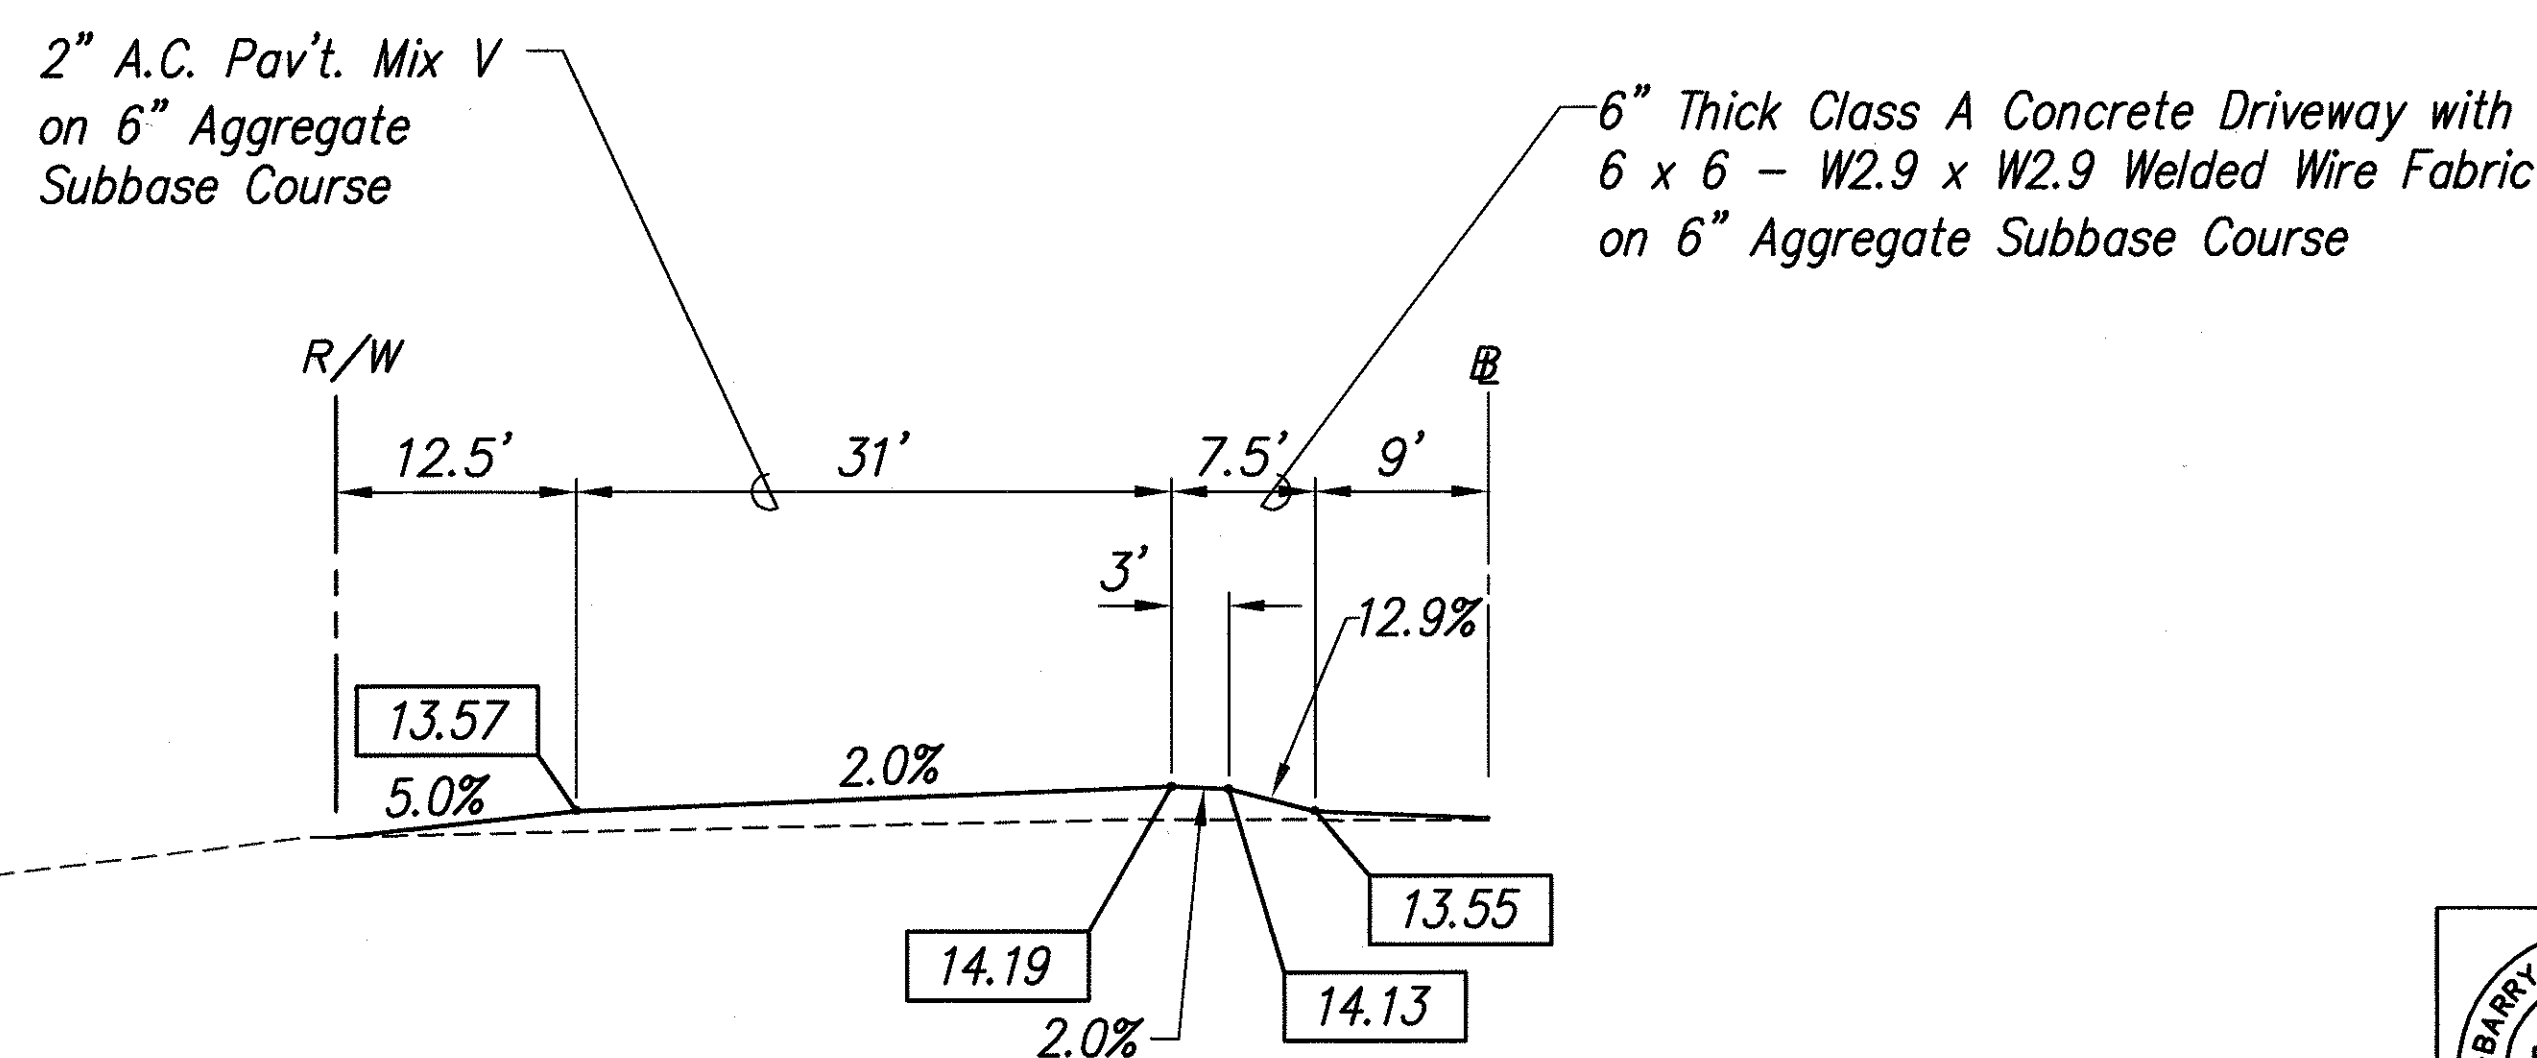

Profile - Sta. 23+86.85 (Left)
Scale: 1" = 10' (Horiz.)
1" = 5' (Vert.)

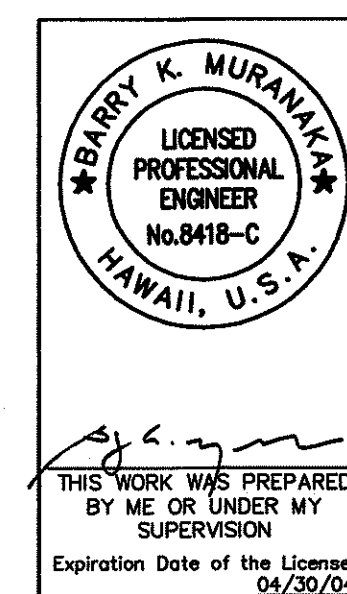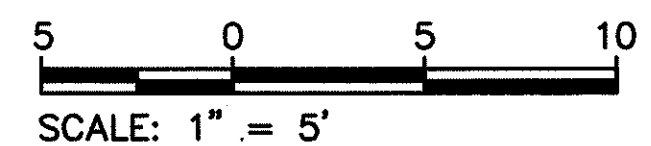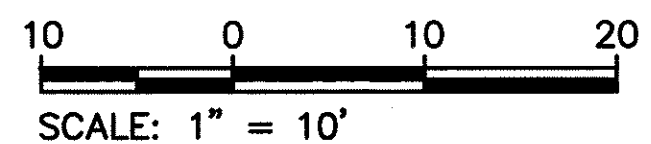

STATE OF HAWAII
DEPARTMENT OF TRANSPORTATION
HIGHWAYS DIVISION
PROPERTY ADJUSTMENTS
STA. 15+27.61 TO 23+86.85
PUULOA ROAD IMPROVEMENTS
Kamehameha Hwy. to Salt Lake Blvd.
Federal Aid Project No. STP-7310(1)
Scale: As shown Date: May 2003
SHEET NO. 31 OF 193 SHEETS

P.M.: STY
CURRENT OPR: rgq
PREV. OPR: May 12, 2003 - 12:22pm
CURRENT TIME: May 12, 2003 - 12:21pm
LAST SAVED BY:
LAST MODIFIED: Mon, 12 May 2003 - 12:21pm

PREFIX: C:\RQO\Drawg
FILE: Dot96153a.dwg
BEGIN: 12/01/99
SCALE: 1=1

SURVEY PLOTTED BY	DATE
DRAWN BY	
TRACED BY	
DESIGNED BY	
CHECKED BY	
ORIGINAL PLAN	
NOTEBOOK	
No.	