


P.M.: STY
CURRENT: OPR: c/j
PREV. OPR:
BEGIN: 12/01/99
LAST SAVED BY: mnn
LAST MODIFIED: Wed, 21 Jan 2009 - 3:52pm


PREF: G:\DOT\H9601A\ACAD\
FILE: CO 295-1 Dot96107a.dwg
SCALE: 1=1

DATE	
DESIGNED BY	
QUANTITIES BY	
CHECKED BY	
ORIGINAL	
PLAN	
NOTED	
NO.	

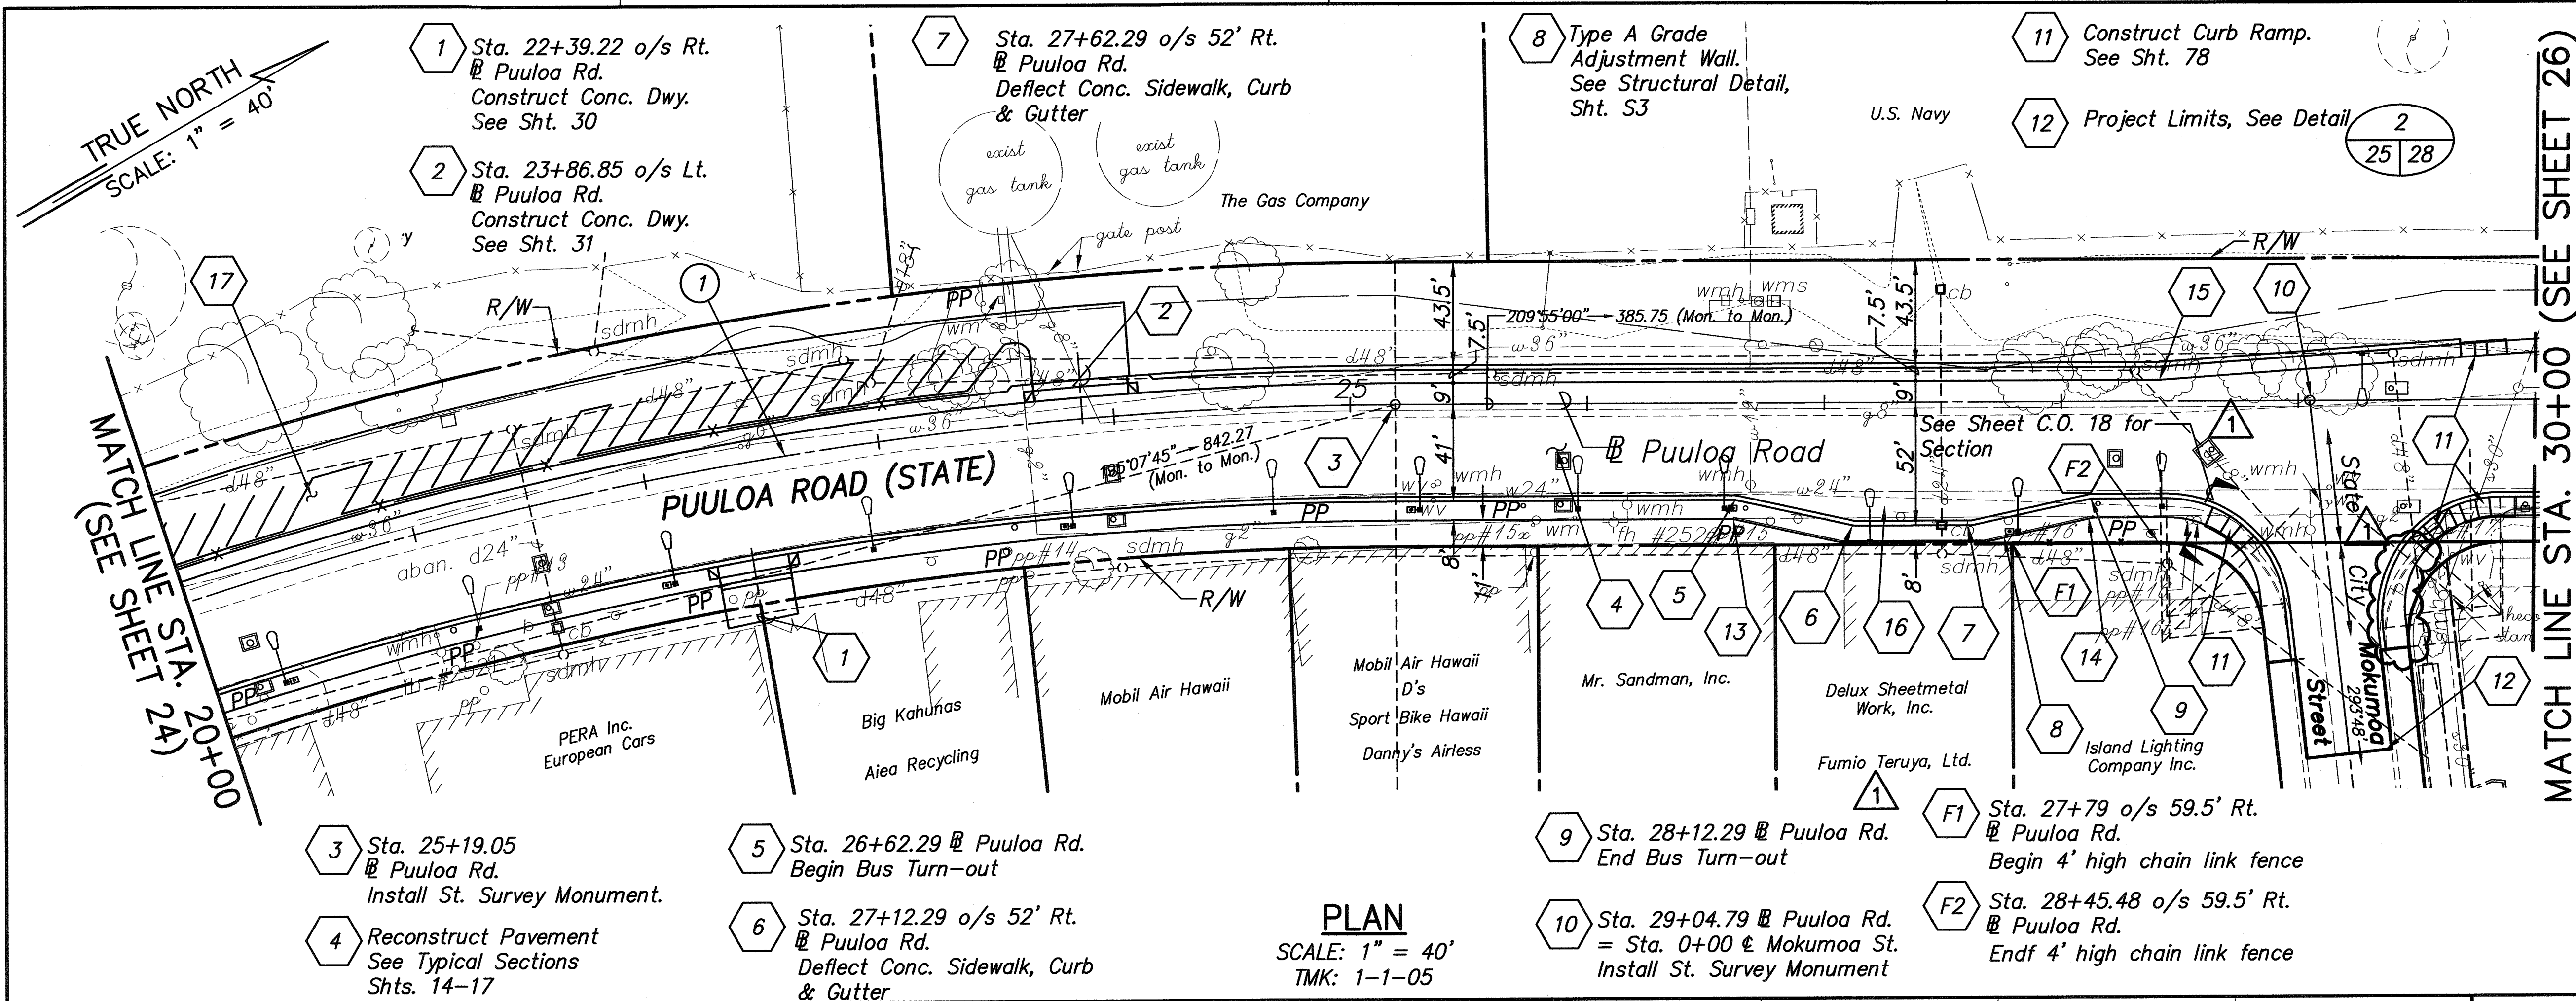

FED. ROAD DIST. NO.	STATE	FED. AID PROJ. NO.	FISCAL YEAR	SHEET NO.	TOTAL SHEETS
HAWAII	HAW.	STP-7310(1)	2003	C.O.25	193

CURVE	(1)
Δ	29°34'30"
$\Delta/2$	14°47'15"
R	1650.00
T	435.56
C	842.27
Lc	851.70

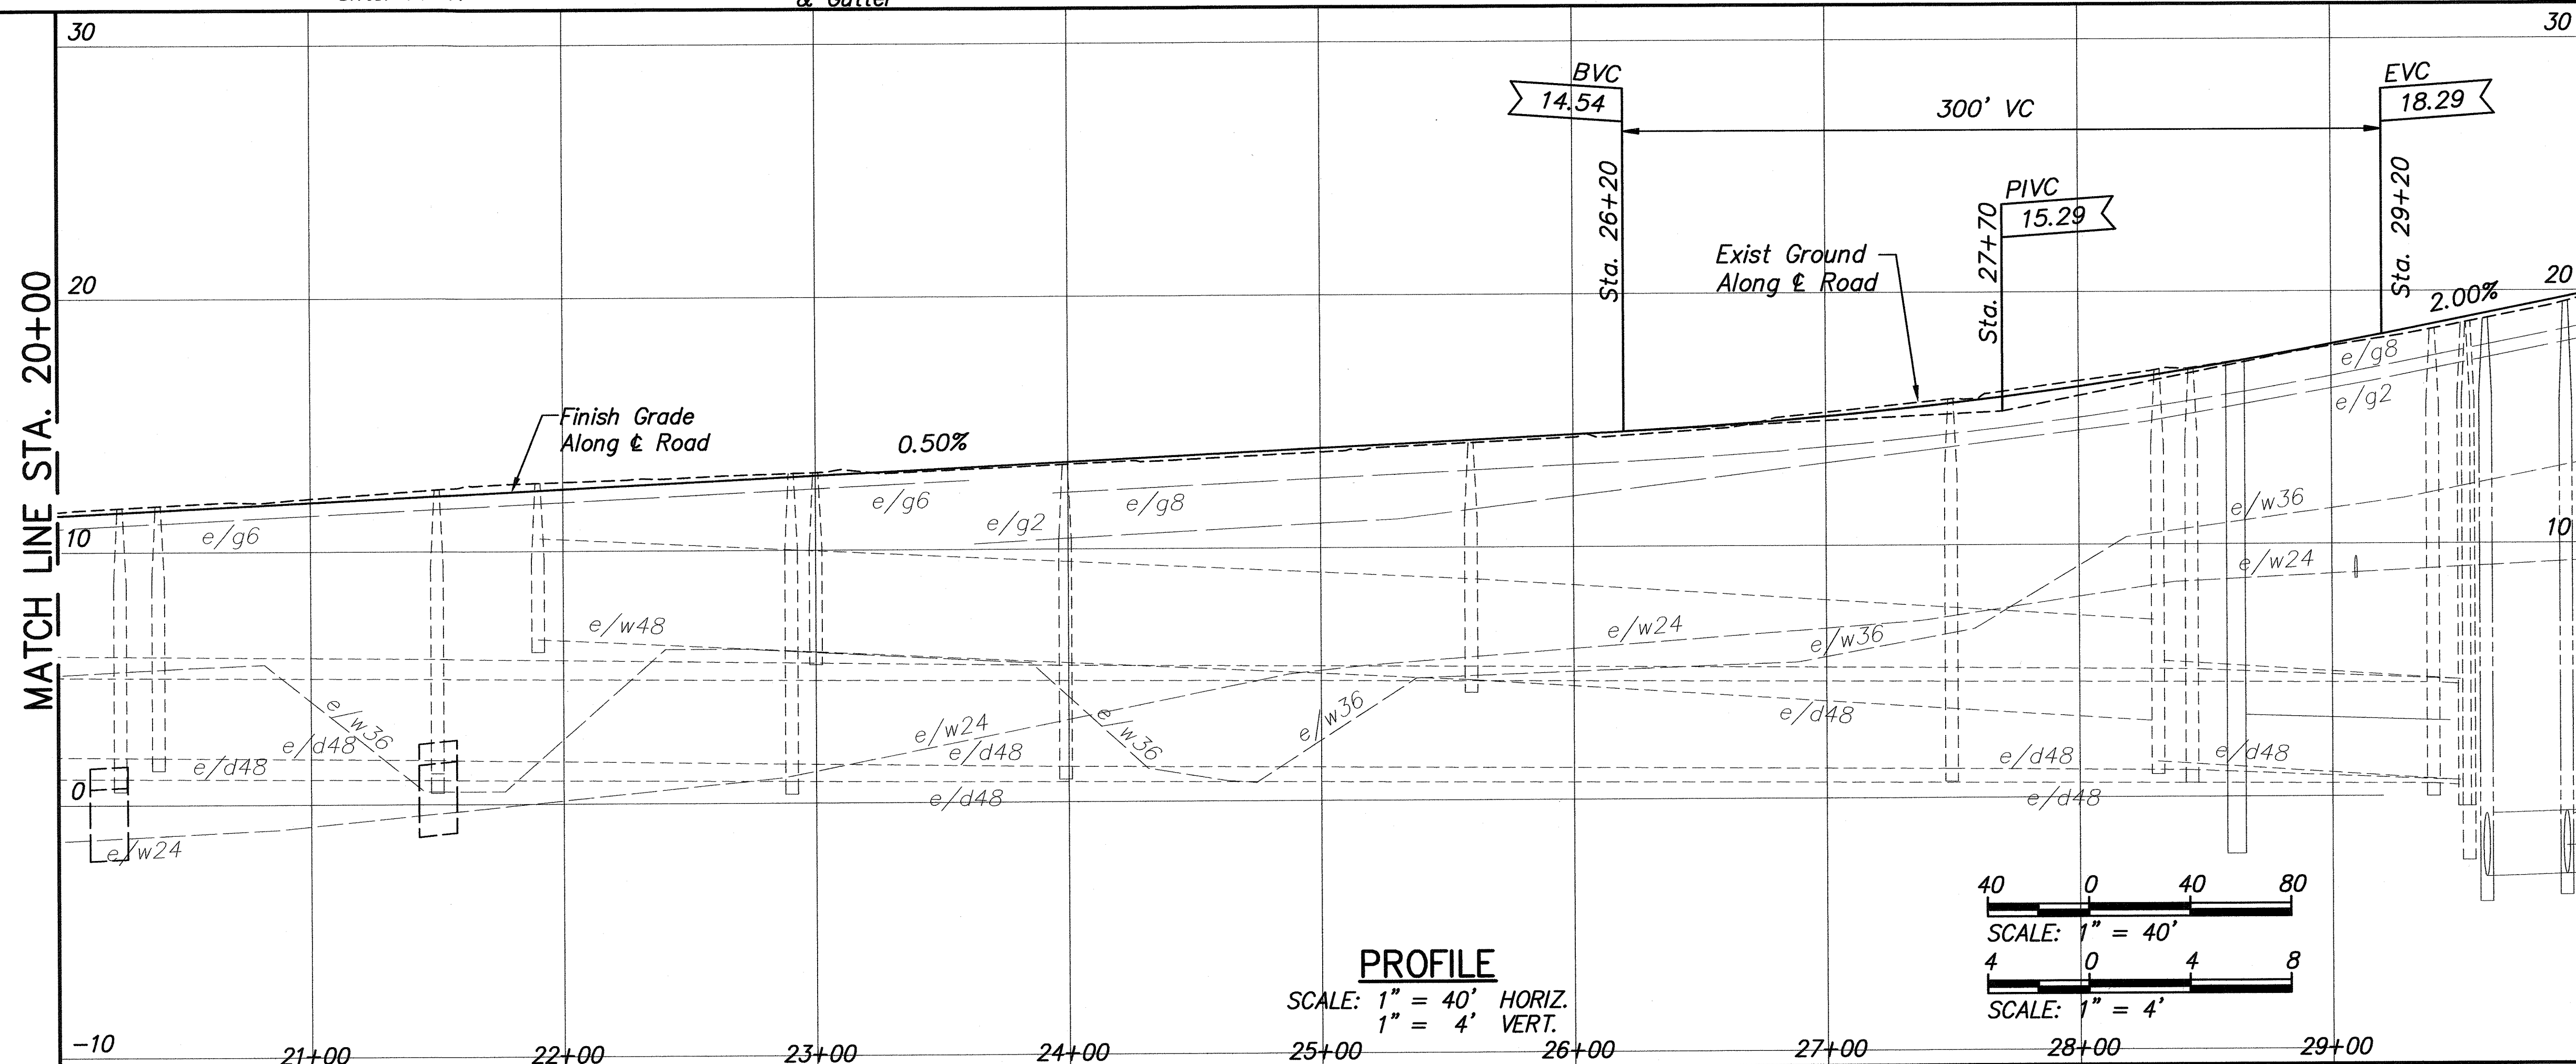

APPROVED:

[Signature]
Chief, Traffic Review Branch, D.P.P.
(For work within City R/W only)



[Signature]
Chief, Civil Engineering Branch, D.P.P.
(For construction within City R/W only)

[Signature]
Chief, Wastewater Branch, D.P.P. W


1	12/02/08	Added C.L. fence; revised back of sidewalk tie-in to City street	AA
SYMBOL	DATE	REVISION	BY
STATE OF HAWAII DEPARTMENT OF TRANSPORTATION HIGHWAYS DIVISION ROAD PLAN & PROFILE STA. 20+00 TO 30+00 PUULO ROAD IMPROVEMENTS Kamehameha Hwy. to Salt Lake Blvd. Federal Aid Project No. STP-7310(1) Scale: As shown Date: May 2003 SHEET NO. 25 OF 193 SHEETS			

C.O. 25

14 Install A.C. Curb. Provide Openings at Striped Crosswalks with 4' Clearance From Striping. Install Detectable Warnings. See Detail 4 and Sht. 70.

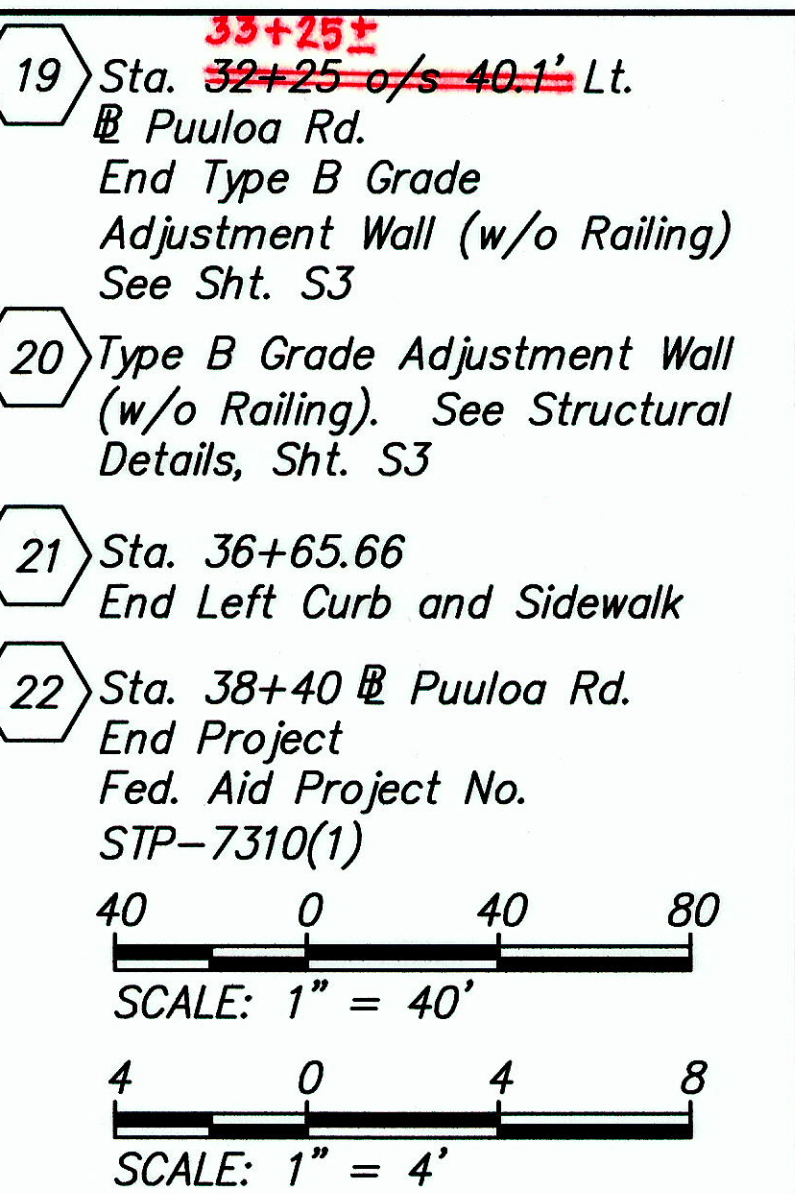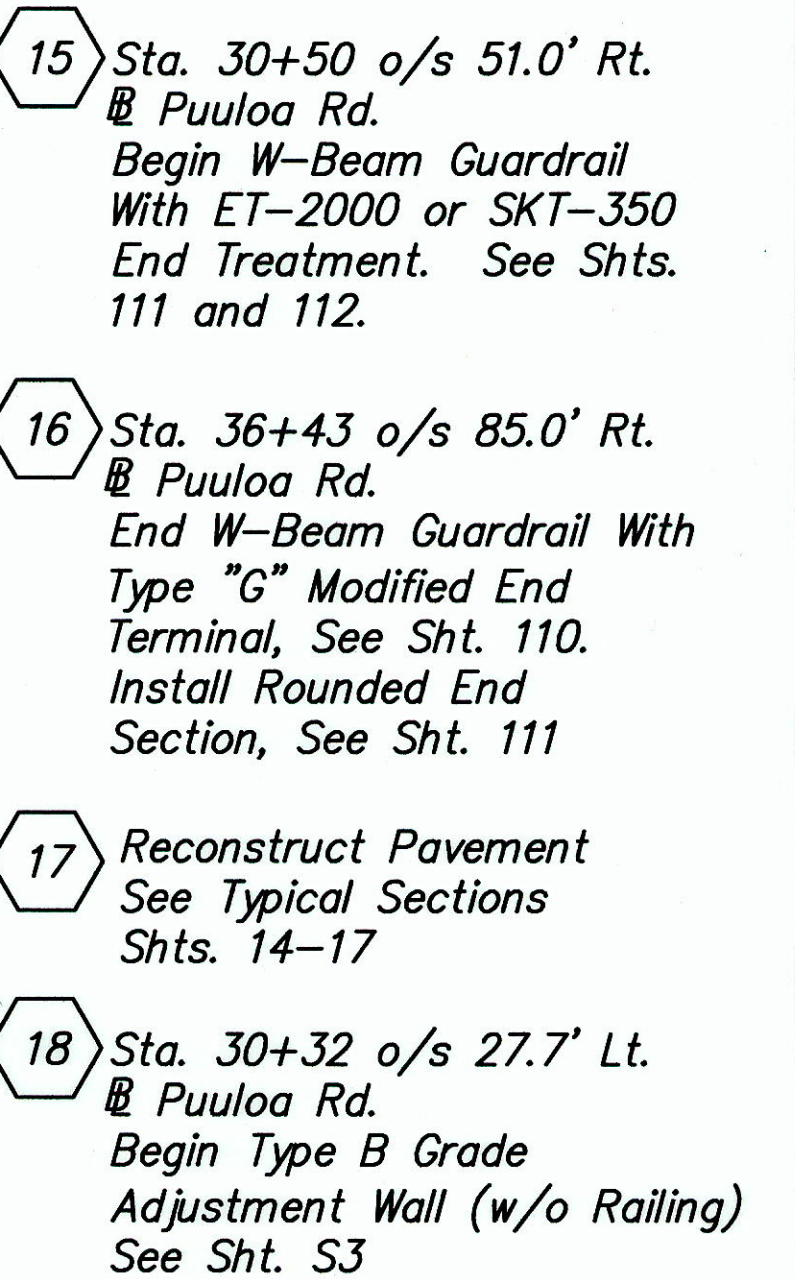

<u>Dennis M. Michimura</u>	7/16/03
Chief, Wastewater Branch, D.P.P. mv	Date

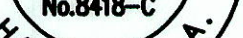10	2/25/04 DATE	Replaced Sheet Per Addendum No.3 REVISION
0	  THIS WORK WAS PREPARED BY ME OR UNDER MY SUPERVISION	STATE OF HAWAII DEPARTMENT OF TRANSPORTATION HIGHWAYS DIVISION <u>ROAD PLAN & PROFILE</u> <u>STA. 30+00 TO END</u> PUULOA ROAD IMPROVEMENTS Kamehameha Hwy. to Salt Lake Blvd. Federal Aid Project No. STP-7310(1)
0	Expiration Date of the License: 04/25/08	Scale: As shown Date: May 2003
+00	SHEET NO. 26 OF 193 SHEETS	