

INDEX TO DRAWINGS

SHEET NO.	DESCRIPTION
1	TITLE SHEET
2	STANDARD PLANS SUMMARY
3-4	GENERAL NOTES AND LEGEND
5-6	WATER POLLUTION AND EROSION CONTROL NOTES
7-9	GEOTECHNICAL NOTES AND BORING LOGS
10-13	GENERAL LAYOUT PLANS
14-17	TYPICAL ROAD SECTIONS
18	MISCELLANEOUS DETAILS
19-22	EXISTING CONDITION PLANS
23-26	ROAD PLAN & PROFILES
27-28	INTERSECTION DETAILS & CURB RETURN GRADES
29-31	PROPERTY ADJUSTMENTS AND DETAILS
32-35	EROSION CONTROL PLANS
36-37	DRAINAGE SUMMARY
38-46	DRAINAGE PLAN & PROFILES
47-51	MISCELLANEOUS DRAINAGE DETAILS
52-53	UNDERDRAIN LAYOUT PLAN & DETAIL
54-62	UTILITY ADJUSTMENT PLAN, PROFILES & DETAILS
63	SIGNING & PAVEMENT MARKING NOTES
64	PAVEMENT MARKING LEGEND, DETAILS & NOTES
65-68	SIGNING & STRIPING PLANS
69	TRAFFIC SIGN AND PAV'T. MARKING SUMMARIES
70-79	CURB RAMP DETAILS
80-92	CONSTRUCTION PHASING PLANS
93	DETOUR ROUTE PLAN
94	CONSTRUCTION PHASING NOTES, DETAIL, LEGEND
95-109	ROAD CROSS SECTIONS AND SUMMARY
110-113	GUARDRAIL DETAILS
114-115	PARKING LOT PLANS
116-121	STRUCTURAL PLANS (S-1 TO S-6)
122-177	ELECTRICAL PLANS (E-1 TO E-44)
178-193	LANDSCAPING PLANS (L-1 TO L-16)

STATE OF HAWAII

DEPARTMENT OF TRANSPORTATION

HIGHWAYS DIVISION

HONOLULU, HAWAII

"AS-BUILT"

PLANS FOR

PUULOA ROAD IMPROVEMENTS


KAMEHAMEHA HIGHWAY TO SALT LAKE BOULEVARD

TMK: 1-1-05, 07, 10

FEDERAL AID PROJECT NO. STP-7310(1)

DISTRICT OF HONOLULU

ISLAND OF OAHU

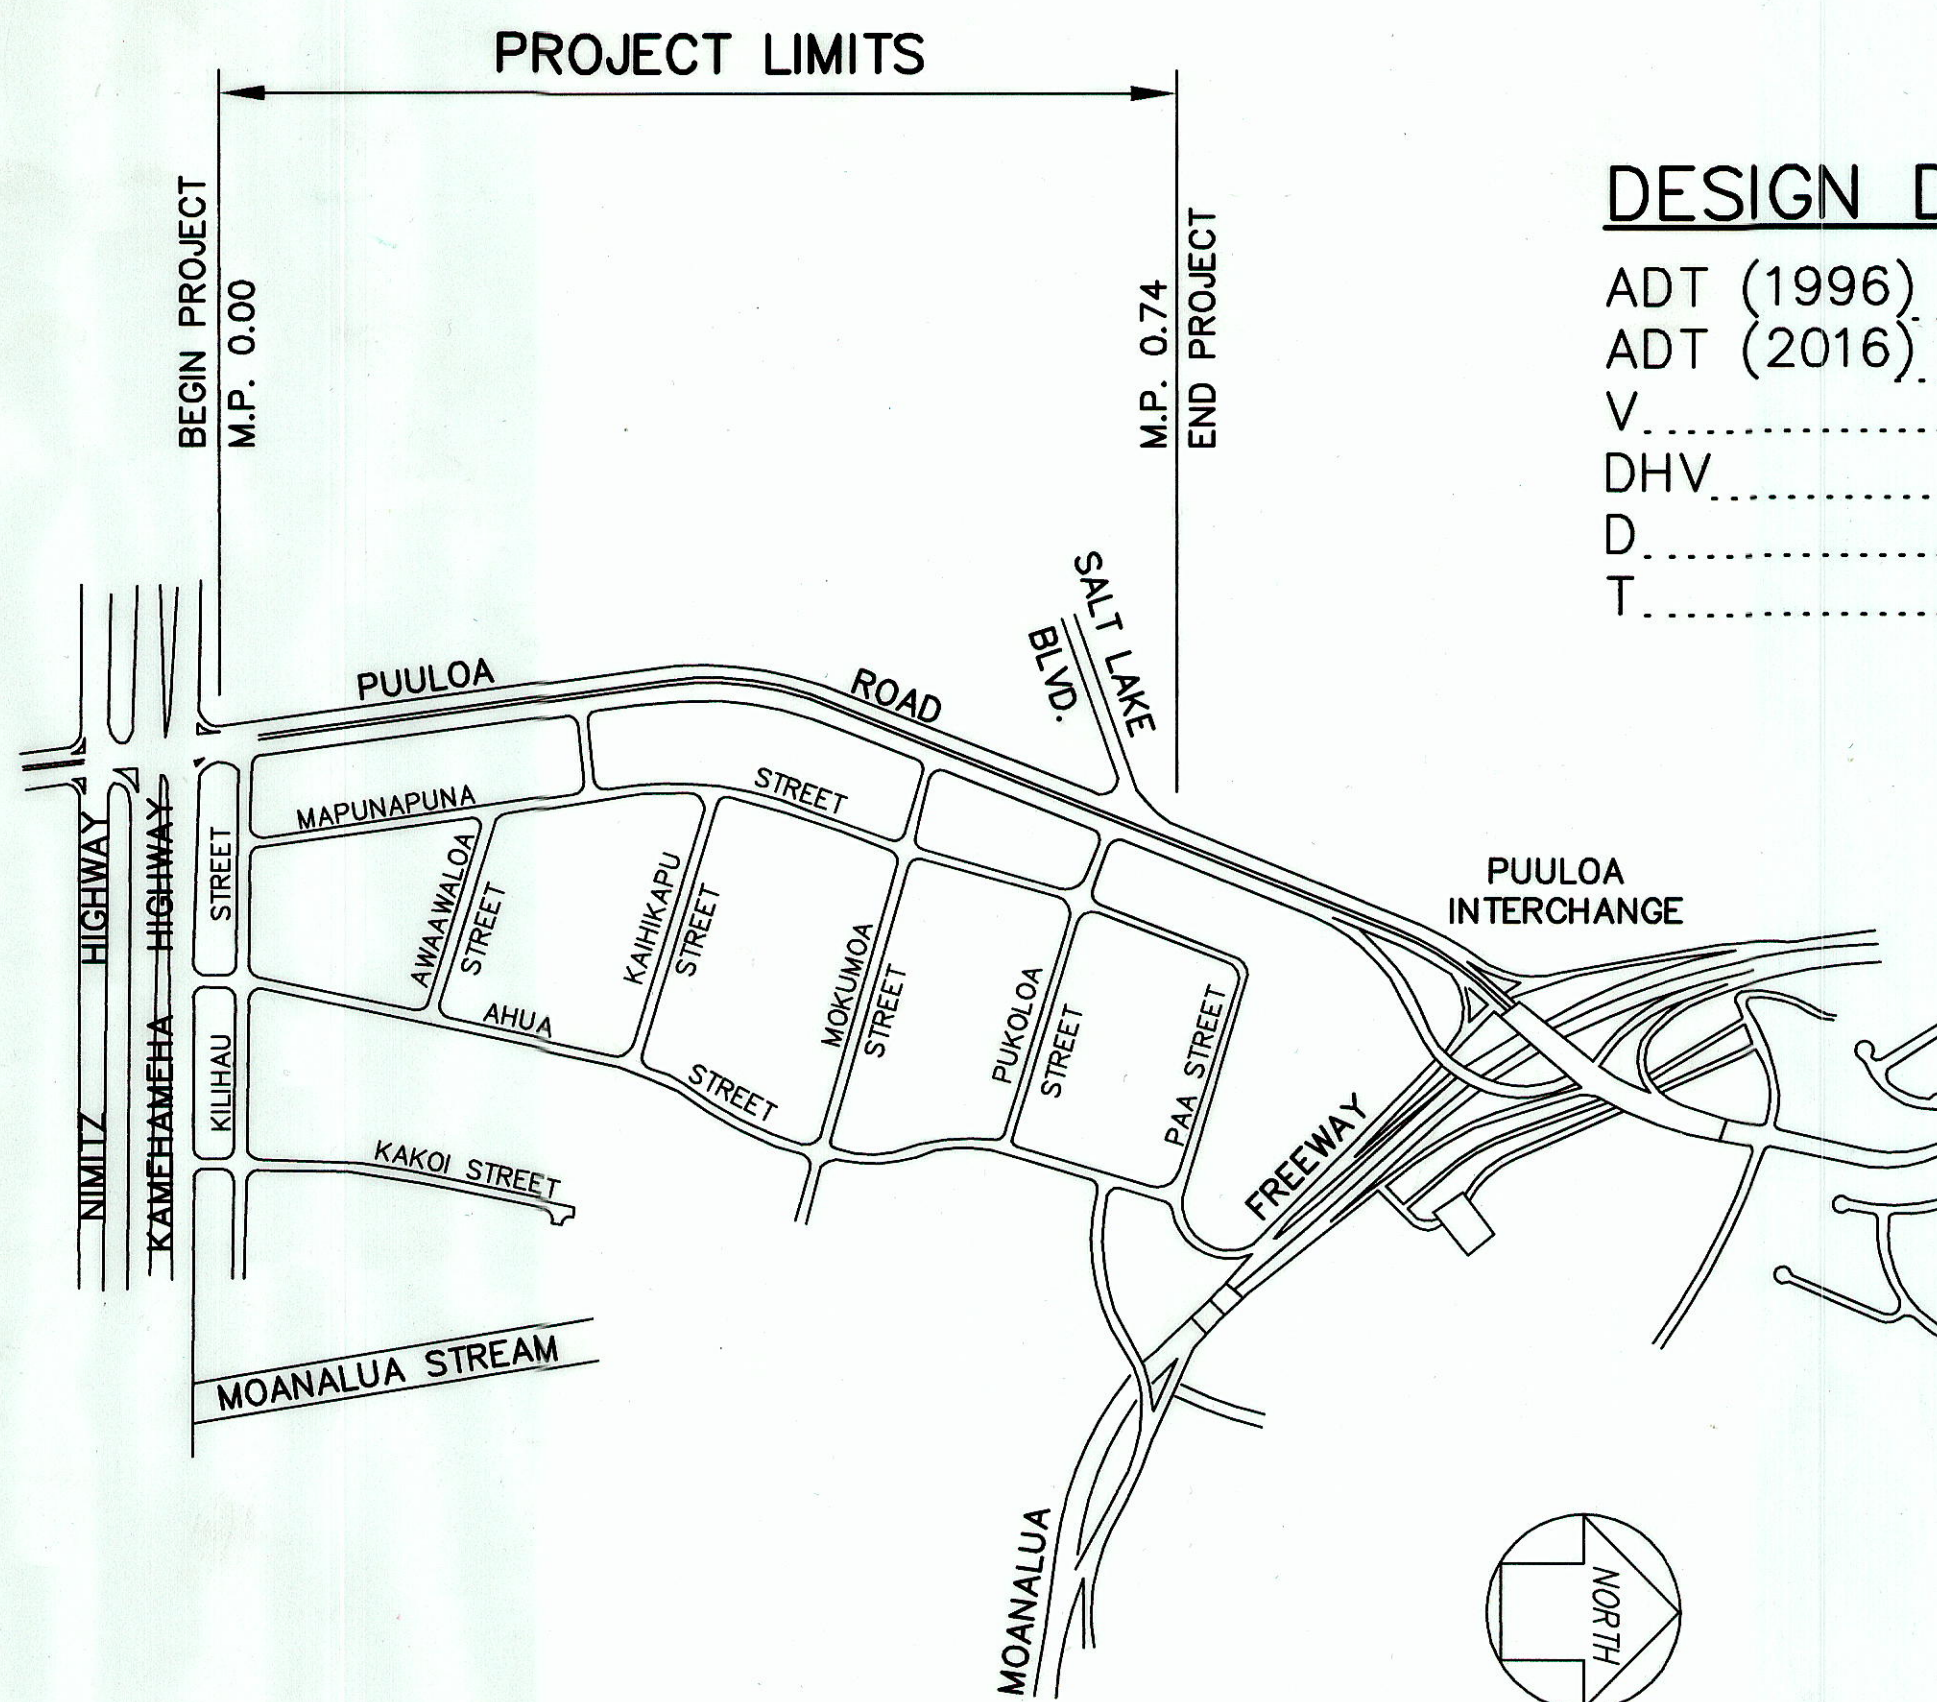

PROJECT LOCATION
NOT TO SCALE

DESIGN DESIGNATION




ADT (1996)	22,646
ADT (2016)	23,478
V	40 M.P.H.
DHV	2,465
D	65/35
T	5.5%

PROJECT LOCATION

----- FEDERAL AID INTERSTATE PROJECTS PREVIOUSLY
CONSTRUCTED OR UNDER CONSTRUCTION

MILE POST 0.00 TO MILE POST 0.74

FED. ROAD DIST. NO.	STATE	FED. AID PROJ. NO.	FISCAL YEAR	SHEET NO.	TOTAL SHEETS
HAWAII	HAW.	STP-7310(1)	2003	1	193

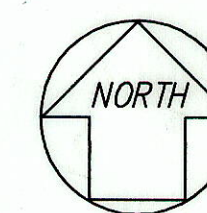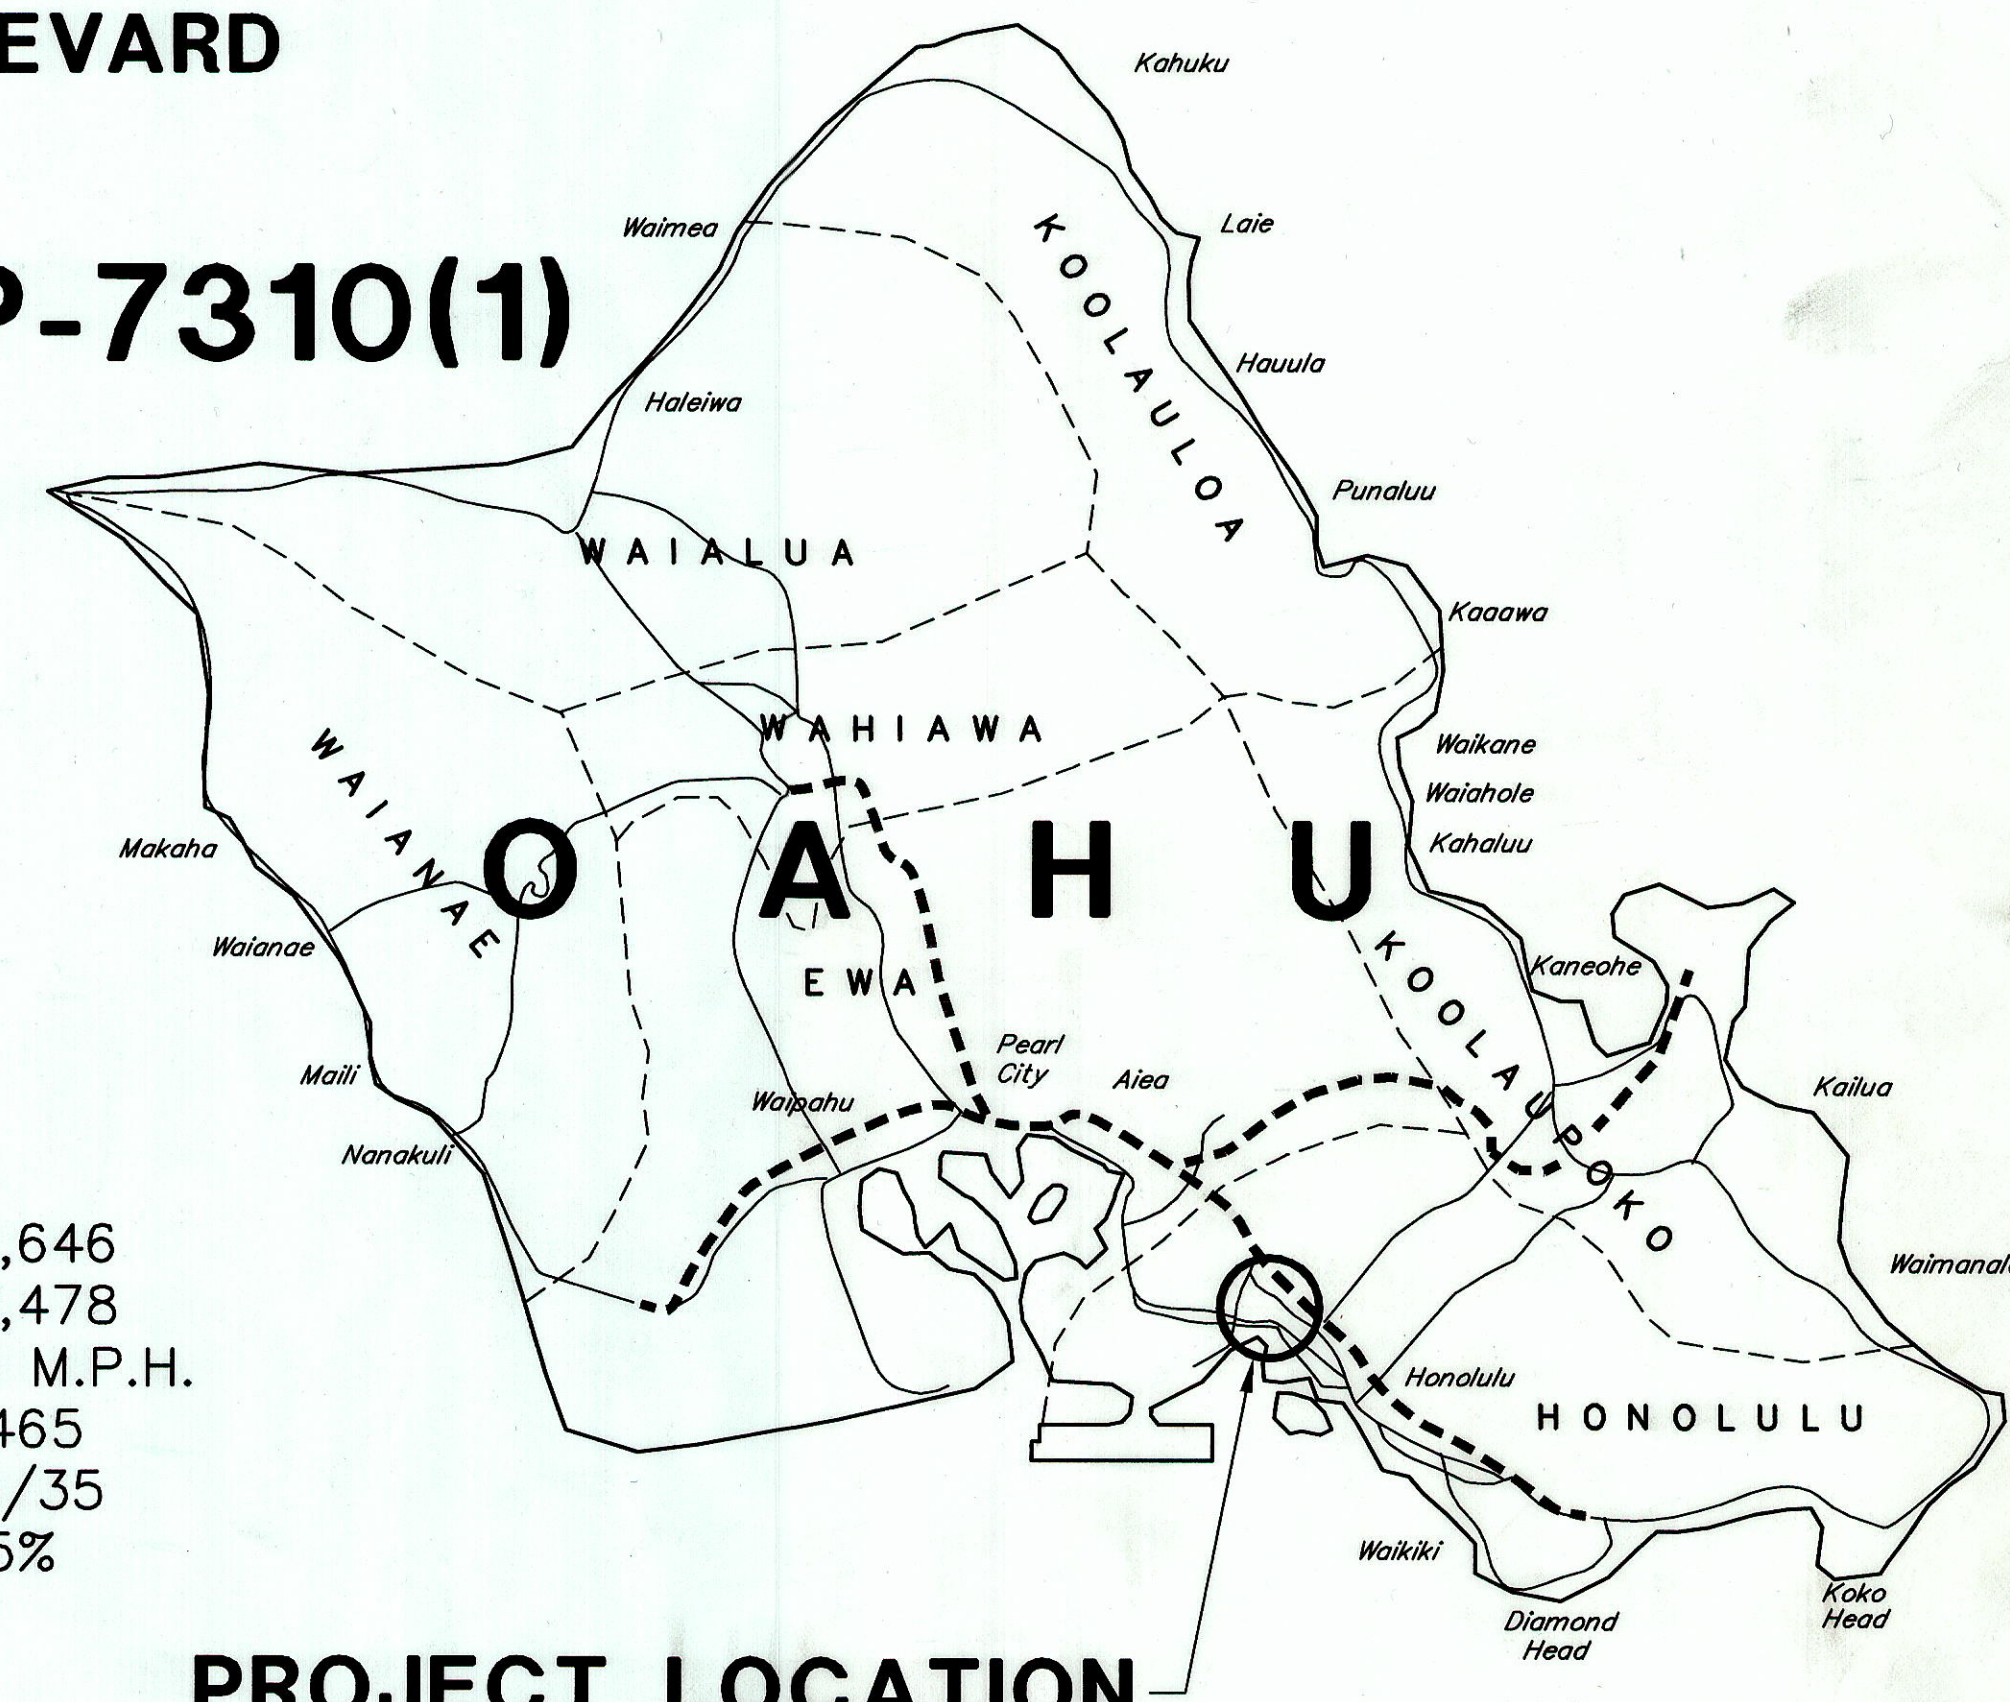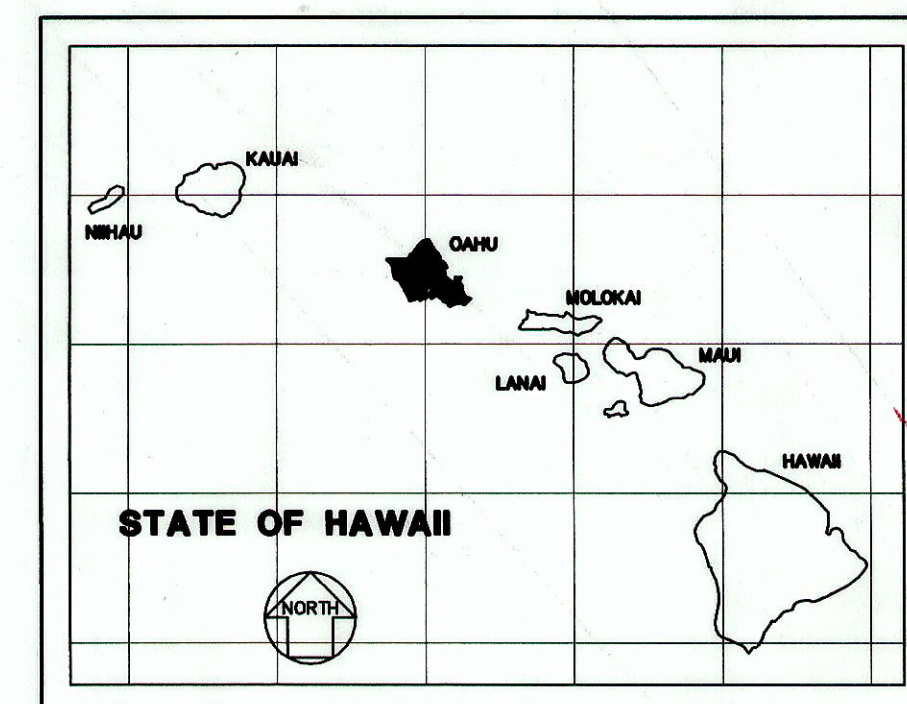

1 0 1 2 3 6 9
SCALE IN MILES

CHANGES MADE DURING CONSTRUCTION HAVE BEEN
INCORPORATED ON THESE PLANS EXCEPT CHANGES
IN THE ORIGINAL THEORETICAL QUANTITIES. FOR
ACTUAL QUANTITIES, REFER TO PROJECT LEDGER
AND/OR COMPUTATION BOOK.

9-24-2015
DATE

DEPARTMENT OF TRANSPORTATION STATE OF HAWAII
APPROVED:
for DIR. OF TRANSPORTATION
DATE