	INDEX TO DRAWINGS
SHEET NO.	DESCRIPTION
1	TITLE SHEET
2	STANDARD PLANS SUMMARY
3	LEGEND AND NOTES
4	SIGNING AND STRIPING PLAN
5	TRAFFIC SIGNAL PLAN
6	STREET SIGN DETAIL
.,,,	
<u> </u>	

STATE OF HAWAII

## DEPARTMENT OF TRANSPORTATION


HIGHWAYS DIVISION HONOLULU, HAWAII


"AS-BUILT"

PLANS FOR

JARRETT WHITE ROAD TRAFFIC SIGNALS AT ALA MAHAMOE STREET PROJECT NO. 7345A-01-91

DISTRICT OF HONOLULU ISLAND OF OAHU

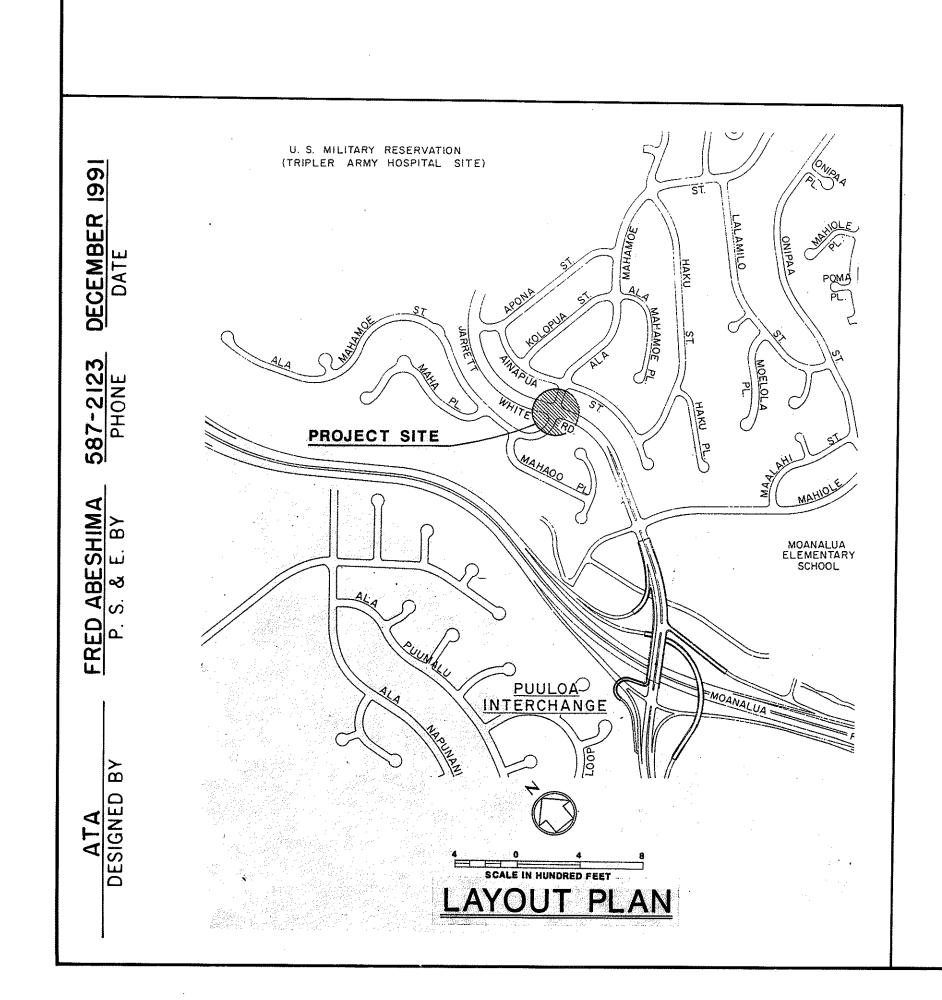

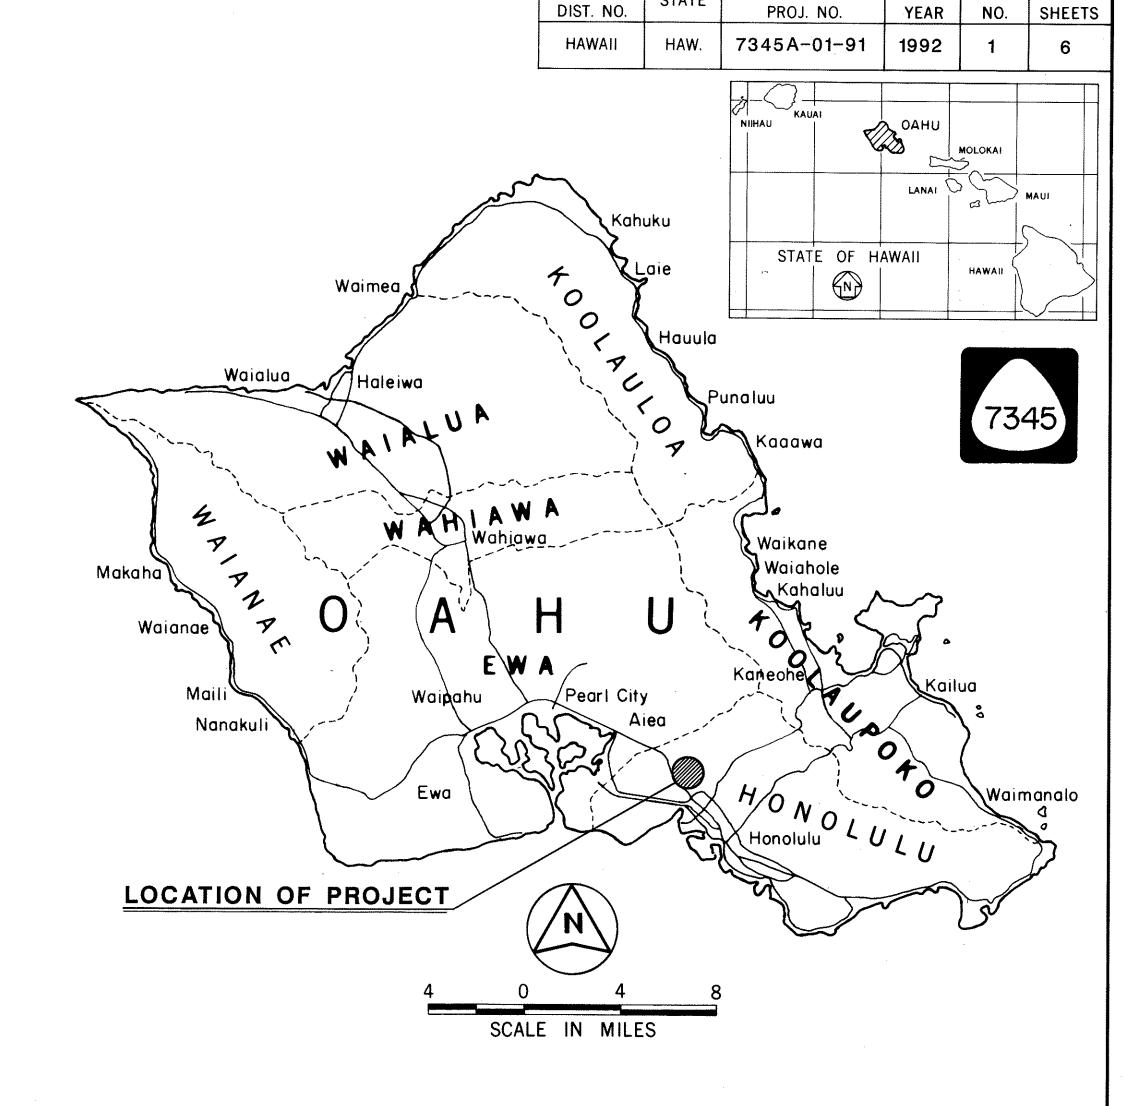

CHANGES MADE DURING CONSTRUCTION HAVE BEEN INCORPORATED ON THESE PLANS EXCEPT CHANGES IN THE ORIGINAL THEORETICAL QUANTITIES, FOR ACTUAL QUANTITIES, REFER TO PROJECT LEDGER AND/OR COMPUTATION BOOK.

RESIDENT ENGINEER

JAN. 13, 1993 DATE