


FED. ROAD DIST. NO.	STATE	FED. AID PROJ. NO.	FISCAL YEAR	SHEET NO.	TOTAL SHEETS
HAWAII	HAW.	I-HI-1(III):14	1974	5	234

NAVY - MARINE GOLF COURSE

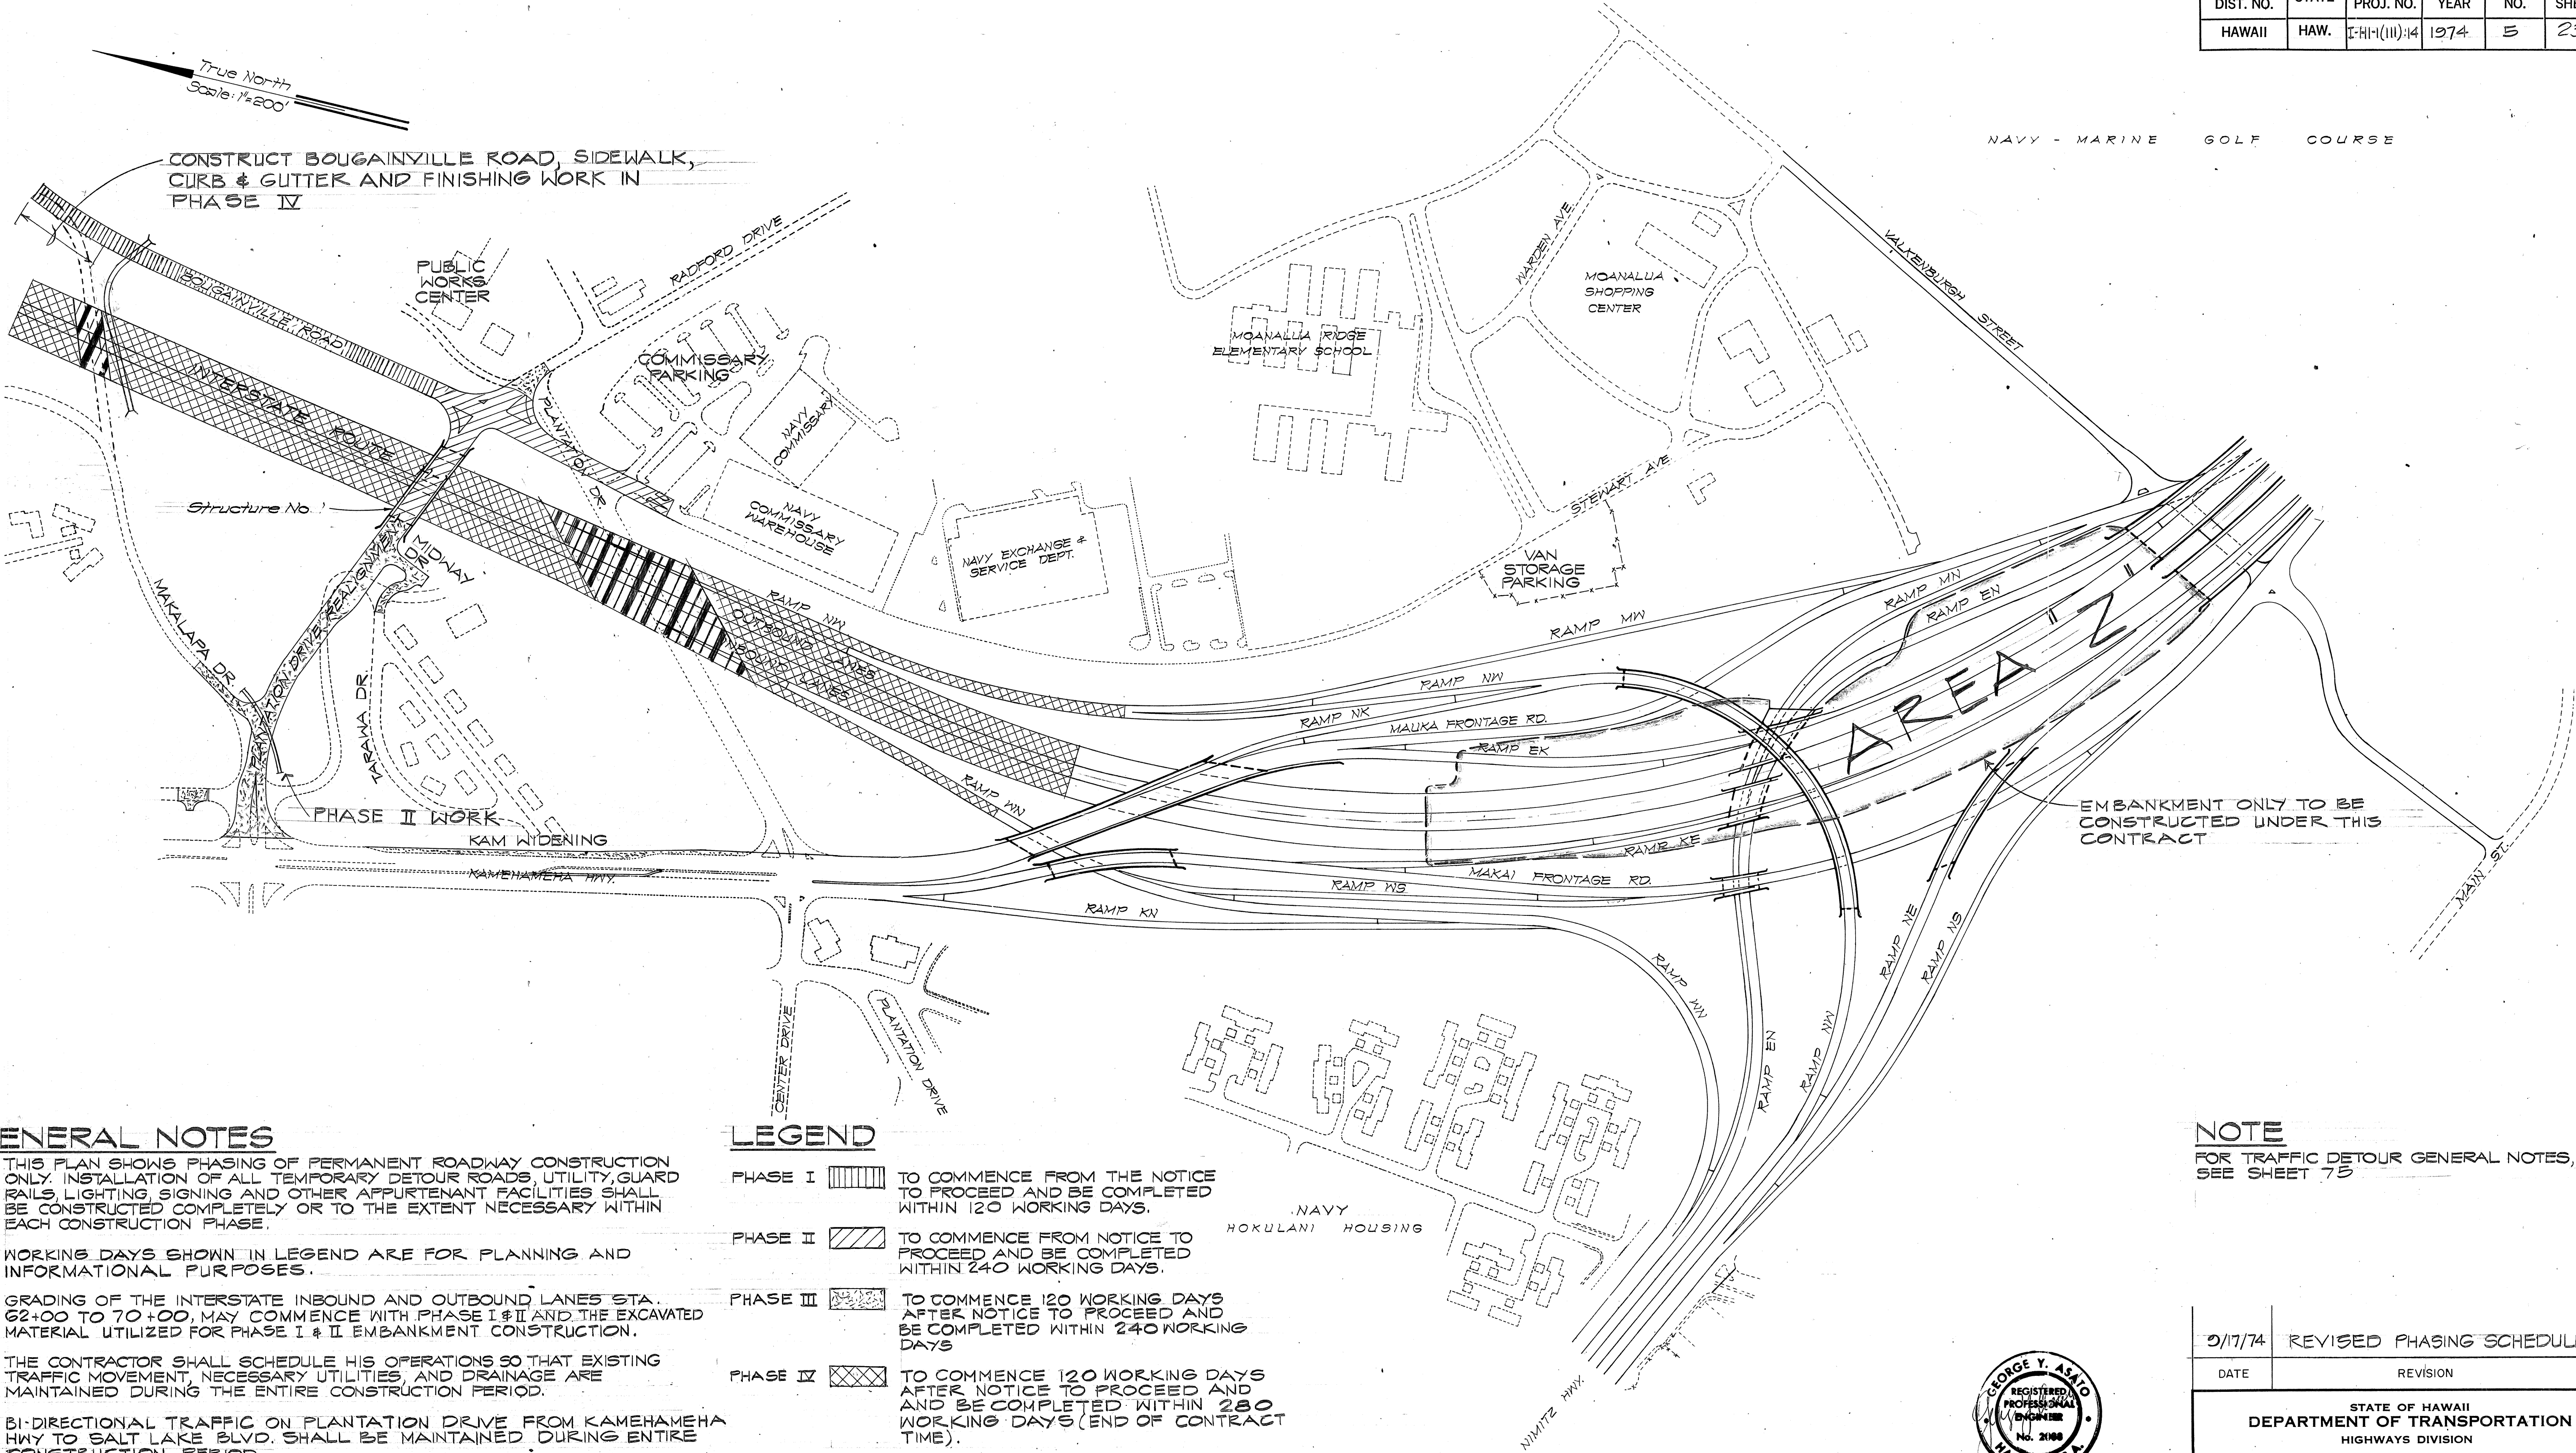

GENERAL NOTES

- THIS PLAN SHOWS PHASING OF PERMANENT ROADWAY CONSTRUCTION ONLY. INSTALLATION OF ALL TEMPORARY DETOUR ROADS, UTILITY, GUARD RAILS, LIGHTING, SIGNING AND OTHER APPURTENANT FACILITIES SHALL BE CONSTRUCTED COMPLETELY OR TO THE EXTENT NECESSARY WITHIN EACH CONSTRUCTION PHASE.
- WORKING DAYS SHOWN IN LEGEND ARE FOR PLANNING AND INFORMATIONAL PURPOSES.
- GRADING OF THE INTERSTATE INBOUND AND OUTBOUND LANES STA. 62+00 TO 70+00, MAY COMMENCE WITH PHASE I & II AND THE EXCAVATED MATERIAL UTILIZED FOR PHASE I & II EMBANKMENT CONSTRUCTION.
- THE CONTRACTOR SHALL SCHEDULE HIS OPERATIONS SO THAT EXISTING TRAFFIC MOVEMENT, NECESSARY UTILITIES, AND DRAINAGE ARE MAINTAINED DURING THE ENTIRE CONSTRUCTION PERIOD.
- BI-DIRECTIONAL TRAFFIC ON PLANTATION DRIVE FROM KAMEHAMEHA HWY TO SALT LAKE BLVD. SHALL BE MAINTAINED DURING ENTIRE CONSTRUCTION PERIOD.
- REFER TO SHEETS 212 TO 234 FOR LIMITS OF EMBANKMENT CONSTRUCTION, AREA "Z". REFER TO SECTION 103.04 "LIMITATION OF OPERATIONS" AND SECTION 104.03 "COOPERATION BETWEEN CONTRACTORS" OF THE SPECIAL PROVISION.
- THE FOLLOWING MAJOR WORK AREAS WILL HAVE TO BE CONSTRUCTED UNDER TRAFFIC (THE CONTRACTOR SHALL PROVIDE NECESSARY DETOUR ROADS TO MAINTAIN EXISTING TRAFFIC PATTERNS AT ALL TIMES):
 - PLANTATION DRIVE REALIGNMENT TOUCHDOWN POINTS AT KAMEHAMEHA HIGHWAY AND RADFORD DRIVE.
 - COMMISSARY RD. AT EXISTING PLANTATION DR. CROSSING.

LEGEND


- | | | |
|-----------|--|---|
| PHASE I | | TO COMMENCE FROM THE NOTICE TO PROCEED AND BE COMPLETED WITHIN 120 WORKING DAYS. |
| PHASE II | | TO COMMENCE FROM NOTICE TO PROCEED AND BE COMPLETED WITHIN 240 WORKING DAYS. |
| PHASE III | | TO COMMENCE 120 WORKING DAYS AFTER NOTICE TO PROCEED AND BE COMPLETED WITHIN 240 WORKING DAYS. |
| PHASE IV | | TO COMMENCE 120 WORKING DAYS AFTER NOTICE TO PROCEED AND AND BE COMPLETED WITHIN 280 WORKING DAYS (END OF CONTRACT TIME). |
| PHASE V | | TO COMMENCE 240 WORKING DAYS AFTER NOTICE TO PROCEED AND BE COMPLETED WITHIN 160 WORKING DAYS (END OF CONTRACT TIME). |

PLAN
SCALE: 1" = 200'

NOTE
FOR TRAFFIC DETOUR GENERAL NOTES, SEE SHEET 75

9/17/74	REVISED PHASING SCHEDULE
DATE	REVISION

STATE OF HAWAII DEPARTMENT OF TRANSPORTATION HIGHWAYS DIVISION	
CONSTRUCTION PHASING	
PEARL HARBOR INTERCHANGE F.A.I. PROJ. NO. I-HI-1(III):14	
SCALE: AS SHOWN	DATE: DEC. 14, 1973
SHEET NO. 1 OF 1 SHEETS	

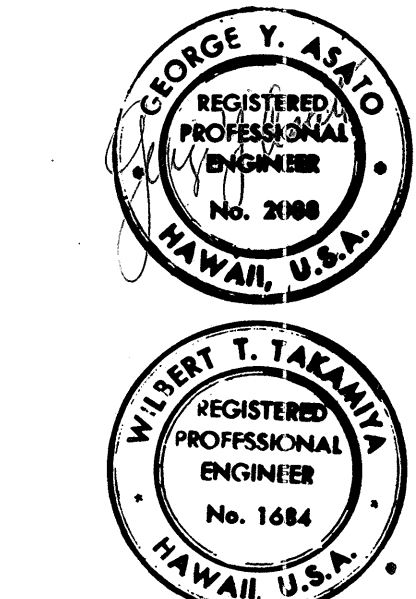

THIS WORK WAS PREPARED BY ME OR UNDER MY SUPERVISION

C.O. 5