
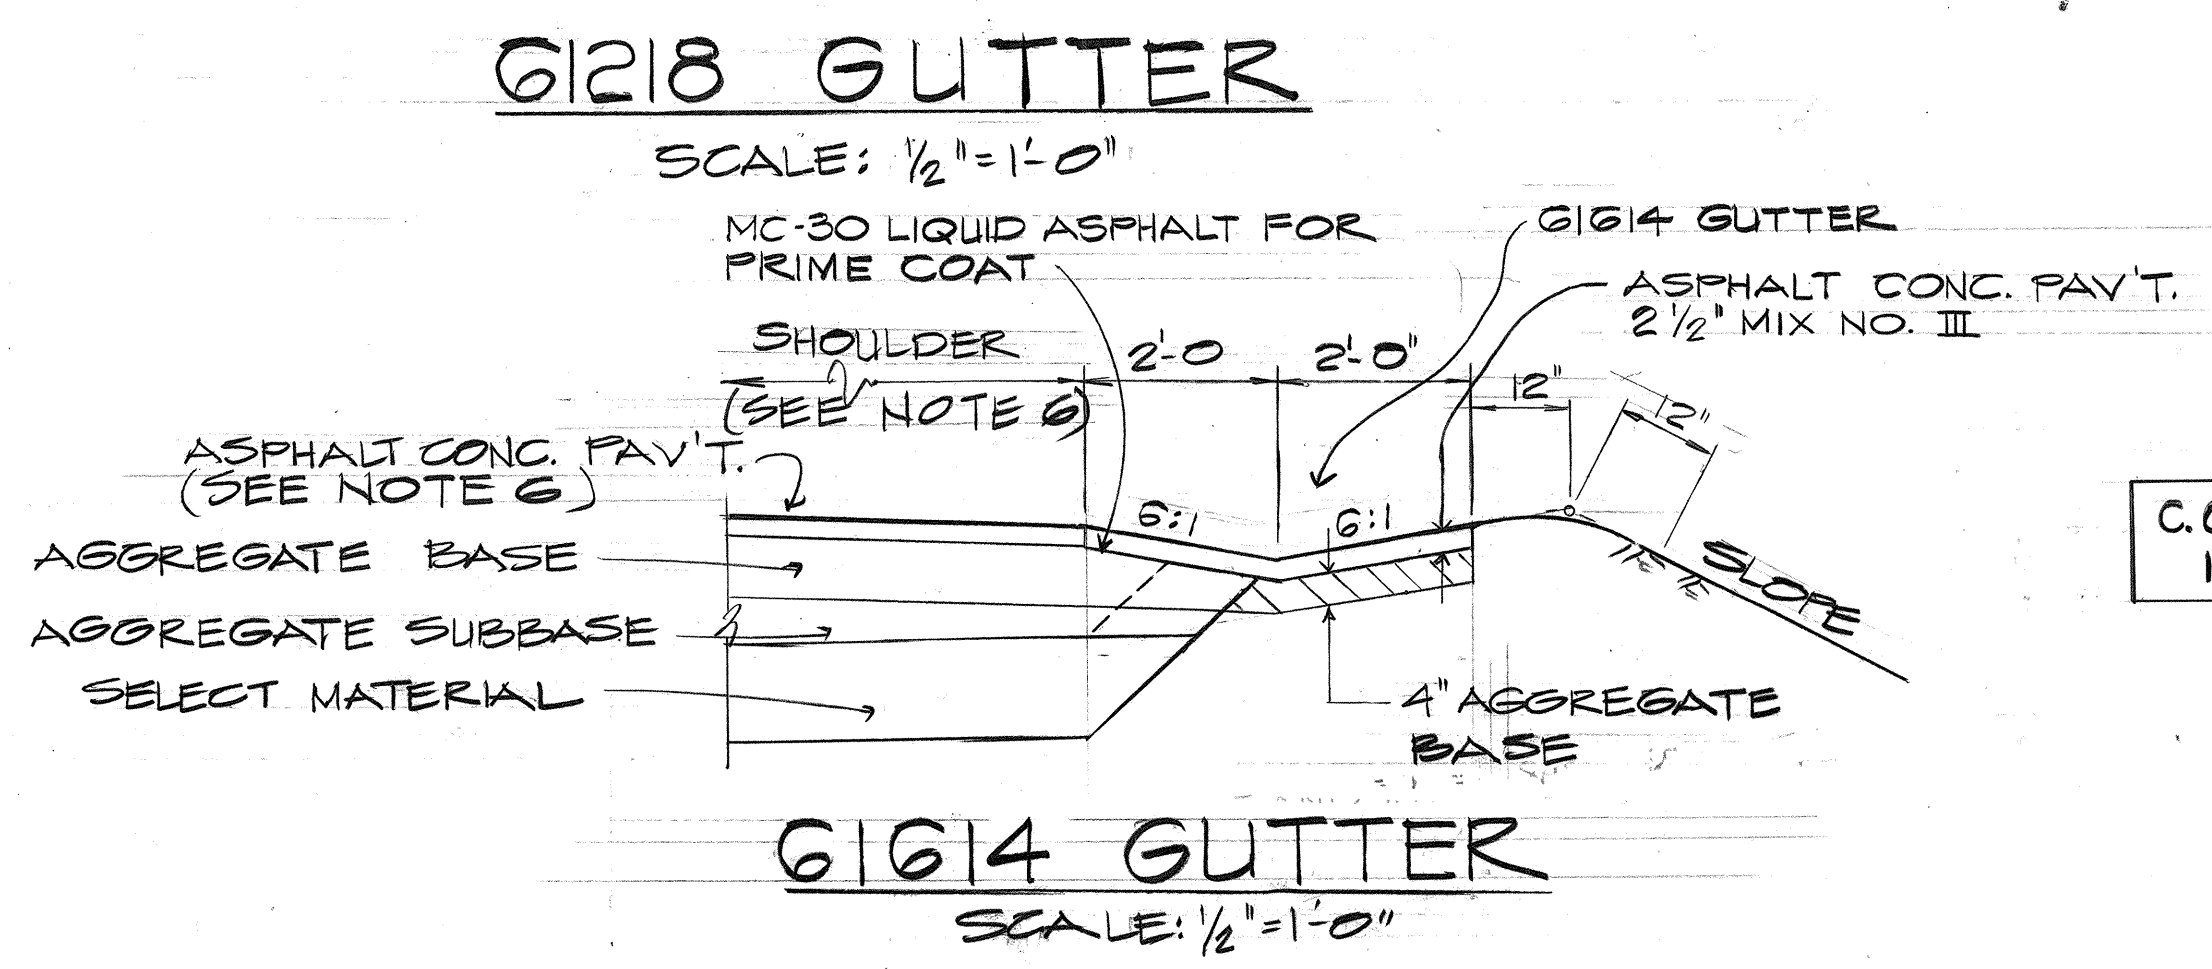
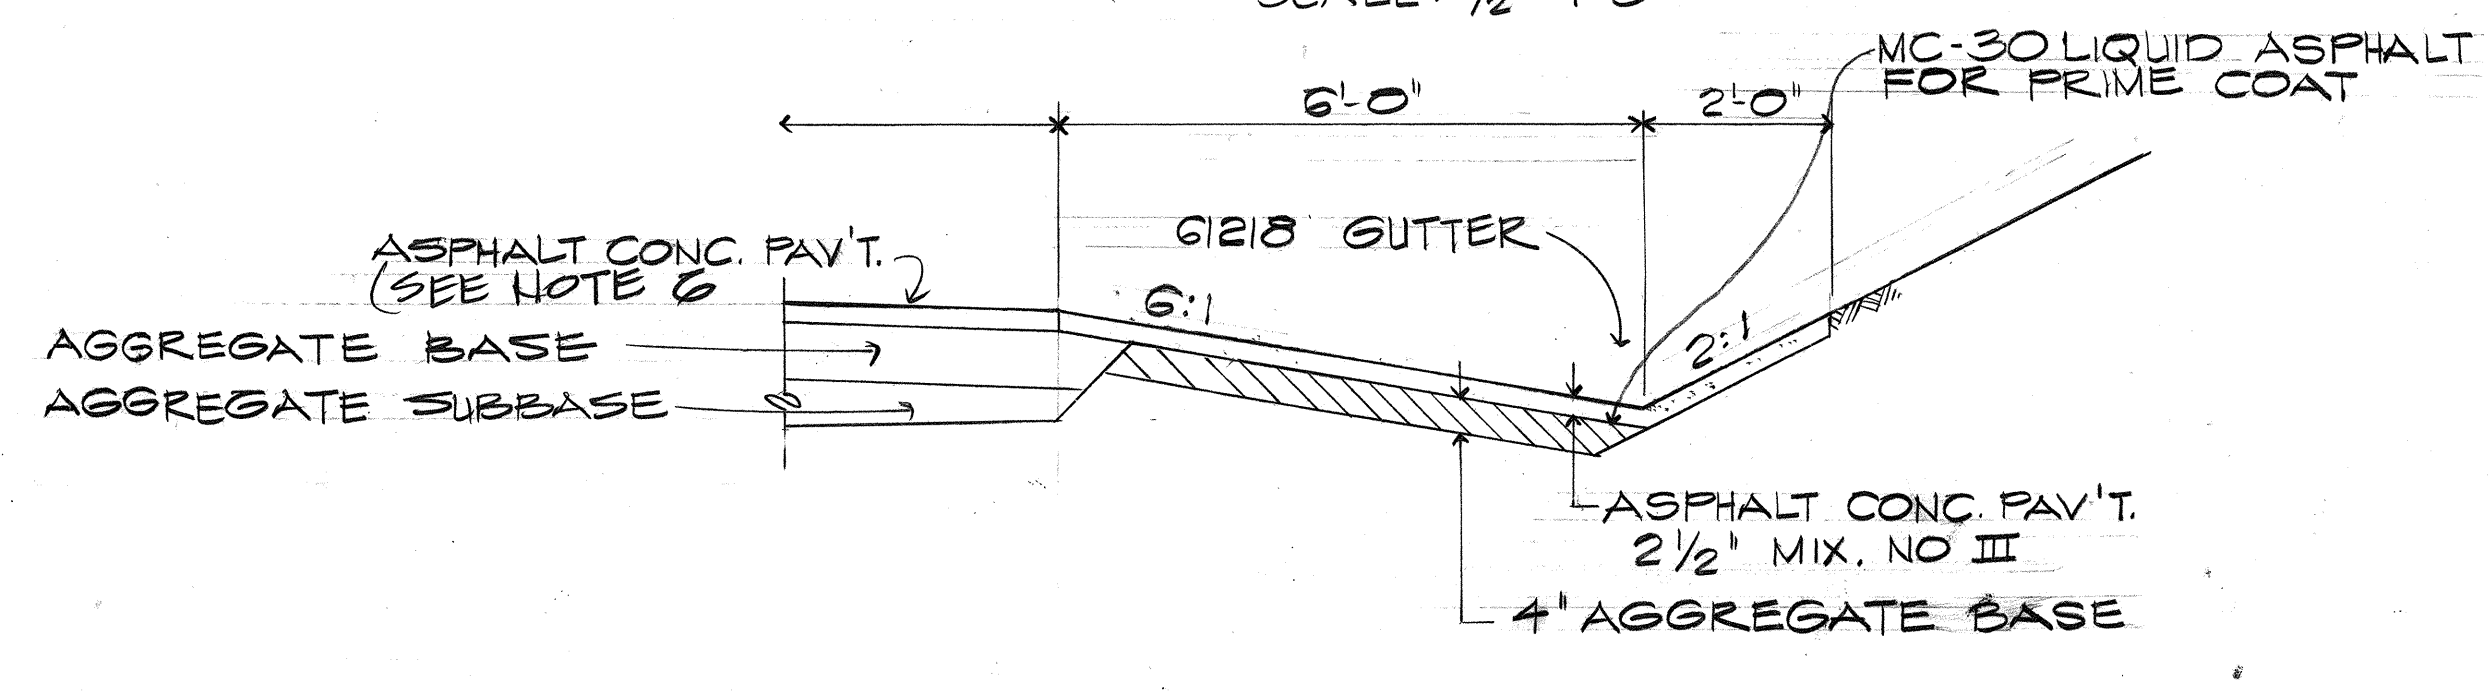
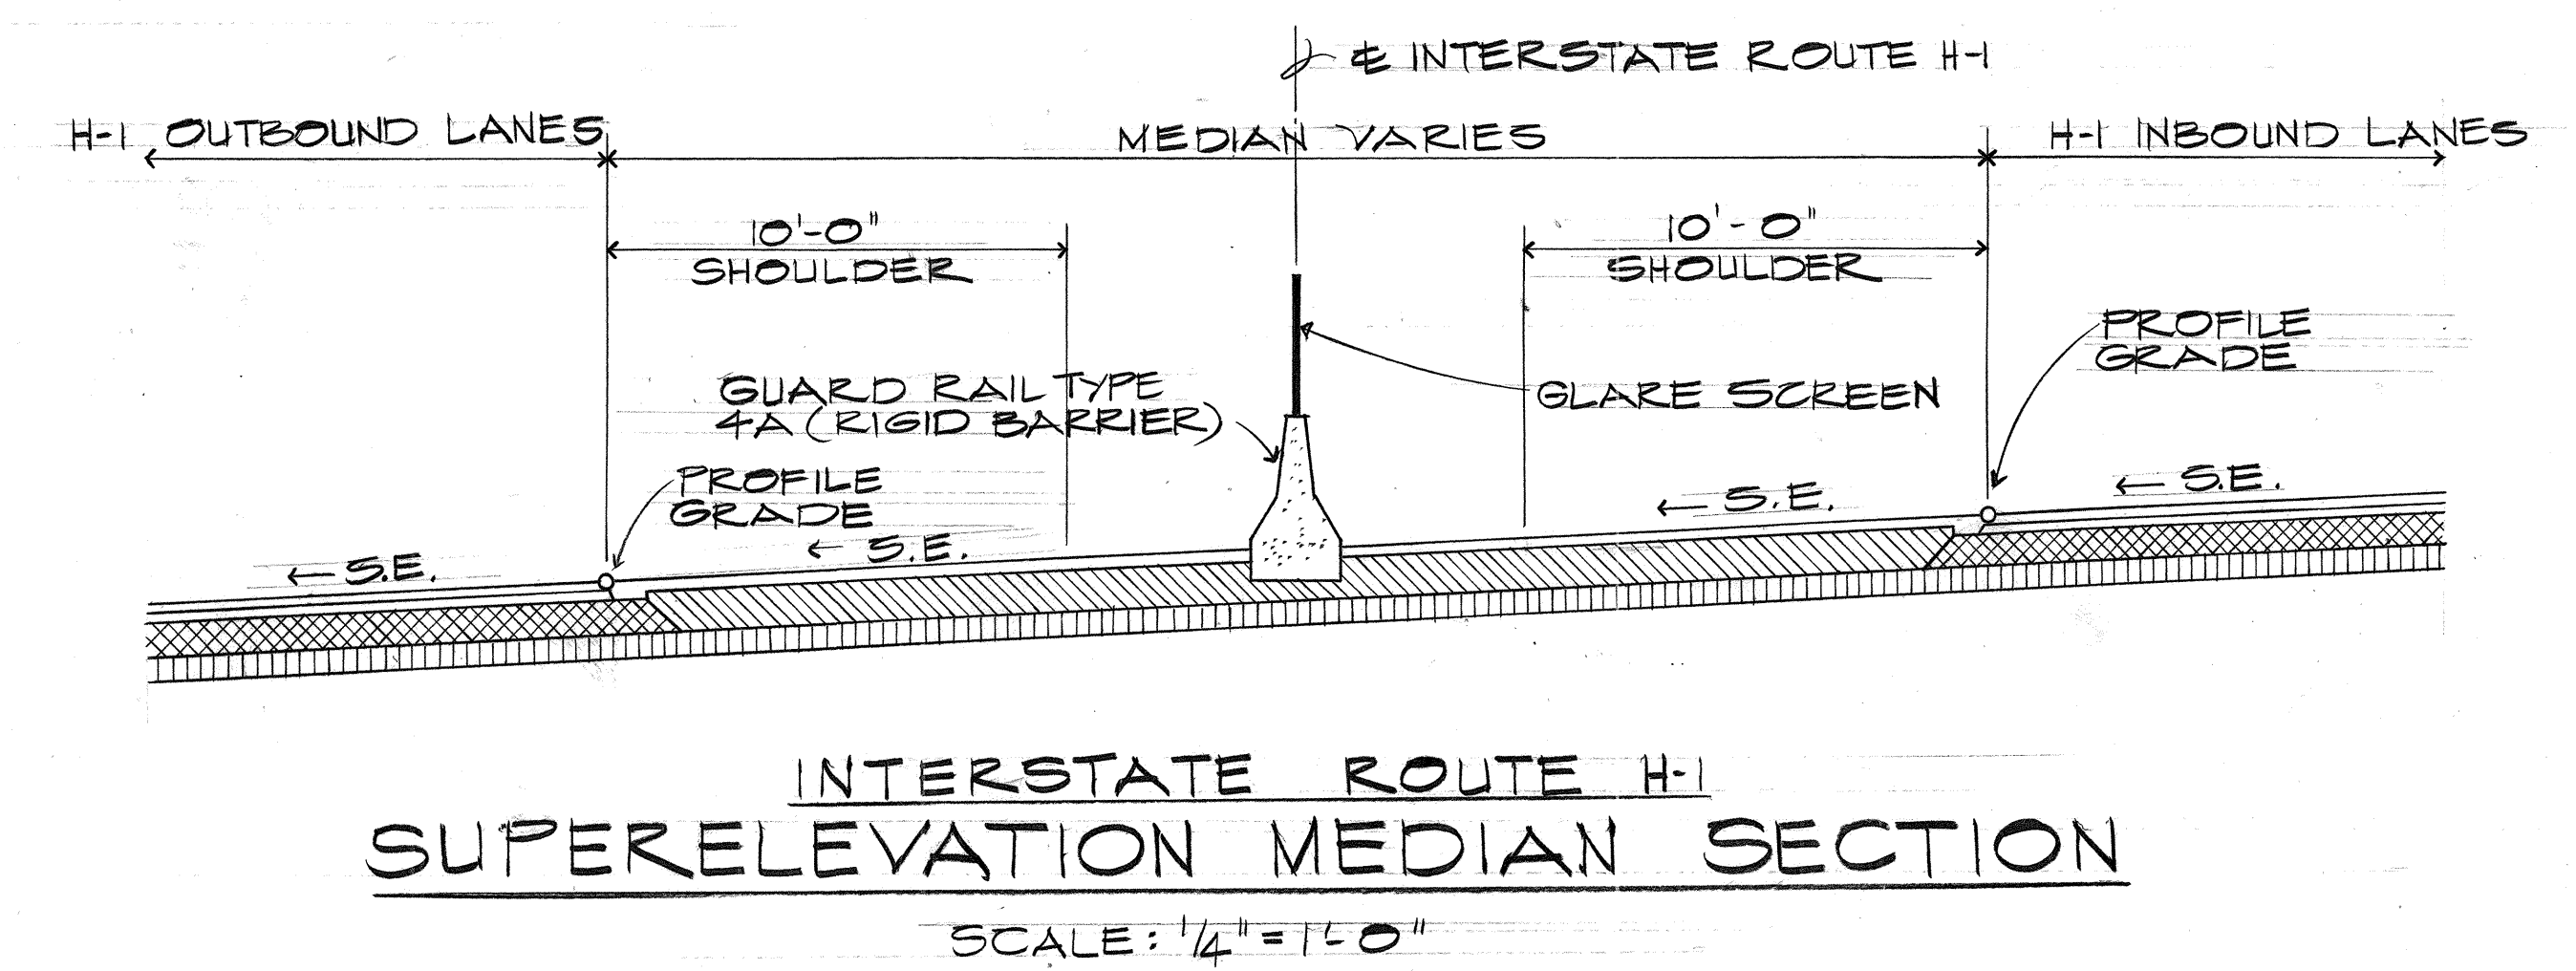
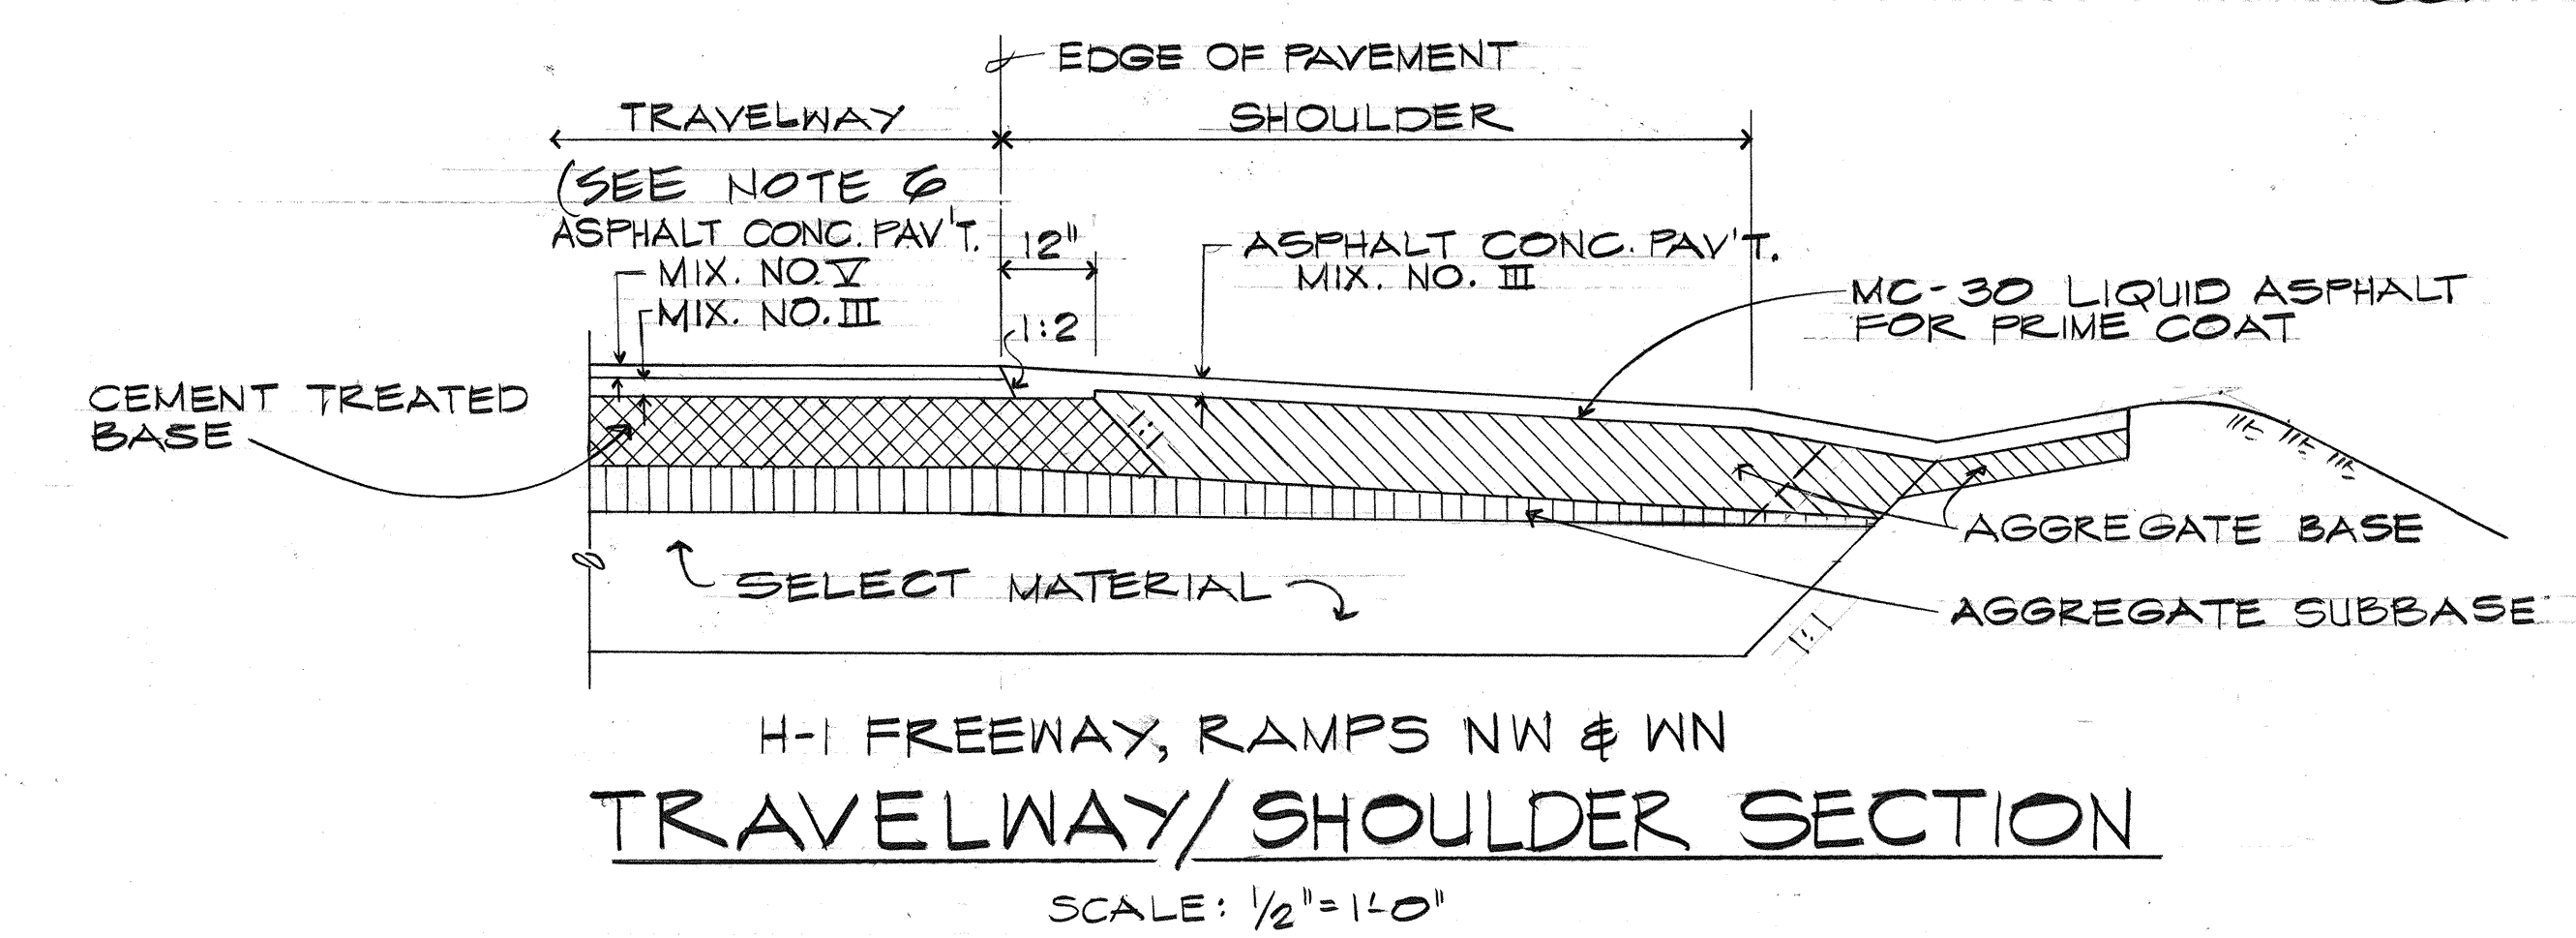


FED. ROAD DIST. NO.	STATE	FED. AID PROJ. NO.	FISCAL YEAR	SHEET NO.	TOTAL SHEETS
HAWAII	HAW.	I-H-1(11):14	1974	6	234

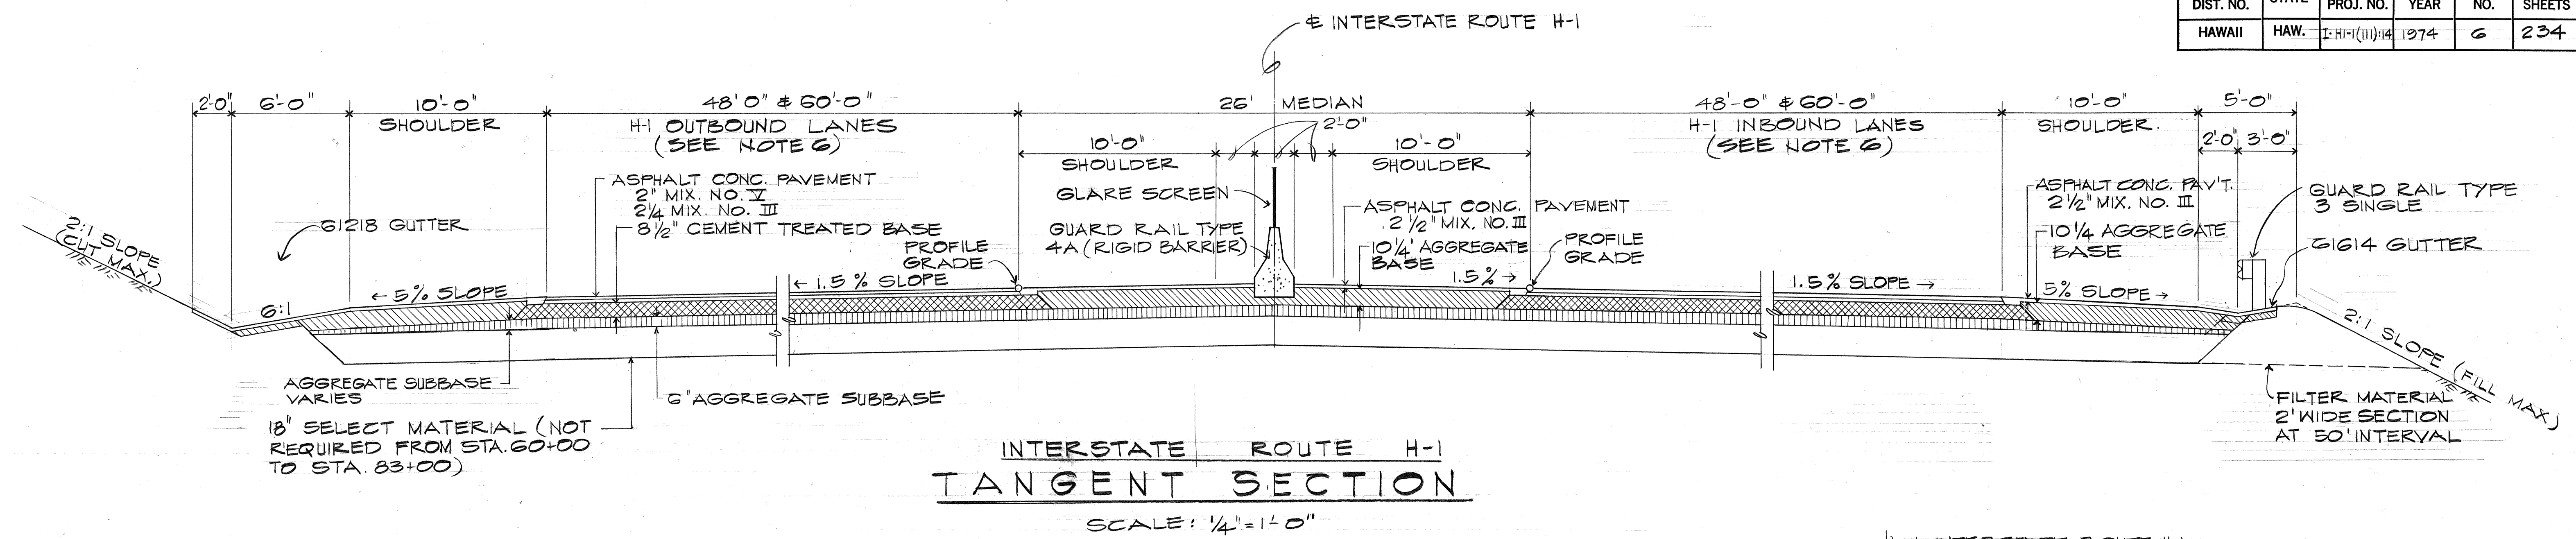


GENERAL NOTES:

1. FOR RAMPS AND ROADWAYS THE SUPERELEVATION AXIS OF ROTATION IS THE BASELINE. FOR THE INTERSTATE ROUTE H-1 THE AXIS OF ROTATION IS THE INSIDE EDGE OF TRAVELWAY FOR THE RESPECTIVE INBOUND AND OUTBOUND LANES.
2. SEE PLAN & PROFILE SHEET FOR THE RELATIONSHIP OF H-1 INBOUND PROFILE GRADE TO H-1 OUTBOUND PROFILE GRADE.
3. PROFILE GRADES (BASELINE) FOR RAMPS AND ROADWAYS ARE SHOWN ON THE PLAN AND PROFILE SHEETS.
4. ALL TYPICAL SECTIONS SHOWN ARE IN THE DIRECTION OF TRAVEL.
5. FOR CURBS AND CURB & GUTTER, SPACE EXPANSION JOINTS 20' APART.
6. H-1 INBOUND AND OUTBOUND LANES ASPHALT CONC. PAVEMENT 2" MIX. NO. III IS TO BE DELETED FROM THIS CONTRACT H-1 OUTB. & STA. 70+00 TO 83+00, H-1 INB. STA. 73+00 TO 83+00 SEE PLAN SHTS. C.O. 71, C.O. 78

C.C.O. # 29
12-19-75







11/14/75 ADDED GENERAL NOTE G
4/19/74 REMOVE REDWOOD HEADERS
DATE REVISION

STATE OF HAWAII
DEPARTMENT OF TRANSPORTATION
HIGHWAYS DIVISION
PEARL HARBOR INTERCHANGE
F.A.T. PROJ. NO. I-H-1(11):14
SCALE: AS SHOWN DATE: DEC. 14, 1973
SHEET NO. 1 OF 2 SHEETS

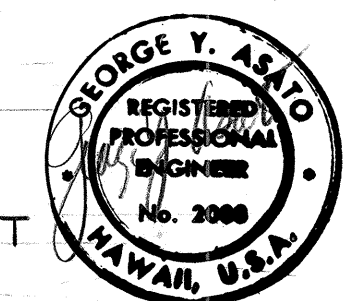

Willbert T. Takanaka
THIS WORK WAS PREPARED BY ME
OR UNDER MY SUPERVISION

FED. ROAD DIST. NO.	STATE	FED. AID PROJ. NO.	FISCAL YEAR	SHEET NO.	TOTAL SHEETS
HAWAII	HAW.	I-HI-1(III):14	1974	7	234

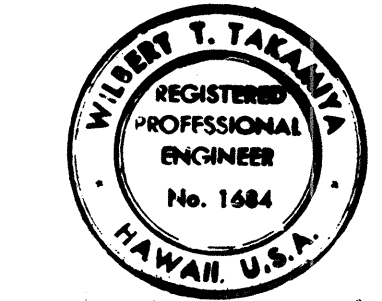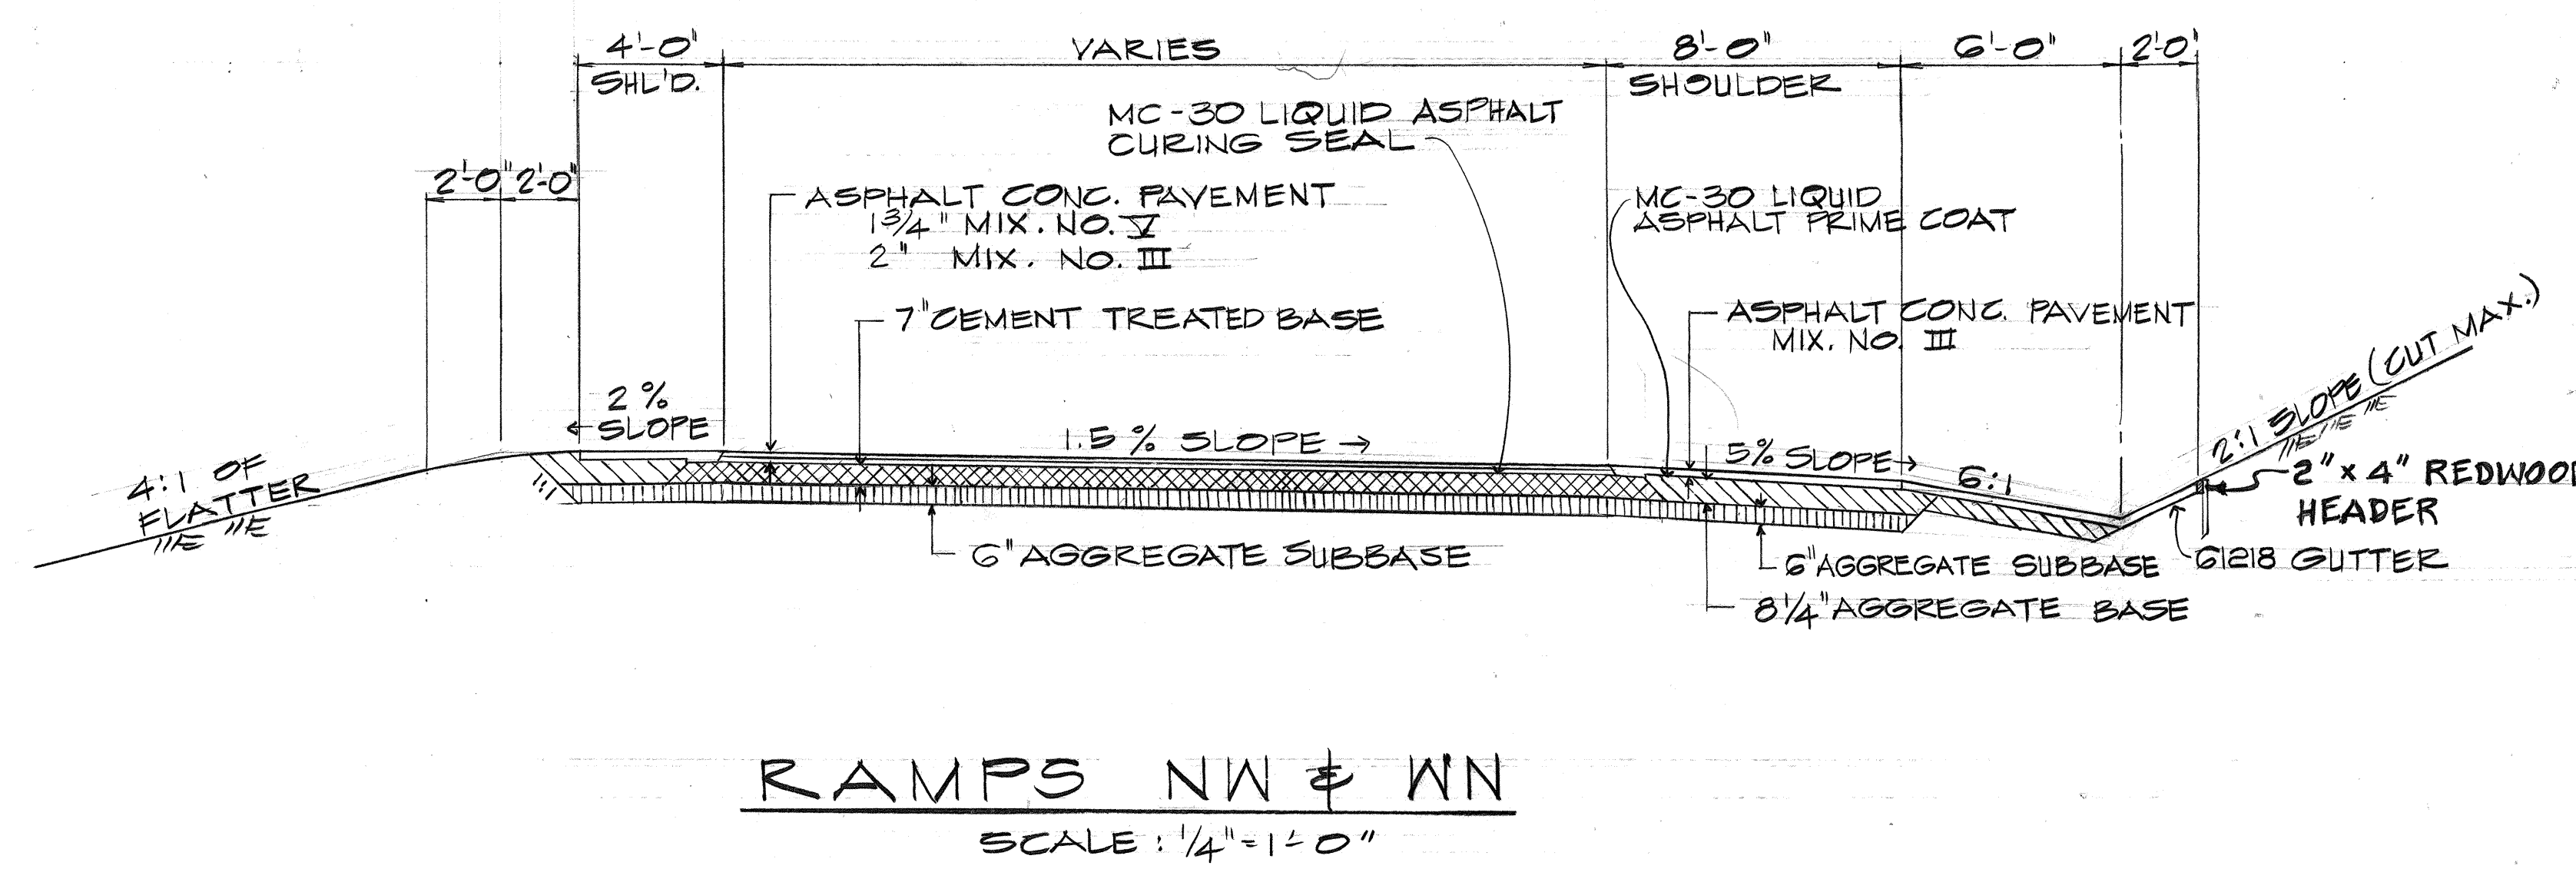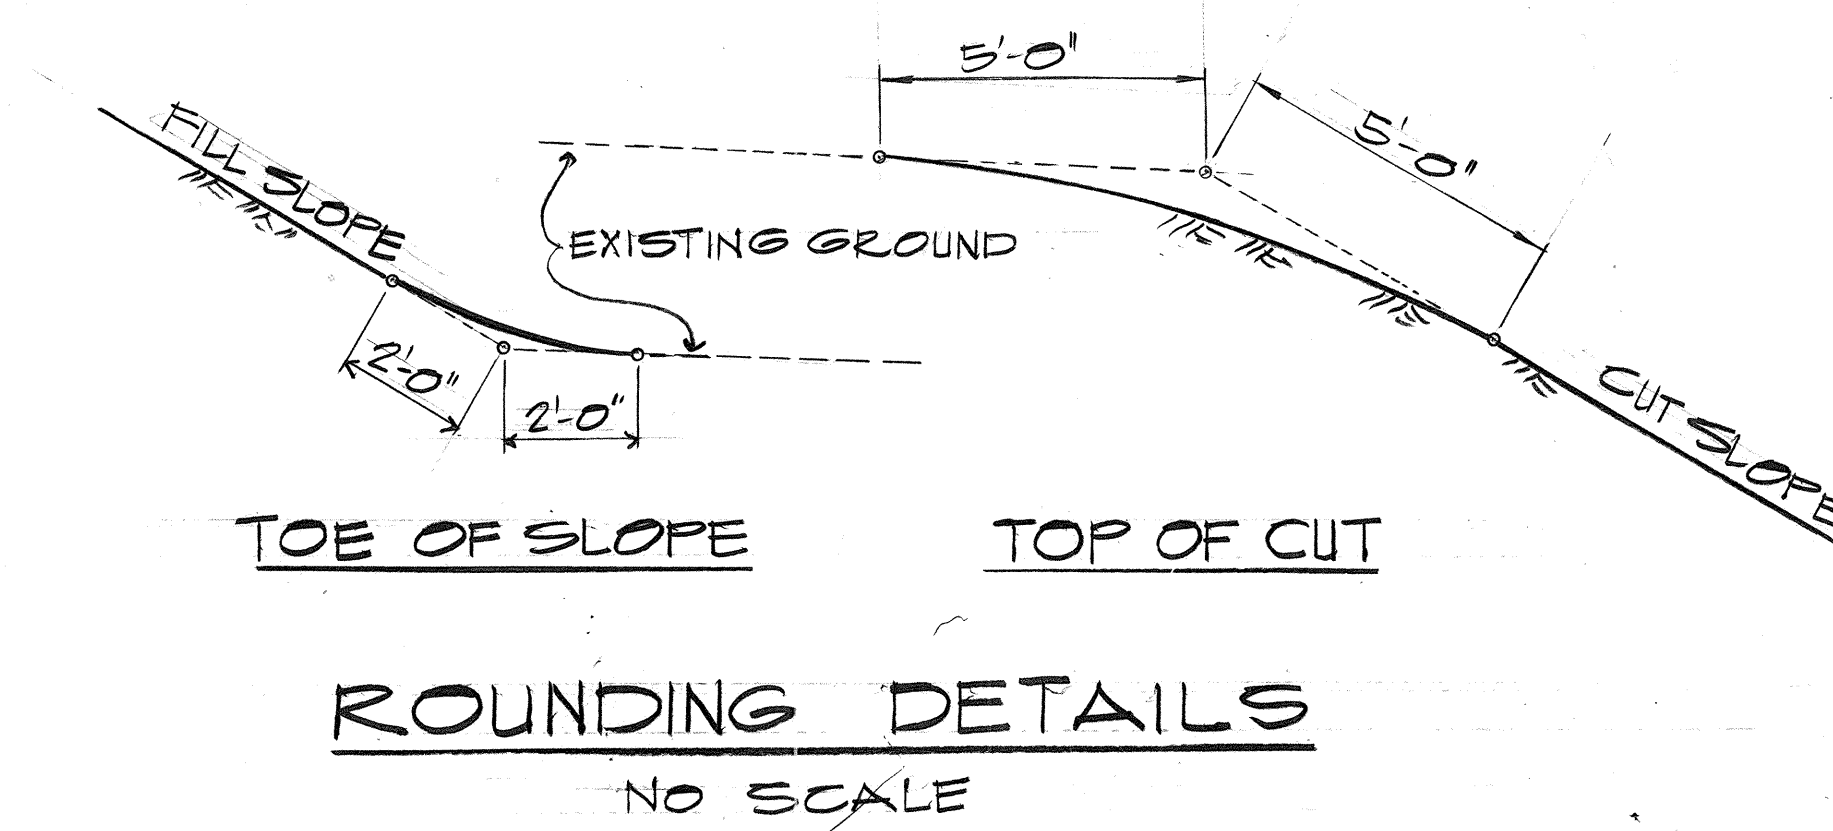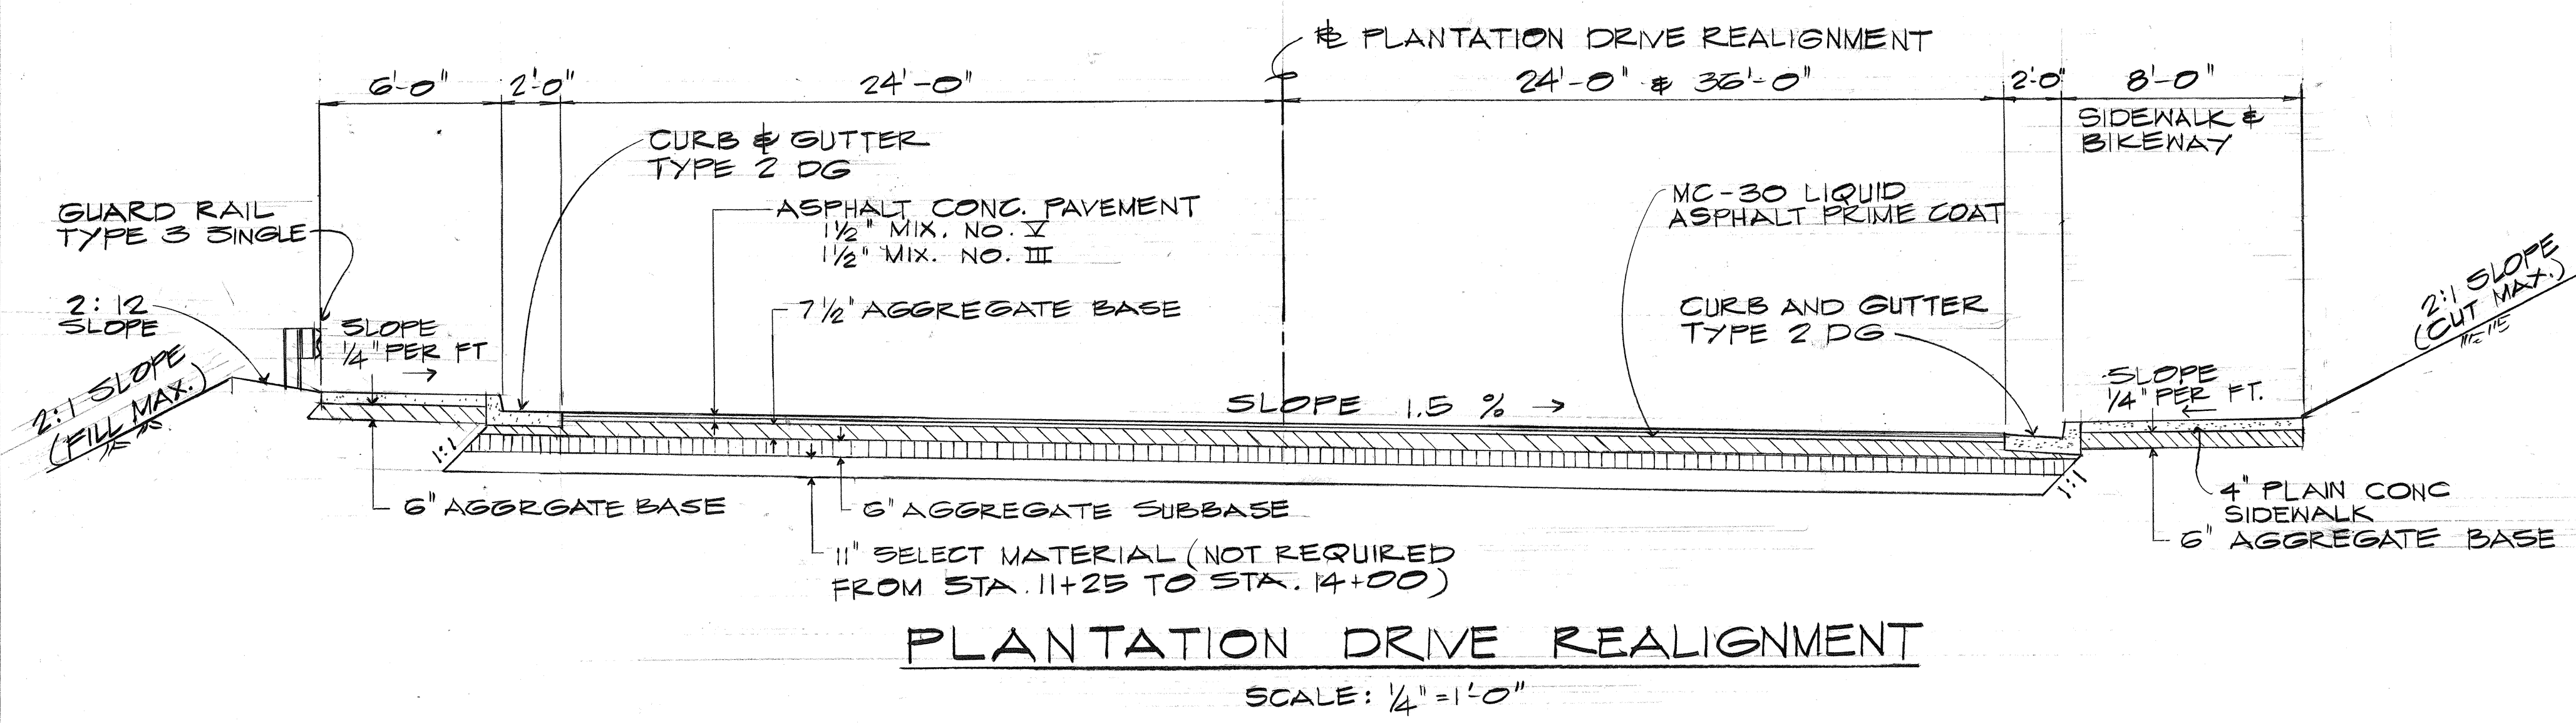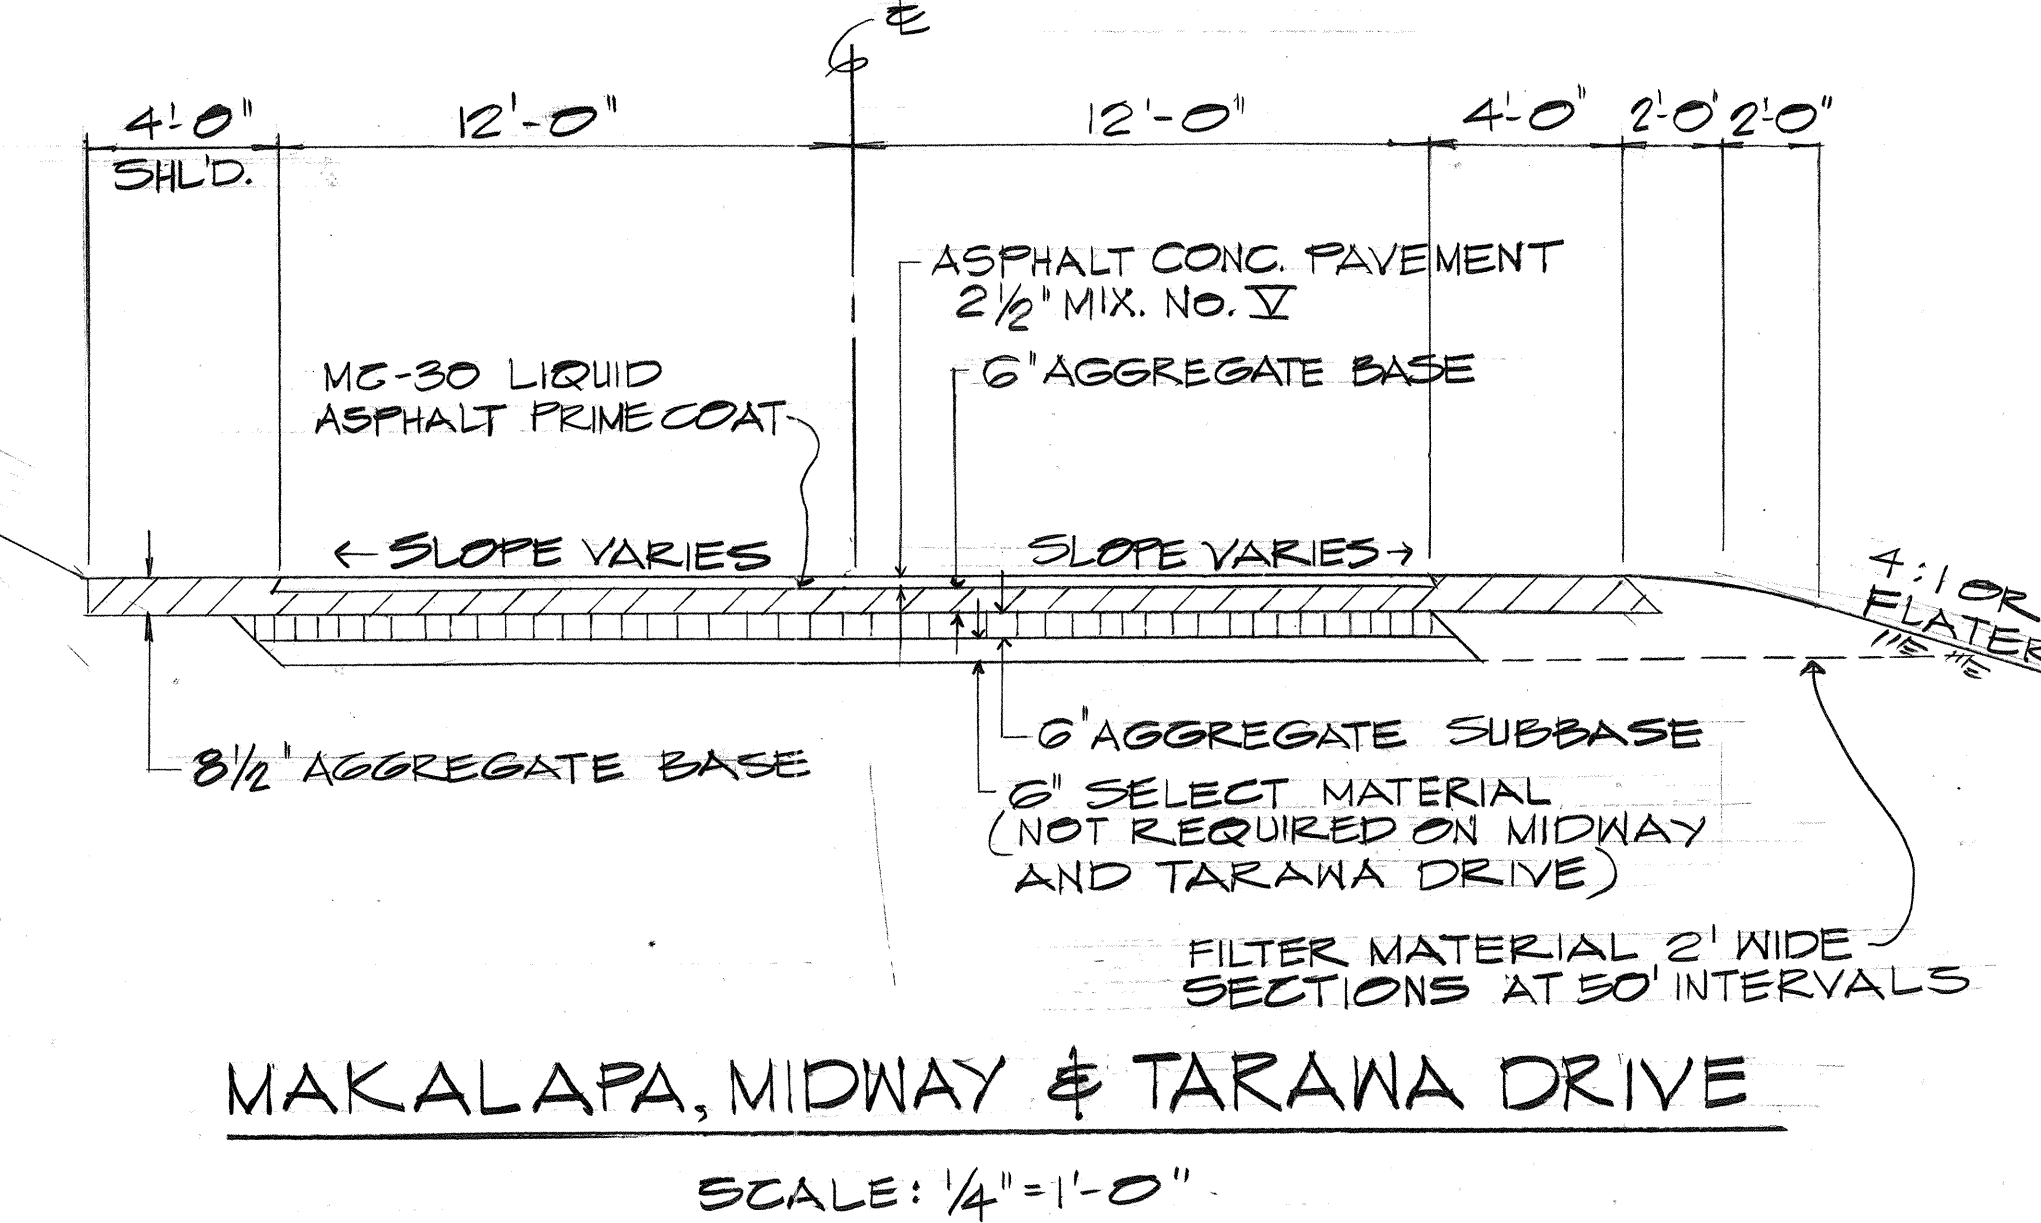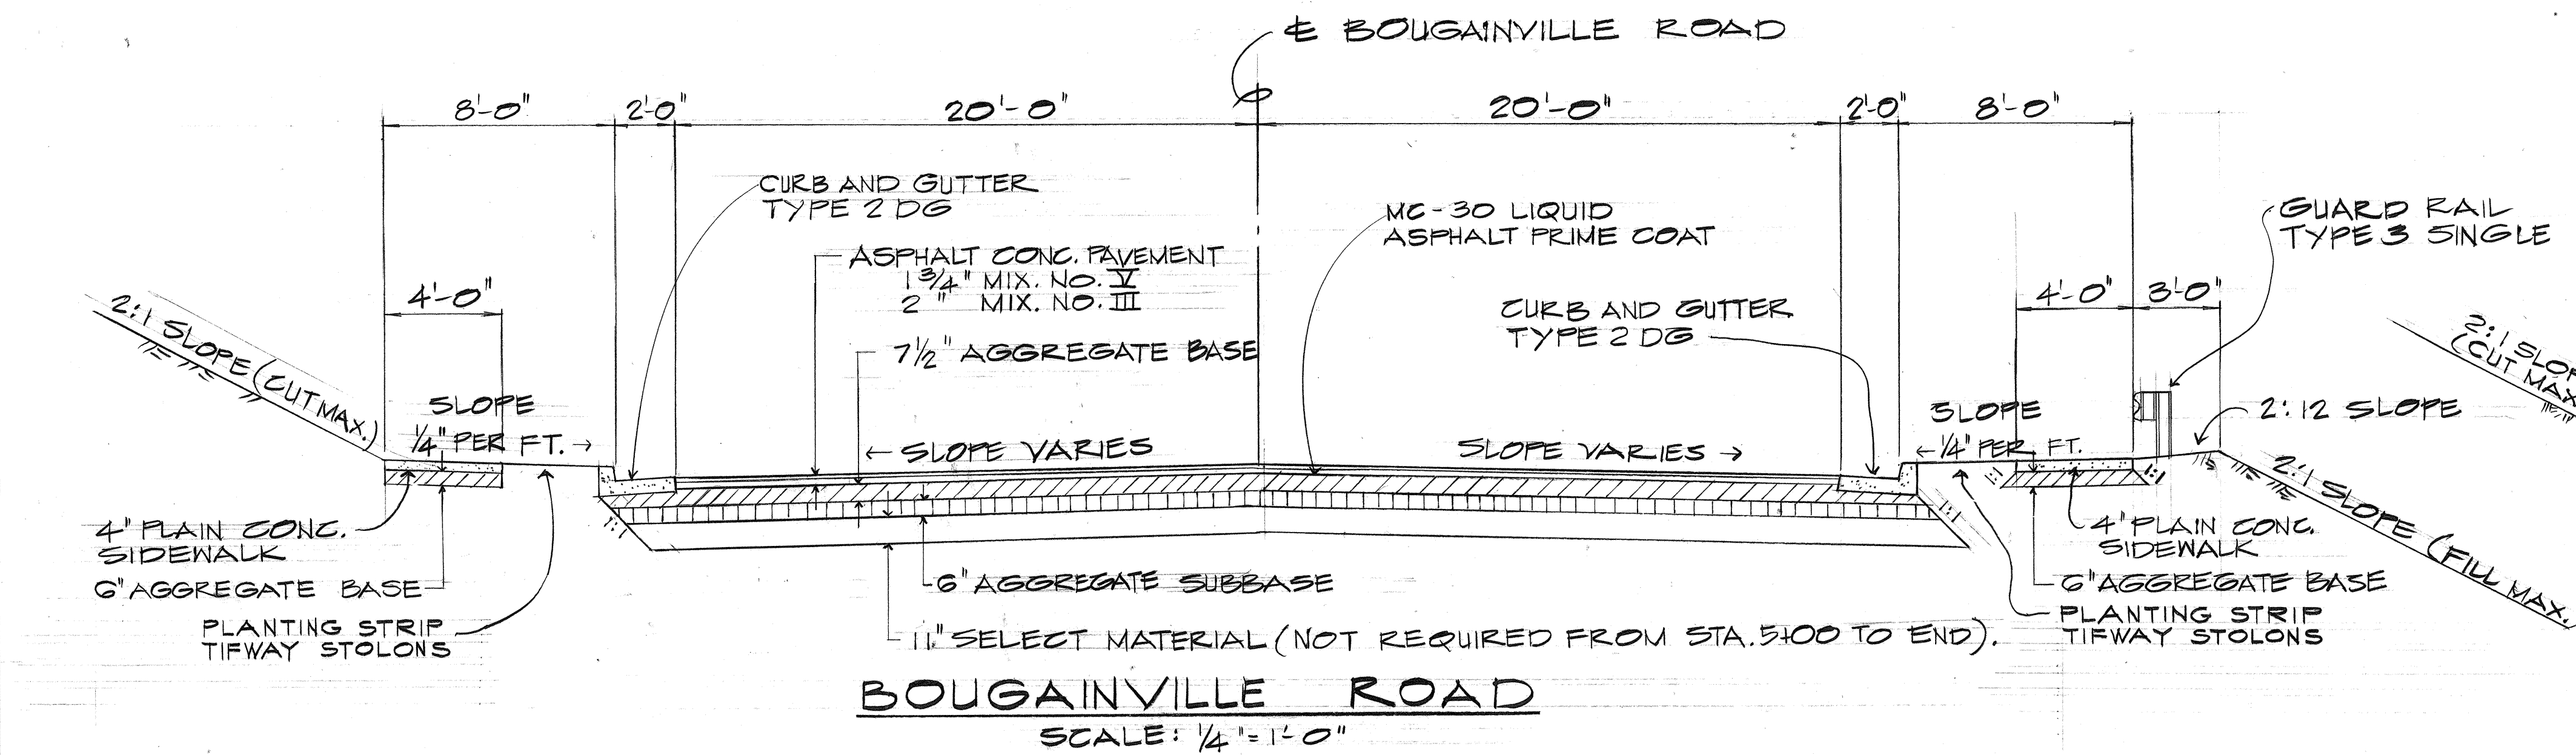

WILBERT T. TAKAMA
THIS WORK WAS PREPARED BY ME
OR UNDER MY SUPERVISION

C.C.O. #23 2nd Supplement	
4/19/74	REMOVE REDWOOD HEADERS
DATE	REVISION
STATE OF HAWAII DEPARTMENT OF TRANSPORTATION HIGHWAYS DIVISION	
TYPICAL ROADWAY SECTIONS	
PEARL HARBOR INTERCHANGE F.A.I. PROJ. NO. I-HI-1(III):14	
SCALE: AS SHOWN	DATE: DEC. 14, 1973
SHEET NO. 2 OF 2 SHEETS	