


FED. ROAD DIST. NO.	STATE	FED. AID PROJ. NO.	FISCAL YEAR	SHEET NO.	TOTAL SHEETS
HAWAII	HAW.	STP-0300(32)	1994	15	21

LOOP DETECTOR NOTES:

1. The Contractor shall notify the Traffic Signal Branch, Dept. of Transportation Services, City & County of Honolulu, 2 week prior to commencing any loop detector work.
2. Dept. of Transportation Services, City & County of Honolulu, will assist the Engineer in construction inspection for the loop detector work.
3. The exact locations of the new loop detectors shall be determined in the field by the Engineer.
4. Loop detectors damaged during the Contractor's reconstruction of pavement areas of cold planing operation shall be replaced within 48 hours, at his cost, in accordance with the requirements of the City & County of Honolulu. Replacement and location of the new loop detectors shall be as directed by the Engineer.
5. Existing loop detectors not incorporated into the new traffic signal system shall be abandoned in place.

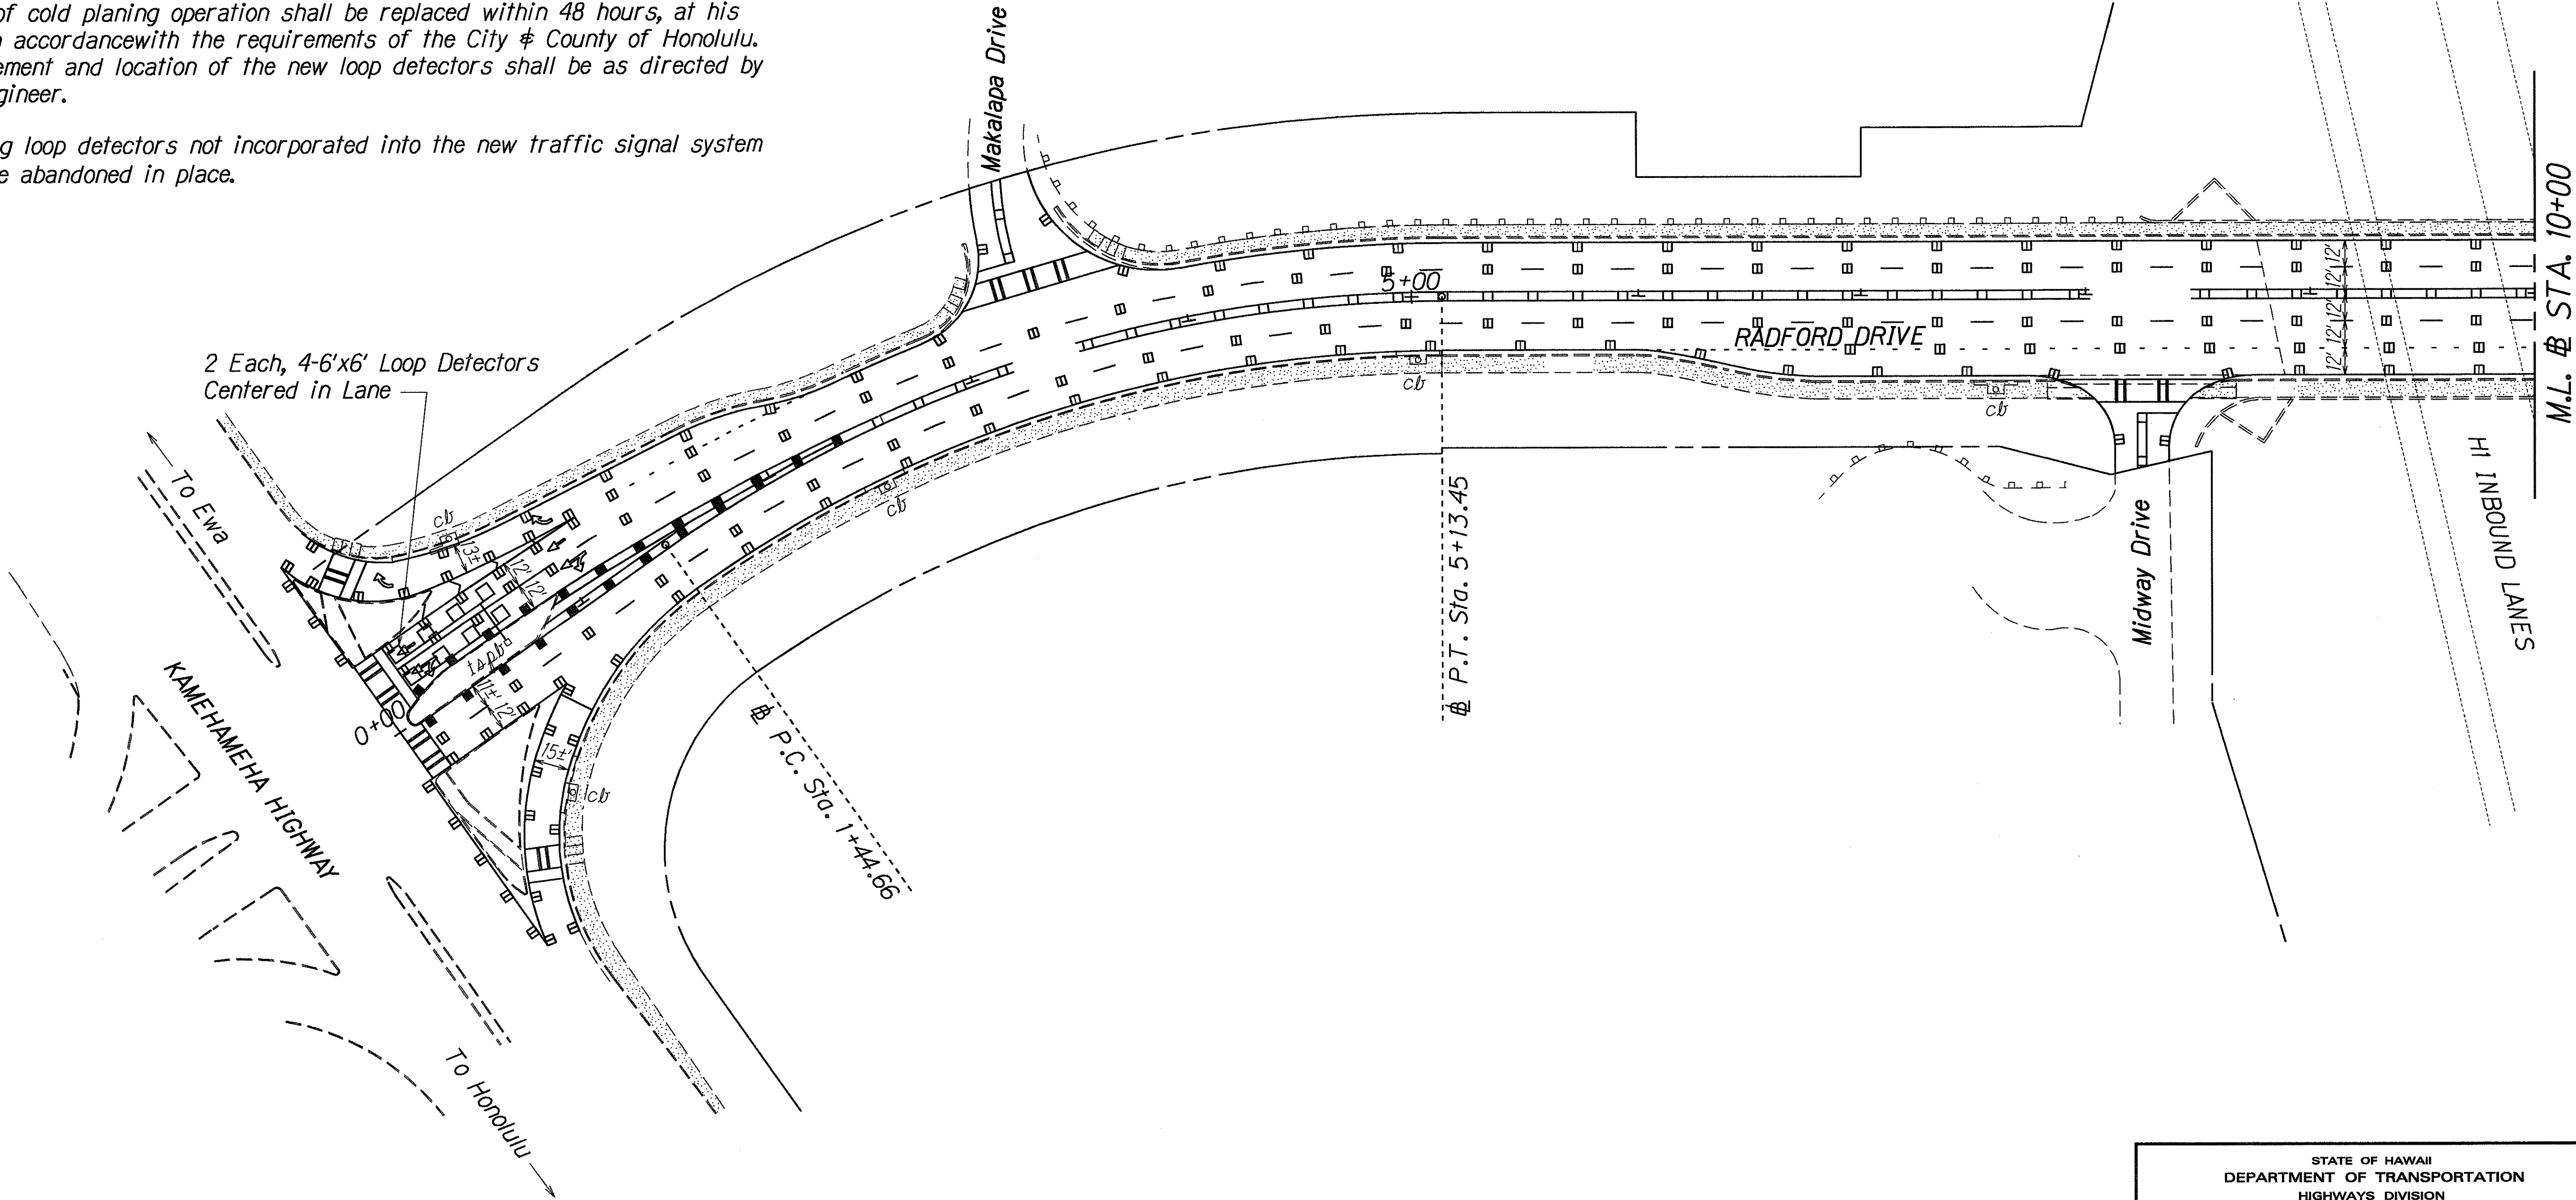

ORIGINAL PLAN	SURVEY PLOTTED BY	DATE
NOTE BOOK	DRAWN BY R. Ahi	1/94
10/1/94	TRACED BY G. Kato	
10/1/94	QUANTITIES BY	
10/1/94	CHECKED BY	

STATE OF HAWAII
DEPARTMENT OF TRANSPORTATION
HIGHWAYS DIVISION

LOOP DETECTOR PLAN

RADFORD DR. & BOUGAINVILLE DR.

RESURFACING


Kamehameha Hwy. Towards Salt Lake Blvd.

FED. AID PROJ. NO. STP-0300(32)

Scale: 1" = 40' Date: Jan., 1994

SHEET No. 15 OF 21 SHEETS

FED. ROAD DIST. NO.	STATE	FED. AID PROJ. NO.	FISCAL YEAR	SHEET NO.	TOTAL SHEETS
HAWAII	HAW.	STP-0300(32)	1994	16	21

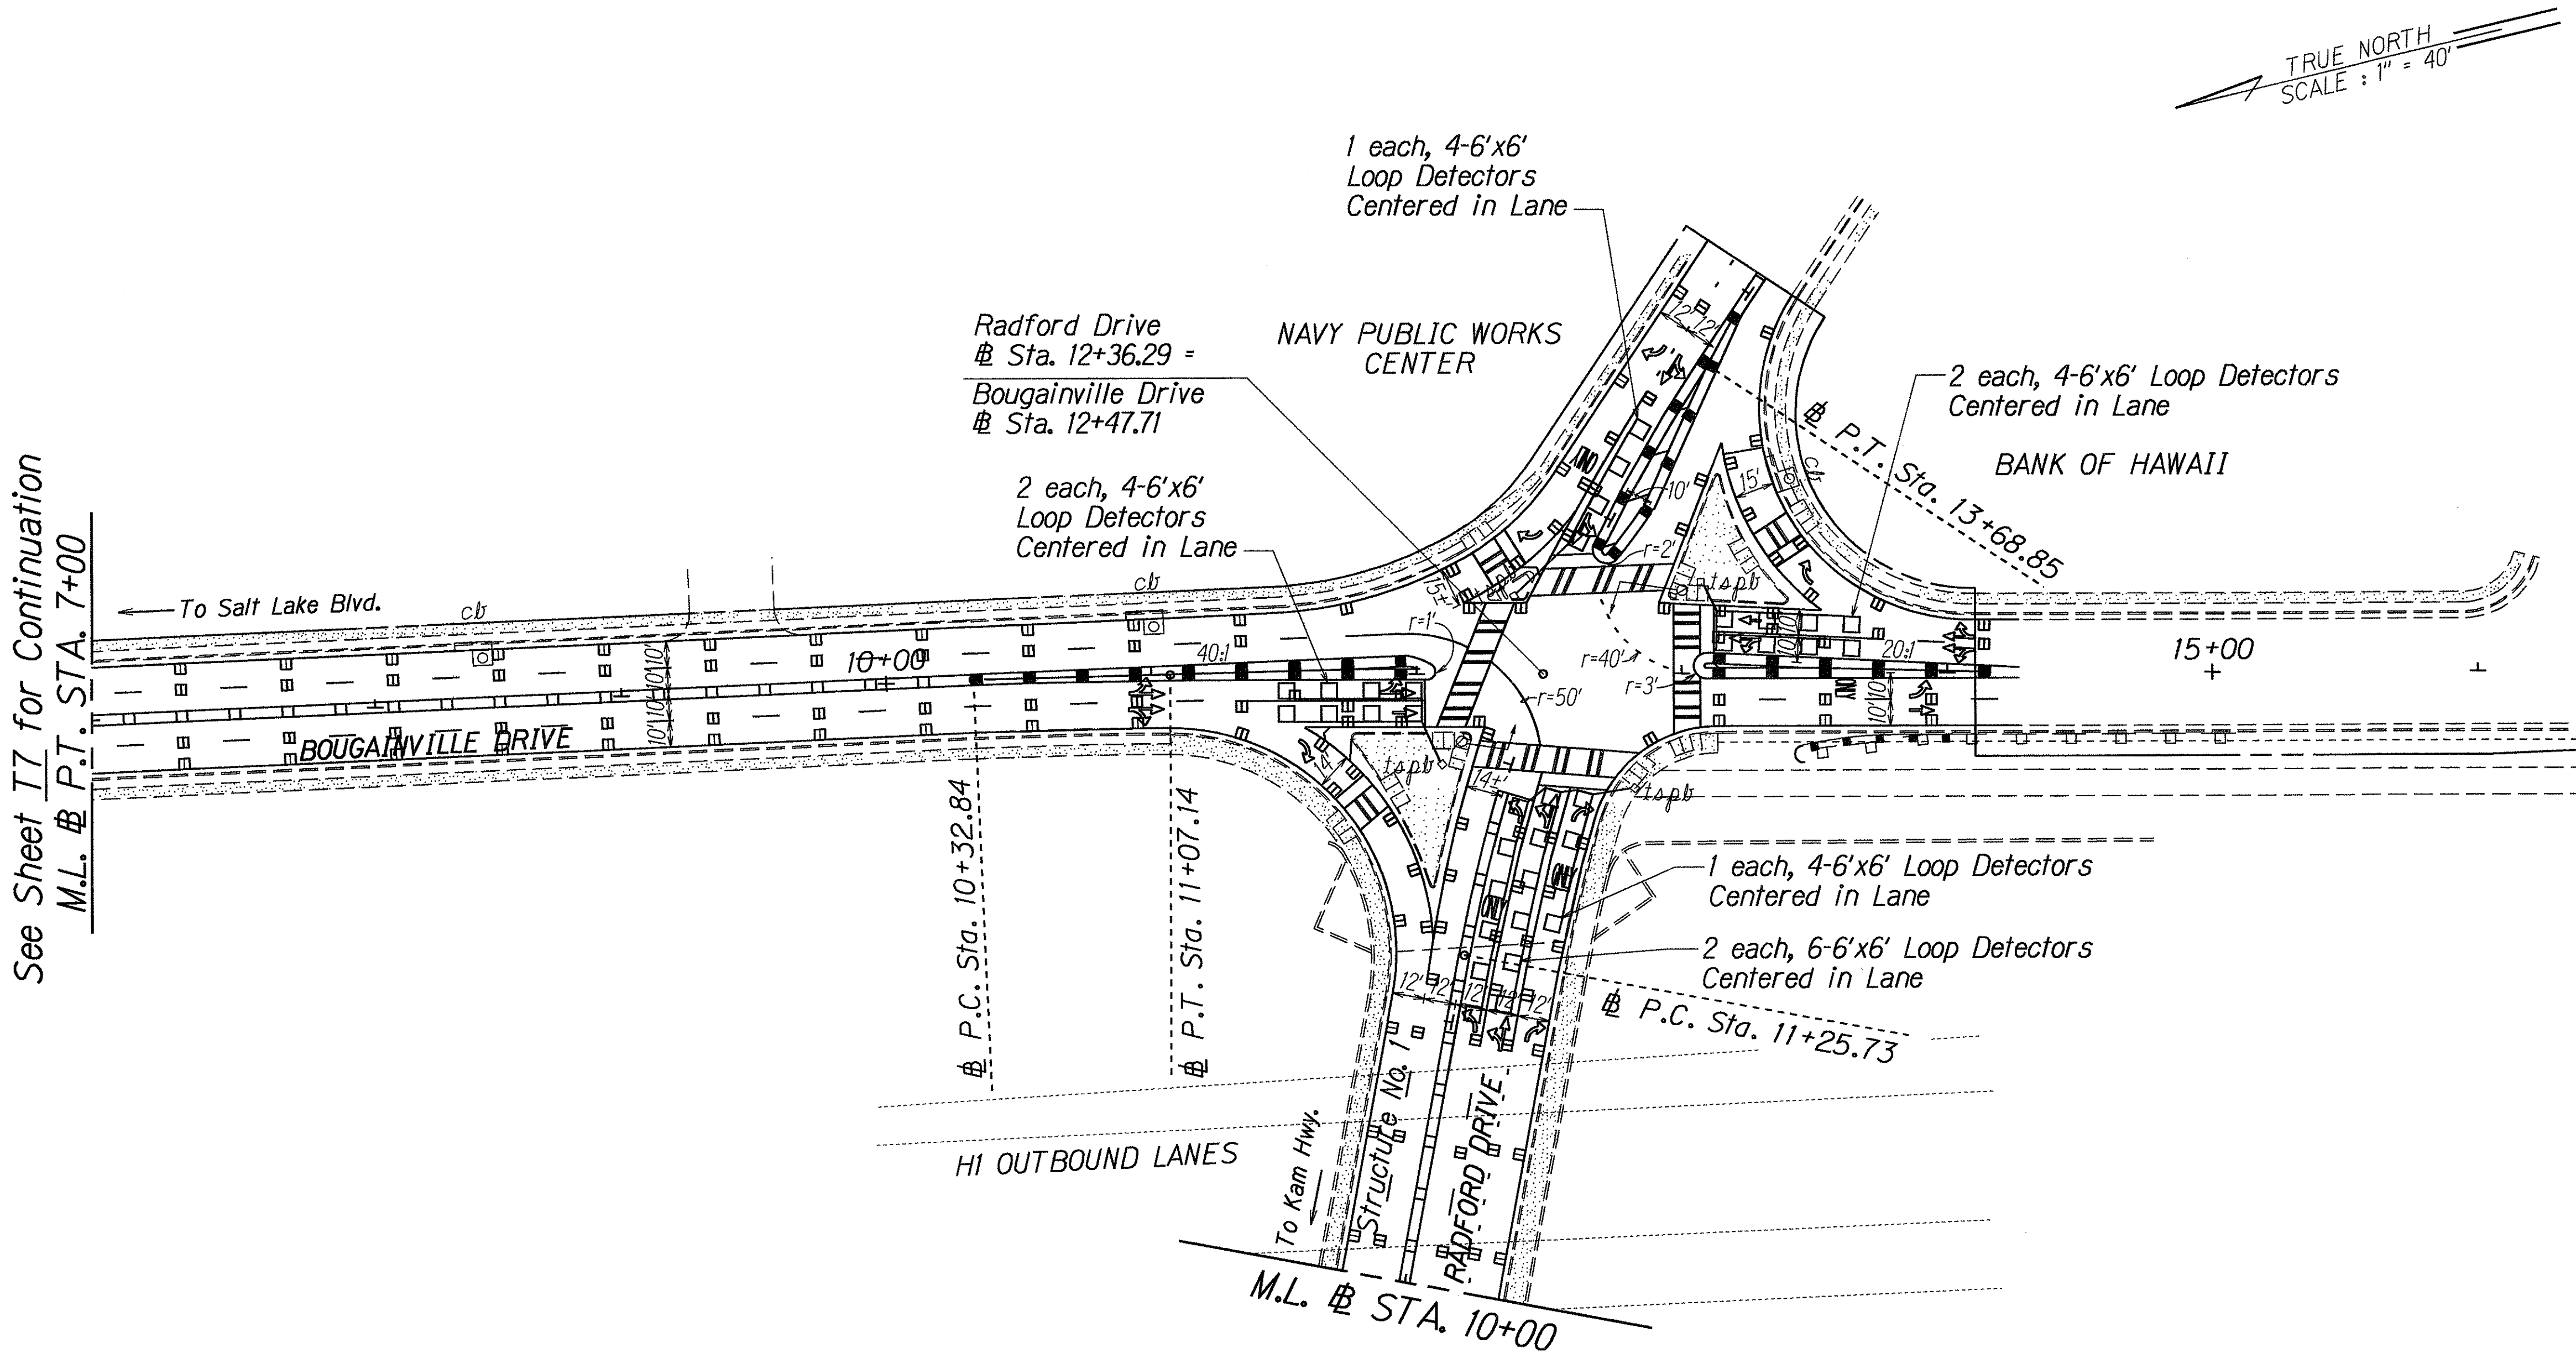


ORIGINAL PLAN	SURVEY PLOTTED BY	DATE
NOTE BOOK	DESIGNED BY	1/94
QUANTITIES BY	CHECKED BY	

STATE OF HAWAII
DEPARTMENT OF TRANSPORTATION
HIGHWAYS DIVISION

LOOP DETECTOR PLAN
RADFORD DR. & BOUGAINVILLE DR.
RESURFACING
Kamehameha Hwy. Towards Salt Lake Blvd.
FED. AID PROJ. NO. STP-0300(32)
Scale: 1" = 40' Date: Jan., 1994
SHEET No. 16 OF 11 SHEETS

FED. ROAD DIST. NO.	STATE	FED. AID PROJ. NO.	FISCAL YEAR	SHEET NO.	TOTAL SHEETS
HAWAII	HAW.	STP-0300(32)	1994	17	21

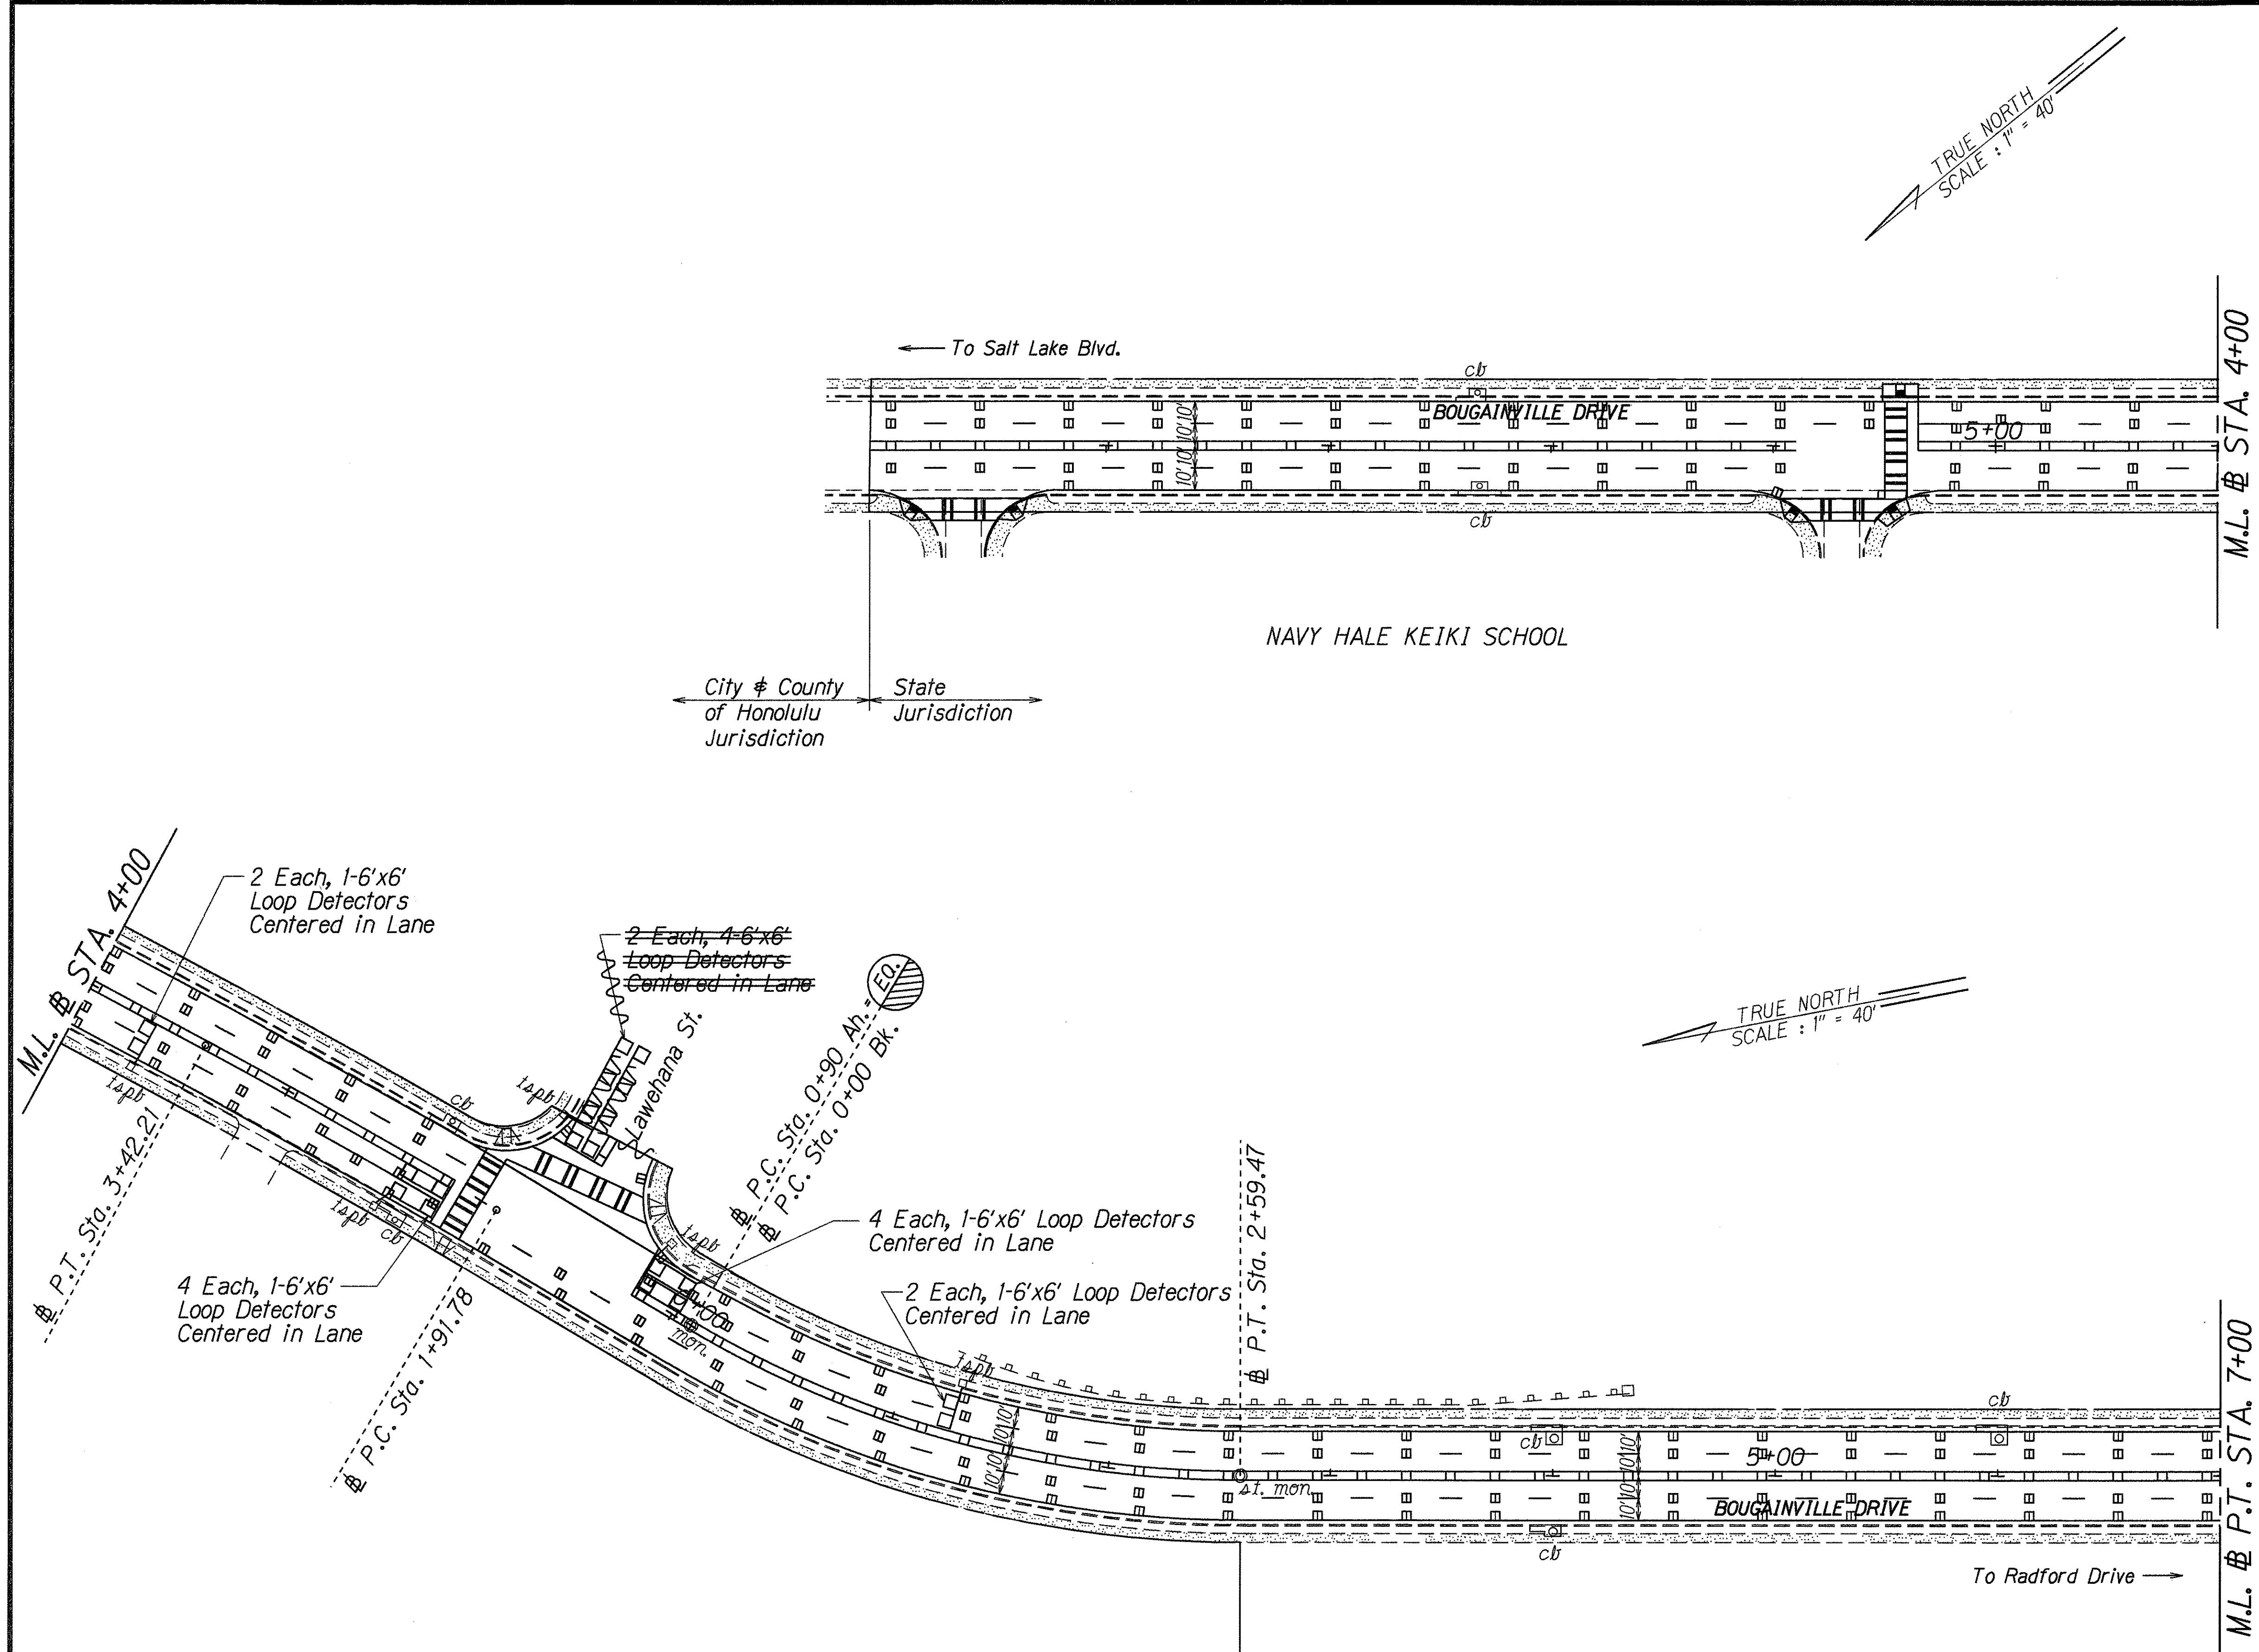

ORIGINAL PLAN	SURVEY PLOTTED BY	DATE
NOTED BOOK	DRAWN BY	1/29/94
DESIGNED BY	TRACED BY	
QUANTITIES BY	DESIGNED BY	
CHECKED BY		

LEGEND FOR AS-BUILT POSTINGS	
	Squiggly line for as-built deletion
	Double line for as-built deletion
Roadway	Text for as-built posting

STATE OF HAWAII
DEPARTMENT OF TRANSPORTATION
HIGHWAYS DIVISION

LOOP DETECTOR PLAN

RADFORD DR. & BOUGAINVILLE DR.
RESURFACING
Kamehameha Hwy. Towards Salt Lake Blvd.
FED. AID PROJ. NO. STP-0300(32)

Scale: 1" = 40' Date: Jan., 1994

SHEET No. T7 OF 11 SHEETS