
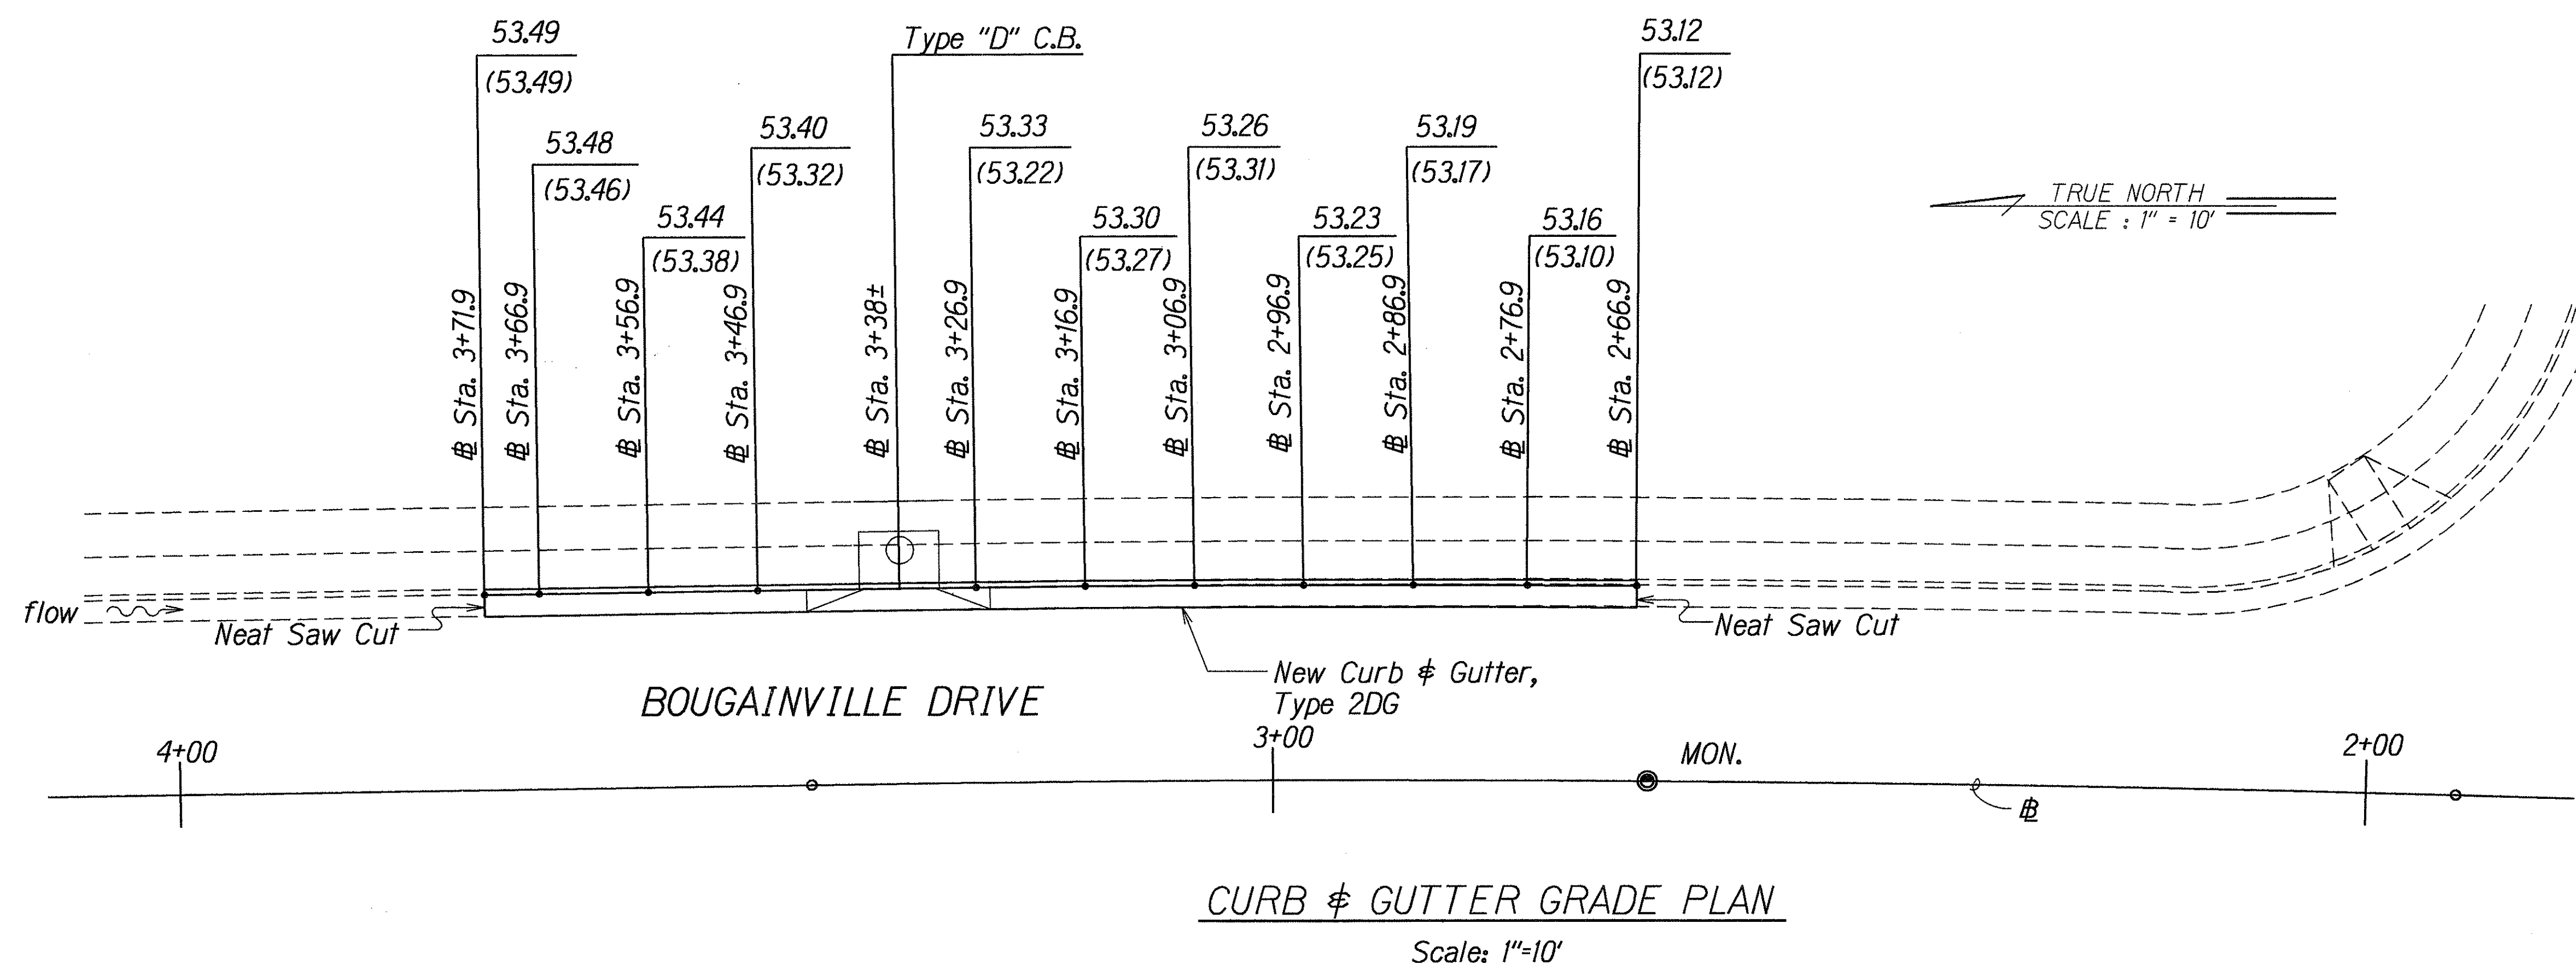


FED. ROAD DIST. NO.	STATE	FED. AID PROJ. NO.	FISCAL YEAR	SHEET NO.	TOTAL SHEETS
HAWAII	HAW.	STP-0300(32)	1994	10	21

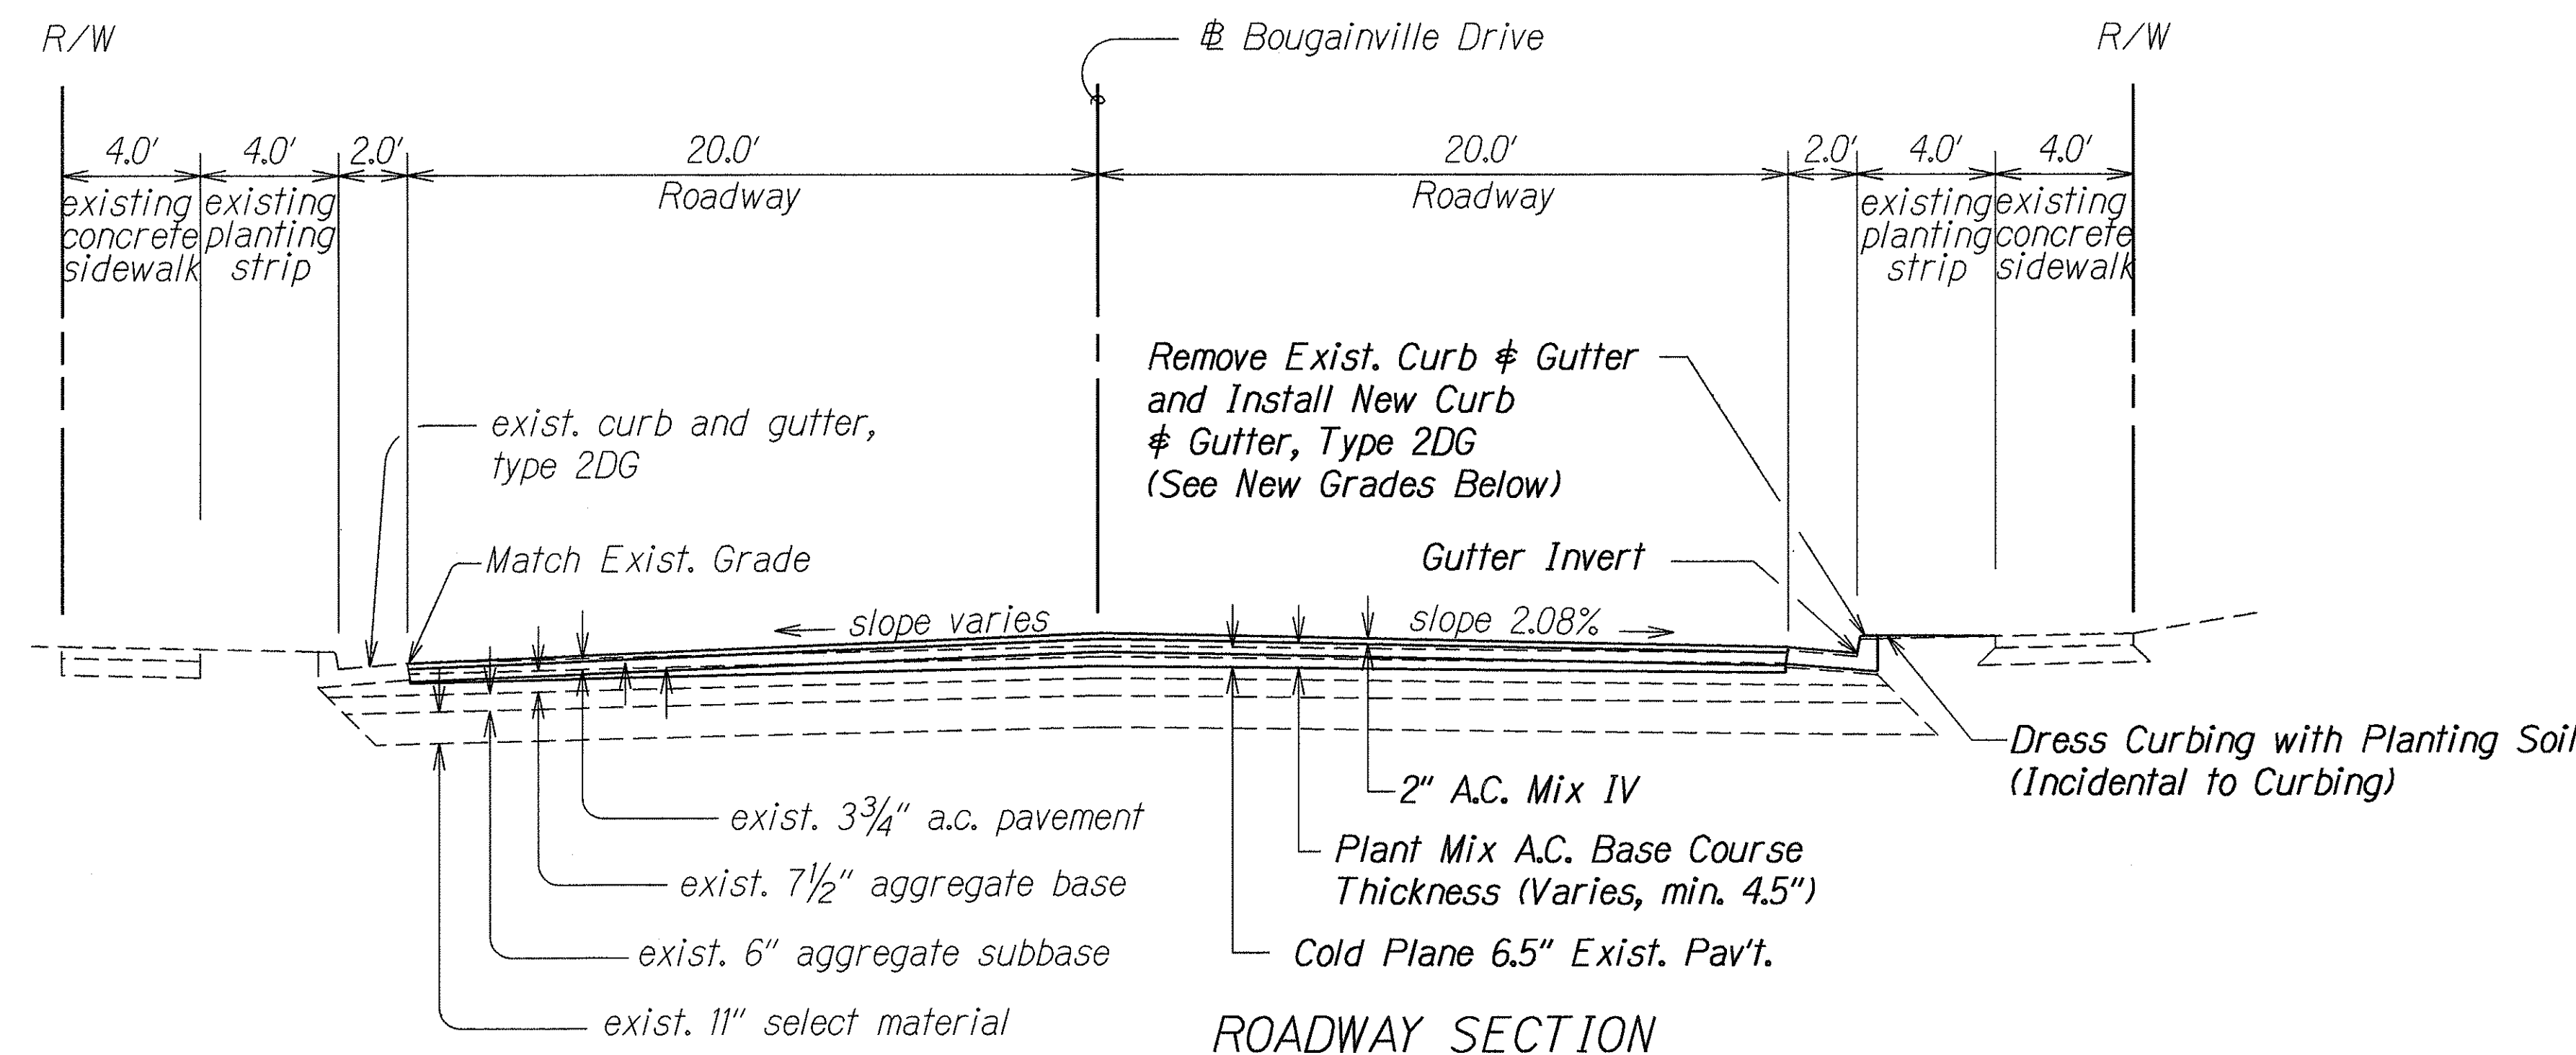

CURB & GUTTER AND PAVEMENT RECONSTRUCTION PLAN Bougainville Drive # Sta. 2+66.9 to # Sta. 3+71.9

STATE OF HAWAII DEPARTMENT OF TRANSPORTATION HIGHWAYS DIVISION	
RECONSTRUCTION GRADE PLAN	
# ROADWAY SECTION	
RADFORD DR. # BOUGAINVILLE DR. Kamehameha Hwy. towards Salt Lake Blvd.	
FED. AID PROJ. NO. STP-0300(32)	
Scale: As Shown	Date: May, 1994
SHEET No. 1 OF 1 SHEETS	