



FED. ROAD DIST. NO.	STATE	FED. AID PROJ. NO.	FISCAL YEAR	SHEET NO.	TOTAL SHEETS
HAWAII	HAW.	STP-0300(32)	1994	5	21

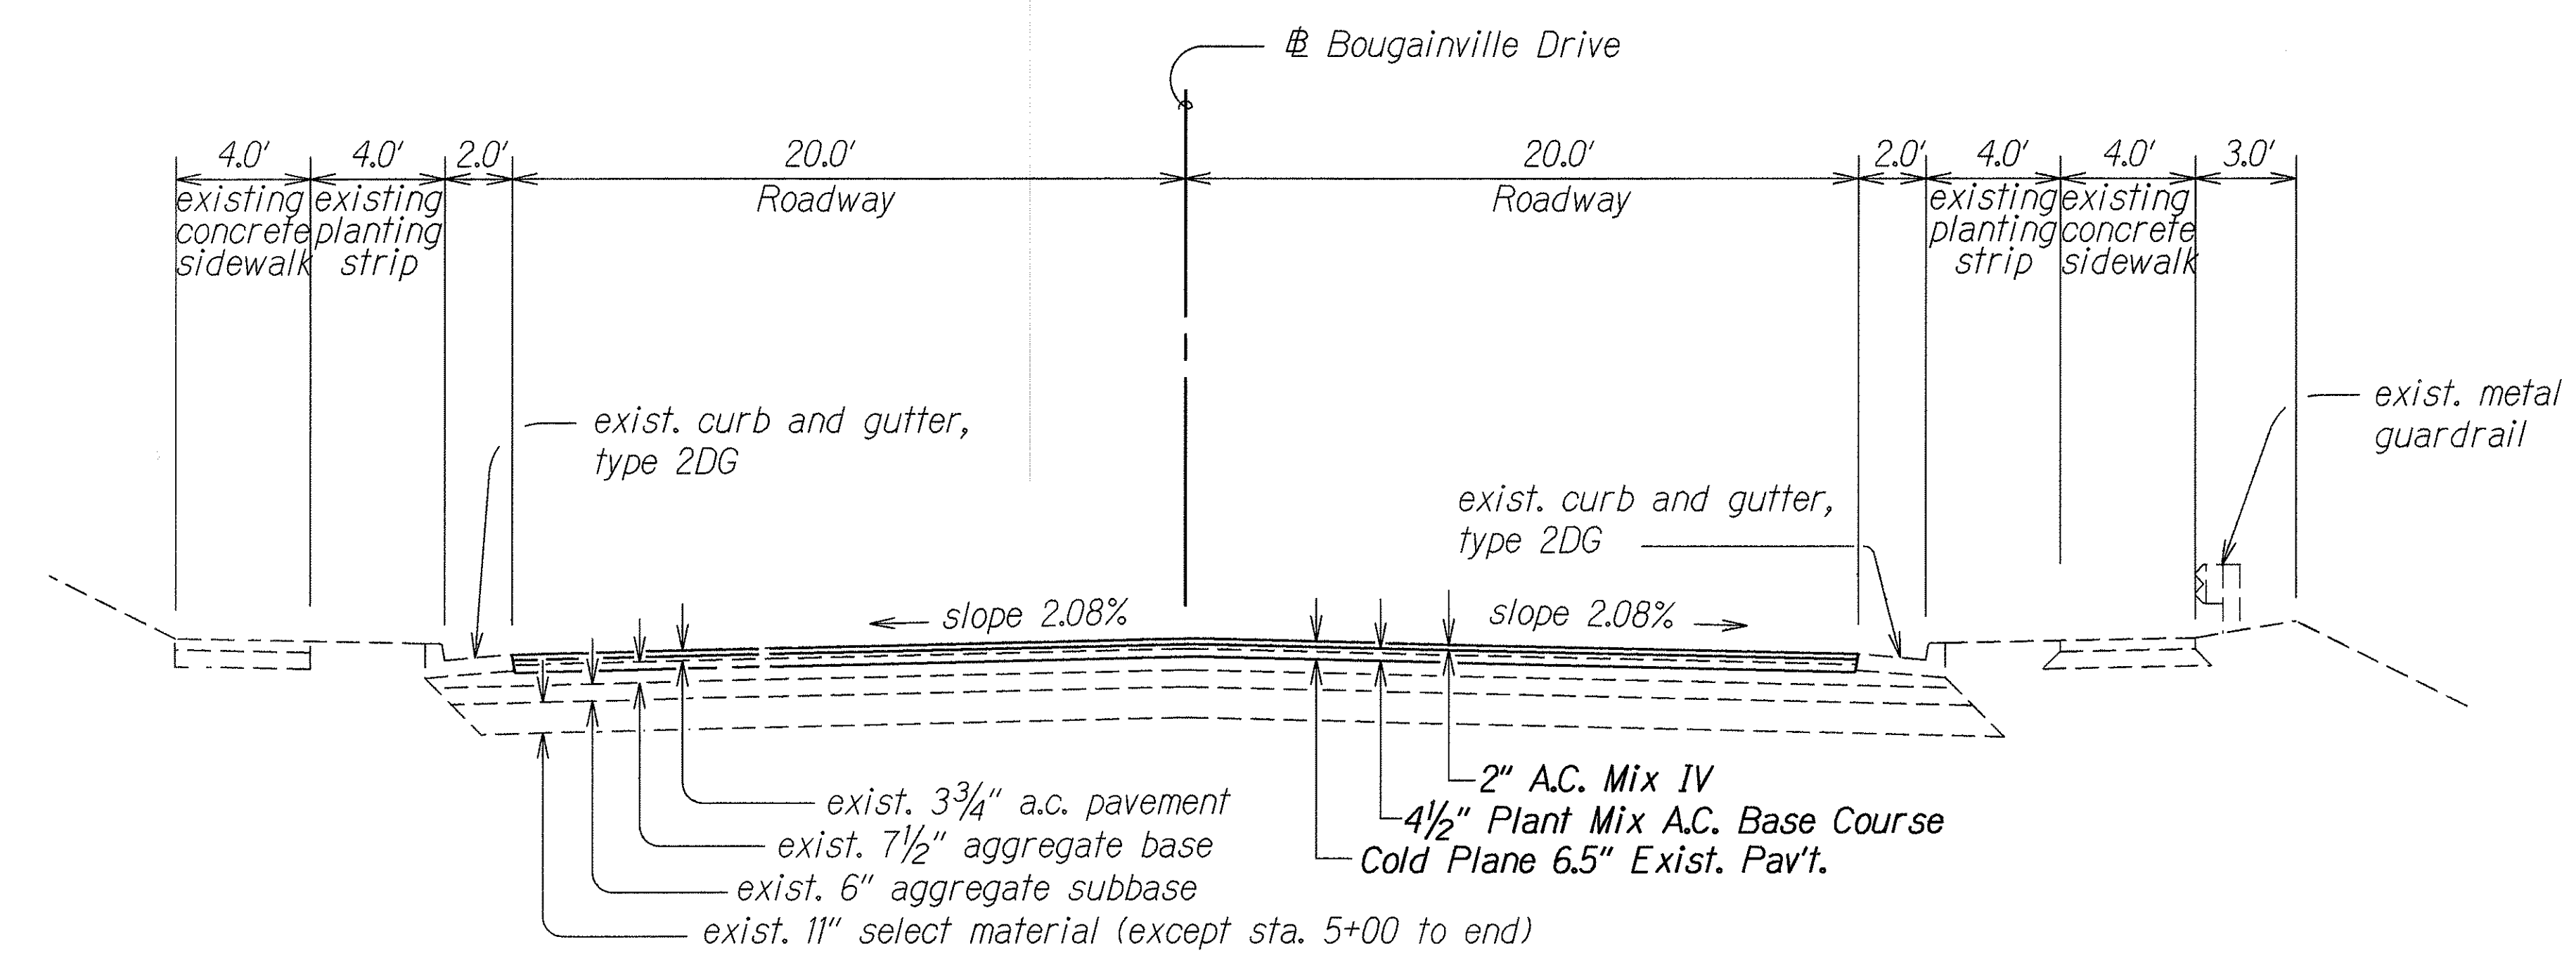

**TYPICAL SECTION
BOUGAINVILLE DRIVE**
Scale: 1/4"=1'-0"

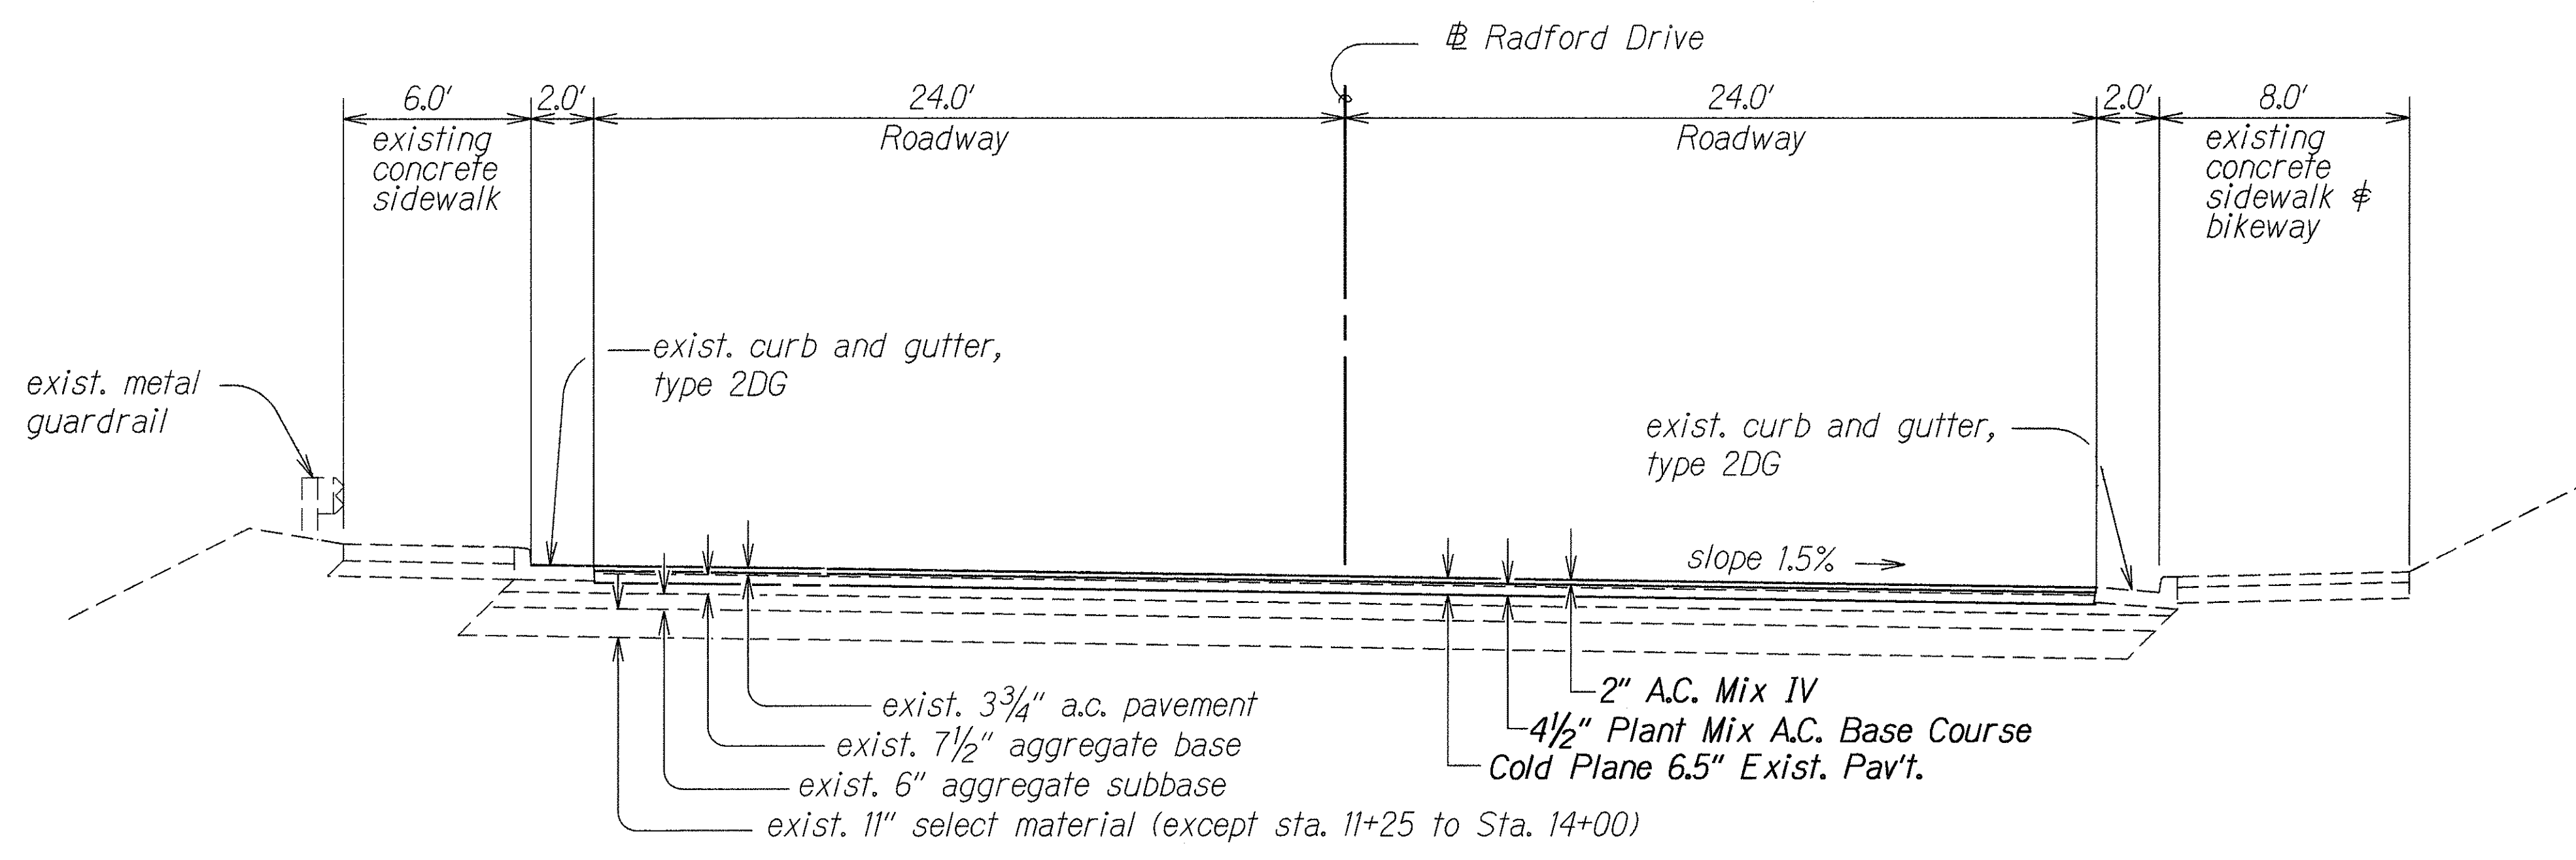

**TYPICAL SECTION
RADFORD DRIVE**
Scale: 1/4"=1'-0"

Note: Cross slope varies at superelevated sections.

ORIGINAL PLAN	DATE
SURVEY PLOTTED BY	
DESIGNED BY	
CHECKED BY	
NOTED BY	
DATE	

STATE OF HAWAII
DEPARTMENT OF TRANSPORTATION
HIGHWAYS DIVISION

TYPICAL SECTION

RADFORD DR. & BOUGAINVILLE DR.
Kamehameha Hwy. towards Salt Lake Blvd.

FED. AID PROJ. NO. STP-0300(32)

Scale: As Shown Date: May, 1994

SHEET No. 1 OF 1 SHEETS