	INDEX TO DRAWINGS
SHEET NO.	DESCRIPTION
1	TITLE SHEET
. 2	STANDARD PLANS SUMMARY
3	LEGEND AND NOTES
4	TRAFFIC SIGNAL PLAN
5	STREET SIGN DETAIL
6	LOOP DETECTOR DETAILS
	11 1 1 1 1 1 1 1 1 1 1 1 1 1 1 1 1 1 1

STATE OF HAWAII


DEPARTMENT OF TRANSPORTATION
HIGHWAYS DIVISION
HONOLULU, HAWAII


"AS-BUILT"

PLANS FOR

BOUGAINVILLE DRIVE, TRAFFIC SIGNALS
AT LAWEHANA STREET
PROJECT NO. HWY-0-01-91

DISTRICT OF EWA ISLAND OF OAHU

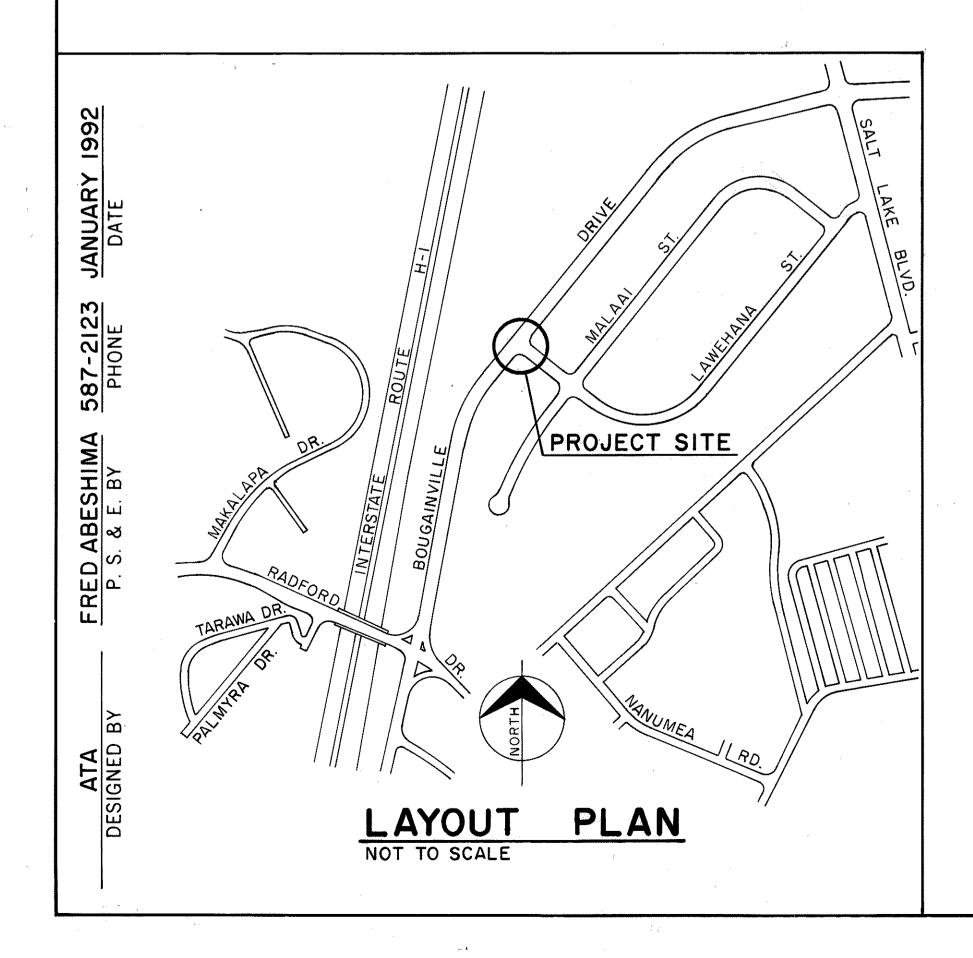

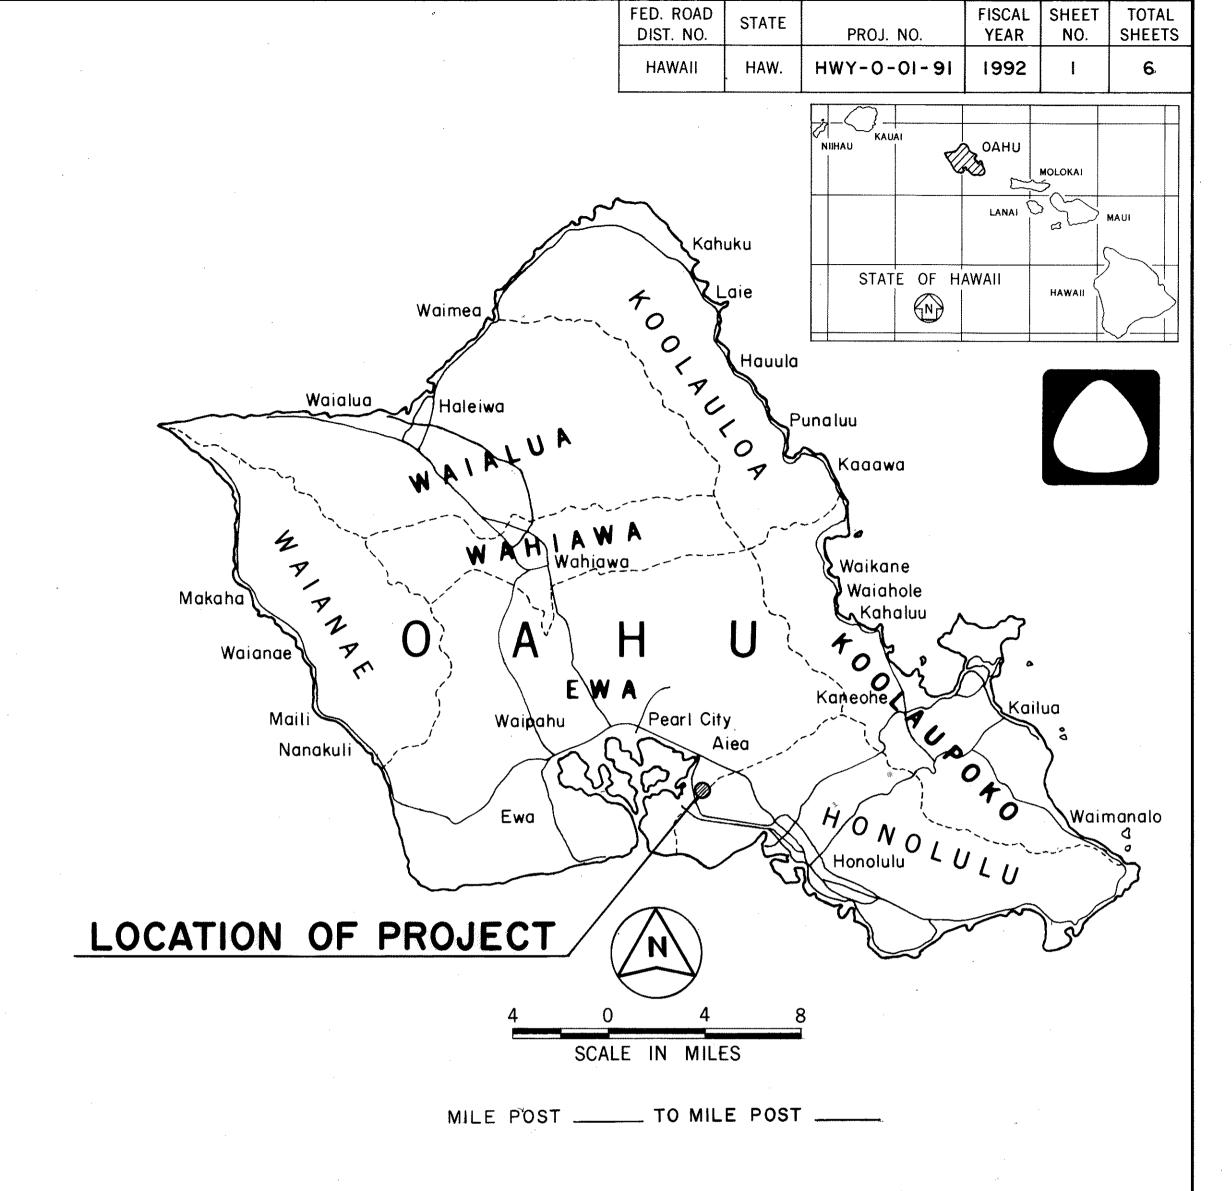

CHANGES MADE DURING CONSTRUCTION HAVE BEEN INCORPORATED ON THESE PLANS EXCEPT CHANGES IN THE ORIGINAL THEORETICAL QUANTITIES.

RESIDENT ENGINEER DATE

DEPARTMENT OF TRANSPORTATION
STATE OF HAWAII

APPROVED:

JUNE 2/12/12

FURDIR. OF TRANSPORTATION

DATE