


F 0 9 0 1 0 2 0 0 . S 1

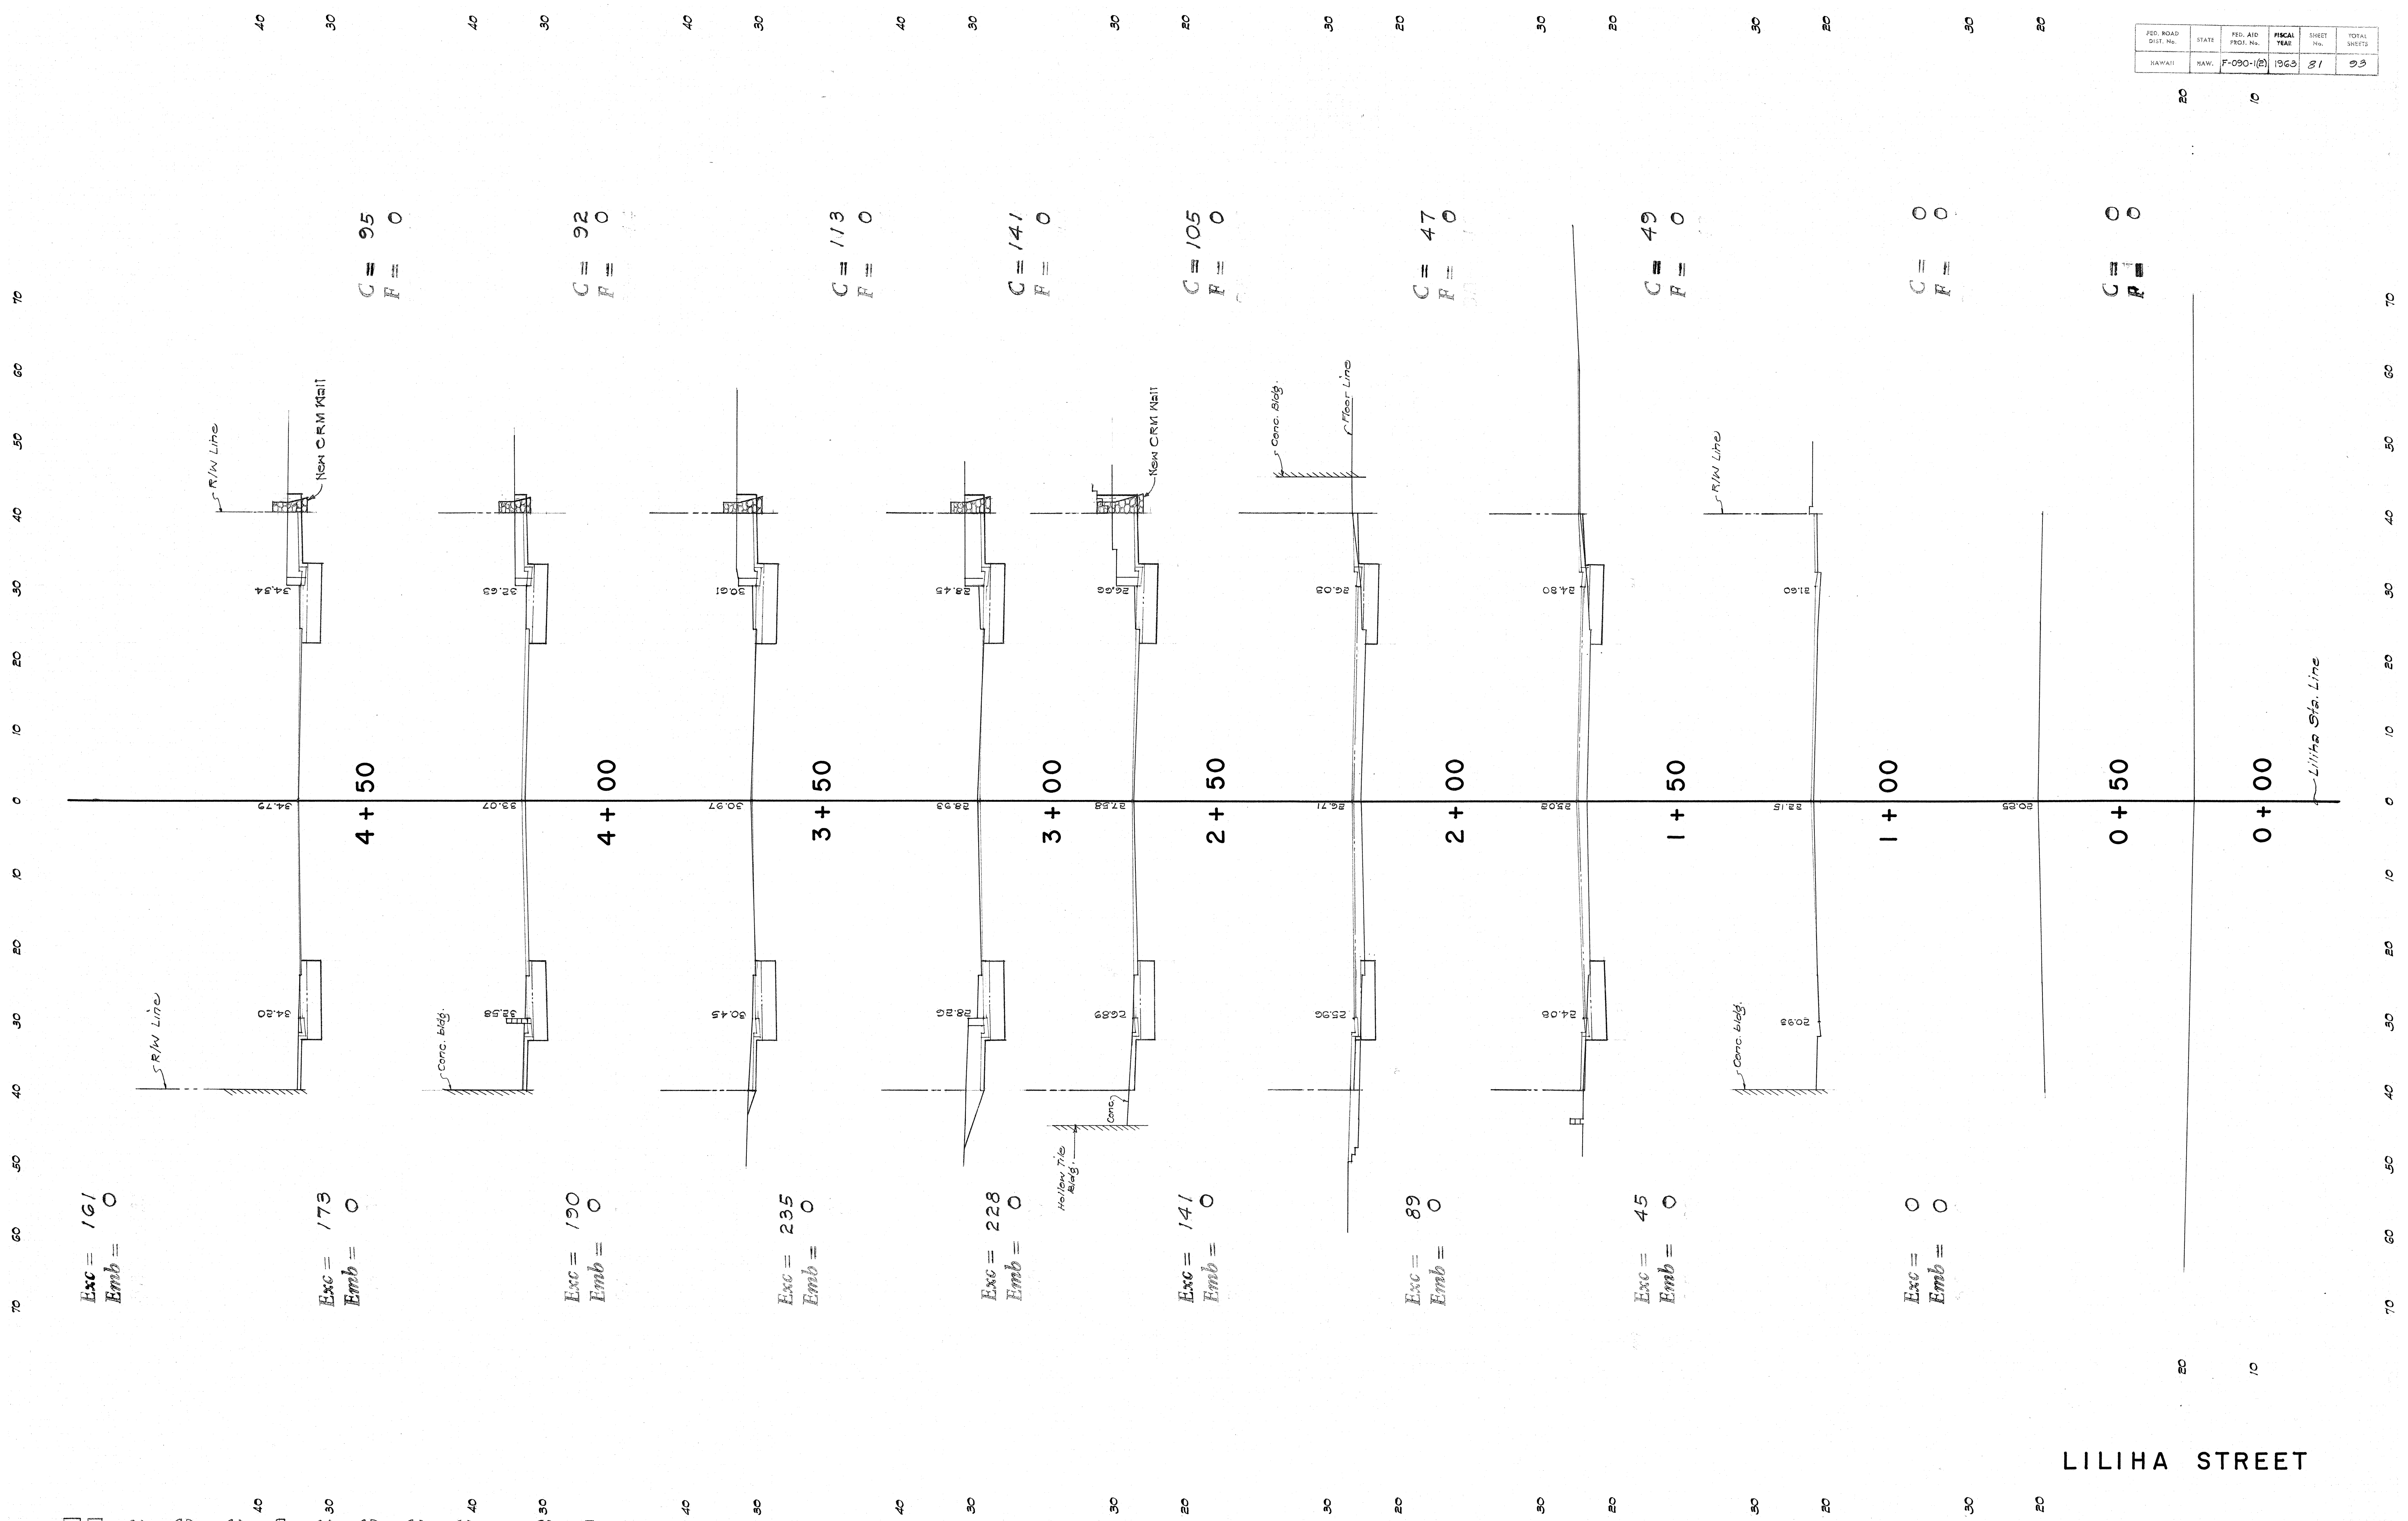

LILIHA STREET

FED. ROAD DIST. No.	STATE	FED. AID PROJ. No.	FISCAL YEAR	SHEET No.	TOTAL SHEETS
HAWAII	HAW.	F-090-1(2)	1963	81	93


F 0 9 0 1 0 2 0 0 . S 2

Exc = 0
Emb = 0

9 + 33 C = 0
F = 0

9 + 03.83 C = 0
F = 0

(END LILIHA SEPARATION)

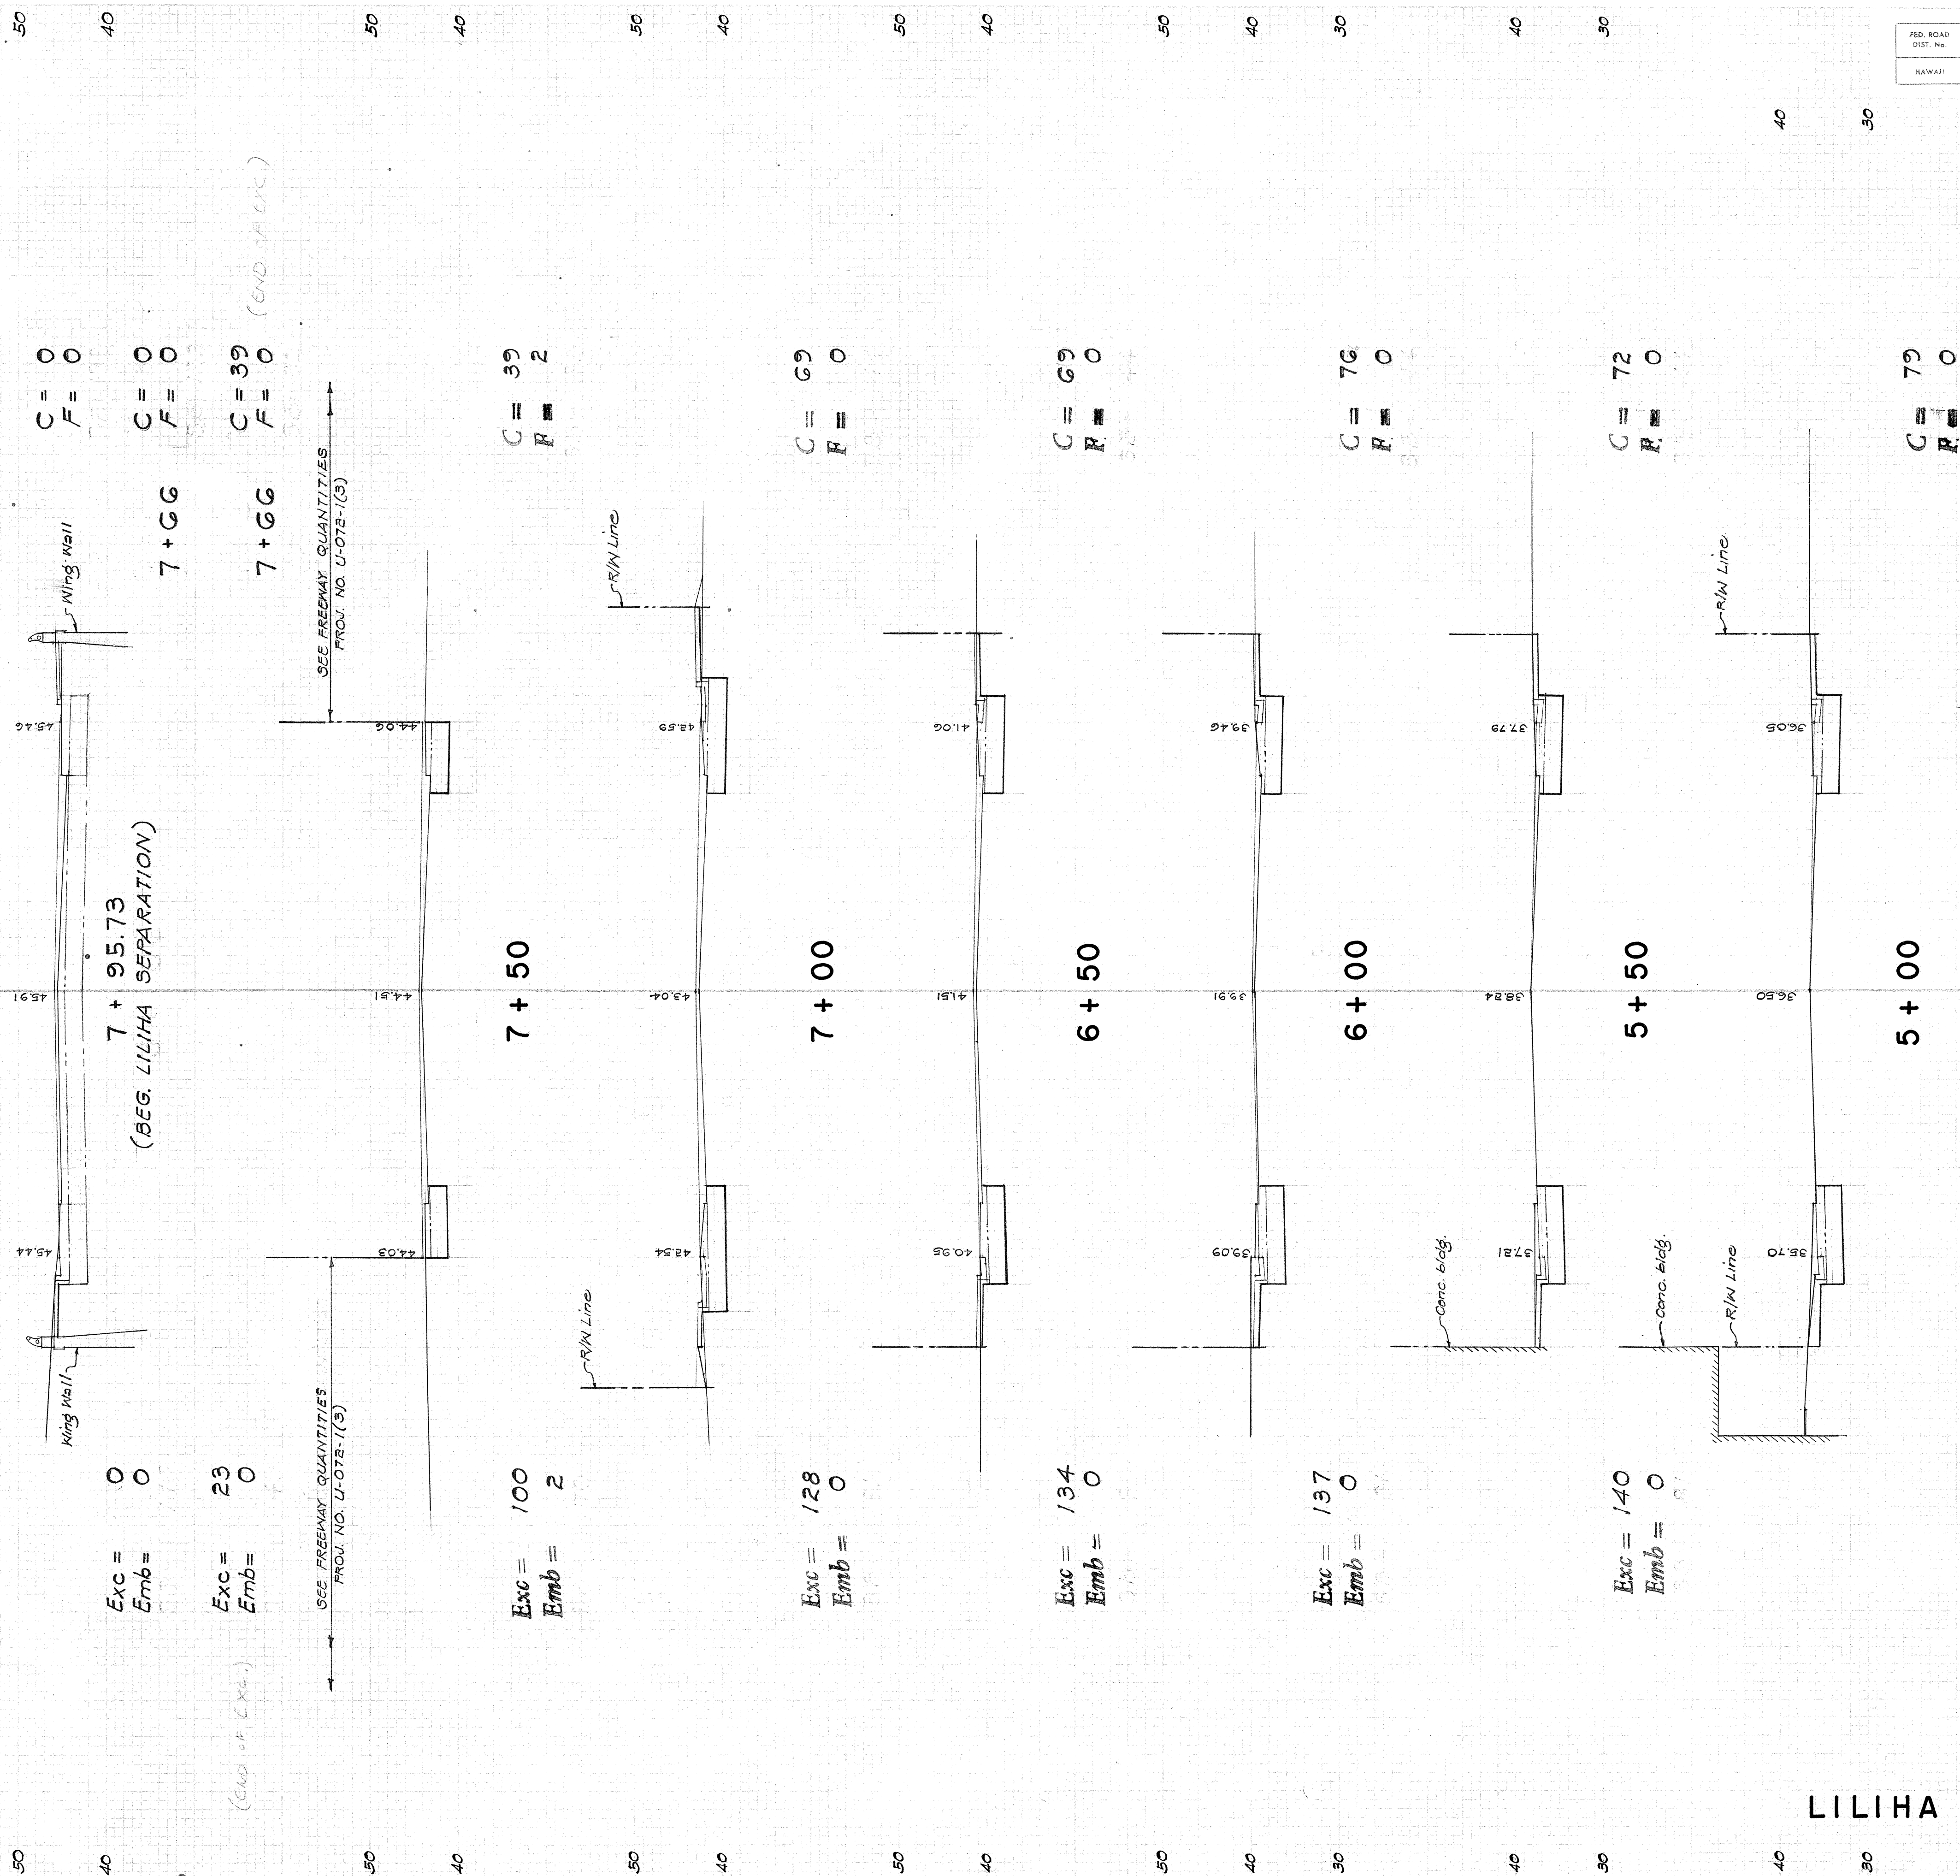

LILIHA STREET

FED. ROAD DIST. No.	STATE	FED. AID PROJ. No.	FISCAL YEAR	SHEET No.	TOTAL SHEETS
HAWAII	HAW.	F-090-1(2)	1963	82	93