



FED. ROAD DIST. No.	STATE	FED. AID PROJ. No.	FISCAL YEAR	SHEET No.	TOTAL SHEETS
HAWAII	HAW.	U-0724(3)	1963	13	246
		F-0001(8)	1963	3	93

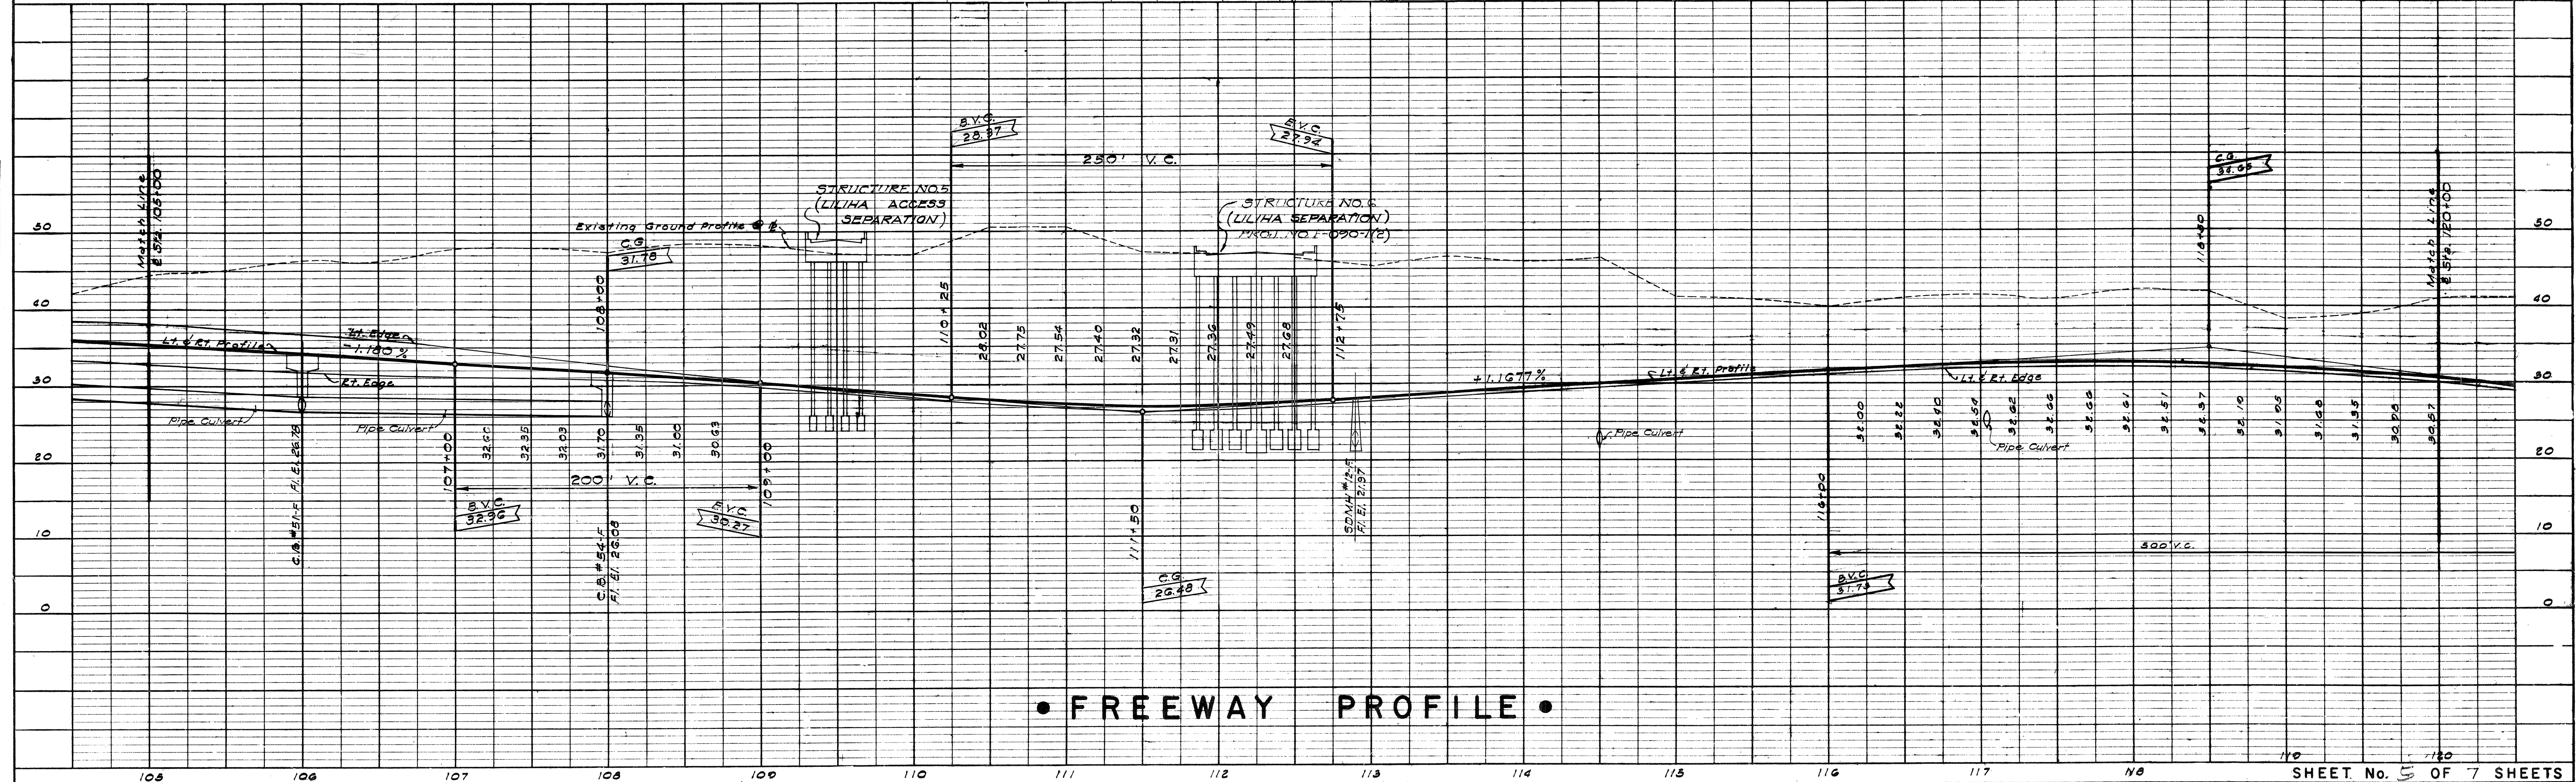

• FREEWAY PROFILE •

NOTE:
B.M. Elev. 52.68 "t" Cut on top
of F.H. #417
See Sht. No. 114 for approx.
location.

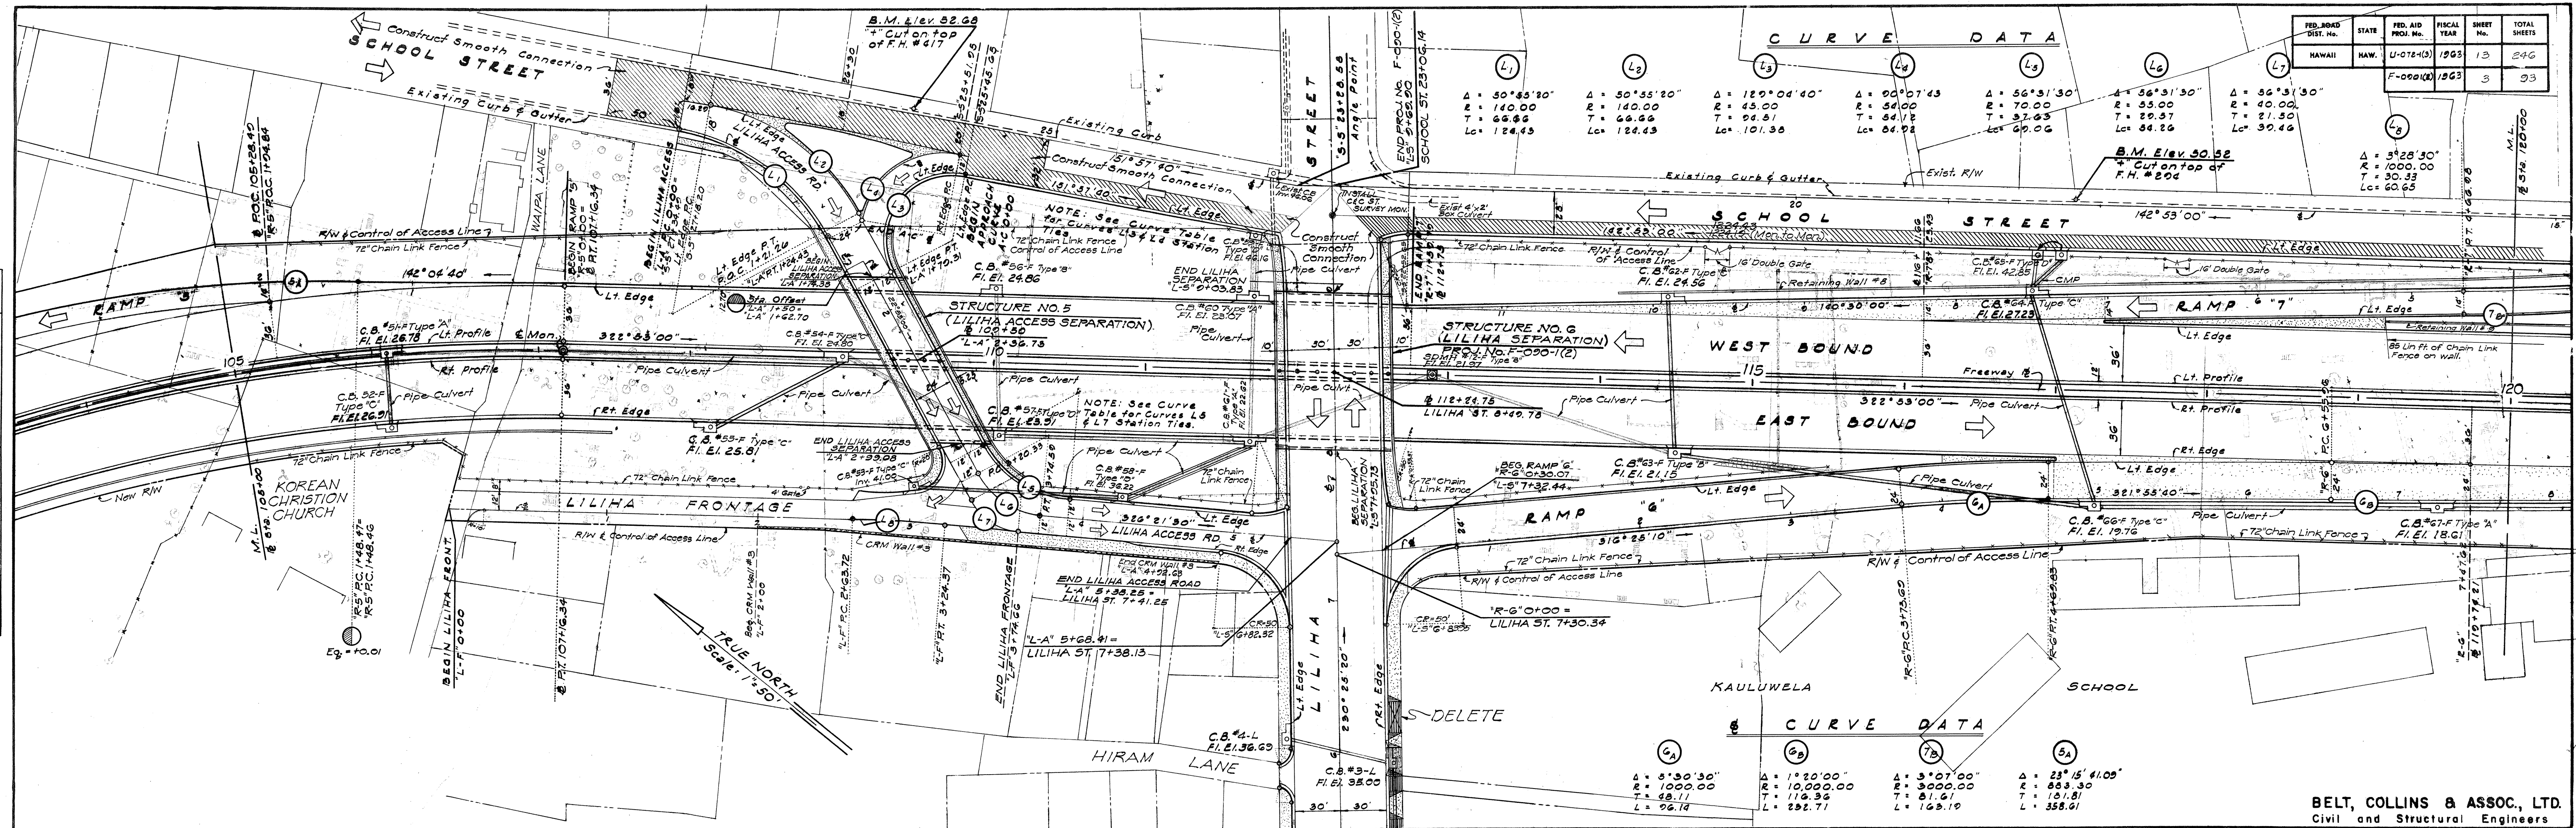