

INDEX TO DRAWINGS		COMPOSITE SHEET NO.
SHEET NO.	DESCRIPTION	
1	TITLE SHEET	3
2	TYPICAL SECTIONS	4
3, 4	PLAN AND PROFILE	15, 17
5 - 7	DETAIL PLAN OF ROADWAY	30, 34, 35
8	CONSTRUCTION PHASES	36
9 - 11	MISC. ROADWAY DETAILS	46 - 48
12 - 19	STANDARD DETAILS - HIGHWAY	52 - 59
20, 21	BORING LOG	69, 71
22, 23	DRAINAGE SYSTEM	84, 88
24 - 34	RELOC. & REHAB. OF BLDGS. & IMPROVEMENTS	98 - 108
35 - 40	UTILITIES - WATER	114, 116 - 120
41 - 45	UTILITIES - SEWER	124, 126 - 129
46 - 60	UTILITIES - ELECTRIC AND TELEPHONE	132, 133, 137, 138, 140 - 142, 145 - 149, 151 - 153
61, 62	UTILITIES - GAS	156, 157
63 - 66	HIGHWAY LIGHTING SYSTEM	161 - 164
67	TRAFFIC SIGNAL SYSTEM	168
68	TRAFFIC SIGNS	173
69 - 80	STANDARD DETAILS - TRAFFIC SIGNS	184 - 195
81, 82	CROSS SECTIONS	235, 236
83 - 87	STRUCTURE NO. 6	267 - 271
88 - 93	STANDARD DETAILS - BRIDGE	278 - 283

STATE OF HAWAII
DEPARTMENT OF TRANSPORTATION
HIGHWAYS DIVISION

"AS BUILT" PLANS OF

LILIHA STREET


VINEYARD BOULEVARD TO SCHOOL STREET

FEDERAL AID PROJECT NO. F-090-1(2)


DISTRICT OF HONOLULU
ISLAND OF OAHU

SCALES	
PLAN	1" = 50'-0"
PROFILE	HOR. 1" = 50'-0"
	VER. 1" = 10'-0"
CROSS SECTION	HOR. 1" = 10'-0"
	VER. 1" = 10'-0"

NOTE:
ALL CHANGES MADE DURING CONSTRUCTION
HAVE BEEN NOTED IN RED ON THESE
TRACINGS AND CHECKED BY:
Ronald T. ...
PROJECT ENGINEER
DATE *4/18/63*

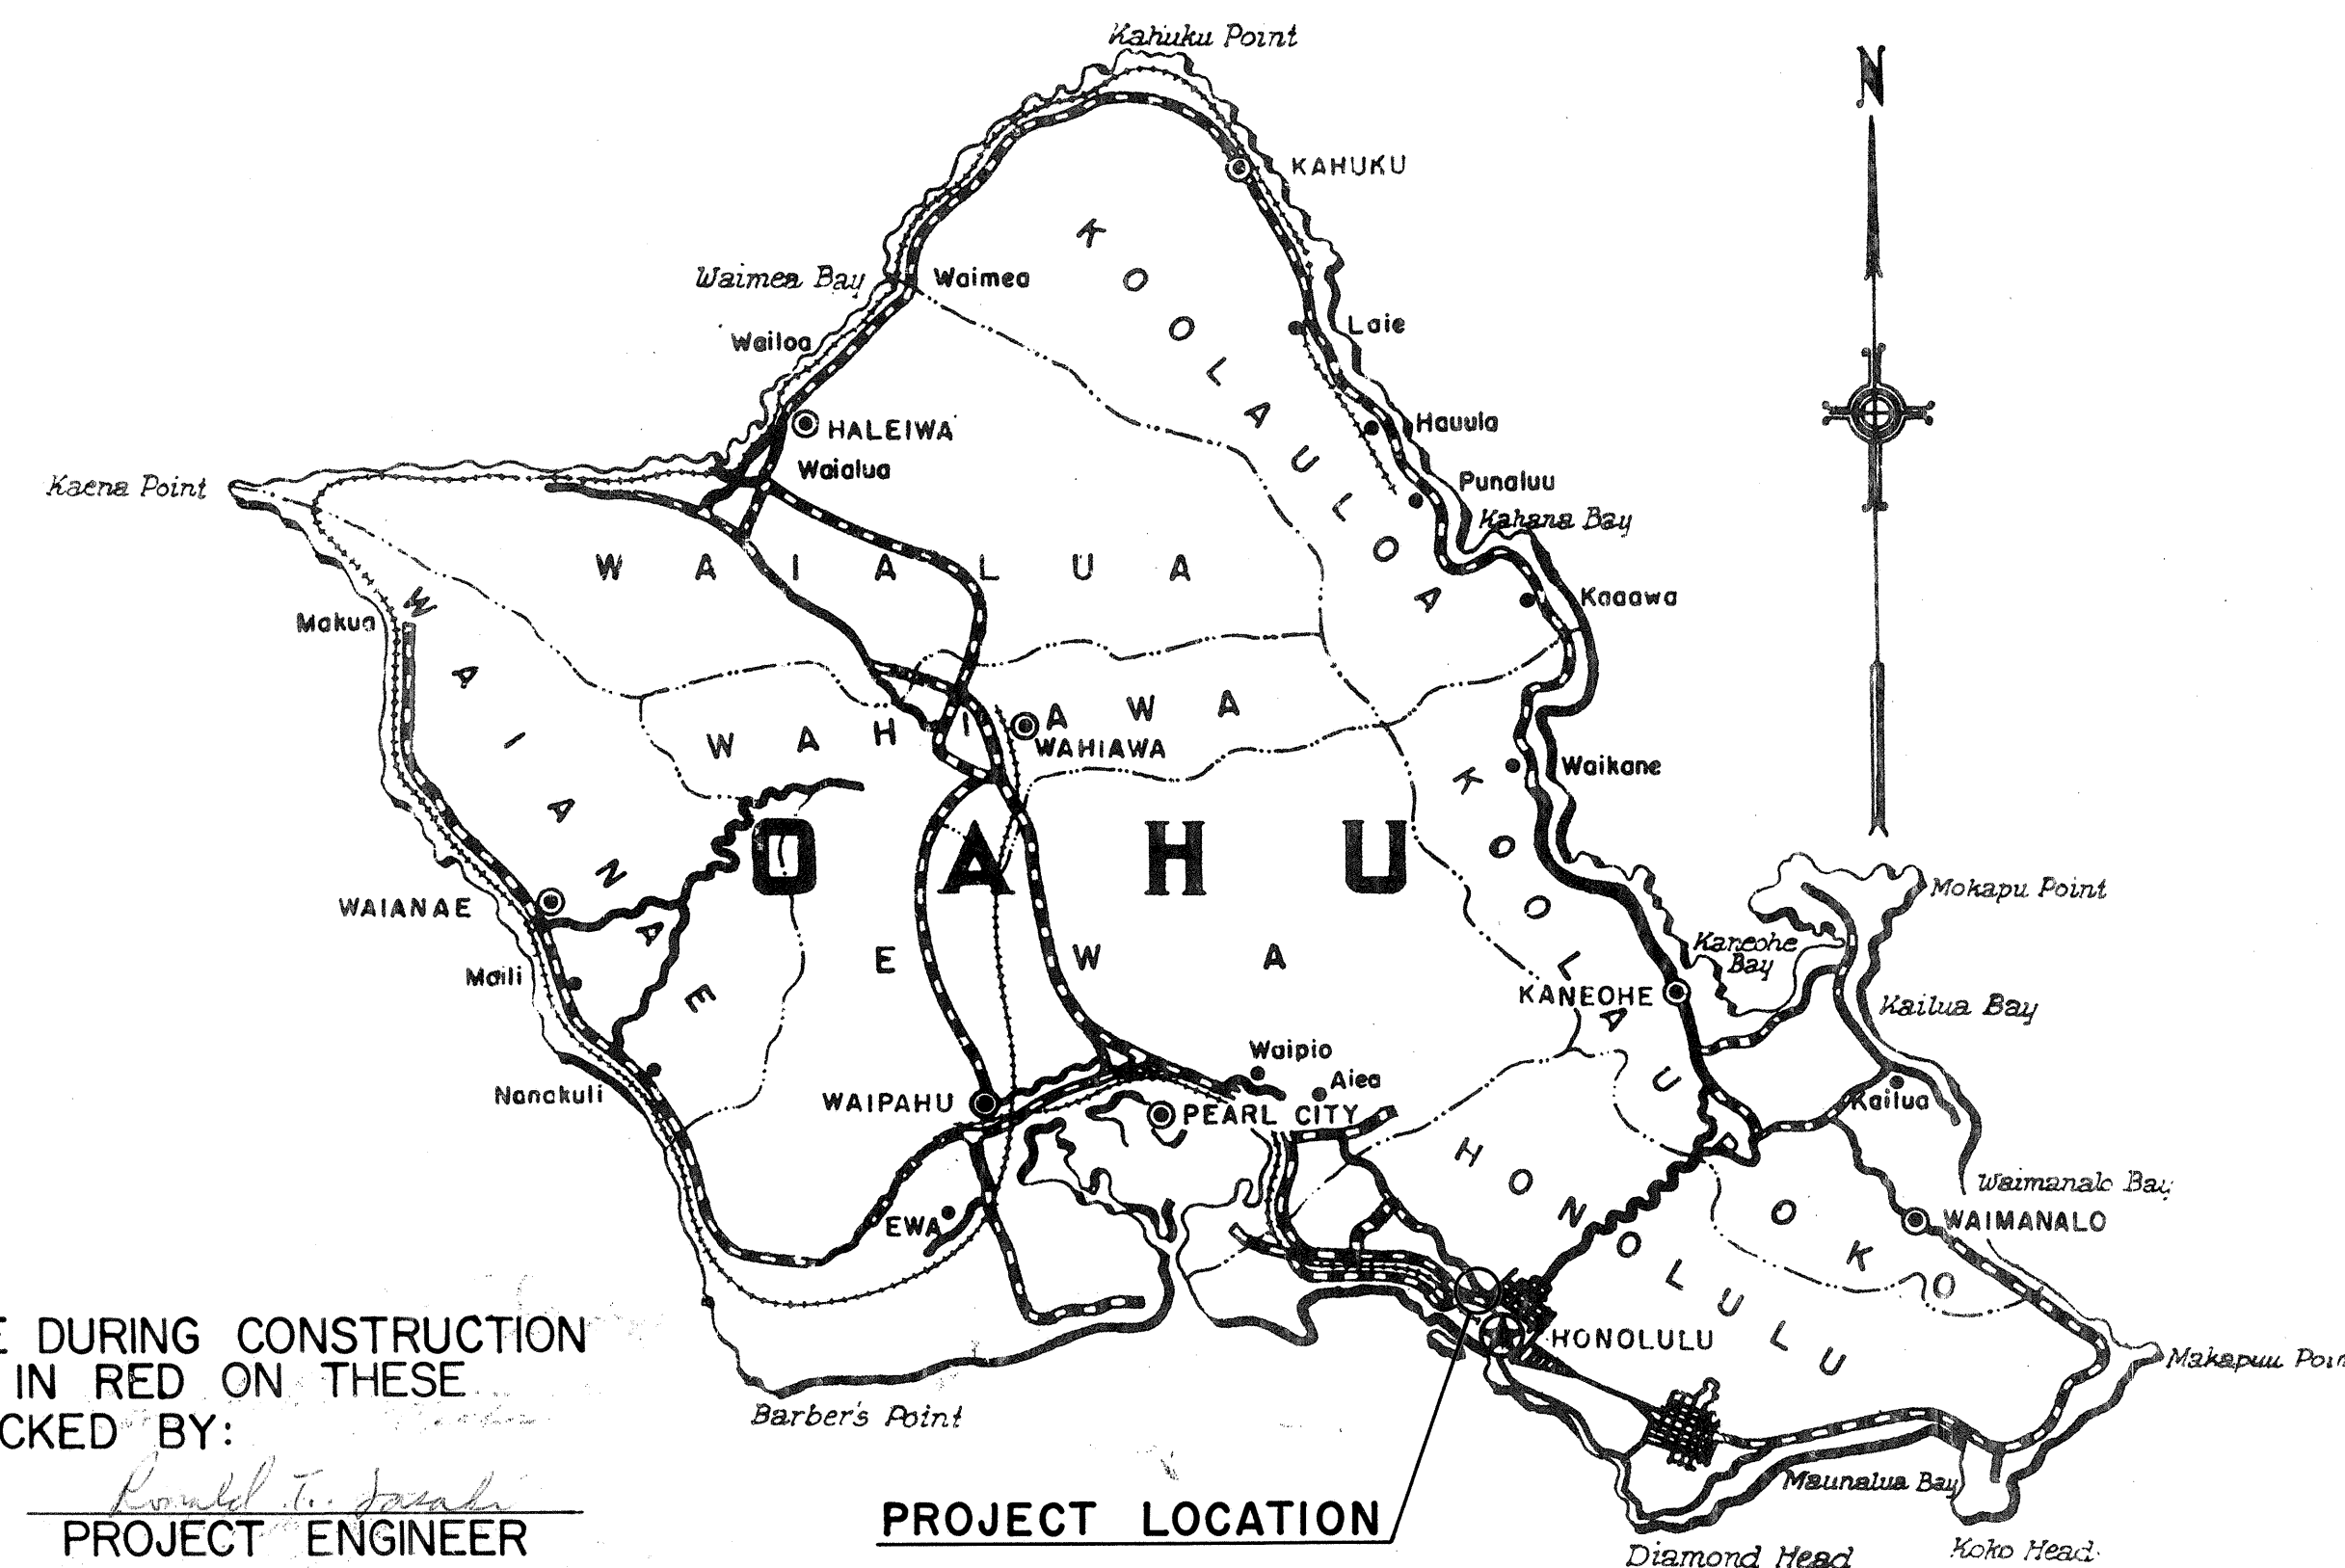

Federal Aid Projects Previously Constructed Or Under Construction

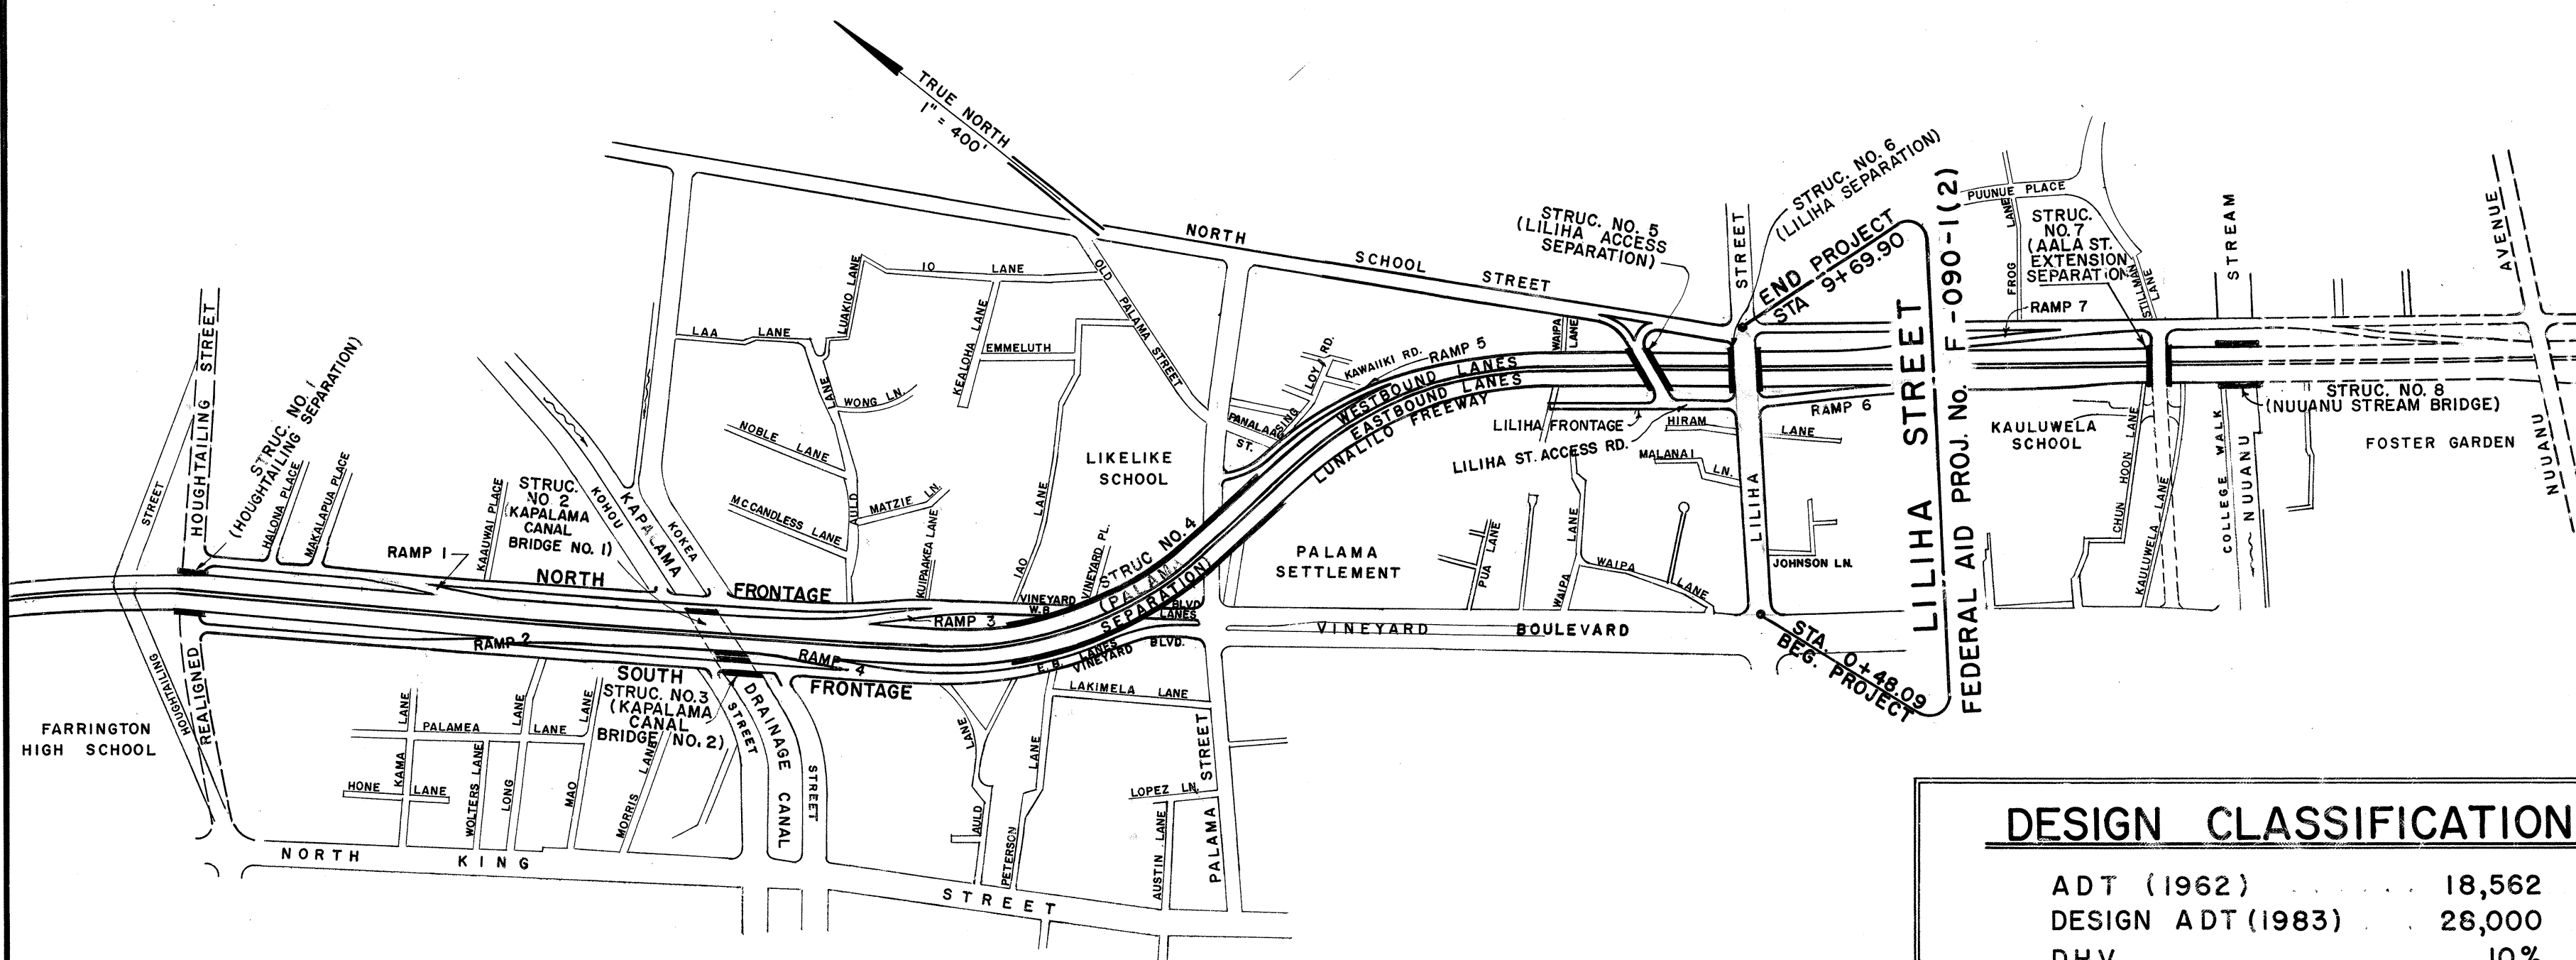

LAYOUT PLAN

DESIGN CLASSIFICATION

ADT (1962)	18,562
DESIGN ADT (1983)	28,000
DHV	10%
D	70/30
T	2%

GROSS LENGTH OF PROJECT	0.1746 MILE
BRIDGES OVER 20'-0" LENGTH	0.0205 MILE
NET LENGTH OF ROADWAY	0.1541 MILE

BELT, COLLINS & ASSOCIATES, LTD.

Civil and Structural Engineers

• ASSOCIATES •

MOFFATT, NICHOL & TAYLOR - Structural Engineers
WALTER P. THOMPSON - Surveyor
PAUL R. WEISSICH - Landscape Architect
WYNN NAKAMURA - Electrical Engineer

APPROVED: *Ronald T. ...* DATE *4/18/63*
DIRECTOR OF TRANSPORTATION

DEPARTMENT OF COMMERCE
BUREAU OF PUBLIC ROADS
APPROVED: _____
DIVISION ENGINEER DATE