




FED. ROAD DIST. NO.	STATE	PROJ. NO.	FISCAL YEAR	SHEET NO.	TOTAL SHEETS
HAWAII	HAW.	9700B-01-83M	1983	3	24

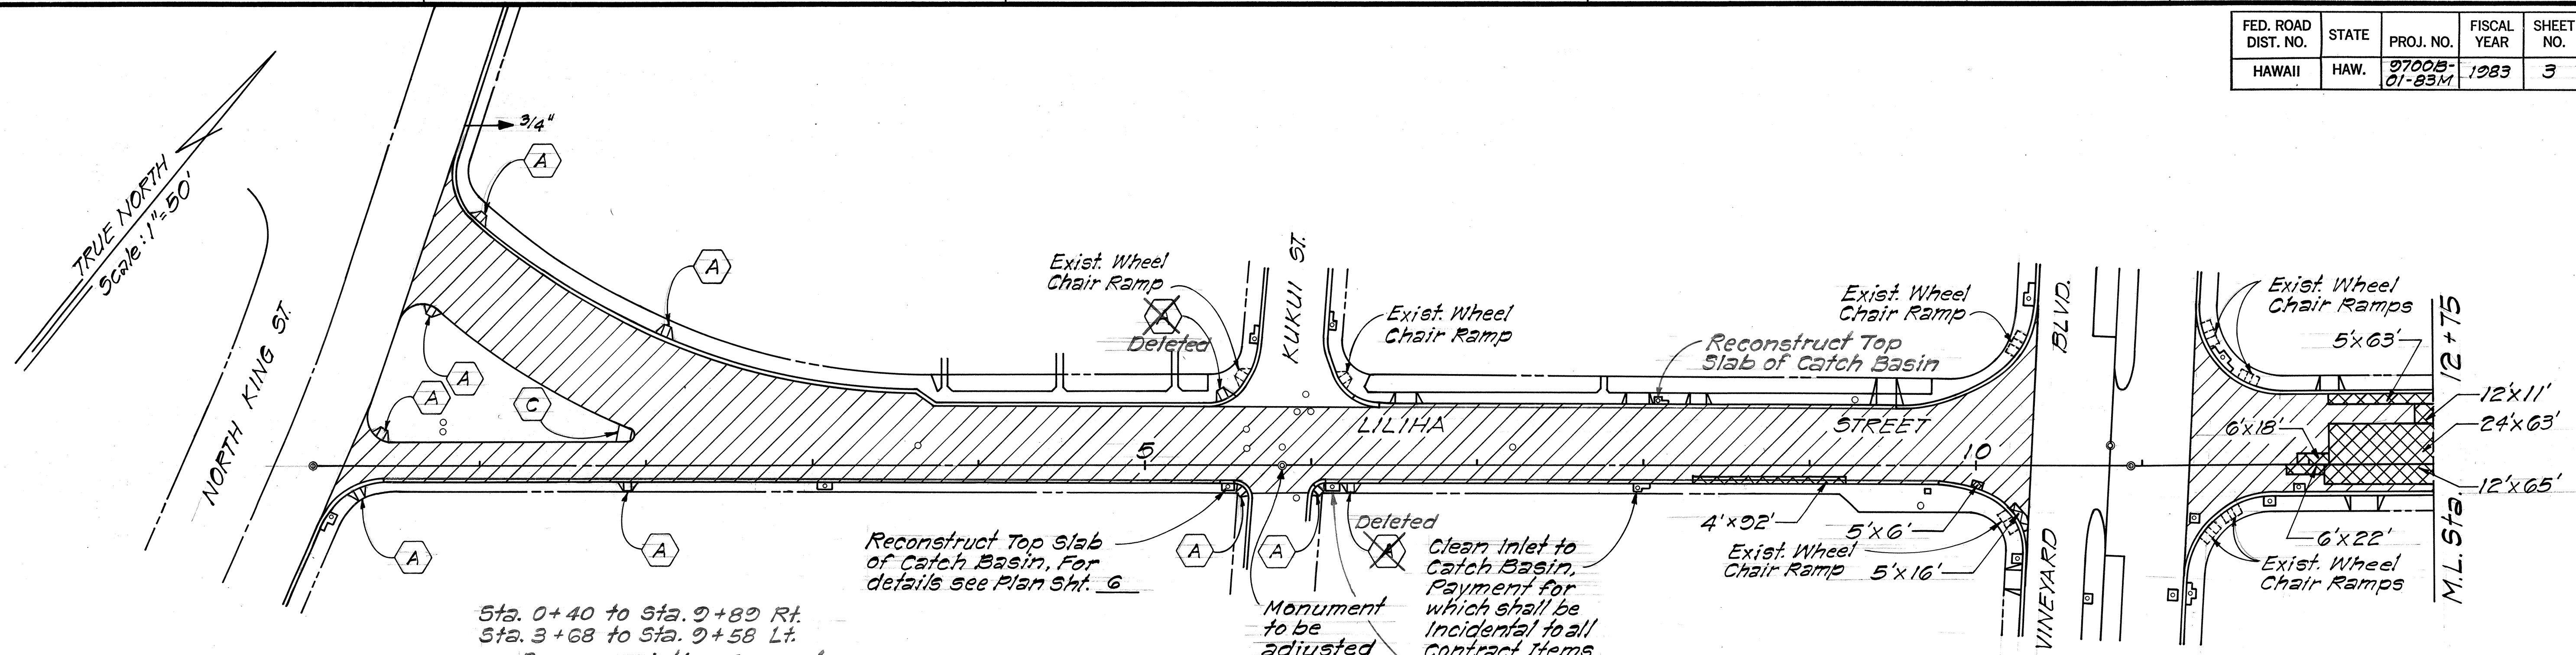

LEGEND

- Resurfacing Area
- Reconstruction of Weakened Pavement Areas and Resurfacing Areas.
- Install New Type "A" Wheel Chair Ramp, For Details see Plan Sht. No. 9
- Install New Type "C" Wheel Chair Ramp, For Details see Plan Sht. No. 9
- Install New Type "F" Wheel Chair Ramp, For Details see Plan Sht. No. 7
- Install New Type "H" Wheel Chair Ramp, For Details see Plan Sht. No. 7

Sta. 0+40 to Sta. 9+80 Rt.
Sta. 3+68 to Sta. 9+58 Lt.
Remove existing Concrete Gutter and reconstruct with ACB.

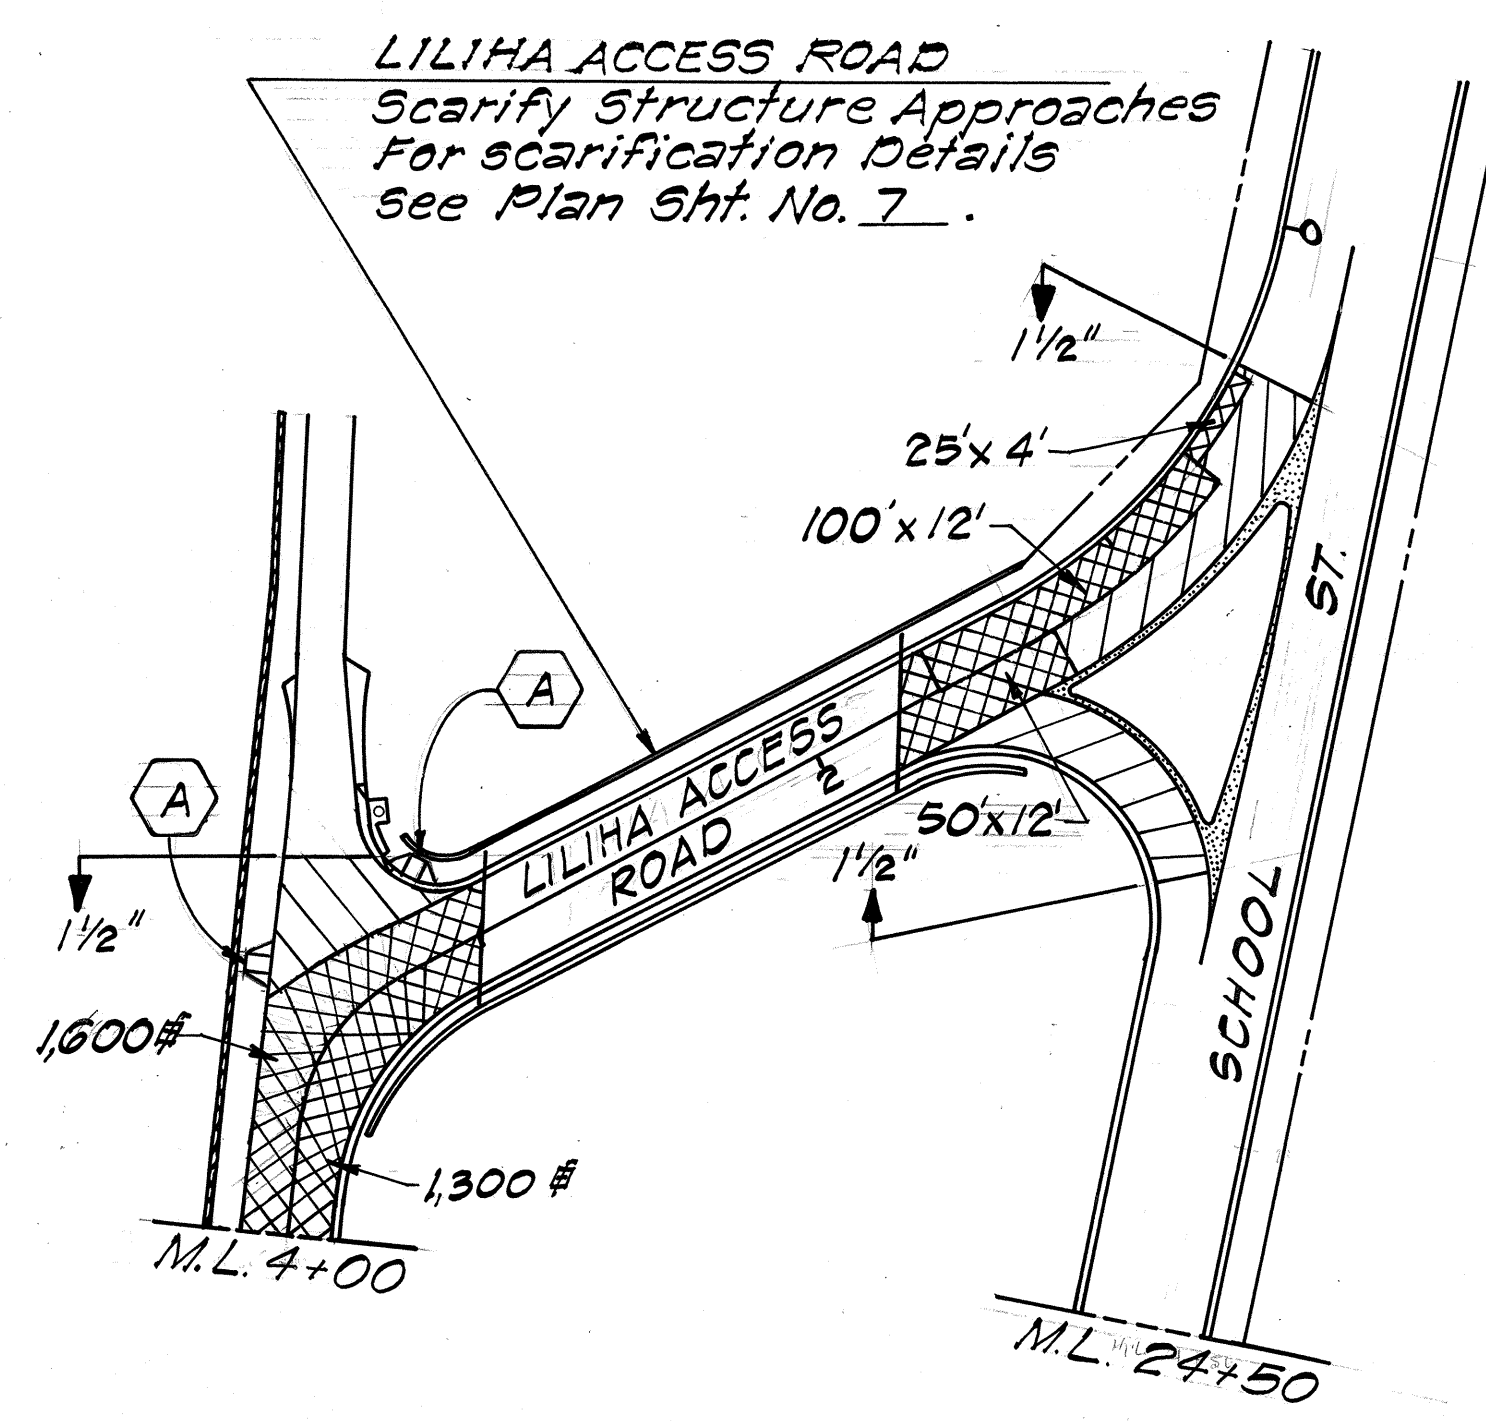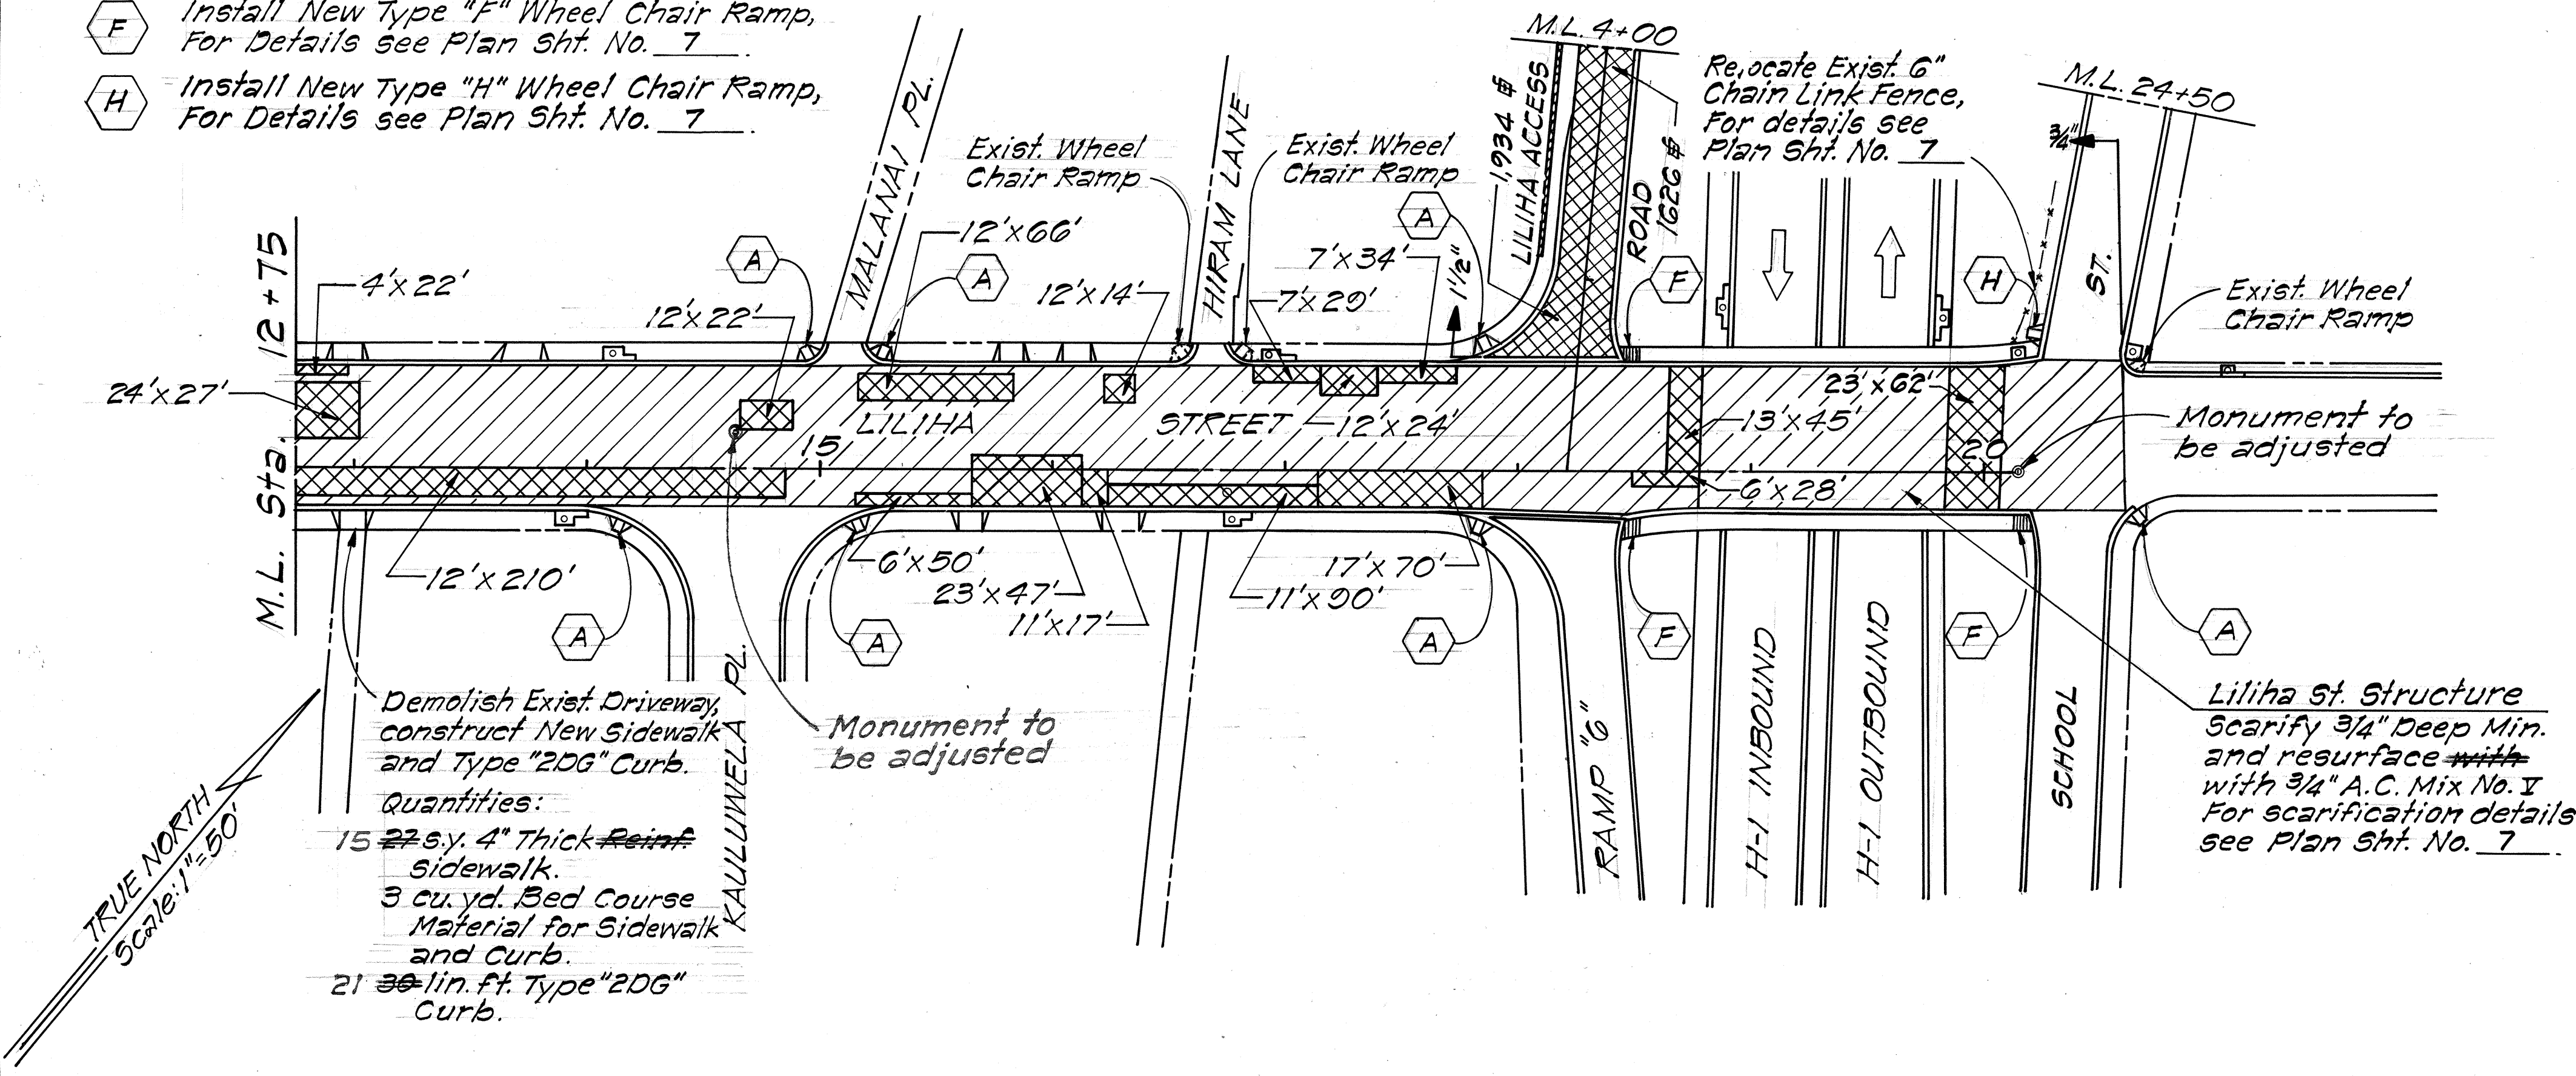

STATE OF HAWAII
DEPARTMENT OF TRANSPORTATION
LAND TRANSPORTATION FACILITIES DIVISION



ROADWAY PLAN

LILIHA STREET RESURFACING
Proj. No. 9700B-01-83M

Scale: 1"=50' Date: Jan, 1983
SHEET No. 1 OF 2 SHEETS

DATE	_____
SURVEY PLOTTED BY	_____
ORIGINAL PLAN	_____
DESIGNED BY	_____
TRACED BY	_____
NOTE BOOK	_____
QUANTITIES BY	_____
CHECKED BY	_____
No.	_____

FED. ROAD DIST. NO.	STATE	PROJ. NO.	FISCAL YEAR	SHEET NO.	TOTAL SHEETS
HAWAII	HAW.	9700B-01-83M	1983	4	24

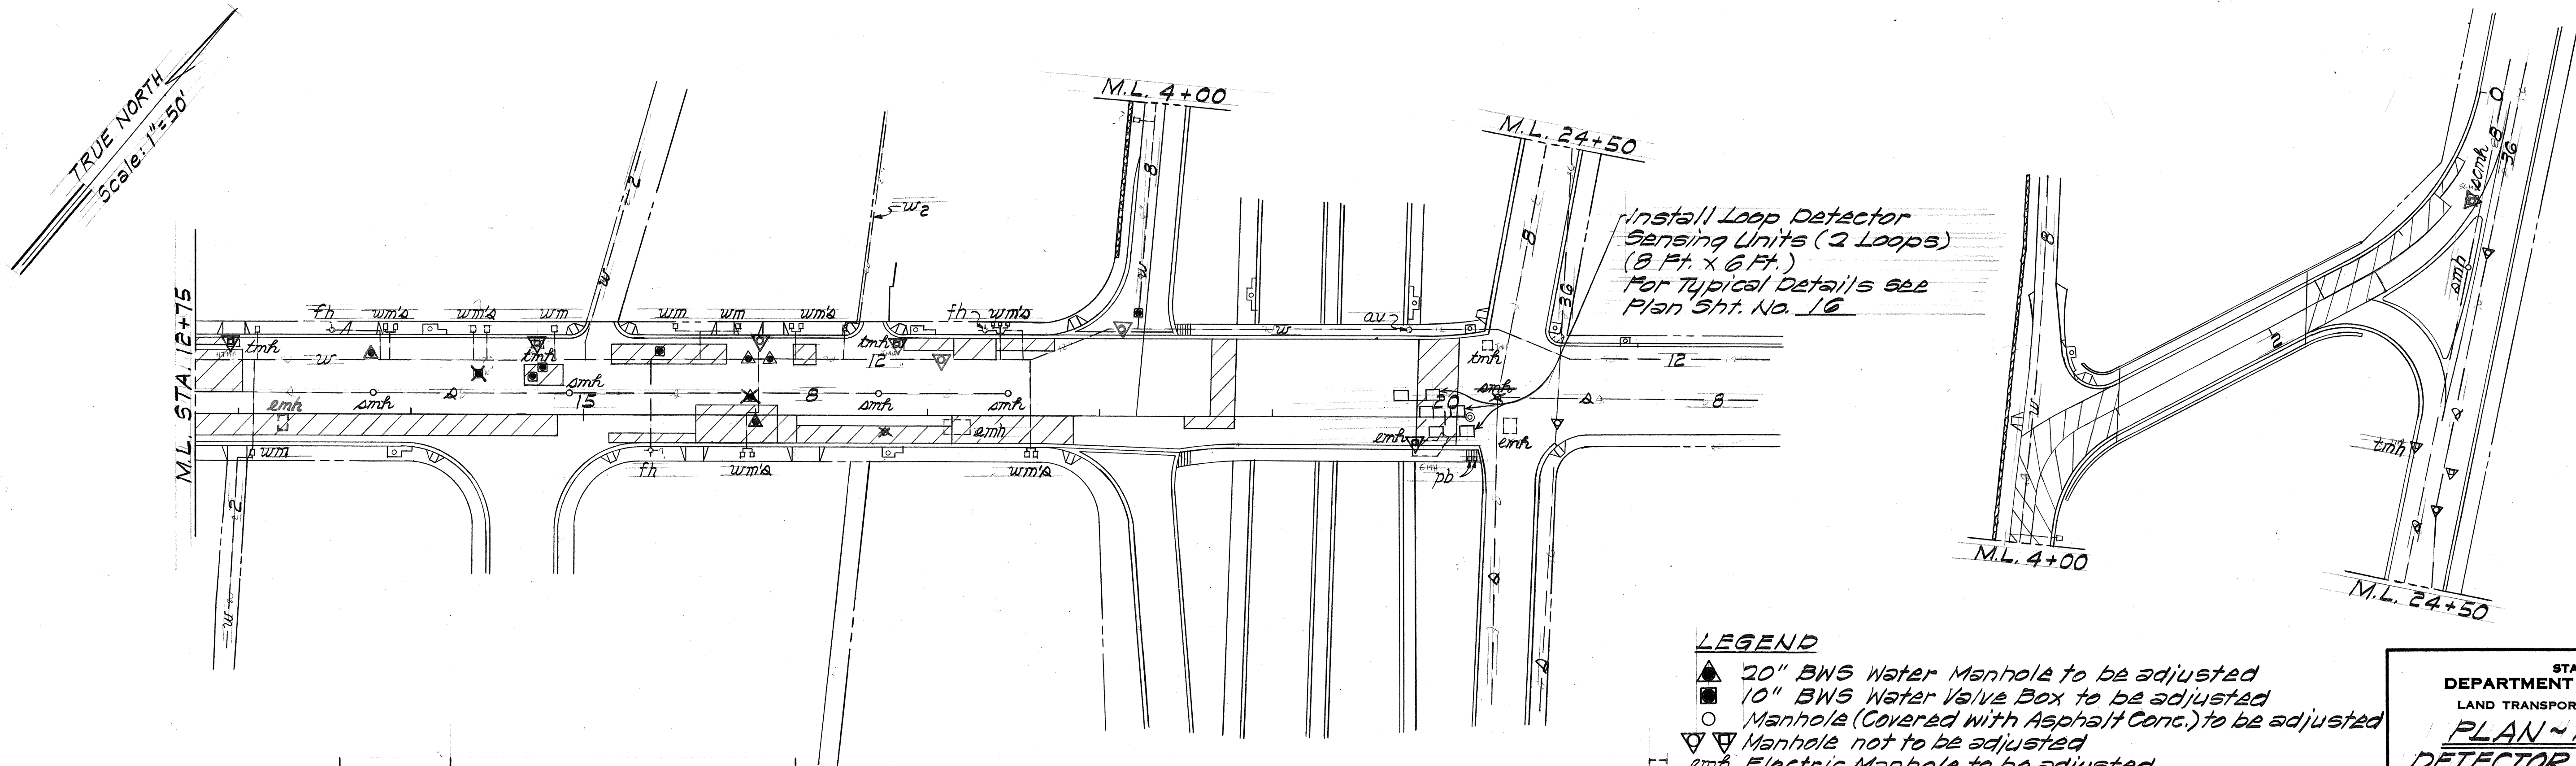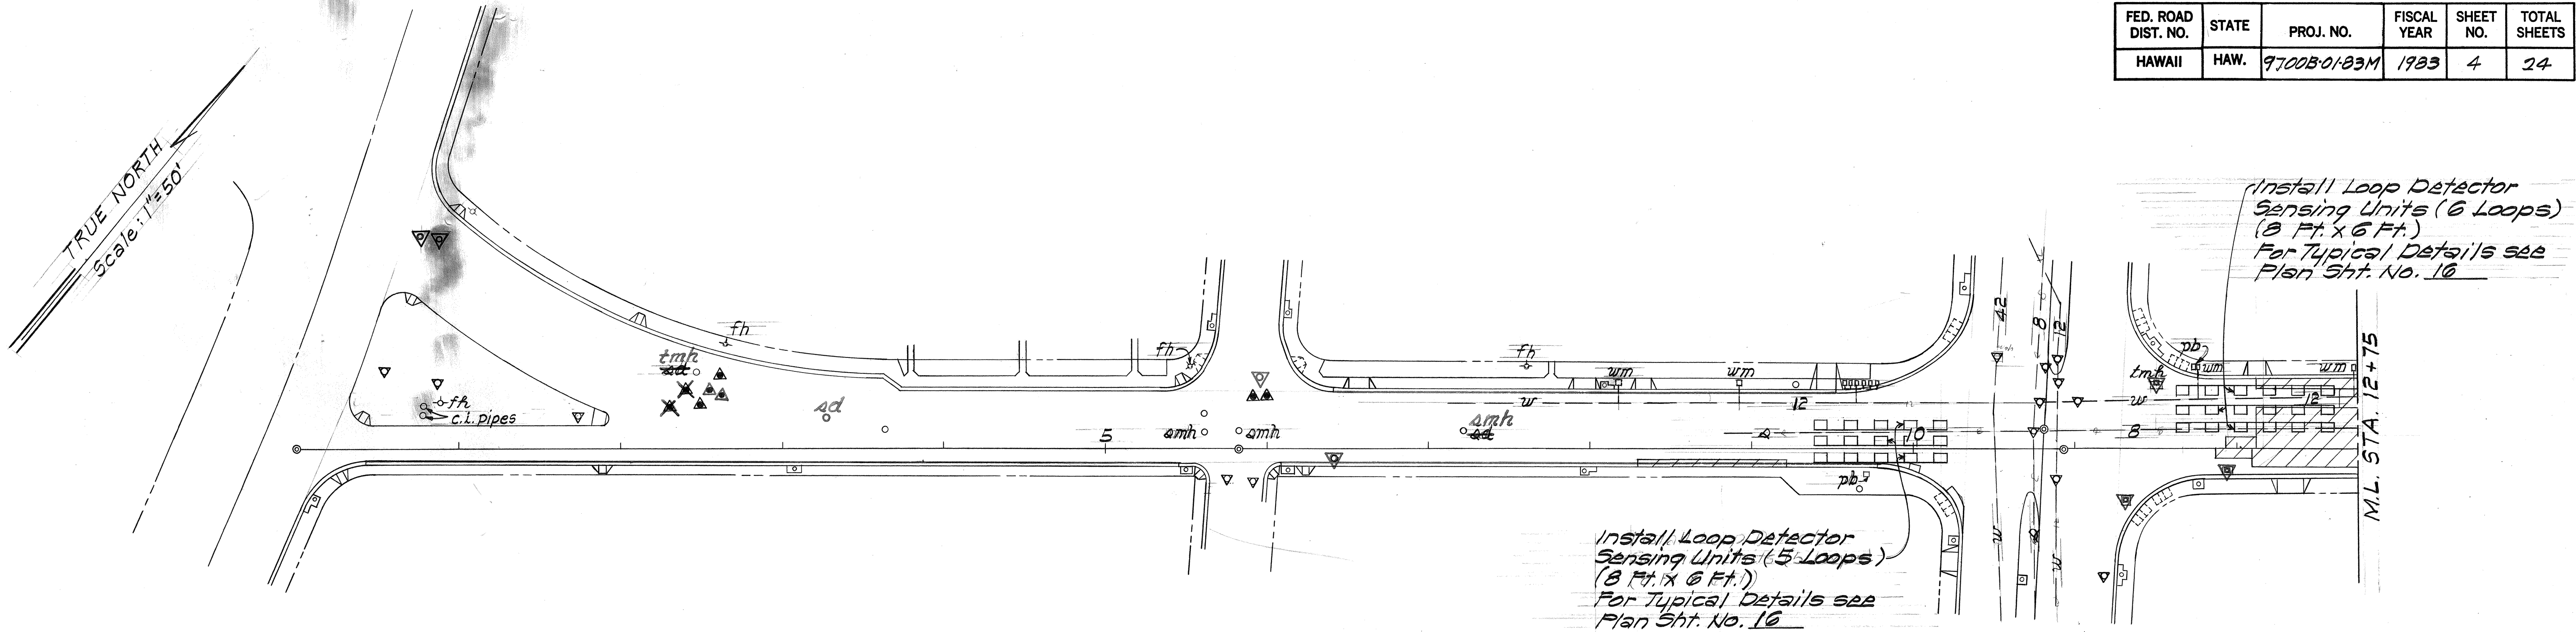

- LEGEND**
- ▲ 20" BWS Water Manhole to be adjusted
 - 10" BWS Water Valve Box to be adjusted
 - Manhole (Covered with Asphalt Conc.) to be adjusted
 - ▽ Manhole not to be adjusted
 - emh Electric Manhole to be adjusted
 - sd Storm Drain Manhole to be adjusted
 - smh Sewer Manhole to be adjusted
 - tmh Telephone Manhole to be adjusted
 - scmh Signal Corps Manhole to be adjusted

APPROVED:

R. Nagata
for Chief, Planning & Engineering, BWS Date 2-15-83

2/14/83	Added Board of Water Supply Meter Boxes, Laterals and Main Lines.
DATE	REVISION

STATE OF HAWAII
DEPARTMENT OF TRANSPORTATION
LAND TRANSPORTATION FACILITIES DIVISION

PLAN - MANHOLE & DETECTOR LOOP LOCATIONS

LILIHA STREET RESURFACING
Proj. No. 9700B-01-83M

Scale: 1" = 50' Date: Jan., 1983
SHEET NO. 2 OF 2 SHEETS

DATE	____
SURVEY PLOTTED BY	____
DRAWN BY	____
DESIGNED BY	____
NOTE BOOK	____
QUANTITIES BY	____
CHECKED BY	____