| IN        | NDEX TO DRAWINGS                              |
|-----------|---|
| SHEET NO. | DESCRIPTION                                   |
| 1.        | TITLE SHEET                                   |
| 2         | TYPICAL SECTION AND GENERAL NOTES             |
| 3 - 4     | PLANS   |
| 5 - 9     | UTILITY NOTES, MISC. AND TYPICAL DETAILS      |
| 10 -24    | PAVEMENT MARKING & STRIPING PLANS AND DETAILS |
|           |   |
|           |   |
| 1         |   |
|           |   |
|           |   |
STATE OF HAWAII





DEPARTMENT OF TRANSPORTATION LAND TRANSPORTATION FACILITIES DIVISION

HONOLULU, HAWAII
"AS BUILT"
PLANS FOR

LILIHA STREET RESURFACING
King Street to School Street
PROJECT NO. 9700B-01-83M

DISTRICT OF HONOLULU ISLAND OF OAHU

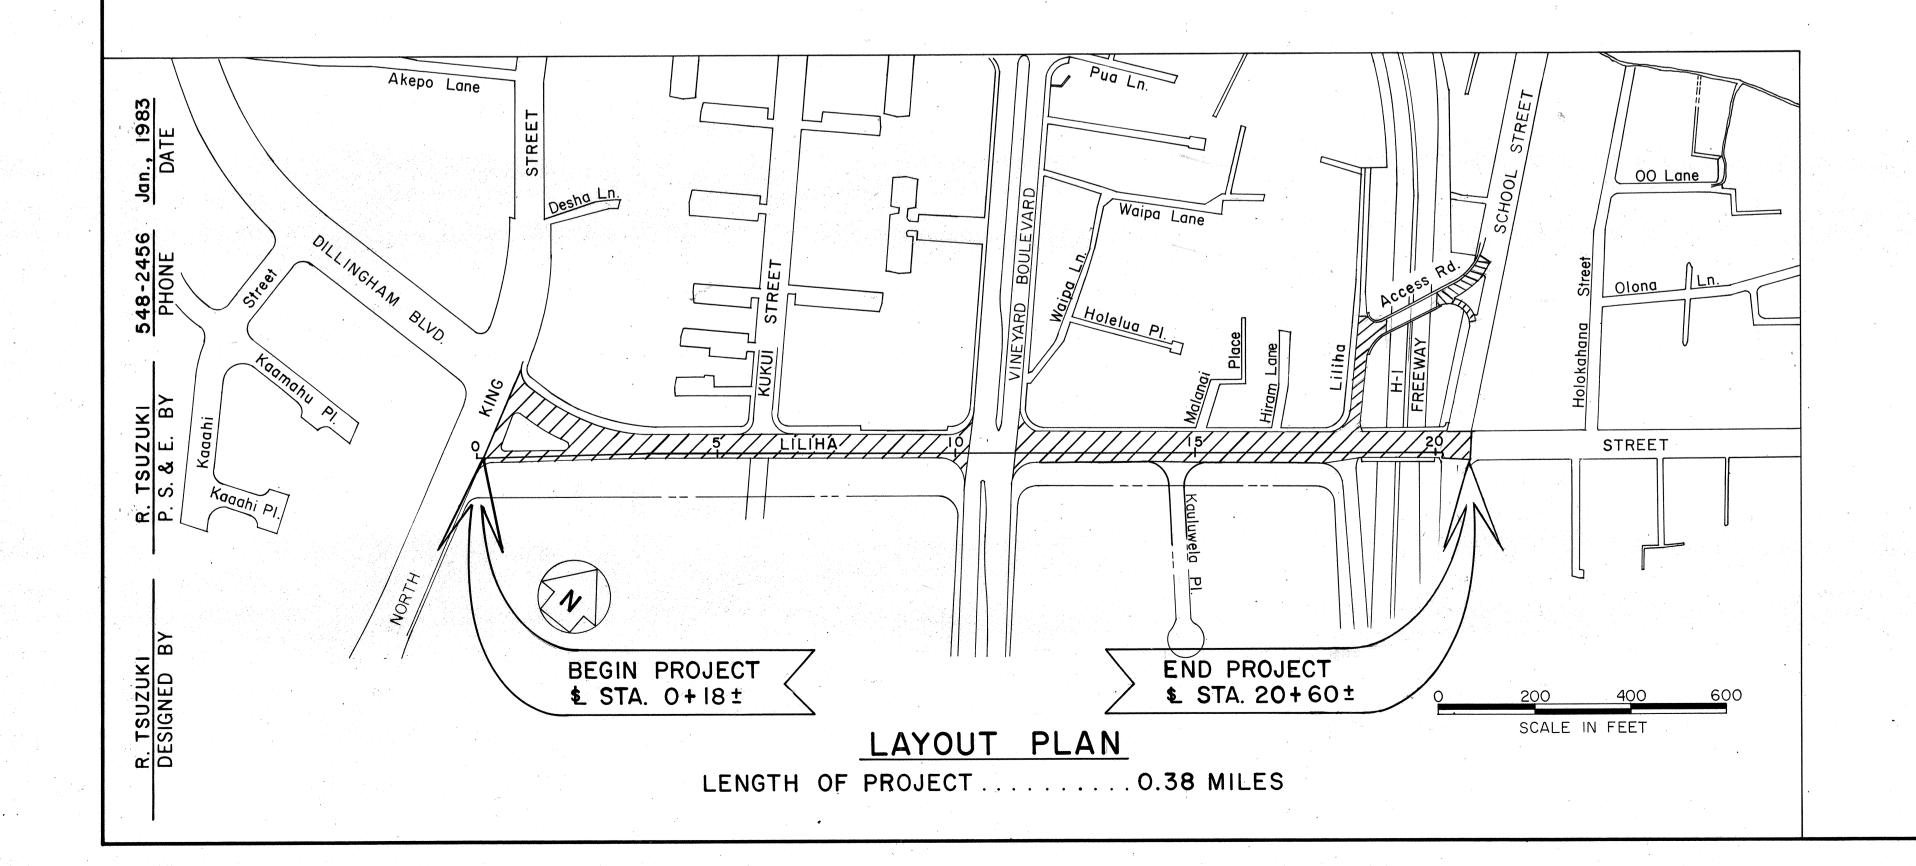

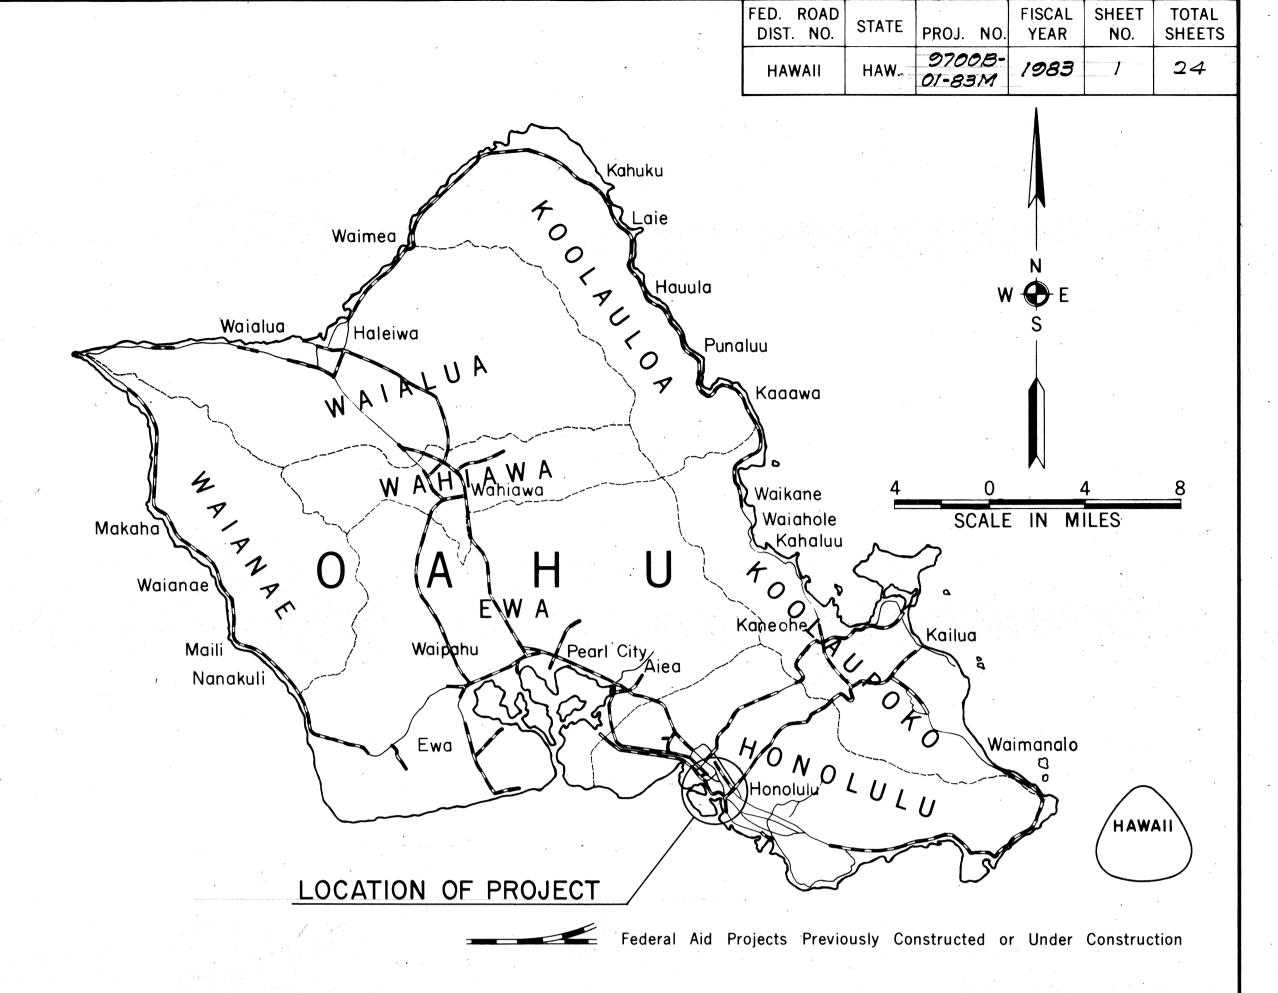

CHANGES MADE DURING CONSTRUCTION HAVE BEEN INCORPORATED ON THESE PLANS EXCEPT CHANGES IN THE ORIGINAL THEORETICAL QUANTITIES. FOR ACTUAL QUANTITIES, REFER TO PROJECT LEDGER AND/OR COMPUTATION BOOK.

RESIDENT ENGINEER DATE

DEPARTMENT OF TRANSPORTATION
STATE OF HAWAII

APPROVED:

BIR. OF TRANSPORTATION

DATE