



FED. ROAD DIST. NO.	STATE	PROJ. NO.	FISCAL YEAR	SHEET NO.	TOTAL SHEETS
HAWAII	HAW.	2700B-01-83M	1983	2	24

GENERAL NOTES


- Improvements consist of resurfacing, reconstructing weakened pavement areas, signing, scarifying pavement on structures, installing pavement markers, and striping paved surfaces.
- Only the hatched area shown on the plan sheets shall be resurfaced.
- Provide smooth transition at connections to existing pavement and through gutters. The details of the transitions will be determined by the Engineer.
- Ruts on the existing roadway pavement shall be filled with a thin layer of leveling course ~~Mix No. I~~ prior to resurfacing. This leveling course will ~~be~~ consist of A.C. Pavement Mix No. I ~~and shall be incidental to Item No. 401.0500~~ and shall be measured and paid for under Item No. 401.0500.
- The exact limits of the reconstructed areas shall be determined in the field by the Engineer.
- The A.C. overlay thickness shall be as shown on the plans, unless otherwise directed by the Engineer.
- Exact locations of wheelchair ramps shall be determined by the Engineer.
- Payment for adjusting manholes and water valve boxes shall be made under Item No. 604.5000 Adjust Cast Iron Frame & Cover.
- All salvageable existing signs to be removed shall be removed and delivered to an area designated by the Engineer, and the cost for which shall be incidental to the various contract items.

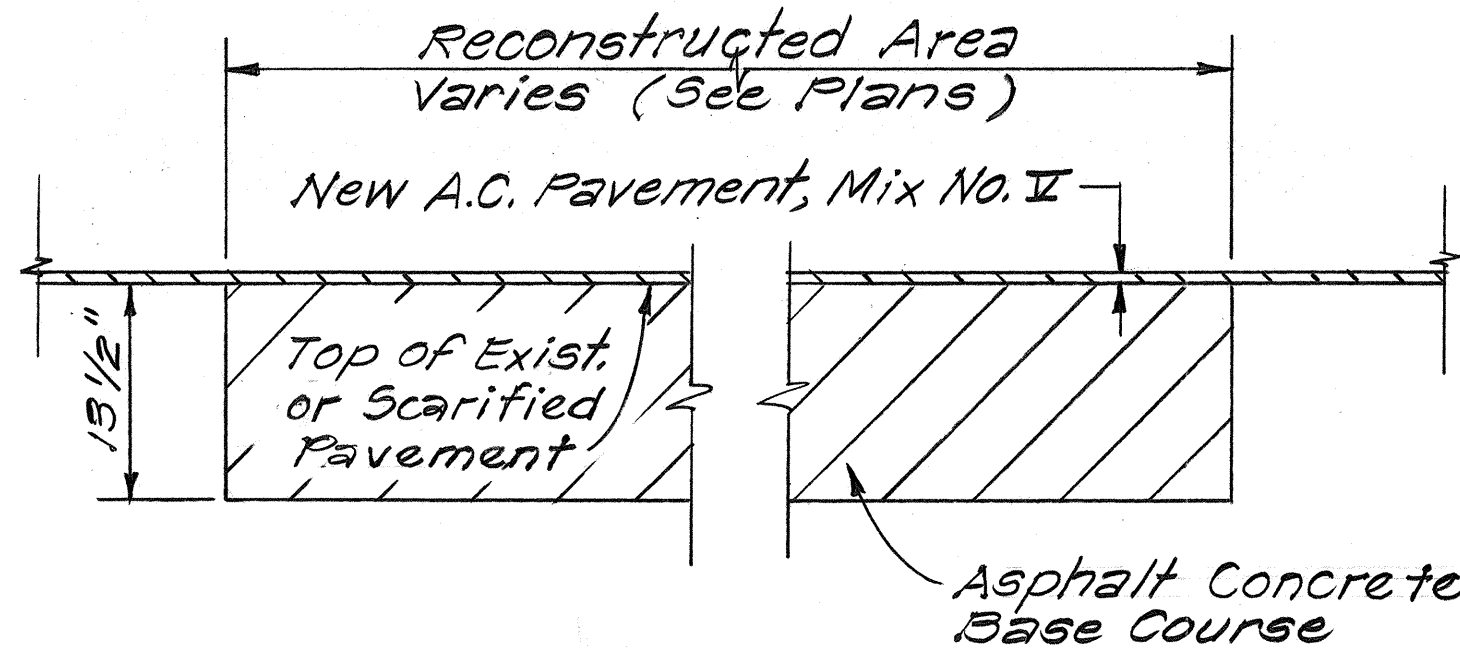


TYPICAL SECTION ~ RECONSTRUCTED AREA
ALONG LILIHA STREET
Scale: 1"=1'-0"

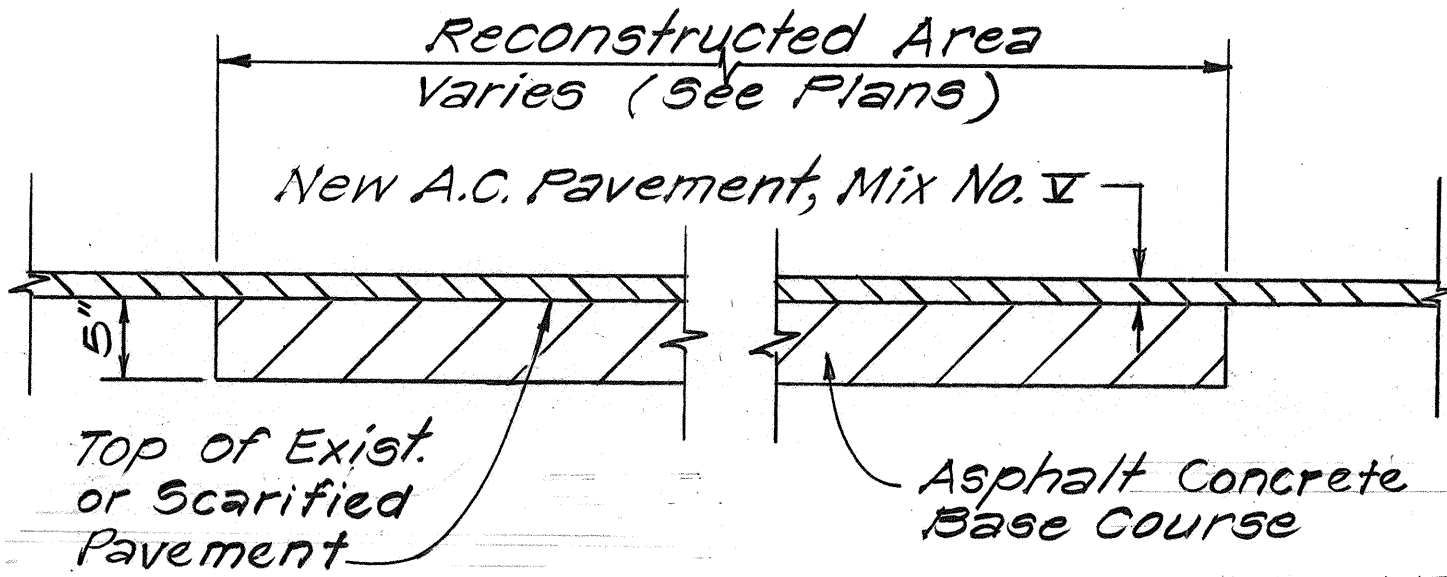


TYPICAL SECTION ~ RECONSTRUCTED AREA
ALONG LILIHA ACCESS ROAD
Scale: 1"=1'-0"

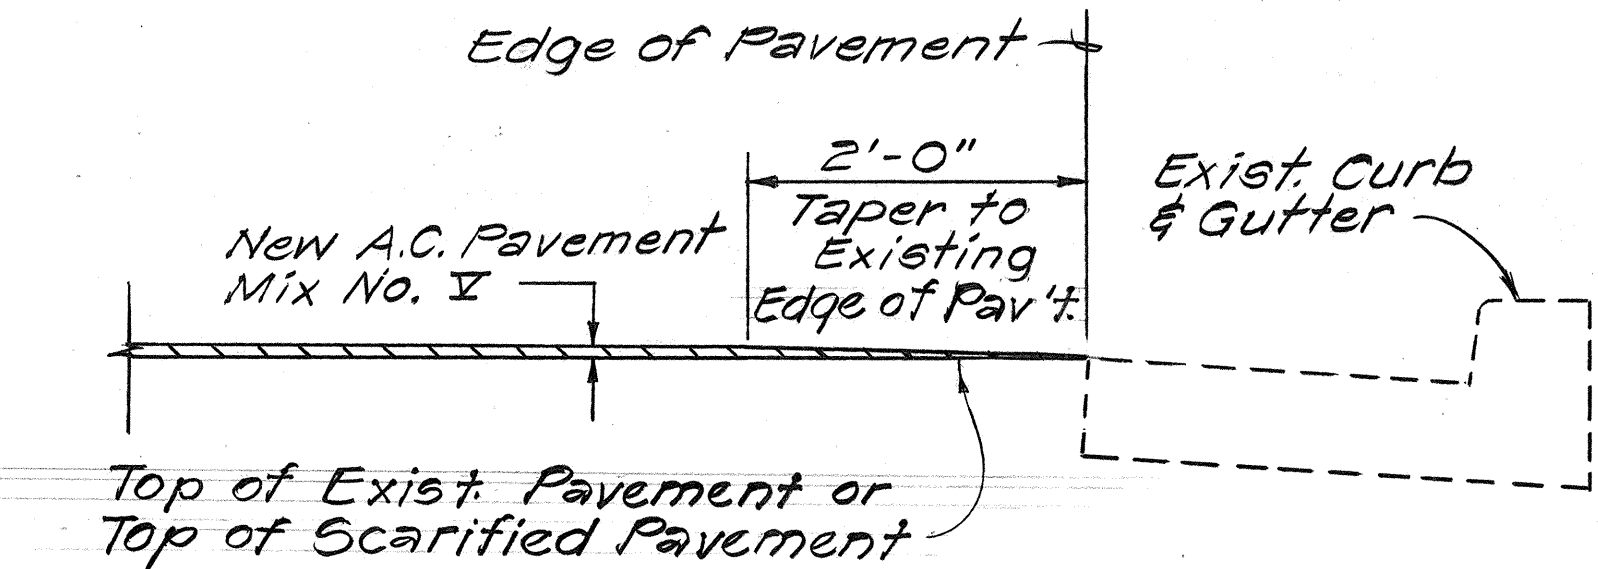


TYPICAL SECTION ~ RESURFACING TAPER
AT CONCRETE GUTTER
Scale: 1"=1'-0"

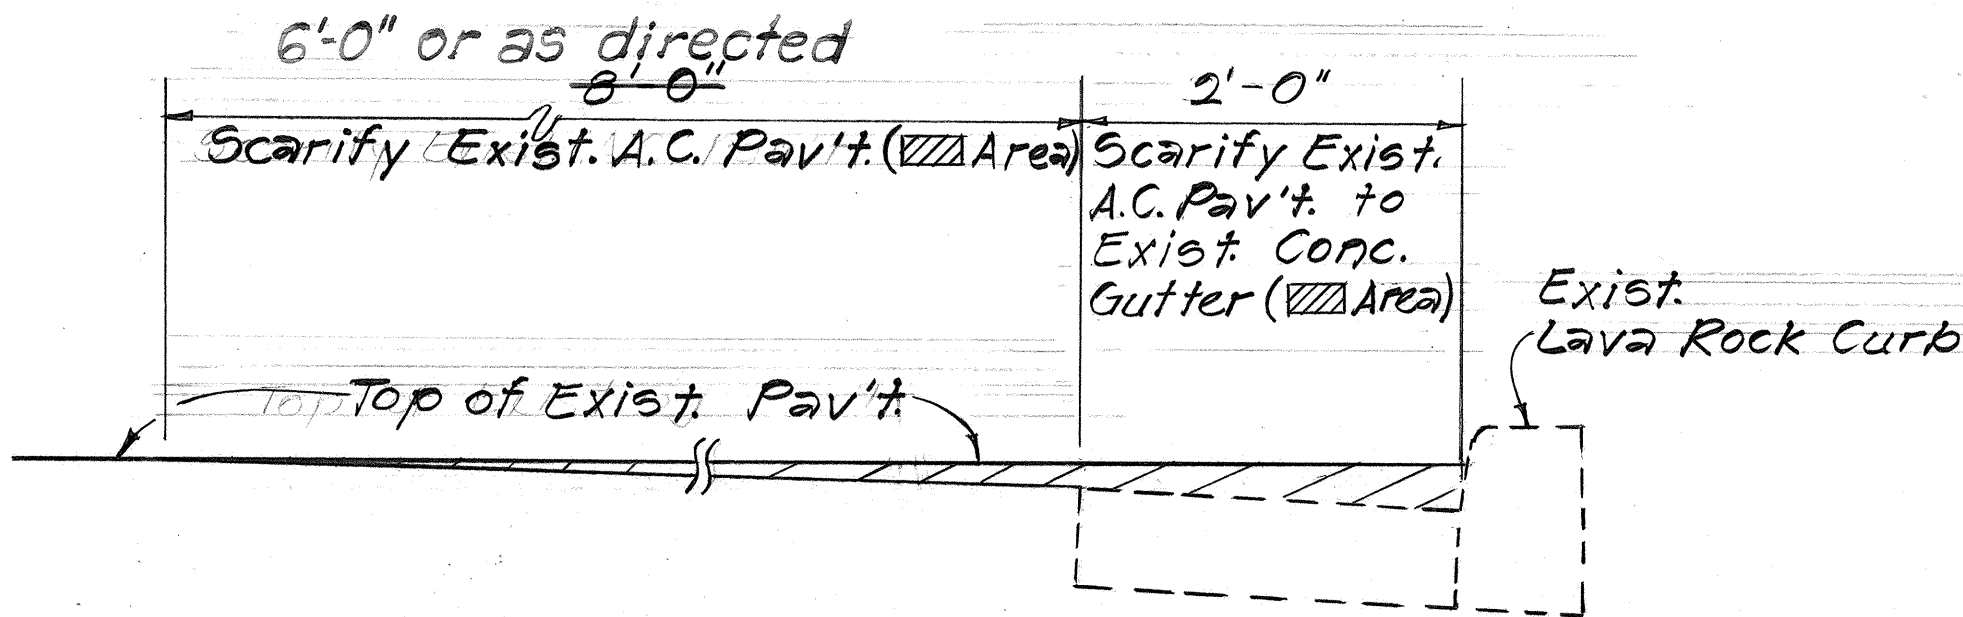


TYPICAL SECTION ~ SCARIFICATION
AT CONCRETE GUTTER
Scale: 1"=1'-0"

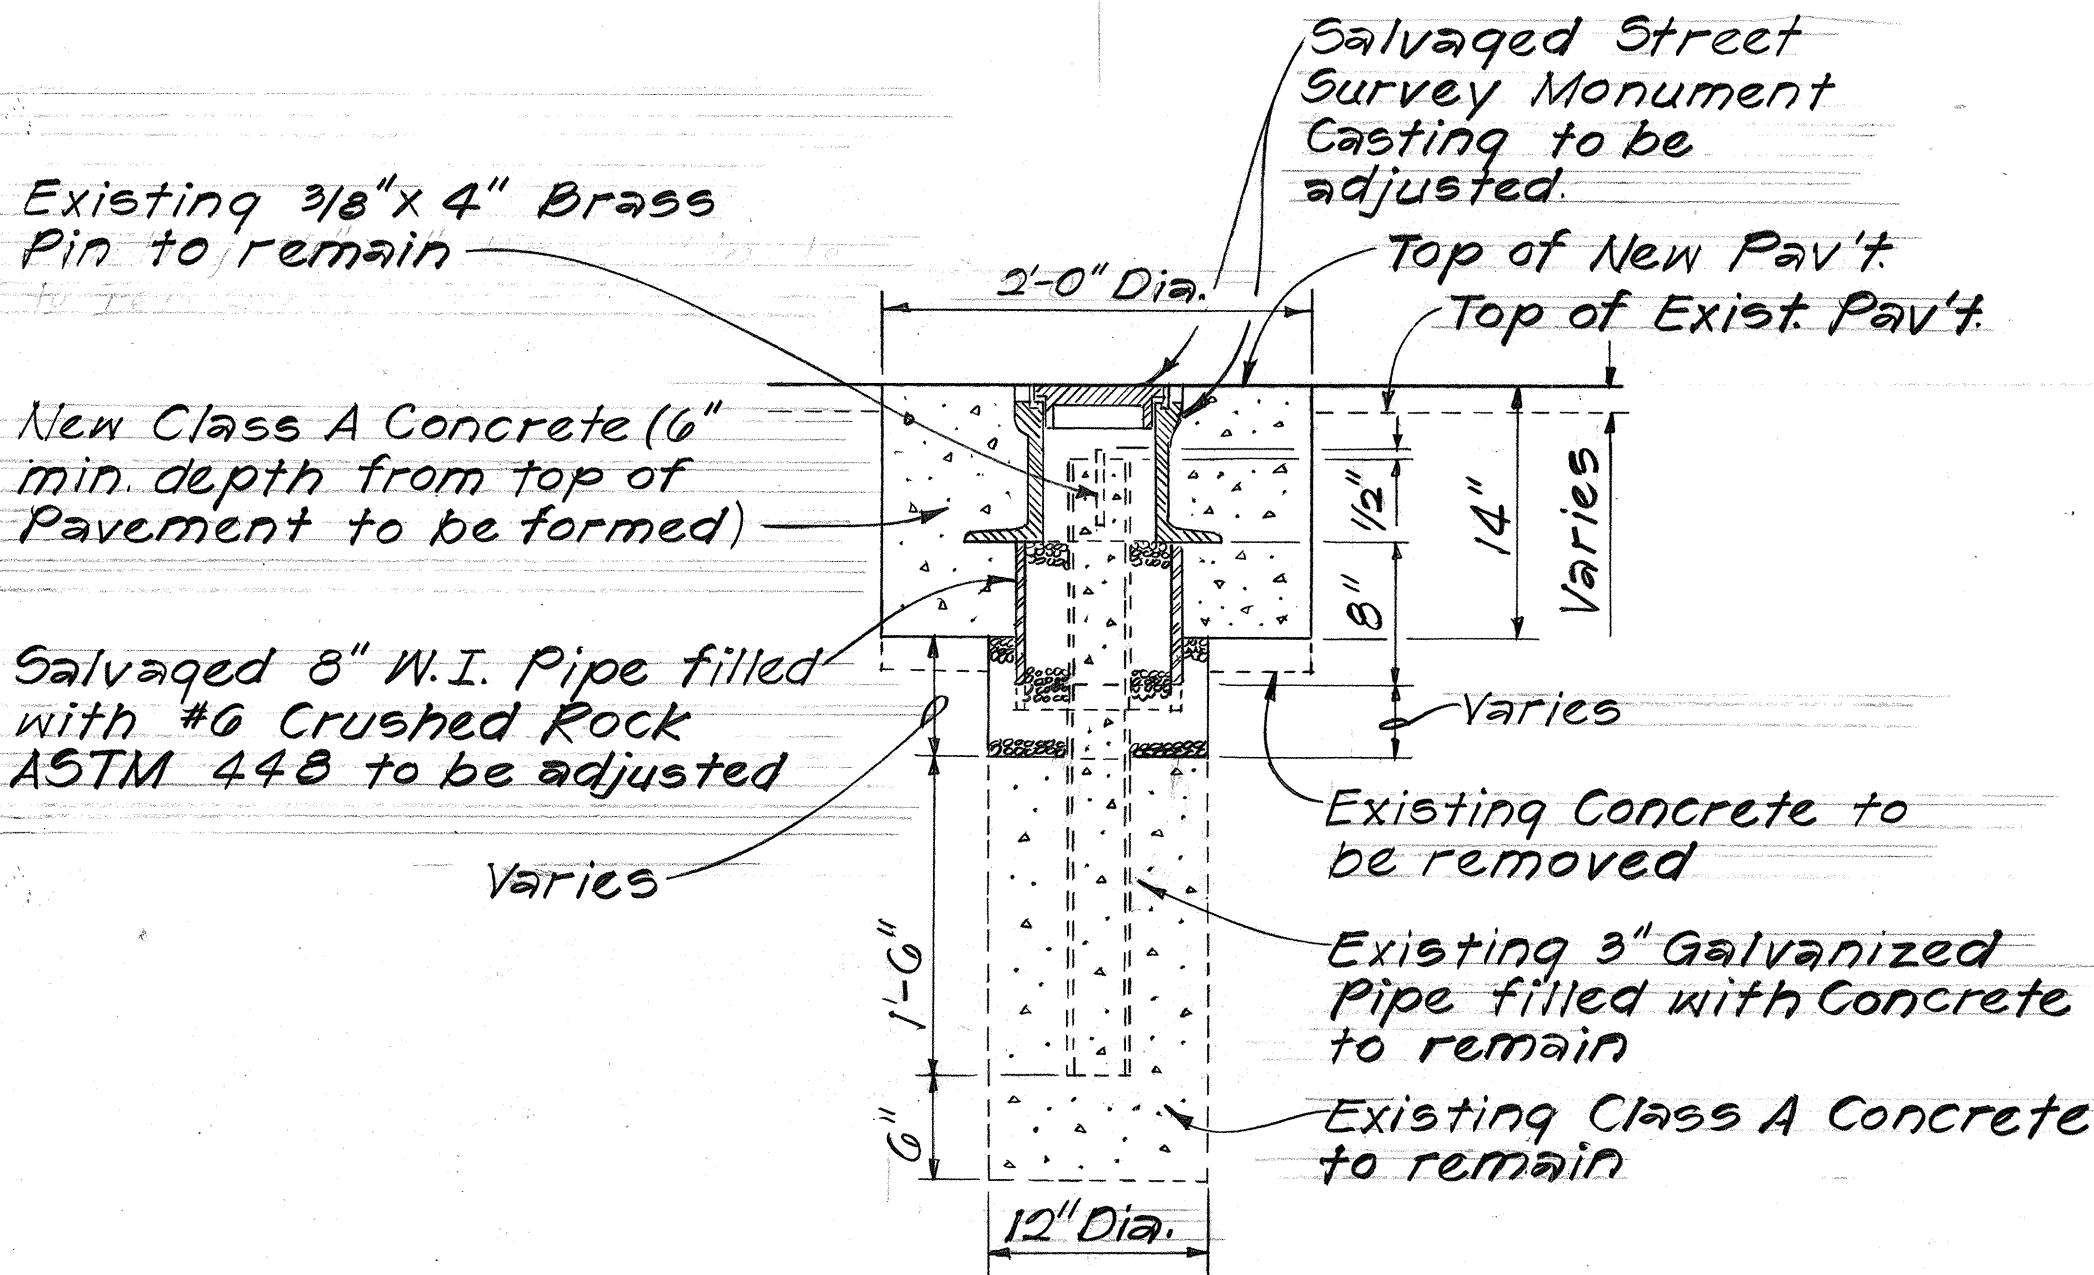

TYPICAL STREET SURVEY
MONUMENT ADJUSTMENT
Not to Scale

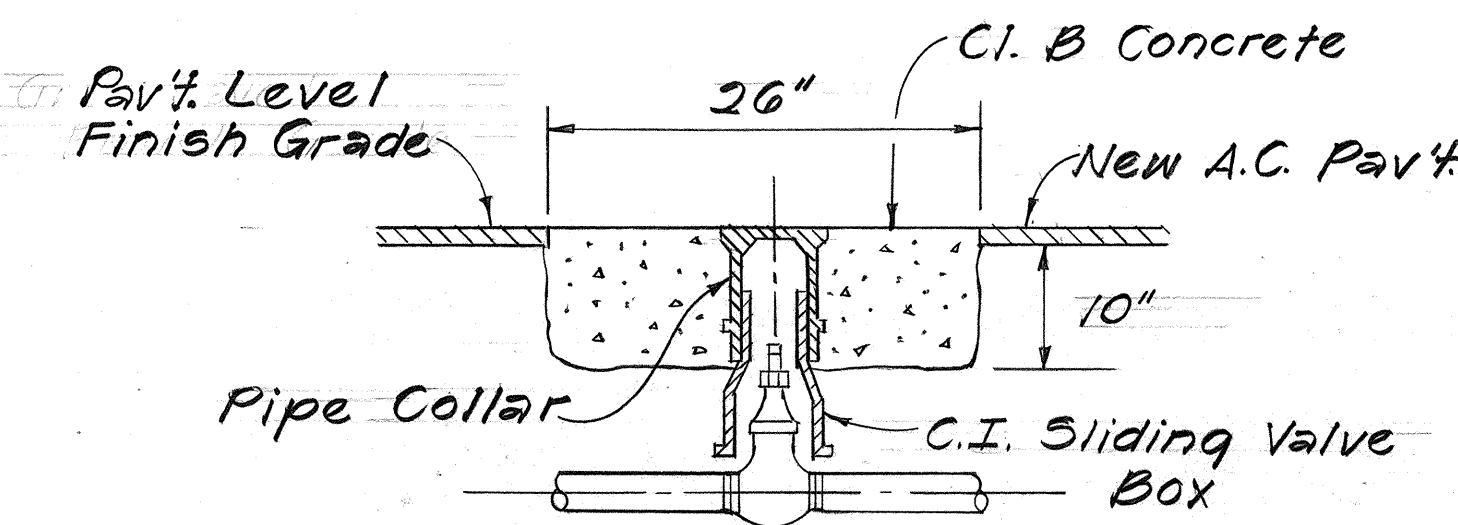

ADJUSTED WATER VALVE BOX
Not to Scale

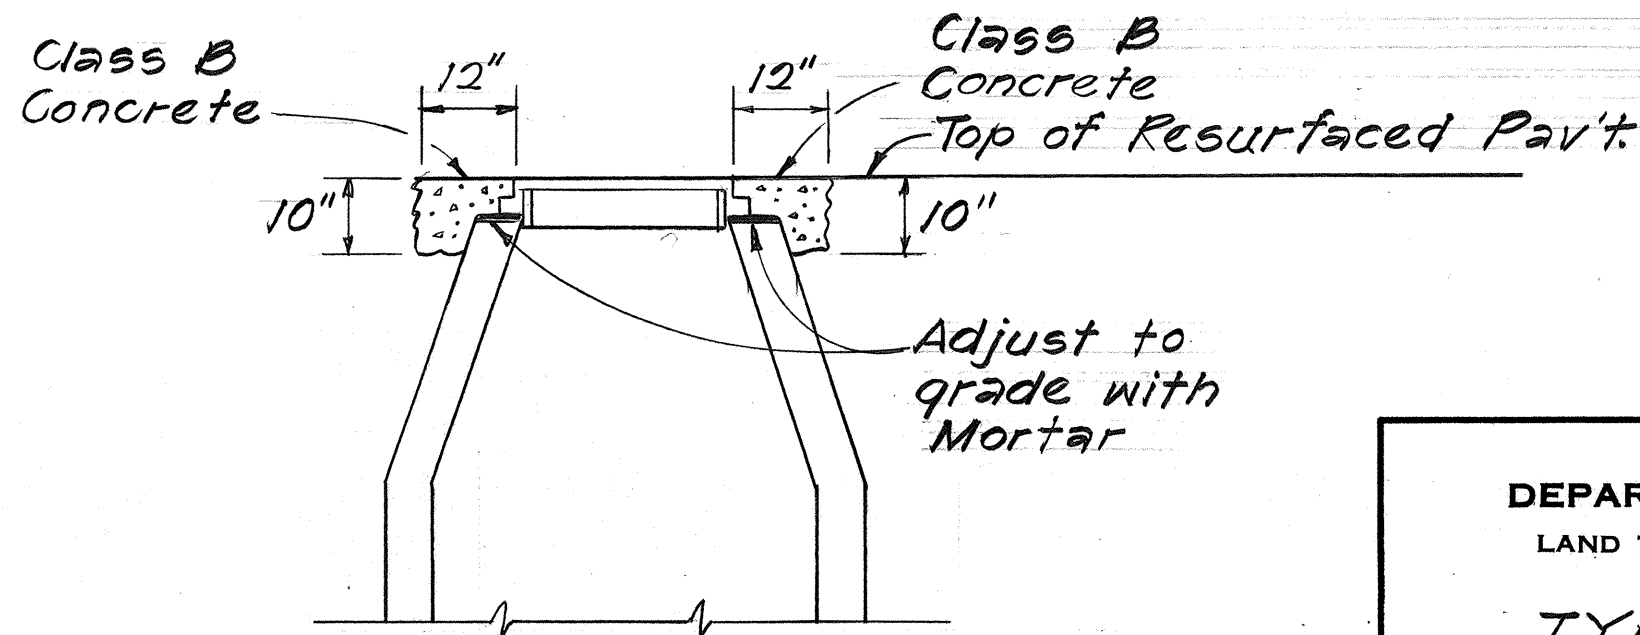

ADJUSTED MANHOLE AND
AIR RELIEF VALVE BOX
Not to Scale

STATE OF HAWAII DEPARTMENT OF TRANSPORTATION LAND TRANSPORTATION FACILITIES DIVISION					
TYPICAL SECTIONS AND GENERAL NOTES					
LILIHA STREET RESURFACING PROJECT NO. 2700B-01-83M					
Scale: 1"=1'-0" Date: Jan., 1983					
SHEET NO. 1 OF 1 SHEETS					