





FED. ROAD DIST. NO.	STATE	FED. AID PROJ. NO.	FISCAL YEAR	SHEET NO.	TOTAL SHEETS
HAWAII	HAW.	STP-7413(1)	1994	C018S-2	18

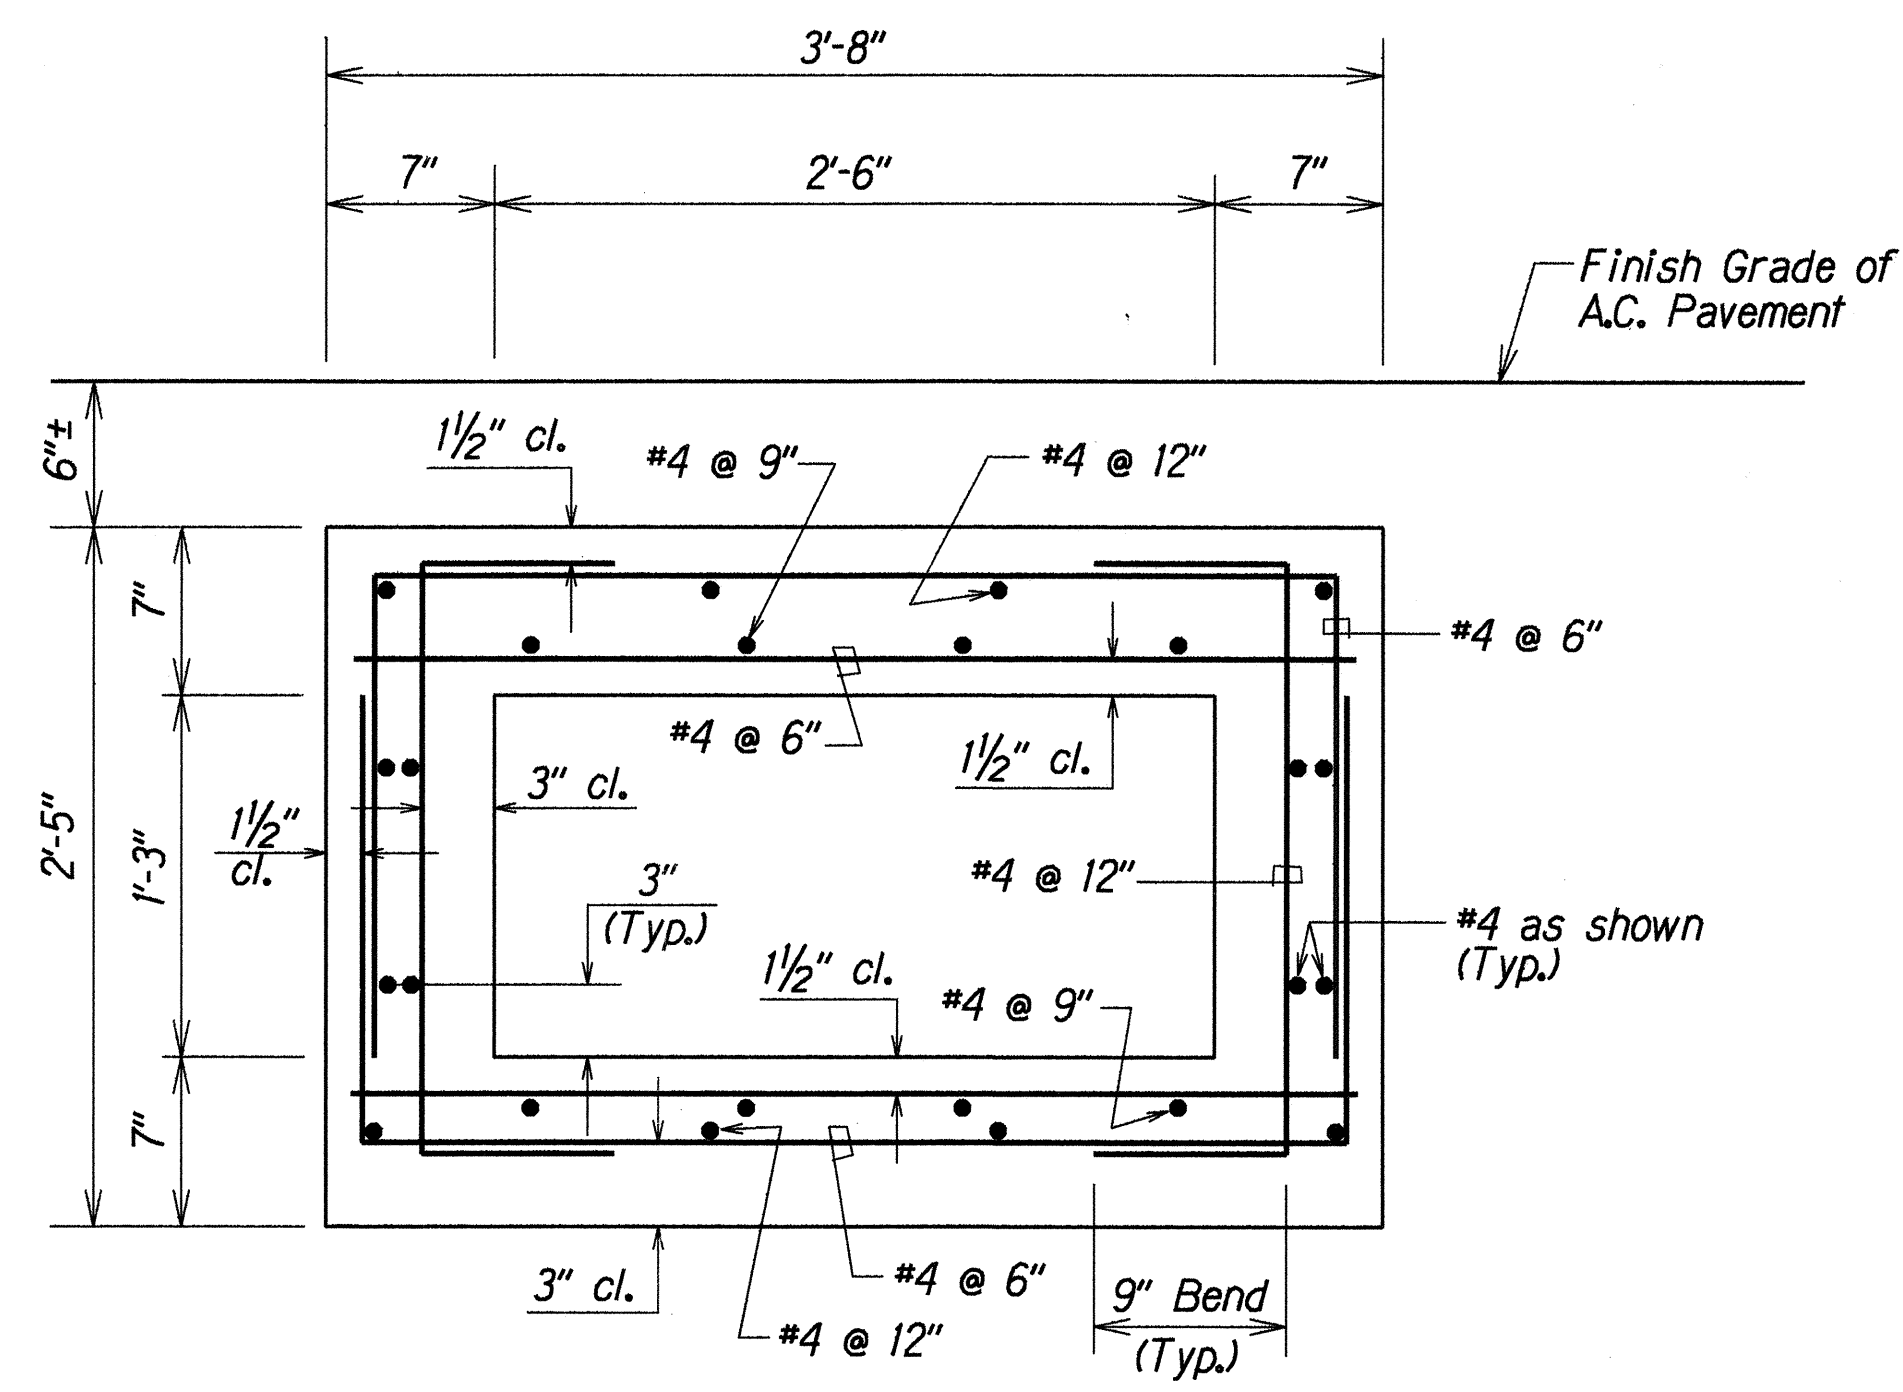

TYPICAL SECTION OF 2'-6" X 1'-3" CONCRETE BOX CULVERT
Scale: 1 1/2"=1'-0"

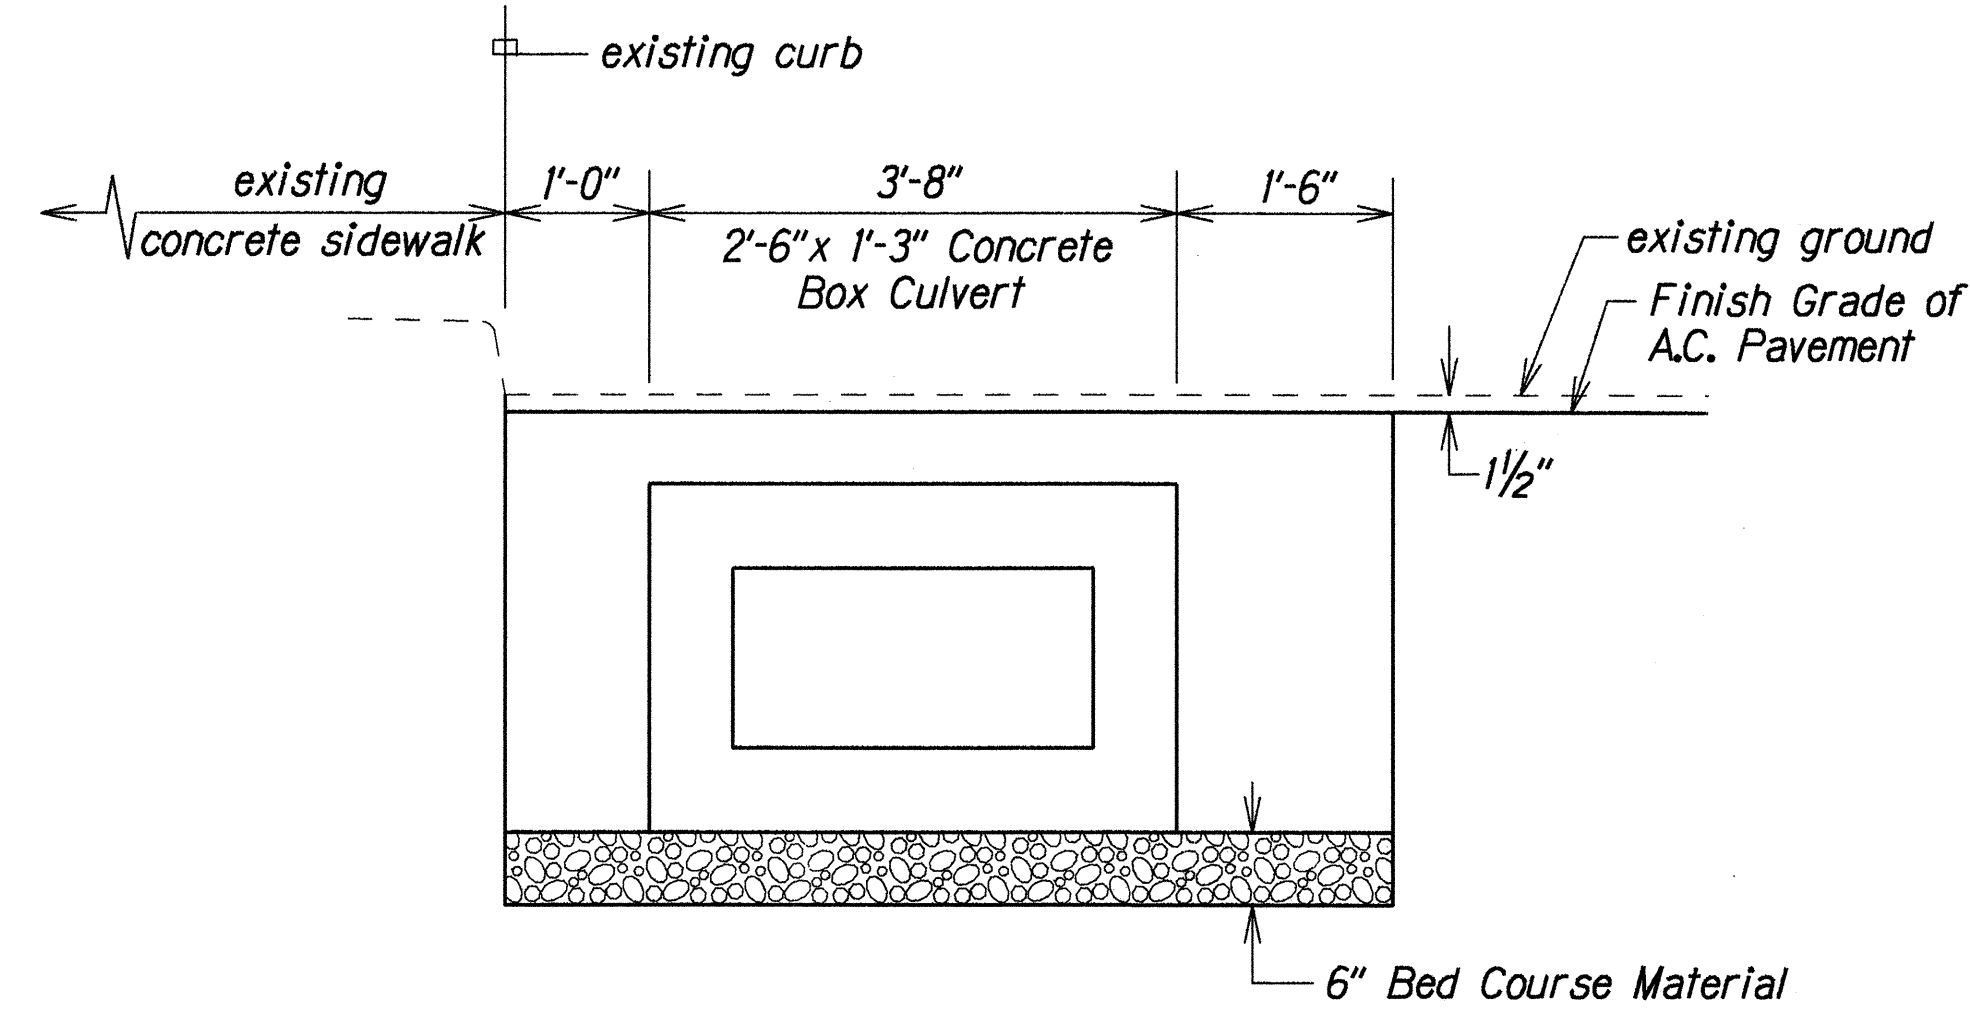

TYPICAL DETAIL OF CULVERT TRENCH
Scale: 3/4"=1'-0"

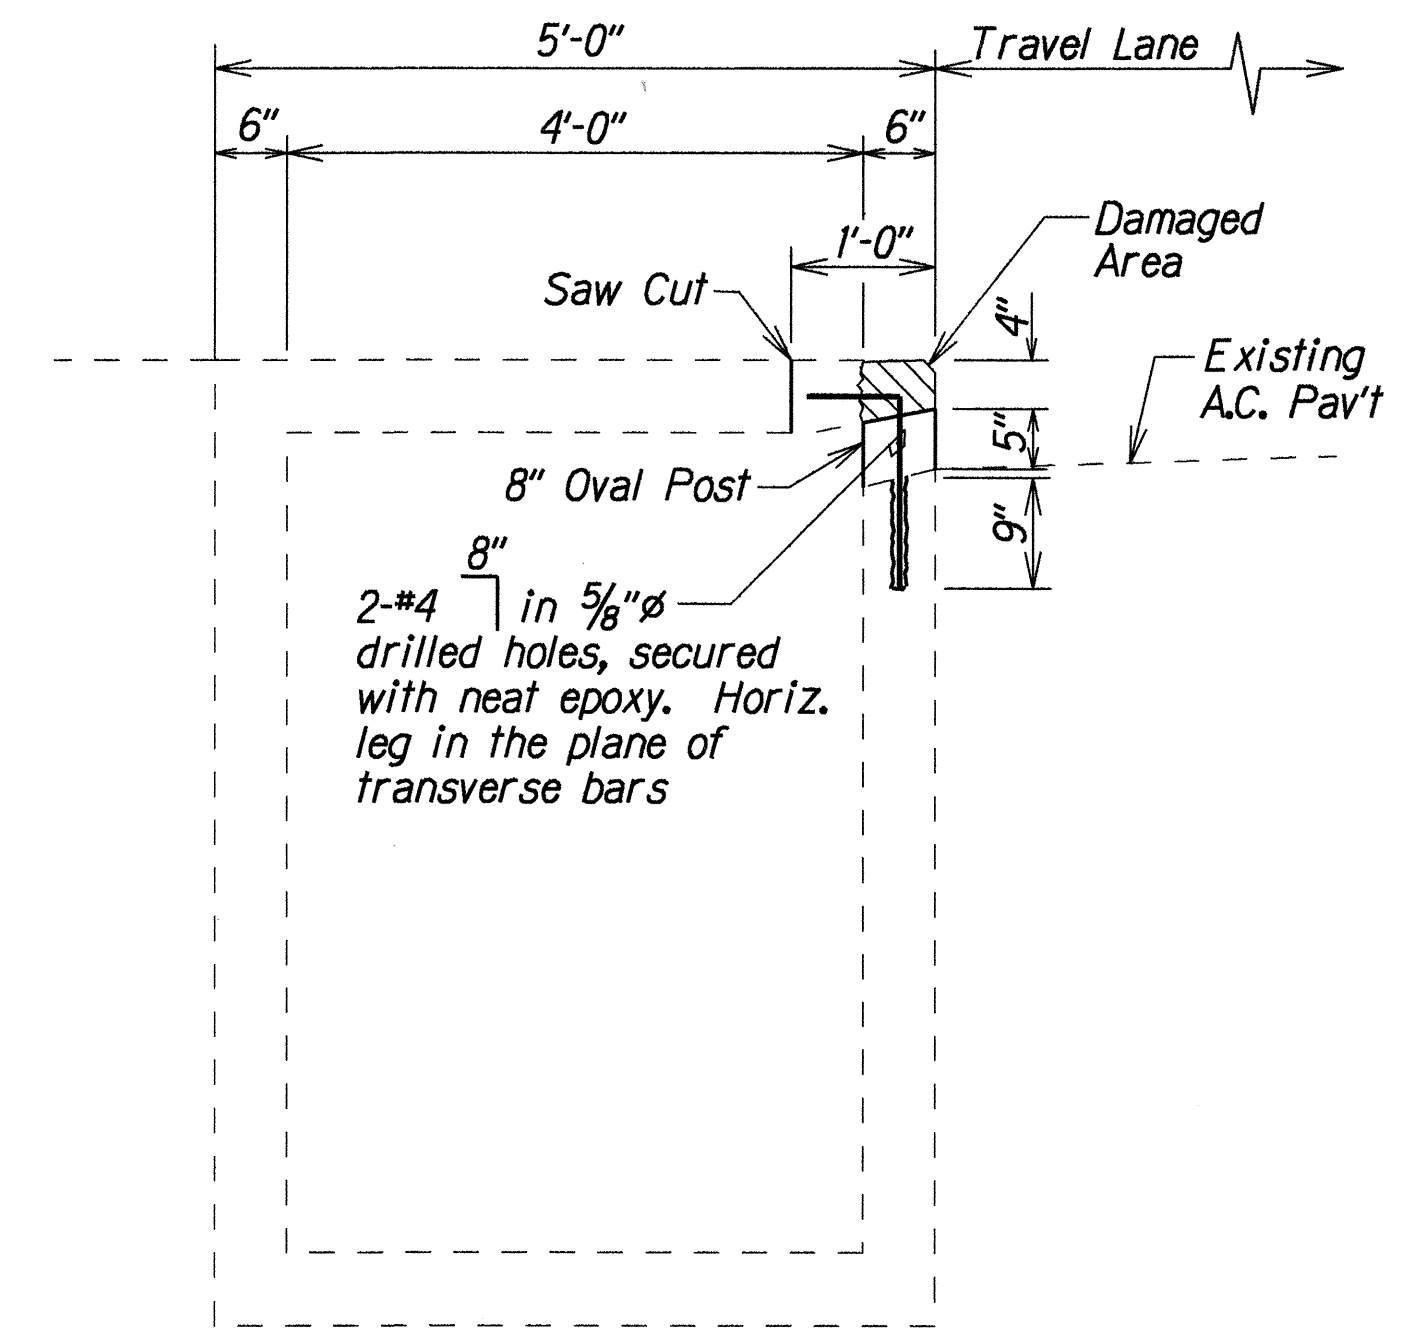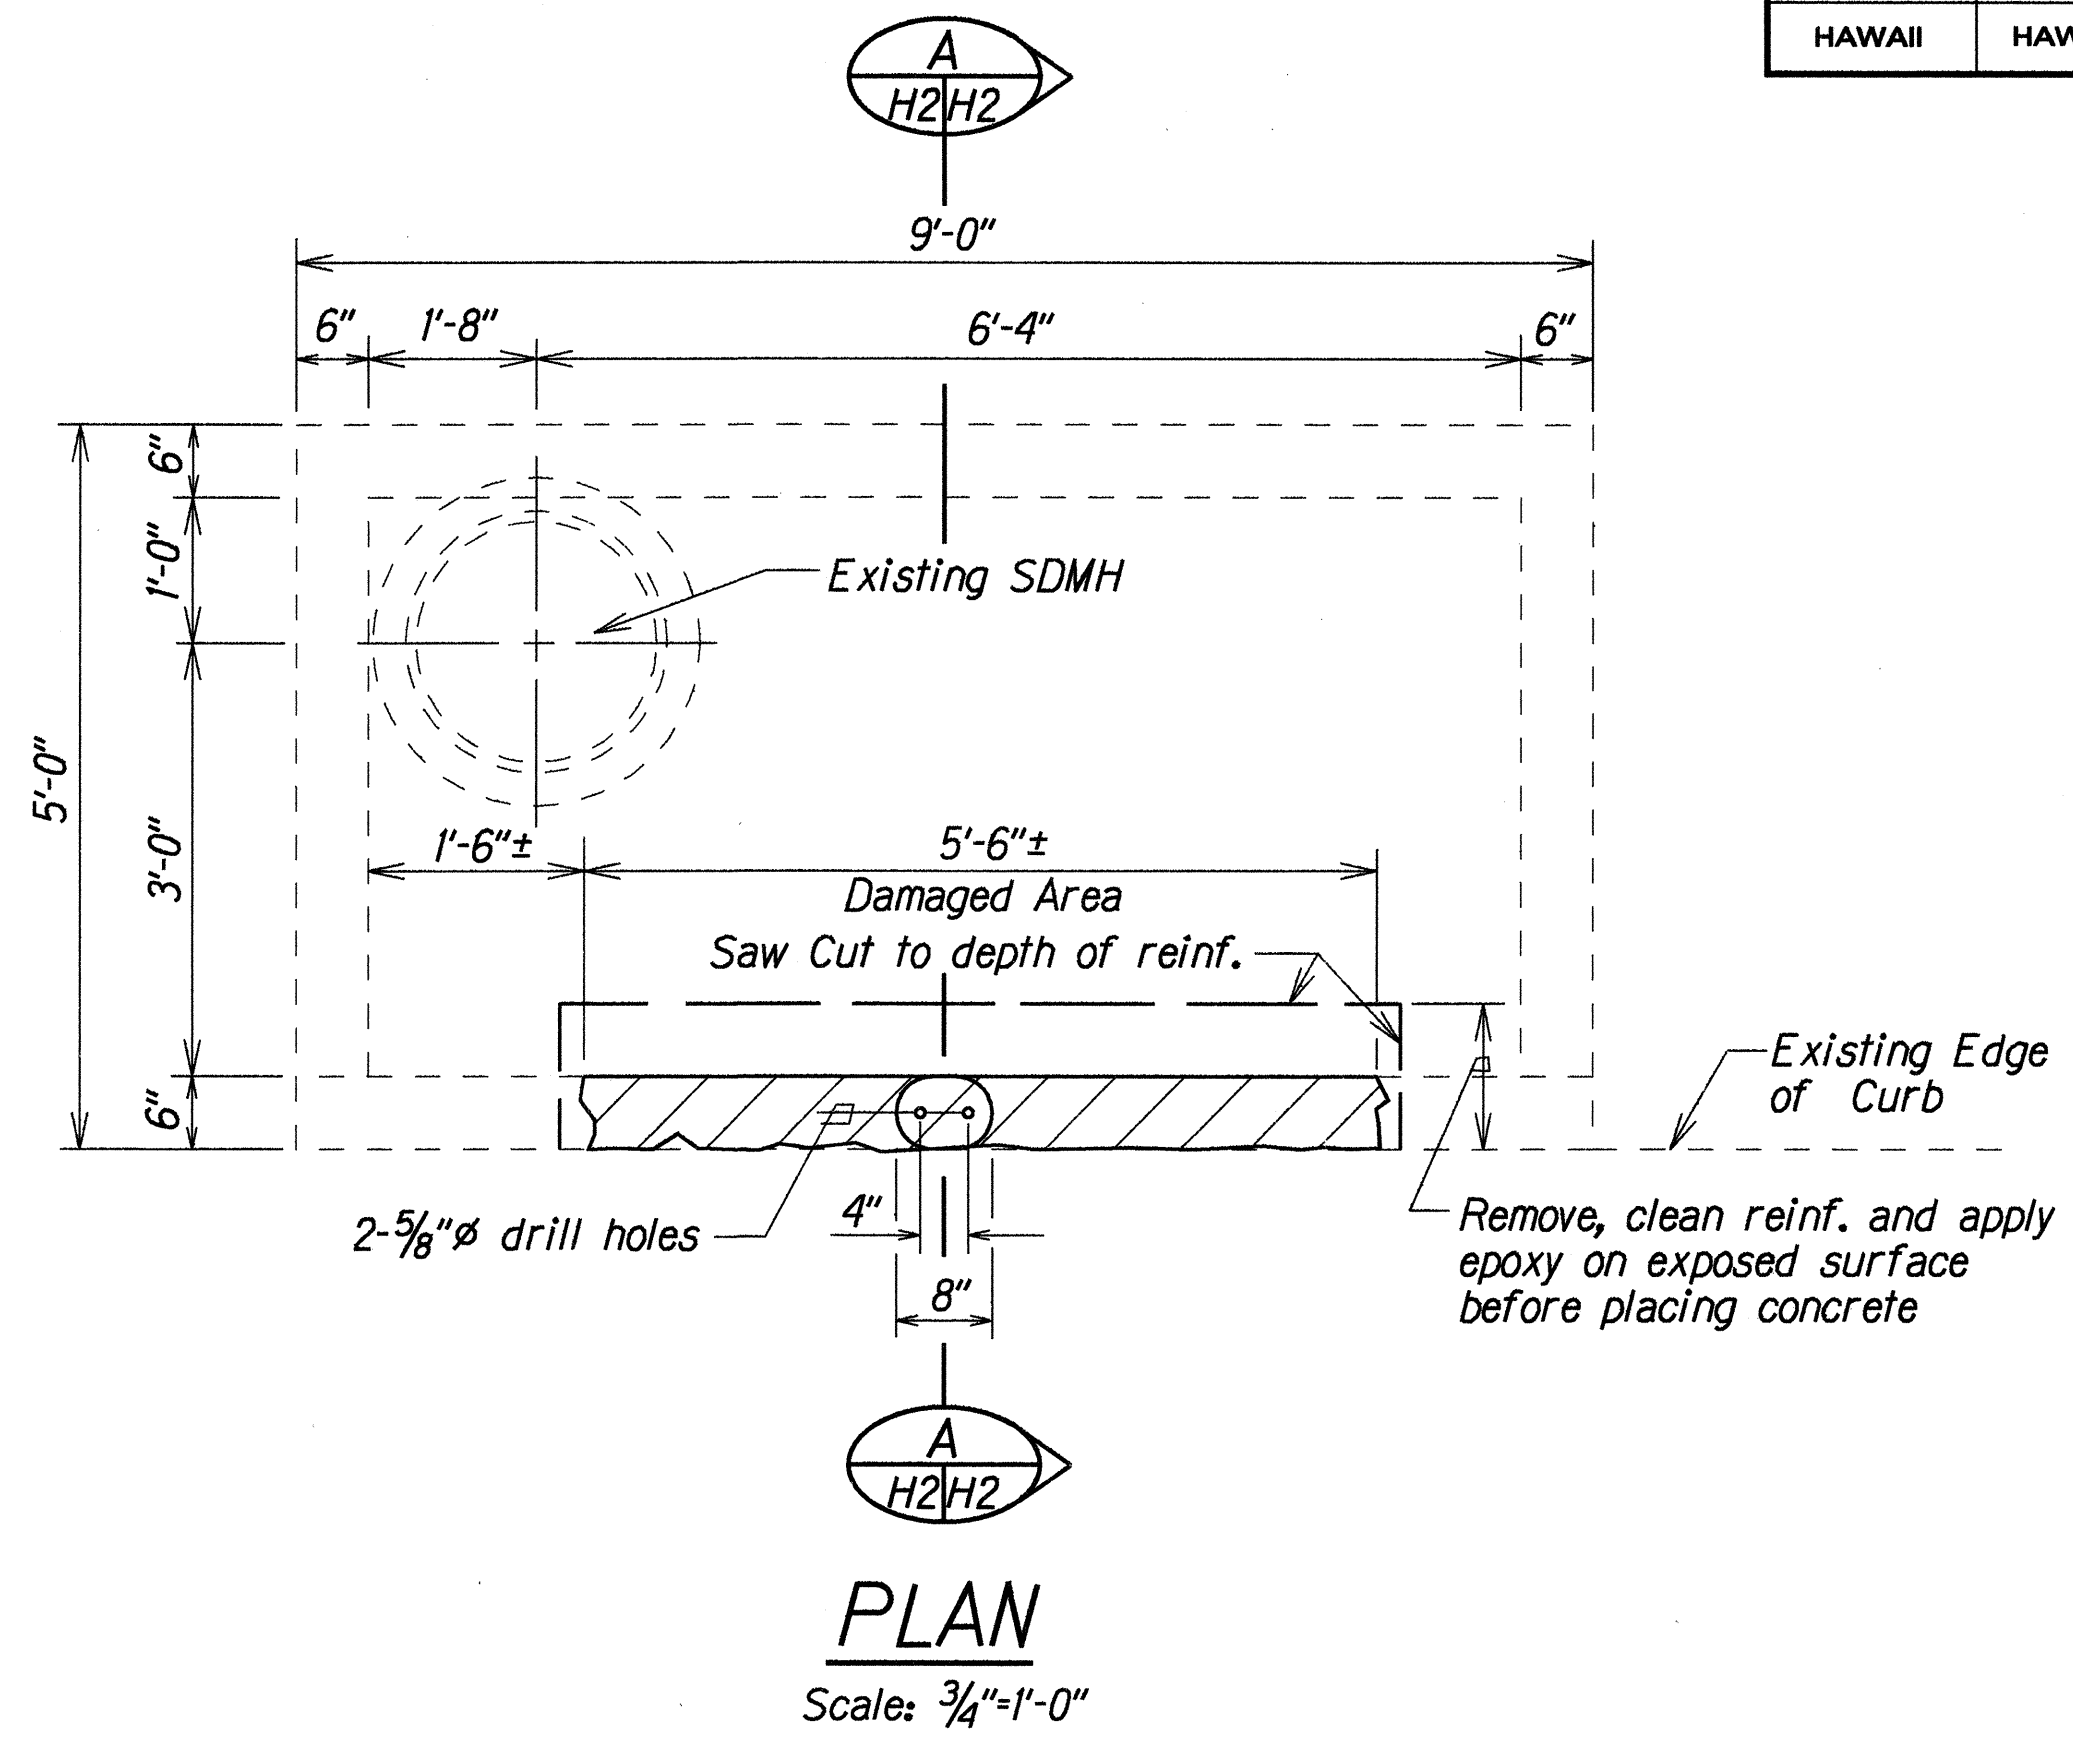

DETAILS OF REPAIRS TO EXISTING CATCH BASIN
Scale: 3/4"=1'-0"

4/15/94	Added Drainage Details
DATE	REVISION
STATE OF HAWAII DEPARTMENT OF TRANSPORTATION HIGHWAYS DIVISION	
DRAINAGE DETAILS	
LILIHA STREET RESURFACING	
North King Street to H-1 Overpass	
Fed. Aid Project No. STP-7413(1)	
Scale: As Shown	Date: Apr. 1994
SHEET No. H2 OF 2 SHEETS	