
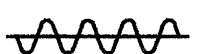
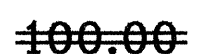


| FED. ROAD DIST. NO. | STATE | FED. AID PROJ. NO. | FISCAL YEAR | SHEET NO. | TOTAL SHEETS |
|---------------------|-------|--------------------|-------------|-----------|--------------|
| HAWAII              | HAW.  | STP-7413(1)        | 1994        | 15        | 18           |


**LEGEND FOR**  
**AS-BUILT POSTINGS**

 Squiggly line for as-built deletion  
 Double line for as-built deletion  
Roadway Text for as-built posting

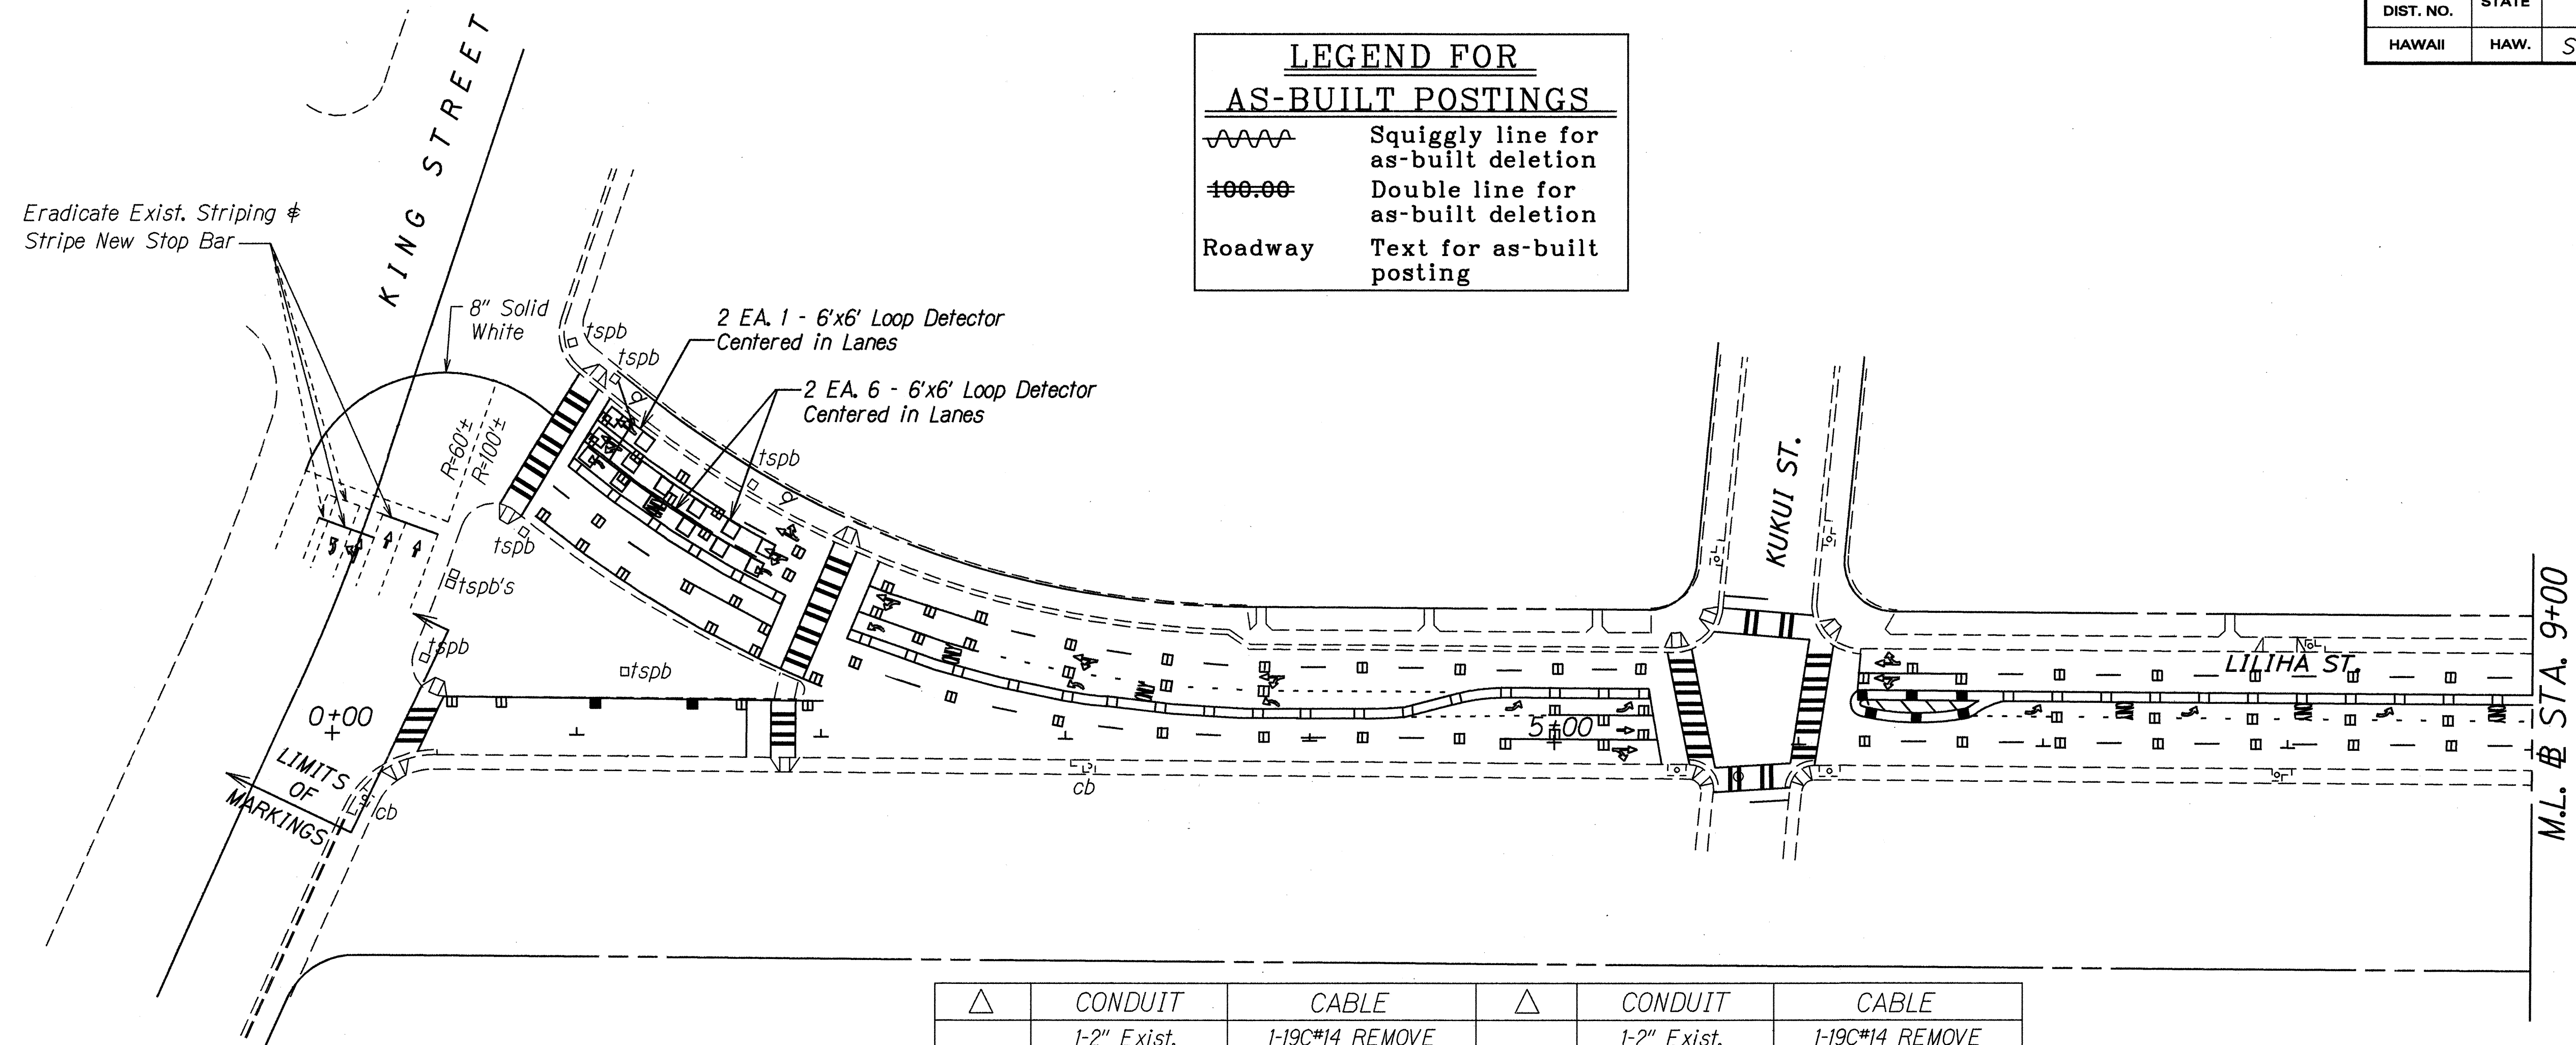

| △ | CONDUIT     | CABLE           | △ | CONDUIT     | CABLE           |
|---|-------------|-----------------|---|-------------|-----------------|
| 1 | 1-2" Exist. | 1-19C*14 REMOVE | 2 | 1-2" Exist. | 1-19C*14 REMOVE |
|   | 1-2" Exist. | 1-26C*14 NEW    |   | 1-2" Exist. | 1-26C*14 NEW    |
|   | 1-2" Exist. | 1-2C*14 NEW     |   | 1-2" Exist. | 2-2C*14 NEW     |

NOTE: 1. Remove Existing Cable and Install New Cables as noted and make all necessary connections to make the Traffic Signal System operational.  
2. Removing Existing Cables shall not be paid for separately but shall be considered incidental to the various cable items.

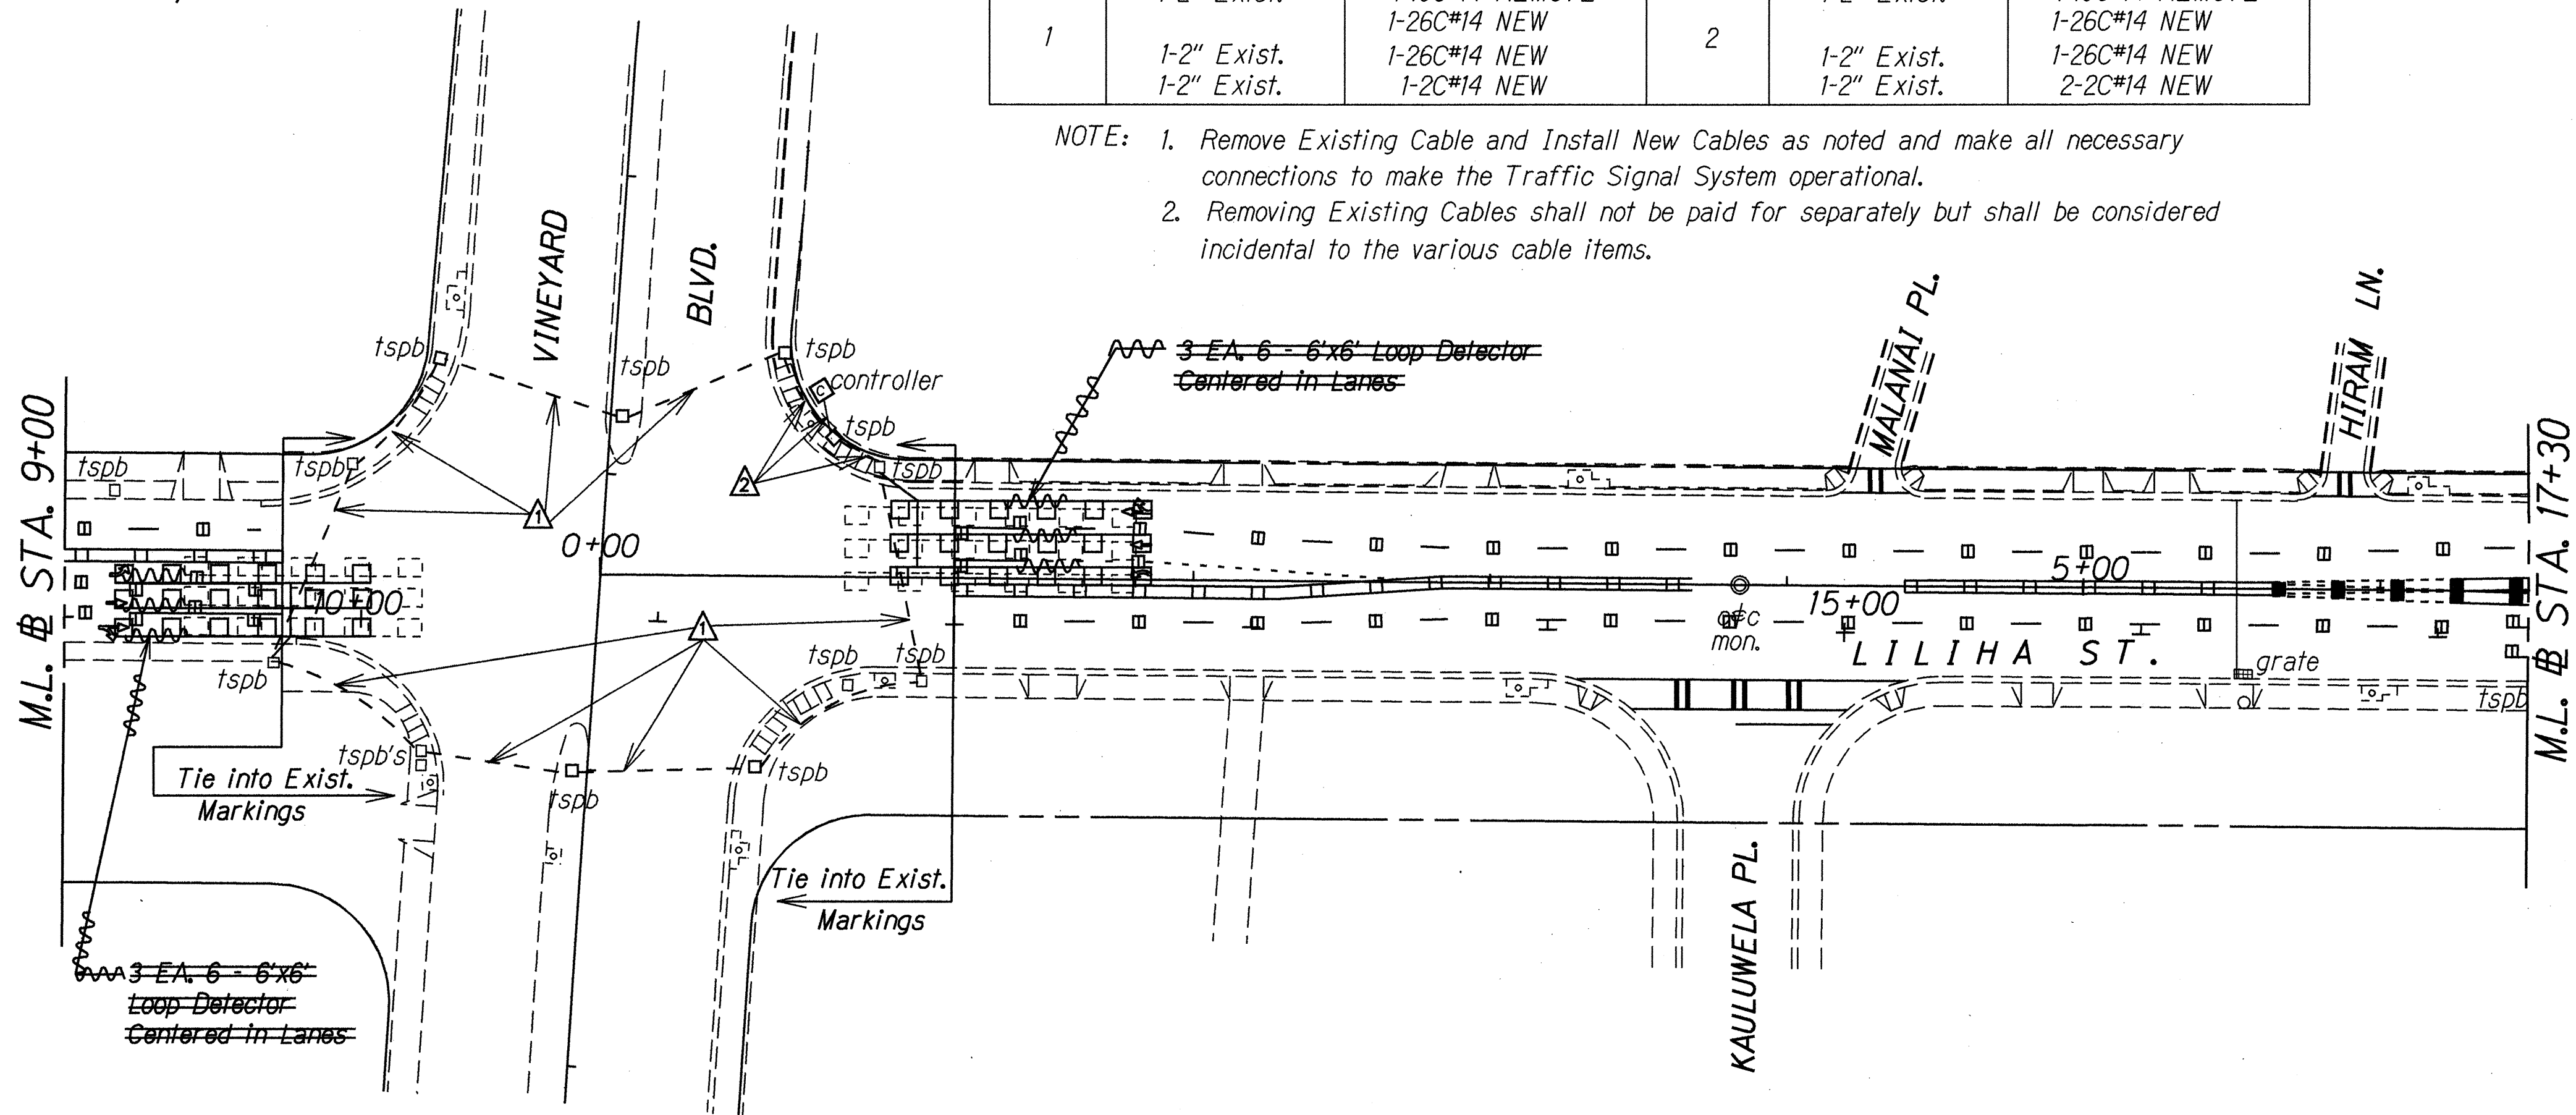

|                   |         |
|-------------------|---------|
| SURVEY PLOTTED BY | DATE    |
| PLAN              | 7/24/93 |
| DESIGNED BY       |         |
| QUANTITIES BY     |         |
| CHECKED BY        |         |

STATE OF HAWAII  
DEPARTMENT OF TRANSPORTATION  
HIGHWAYS DIVISION

**TRAFFIC SIGNAL PLANS**  
**LILIHA STREET RESURFACING**  
North King Street to H-1 Overpass  
Fed. Aid Project No. STP-7413(1)  
Scale: 1" = 40'      Date: July 1993  
SHEET No. 76 OF 9 SHEETS