



FED. ROAD DIST. NO.	STATE	FED. AID PROJ. NO.	FISCAL YEAR	SHEET NO.	TOTAL SHEETS
HAWAII	HAW.	STP-7413(1)	1994	5	18

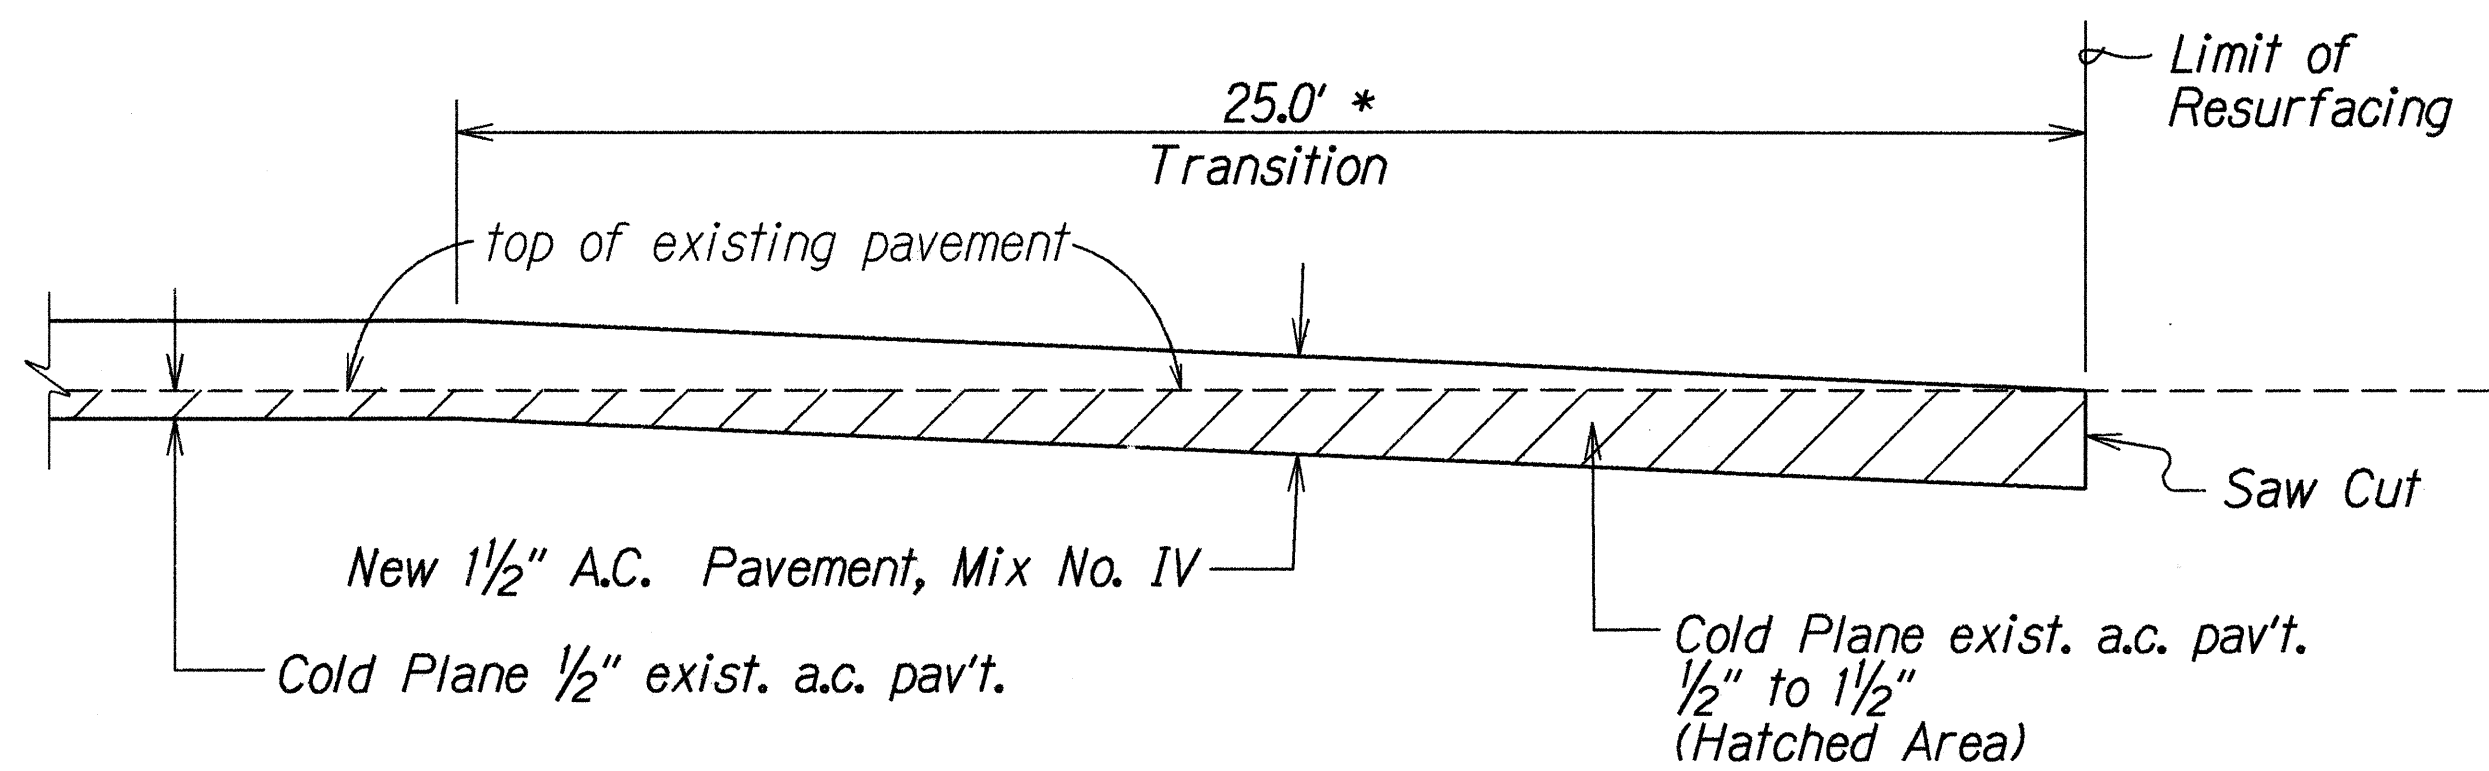


* On Malanai Place and Hiram Lane Transition shall be from e. p. to Limit of Resurfacing


COLD PLANED TRANSITION TO EXISTING A.C. PAVEMENT
Not To Scale

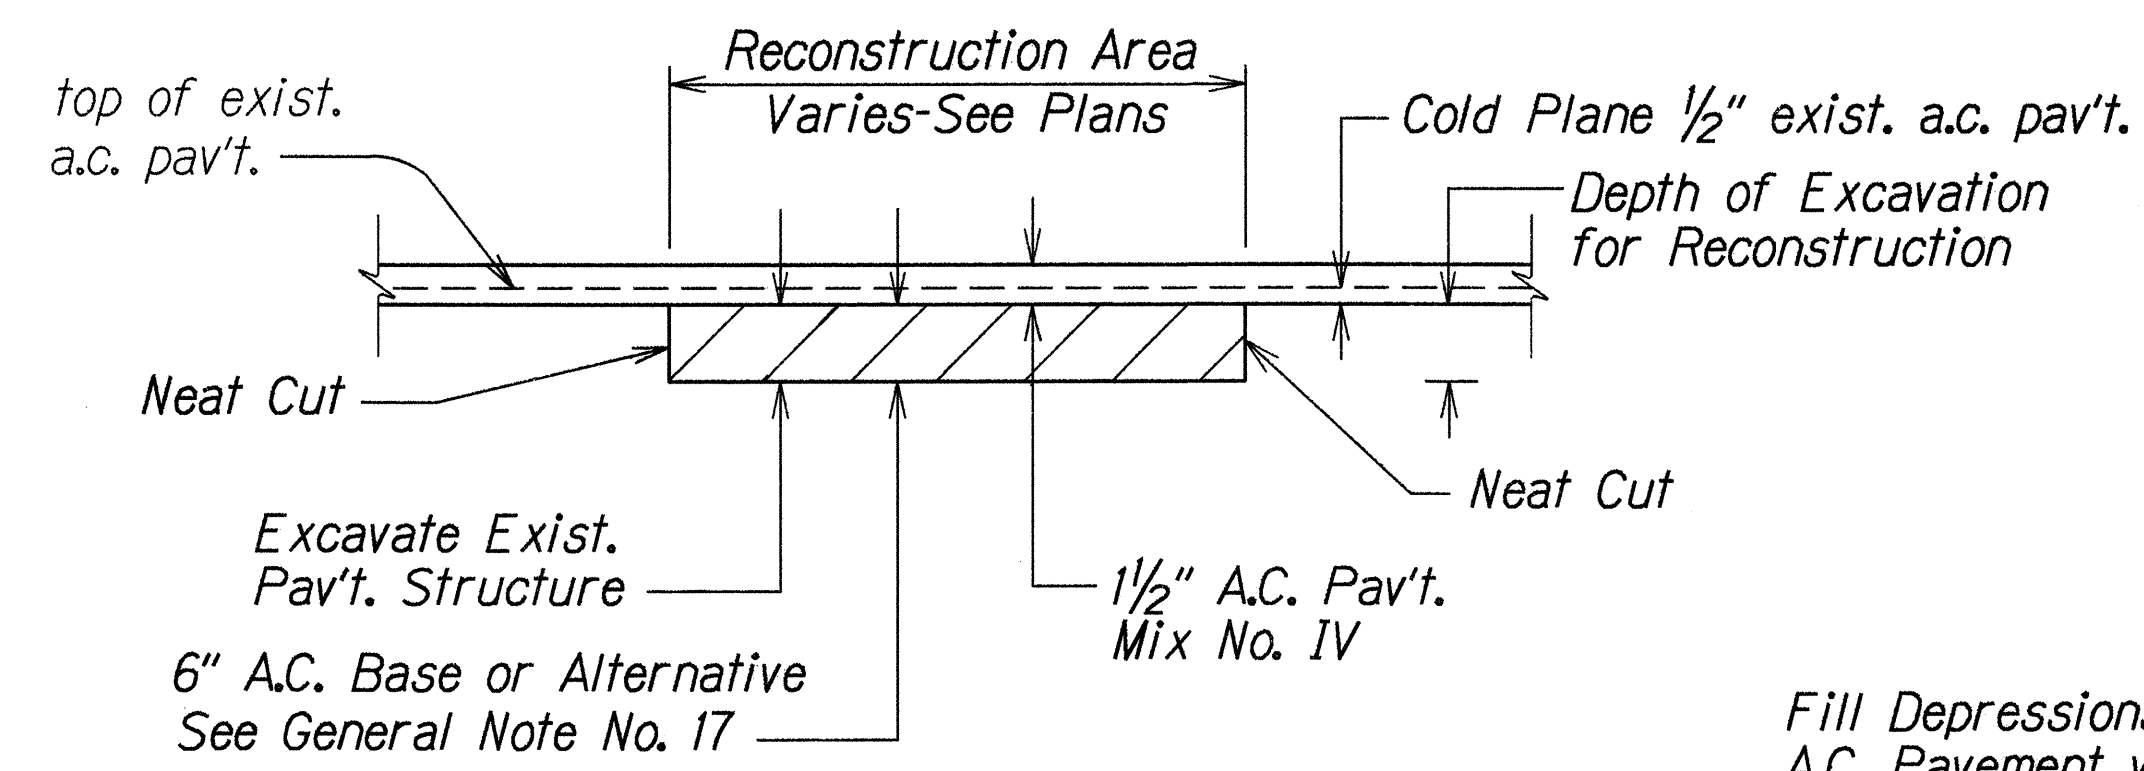


A.C. PAVEMENT RECONSTRUCTION DETAIL
± STA. 12+00± TO ± STA. 20+20±
Not To Scale

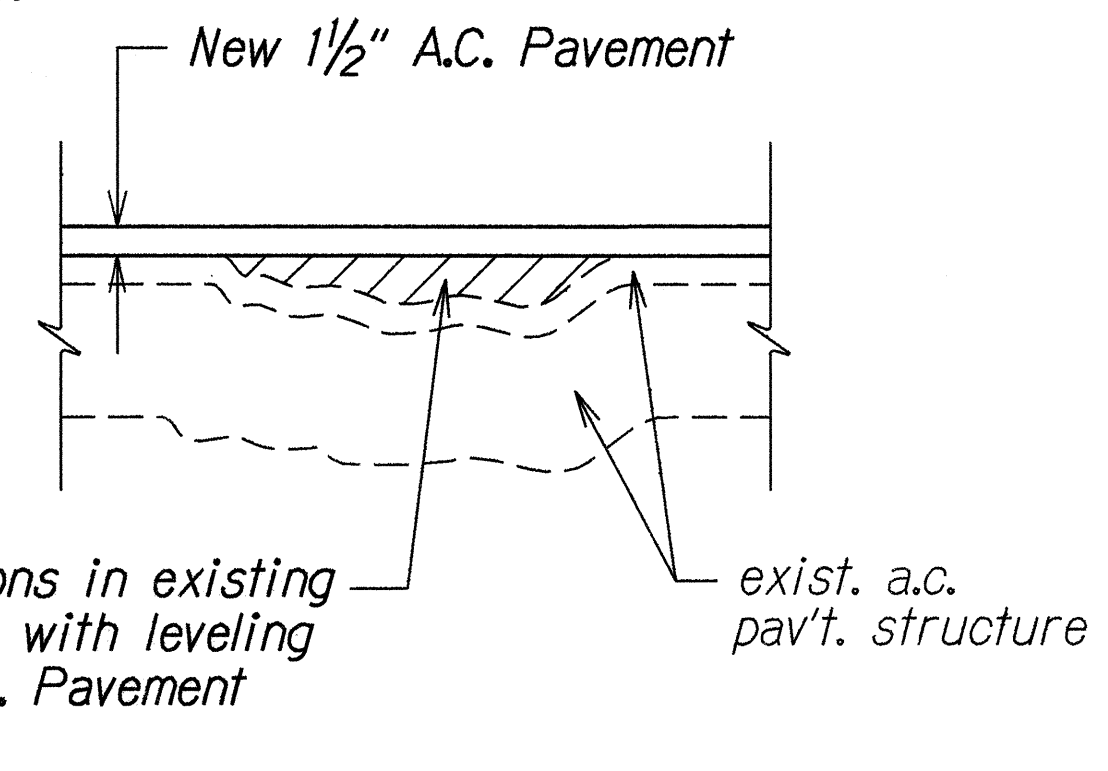


LEVELING DETAIL
Not To Scale

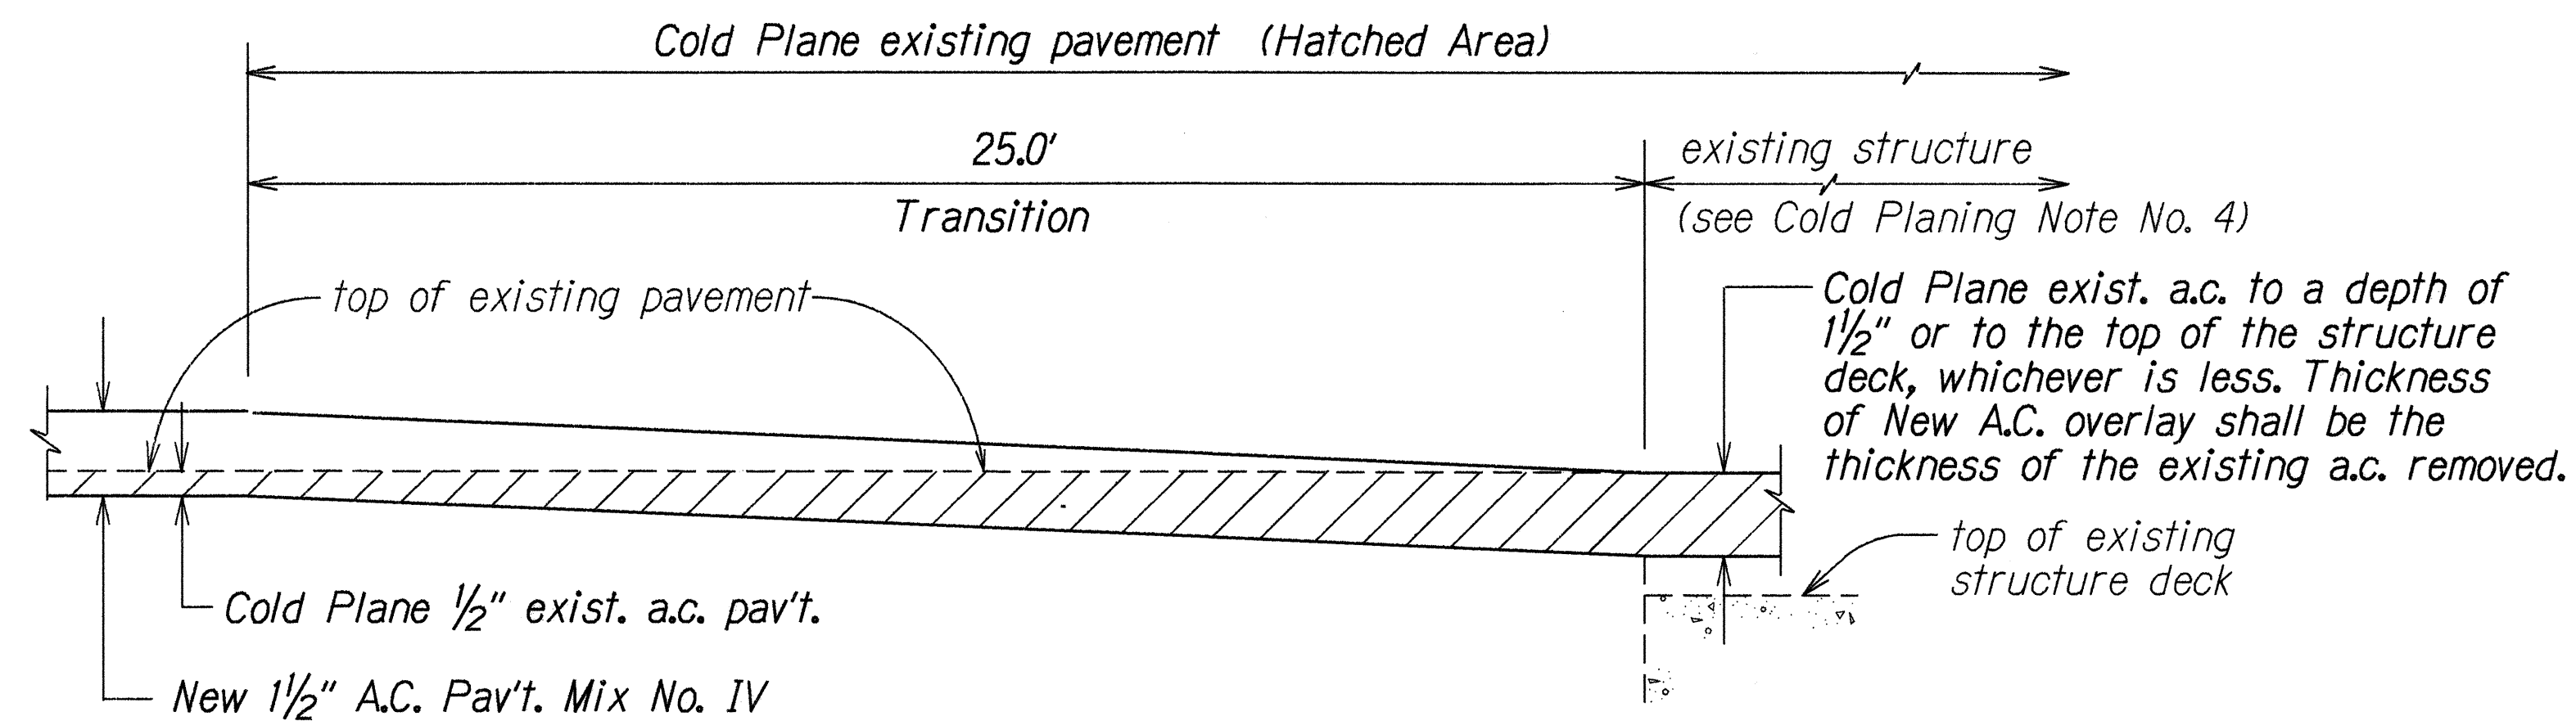


TYPICAL LONGITUDINAL SECTION AT H-1 OVERPASS STRUCTURE TO BE RESURFACED
Not To Scale

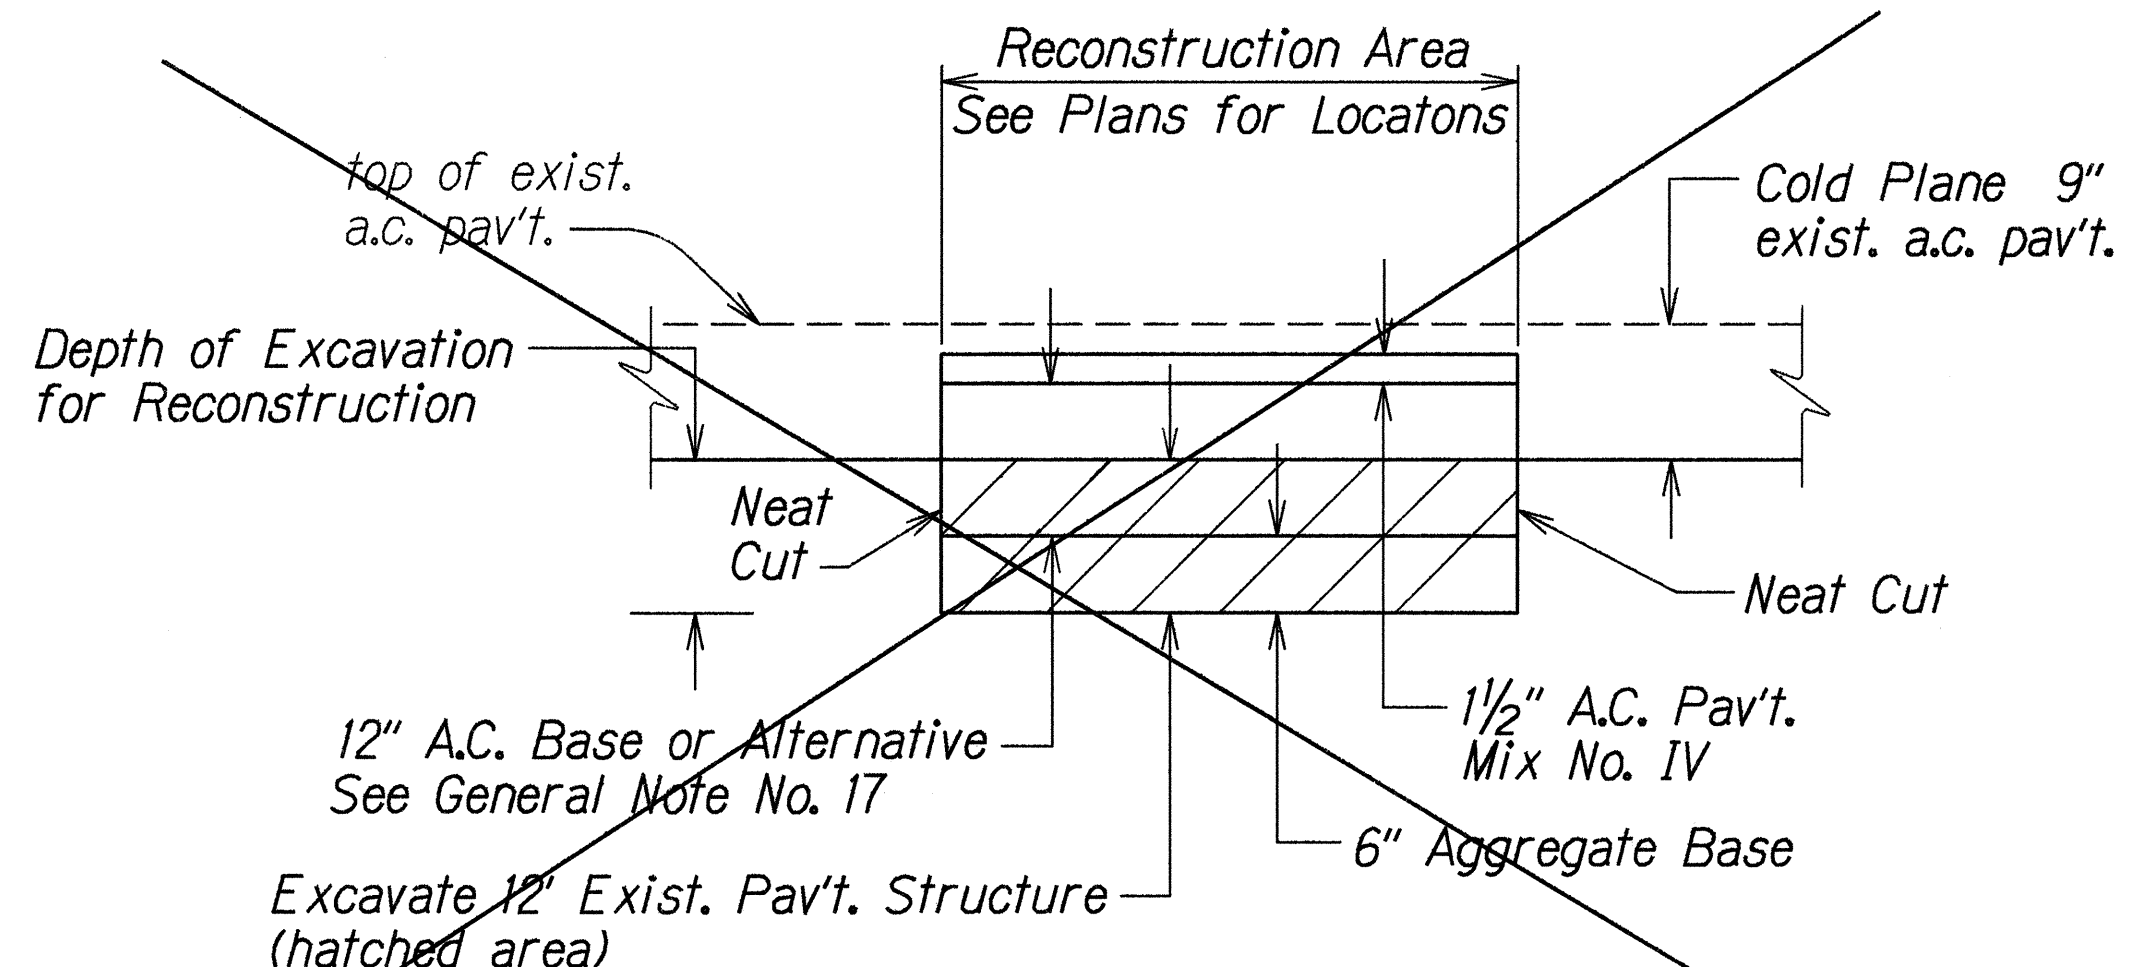

A.C. PAVEMENT RECONSTRUCTION DETAIL
± STA. 0+00± TO ± STA. 9+70±
Not To Scale

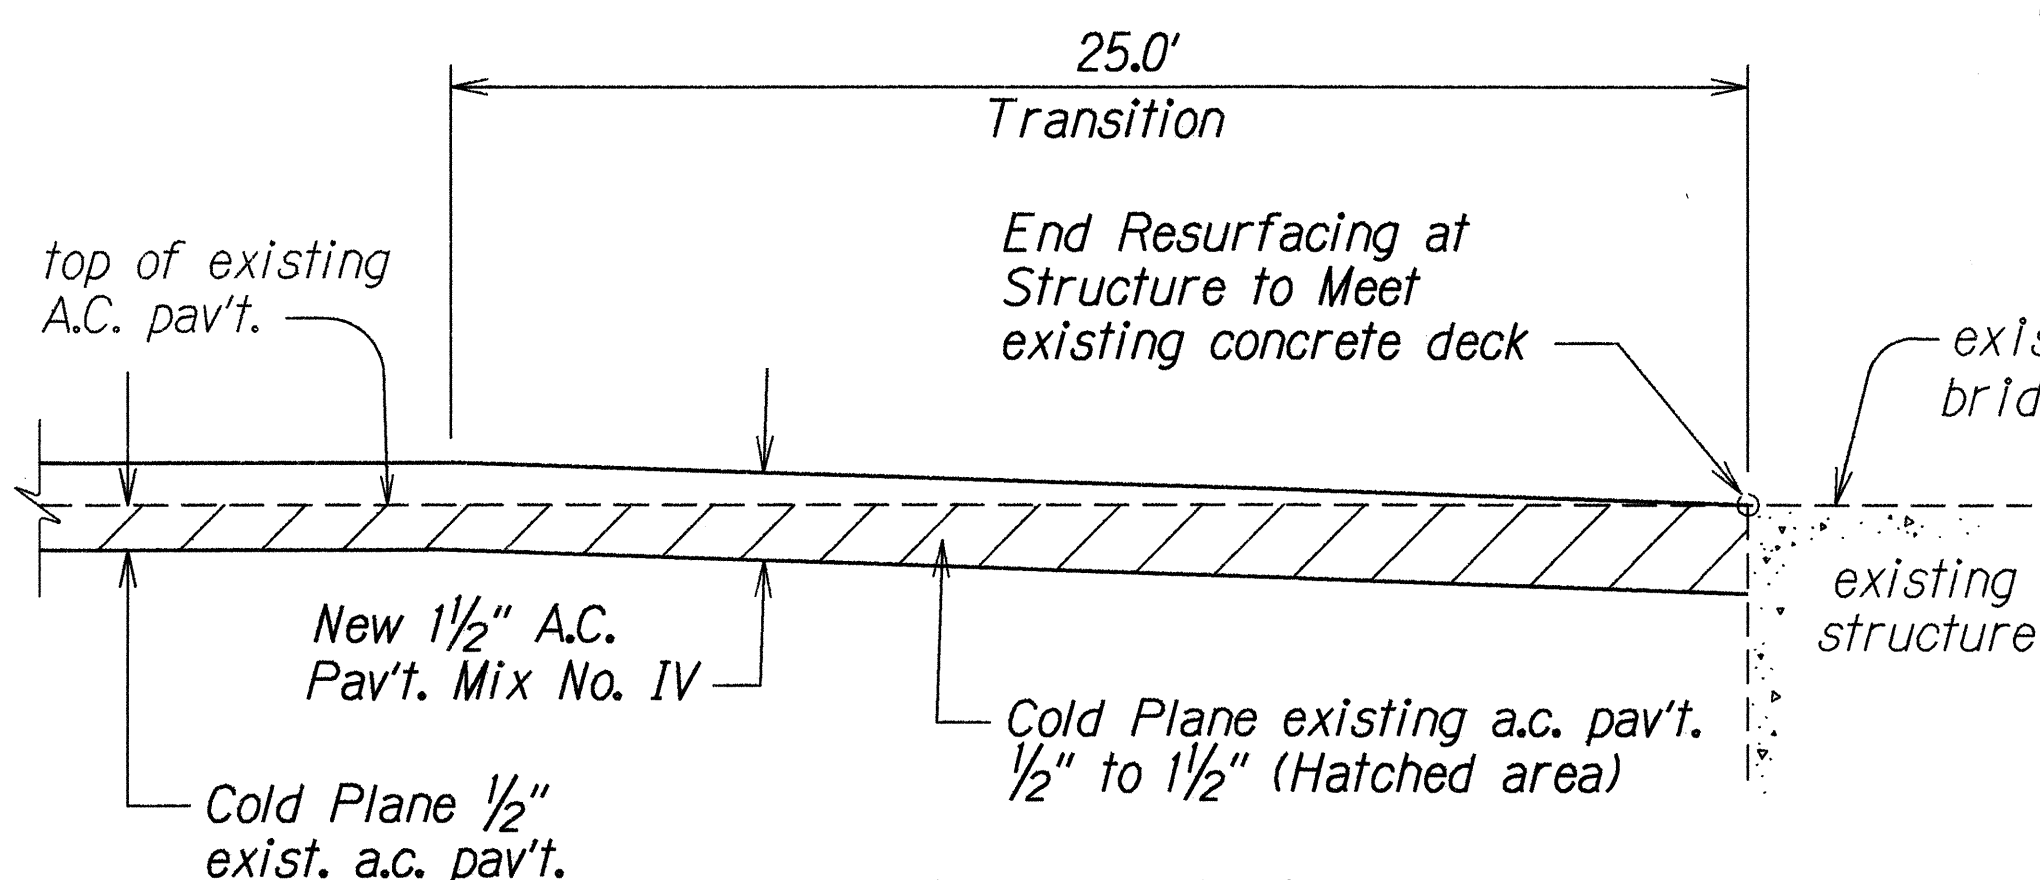

TRANSITION AT LILIHA ACCESS ROAD STRUCTURE
Not To Scale

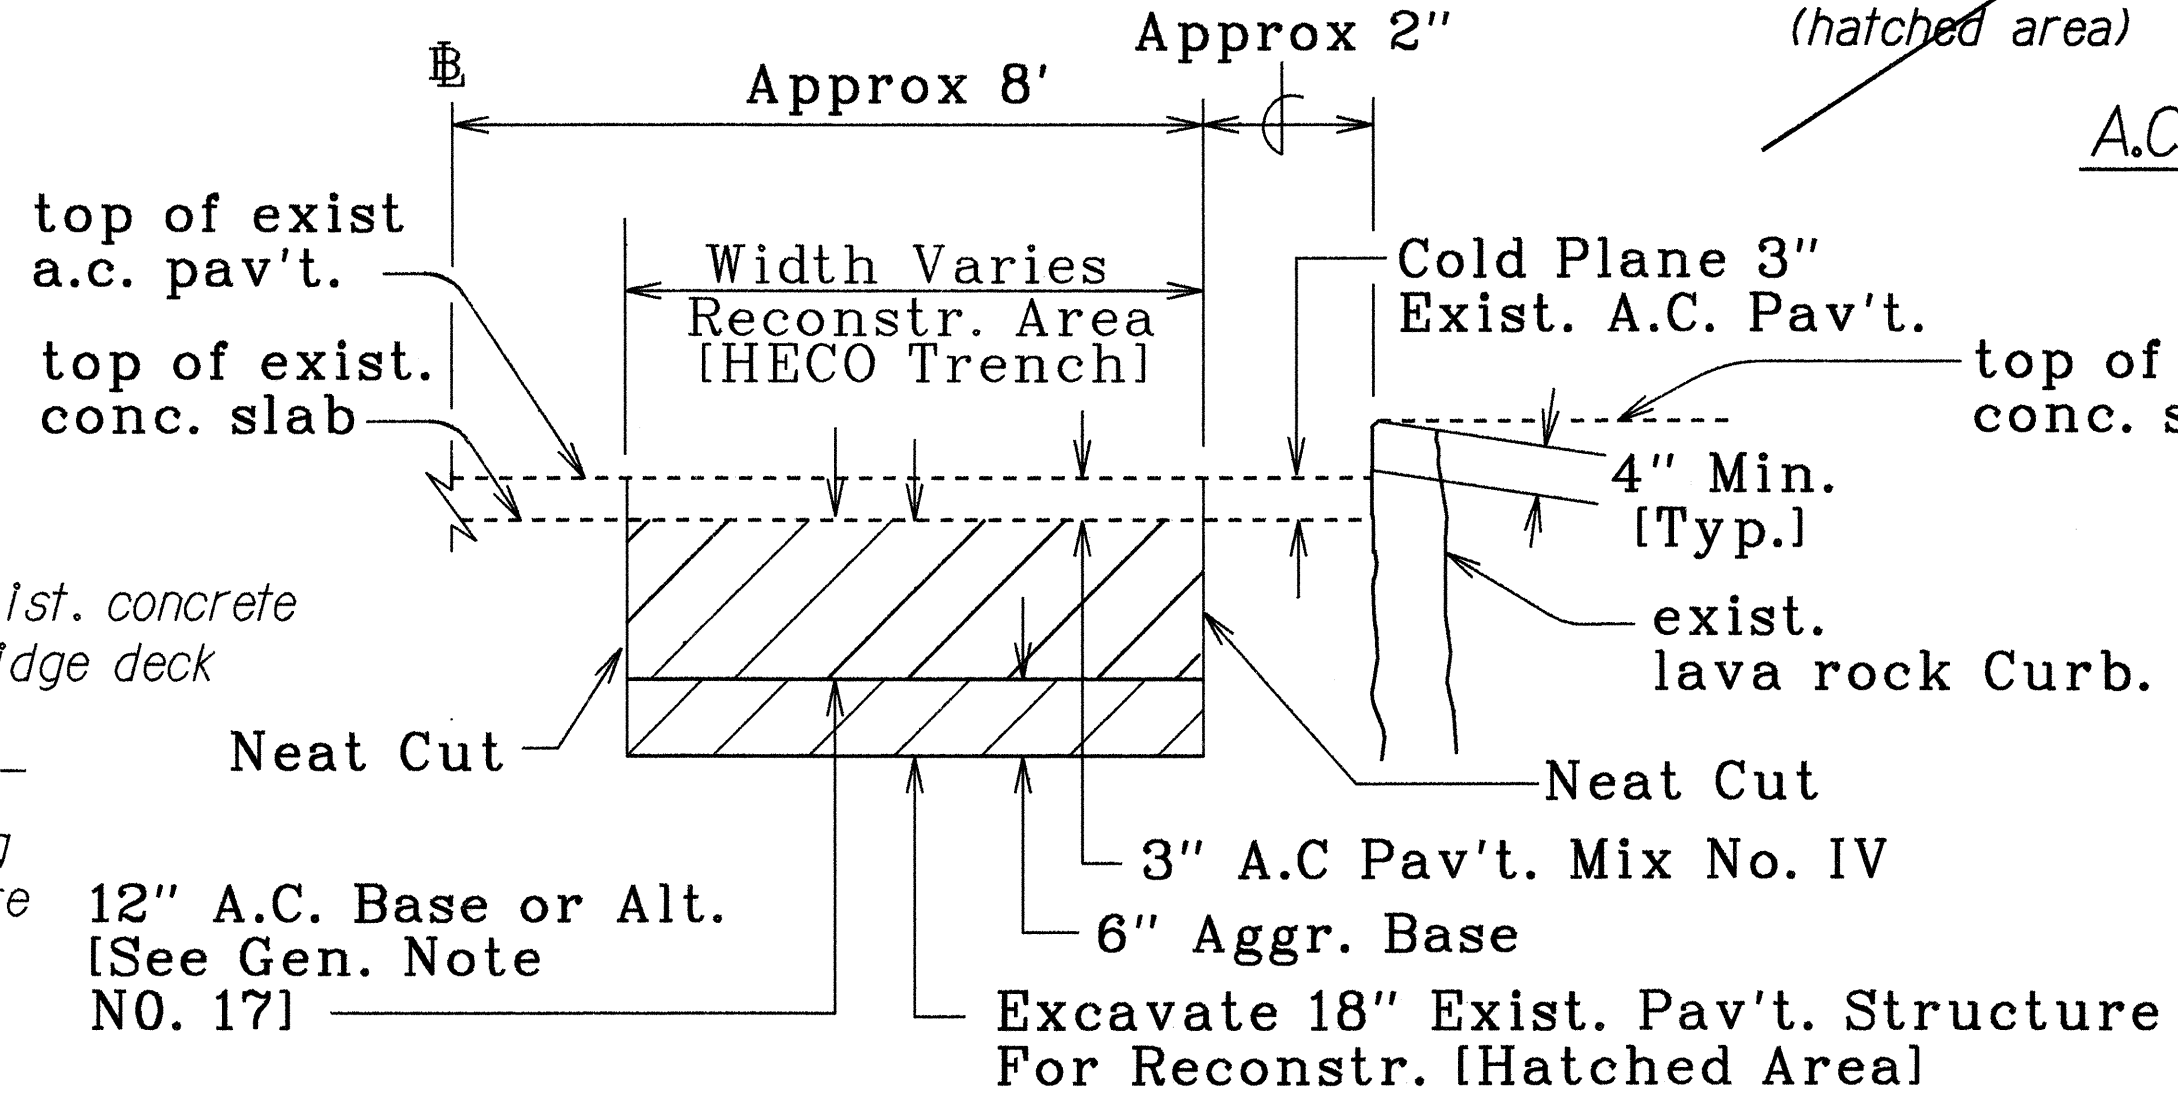

A.C. PAVEMENT RECONSTRUCTION DETAIL [HECO TRENCH]
± STA. 2+30± to ± STA. 9+70± RT. LN.
Not to Scale

LEGEND FOR AS-BUILT POSTINGS

	Squiggly line for as-built deletion
	Double line for as-built deletion
Roadway	Text for as-built posting

STATE OF HAWAII
DEPARTMENT OF TRANSPORTATION
HIGHWAYS DIVISION

MISC. DETAILS


LILIHA STREET RESURFACING
North King Street to H-1 Overpass
Fed. Aid Project No. STP-7413(1)

Scale: As Noted Date: Sept., 1993


SHEET No. 1 OF 2 SHEETS

SURVEY PLANNED BY	DATE
DESIGNED BY	
TRACED BY	
NOTED BY	
CHECKED BY	
IN CHARGE	


FED. ROAD DIST. NO.	STATE	FED. AID PROJ. NO.	FISCAL YEAR	SHEET NO.	TOTAL SHEETS
HAWAII	HAW.	STP-7413(1)	1994	6	18

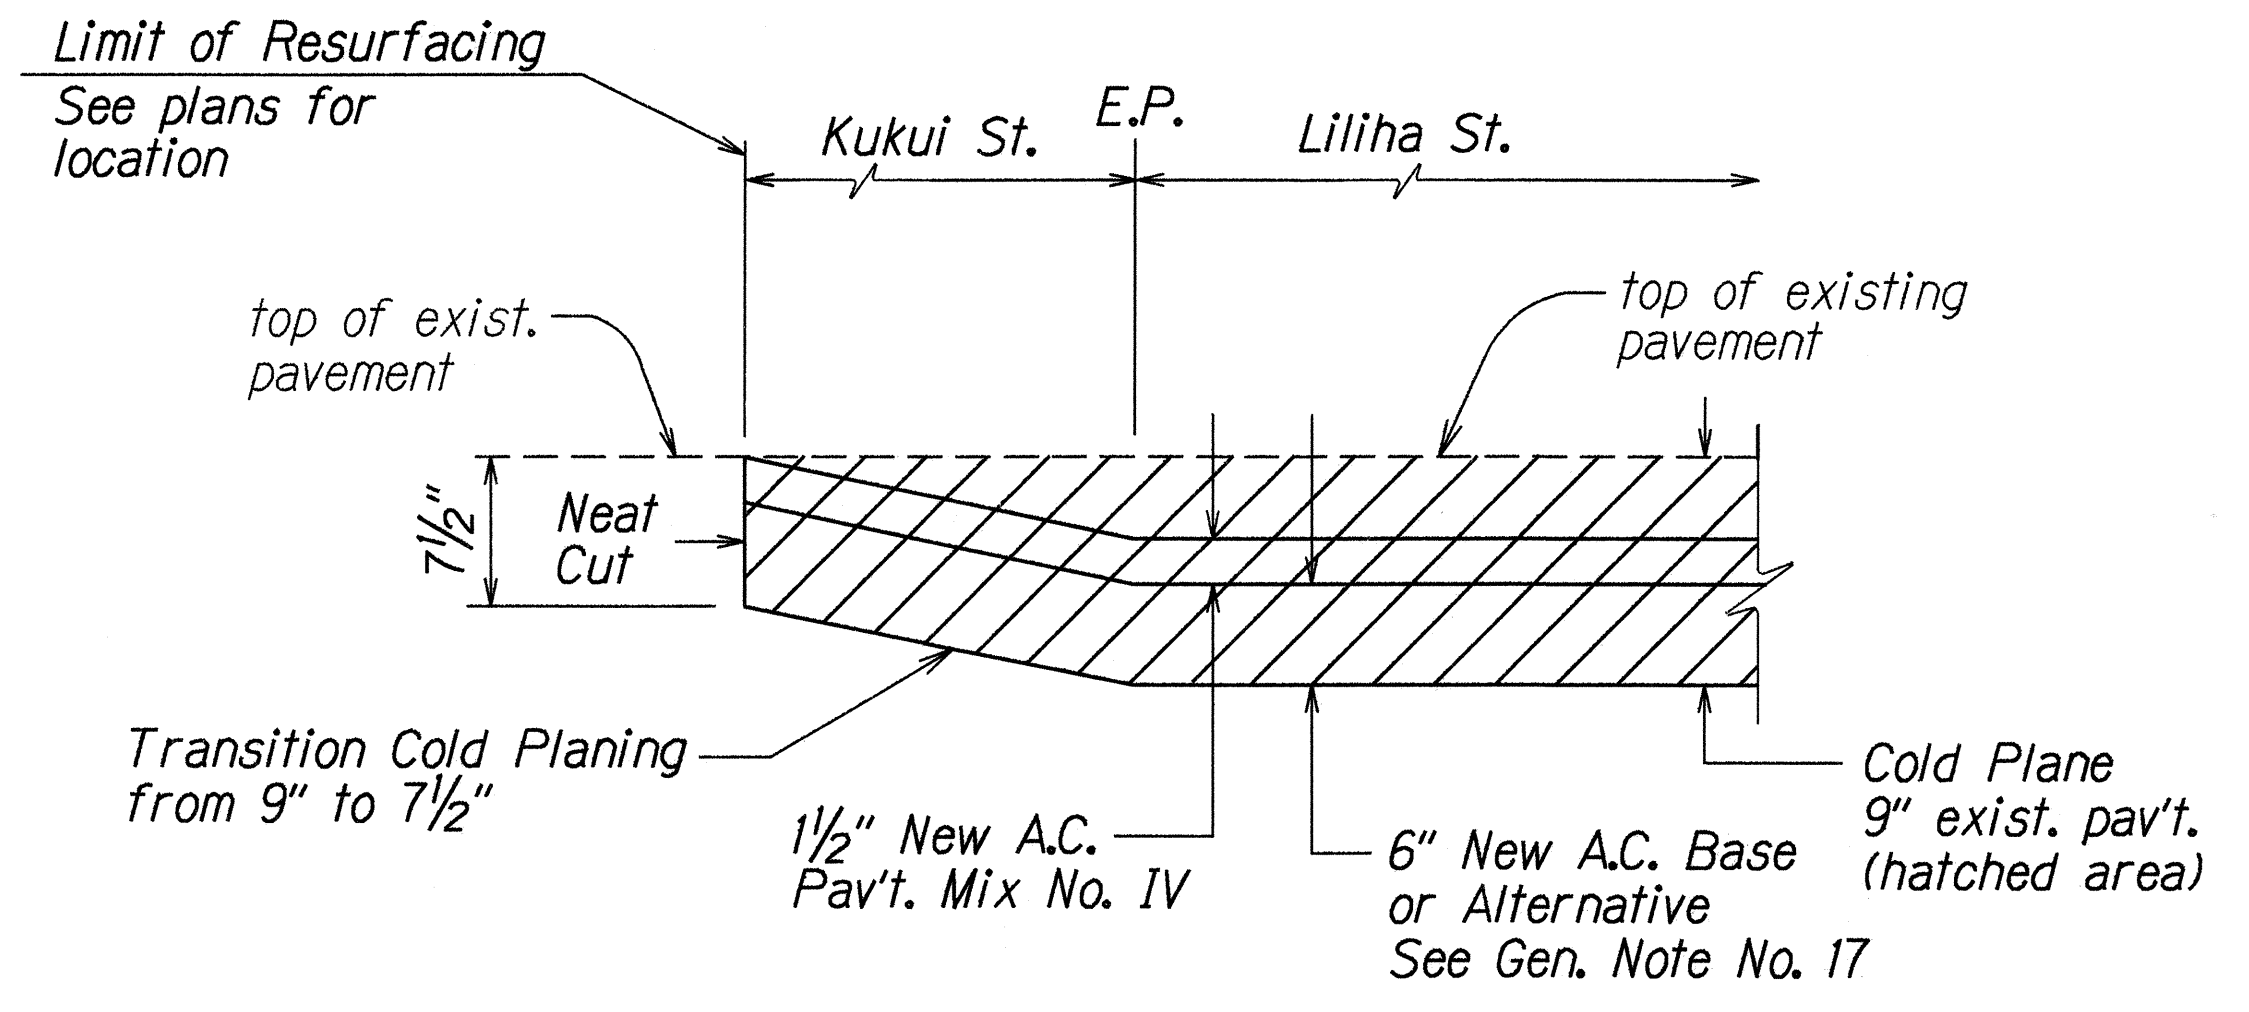


TRANSITION DETAIL AT KUKUI STREET
Not to Scale

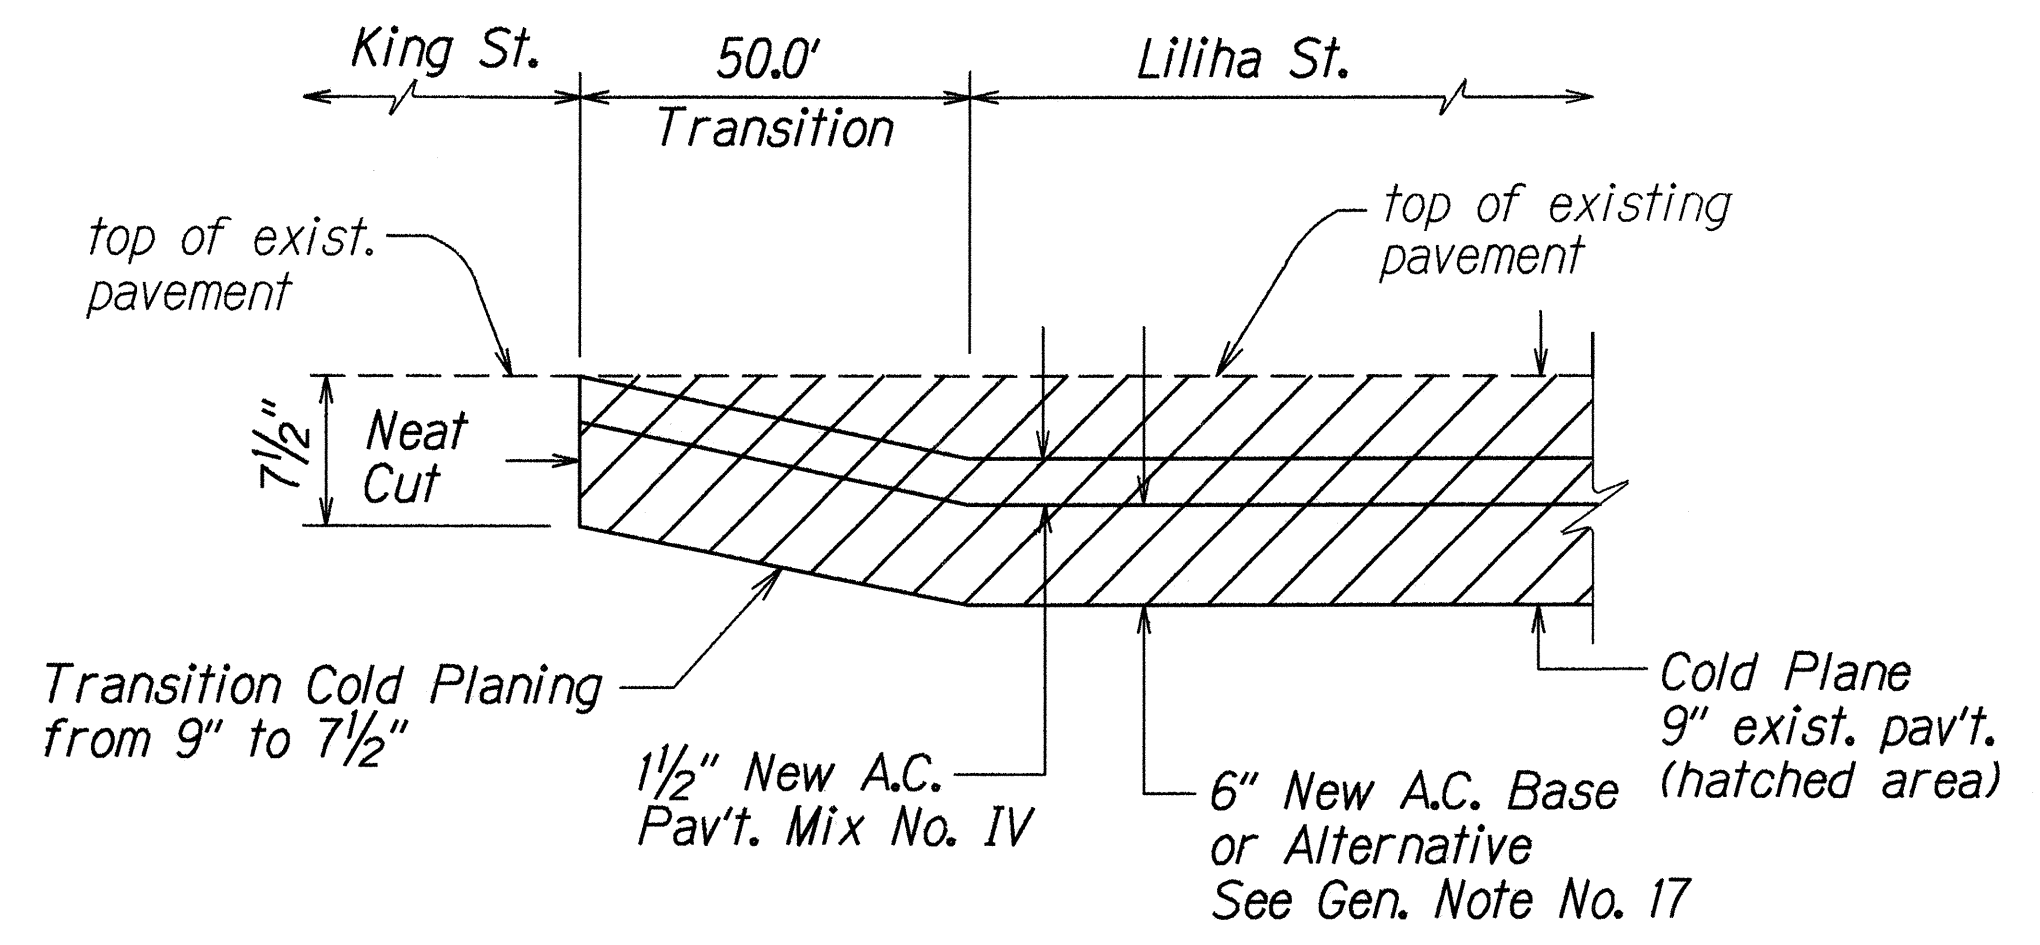


TRANSITION DETAIL AT KING STREET
Not To Scale

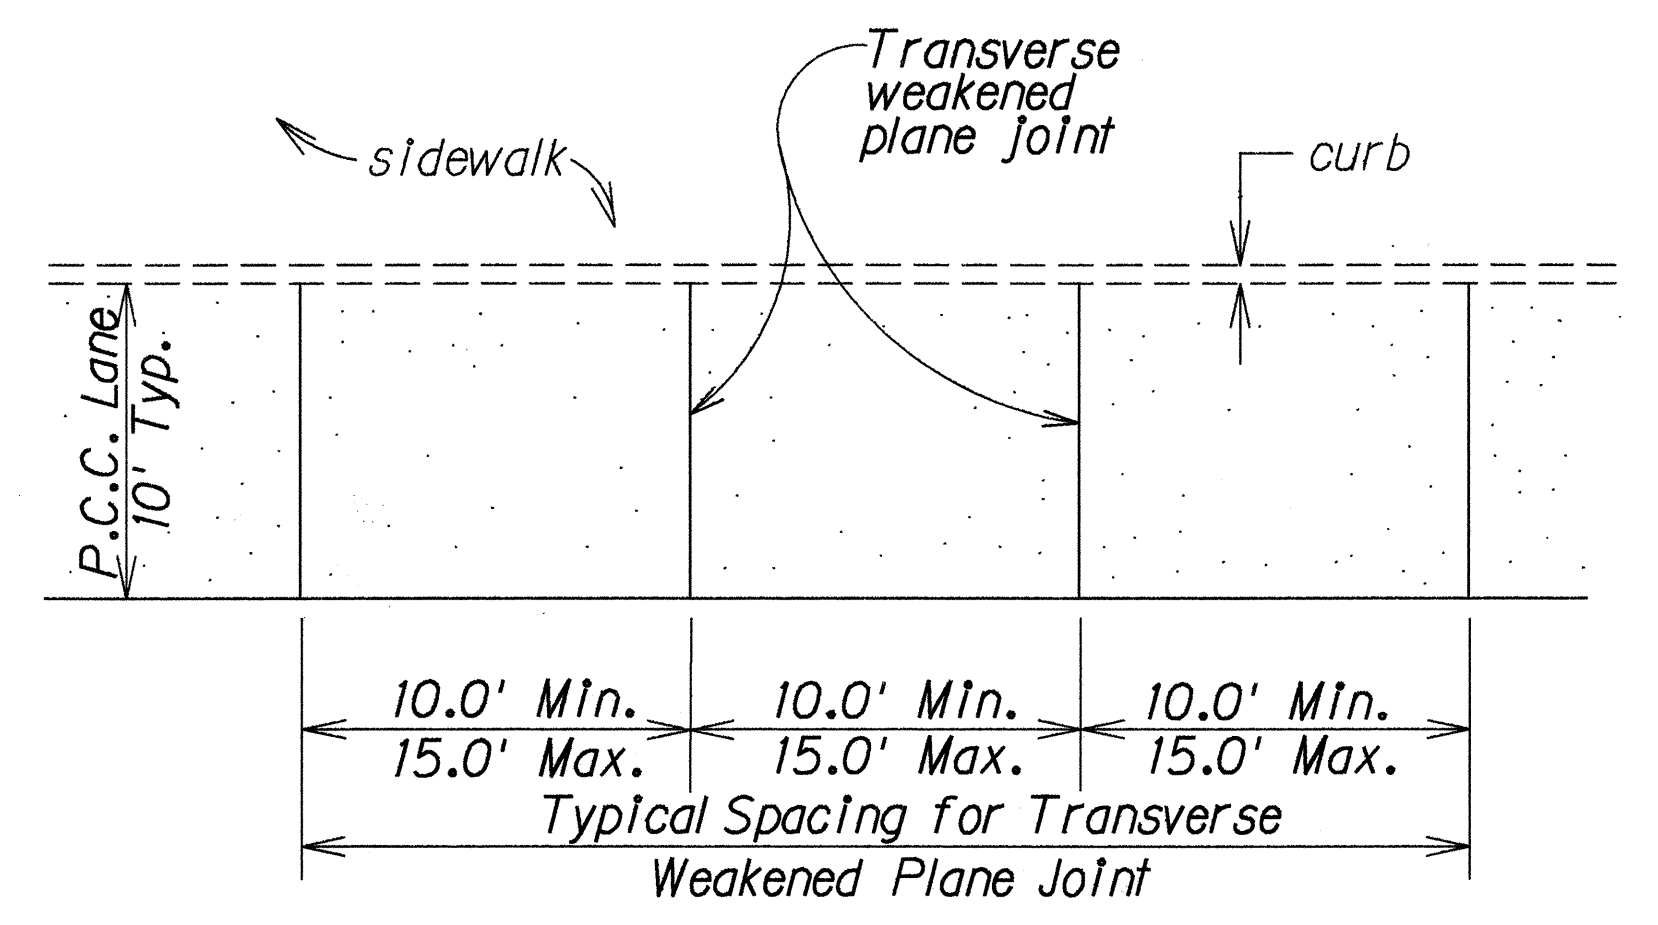


TYPICAL JOINT LOCATION AND LAYOUT
PLAN FOR P.C.C. BUS STOP
Not To Scale

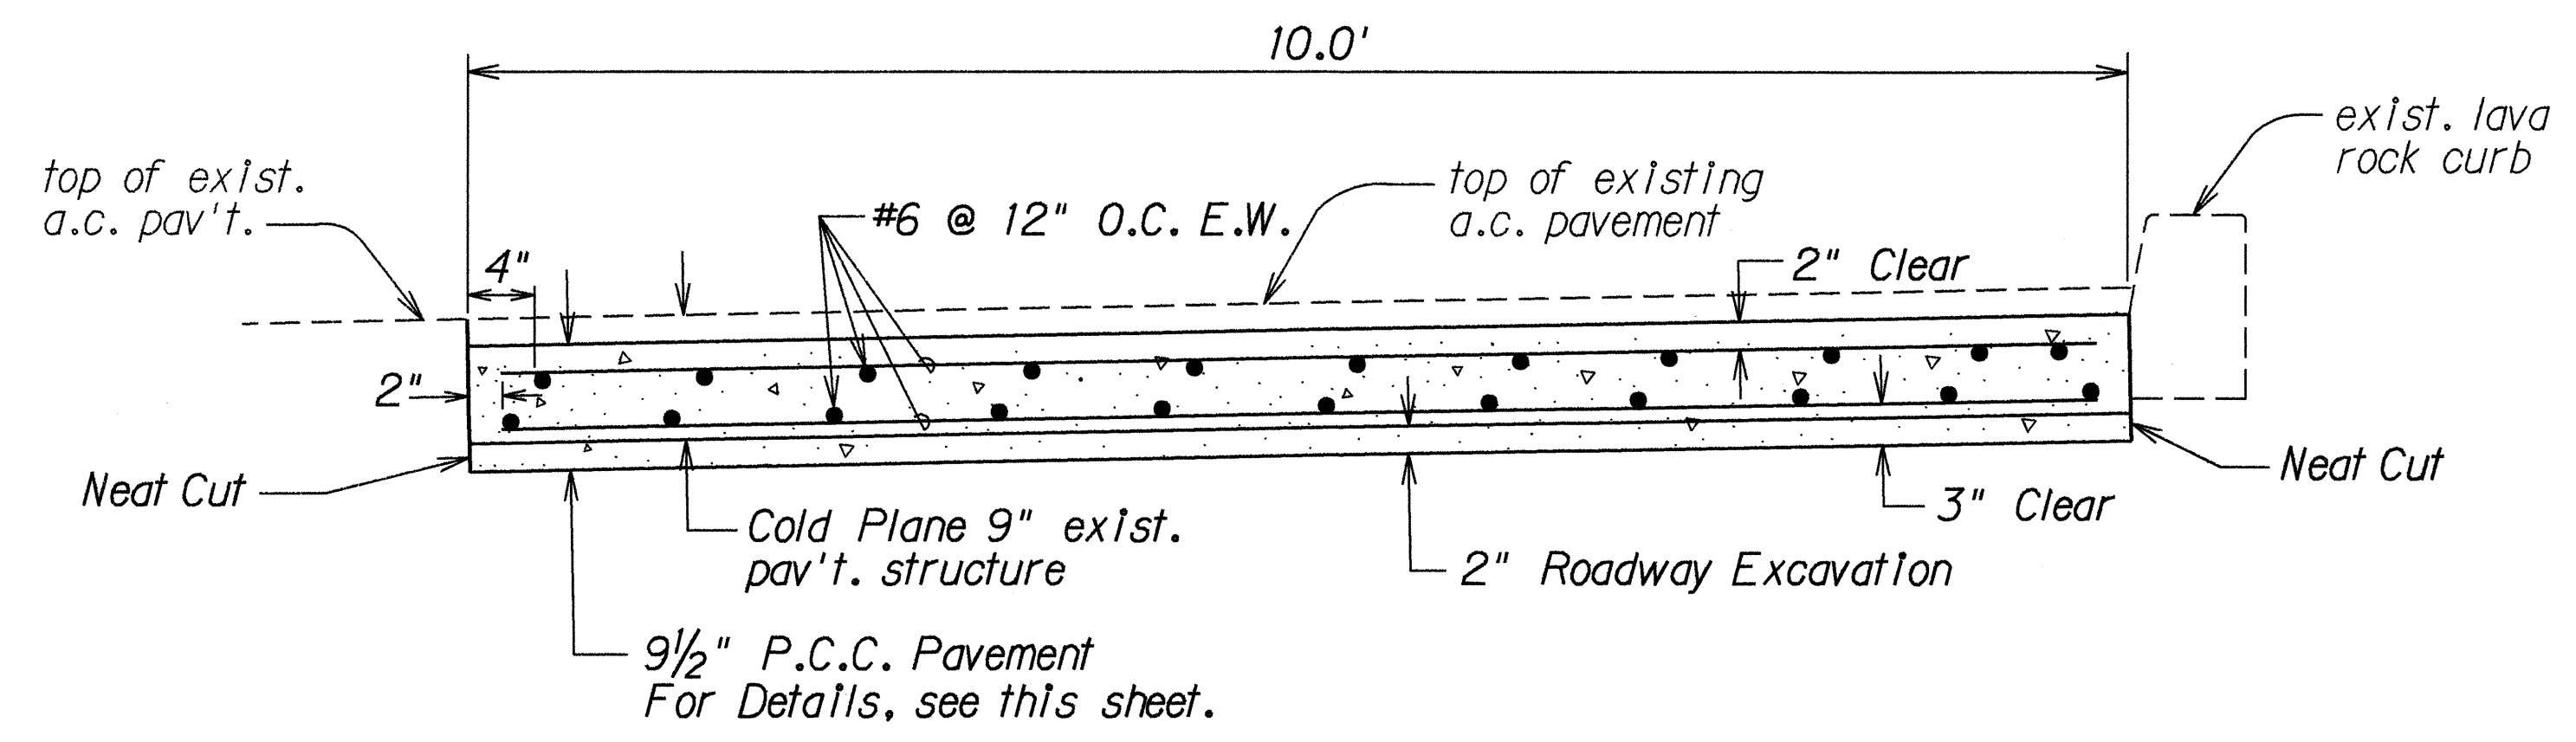


P.C.C. BUS STOP PAVEMENT DETAIL
Not to Scale

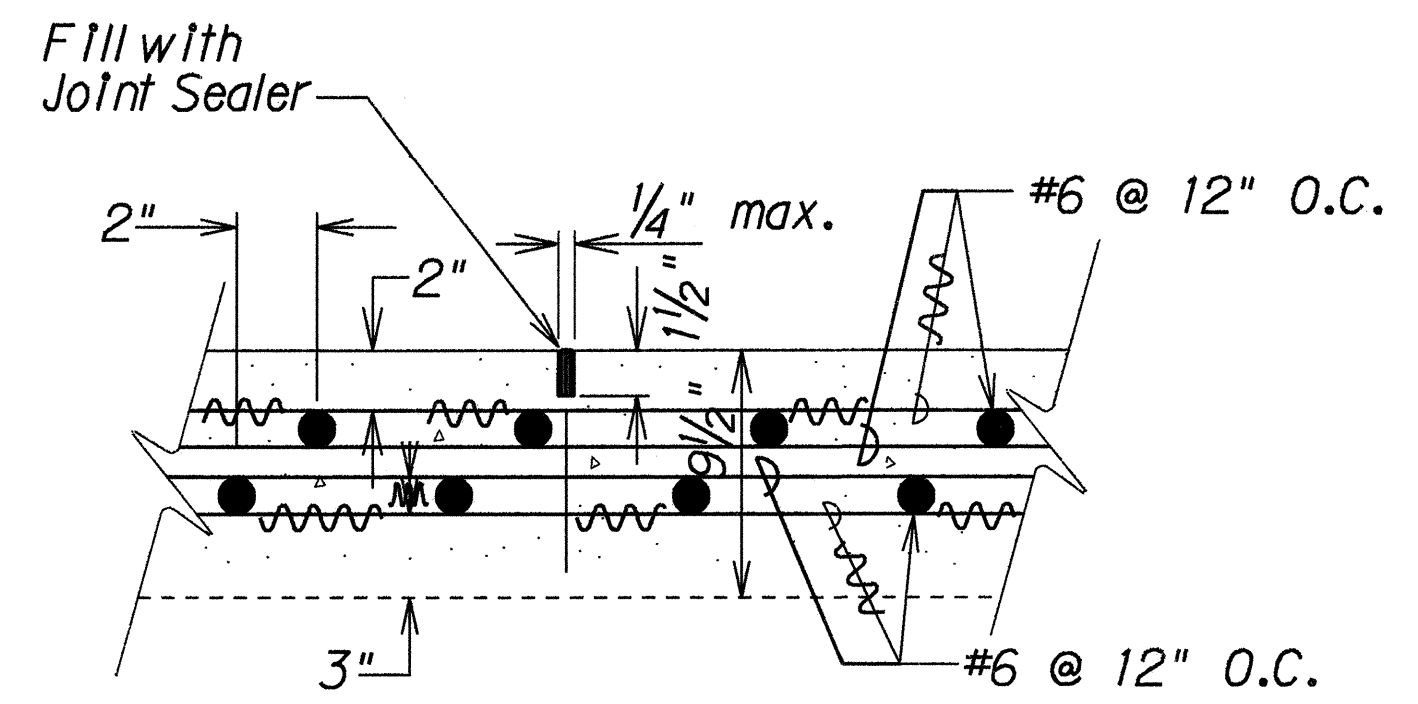

TRANSVERSE WEAKENED PLANE JOINT
FOR P.C.C. BUS STOP
(SAWED CONTRACTION)
Not To Scale

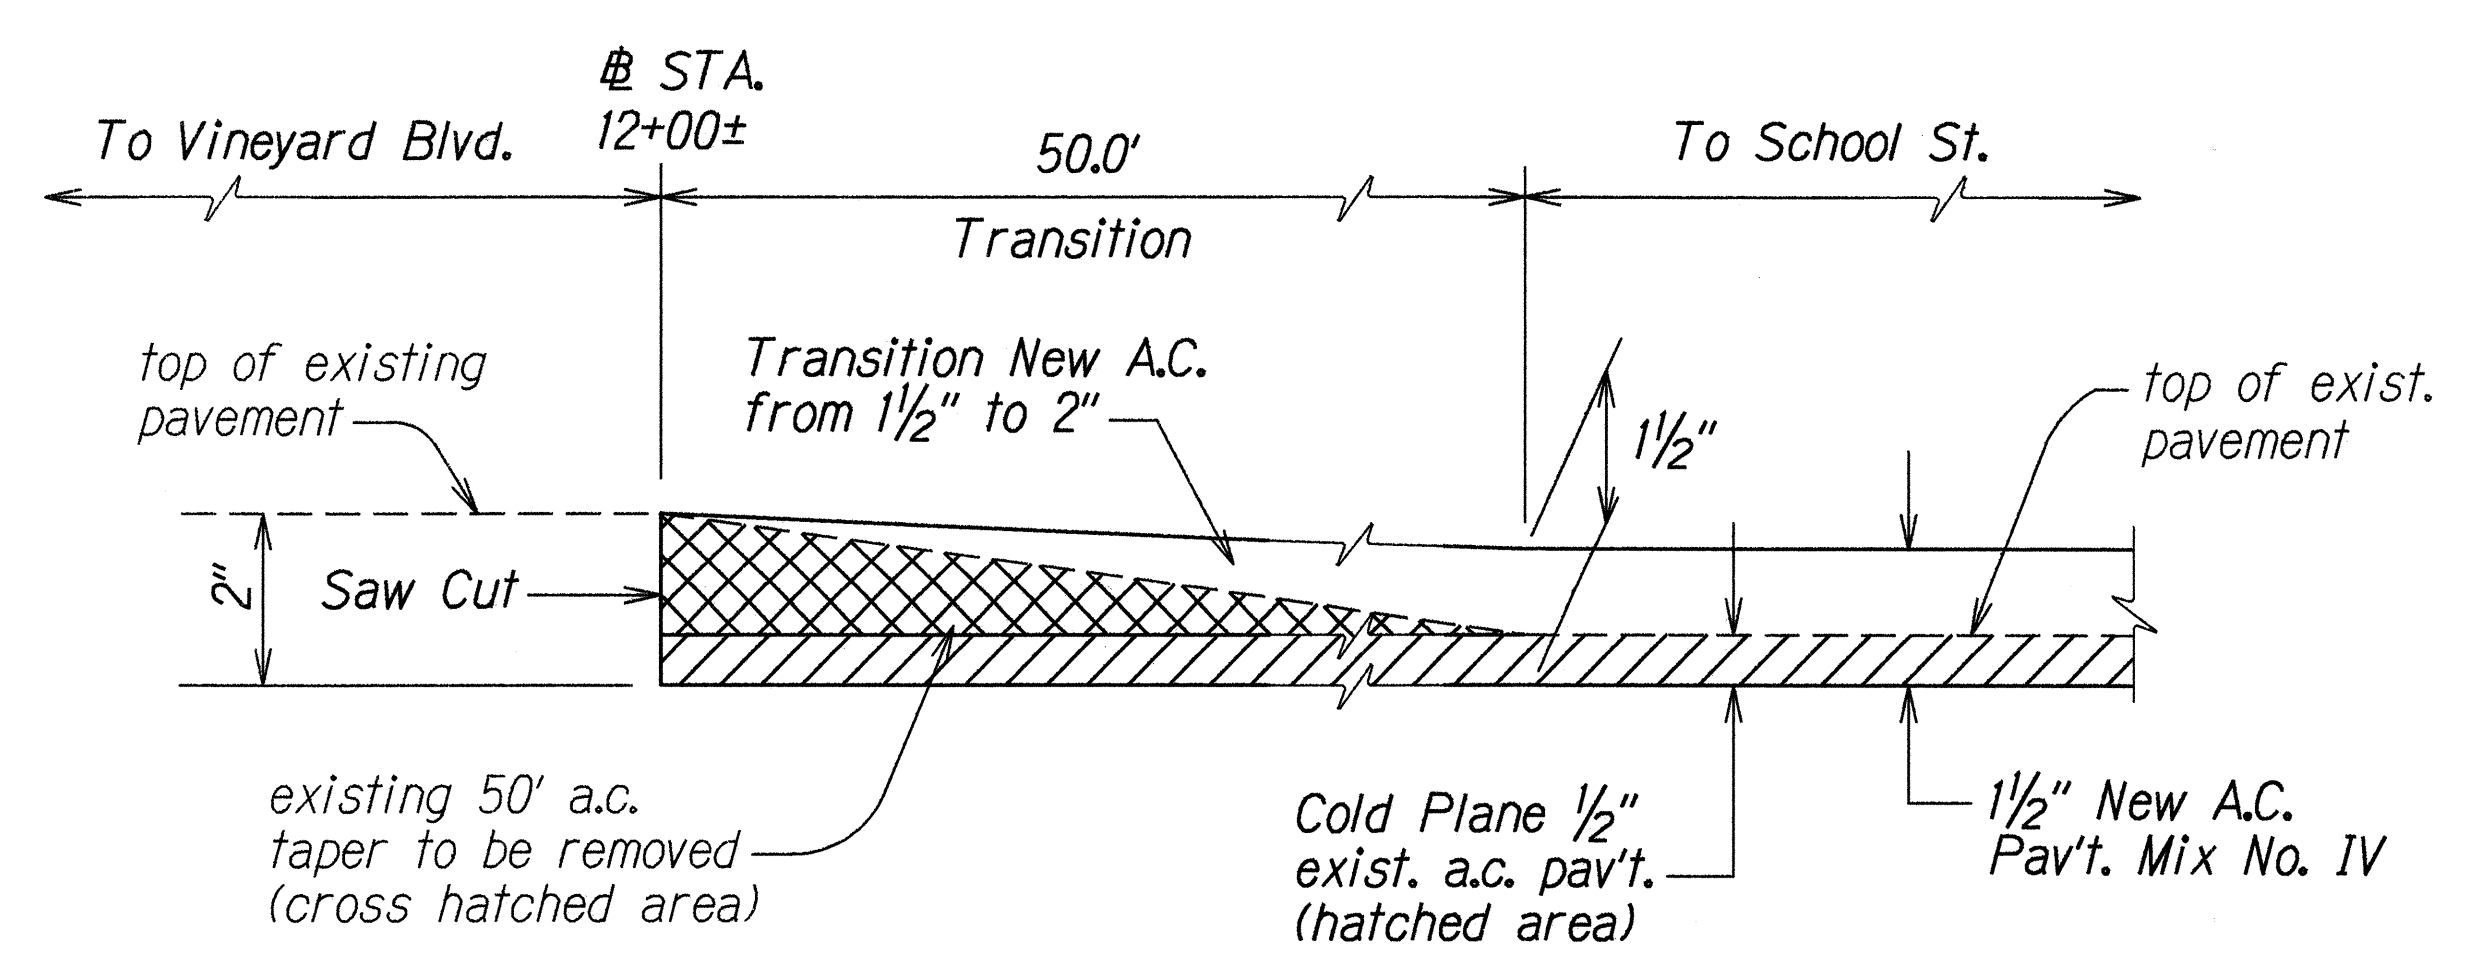

TRANSITION DETAIL AT # STA. 12+00±
Not To Scale

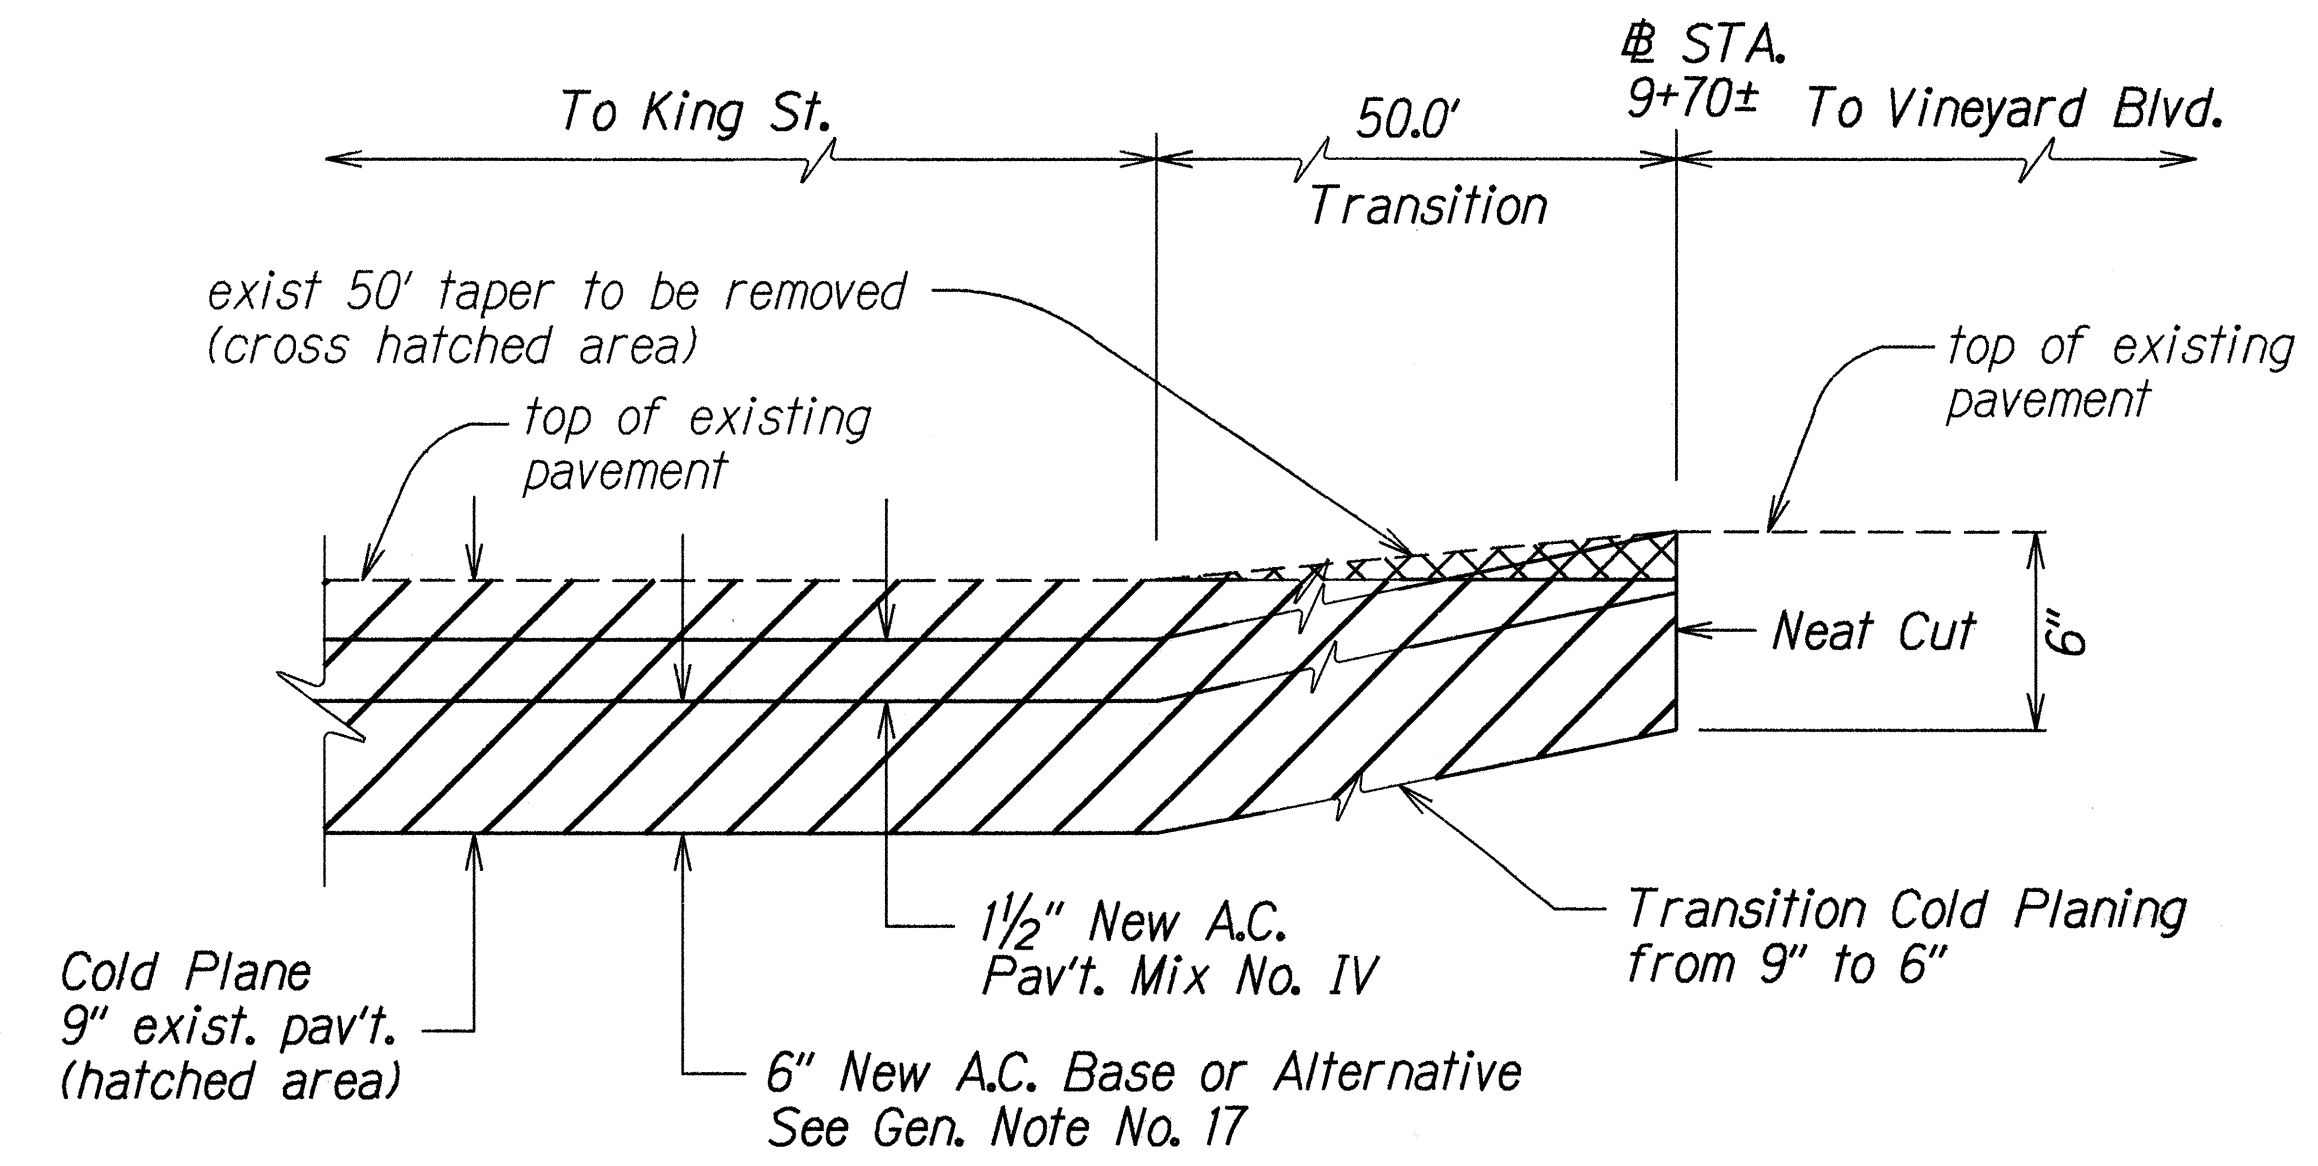

TRANSITION DETAIL AT # STA. 9+70±
Not To Scale

LEGEND FOR AS-BUILT POSTINGS	
	Squiggly line for as-built deletion
	Double line for as-built deletion
	Text for as-built posting

STATE OF HAWAII
DEPARTMENT OF TRANSPORTATION
HIGHWAYS DIVISION

MISC. DETAILS


LILIHA STREET RESURFACING
North King Street to H-1 Overpass
Fed. Aid Project No. STP-7413(1)

Scale: As Noted Date: Sept., 1993

SHEET No. 2 OF 2 SHEETS

SURVEY PLANNED BY	DATE
DESIGNED BY	9-7-93
TRACED BY	
QUANTITIES BY	
CHECKED BY	
ORIGINAL PLAN	
NOTE BOOK	
ILLUSTRATIONS	

FED. ROAD DIST. NO.	STATE	FED. AID PROJ. NO.	FISCAL YEAR	SHEET NO.	TOTAL SHEETS
HAWAII	HAW.	STP-7413[1]	1994	1 of 1	19

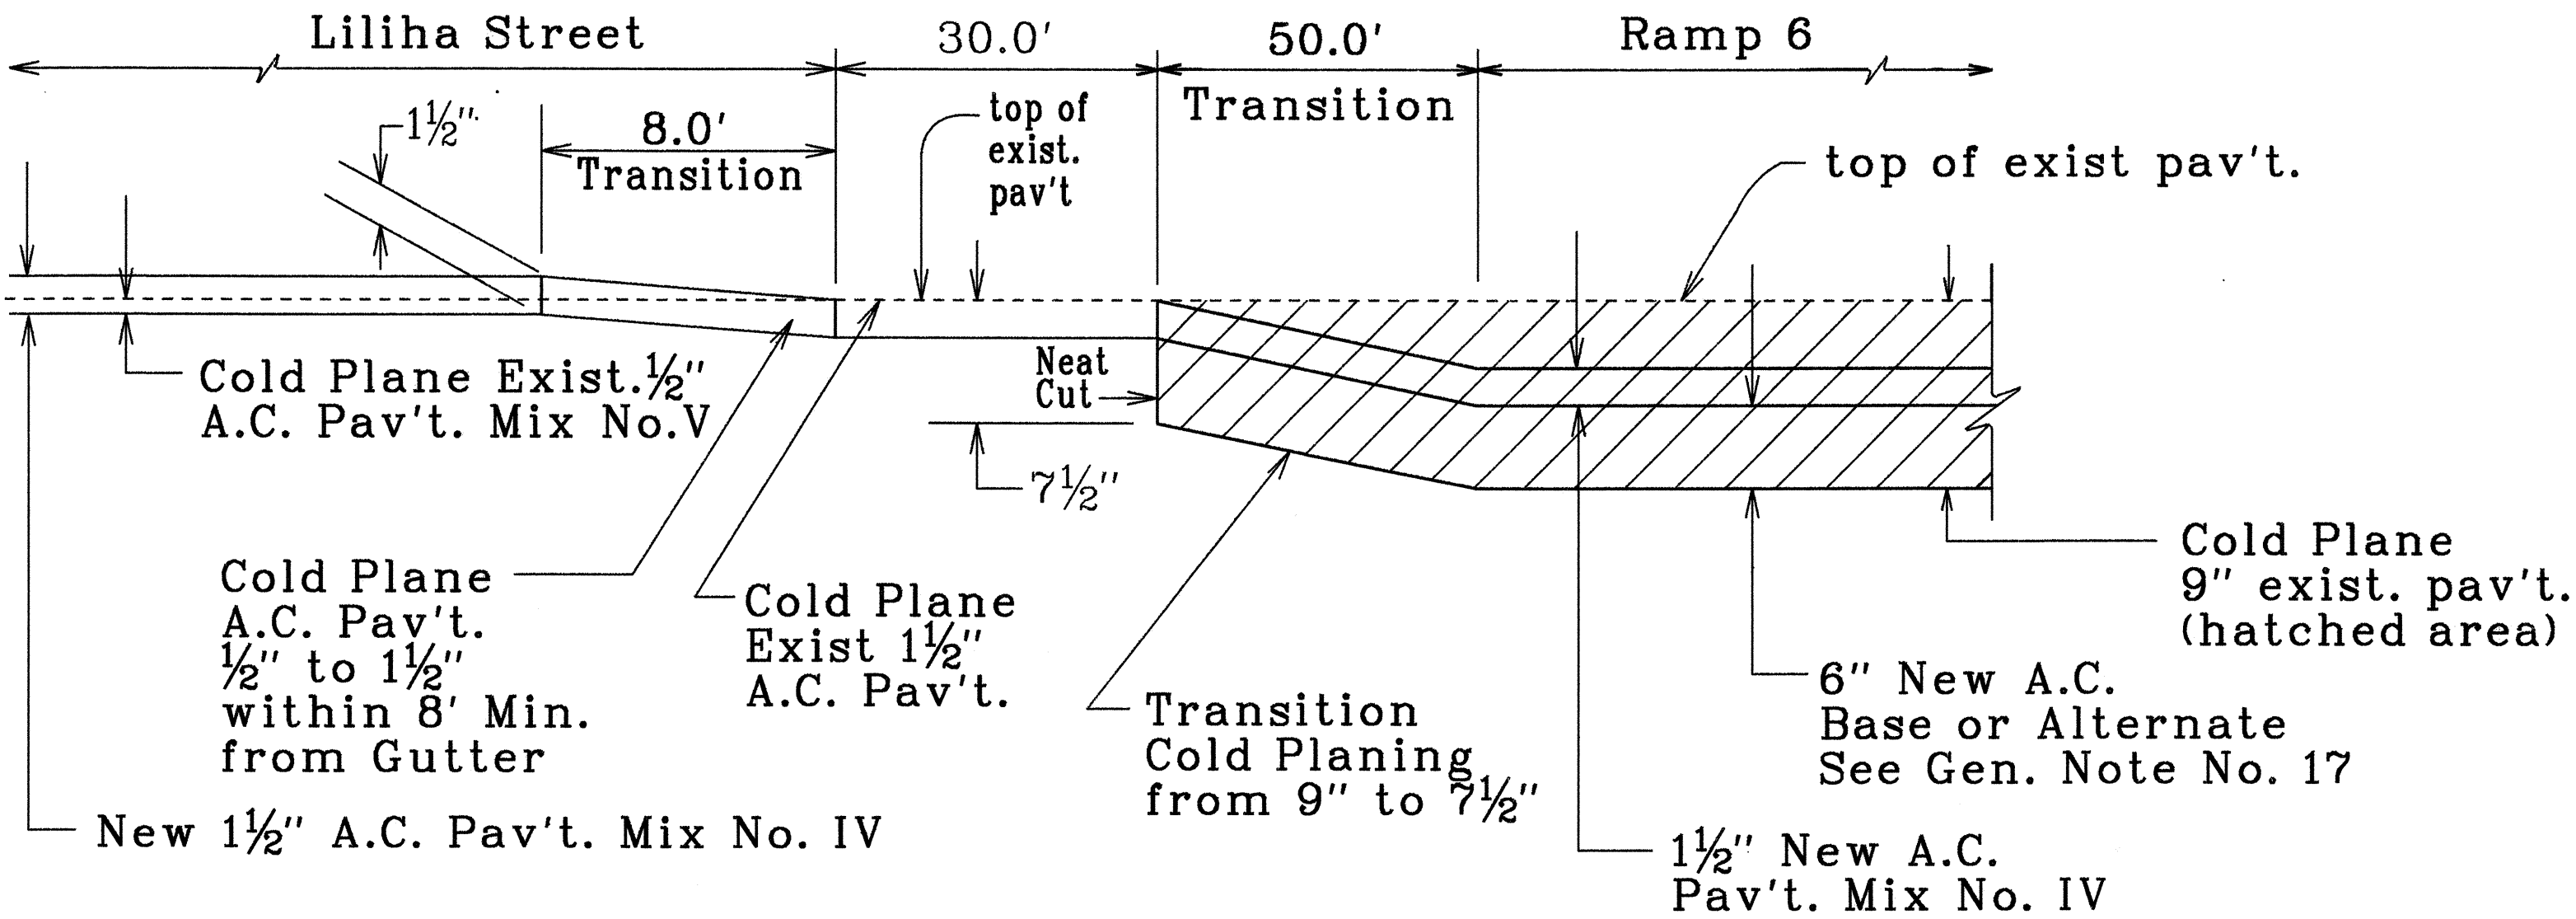

TRANSITION DETAIL AT RAMP 6
Not to Scale

ORIGINAL PLAN	SURVEY PLOTTED BY	DATE
NOTE BOOK	DESIGNED BY	5/2/93
11/1/93	CHECKED BY	

LEGEND FOR AS-BUILT POSTINGS	
	Squiggly line for as-built deletion
	Double line for as-built deletion
Roadway	Text for as-built posting

Note: This tracing prepared during "As-Built" posting.

STATE OF HAWAII DEPARTMENT OF TRANSPORTATION HIGHWAYS DIVISION	
MISC. DETAILS	
LILIHA STREET RESURFACING	
North King Street to H-1 Overpass	
Fed. Aid Project No. STP-7413[1]	
Not to Scale	Date: Sept., 1993
SHEET No. 1 OF 1 SHEETS	