



FED. ROAD DIST. NO.	STATE	FED. AID PROJ. NO.	FISCAL YEAR	SHEET NO.	TOTAL SHEETS
HAWAII	HAW.	STP-7413(1)	1994	16	18

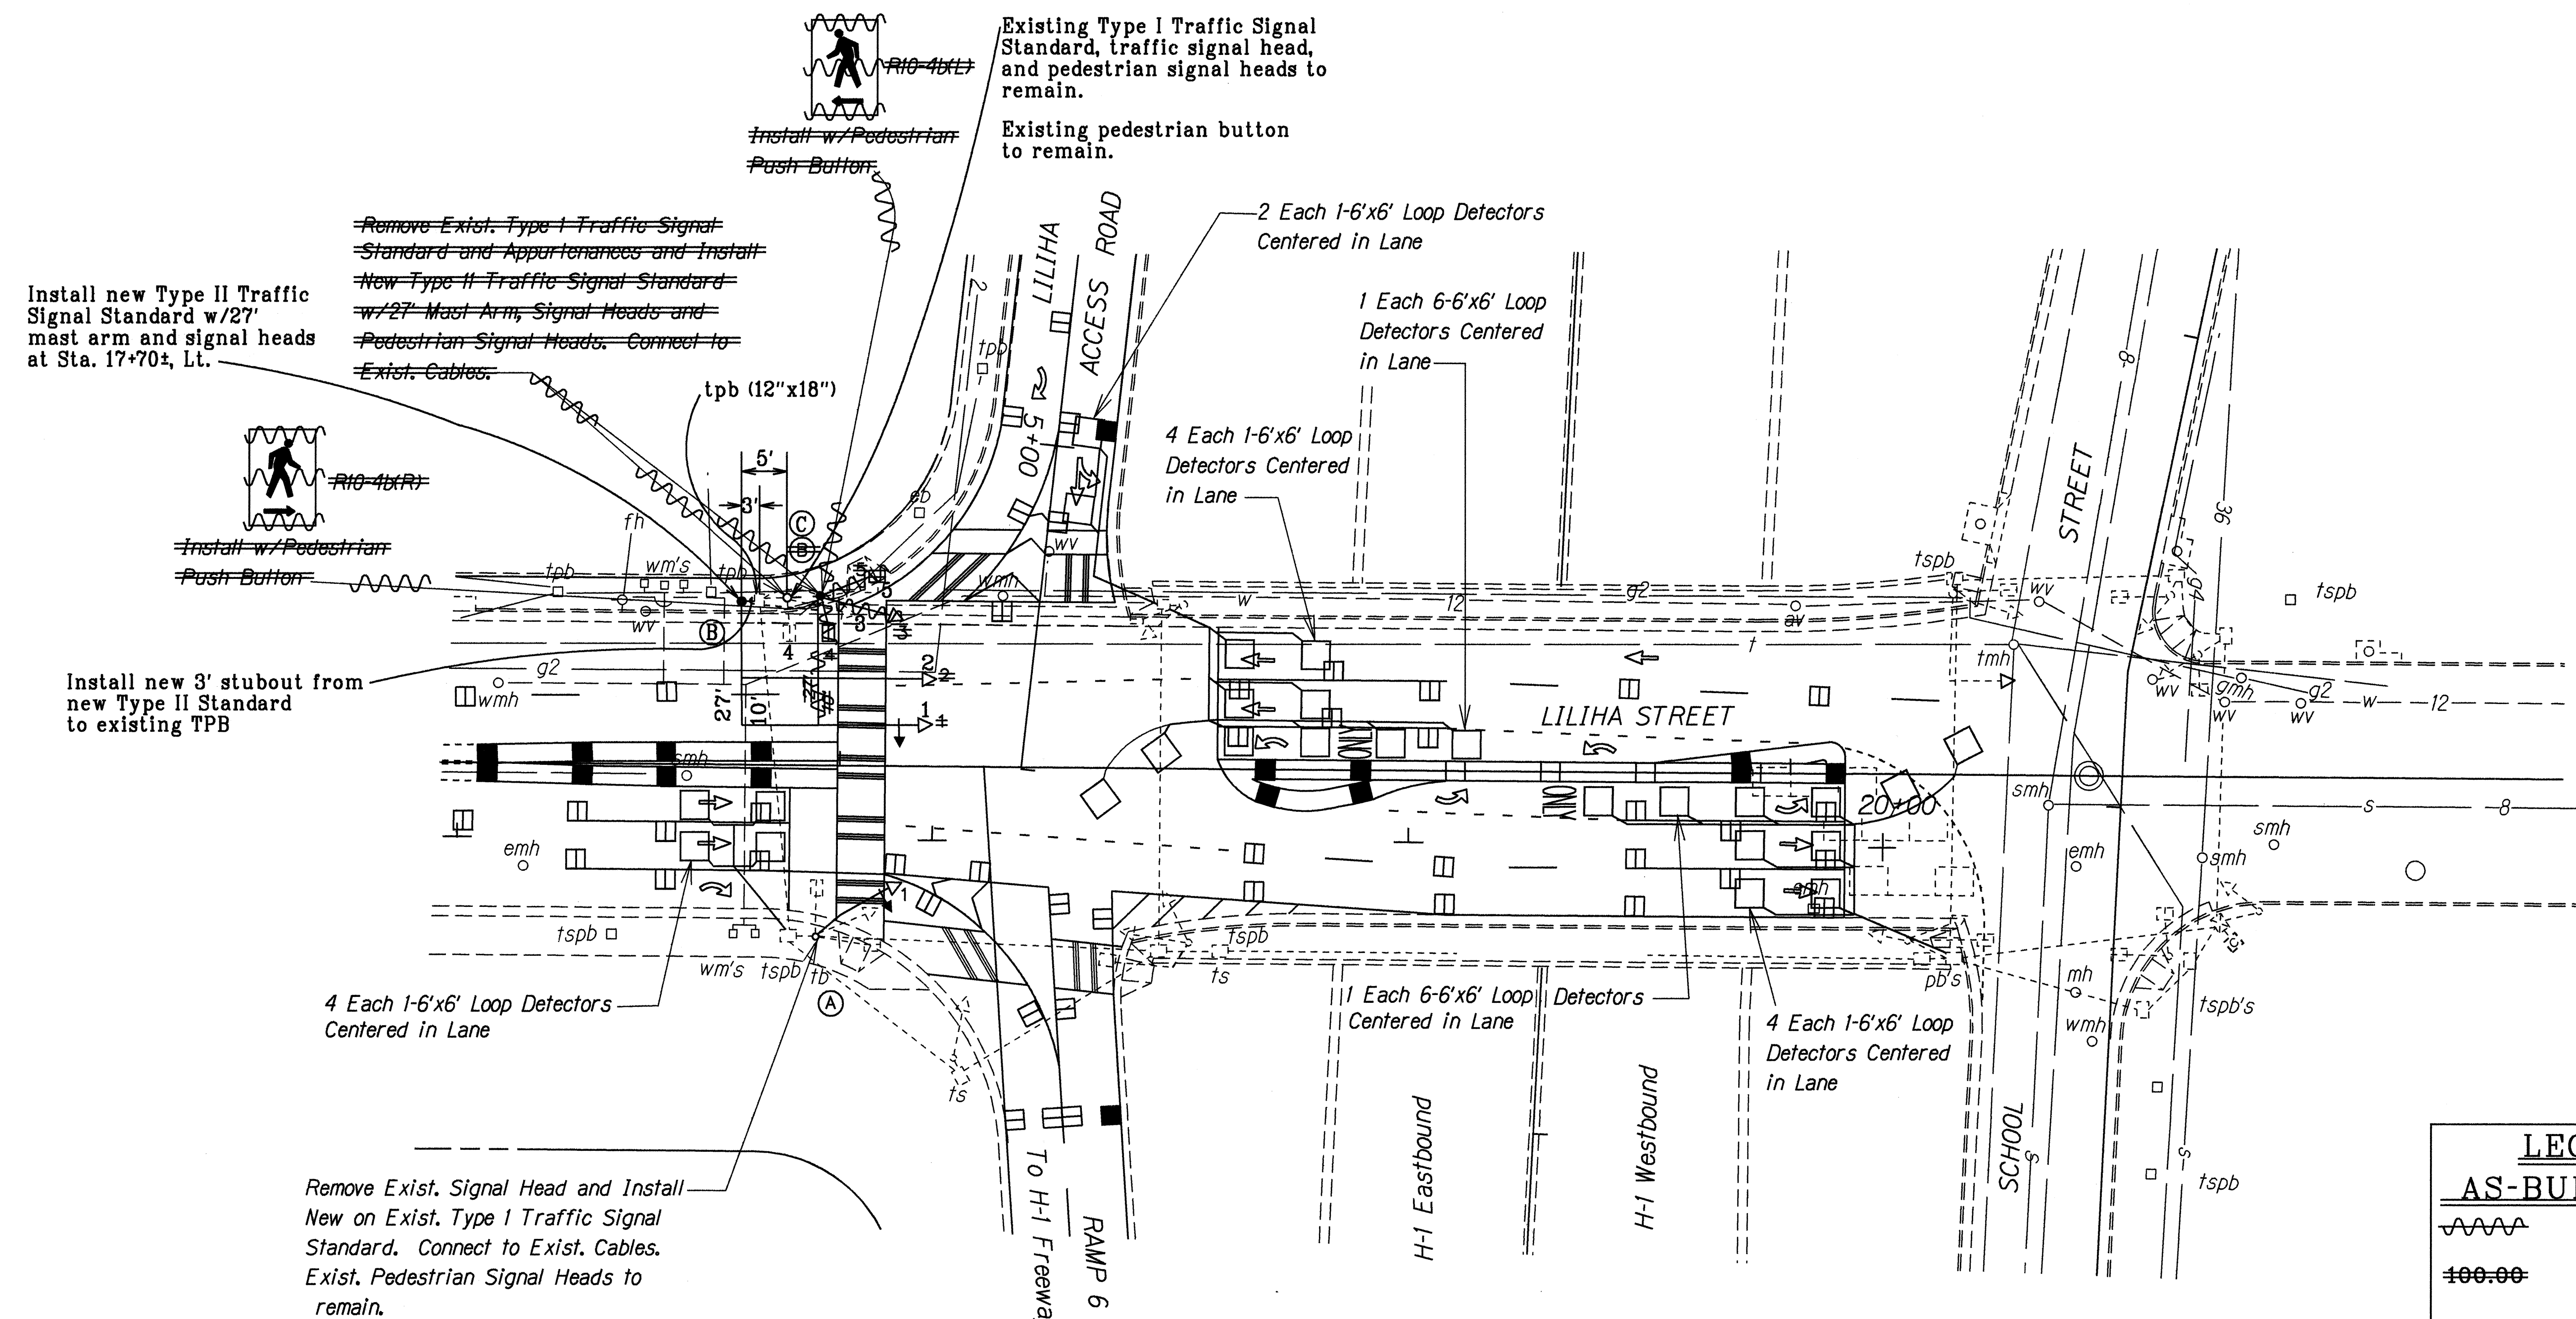

ORIGINAL PLAN	DATE
DESIGNED BY	08/93
TRACED BY	
DESIGNED BY	
QUANTITIES BY	
CHECKED BY	
NOTE BOOK	
REVISIONS	
DATE	
BY	

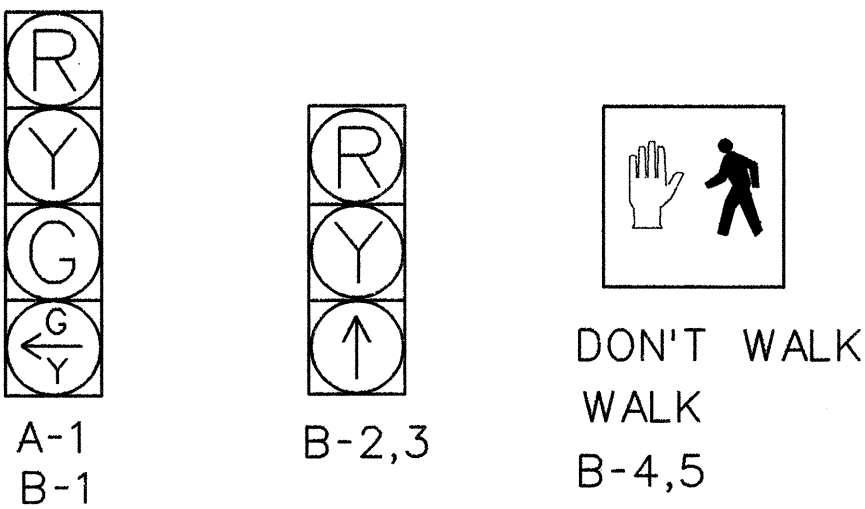

NOTE:

Depth of loop detector sawcut over Liliha Street Overpass Structure shall be determined in the field by the Engineer.

LEGEND FOR AS-BUILT POSTINGS	
	Squiggly line for as-built deletion
	Double line for as-built deletion
Roadway	Text for as-built posting

STATE OF HAWAII
DEPARTMENT OF TRANSPORTATION
HIGHWAYS DIVISION

TRAFFIC SIGNAL PLANS
LILIHA STREET RESURFACING
North King Street to H-1 Overpass
Fed. Aid Project No. STP-7413(1)

Scale: 1" = 20'
Date: Aug. 1993

SHEET No. 77 OF 9 SHEETS