




FED. ROAD DIST. NO.	STATE	FED. AID PROJ. NO.	FISCAL YEAR	SHEET NO.	TOTAL SHEETS
HAWAII	HAW.	STP-7413(1)	1994	4	18

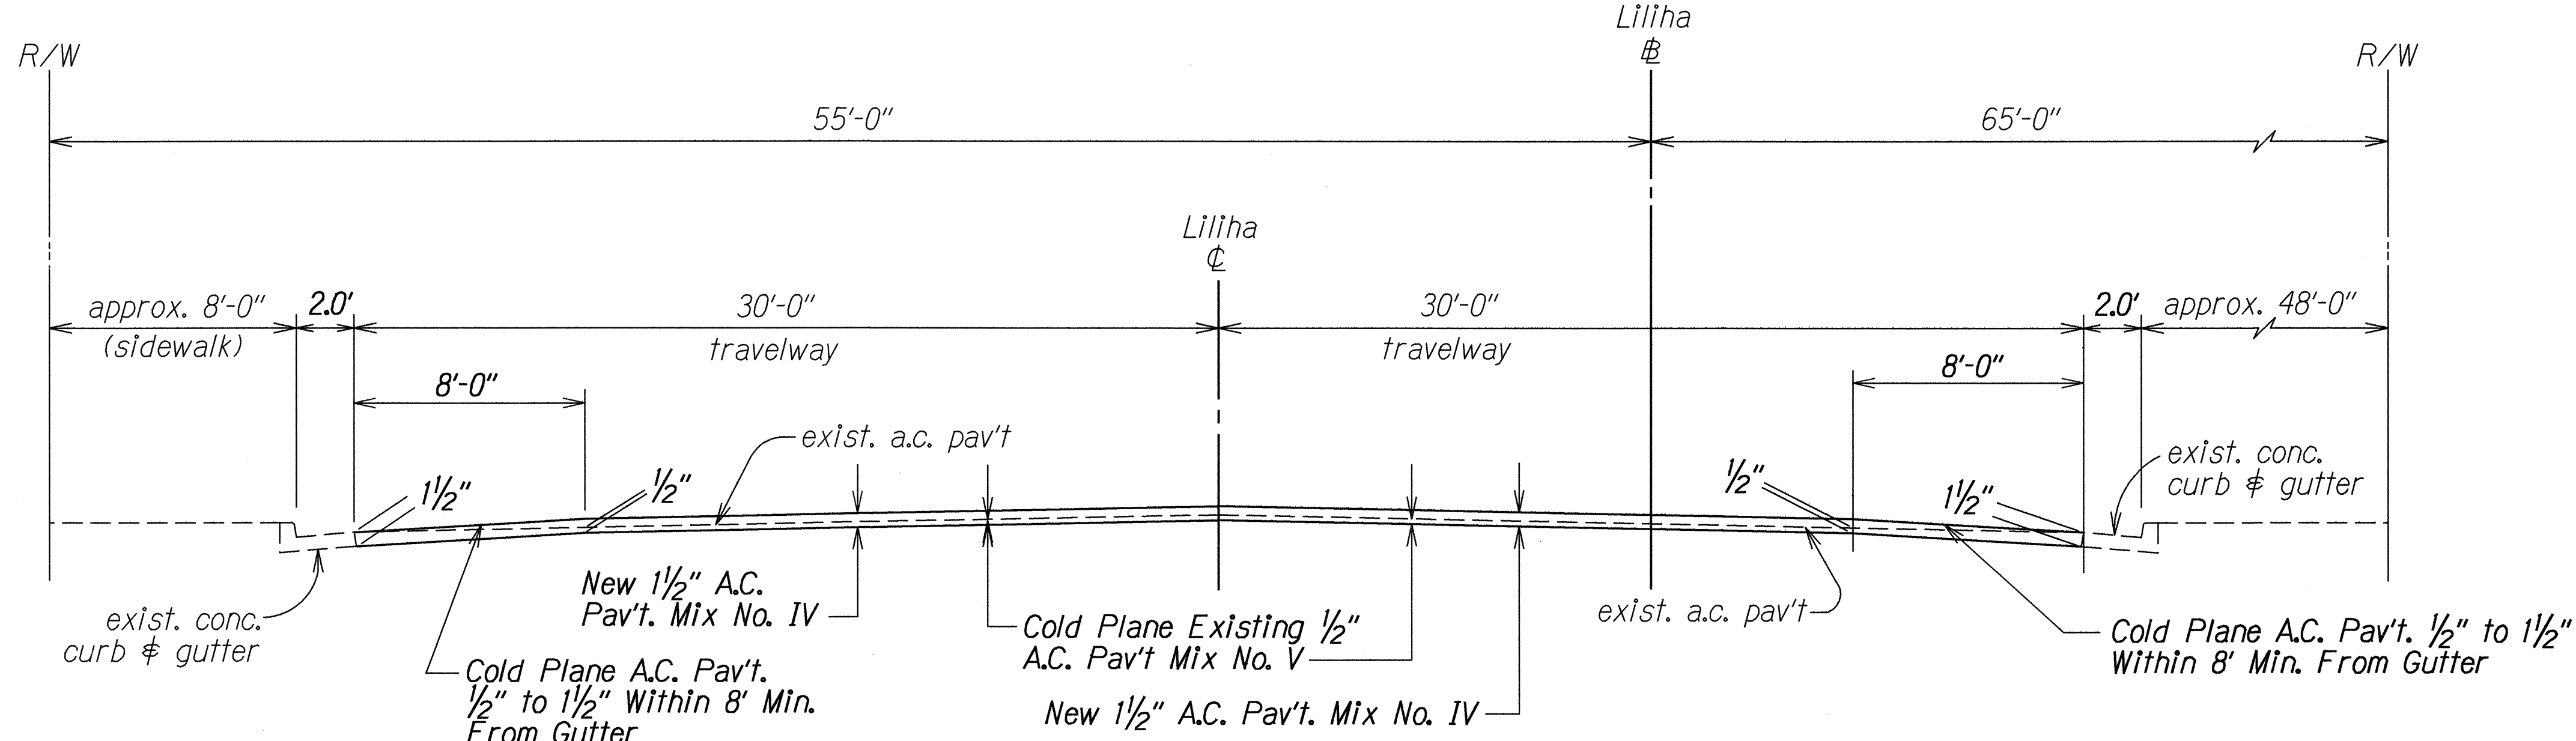


TYPICAL SECTION
Vineyard Blvd. to School St.
 Sta. 12+00± - Sta. 20+20±
 Not To Scale

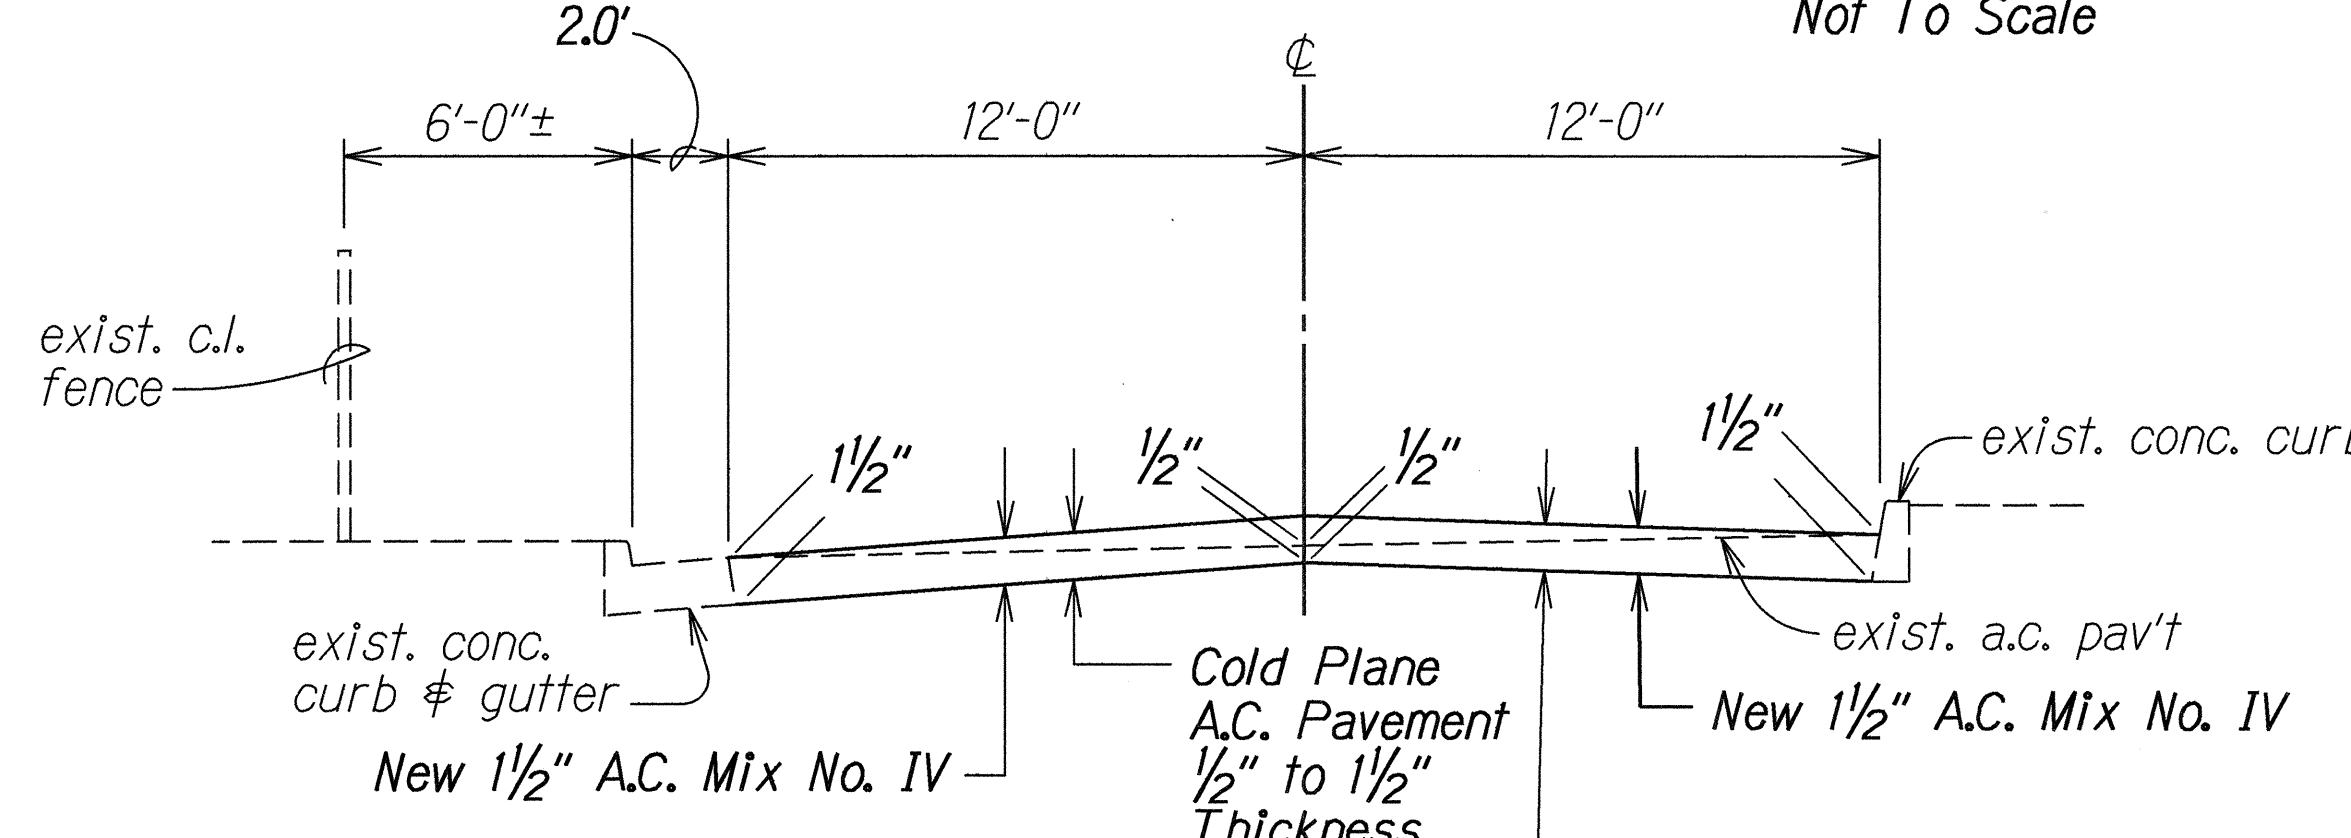

TYPICAL SECTION
Liliha Access Rd.
 Not To Scale

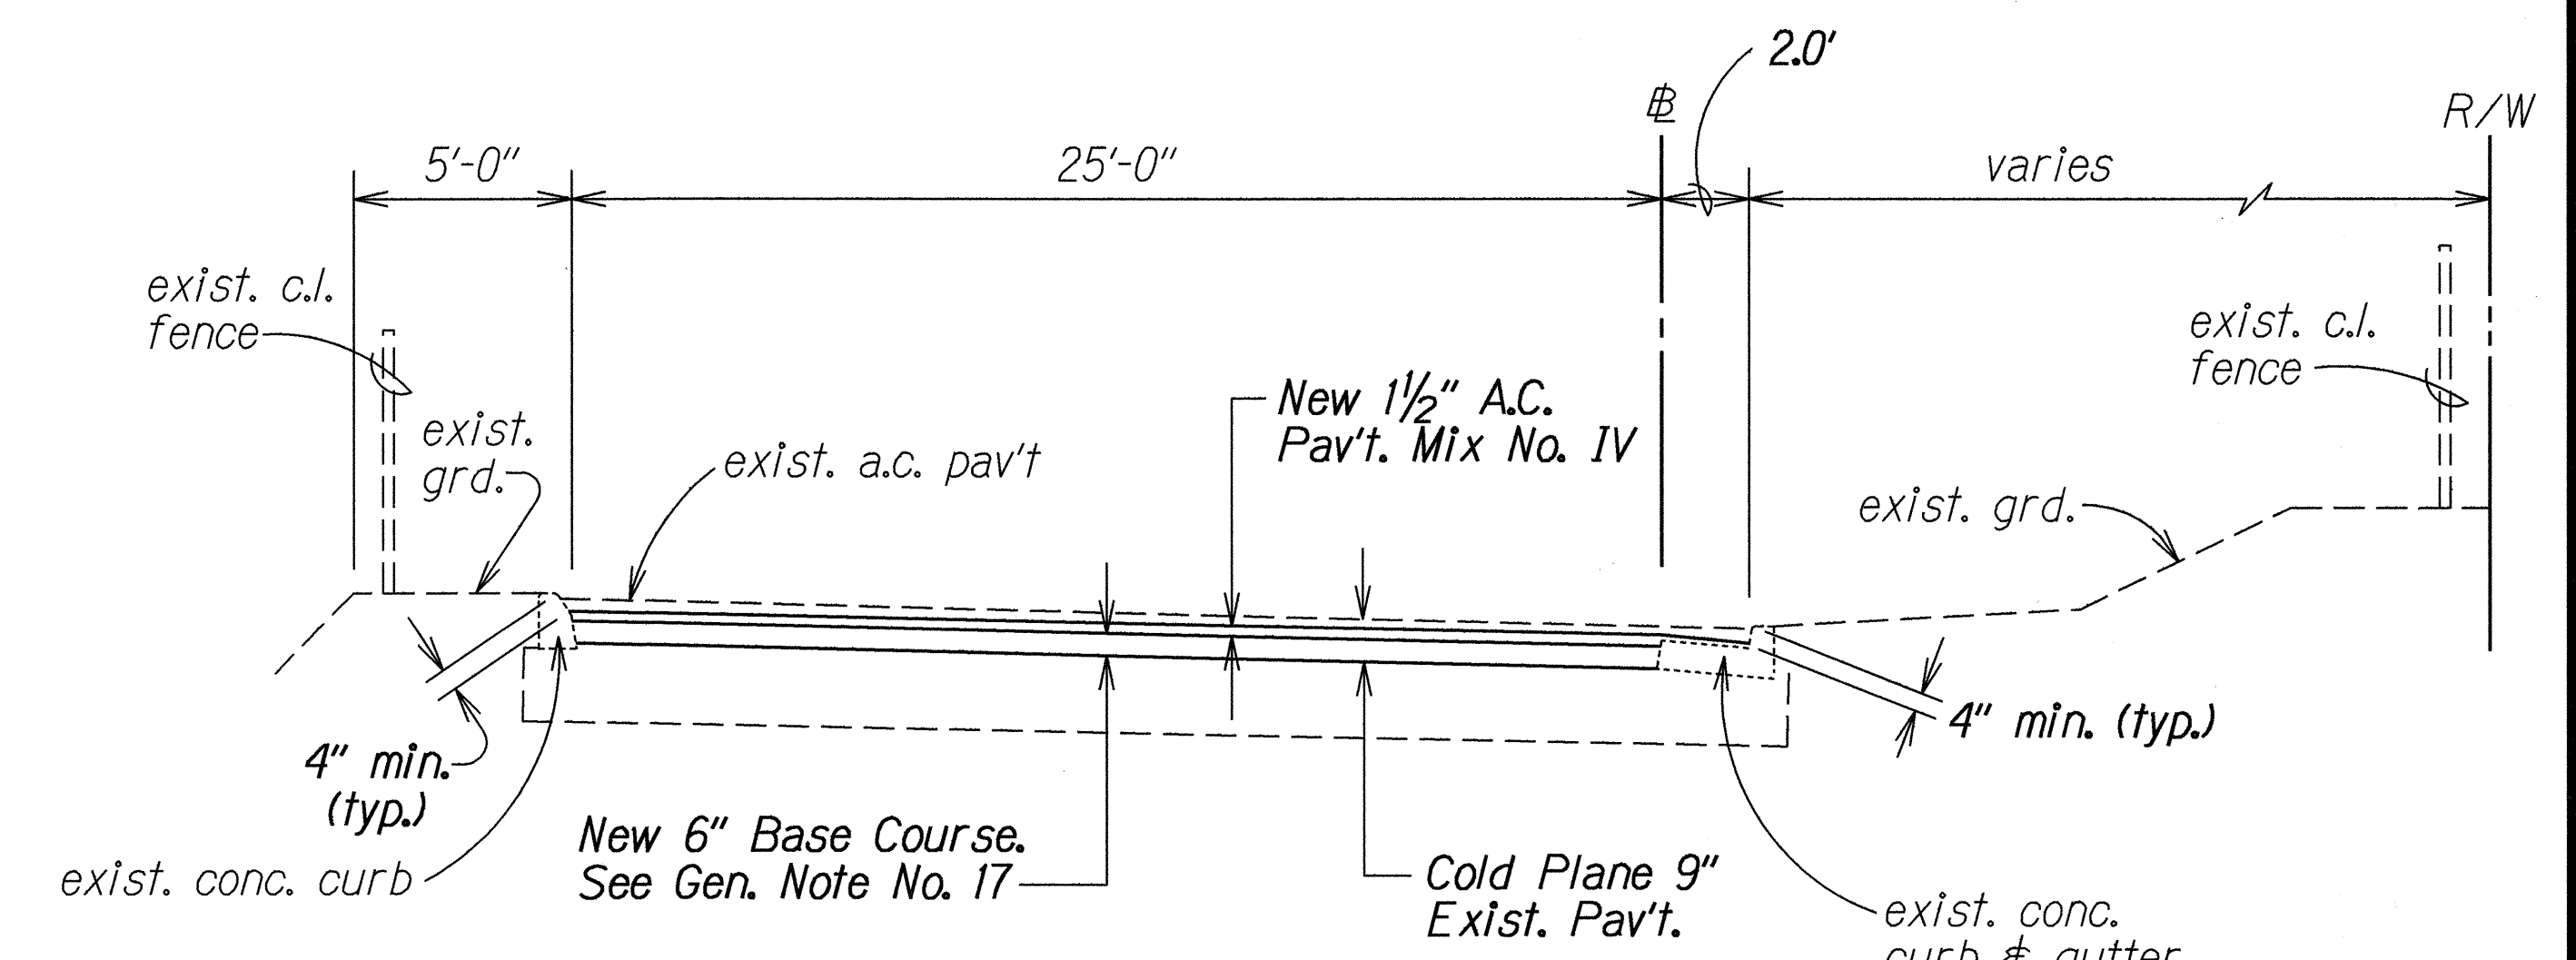

TYPICAL SECTION
Ramp "6"
 Not To Scale

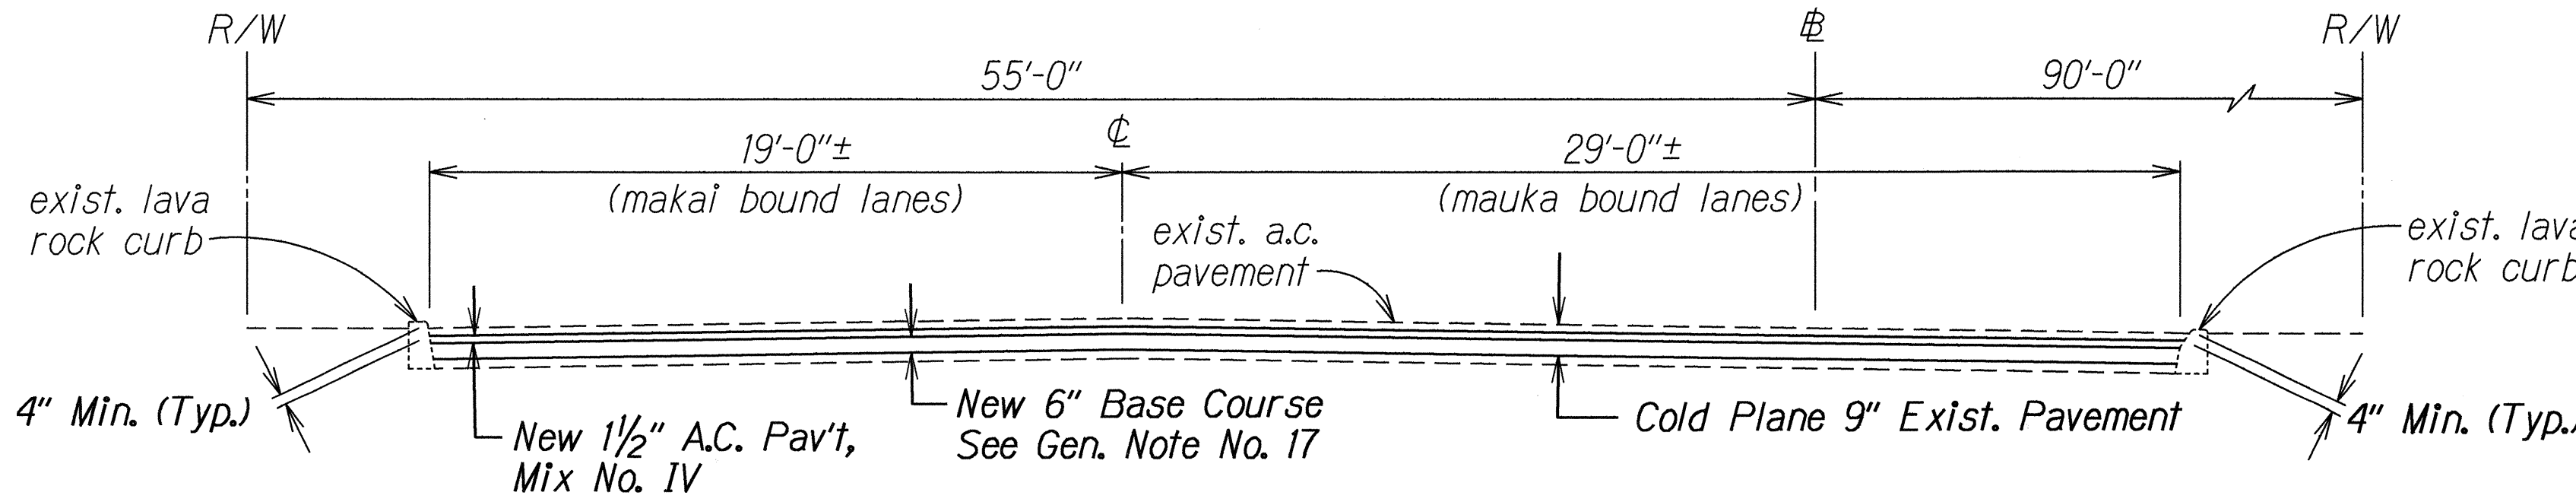

TYPICAL SECTION
King St. to Vineyard Blvd.
 Sta. 0+00± - Sta. 9+70±
 Not To Scale

STATE OF HAWAII
 DEPARTMENT OF TRANSPORTATION
 HIGHWAYS DIVISION

TYPICAL SECTIONS

LILIHA STREET RESURFACING
North King Street to H-1 Overpass
Fed. Aid Project No. STP-7413(1)

Scale: As Noted Date: Sept., 1993

SHEET No. 1 OF 1 SHEETS

ORIGINAL PLAN	DATE
NOTED BY	9/17/93
DESIGNED BY	
CHECKED BY	
QUANTITIES BY	
NOTED BY	