


BEGIN PROJECT
Project No. 7413A-01-04M
@ STA. 0+00±

- Constr. Limits
- protect Intel
- Perimeter Sediment Control

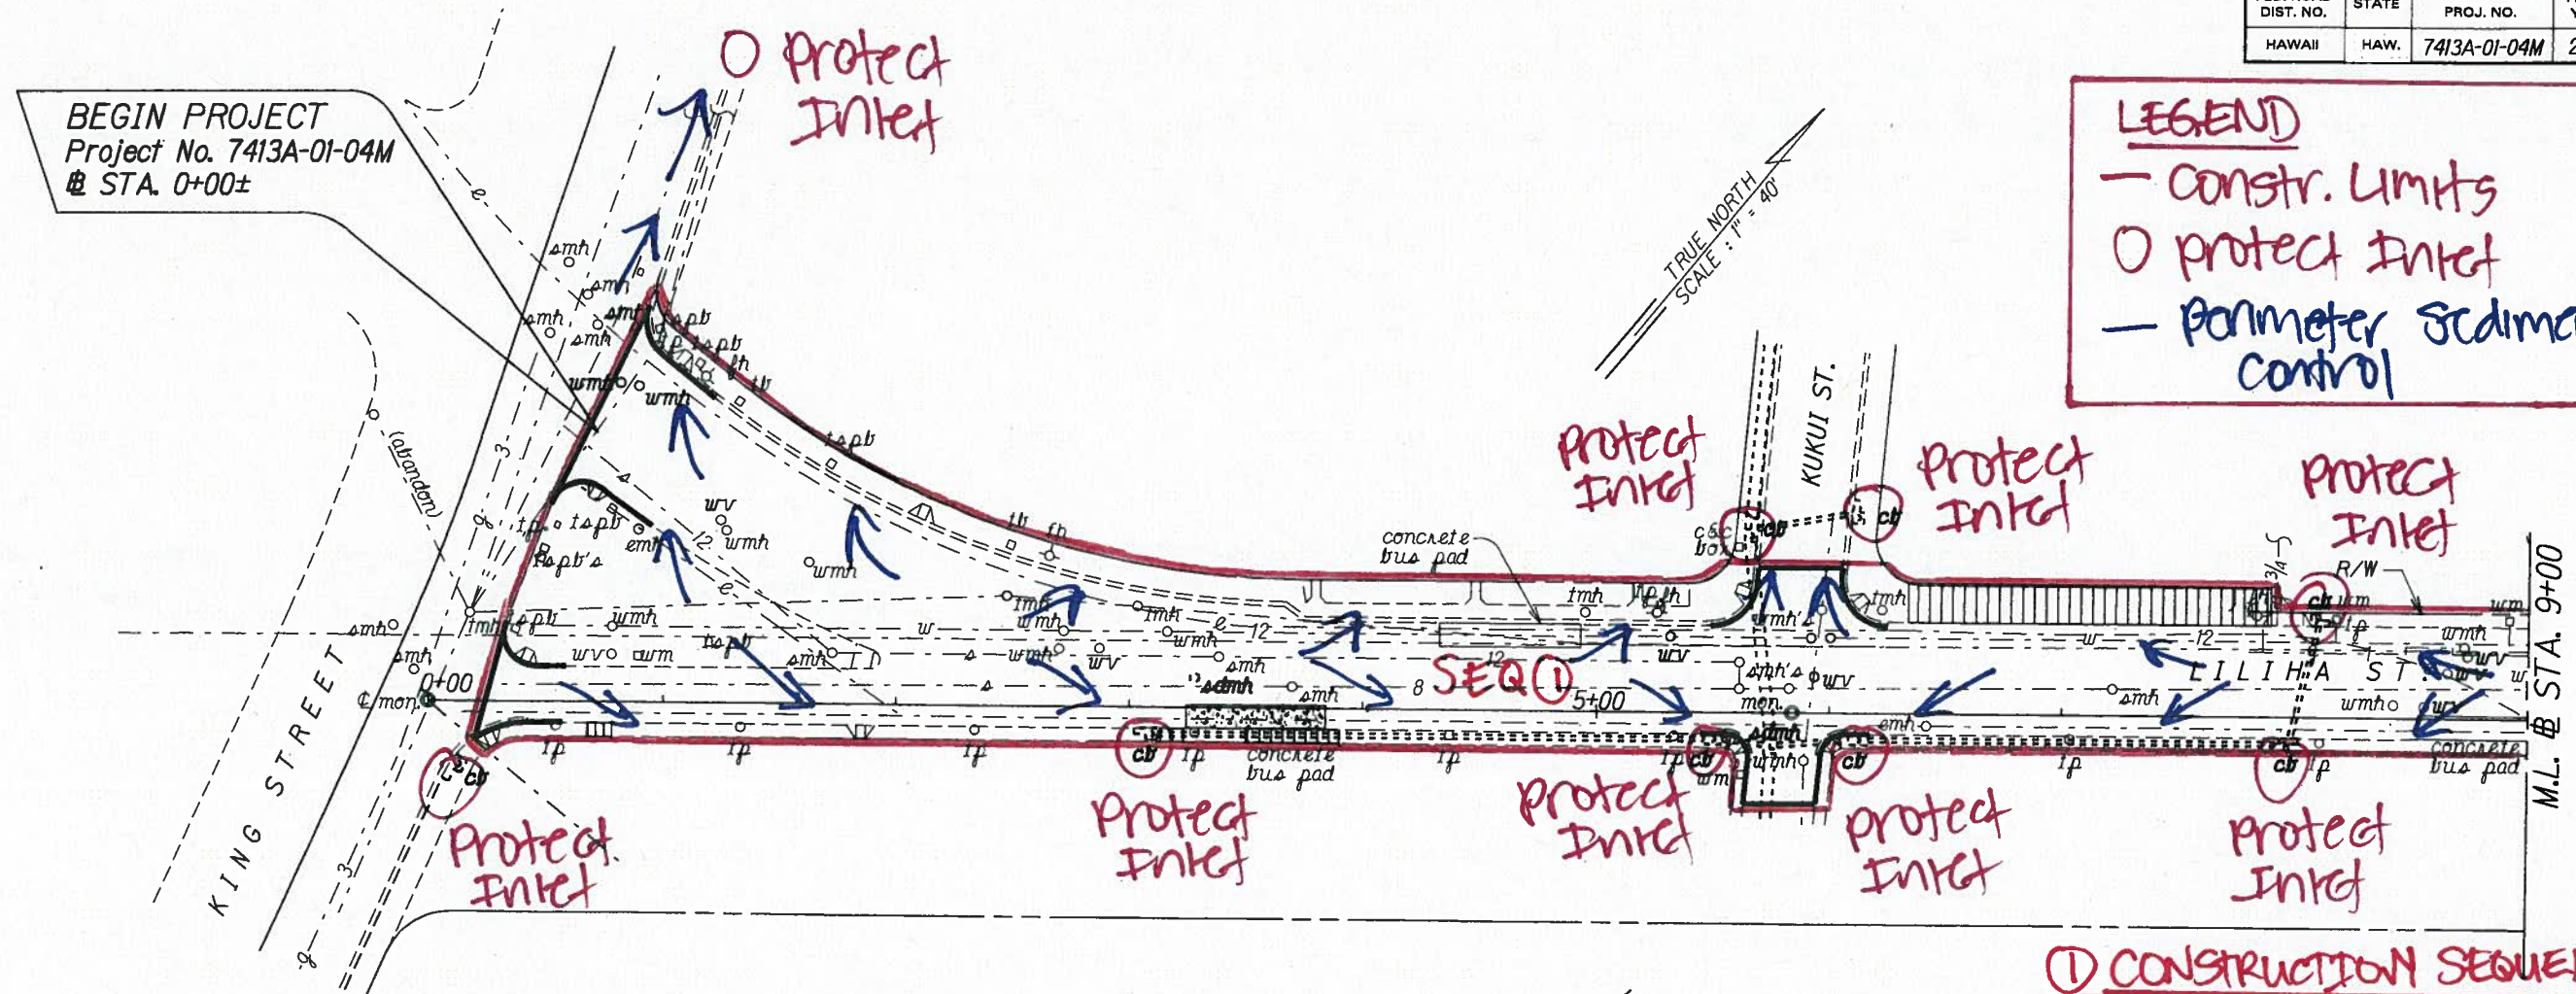


① CONSTRUCTION SEQUENCE DIAG.
KING ST. TO SCHOOL ST.

(A) Install Intel Protection

⑬ Construct Roadway

(Roadway Recon.,
Cold planing AC wearing
surf., resurfacing,
sidewalk recon., gutter
repair/Installation)

(c) Remove BMPs except at staging area

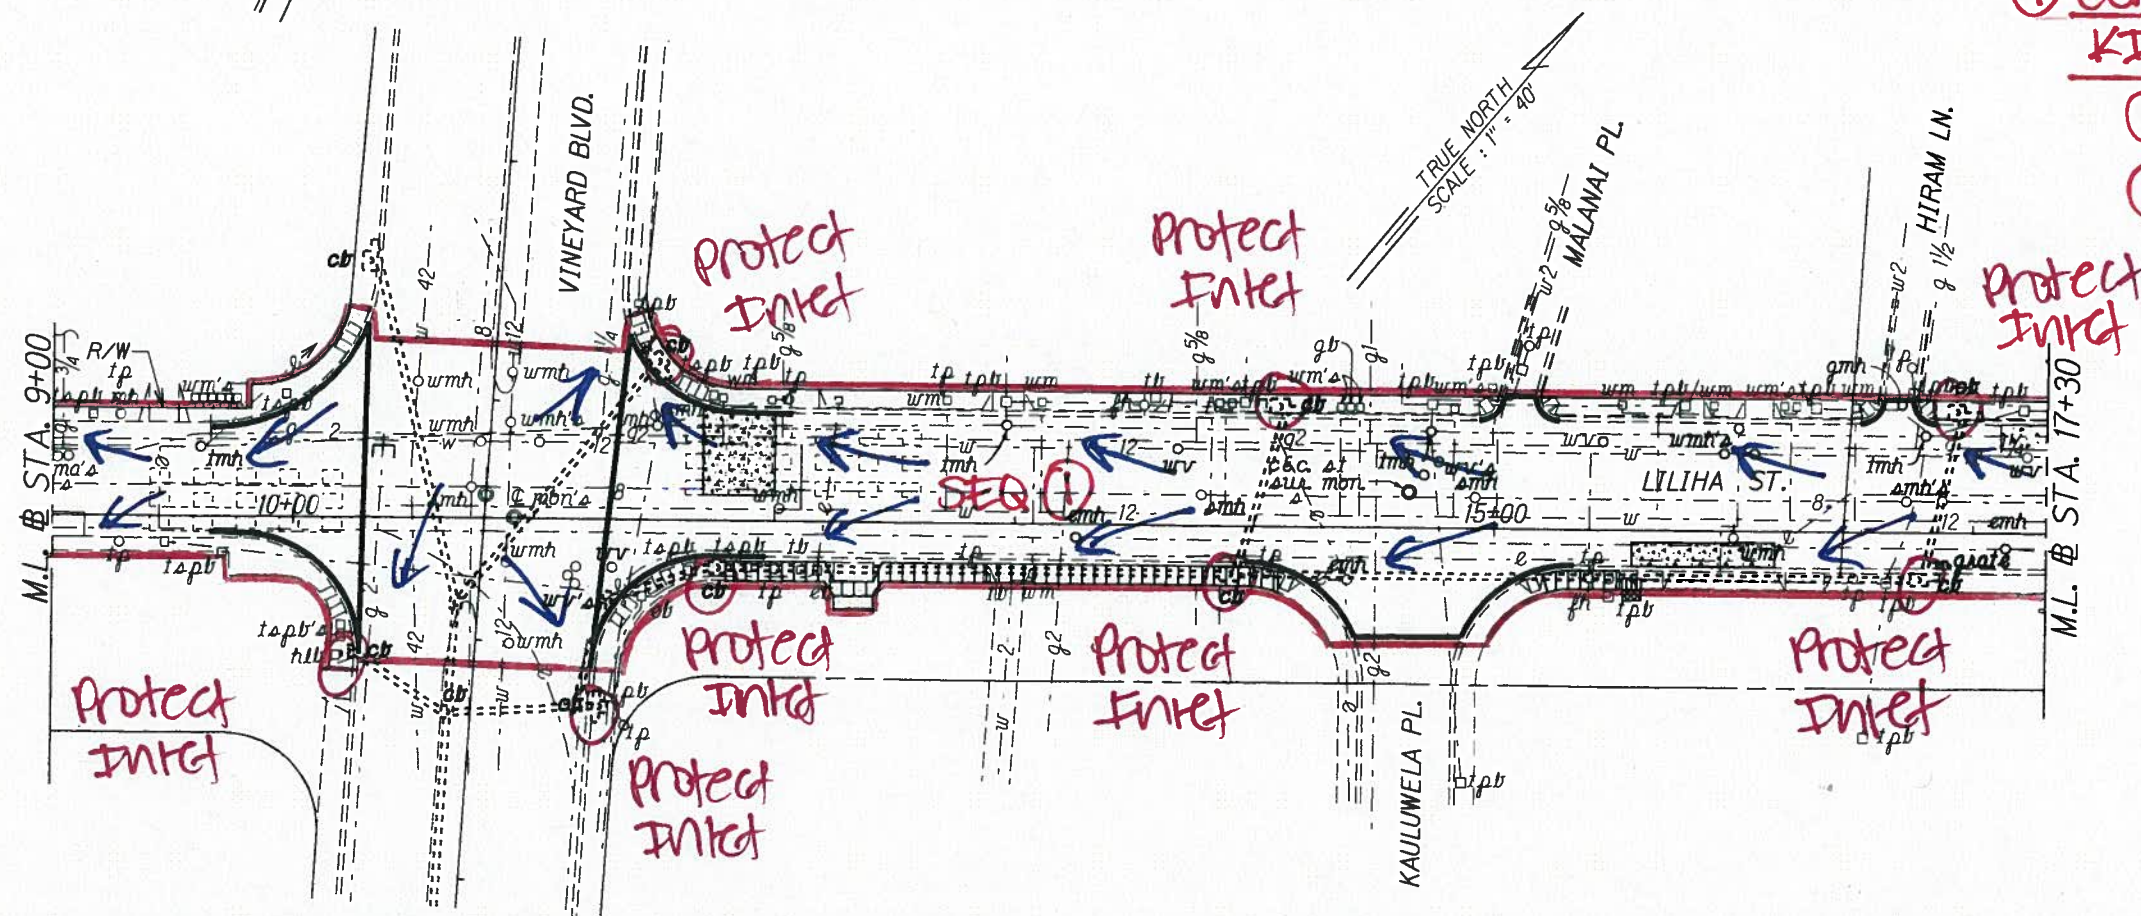

PLAN

LILIHA STREET REHABILITATION
North King Street to School Street
Project No. 7413A-01-04M


Scale: 1" = 40'

Date: Sept. 2007

SHEET No. 1 OF 2 SHEETS

ORIGINAL PLAN	SURVEY PLOTTED BY DRAWN BY <u>Michael Howells</u> DATE <u>8/13/93</u>
NOTE BOOK	PLACED BY _____
	DESIGNED BY <u>Carly Chao</u>
	QUANTITIES BY _____
	CHECKED BY _____
N. <u>21164960</u>	

FED. ROAD DIST. NO.	STATE	PROJ. NO.	FISCAL YEAR	SHEET NO.	TOTAL SHEETS
HAWAII	HAW.	7413A-01-04M	2007	9	18

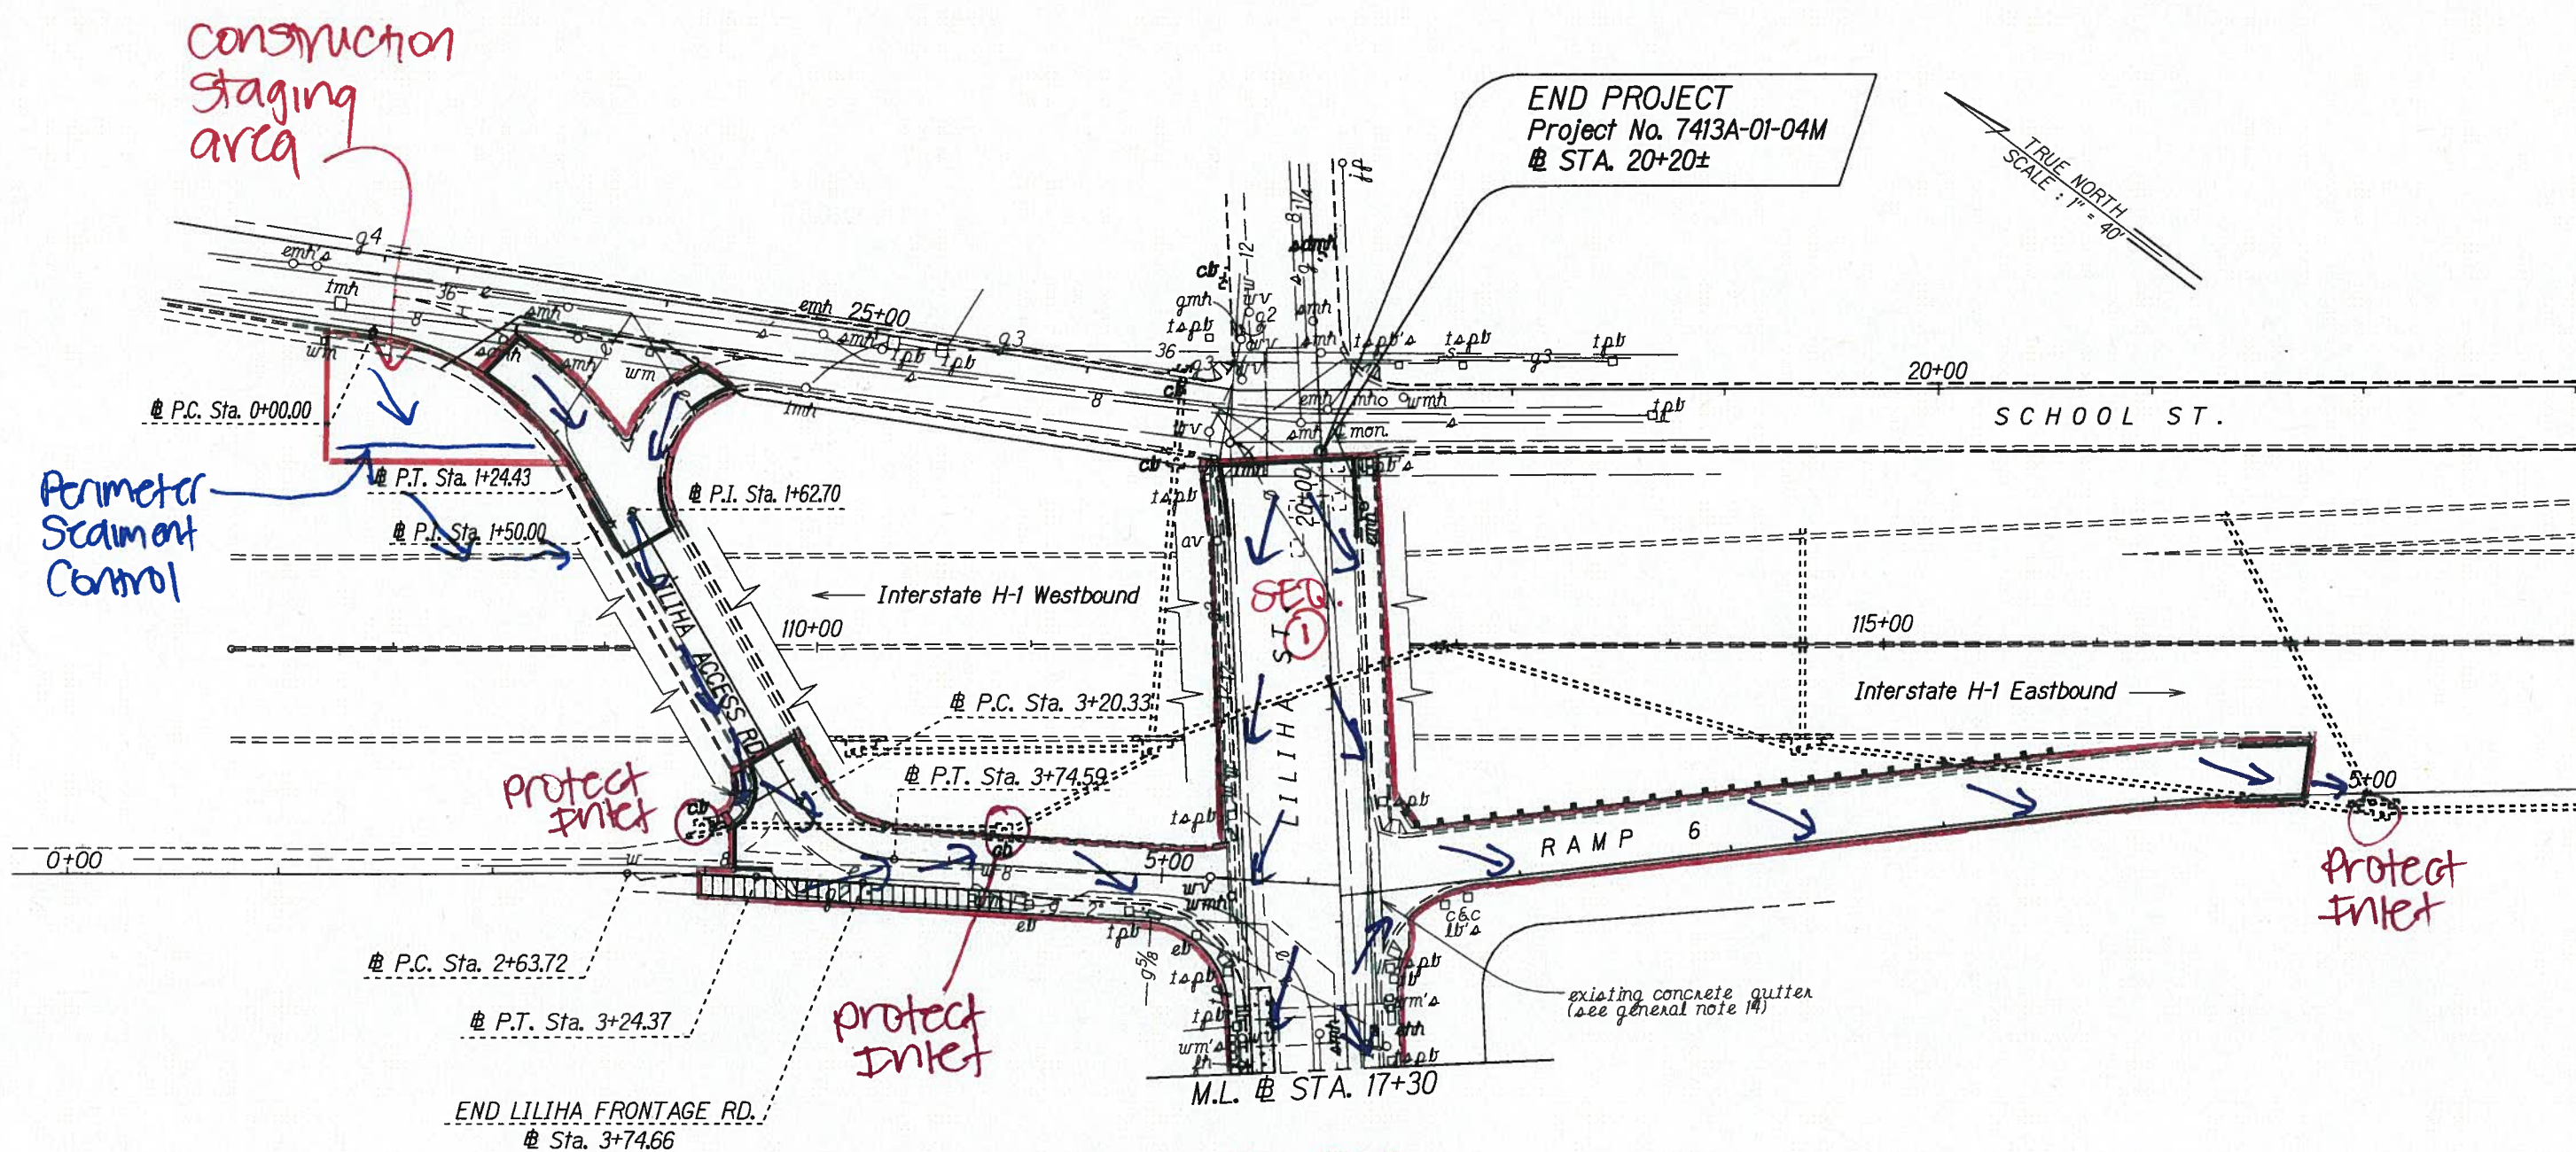

① CONSTRUCTION SEQUENCE DRAG
KING ST. TO SCHOOL ST. (CONT.)

SURVEY PLOTTED BY	DATE
DRAWN BY	8/23/93
CHECKED BY	
NOTES BOOK	
211002.dgn	
N.	

STATE OF HAWAII
DEPARTMENT OF TRANSPORTATION
HIGHWAYS DIVISION

PLAN

LILIHA STREET REHABILITATION
North King Street to School Street
Project No. 7413A-01-04M


Scale: 1" = 40' Date: Sept., 2007

SHEET No. 2 OF 2 SHEETS

BEGIN PROJECT
Project No. 7413A-01-04M
@ STA. 0+00±


LEGEND

- constr. Limits
- protect Thicket
- perimeter sediment Control

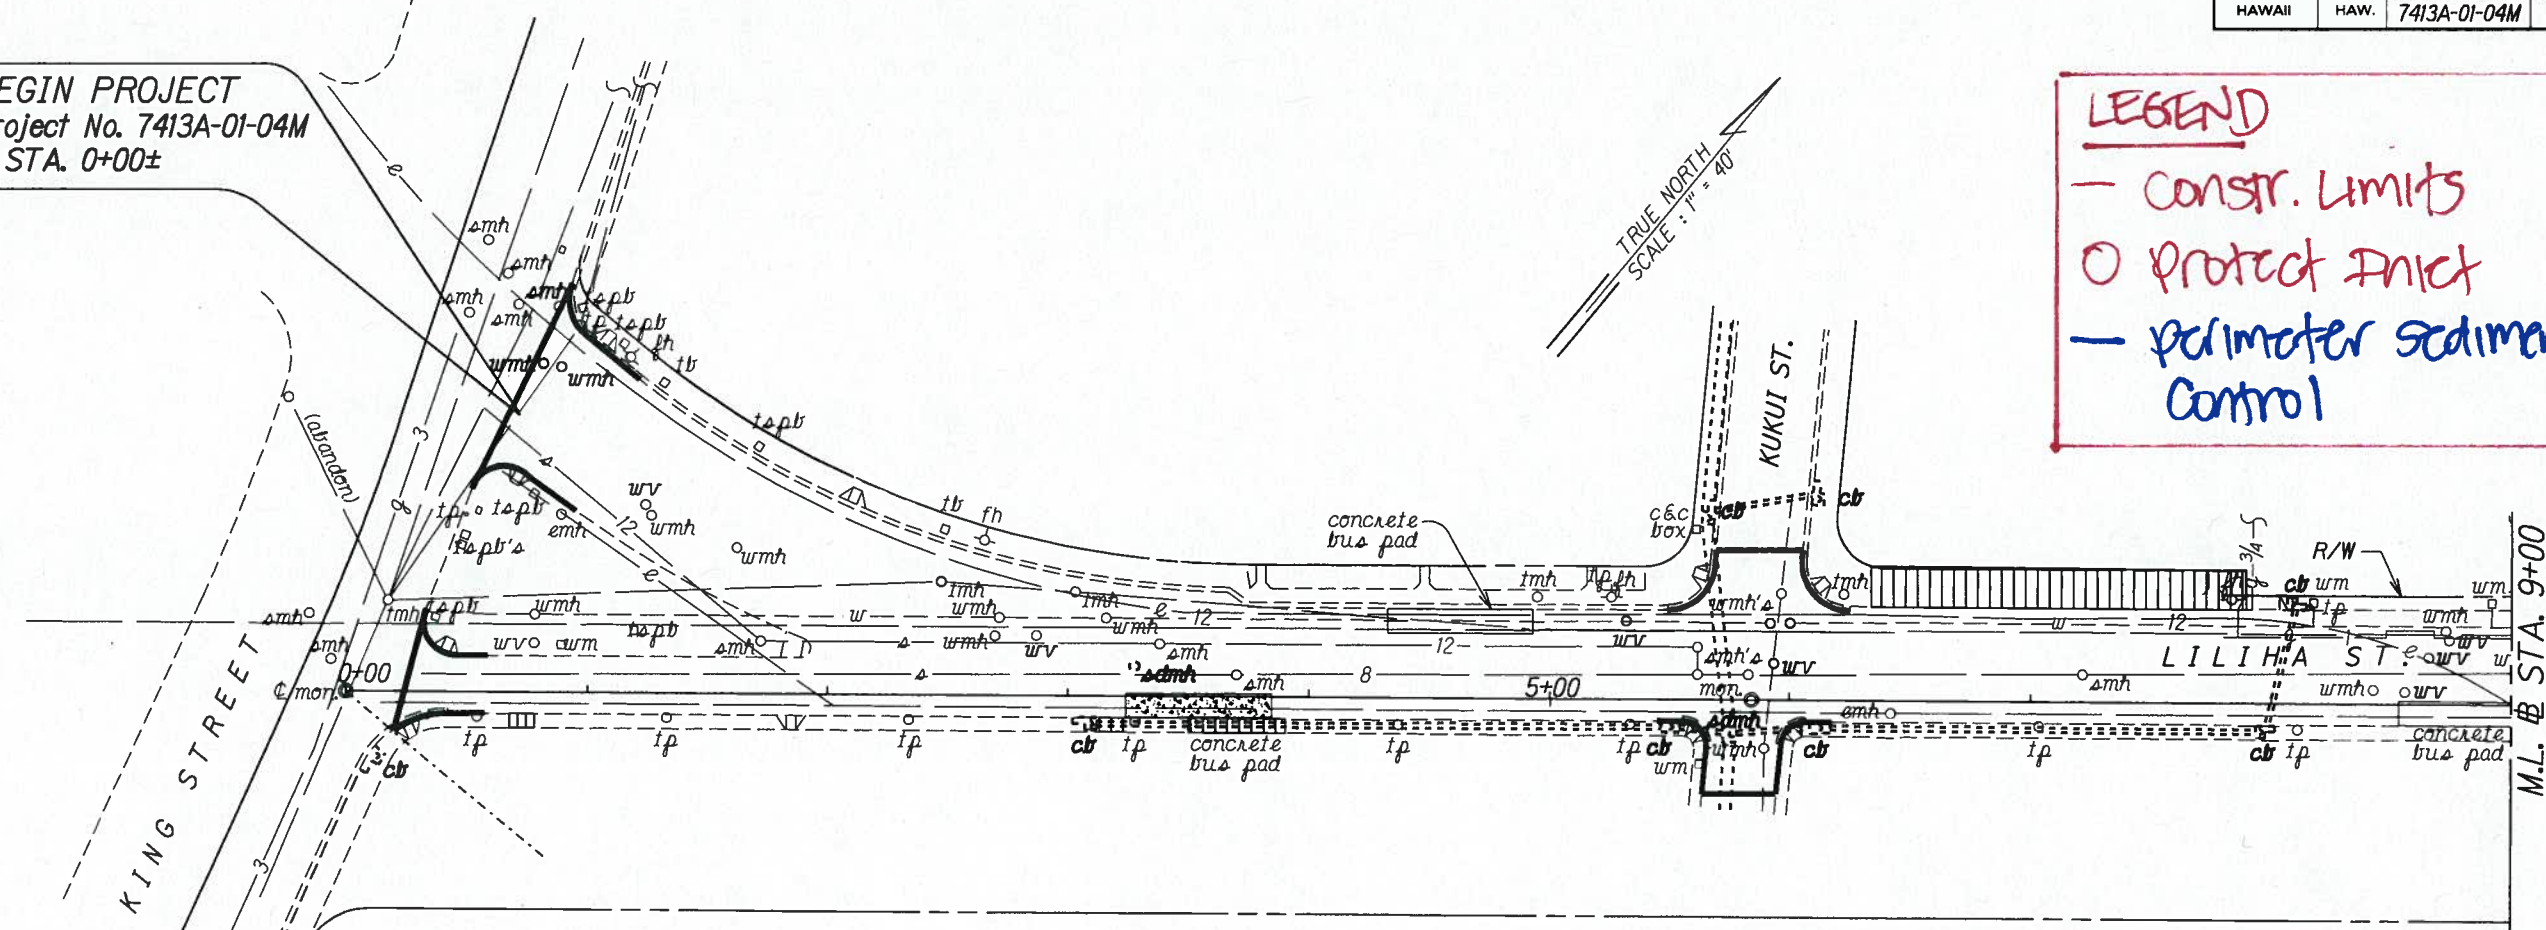

② CONSTRUCTION SEQUENCE DIAG.
RAMP ⑥ to SCHOOL ST.

- ① Install Thicket Protection + Perimeter Sediment Control
- ③ construct roadway (Install Bridge Endpost connection)
- ④ Remove BMPs

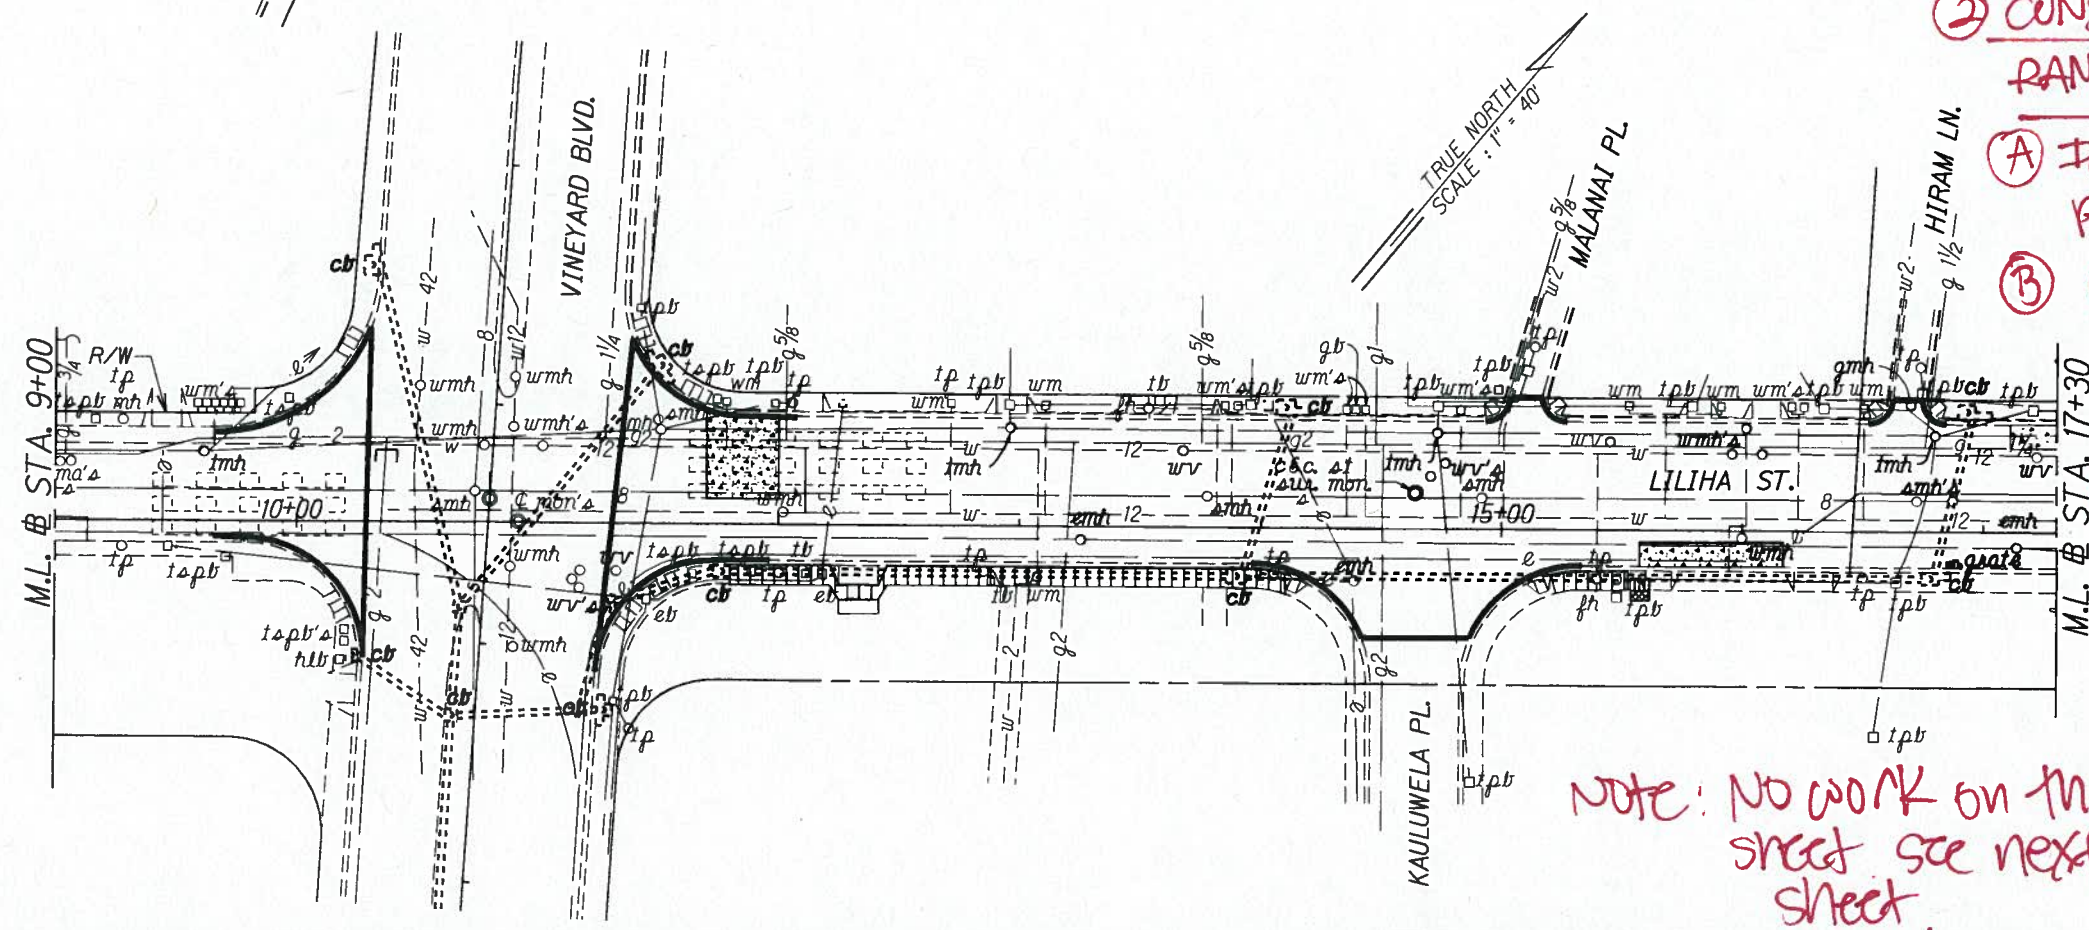

NOTE: NO WORK ON THIS sheet see next sheet.

ORIGINAL PLAN
DATE: 8/13/07
DESIGNED BY: Michael Howells, dd/mm
CHECKED BY: Cary Cheng
NOTED BY: N. 2/10/08

STATE OF HAWAII
DEPARTMENT OF TRANSPORTATION
HIGHWAYS DIVISION


PLAN

LILIHA STREET REHABILITATION
North King Street to School Street
Project No. 7413A-01-04M

Scale: 1" = 40' Date: Sept, 2007

SHEET No. 1 OF 2 SHEETS

FED. ROAD DIST. NO.	STATE	PROJ. NO.	FISCAL YEAR	SHEET NO.	TOTAL SHEETS
HAWAII	HAW.	7413A-01-04M	2007	9	18

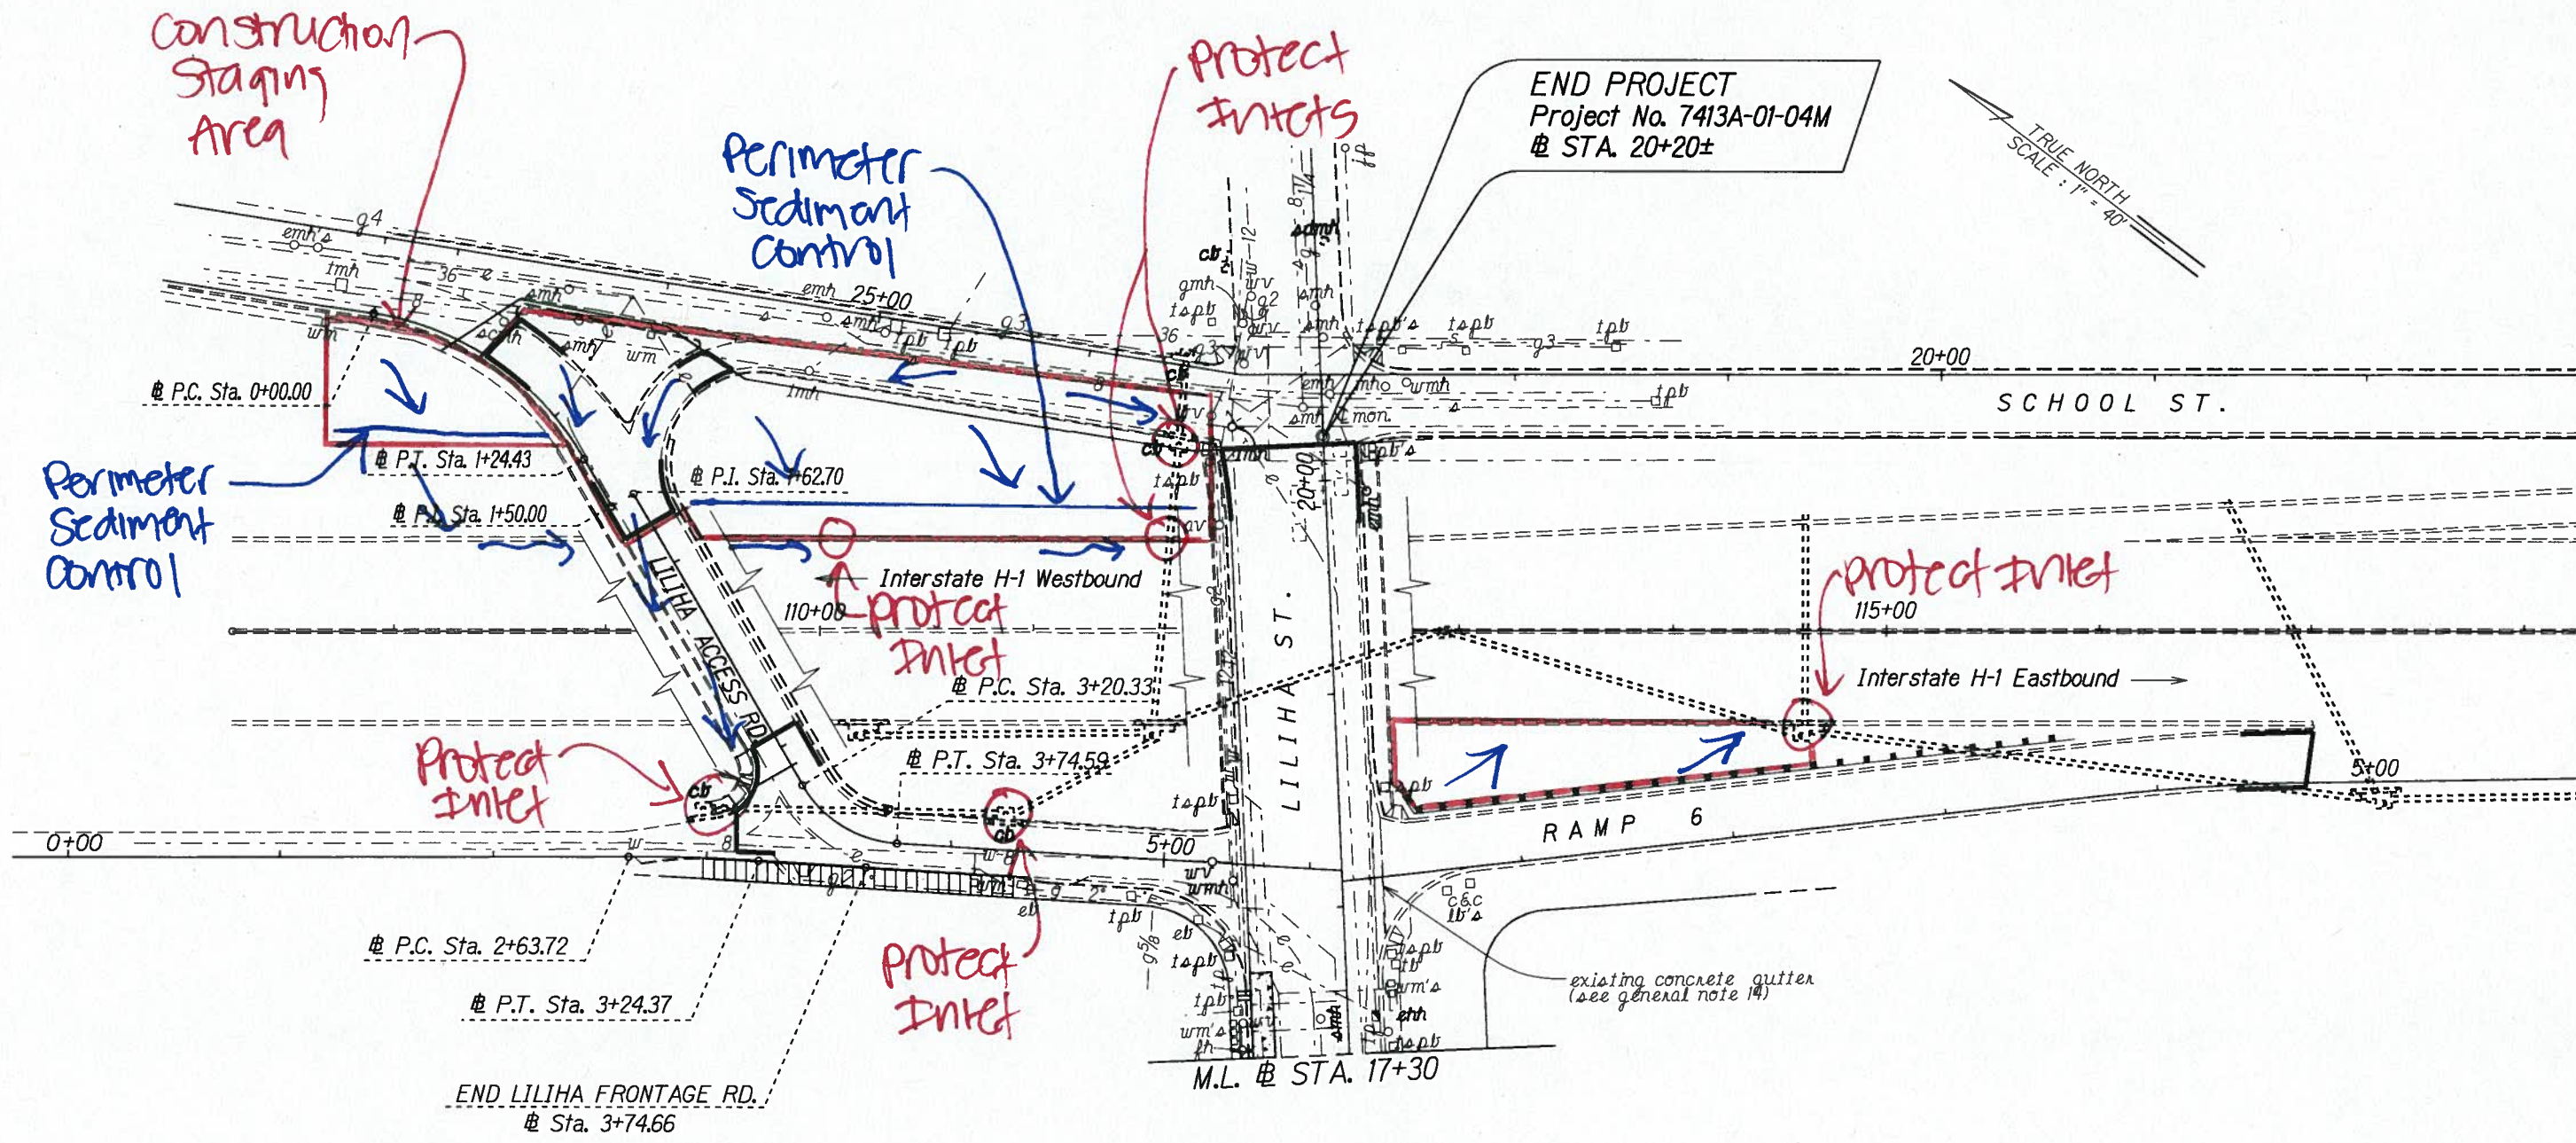

DESIGNED BY	DATE
DRAWN BY	8/13/03
CHECKED BY	
NOTED BY	
ORIGINAL PLAN	

② CONSTRUCTION SEQUENCE DIAGRAM
RAMP 6 TO SCHOOL STREET (CONT.)

STATE OF HAWAII
DEPARTMENT OF TRANSPORTATION
HIGHWAYS DIVISION

PLAN
LILIHA STREET REHABILITATION
North King Street to School Street
Project No. 7413A-01-04M
Scale: 1" = 40'
Date: Sept, 2007

SHEET No. 2 OF 2 SHEETS


BEGIN PROJECT
Project No. 7413A-01-04M
STA. 0+00±

LEGEND


— Constr. Limits

○ protect Inlet

— Perimeter Sediment Control

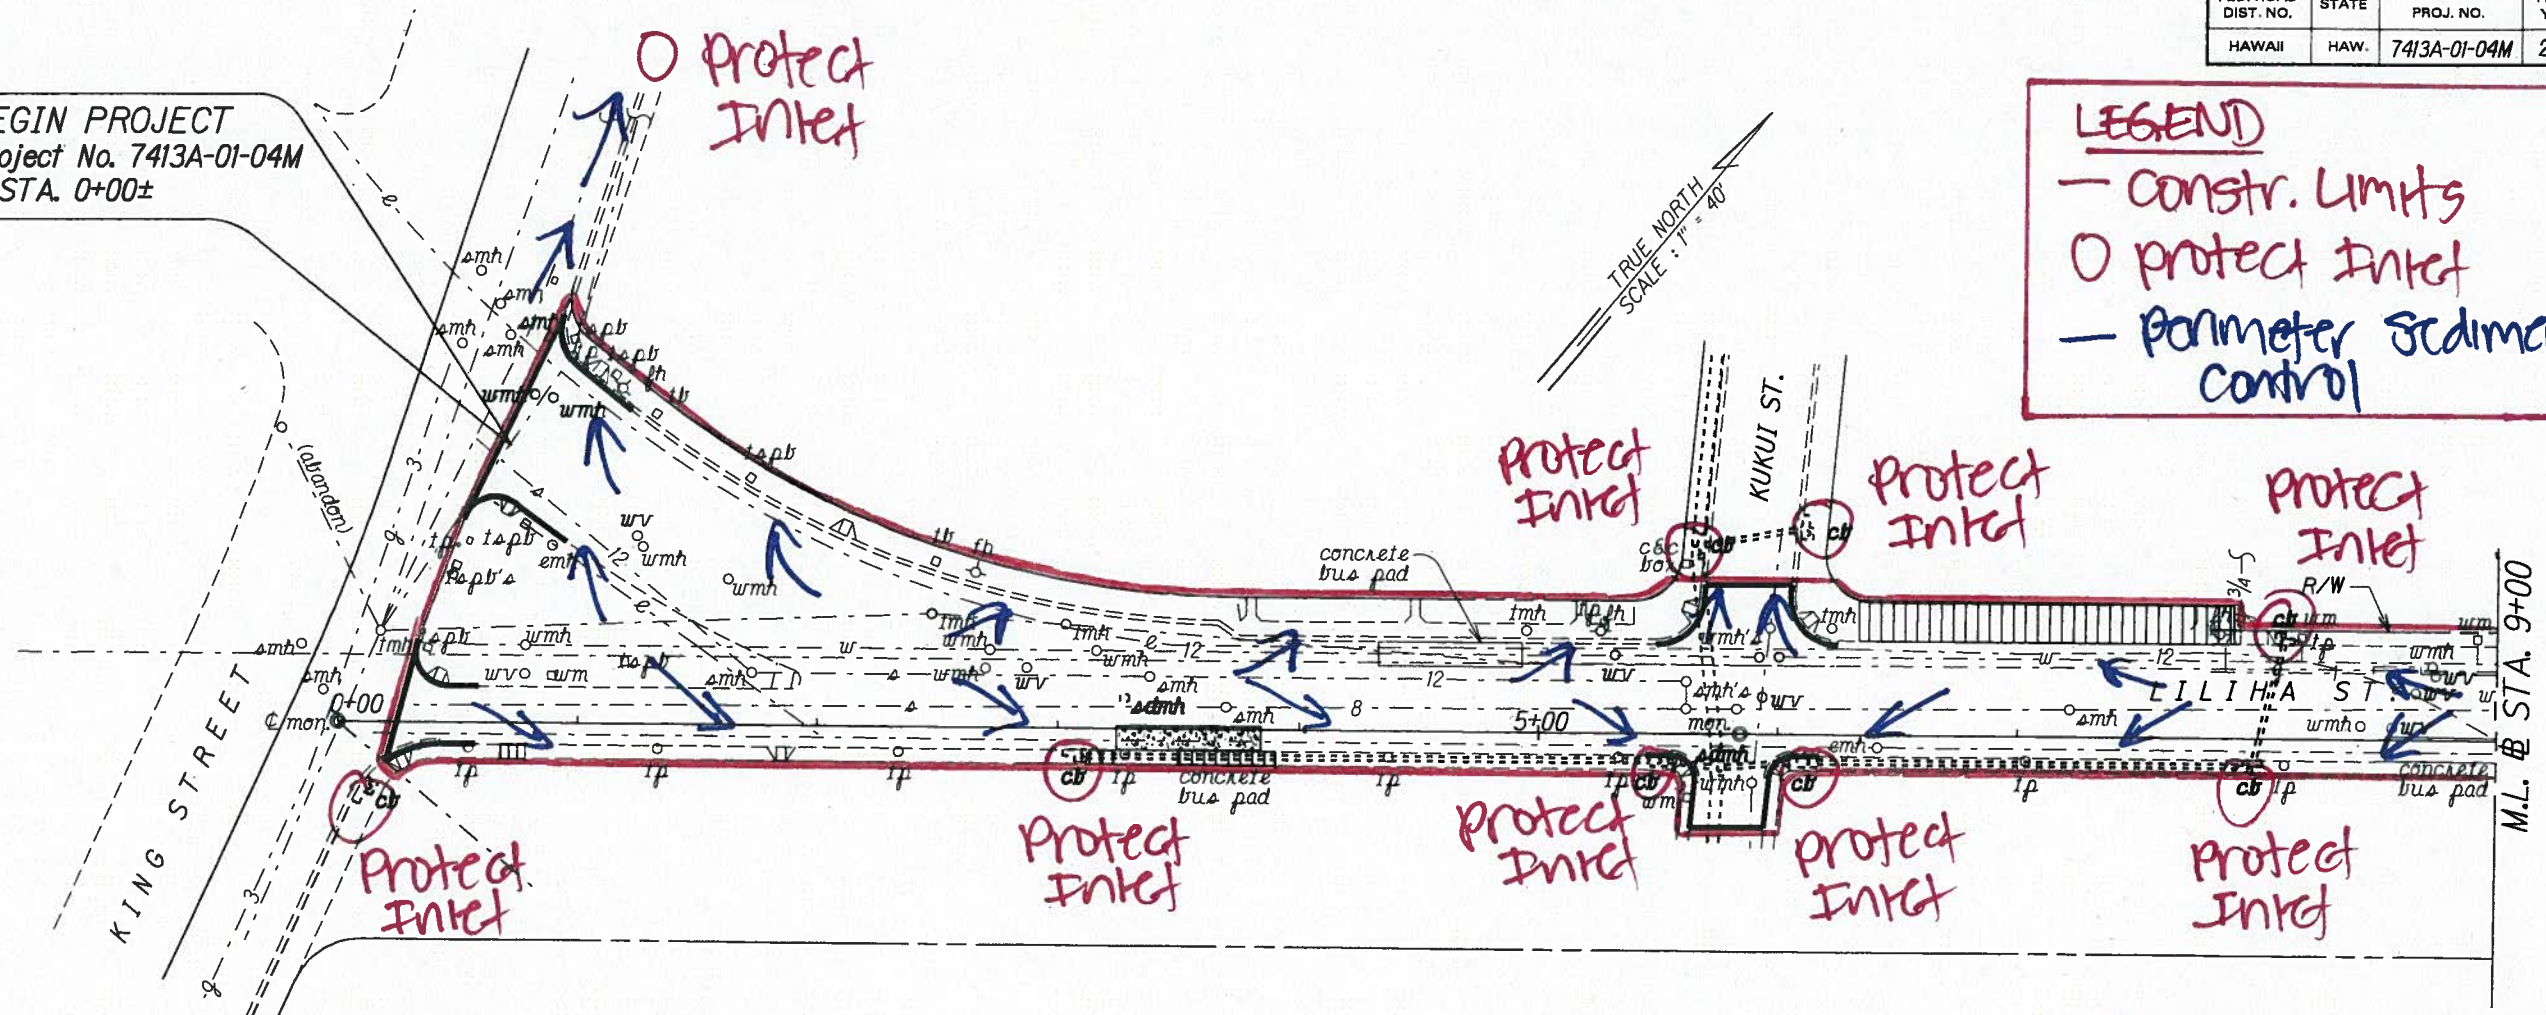

FED. ROAD DIST. NO.	STATE	PROJ. NO.	FISCAL YEAR	SHEET NO.	TOTAL SHEETS
HAWAII	HAW.	7413A-01-04M	2007	9	18

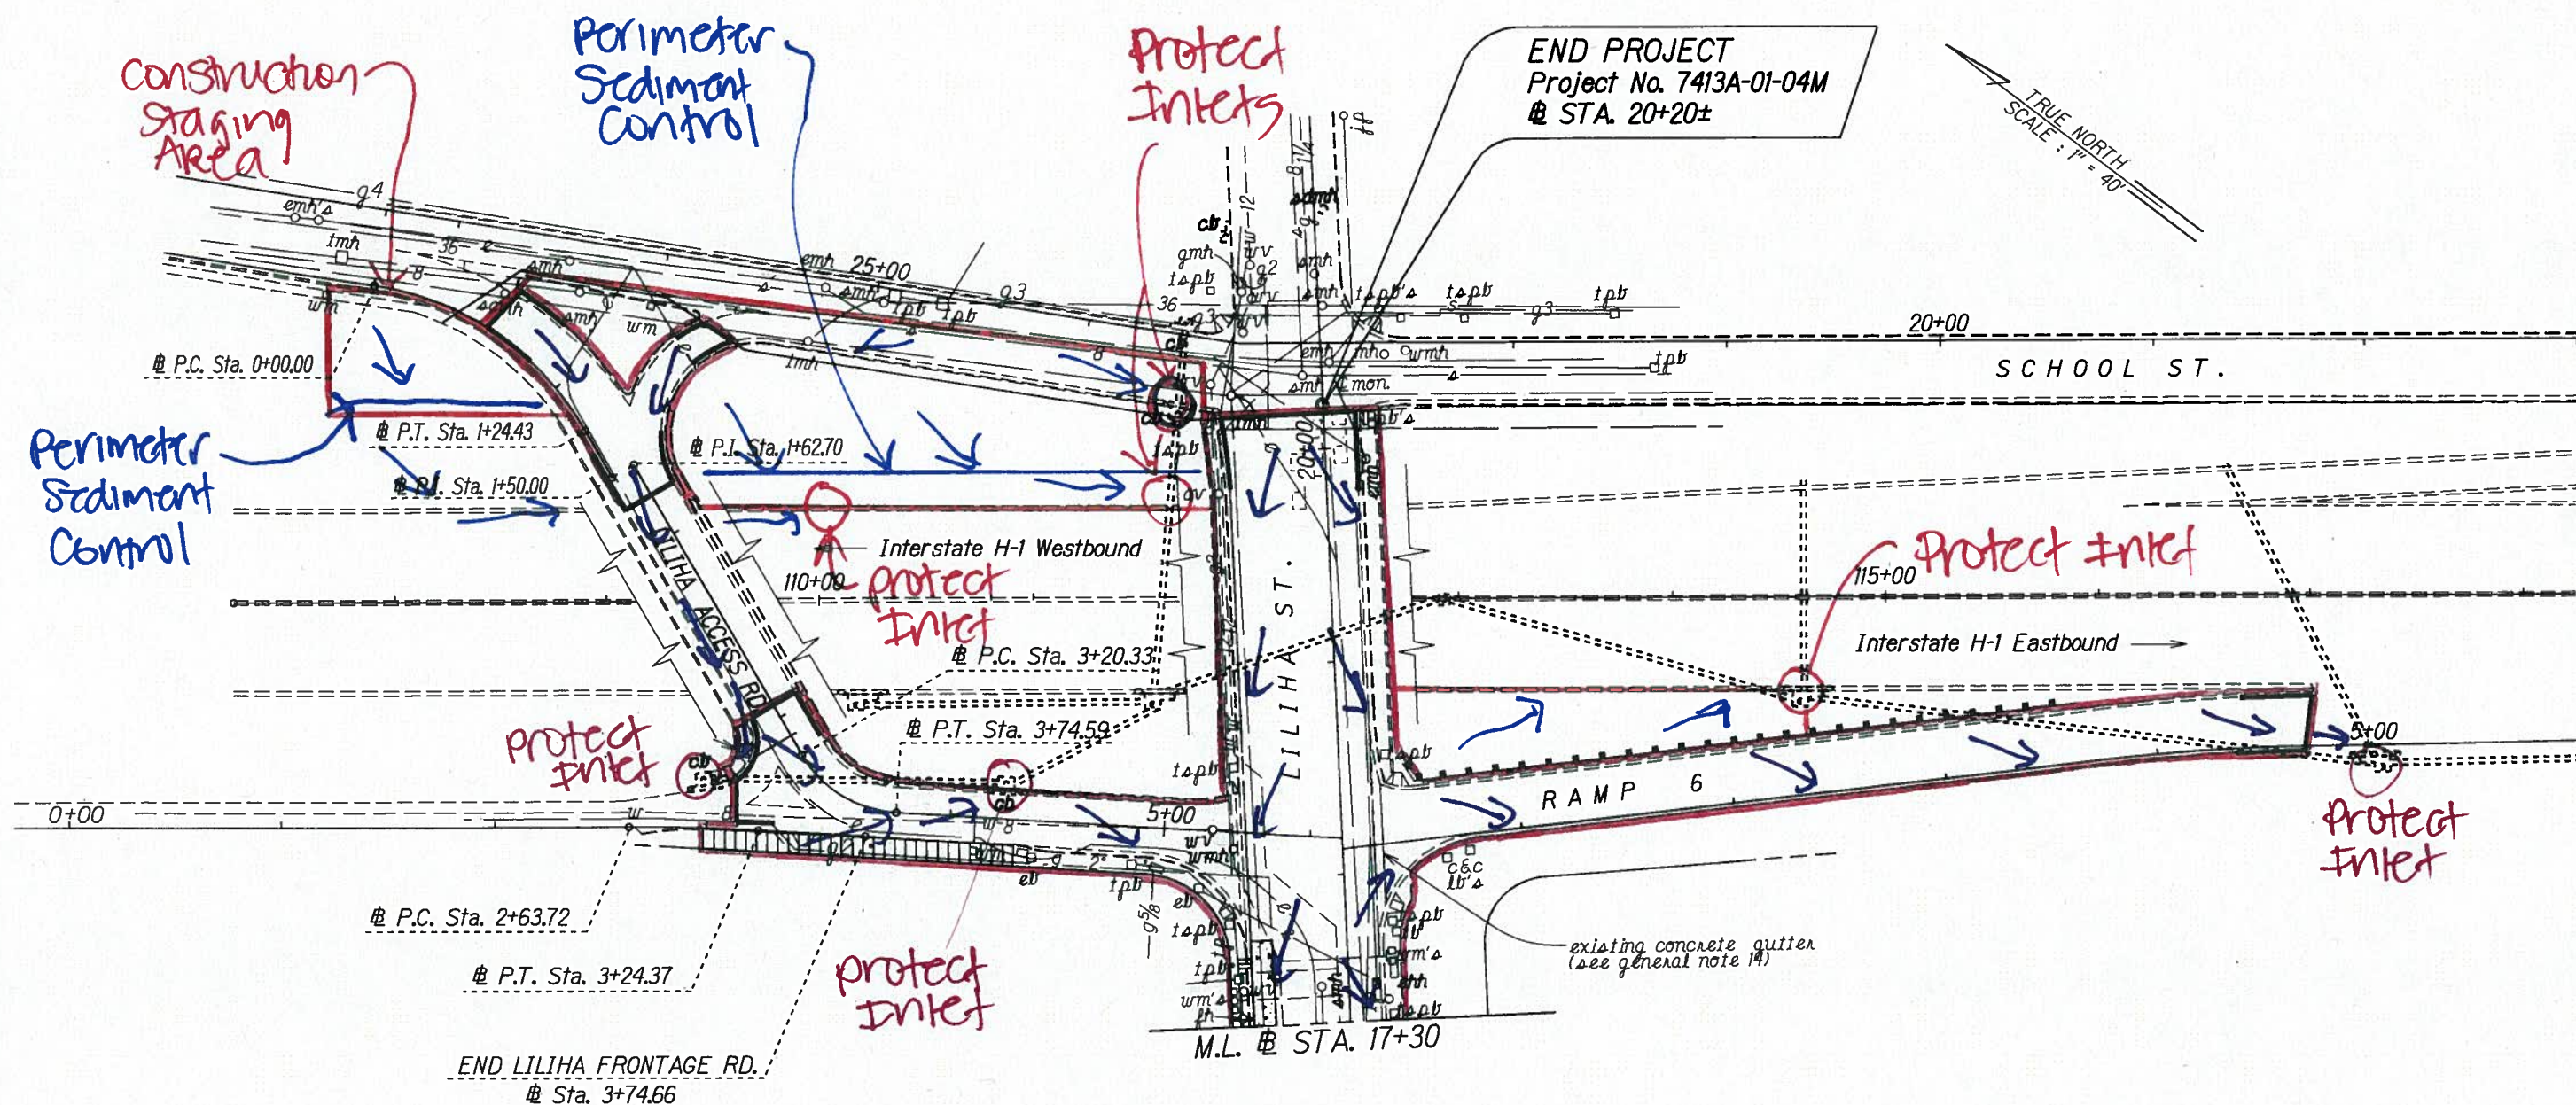


BMP PLAN - ROAD CONSTRUCTION (CONT.)

DESIGNED BY	DATE
DRAWN BY	8/23/07
CHECKED BY	
IN CHARGE	
APPROVED BY	
NOTED BY	
REVISIONS	

STATE OF HAWAII
DEPARTMENT OF TRANSPORTATION
HIGHWAYS DIVISION

PLAN
LILIHA STREET REHABILITATION
North King Street to School Street
Project No. 7413A-01-04M
Scale: 1" = 40' Date: Sept, 2007
SHEET No. 2 OF 2 SHEETS

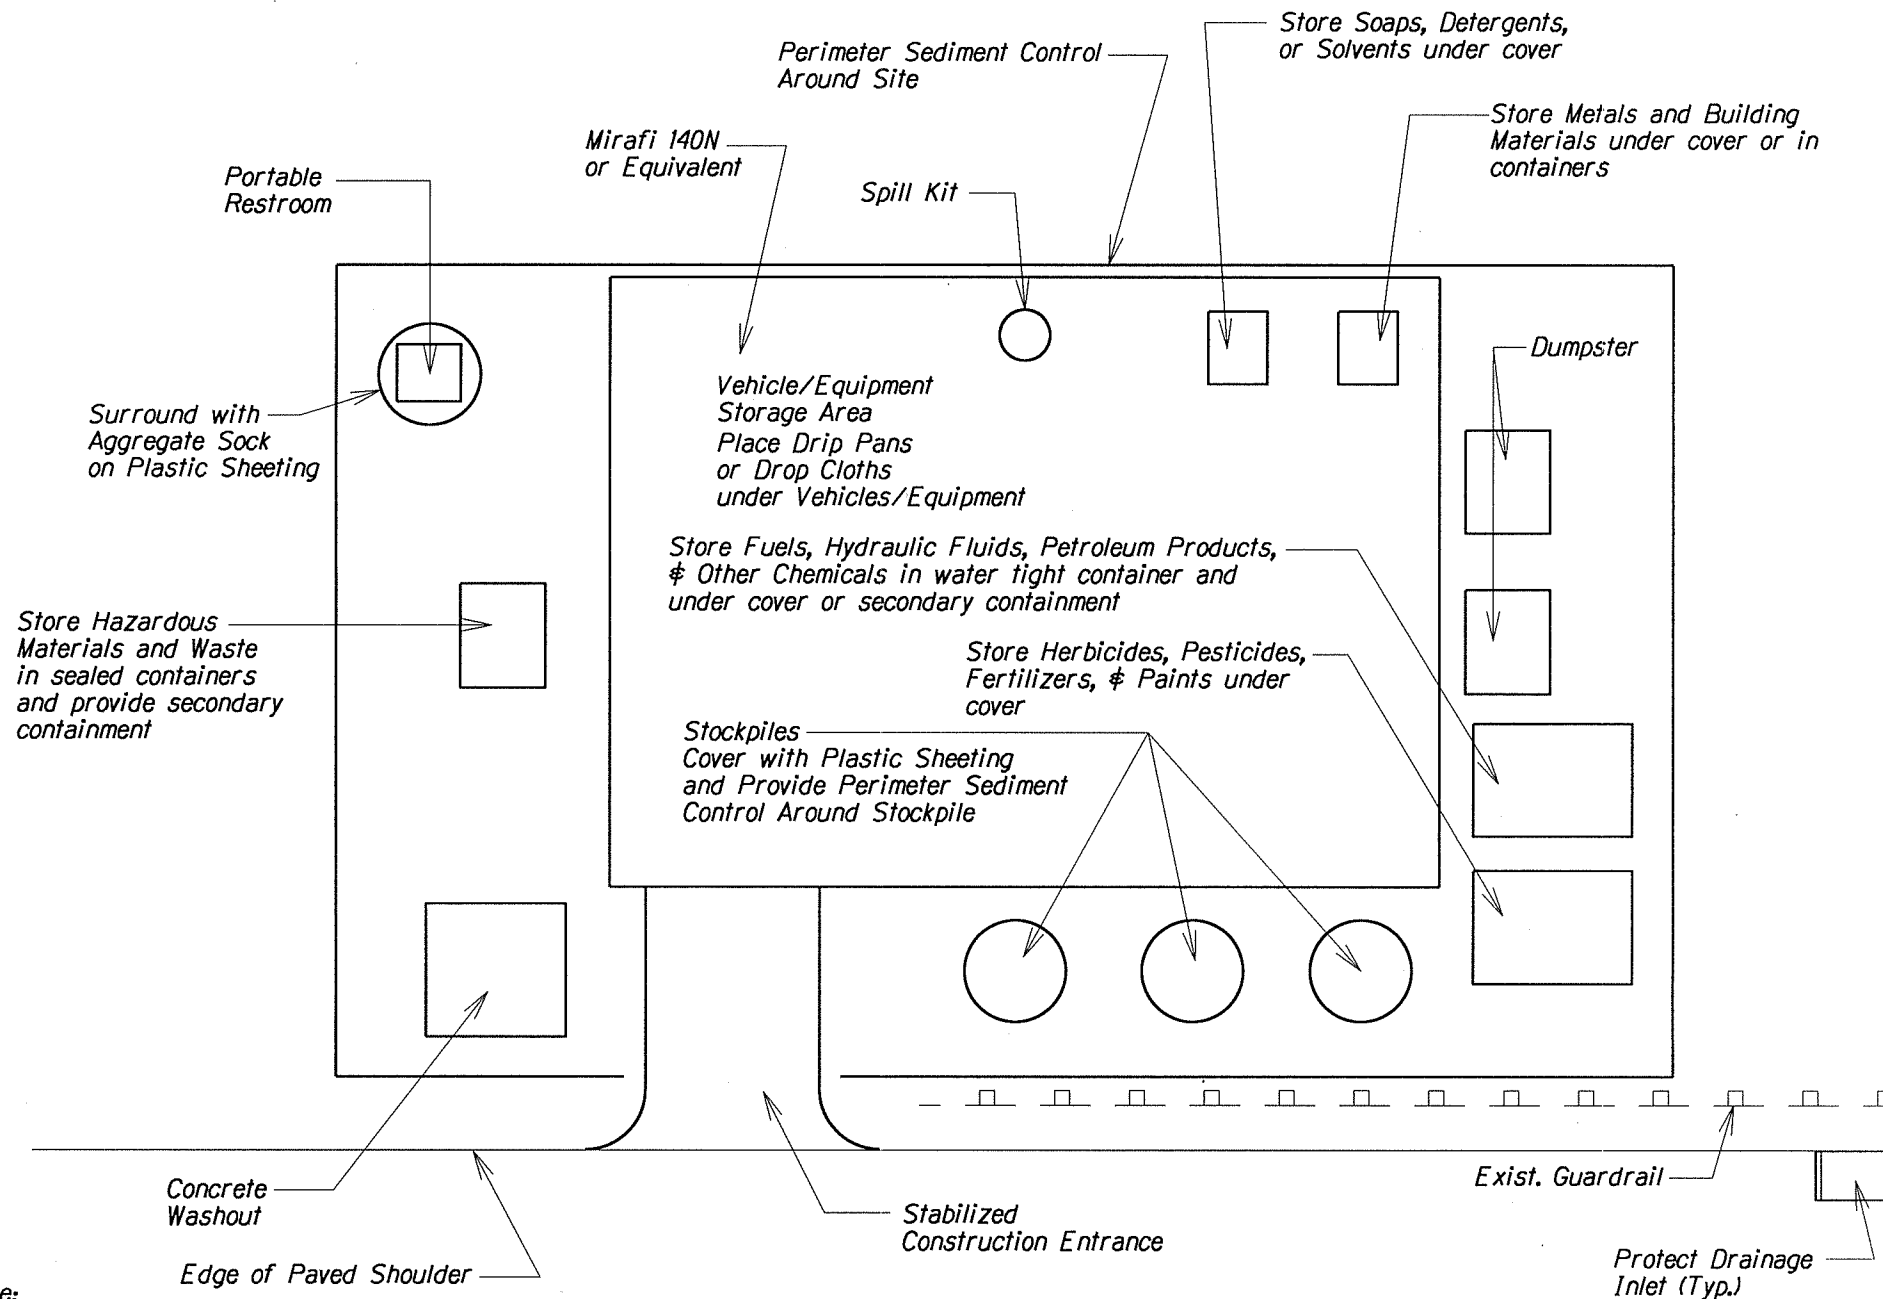


Note:

- 1) Restore area to equivalent of original condition once construction is completed.
- 2) Contractor shall ensure proper protection for Staging/Storage Area.
- 3) Do not maintain or wash vehicles on-site. Provide appropriate BMPs if Contractor elects to do so.

STAGING/STORAGE AREA

Not to Scale

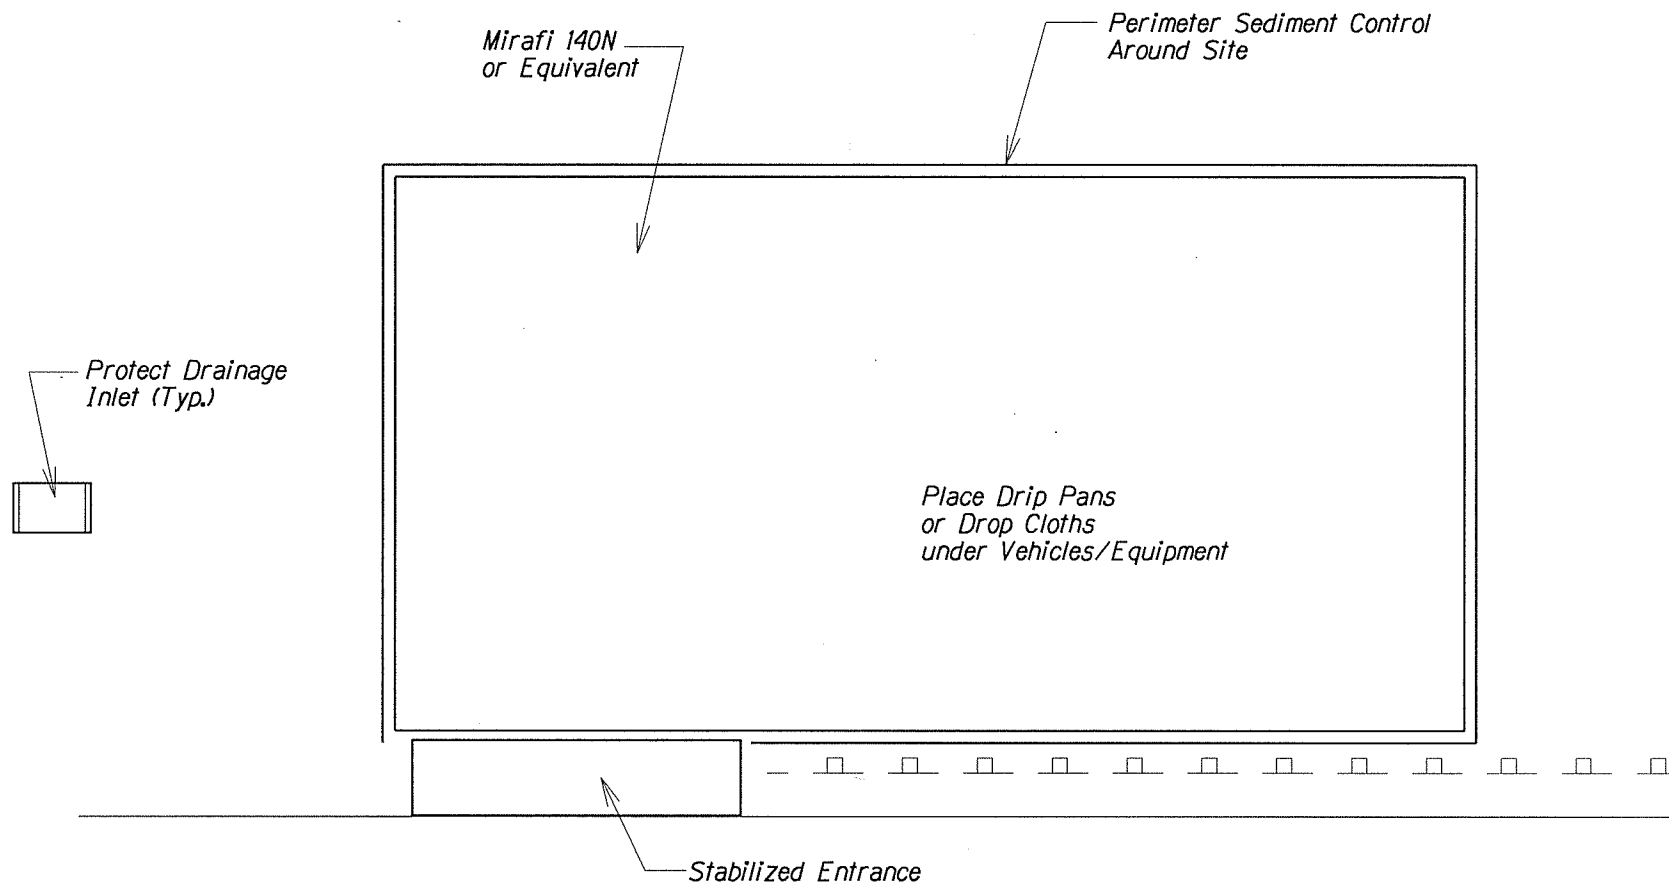

Note:

- 1) Restore area to equivalent of original condition once construction is completed.
- 2) Contractor shall ensure proper protection for Equipment Storage Area.

EQUIPMENT STORAGE AREA
Not to Scale