





VICINITY MAP




© 2002 DeLorme. 3-D TopoQuads®. Data copyright of content owner.
www.delorme.com


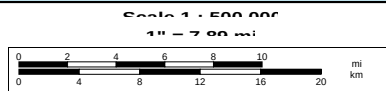


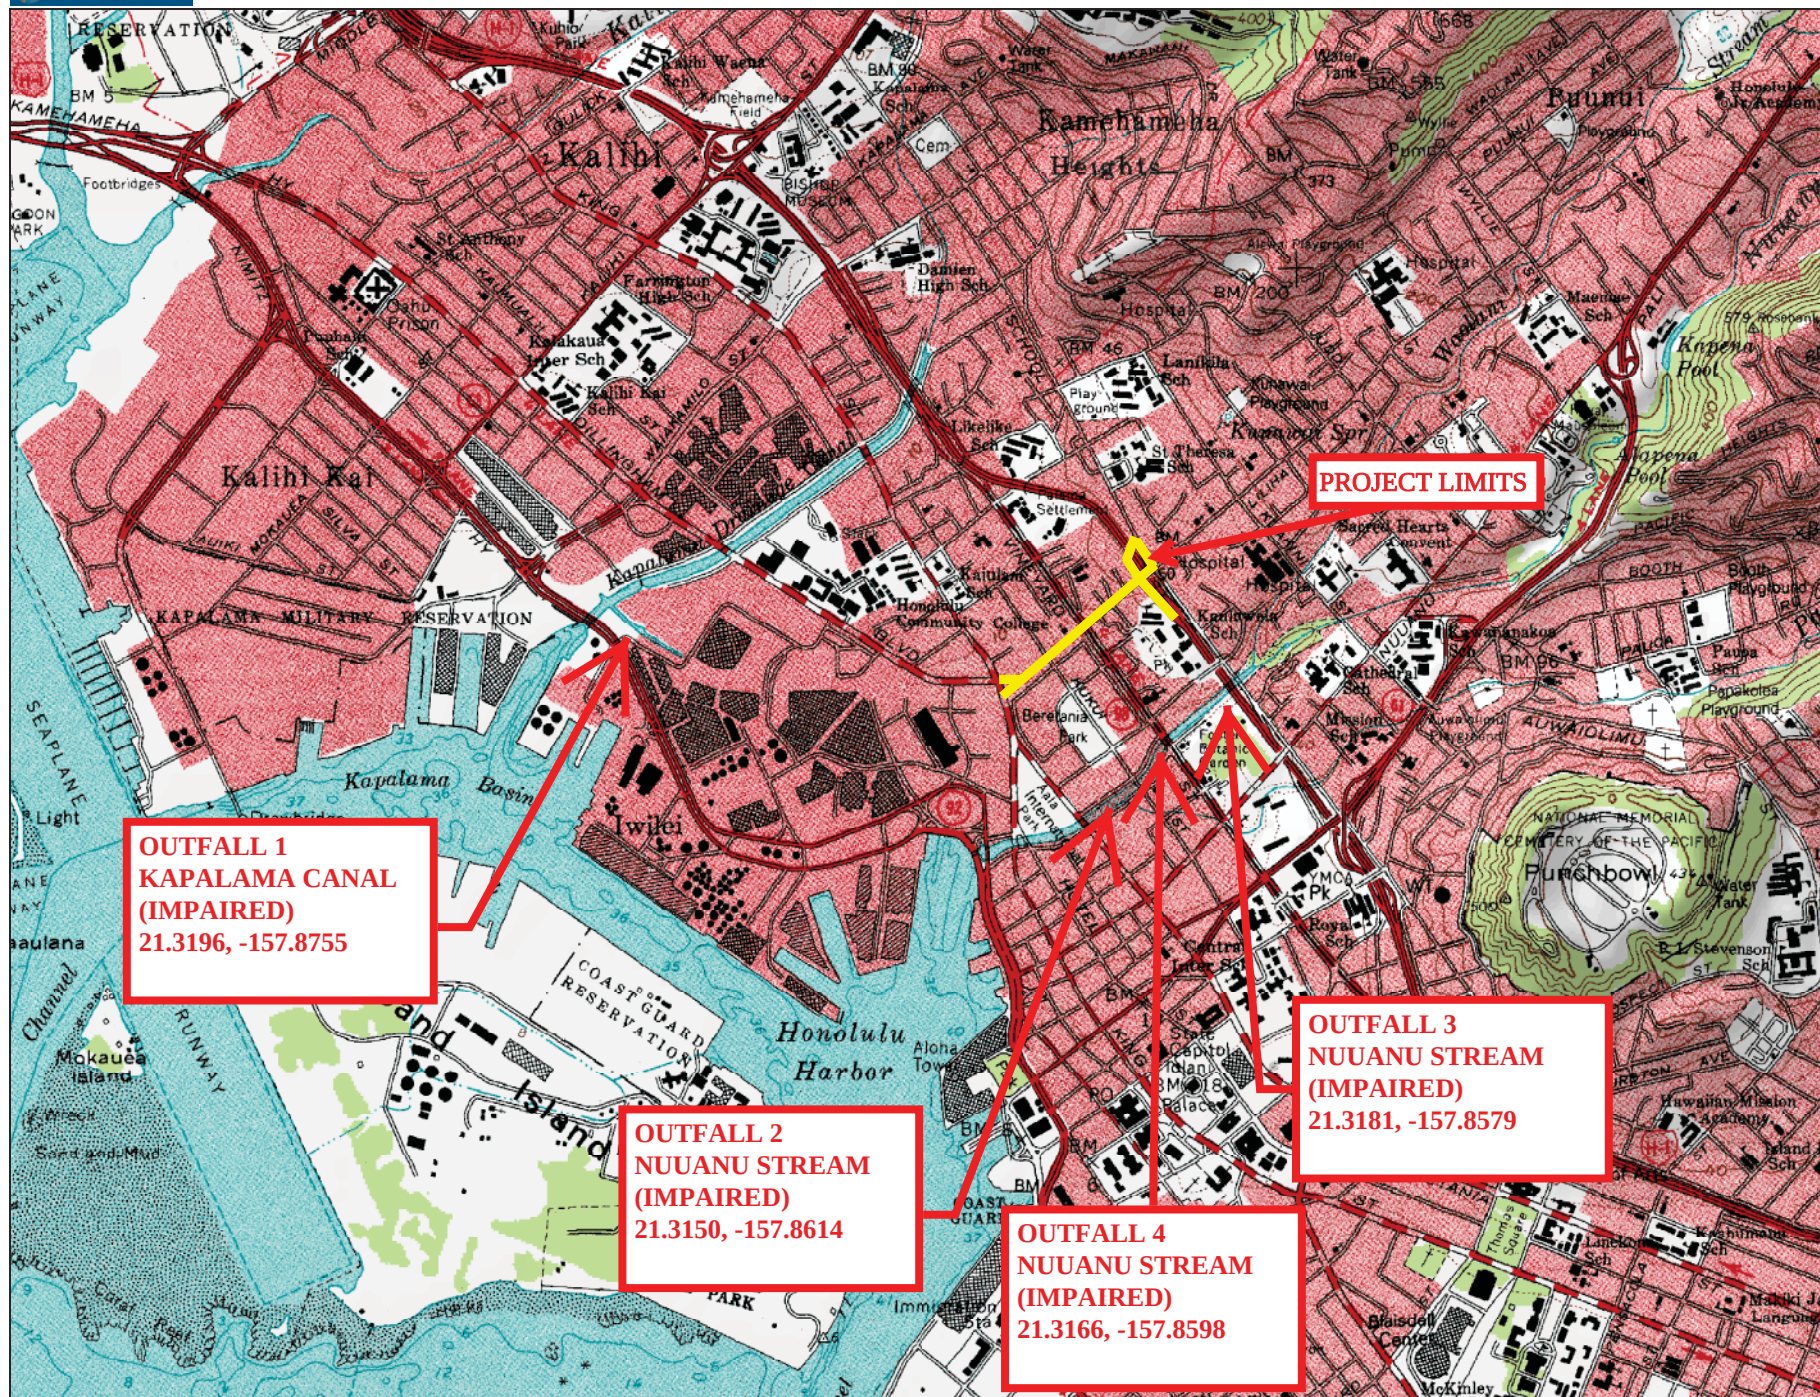

OUTFALL MAP

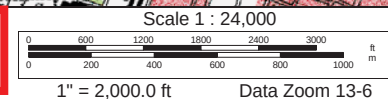

FED. ROAD DIST. NO.	STATE	PROJ. NO.	FISCAL YEAR	SHEET NO.	TOTAL SHEETS
HAWAII	HAW.	7413A-01-04M	2007	8	18

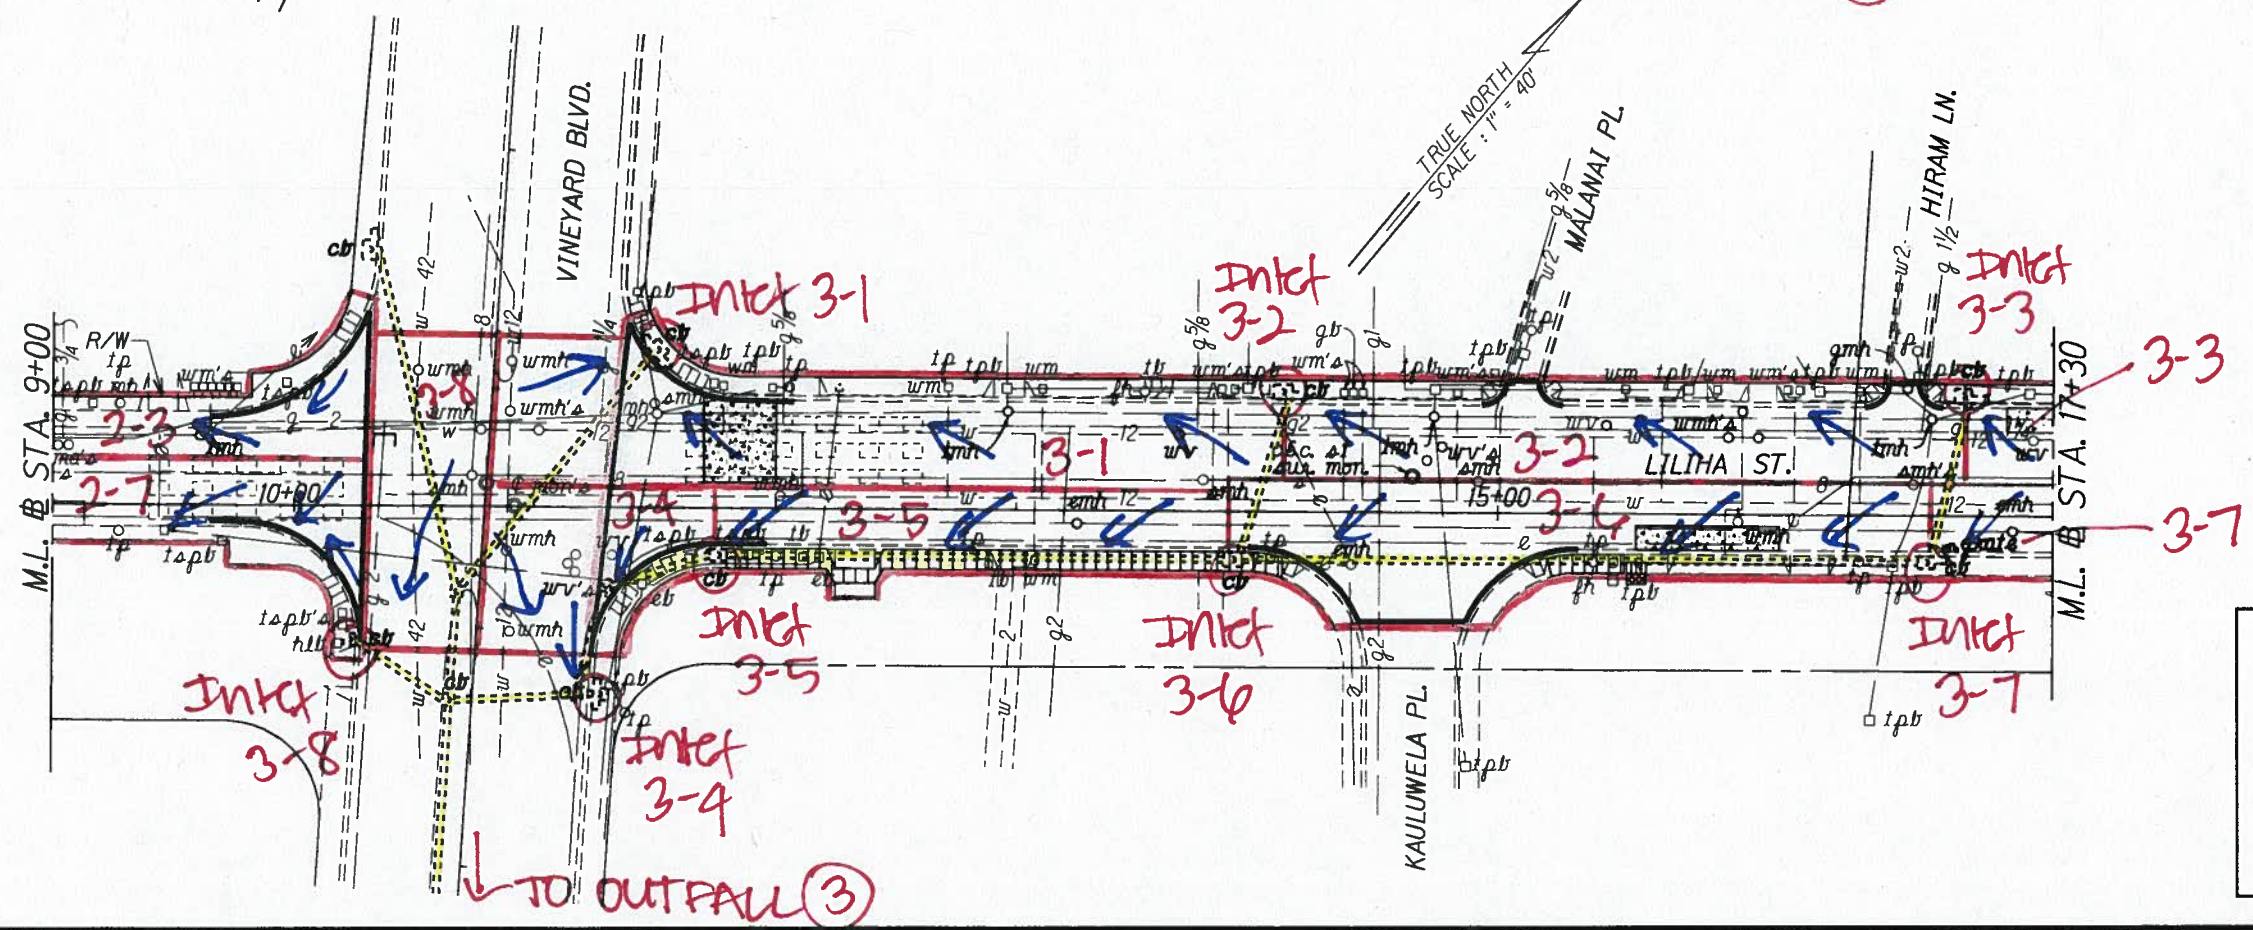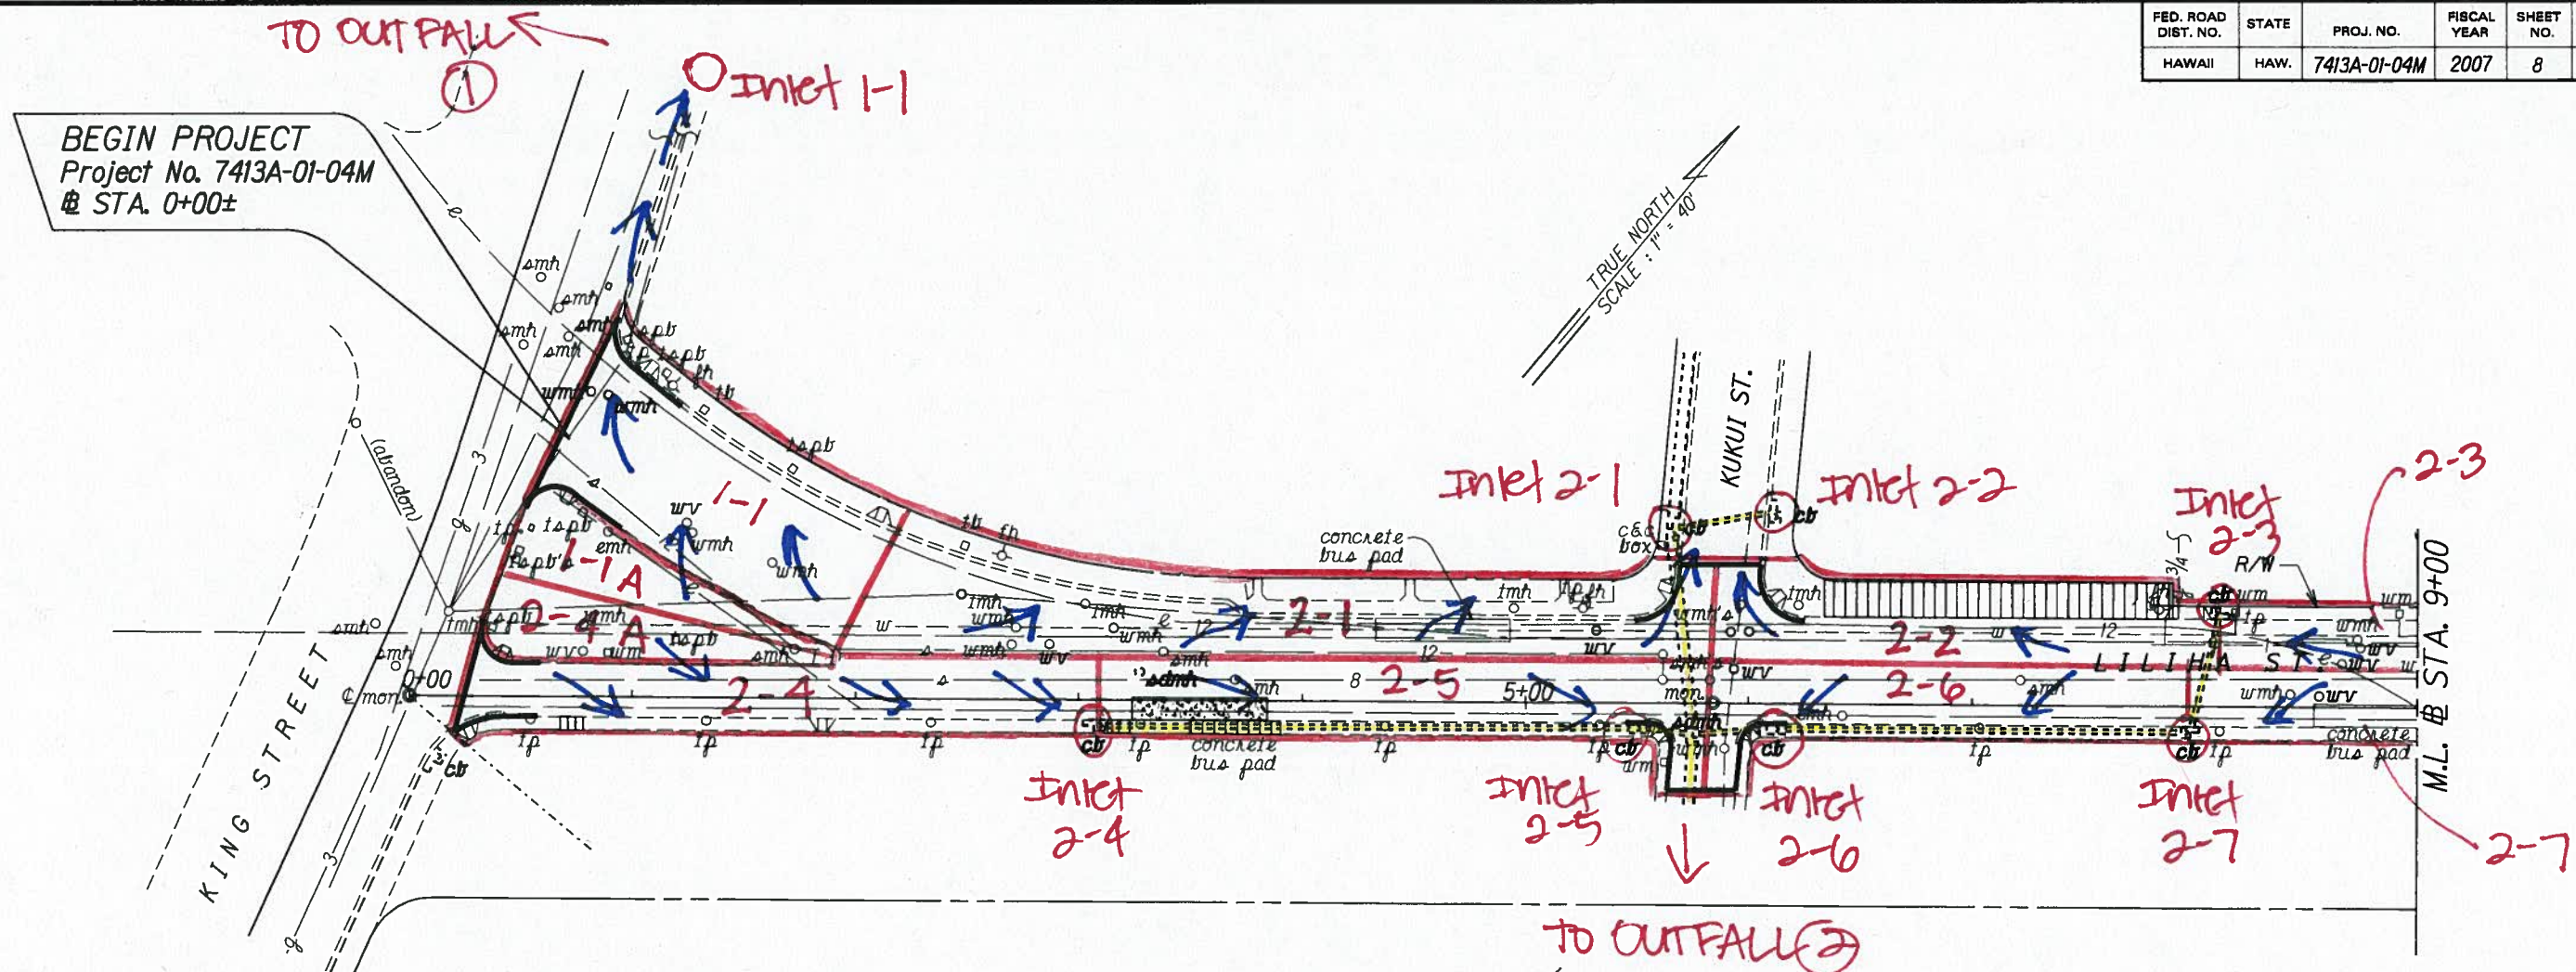


DESIGNED BY	DATE
DRAWN BY	8/15/2007
CHECKED BY	
NOTED BY	
QUANTITIES BY	
IN CHARGE	

STATE OF HAWAII
DEPARTMENT OF TRANSPORTATION
HIGHWAYS DIVISION

PLAN
LILIHA STREET REHABILITATION
North King Street to School Street
Project No. 7413A-01-04M
Scale: 1" = 40' Date: Sept, 2007
SHEET No. 1 OF 2 SHEETS

FED. ROAD DIST. NO.	STATE	PROJ. NO.	FISCAL YEAR	SHEET NO.	TOTAL SHEETS
HAWAII	HAW.	7413A-01-04M	2007	9	18

ORIGINAL PLAN	SURVEY PLOTTED BY	DATE
NOTE BOOK	DRAWN BY	8/13/03
QUANTITIES BY	DESIGNED BY	
CHECKED BY	CHARTERED BY	

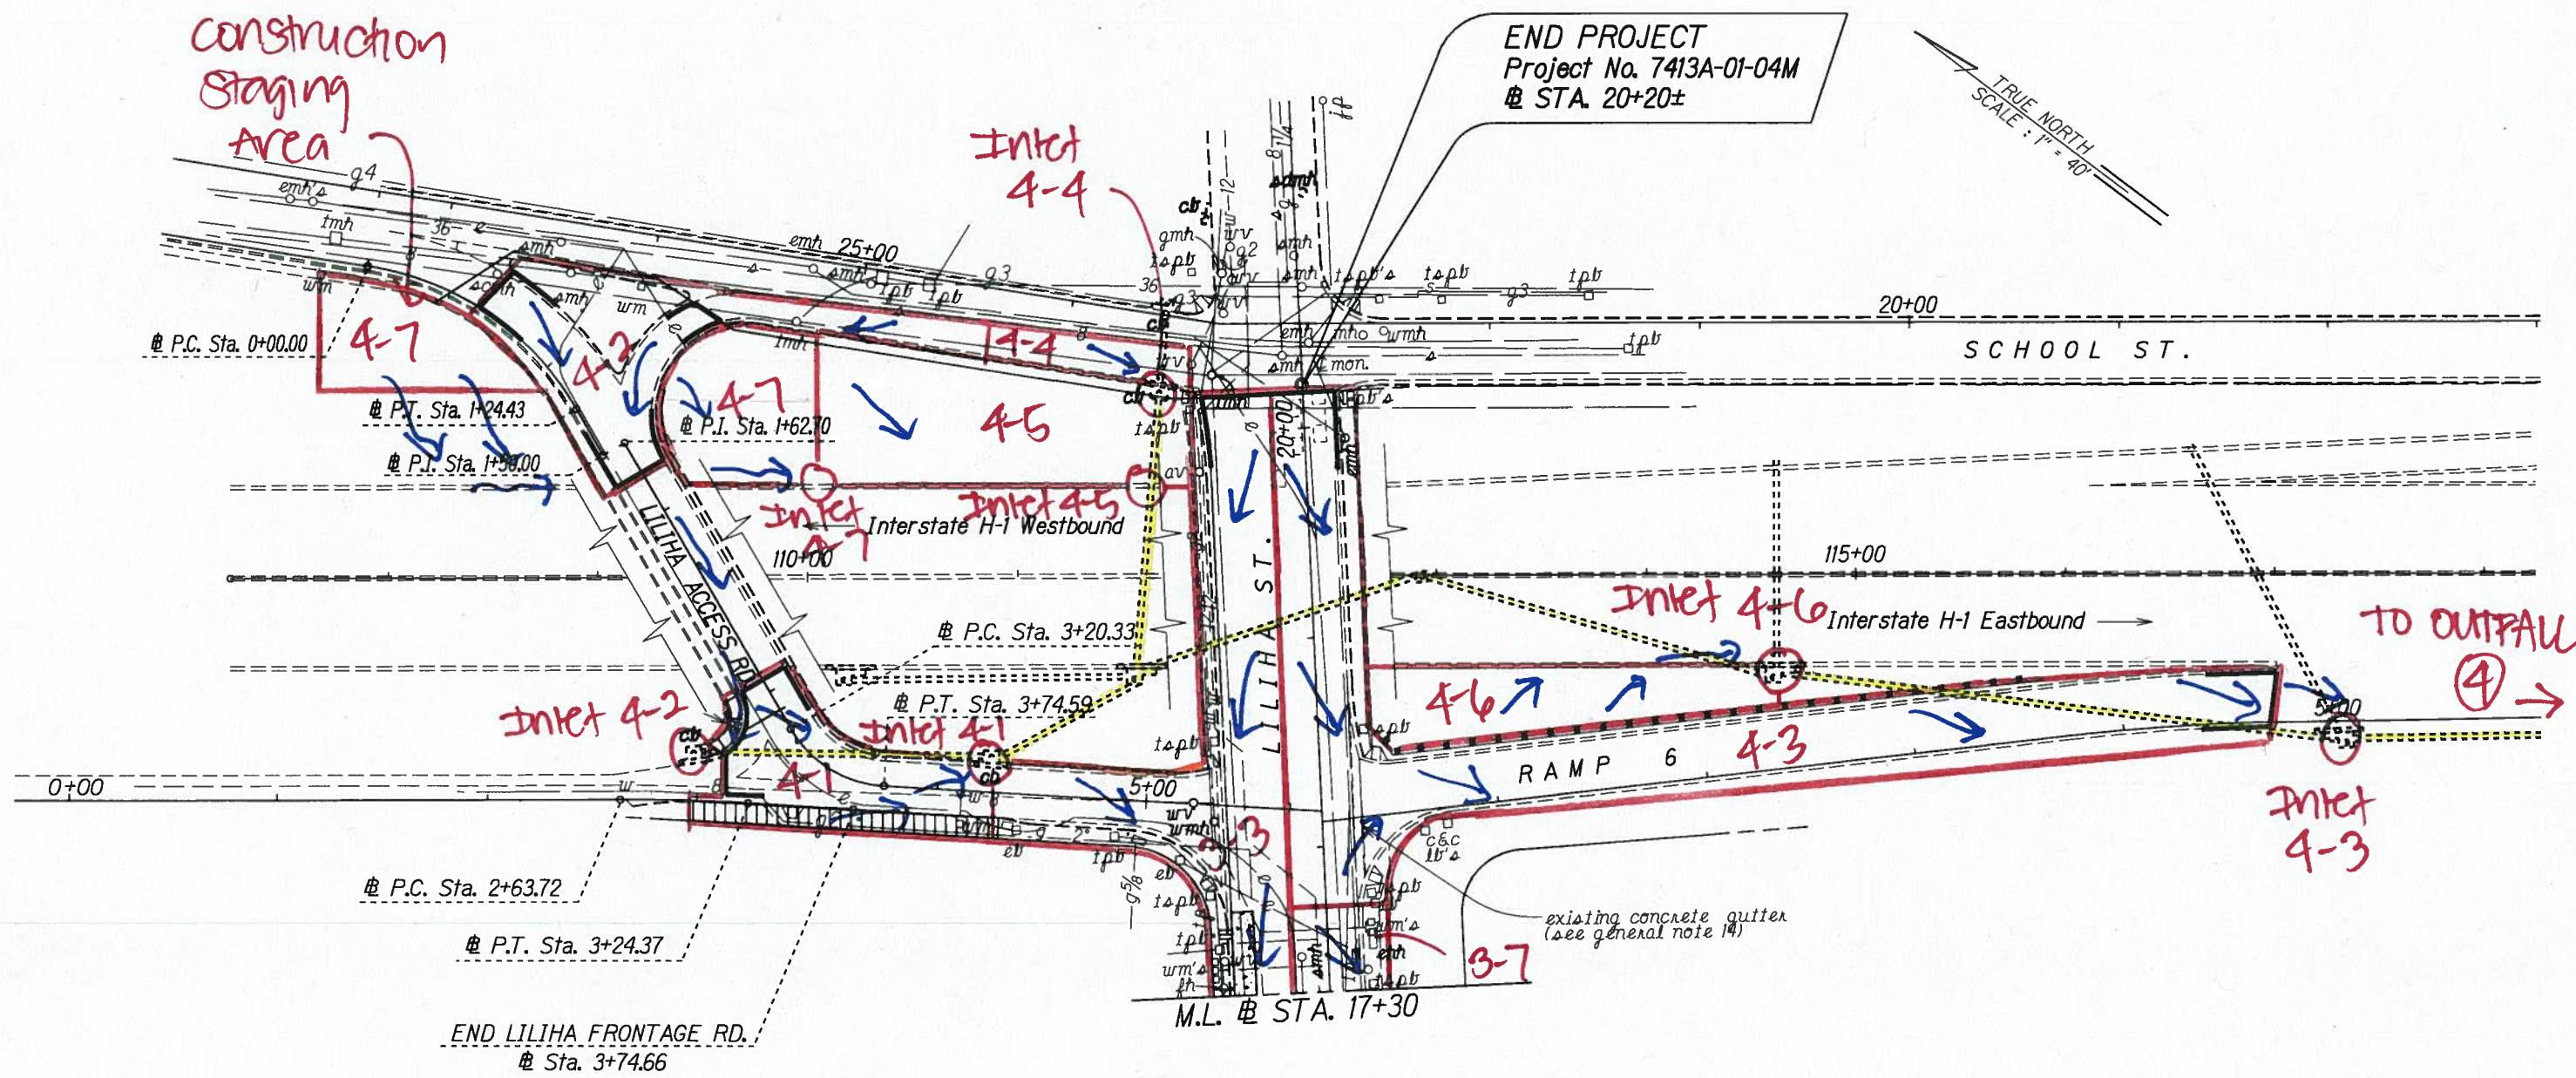

STATE OF HAWAII
DEPARTMENT OF TRANSPORTATION
HIGHWAYS DIVISION

PLAN

LILIHA STREET REHABILITATION
North King Street to School Street
Project No. 7413A-01-04M

Scale: 1" = 40' Date: Sept., 2007

SHEET No. 2 OF 2 SHEETS