

FED. ROAD DIST. NO.	STATE	PROJ. NO.	FISCAL YEAR	SHEET NO.	TOTAL SHEETS
HAWAII	HAW.	7413A-01-04M	2014	ADD. 29	62


AS-BUILT DRAWINGS

This certifies that the dimensions and details shown on this sheet reflect the dimensions and details, and specifications as constructed in the field.

KAIKOR CONSTRUCTION CO., INC.

DATE: 7/27/20

PARTIALLY RECONSTRUCT CURB RAMP TO TRANSITION INTO RECONSTRUCTED PCC SIDEWALK. PARTIAL RECONSTRUCTION OF CURB RAMP SHALL MEET CURRENT ADA REQUIREMENTS. REFER TO SHEET 18. PER FIELD ORDER NO. 1

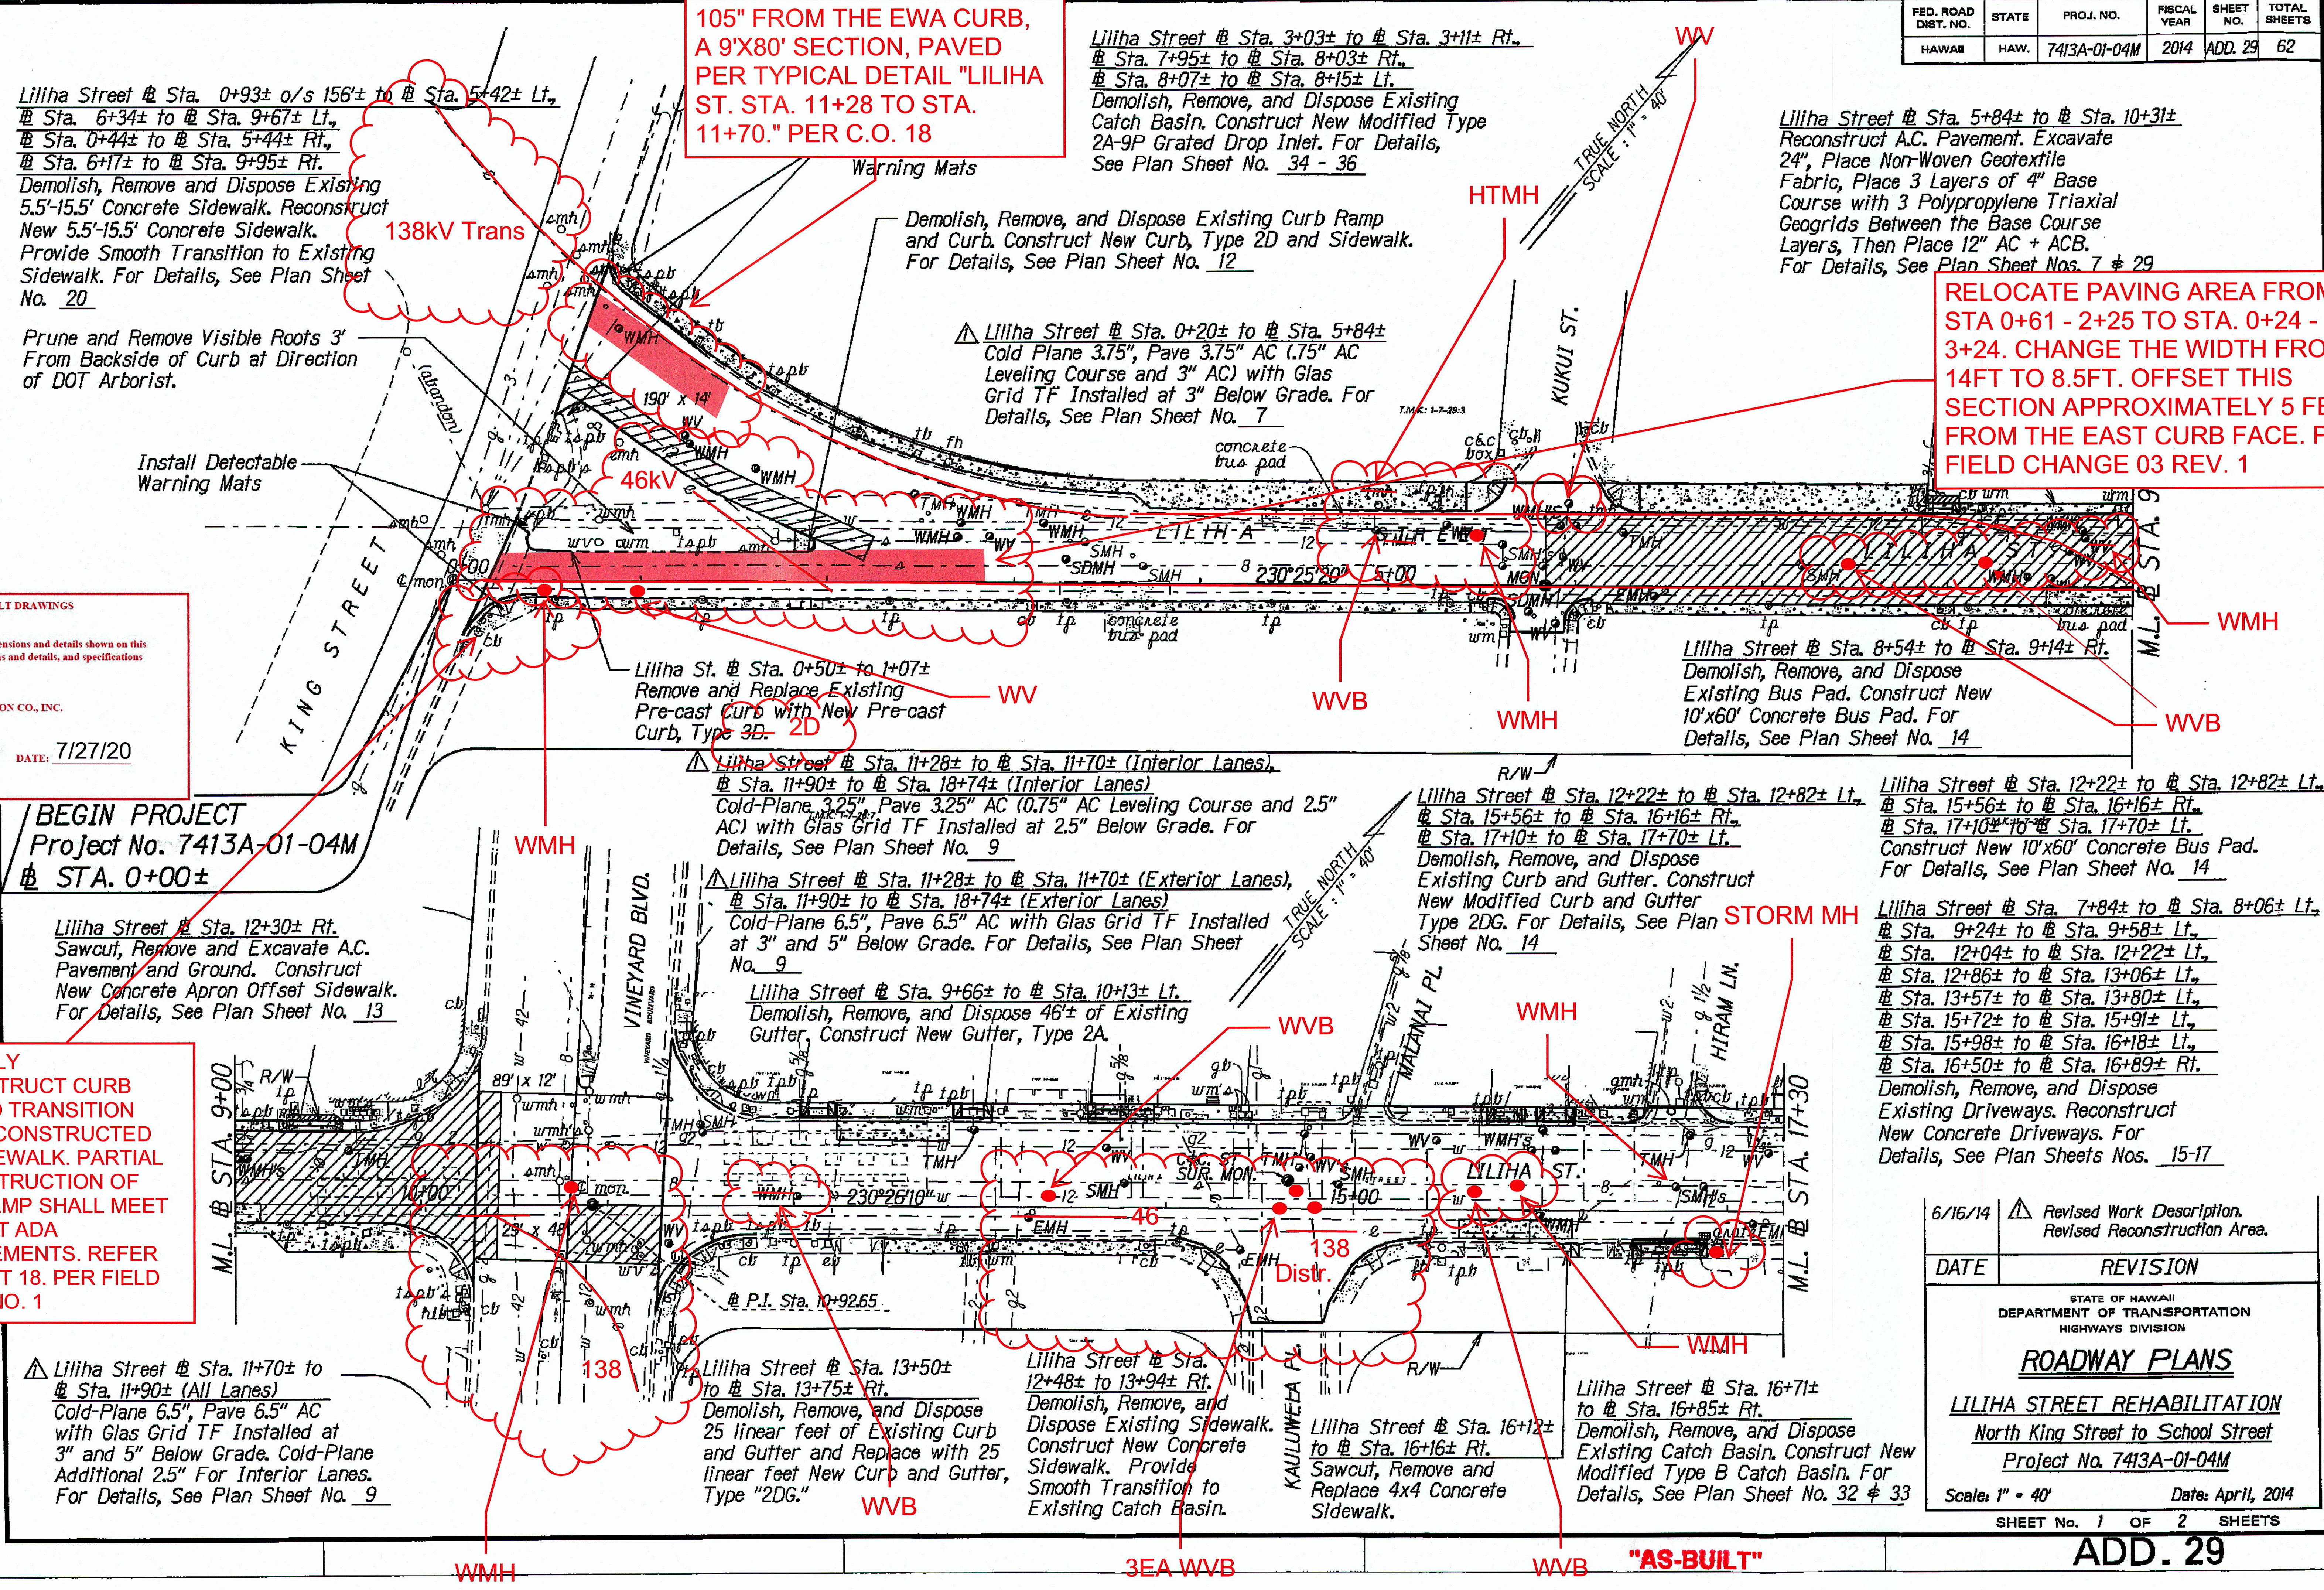

6/16/14	Revised Work Description. Revised Reconstruction Area.
DATE	REVISION
STATE OF HAWAII DEPARTMENT OF TRANSPORTATION HIGHWAYS DIVISION	
ROADWAY PLANS	
LILIHA STREET REHABILITATION North King Street to School Street Project No. 7413A-01-04M	
Scale: 1" = 40'	Date: April, 2014
SHEET No. 1 OF 2 SHEETS	

