



FED. ROAD DIST. NO.	STATE	FED. AID PROJ. NO.	FISCAL YEAR	SHEET NO.	TOTAL SHEETS
HAWAII	HAW.	HSIP-7413(2)	2011	ADD.17	29

Notes:

- The contractor shall at his own cost, work with Oceanic cable and Hawaiian Telcom to resolve any conflicts between overhead utility lines and new traffic signal mast arms, inclusive of but not limited to adjusting the height and/or slack of the utility lines.
- Contractor shall install interconnect cables (12pr#19) in fabric subduct.

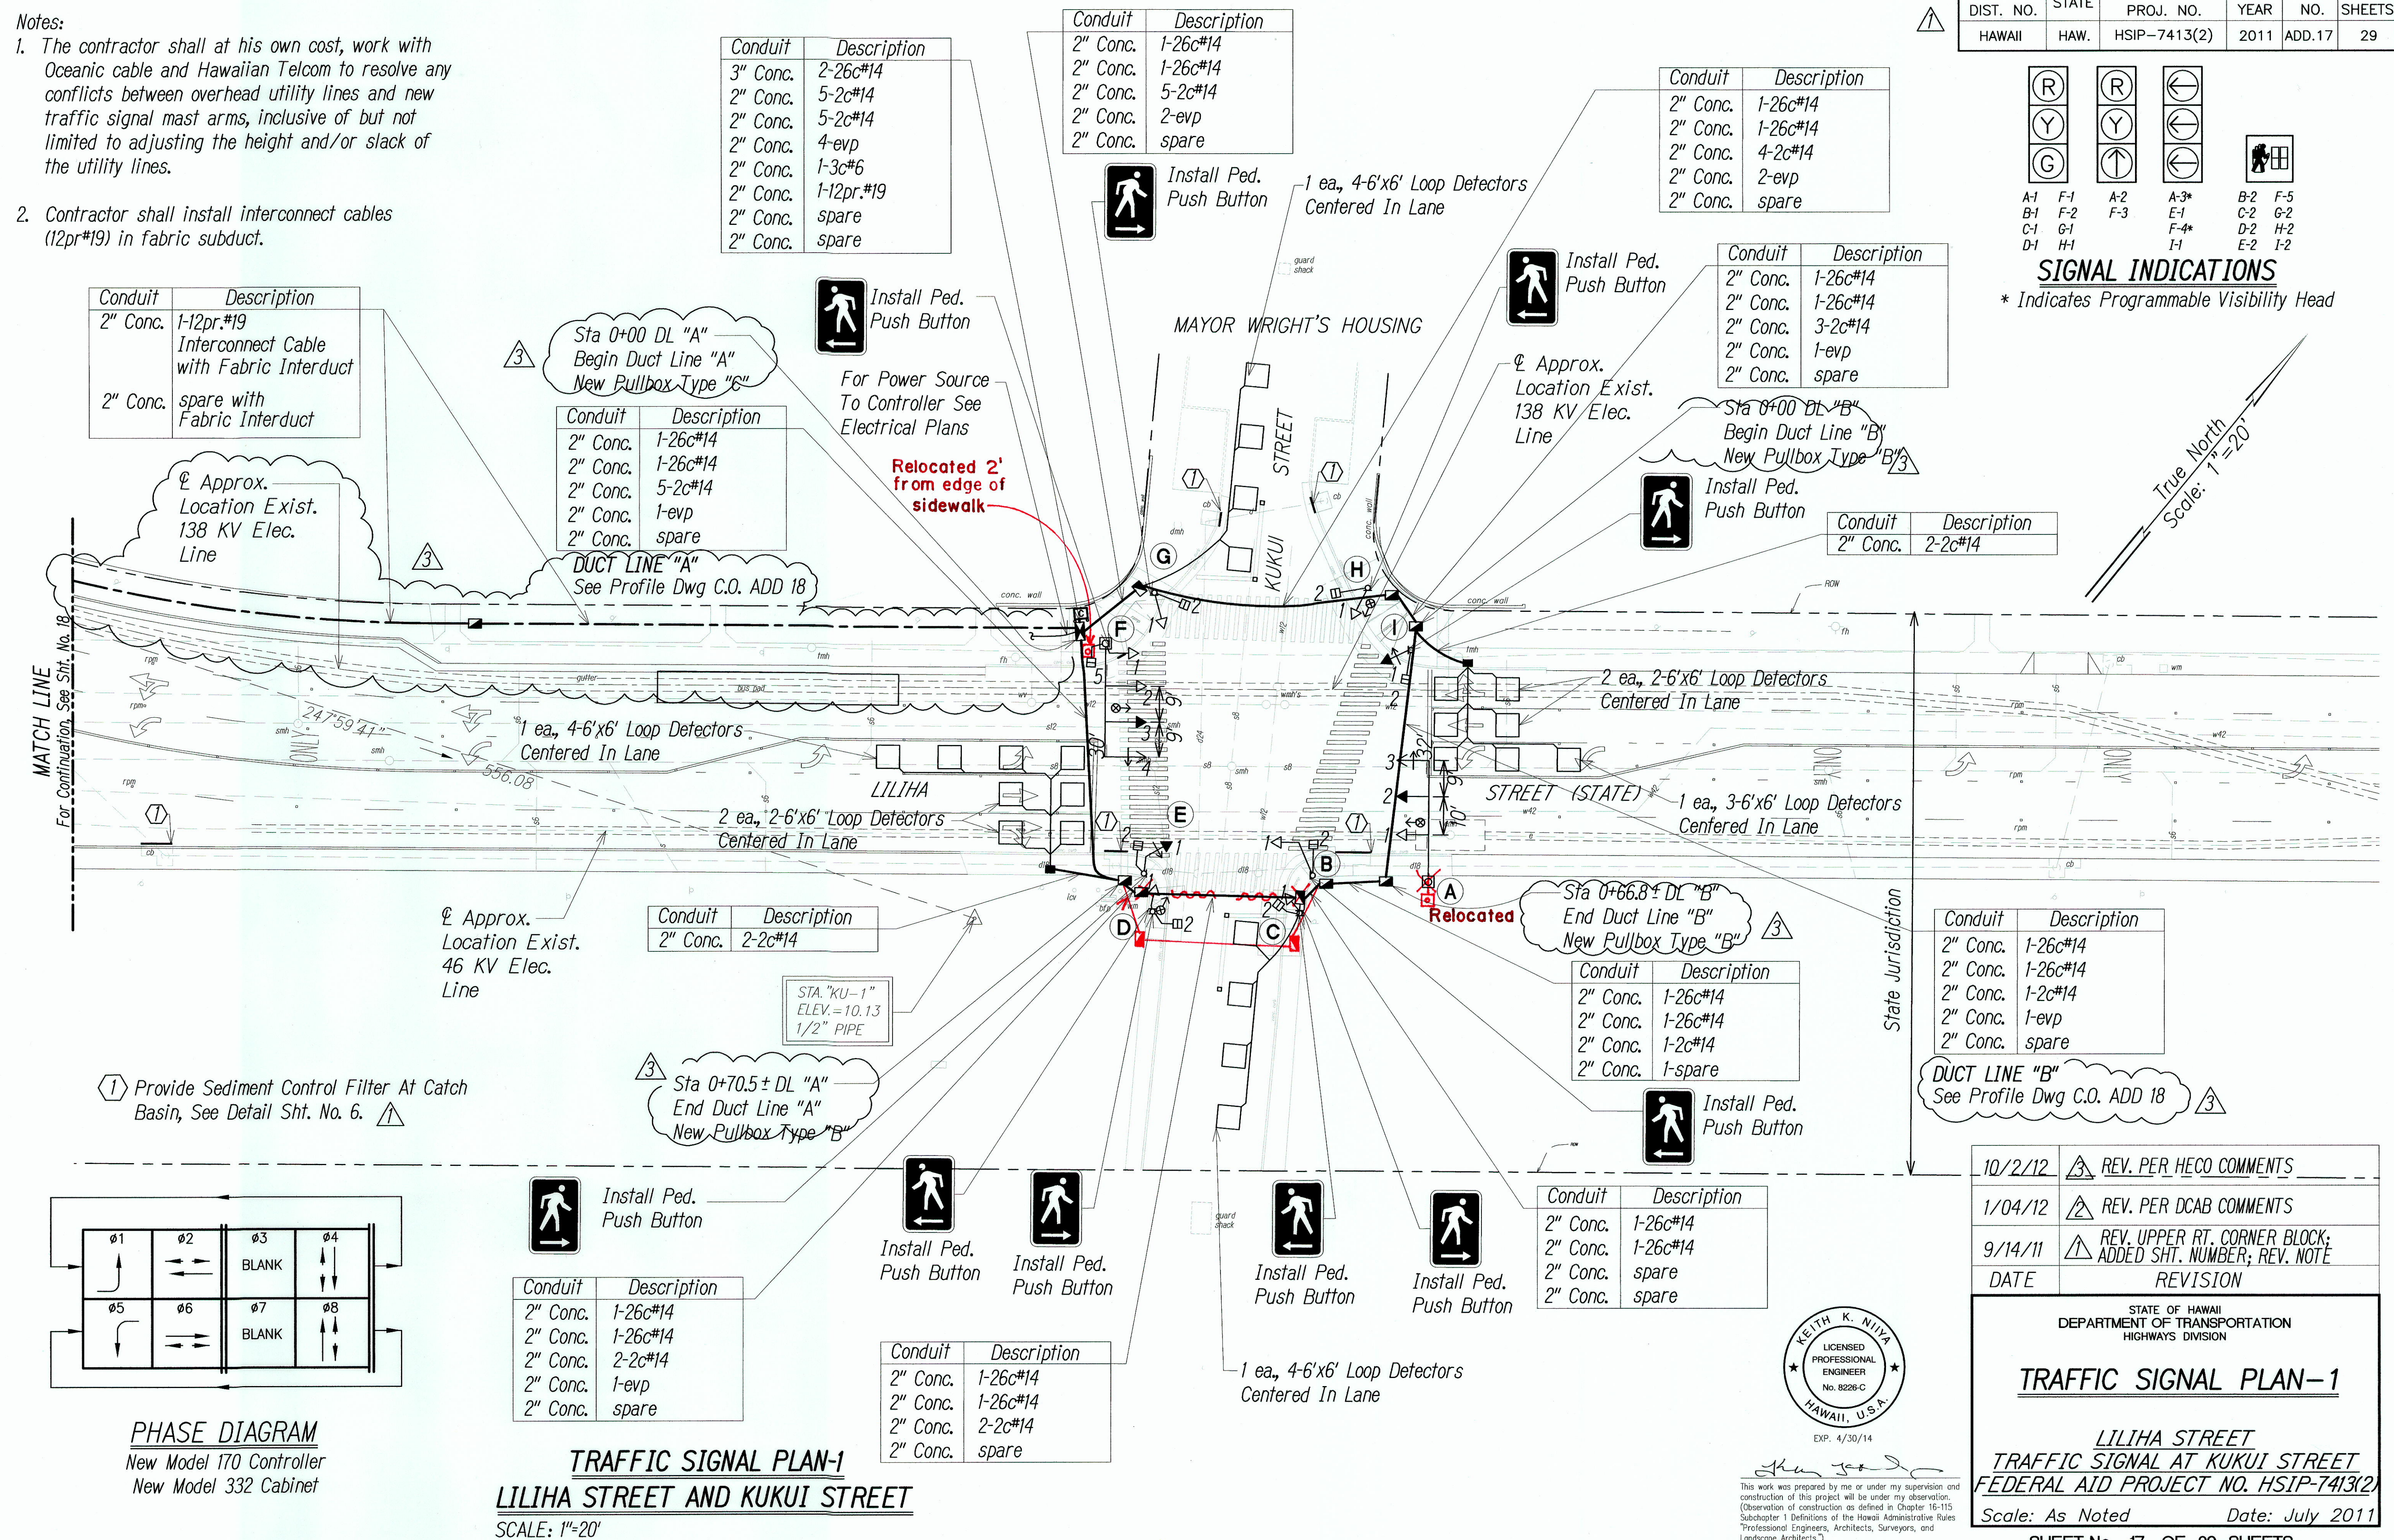


FED. ROAD DIST. NO.	STATE	FED. AID PROJ. NO.	FISCAL YEAR	SHEET NO.	TOTAL SHEETS
HAWAII	HAW.	HSIP-7413(2)	2011	ADD.18	29

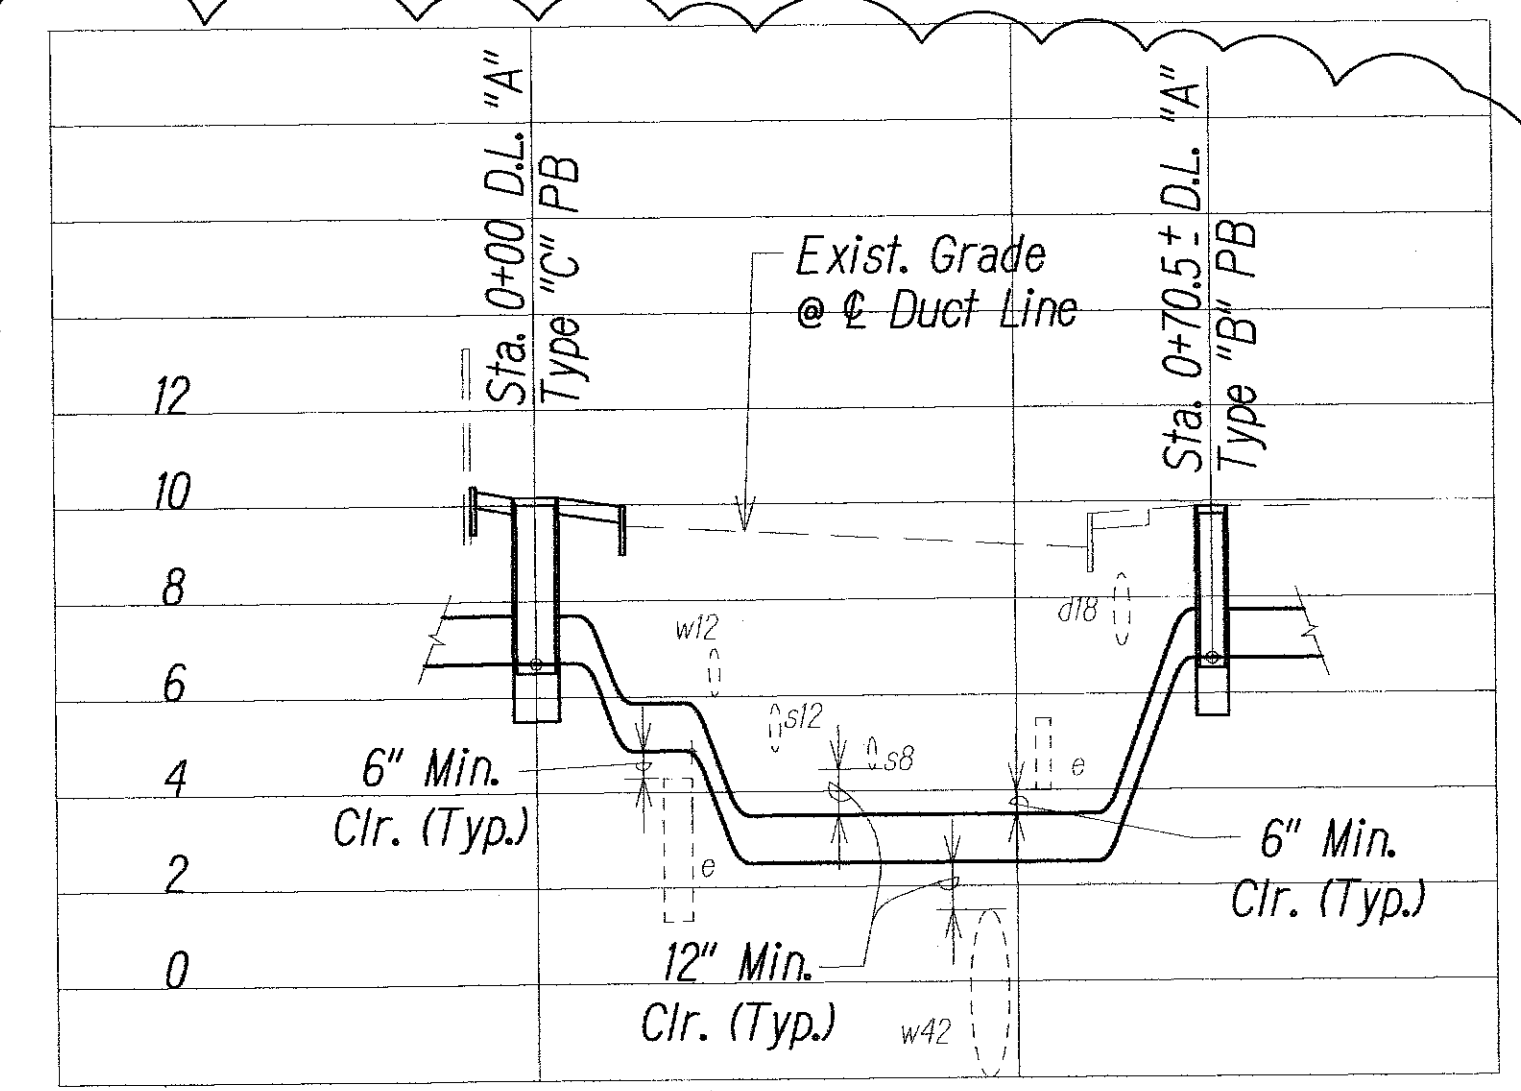

DUCT LINE "A" PROFILE

SCALE: HORIZ. 1"=20'
VERT. 1"=4'

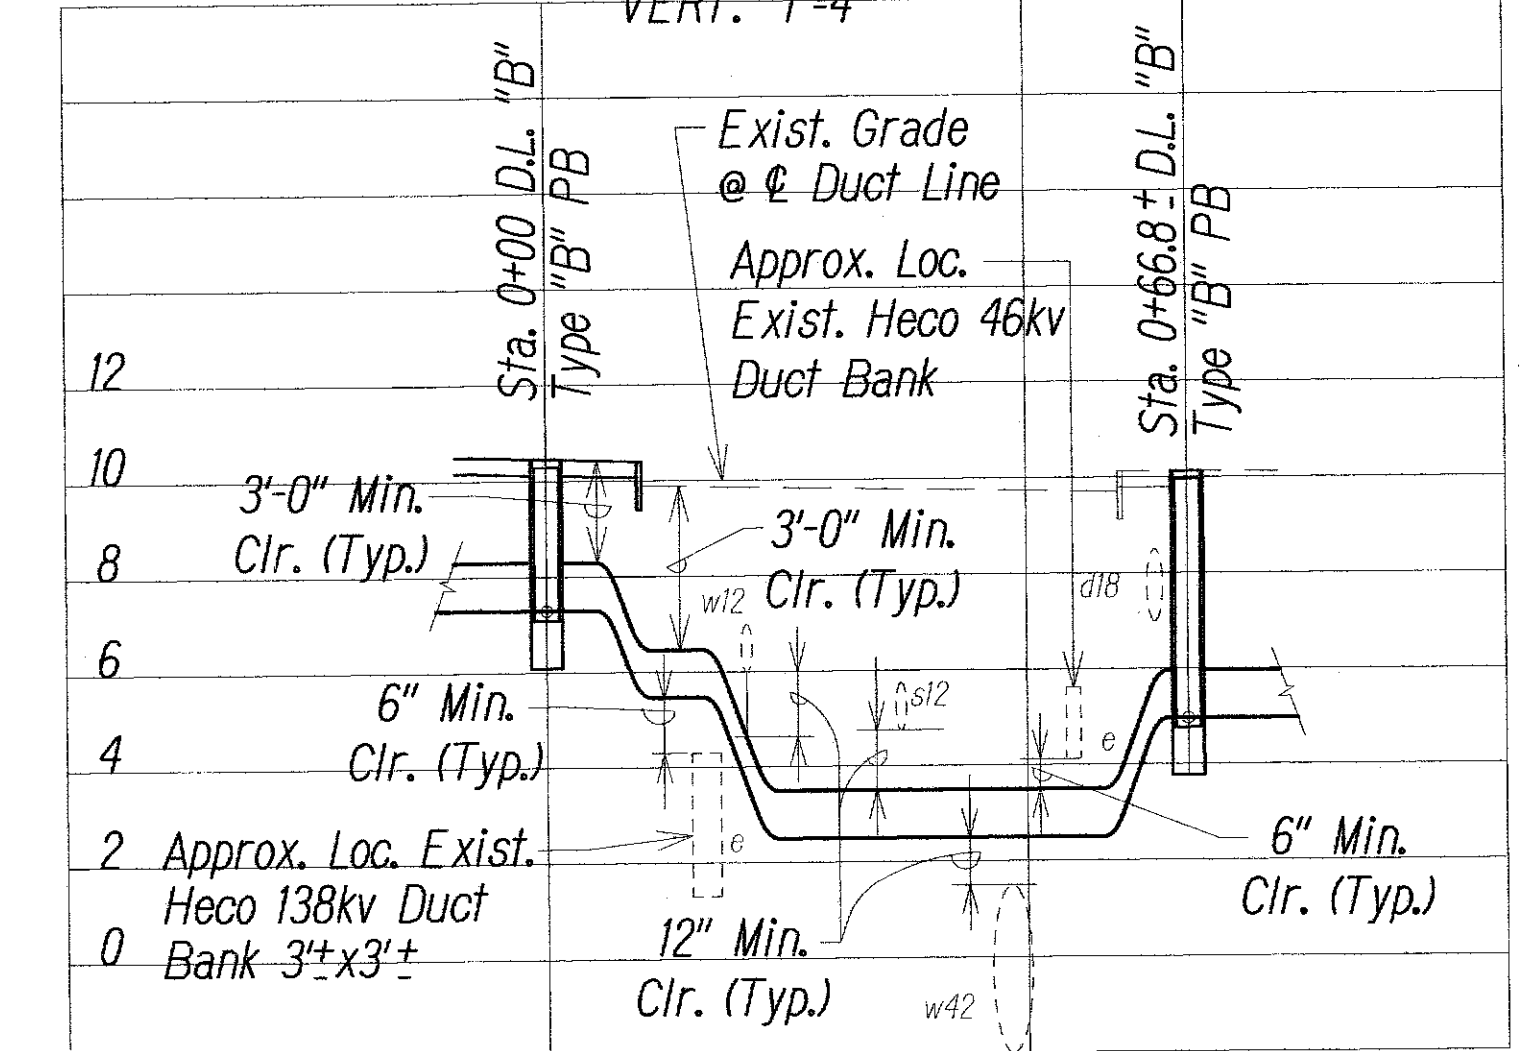


DUCT LINE "B" PROFILE

SCALE: HORIZ. 1"=20'
VERT. 1"=4'

- Notes:
- Contractor shall install interconnect cables (12pr#19) in fabric subduct.
 - Repair existing curb ramp to pre-construction lines and grades as directed by the Engineer.

① Provide Sediment Control Filter At Catch Basin, See Detail Sht. No. 6.

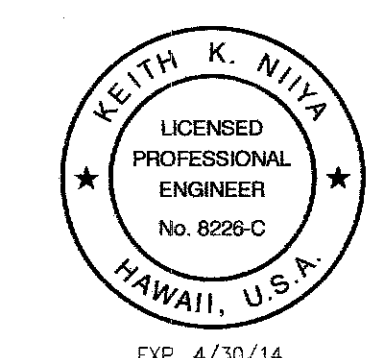

11/16/12	△	REV. PER HECO COMMENTS
1/04/12	△	REV. PER DCAB COMMENTS
9/14/11	△	REV. UPPER RT. CORNER BLOCK; ADDED SHT. NUMBER; REV. NOTE
DATE		REVISION

STATE OF HAWAII
DEPARTMENT OF TRANSPORTATION
HIGHWAYS DIVISION


TRAFFIC SIGNAL PLAN-2

LILIHA STREET
TRAFFIC SIGNAL AT KUKUI STREET
FEDERAL AID PROJECT NO. HSIP-7413(2)

Scale: As Noted Date: July 2011

SHEET No. 18 OF 29 SHEETS

C.O. ADD. 18

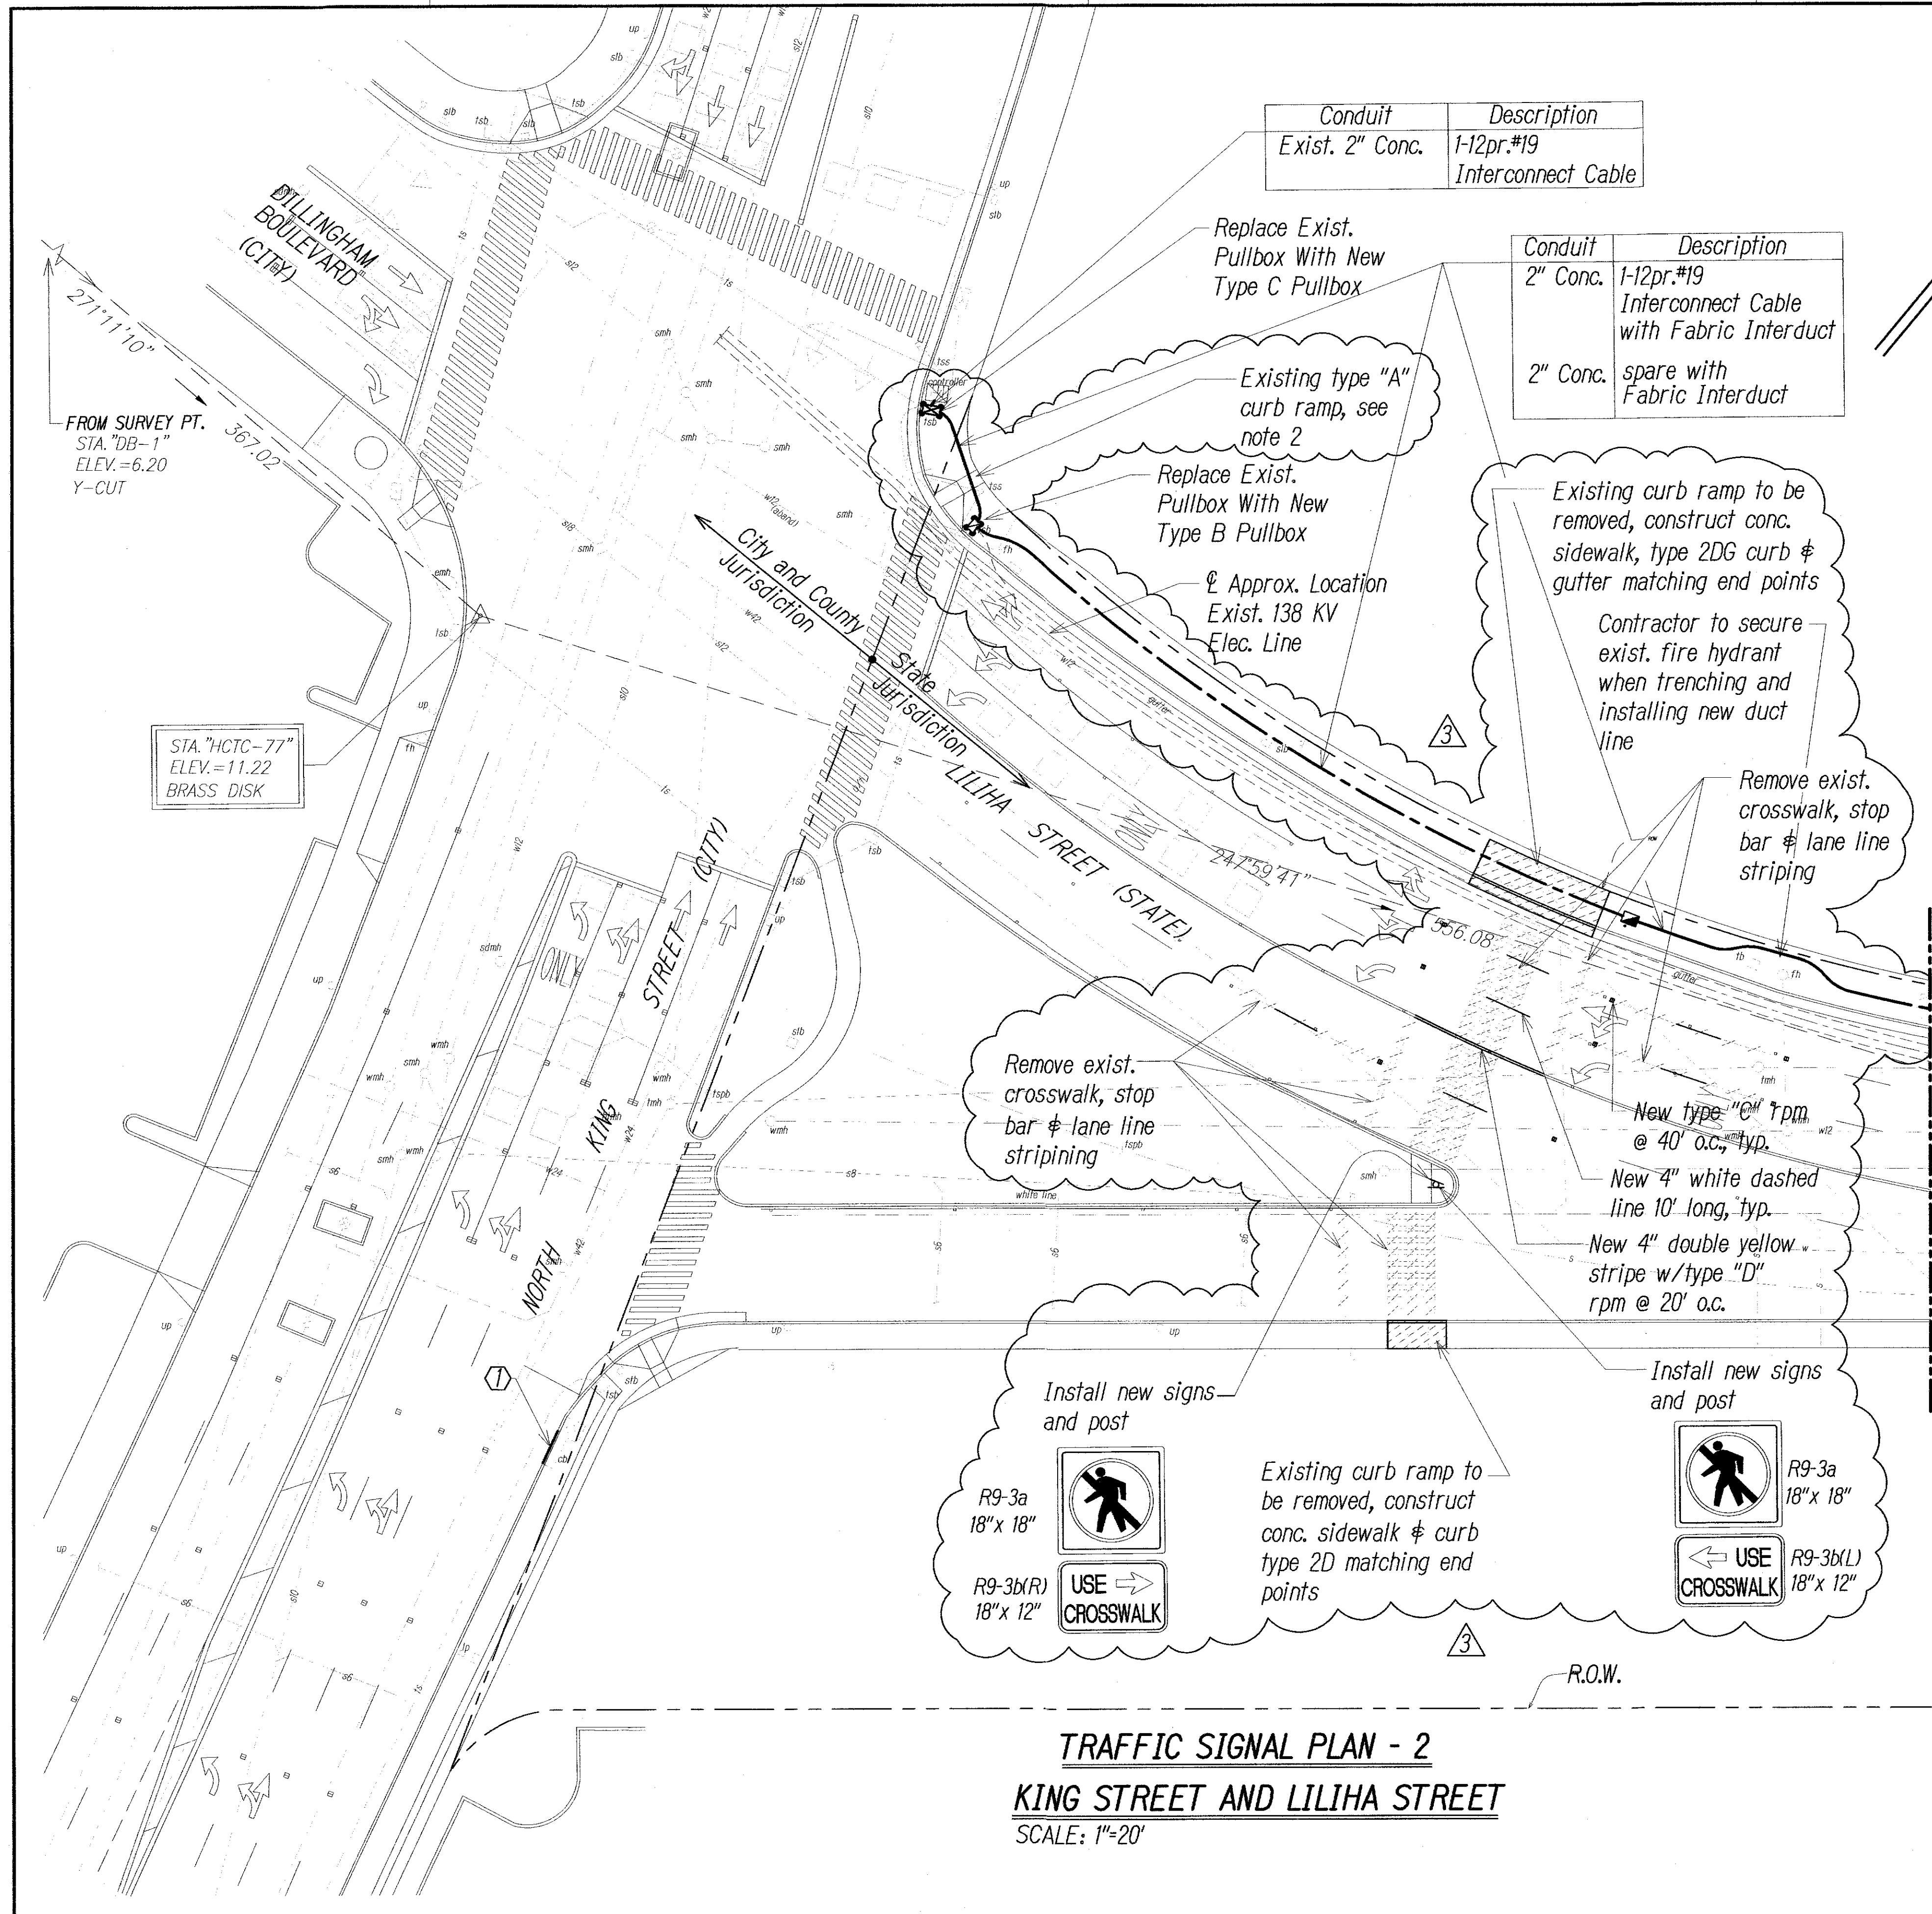

TRAFFIC SIGNAL PLAN - 2

KING STREET AND LILIHA STREET

SCALE: 1"=20'

SURVEY PLOTTED BY	DATE
DRAWN BY	
DESIGNED BY	
QUANTITIES BY	
CHECKED BY	
ORIGINAL PLAN	
NOTE BOOK	
No.	