
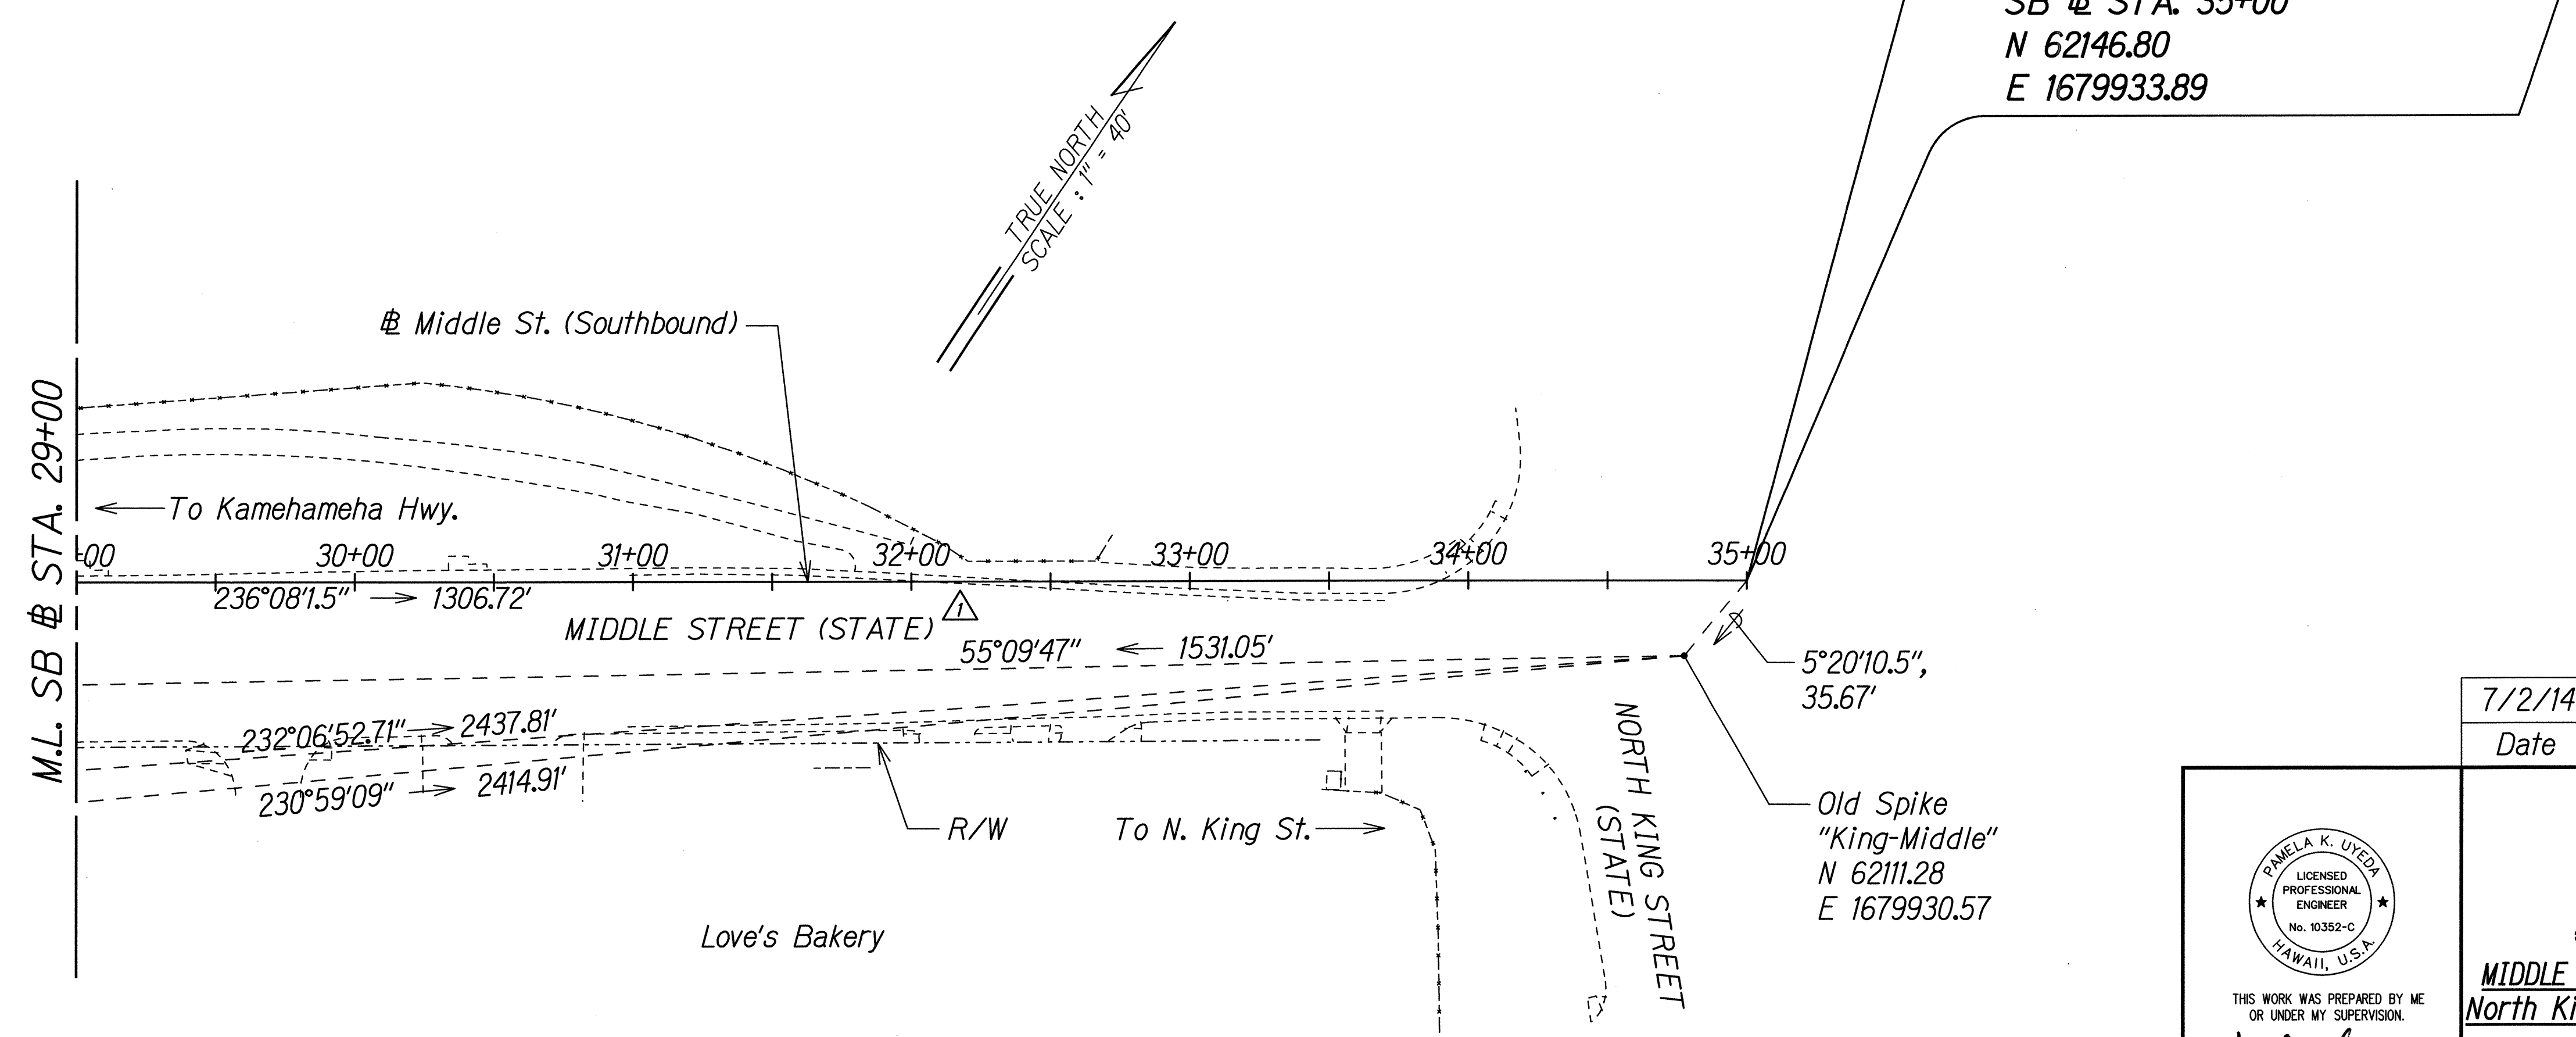


FED. ROAD DIST. NO.	STATE	FEDERAL AID PROJ. NO.	FISCAL YEAR	SHEET NO.	TOTAL SHEETS
HAWAII	HAW.	STP-7415(001)	2014	ADD. 19	173

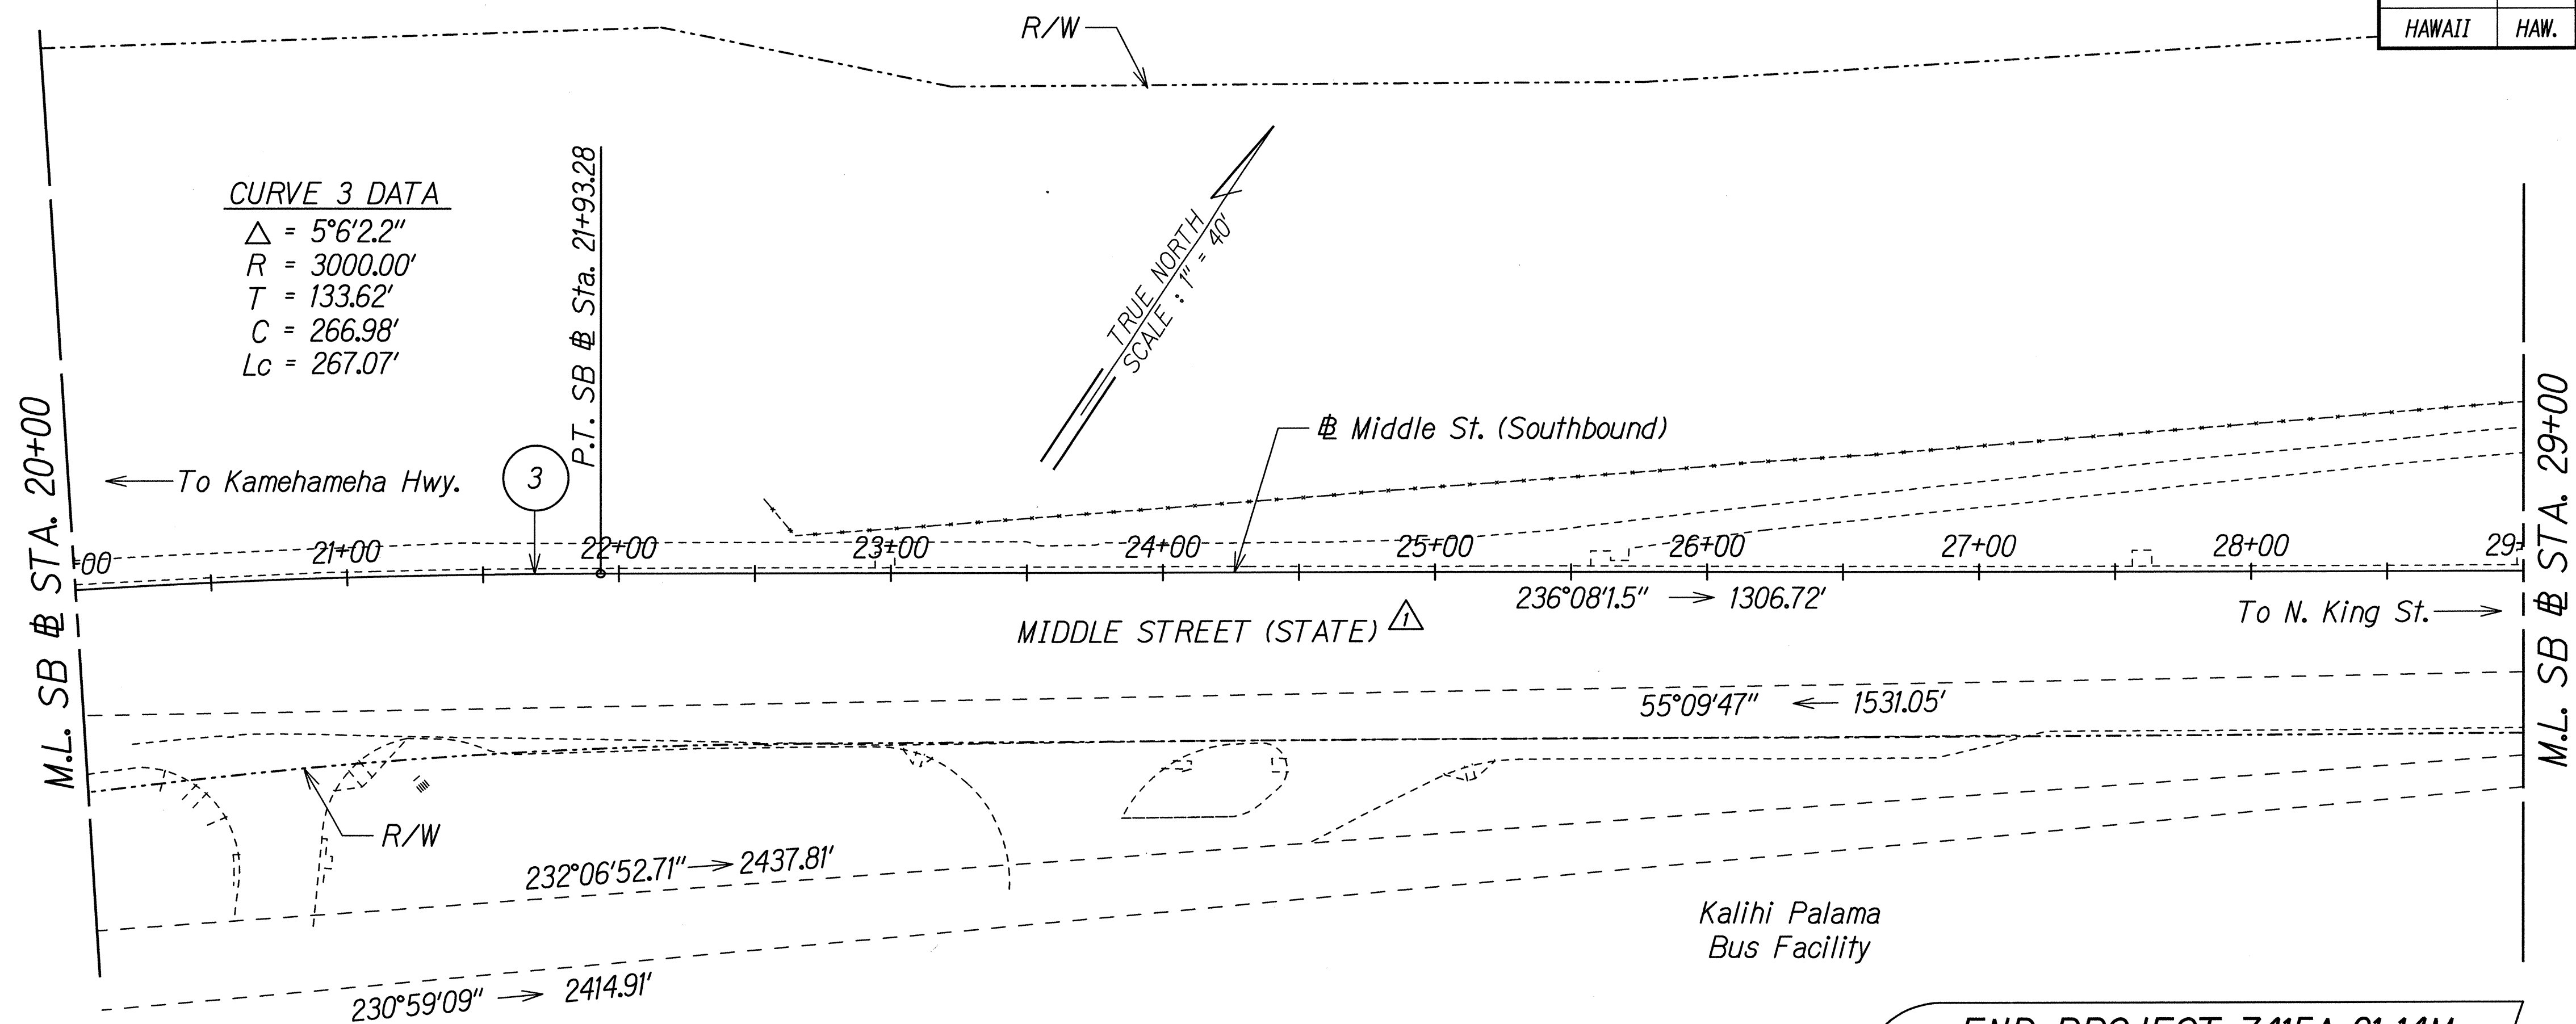

SURVEY PLOTTED BY	DATE
DRAWN BY	
DESIGNED BY	
CHECKED BY	
NOTE BOOK	
N.	

T-16543A Middle St CADD SHEETS/ALIGN-02.dgn

THIS WORK WAS PREPARED BY ME OR UNDER MY SUPERVISION.

Signature: *Pamela K. Uyeda* 04/30/16
 EXPIRATION DATE OF THE LICENSE

7/2/14	Added Jurisdiction.
Date	Revision

STATE OF HAWAII
 DEPARTMENT OF TRANSPORTATION
 HIGHWAYS DIVISION

ALIGNMENT PLAN

MIDDLE STREET PAVEMENT RECONSTRUCTION
 North King Street to Kamehameha Highway
 FAP NO. STP-7415(001)

Scale: 1"=40' Date: June 20, 2014