


| FED. ROAD<br>DIST. NO. | STATE | FEDERAL AID<br>PROJ. NO. | FISCAL<br>YEAR | SHEET<br>NO. | TOTAL<br>SHEETS |
|------------------------|-------|--------------------------|----------------|--------------|-----------------|
| HAWAII                 | HAW.  | STP-7415(001)            | 2014           | 114          | 173             |

INDEX TO STRUCTURAL DRAWINGS

| SHEET<br>NO. | DESCRIPTION                                    | SHEET<br>NO. | DESCRIPTION  |
|--------------|--|--------------|--|
| S0.1         | INDEX TO STRUCTURAL DRAWINGS                   | S3.7         | PPCP LAYOUT PANEL INSTALLATION SEQUENCE                                |
| S0.2         | STRUCTURAL GENERAL NOTES                       | S3.8         | PPCP LAYOUT PANEL INSTALLATION SEQUENCE                                |
| S0.3         | STRUCTURAL GENERAL NOTES                       | S3.9         | PPCP LAYOUT PANEL INSTALLATION SEQUENCE                                |
| S0.4         | SYMBOLS AND ABBREVIATIONS                      | S3.10        | PPCP LAYOUT PANEL INSTALLATION SEQUENCE                                |
|              |  | S3.11        | PPCP LAYOUT PANEL INSTALLATION SEQUENCE                                |
|              |  | S3.12        | PPCP JOINTING PLAN   |
| S1.1         | TYPICAL PCCP JOINT LOCATION PLAN               |              |  |
| S1.2         | TYPICAL PCCP JOINT DETAILS                     |              |  |
| S1.3         | TYPICAL PCCP JOINT DETAILS                     | S4.1         | CONCRETE BARRIER AT SIGN POST  |
| S1.4         | TYPICAL PCCP JOINT DETAILS                     | S4.2         | CONCRETE BARRIER AT SIGN POST SECTIONS                                 |
| S1.5         | TYPICAL PCCP JOINT DETAILS                     | S4.3         | ROADWAY CONSTRUCTION DETAILS MANHOLE ADJUSTMENT/RECONSTRUCTION DETAILS |
| S1.6         | TYPICAL CONCRETE CLOSURE POUR PLAN AND SECTION | S4.4         | ROADWAY CONSTRUCTION DETAILS MANHOLE ADJUSTMENT/RECONSTRUCTION DETAILS |
| S1.7         | PCCP JOINTING PLAN                             | S4.5         | ROADWAY CONSTRUCTION DETAILS MANHOLE ADJUSTMENT/RECONSTRUCTION DETAILS |
| S1.8         | PCCP JOINTING PLAN                             | S4.6         | LIGHT POLE FOUNDATION  |
| S1.9         | PCCP JOINTING PLAN                             | S4.7         | CONCRETE SWALE SECTIONS  |
| S1.10        | PCCP JOINTING PLAN                             |              |  |
|              |  |              |  |
| S2.1         | TYPICAL JPCP PANEL DETAILS                     |              |  |
| S2.2         | TYPICAL JPCP PANEL DETAILS AT TRANSFER STATION |              |  |
| S2.3         | TYPICAL LIFTING/LEVELING DEVICE DETAILS        |              |  |
| S2.4         | PRECAST PANEL INSTALLATION ON A CURVE          |              |  |
| S2.5         | JPCP AT EXISTING PAVEMENT SECTIONS             |              |  |
| S2.6         | CIRCULAR BLOCKOUT DETAILS                      |              |  |
| S2.7         | CIRCULAR BLOCKOUT DETAIL                       |              |  |
| S2.8         | JPCP JOINTING PLAN                             |              |  |
| S2.9         | JPCP JOINTING PLAN                             |              |  |
| S2.10        | JPCP JOINTING PLAN                             |              |  |
|              |  |              |  |
|              |  |              |  |
| S3.1         | TYPICAL PPCP END PANEL DETAILS                 |              |  |
| S3.2         | TYPICAL PPCP INTERIOR PANEL DETAILS            |              |  |
| S3.3         | TYPICAL PPCP DETAILS                           |              |  |
| S3.4         | TYPICAL PPCP ANCHORAGE SYSTEM DETAILS          |              |  |
| S3.5         | TYPICAL PPCP PANEL LAYOUT PLAN                 |              |  |
| S3.6         | PPCP LAYOUT PANEL INSTALLATION SEQUENCE        |              |  |

|                  |                   |      |
|------------------|-------------------|------|
| ORIGINAL<br>PLAN | SURVEY PLOTTED BY | DATE |
| NOTE BOOK        | DRAWN BY          |      |
| No.              | DESIGNED BY       |      |
|                  | QUANTITIES BY     |      |
|                  | CHECKED BY        |      |

DRAWING NAME: 2\00\ONGONG\2-0331-HFL MIDDLE STREET RECONSTRUCTION-DOTH\CAD\06-19-14 BD\HFL-M3001.DWG PLOT TIME: 06-18-14, 6:54 PM

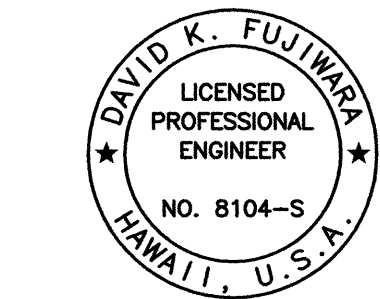

THIS WORK WAS PREPARED BY  
ME OR UNDER MY SUPERVISION.  
*David K. Fujiwara*  
SIGNATURE      4-30-16  
EXPIRATION DATE OF THE LICENSE

STATE OF HAWAII  
DEPARTMENT OF TRANSPORTATION  
HIGHWAYS DIVISION  
**INDEX TO**  
**STRUCTURAL DRAWINGS**  
MIDDLE STREET PAVEMENT RECONSTRUCTION  
North King Street to Kamehameha Highway  
FAP NO. STP-7415(001)  
Scale: None      Date: Jun. 20, 2014  
SHEET No. S01 OF 4 SHEETS



| FED. ROAD DIST. NO. | STATE | FEDERAL AID PROJ. NO. | FISCAL YEAR | SHEET NO. | TOTAL SHEETS |
|---------------------|-------|-----------------------|-------------|-----------|--------------|
| HAWAII              | HAW.  | STP-7415(001)         | 2014        | 115       | 173          |

STRUCTURAL GENERAL NOTES

1. General Specifications: Hawaii State Department of Transportation (HDOT), Hawaii Standard Specifications for Road and Bridge Construction, 2005, together with Special Provisions prepared for this contract.

2. Design Specifications:

(A) AASHTO 2010 LRFD Bridge Design Specifications (Fifth Edition) and its subsequent interim specifications with interim supplements and modifications by the HDOT Highways Division.

(B) HDOT Document dated March 1, 2013 with subject title "Design Criteria for Bridges and Structures"

3. Loads:

(A) Live Load: AASHTO HL-93 Truck Loading

4. Materials:

(A) All concrete strengths shall be as noted below:

| Item No. | Structural Parts  | Minimum Compressive Strength<br>f'c (28 Days) | Maximum Water/Cement<br>(W/C) |
|----------|---|---|-------------------------------|
| (1)      | Cast-in-Place PCCP<br>See Note 4.(F)                    | Section 411<br>fr = 650 psi<br>(14 days)      | 0.40                          |
| (2)      | Jointed Precast Panels<br>See Note 4.(C)                | 6000 psi                                      | 0.40                          |
| (3)      | Precast Prestressed Panels<br>See Note 4.(C)            | 6000 psi                                      | 0.40                          |
| (4)      | Closure Pour Around Manhole<br>See Note 4.(C) and 4.(F) | 6000 psi                                      | 0.40                          |
| (5)      | Barrier Wall and Footing<br>See Note 4.(C) and 4.(F)    | 4500 psi                                      | 0.45                          |
| (6)      | Except as noted otherwise,<br>all others                | 4500 psi                                      | 0.45                          |

(B) The use of any calcium chloride in any concrete is prohibited.

(C) The concrete mix for Item Nos. (2), (3), (4) and (5) under Note 4.(A) shall contain a minimum of 128 oz. of shrinkage reducing admixture such as Eclipse or Masterlife SRA 20 or approved equal.

(D) All reinforcing steel shall be deformed ~~epoxy-coated~~ bars ASTM A775 Grade 60 unless otherwise noted. ~~Non-epoxy coated is allowed.~~

(E) All concrete shall be cured for a minimum of seven consecutive days immediately after pouring by the use of wet Burlap, Fog Spraying, Curing Compound, or other approved methods.

4. Materials:

(F) Reinforce panels with 12 lbs./cy of structural alkali resistant glass fiber or accepted equal. Cast-in-place panel to be reinforced with fibers shall be as follows, unless otherwise noted:

(1) Odd-shaped panels

(2) Panels with openings

(3) Panel opening closure pours

(4) Panels with mismatched joints

(5) PCCP-AC transverse transition panels

(6) Sidewalk extension

(G) Non-shrink grout for lightpole transformer bases shall contain 1 oz. of migrating amine-carboxylate corrosion inhibiting admixture per 1 cubic foot of grout.

5. Reinforcement (Cont.):

(A) The covering measured from the surface of the concrete to the face of any reinforcing bars shall be as follows, except as otherwise shown:

(1) Concrete cast against and permanently exposed to earth = 3"

(2) All others unless otherwise noted = 2".

(B) Reinforcing bars shall be detailed in accordance with the latest edition of the A.C.I. Detailing Manual unless otherwise noted.

(C) Minimum clear spacing between parallel bars shall be 1-1/2 times the diameter of bars (for non-bundled bars). In no case shall the clear distance between the bars be less than 1-1/2 times the maximum size of the coarse aggregate or 1 1/2" whichever is greater.

(D) All dimensions relating to reinforcing bars are to centers of bars unless otherwise noted.

(E) Reinforcing bars shall be securely tied at all intersections and lap splices except where the spacing of intersections is less than one foot in each direction, in which case alternate intersections shall be tied.

(F) For Glass Fiber Reinforced Polymer (GFRP) Rebar requirements see Specification Section 670.

6. Construction Notes:

(A) Except as otherwise noted, all vertical dimensions are measured plumb.

(B) Unless otherwise noted, all exposed concrete edges shall be chamfered 3/4" x 3/4".

7. Portland Cement Concrete Pavement (PCCP) and Jointing Notes:

A. Details and information for pavement width, pavement thickness, pavement boundaries, pavement layout (plans and profiles), cross slope, roadway sections, and pavement sections are shown in the Civil drawings.

B. For other requirements, see Section 411 - Portland Cement Concrete Pavement and sheets S1.1 to S1.6.

C. Provide shop drawings for all joint layouts a minimum of 2-weeks prior to work for approval by the Engineer. Include added trim bar reinforcing where obstructions such as manholes and blockouts are encountered and termination of concrete with triangular or odd-shaped panels, panels with openings, panel opening closure pours, panels with mismatched joints, at PCCP-AC transverse transition panels, and sidewalk extension.

D. For locations of longitudinal joints, see pavement jointing plans on sheets S1.7 to S1.10. Locate longitudinal joints along lane lines as much as practical.

E. For locations of transverse joints, see pavement jointing plans on sheets S1.7 to S1.10. Locate transverse construction joints at planned transverse contraction joint as shown on the pavement jointing plans.

F. Where a monolithic curb is specified, the transverse joint in the curb shall coincide with pavement joints and may be formed by any means approved by the Engineer.

G. Unless otherwise noted use isolation joints to isolate the new PCCP from a structure or another paved area. Isolation joints shall be provided at intersections, and around in-pavement structures such as drainage inlets and manholes.

H. Reinforce with #5 @ 12" top and bottom, each way at odd shaped panels and panels with mismatched joints. Odd shaped panels are panels with length-to-width ratios greater than 1.25, triangular, and other non-square shaped panels. See sheets S1.2 to S1.6 for additional locations for rebar reinforced sections.

J. Triangular shapes are not allowed unless otherwise shown on the plans. Trim bars are required for corner angles <80° and for pavement sections opposite mismatched joint.

K. The Contractor shall not damage the epoxy coating on the dowels and deformed bars in any way during shipment, handling, or placement. Damaged epoxy coated dowels and deformed bars shall be replaced at no cost to the State. Repair of epoxy coating as approved by the Engineer shall meet ASTM A775.

|                   |      |
|-------------------|------|
| SURVEY PLOTTED BY | DATE |
| DRAWN BY          |      |
| TRACED BY         |      |
| DESIGNED BY       |      |
| QUANTITIES BY     |      |
| CHECKED BY        |      |
| NO.               |      |

DRAWING NAME: Z:\00 ONGOING\12-033.1-HL MIDDLE STREET RECONSTRUCTION-DOTH\CA06-19-14 BID\HL-MS002.DWG PLOT TIME: 06-18-14 6:53 PM



THIS WORK WAS PREPARED BY ME OR UNDER MY SUPERVISION.

SIGNATURE: David K. Fujiwara EXPIRATION DATE OF THE LICENSE: 4-30-18

STATE OF HAWAII  
DEPARTMENT OF TRANSPORTATION  
HIGHWAYS DIVISION

STRUCTURAL GENERAL NOTES

MIDDLE STREET PAVEMENT RECONSTRUCTION  
North King Street to Kamehameha Highway  
FAP NO. STP-7415(001)

Scale: None Date: Jun. 20, 2014

SHEET No. S02 OF 4 SHEETS

"AS-BUILT"



| FED. ROAD DIST. NO. | STATE | FEDERAL AID PROJ. NO. | FISCAL YEAR | SHEET NO. | TOTAL SHEETS |
|---------------------|-------|-----------------------|-------------|-----------|--------------|
| HAWAII              | HAW.  | STP-7415(001)         | 2014        | 116       | 173          |

STRUCTURAL GENERAL NOTES (CONT.)

8. Jointed Precast Concrete Pavement (JPCP) Notes:

- A. Details and information for pavement width, pavement thickness, pavement boundaries, pavement layout (plans and profiles), cross slope, roadway sections, and pavement sections are shown in the Civil drawings.
- B. For other requirements, see Section 416 - Jointed Precast Concrete Pavement (JPCP) and sheets S2.1 to S2.7.
- C. Provide shop drawings for all joint layouts a minimum of 2-weeks prior to work for approval by the Engineer. Include reinforcing where obstructions such as manholes are encountered, termination of concrete with triangular or odd shaped panels and at JPCP-AC transition panel. Include JPCP layout at curves.
- D. Use isolation joints to isolate the new JPCP panels from a structure or another paved area, or an immovable object. Isolation joints shall be provided around in-pavement structures such as drainage inlets and manholes.
- E. The Contractor shall not damage the epoxy coating on the dowels and deformed bars in any way during shipment, handling, or placement. Damaged epoxy coated dowels and deformed bars shall be replaced at no cost to the State. Repair of epoxy coating as approved by the Engineer shall meet ASTM A775.

9. Precast Prestressed Concrete Pavement (PPCP) and Jointing Notes:

- A. Details and information for pavement width, pavement thickness, pavement boundaries, pavement layout (plans and profiles), cross slope, roadway sections, and pavement sections are shown in the Civil drawings.
- B. For other requirements, see Section 417 - Precast Prestressed Concrete Pavement (PPCP) and sheets S3.1 to S3.4.
- C. Provide shop drawings for all joint layouts a minimum of 2-weeks prior to work for approval by the Engineer. Include reinforcing where obstructions such as manholes are encountered, and termination of concrete with triangular or odd shaped slabs. Include Pretensioning, Post-Tensioning, and Construction Sequence.
- D. Use isolation joints to isolate the new PPCP panels from a structure or another paved area, or an immovable object. Isolation joints shall be provided around in-pavement structures such as drainage inlets and manholes.
- E. Pretensioning:
- (1) Concrete compressive strength at time of pretensioning strand release fci = 3500 psi.
- (2) Pretensioned strands shall be ASTM A416 Grade 270 0.5" Diameter Low Relaxation.
- (3) Strand release sequence shall not induce any lateral deflection of the panel.
- (4) During curing and storage, care shall be taken to avoid any lateral deflection of the panel due to improper orientation. Steam curing may be used to accelerate strength gain.
- (5) The working force for each strand shall be 25.2 kips.

9. Precast Prestressed Concrete Pavement (PPCP) and Jointing Notes (Cont.):

E. Pretensioning:


- (1) Concrete compressive strength at time of pretensioning strand release fci = 3500 psi.
- (2) Pretensioned strands shall be ASTM A416 Grade 270 0.5" Diameter Low Relaxation.
- (3) Strand release sequence shall not induce any lateral deflection of the panel.
- (4) During curing and storage, care shall be taken to avoid any lateral deflection of the panel due to improper orientation. Steam curing may be used to accelerate strength gain.
- (5) The working force for each strand shall be 25.2 kips.

F. Post-Tensioning:

- (1) Post-tensioning strands shall be ASTM A416 Grade 270 0.6" diameter low relaxation. Ducts shall be galvanized metal.
- (2) After post-tensioning, ducts shall be pressure grouted with Masterflow 1205 Cable Grout, Sika Grout 300 PT, or approved equal. Ducts shall have grouting vents at anchorage and at each high point along the tendon profile.
- (3) Ducts shall be secured to prevent misalignment or leakage during concrete pour.
- (4) A minimum concrete compressive strength of 6000 psi shall be attained before the application of post-tensioning.
- (5) Prevent ducts, at all times, from getting plugged or damaged. Ducts shall be checked to show that ducts are clear and contain no obstructions prior to installing prestressing steel and stressing the member.
- (6) The post-tensioning design assumptions are as follows:
- Wobble friction coefficient..... 0.0002/ft.  
Anchor set..... 3/8"
- (7) The jacking force for each tendon shall be 44.0<sup>k</sup> times the number of strands in each tendon.
- (8) Post-tensioning shall comply with HDOT Specifications and AASHTO LFRD Bridge Construction Specifications including the latest interim revisions.
- (9) Prior to grouting and within two days after installing strands, a corrosion inhibitor amine carboxylate powder (Cortec MCI-309 or accepted equal) shall be blown into the ducts in accordance with manufacturer's recommendations.
- (10) After completion of stressing and grouting of PPCP, fill the anchor head blockouts with fill material. Coat blockout and anchor head with bonding agent before filling blockout. Finish flush to end of panel. See Special Provision Section 417 for material requirements.

|               |      |
|---------------|------|
| ORIGINAL PLAN | DATE |
| DESIGNED BY   |      |
| NOTED BY      |      |
| CHECKED BY    |      |
| NO.           |      |

DRAWING NAME: Z:\000\_0\CONV\12-0331-HEL MIDDLE STREET RECONSTRUCTION-DOT\HA\06-19-14 BID\HEL-MS002.DWG PLOT TIME: 05-18-14, 6:54 PM

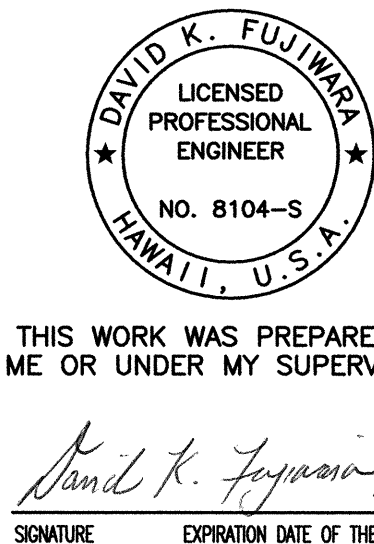

THIS WORK WAS PREPARED BY ME OR UNDER MY SUPERVISION.  
Signature: David K. Fujiwara  
EXPIRATION DATE OF THE LICENSE: 4-30-16

STATE OF HAWAII  
DEPARTMENT OF TRANSPORTATION  
HIGHWAYS DIVISION

STRUCTURAL GENERAL NOTES

MIDDLE STREET PAVEMENT RECONSTRUCTION  
North King Street to Kamehameha Highway  
FAP NO. STP-7415(001)

Scale: None Date: Jun. 20, 2014

SHEET No. 503 OF 4 SHEETS

| FED. ROAD<br>DIST. NO. | STATE | FEDERAL AID<br>PROJ. NO. | FISCAL<br>YEAR | SHEET<br>NO. | TOTAL<br>SHEETS |
|------------------------|-------|--------------------------|----------------|--------------|-----------------|
| HAWAII                 | HAW.  | STP-7415(001)            | 2014           | 117          | 173             |

SYMBOLS AND ABBREVIATIONS

¢ And  
@ At  
∅ Diameter  
≥ Greater Than or Equal to  
≤ Less Than or Equal to  
# Number

Abbr. Abbreviation  
Add. Additional  
Alt. Alternate  
AB Anchor Bolt  
AC Asphaltic Concrete  
Approx. Approximate  
ASB Asphalt Stabilized Base  
Az. Azimuth

Bk. Back  
Bal. Balance  
℄ Baseline  
Bm. Beam  
Brg., Brgs. Bearing, Bearings  
BVC Beginning of Vertical Curve  
Bet. Between  
BF Both Faces  
BW Both Ways  
BFE Bottom of Footing Elevation  
Bot., Bott., B Bottom  
BOF Bottom of Footing  
Blt. Bolt

Cant. Cantilever  
CIP Cast Iron Pipe  
Cast-In-Place  
℄ Center line  
cc Center to Center  
CG Center of Gravity  
CFCW Continuous Flashing Compound  
Waterproofing

Cl. Class  
Clr. Clearance  
CO Clean Out  
Col. Column  
Conc. Concrete  
CBW Concrete Barrier Wall  
Conn. Connection  
Const. Construction  
CJ Construction Joint  
Cntl. Jt. Control Joint  
CLSM Controlled Low Strength  
Material

Cont. Continuous  
CF Cubic Feet  
CY, Cu. Yd. Cubic Yard

Demo. Demolish, Demolition  
Det. Detail  
Dia. Diameter  
Diaph. Diaphragm  
Dim. Dimension  
Dist. Distance  
DO Ditto  
Dwls. Dowels  
Dn. Down  
Dbl. Double  
DI Drain Inlet, Ductile Iron  
Dwg., Dwgs. Drawing, Drawings  
DS Drilled Shaft

E East  
EA, Ea., ea. Each  
EF Each Face  
EFH Each Face Horizontal  
EFV Each Face Vertical  
EW Each Way  
EPE Existing Edge of Pavement  
EPS Expanded Polystyrene  
ES Edge of Shoulder  
Elec. Electrical  
EMH Electrical Manhole  
El., Elev. Elevation  
Emb. Embankment  
EVC End of Vertical Curve  
Eq. Equal  
Est. Estimated  
Exc. Excavation  
Excl. Excluding  
Exist., Ex. Existing  
Exp., (E) Expansion  
EJ Expansion Joint  
Ext. Exterior

(F) Fixed  
FA Force account  
FB Flat Bar  
FC Compression Stresses  
f'c Specified Compressive Strength  
of Concrete at 28 days  
f'ci Specified Compressive Strength  
of Concrete at Time of Initial  
Prestress  
FF Far Face, Front Face  
Fig. Figure  
Fin. Gr. Finish Grade  
fr Modulus of Rupture  
FRP Fiberglass Reinforced Plastic  
FT Tensile Stresses  
Ftg. Footing  
Ft. Feet, Foot

Ga. Gage, Gauge  
Galv. Galvanized

GDI Grated Drain Inlet  
GFRP Glass Fiber Reinforced  
Polymer Rebar  
Gr. Grade  
Grd. Ground  
GRP Grouted Rubble Pavement  
Ht. Height  
(H) Hinge  
Horiz., H Horizontal  
HDOT State of Hawaii Department  
of Transportation  
HDPE High Density Polyethylene  
HS High strength  
HECO Hawaiian Electric Company  
HMA Hot Mix Asphalt

IB Inbound  
In. Inch  
ID Inside Diameter  
IF Inside Face  
Int. Interior  
Inv. Invert  
Jt. Joint  
JPCP Jointed Precast Concrete  
Pavement

K Kips  
KF Kip Foot  
KSF Kips Per Square Foot  
KSI Kips Per Square Inch  
KLF Kips Per Linear Foot

L Length  
lb., lbs., LBS. Pound, Pounds  
Ltg. Std. Lighting Standard  
LF, Lin. Ft. Linear Feet/Foot  
LS Lump Sum  
Longit. Longitudinal

M Modified  
MH Manhole  
Max. Maximum  
Mech. Mechanical  
Min. Minimum  
Misc. Miscellaneous  
MPH Miles Per Hour

NF Near Face  
N North  
NB Northbound  
NIC Not in Contract  
No. Number  
NTS Not to Scale  
NWIM Nanocrete Weigh-In-Motion  
O/S Offset

oc On Center  
Opn'g Opening  
OB Outbound  
OD Outside Diameter  
Perf. Perforated  
PL Plate  
PCCP Portland Cement Concrete  
Pavement  
PC Point of Curvature  
PCF Pounds per Cubic Foot  
P(e) Effective Prestress Force  
After All Losses  
PSF Pounds per Square Foot  
PSI, psi Pounds per Square Inch  
PLF Pounds per Linear Foot  
PI Point of Intersection  
of Tangents

PIVC Point of Intersection of  
Vertical Curve  
PT Point of Tangency  
Pt., Pts. Point, Points  
PRC Point of Reverse Curvature  
PVC Polyvinyl Chloride  
PPCP Precast Prestressed Concrete  
Pavement  
Prestr. Prestressed  
P/S Prestressed Strands  
PB Pull Box


Rad., R Radius  
RF Rear Face  
Rebar Reinforcing Bar  
Ref. Reference  
Reinf. Reinforced, Reinforcing,  
Reinforcement  
Req'd. Required  
Ret. Retaining  
ROW Right of Way  
Rdwy. Roadway

Sect. Section  
Sht. Sheet  
Sim. Similar  
Sl. Slope  
S South  
SB Southbound  
Spc., Spg. Spaces, Spacing  
Sprd. Spread  
Spec. Specification  
SF Square Feet  
SY Square Yard  
SS Stainless Steel  
Std. Standard  
Sta. Station  
Stiff. Stiffener  
Stirr. Stirrup

Stl. Steel  
Str. Straight  
Struct. Structure  
SE Super Elevation  
Symm. Symmetrical  
Tan. Tangent  
TC Continuity Tendons  
Temp. Temporary  
TD Deck Tendon  
Thk. Thick  
T Top  
T&B Top and Bottom  
TCE Top of Column (and Bent  
Cap Soffit) Elevation  
TOD Top of Deck  
TOP Top of Pier  
TFE Top of Footing Elevation  
Tot. Total  
Transv. Transverse  
TS Structural Tubing  
Typ. Typical  
Undergrd. Underground  
UTPB Untreated Permeable Base  
Var. Varies  
Vert., V Vertical  
VC Vertical Curve  
W/C Water/Cement  
w/ With  
W West  
WIM Weigh-In-Motion  
WWF Welded Wire Fabric  
WP Work Point, Working Point  
WS Water Surface  
Yr. Year

|                   |      |
|-------------------|------|
| DATE              | ____ |
| SURVEY PLOTTED BY | ____ |
| DESIGNED BY       | ____ |
| QUANTITIES BY     | ____ |
| CHECKED BY        | ____ |
| ORIGINAL PLAN     | ____ |
| NOTE BOOK         | ____ |
| No.               | ____ |

DRAWING NAME: Z:\000\_ONGOING\12-033-HEL MIDDLE STREET RECONSTRUCTION-DOHA.CAD\06-19-14\_BDA\HEL-MS004.DWG PLOT TIME: 06-19-14, 9:55 AM

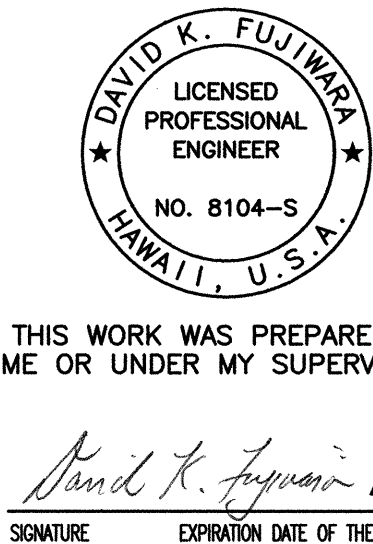

STATE OF HAWAII  
DEPARTMENT OF TRANSPORTATION  
HIGHWAYS DIVISION

**SYMBOLS & ABBREVIATIONS**

MIDDLE STREET PAVEMENT RECONSTRUCTION  
North King Street to Kamehameha Highway  
FAP NO. STP-7415(001)

Scale: None      Date: Jun. 20, 2014


SHEET No. **S04** OF **4** SHEETS



| FED. ROAD DIST. NO. | STATE | FEDERAL AID PROJ. NO. | FISCAL YEAR | SHEET NO. | TOTAL SHEETS |
|---------------------|-------|-----------------------|-------------|-----------|--------------|
| HAWAII              | HAW.  | STP-7415(001)         | 2014        | 118       | 173          |

Notes:

- For locations of longitudinal and transverse joints, See Pavement Jointing Plan, sheets S1.7 and S1.10.
- For travel way lanes, reinforce odd shaped panels and panels with mismatched joints (odd shaped panels are panels with length-to-width ratios greater than 1.25), and other non-square shaped panels with added trim bar as shown on sheets S1.3 and S1.4. Triangular shaped and non-square shaped panels are also considered odd-shaped panels.
- For the shoulder, rebar reinforcing is not required for panels that exceed the length to width ratio of 1.25 unless otherwise noted. Triangular shaped panels shall have added rebar and trim bar reinforcing.
- Provide shop drawings for all joint layouts a minimum of 2-weeks prior to work. Shop drawings shall include but not limited to reinforcing where obstructions such as manholes are encountered, termination of concrete with triangular or odd shaped panels, and at intersections.
- For other joint requirements, See Special Provision Section 411 - Portland Cement Concrete Pavement and sheets S1.2 to S1.10.
- For transition at PCCP Edges where abutting pavements:
  - Asphalt Concrete, See 7/S1.2
  - PCCP to JPCP, See 5/S1.2.
  - PCCP to PPCP, See 5/S1.2.

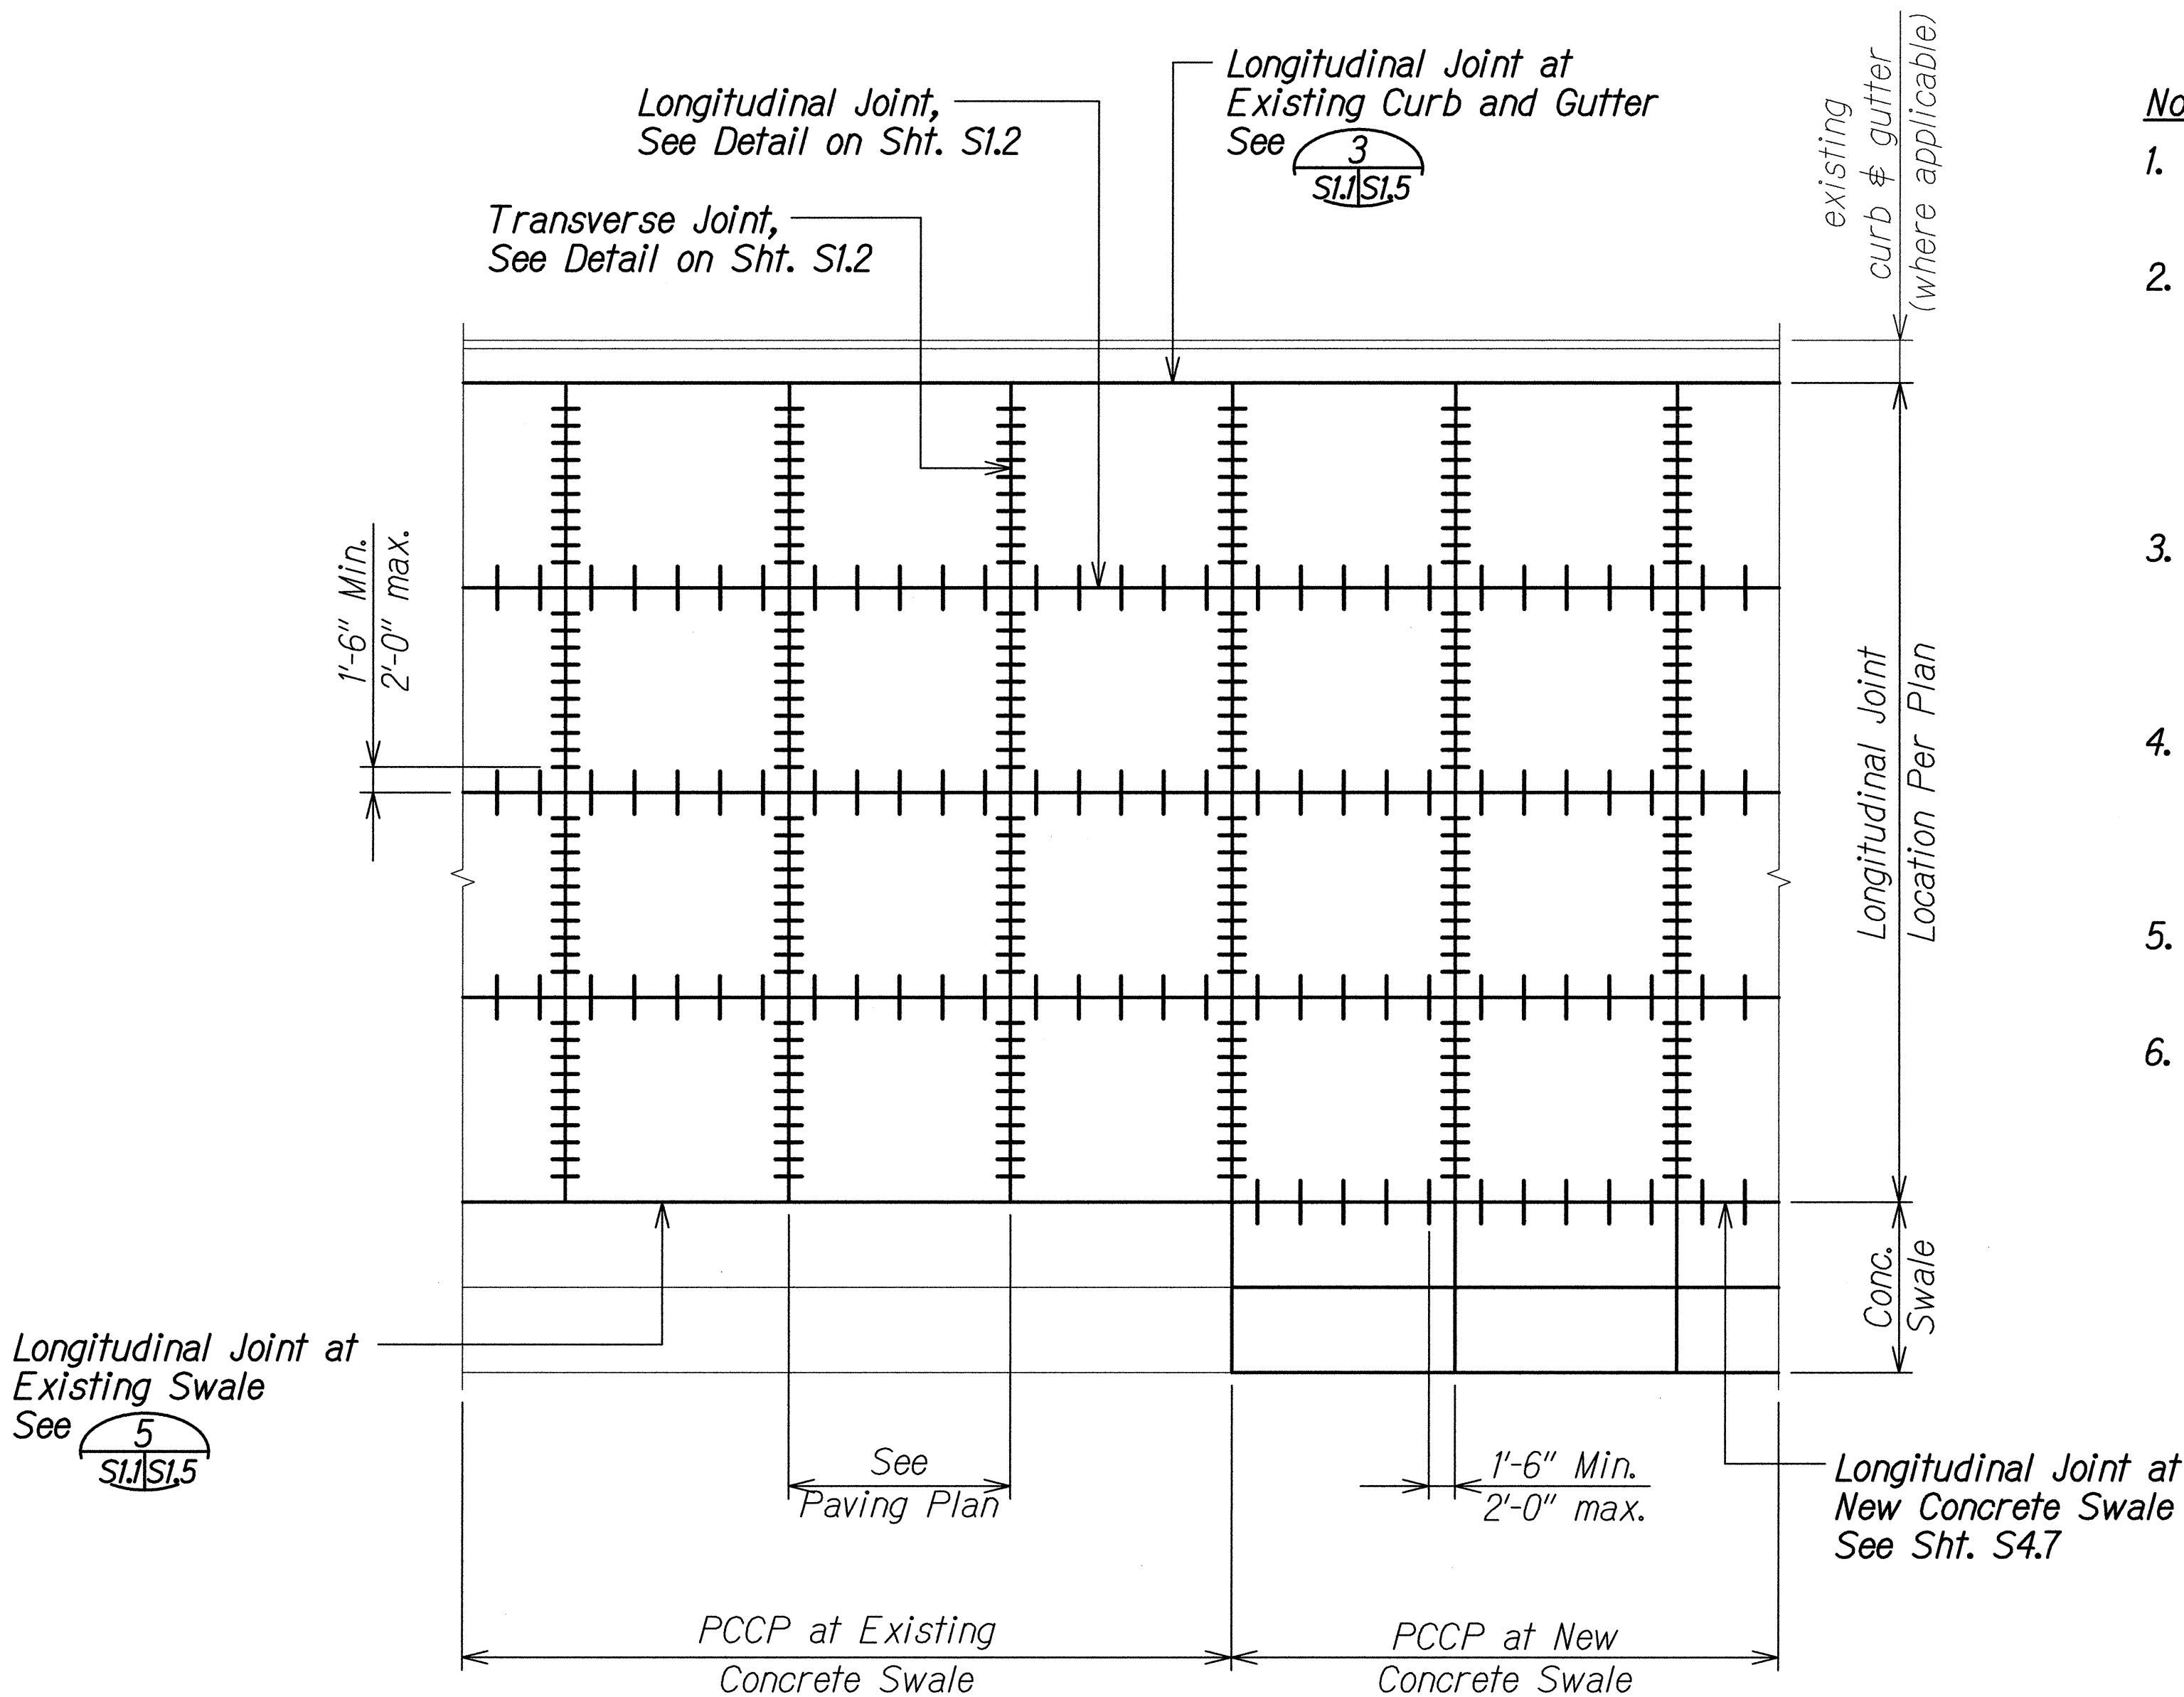


TYPICAL JOINT LOCATION AND LAYOUT PLAN  
FOR CONSTANT PCCP

Scale: 1/8" = 1'-0"



|               |      |
|---------------|------|
| ORIGINAL PLAN | DATE |
| DESIGNED BY   |      |
| CHECKED BY    |      |
| NOTED BY      |      |
| QUANTITIES BY |      |
| NO.           |      |

DRAWING NAME: 74100 ONCONC12-033-HFL MIDDLE STREET RECONSTRUCTION-DOTD(CAD)06-19-14 BDN\HFL-MS101 TO MS106.DWG PLOT TIME: 06-18-14, 6:49 PM

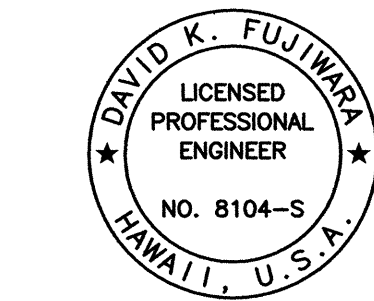

THIS WORK WAS PREPARED BY  
ME OR UNDER MY SUPERVISION.


Signature: *David K. Fujiwara*  
Date: 4-30-16  
EXPIRATION DATE OF THE LICENSE

STATE OF HAWAII  
DEPARTMENT OF TRANSPORTATION  
HIGHWAYS DIVISION


**TYPICAL PCCP JOINT LOCATION PLAN**  
MIDDLE STREET PAVEMENT RECONSTRUCTION  
North King Street to Kamehameha Highway  
FAP NO. STP-7415(001)  
Scale: As Noted Date: Jun. 20, 2014  
SHEET No. *S1.1* OF 10 SHEETS




| FED. ROAD DIST. NO. | STATE | FEDERAL AID PROJ. NO. | FISCAL YEAR | SHEET NO. | TOTAL SHEETS |
|---------------------|-------|-----------------------|-------------|-----------|--------------|
| HAWAII              | HAW.  | STP-7415(001)         | 2014        | 119       | 173          |

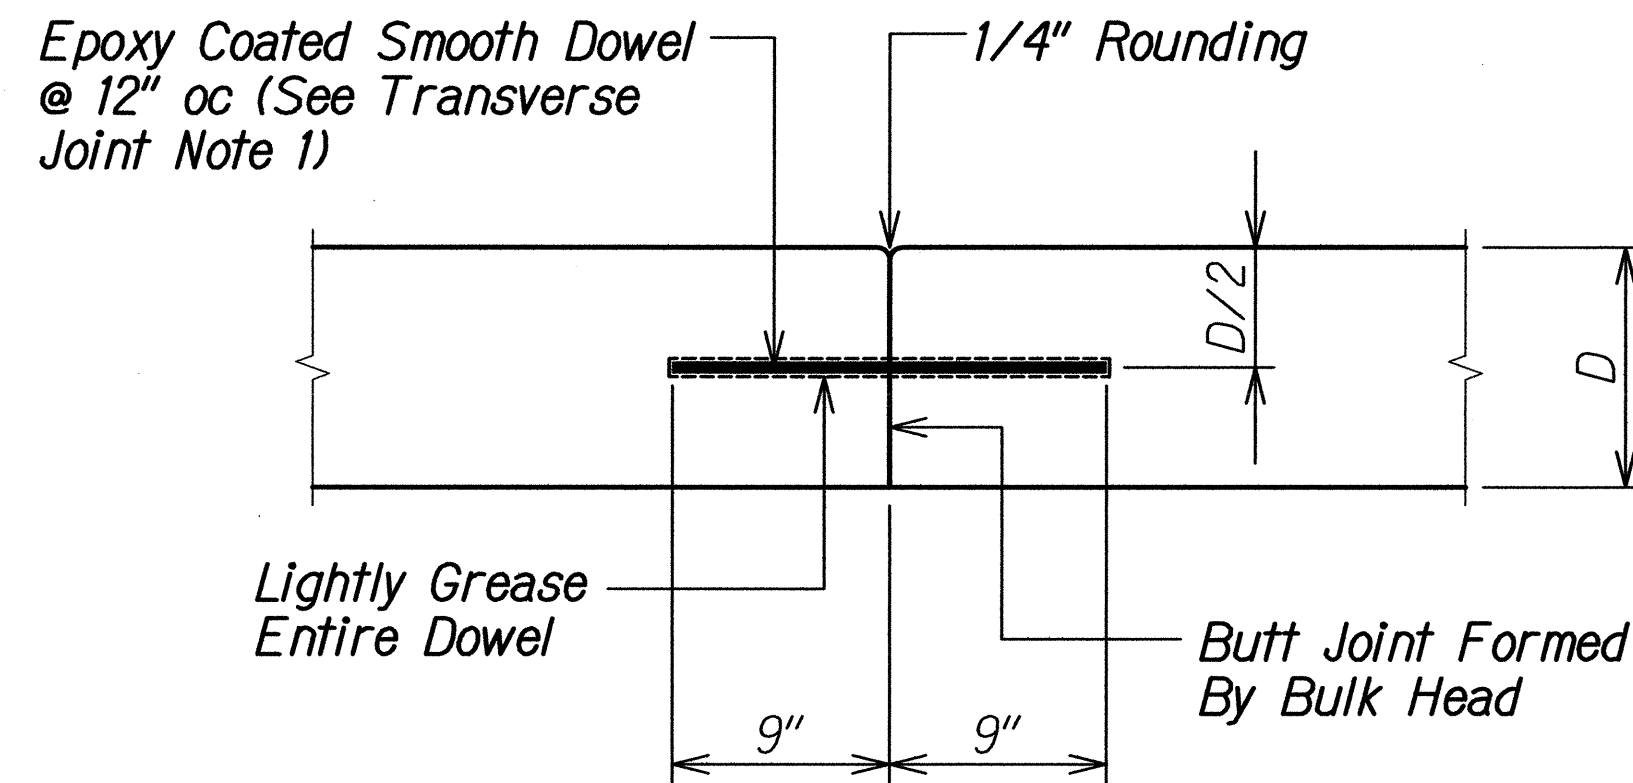


**TRANSVERSE CONSTRUCTION JOINT**  
Not to Scale  
SI.9, S3.12, SI.8, SI.2

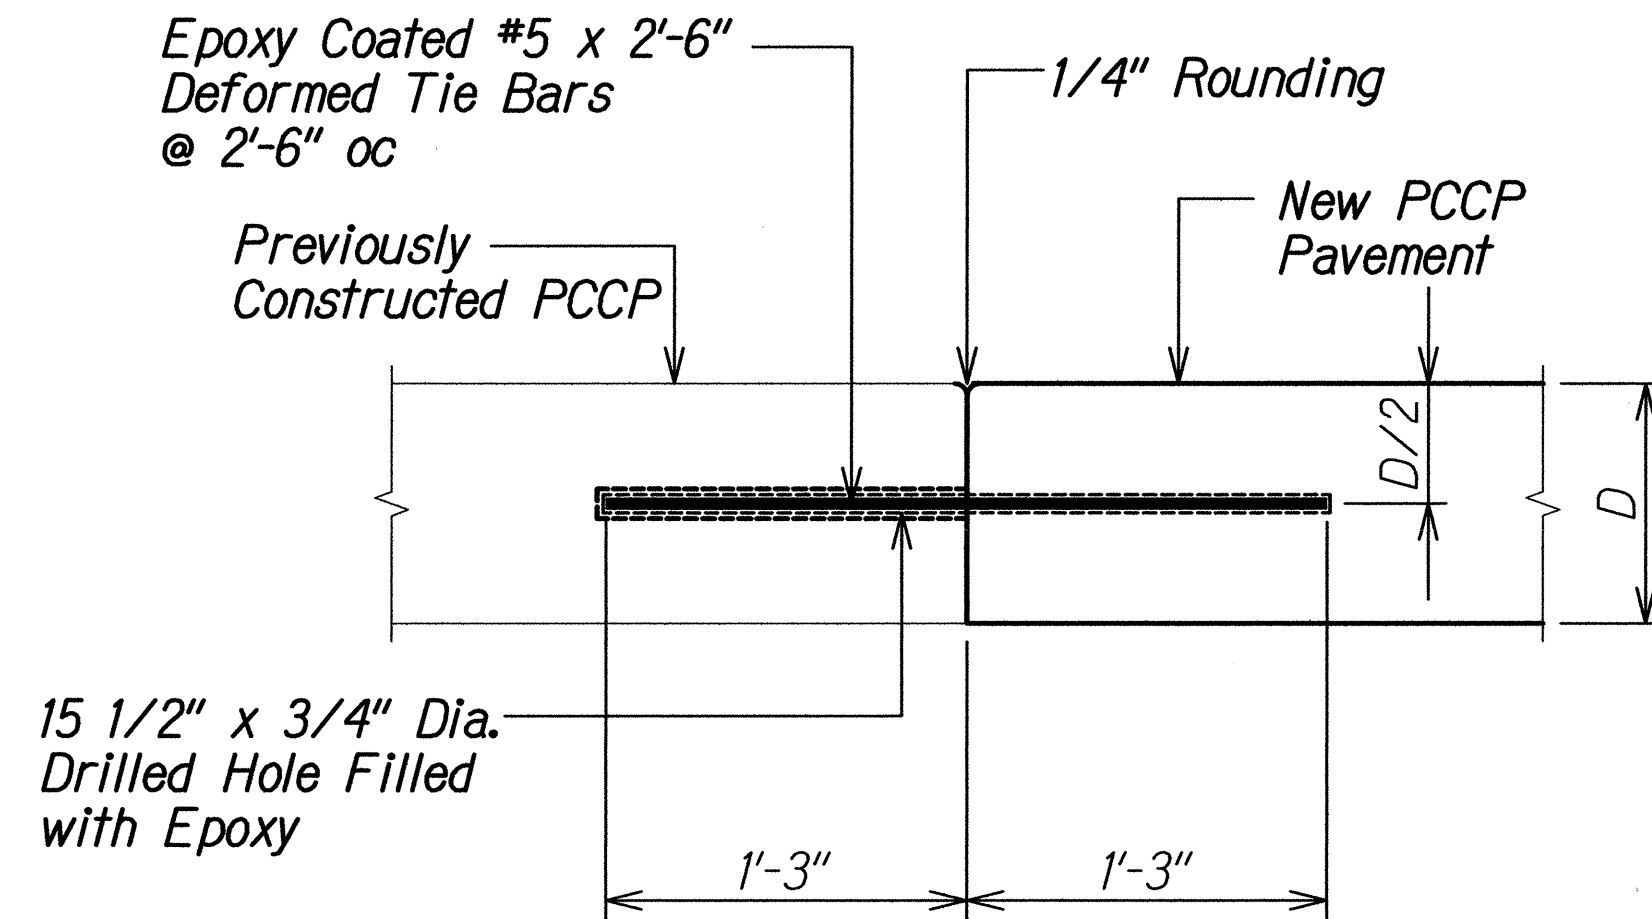


**LONGITUDINAL CONSTRUCTION JOINT AT HARDENED PCCP**  
Not to Scale  
SI.2, SI.2

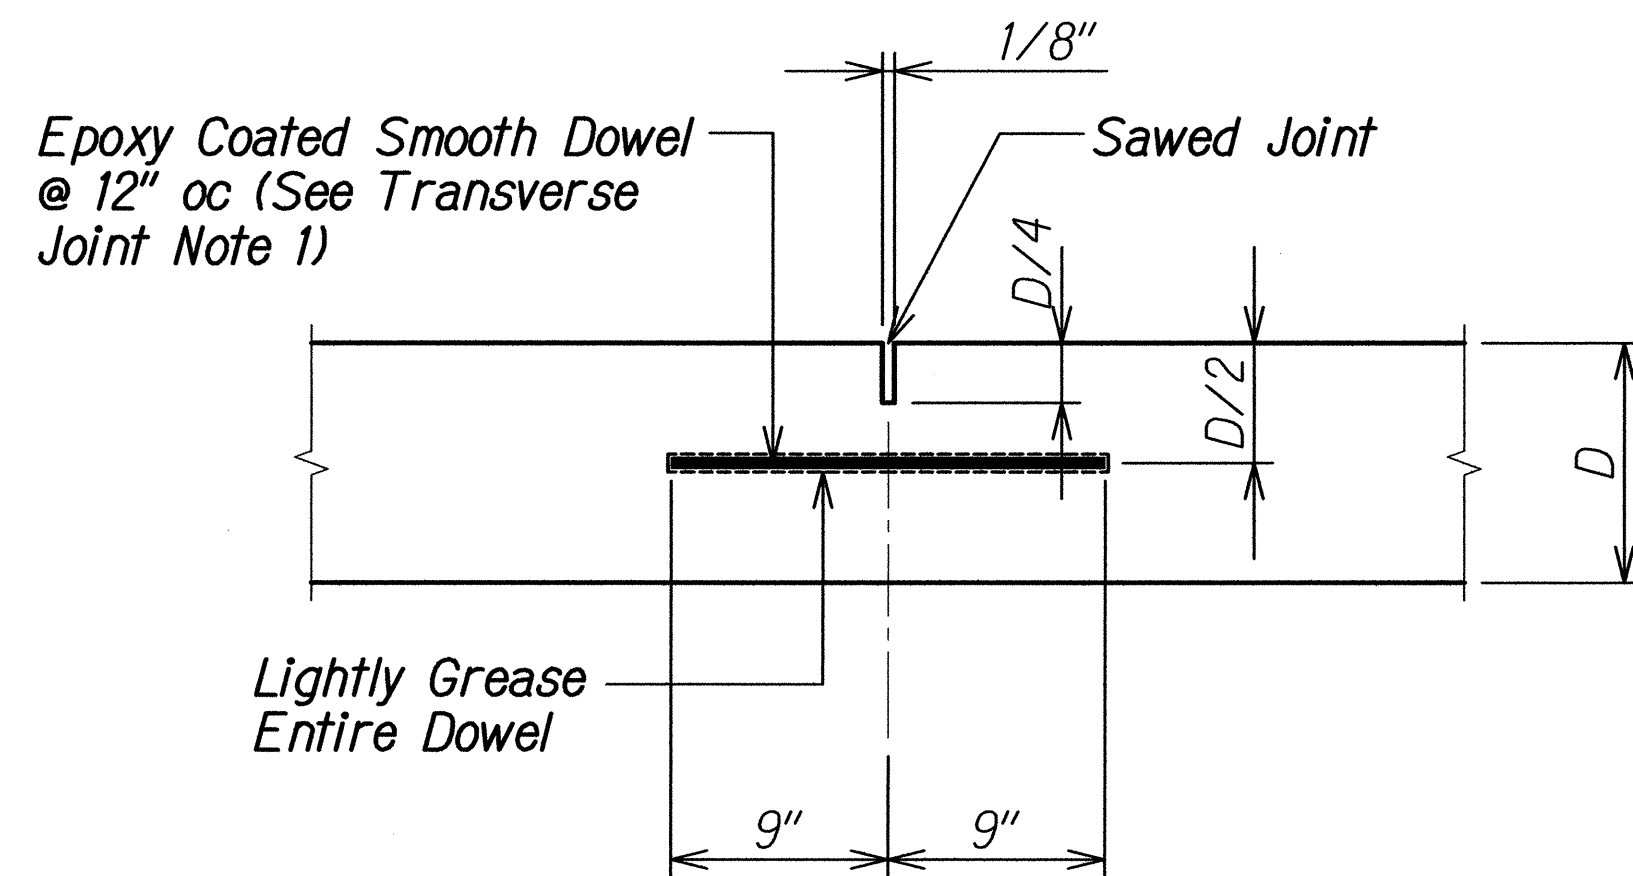


**TRANSVERSE CONTRACTION JOINT**  
Not to Scale  
SI.2, SI.2

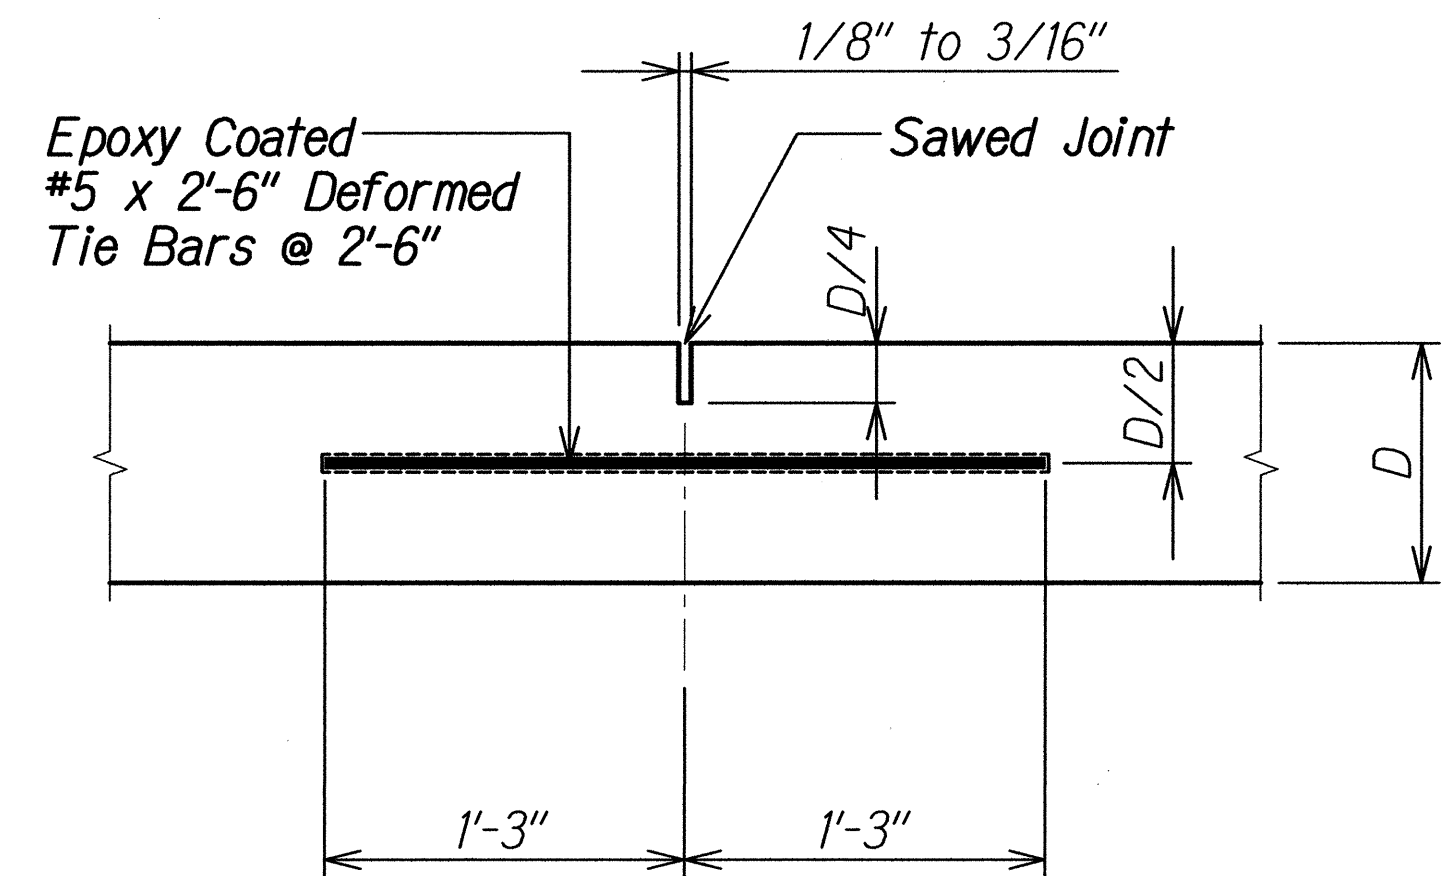

**LONGITUDINAL CONTRACTION JOINT**  
Not to Scale  
SI.2, SI.2

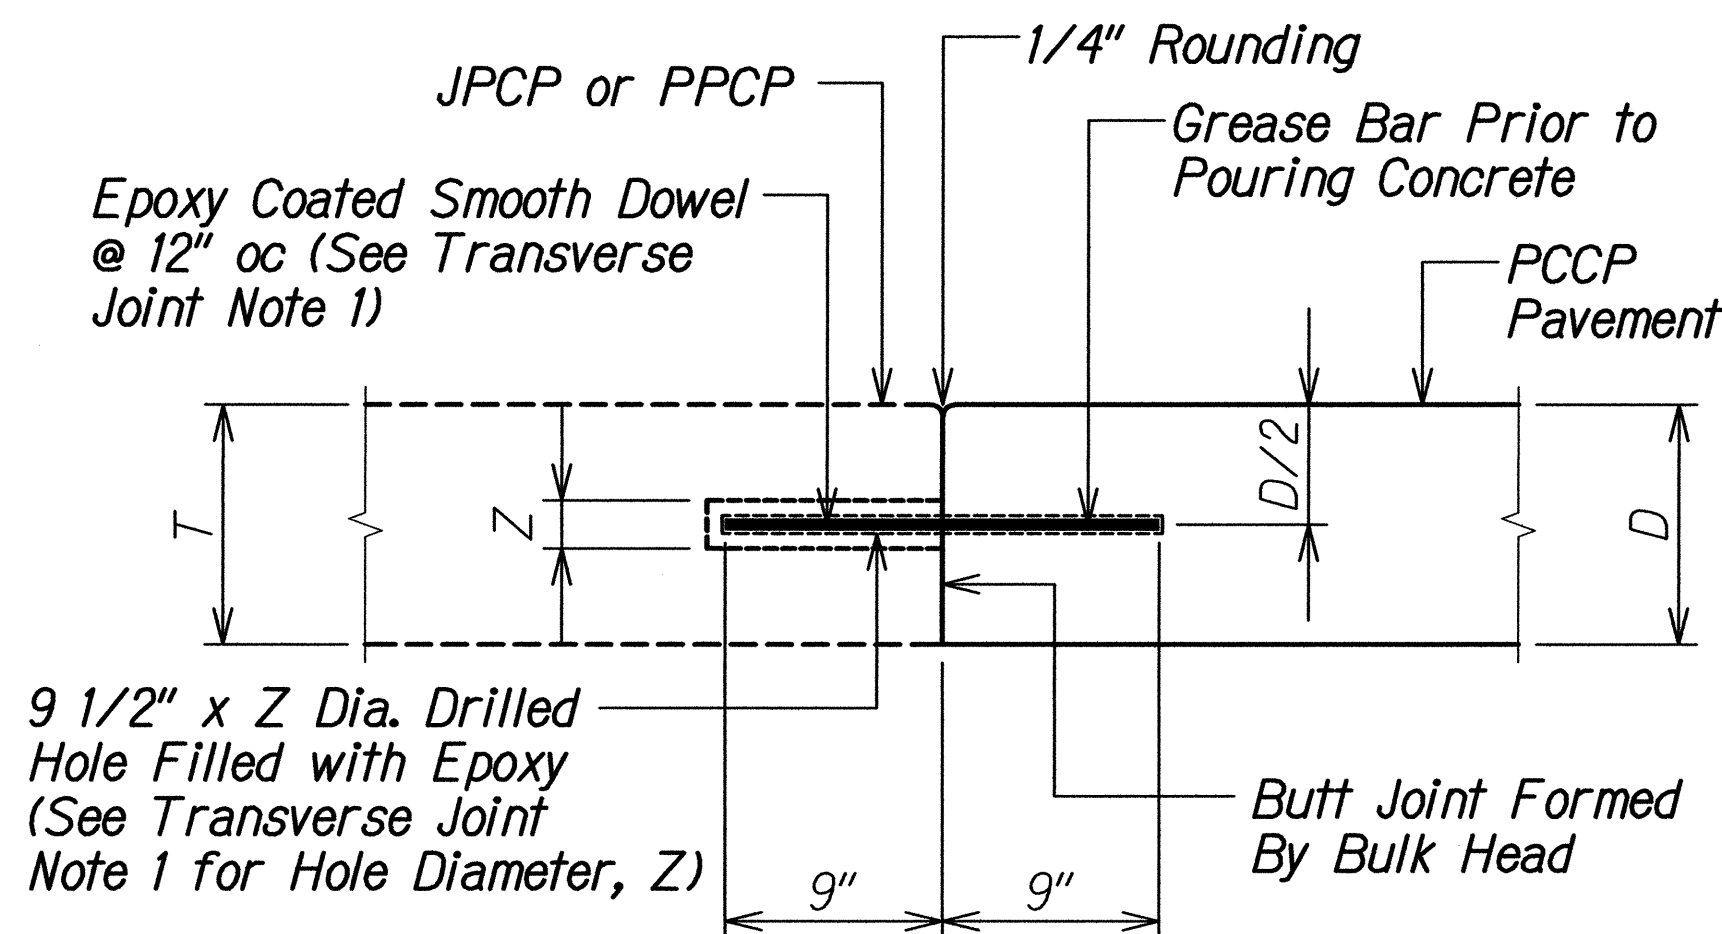

**TRANSVERSE CONSTRUCTION JOINT AT EXISTING JPCP OR PPCP**  
Not to Scale  
SI.8, SI.10, S2.8, S2.9, S2.10, SI.7, SI.2

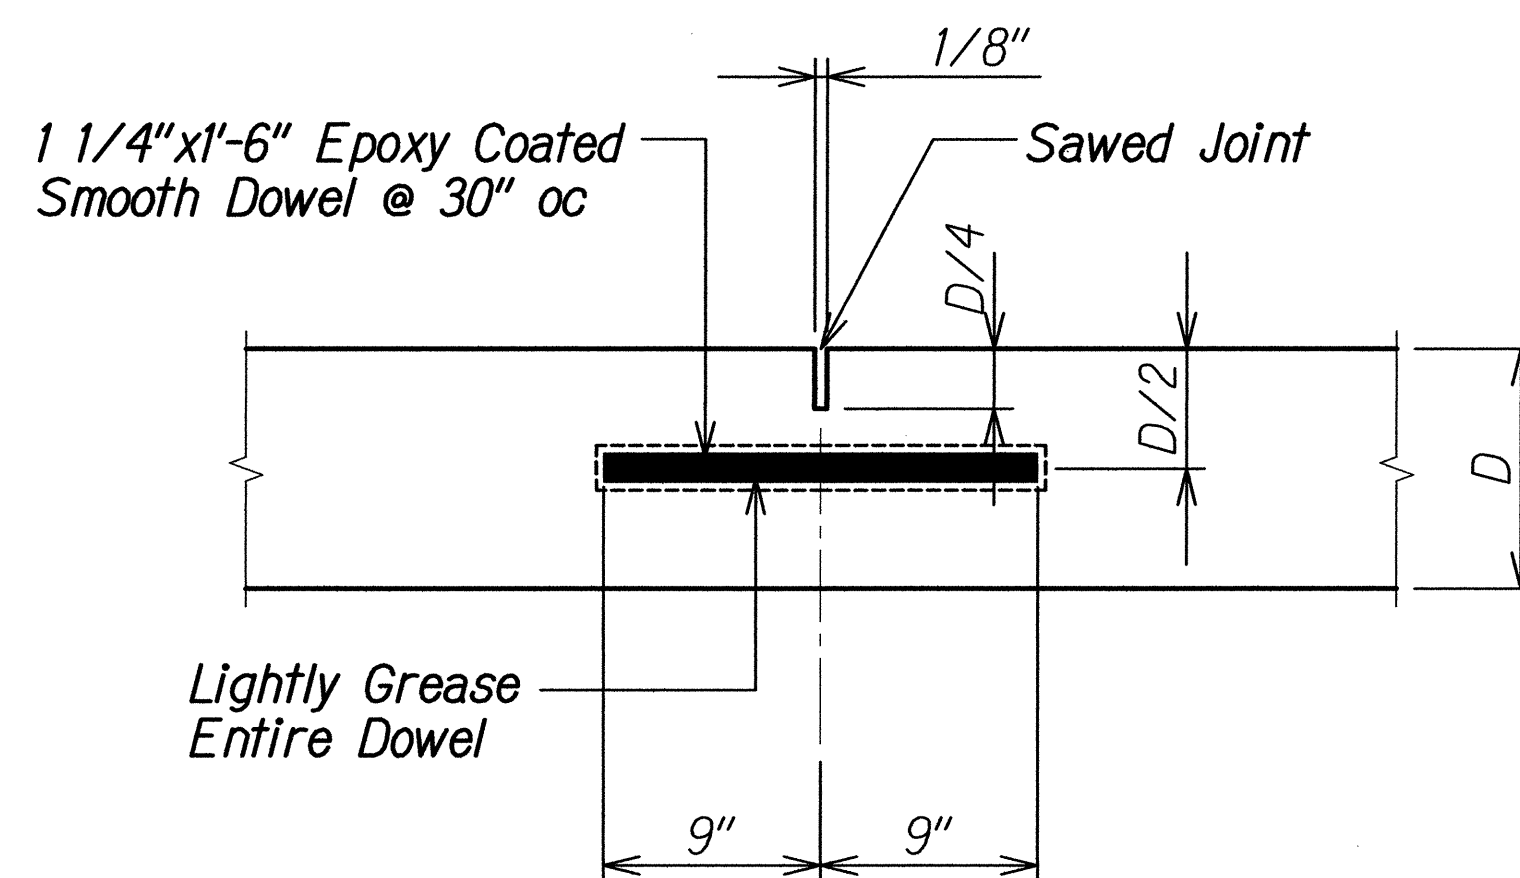


**LONGITUDINAL CONTRACTION JOINT WITH SMOOTH DOWEL**  
Not to Scale  
SI.2, SI.2

**Longitudinal Joint Notes:**

1. Epoxy-Coated deformed tie bars shall conform to ASTM A775 Grade 60.
2. Tiebars are to be located a minimum distance of 18 inches from a transverse joint. Tiebars closer to the transverse joint may interface with joint movement.
3. The Contractor shall not damage the epoxy coating on the deformed bars in any way during shipment, handling, placement or rebending. Damaged epoxy-coated deformed bars shall be replaced at no cost to the State. Repair of epoxy coating as approved by the Engineer shall meet ASTM A775.
4. For joint seal details see 4/SI.5.


**Transverse Joint Notes:**

1. Epoxy-Coated dowels shall conform to ASTM A775 Grade 60. For pavements with  $D < 10"$ , use 1 1/4" Dia. x 1'-6" long dowels. For pavements with  $D \geq 10"$ , use 1 1/2" Dia. x 1'-6" long dowels. Hole shall be drilled at a diameter, Z, equal to 1/8" larger than the diameter of the dowel.
2. Locate transverse construction joints at the nearest planned transverse contraction joint as shown on the jointing plans. Joint shall be perpendicular to paving lane.
3. It is critical that dowels be positioned in place parallel to the pavement surface and paving lane direction to avoid future cracks in the PCCP. The ends of the dowels shall not deviate more than 0.012' from the parallel in 9" length.
4. The Contractor shall not damage the epoxy coating on the dowel in any way during shipment, handling or placement. Damaged epoxy-coated dowels or rebar shall be replaced at no cost to the State. Repair of epoxy coating as approved by the Engineer shall meet ASTM A775.
5. For joint seal details see 4/SI.5.

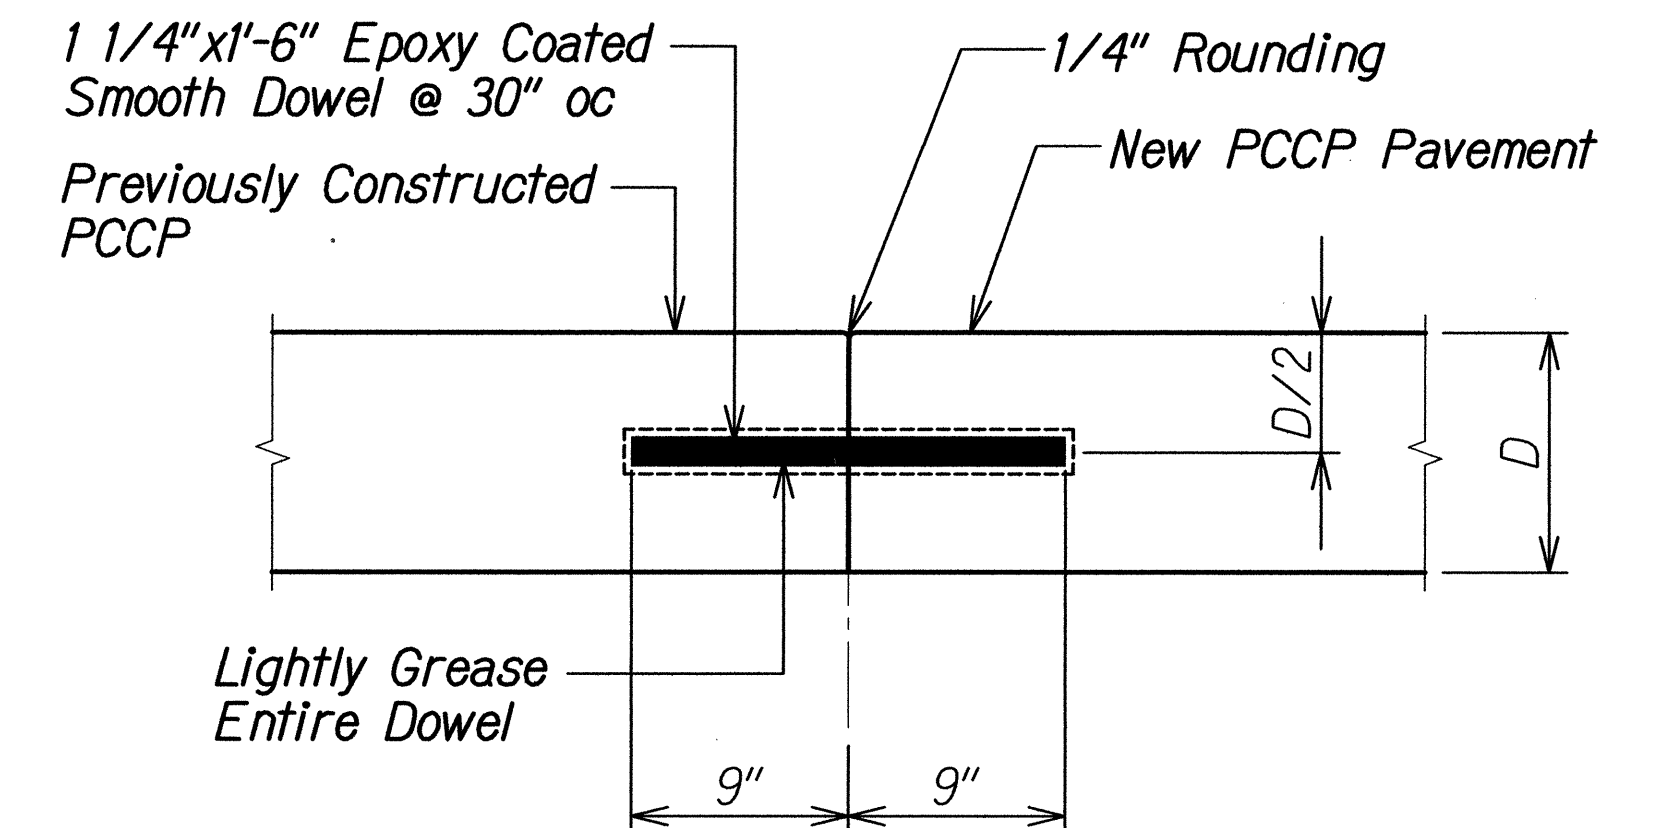

**LONGITUDINAL CONSTRUCTION JOINT WITH SMOOTH DOWEL**  
Not to Scale  
SI.2, SI.2

For Dimension D,  
See Pavement Detail  
on Sheets T-1 and T-2.  
Dimension T = Existing  
Pavement Thickness

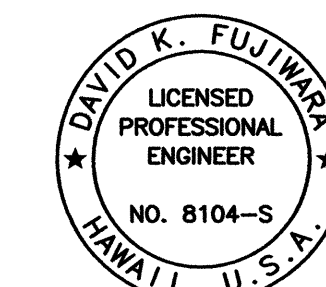

THIS WORK WAS PREPARED BY  
ME OR UNDER MY SUPERVISION.  
Signature: David K. Fujiwara  
EXPIRATION DATE OF THE LICENSE: 4-30-16

STATE OF HAWAII  
DEPARTMENT OF TRANSPORTATION  
HIGHWAYS DIVISION

**TYPICAL PCCP JOINT DETAILS**


MIDDLE STREET PAVEMENT RECONSTRUCTION  
North King Street to Kamehameha Highway  
FAP NO. STP-7415(001)

Scale: As Noted Date: Jun. 20, 2014


SHEET No. SI.2 OF 10 SHEETS



| FED. ROAD DIST. NO. | STATE | FEDERAL AID PROJ. NO. | FISCAL YEAR | SHEET NO. | TOTAL SHEETS |
|---------------------|-------|-----------------------|-------------|-----------|--------------|
| HAWAII              | HAW.  | STP-7415(001)         | 2014        | 120       | 173          |

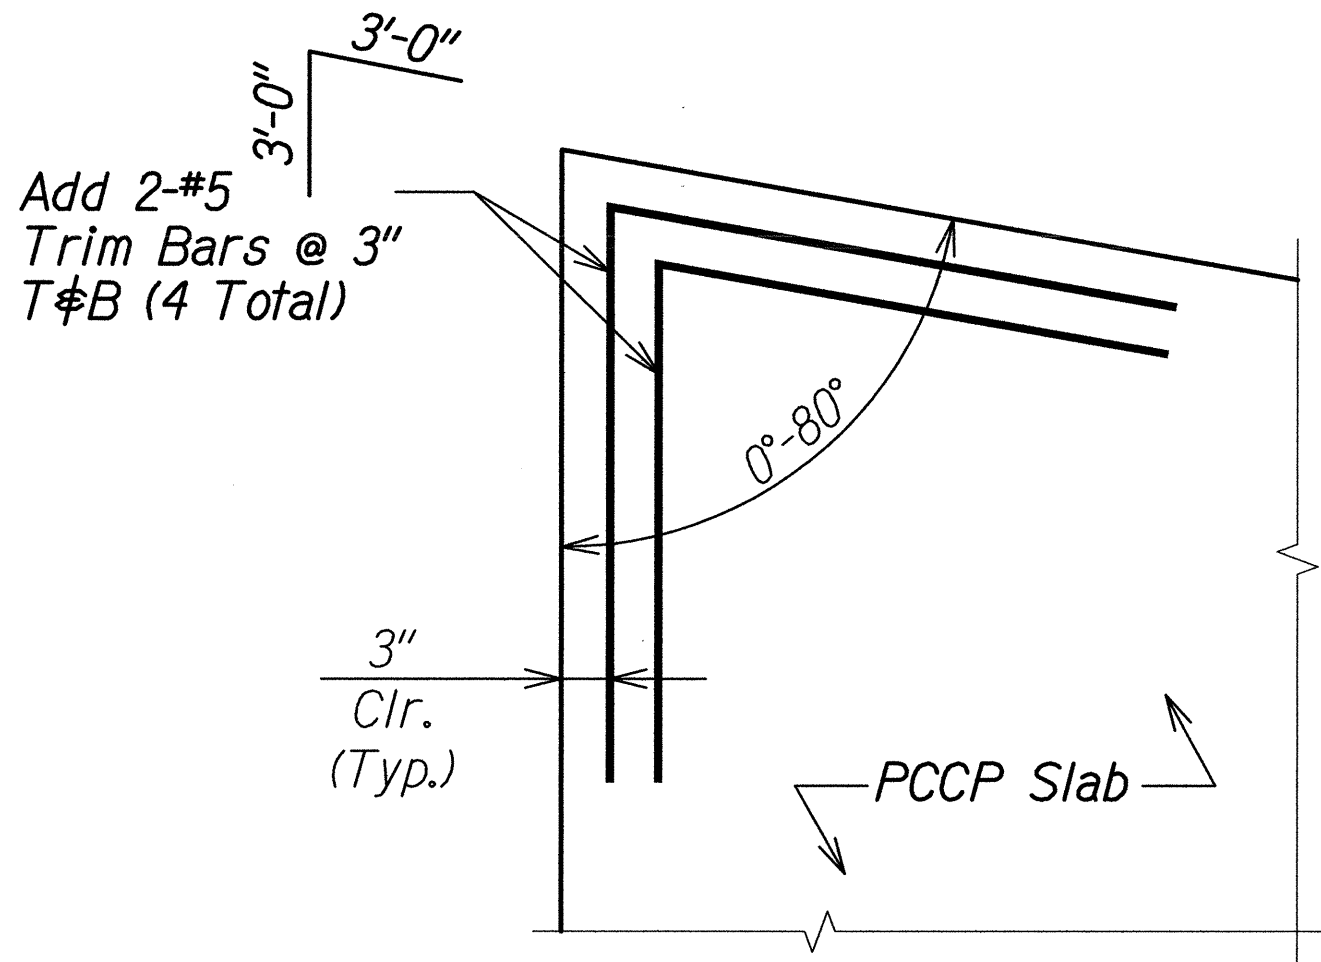


- Notes:
- Concrete for odd shaped panels shall be reinforced with fibers and added rebar. See General Notes 4.(F) and 7.(H) on sheet S0.2.
  - For standard shaped (not odd shaped or with mismatched joints) panels with openings, only fibers with added trim bars are required. See General Note 4.(F) on sheet S0.2.

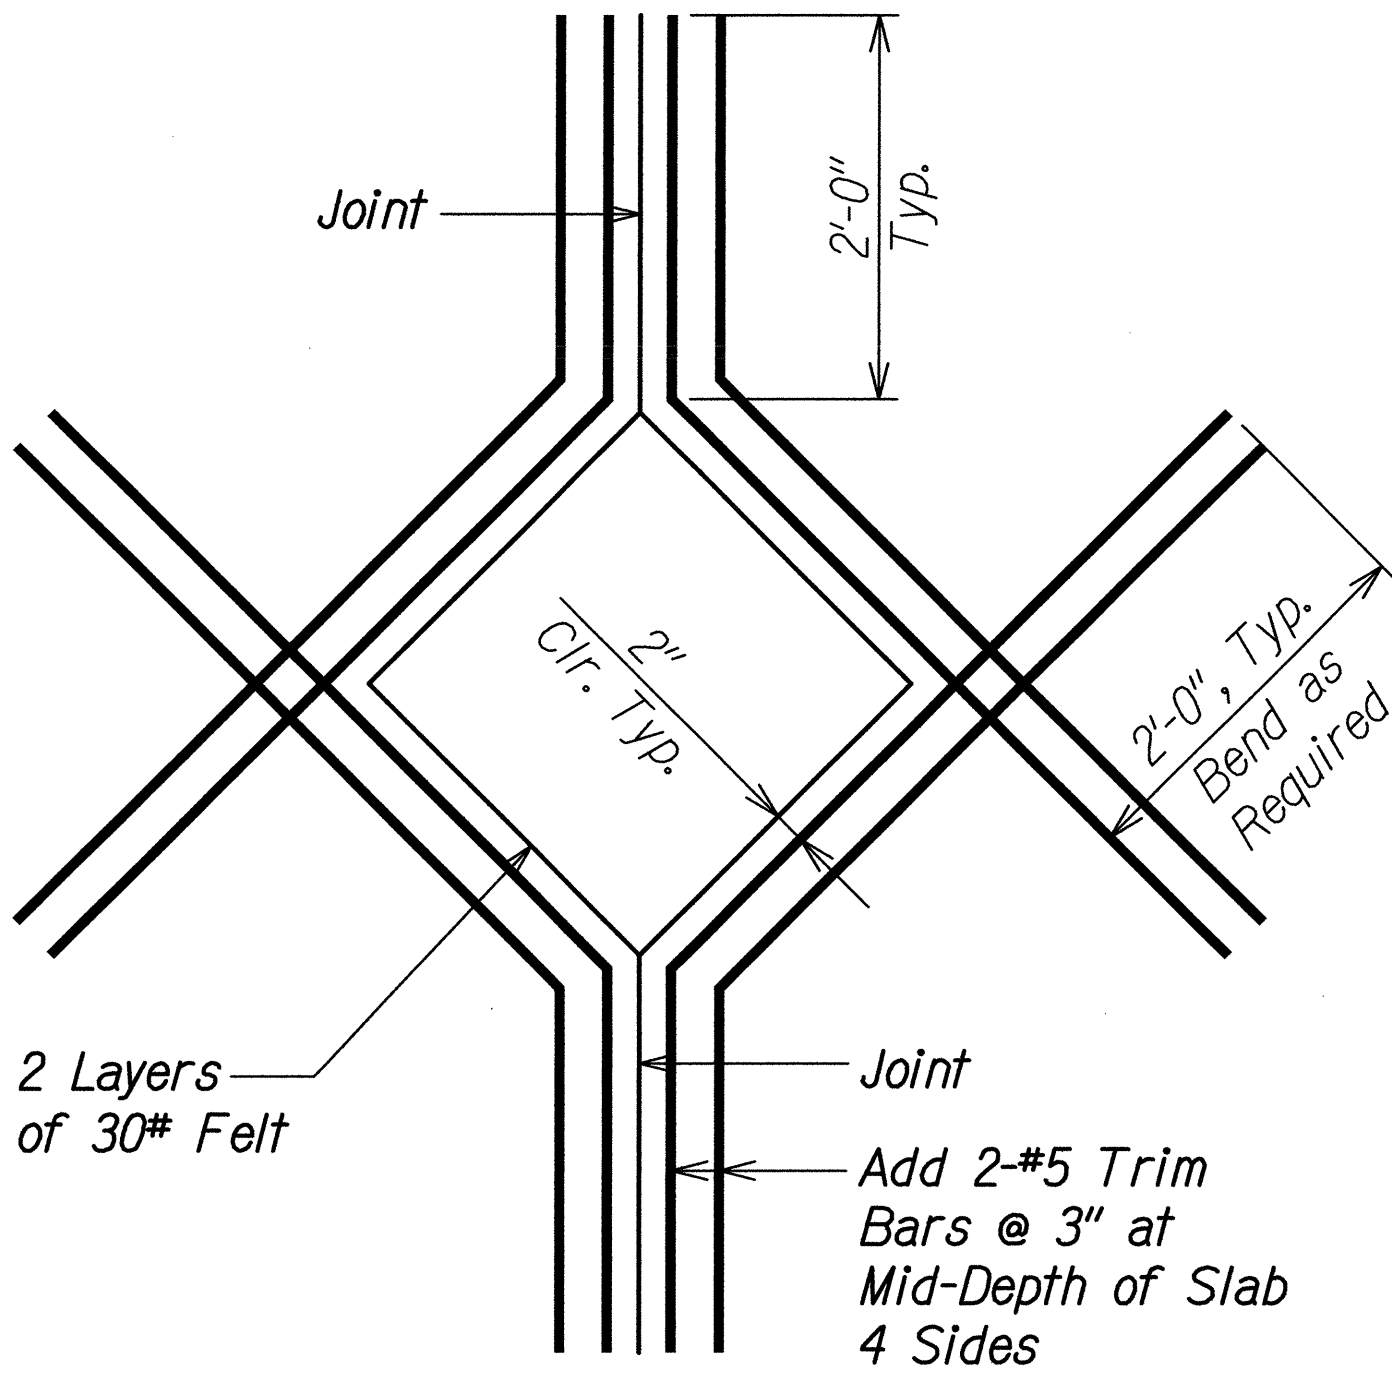


OPENING W/ CORNERS-CORNERS  
AT A JOINT DETAIL

Not to Scale

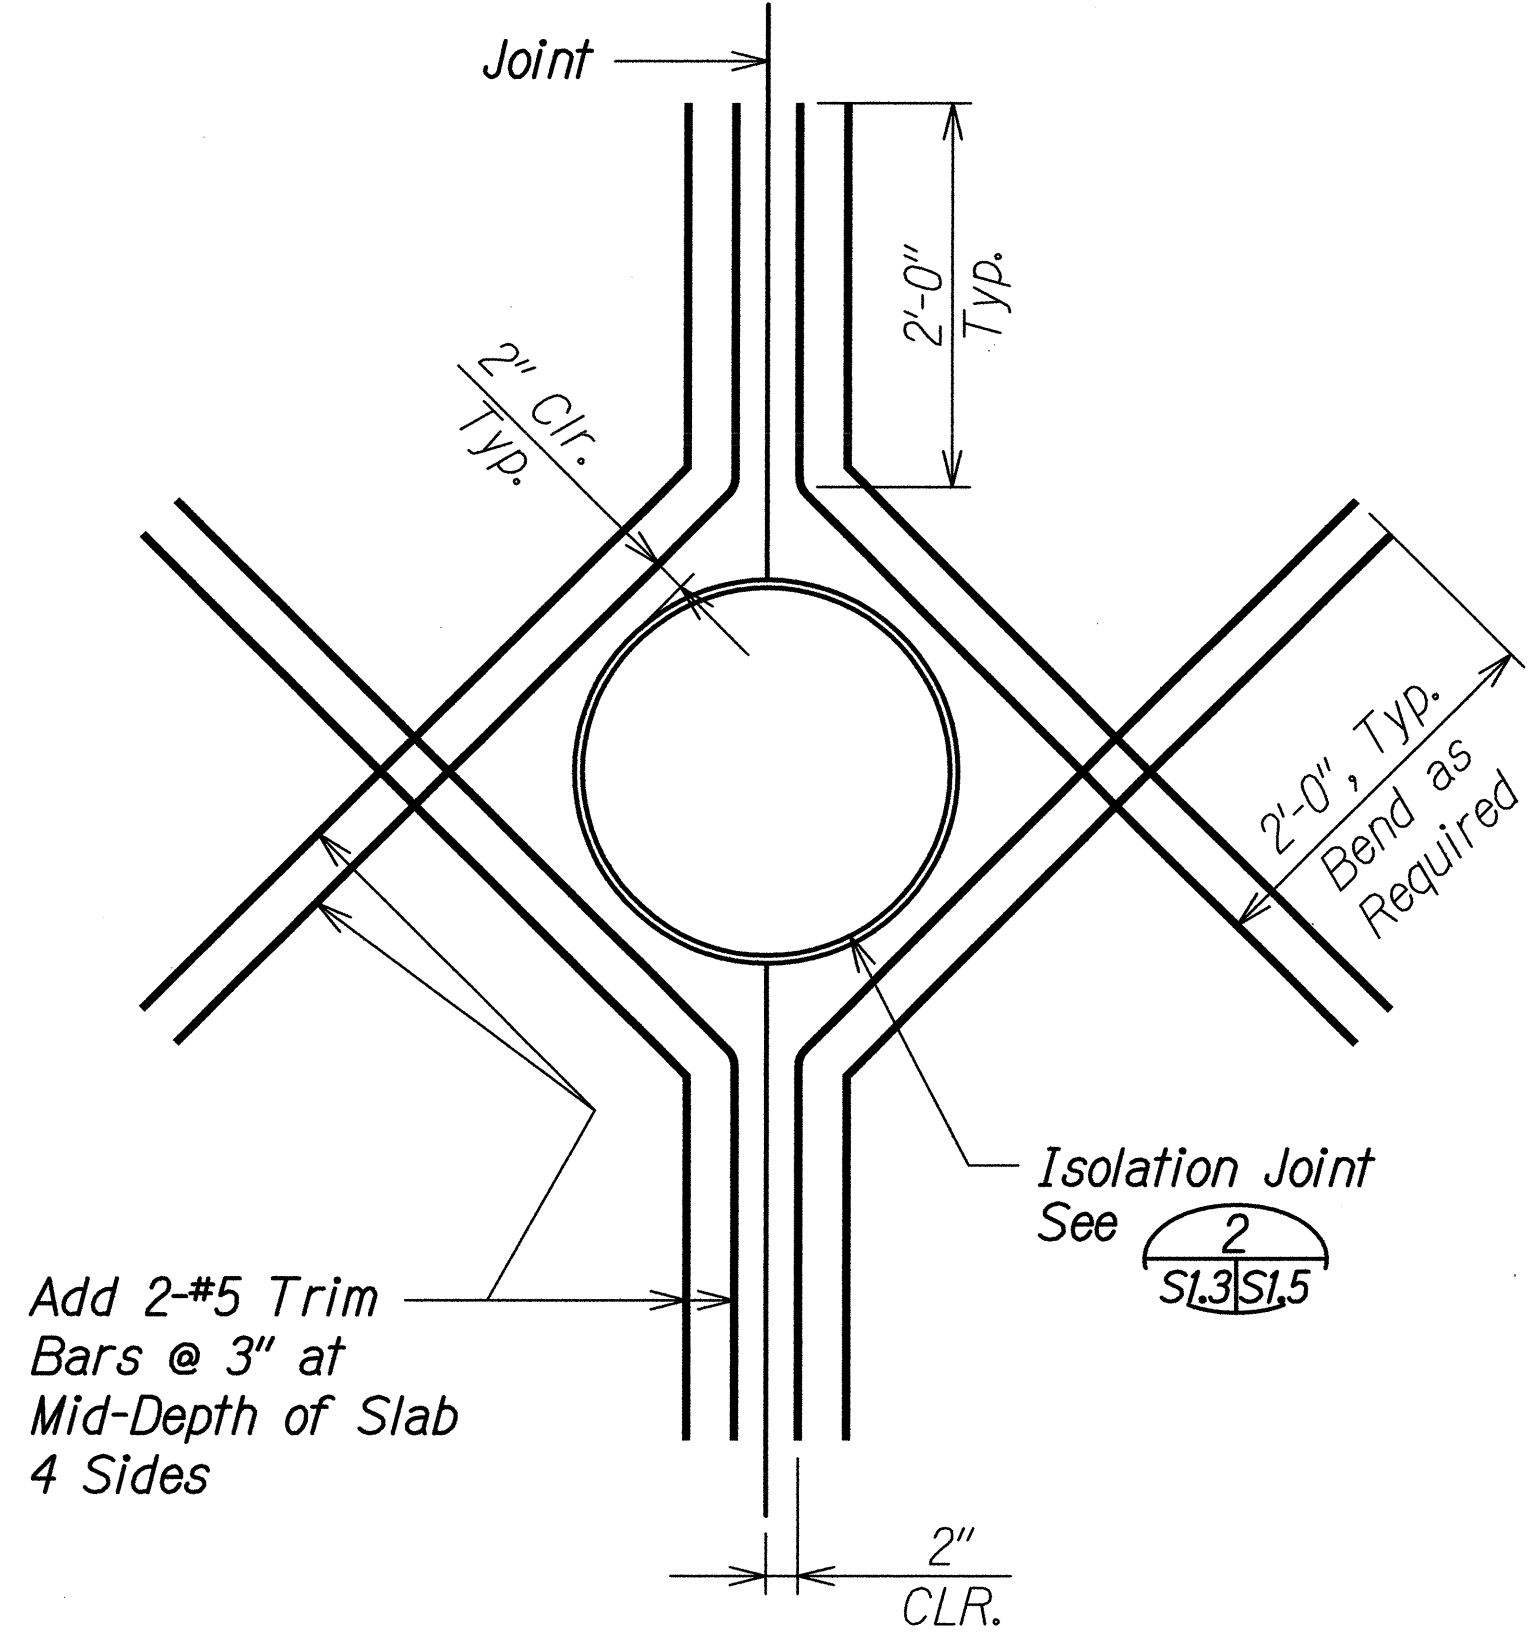

ADDED REINFORCEMENT AT ODD-SHAPED  
PCCP POURS FOR CURVED PCCP EDGE

Not to Scale

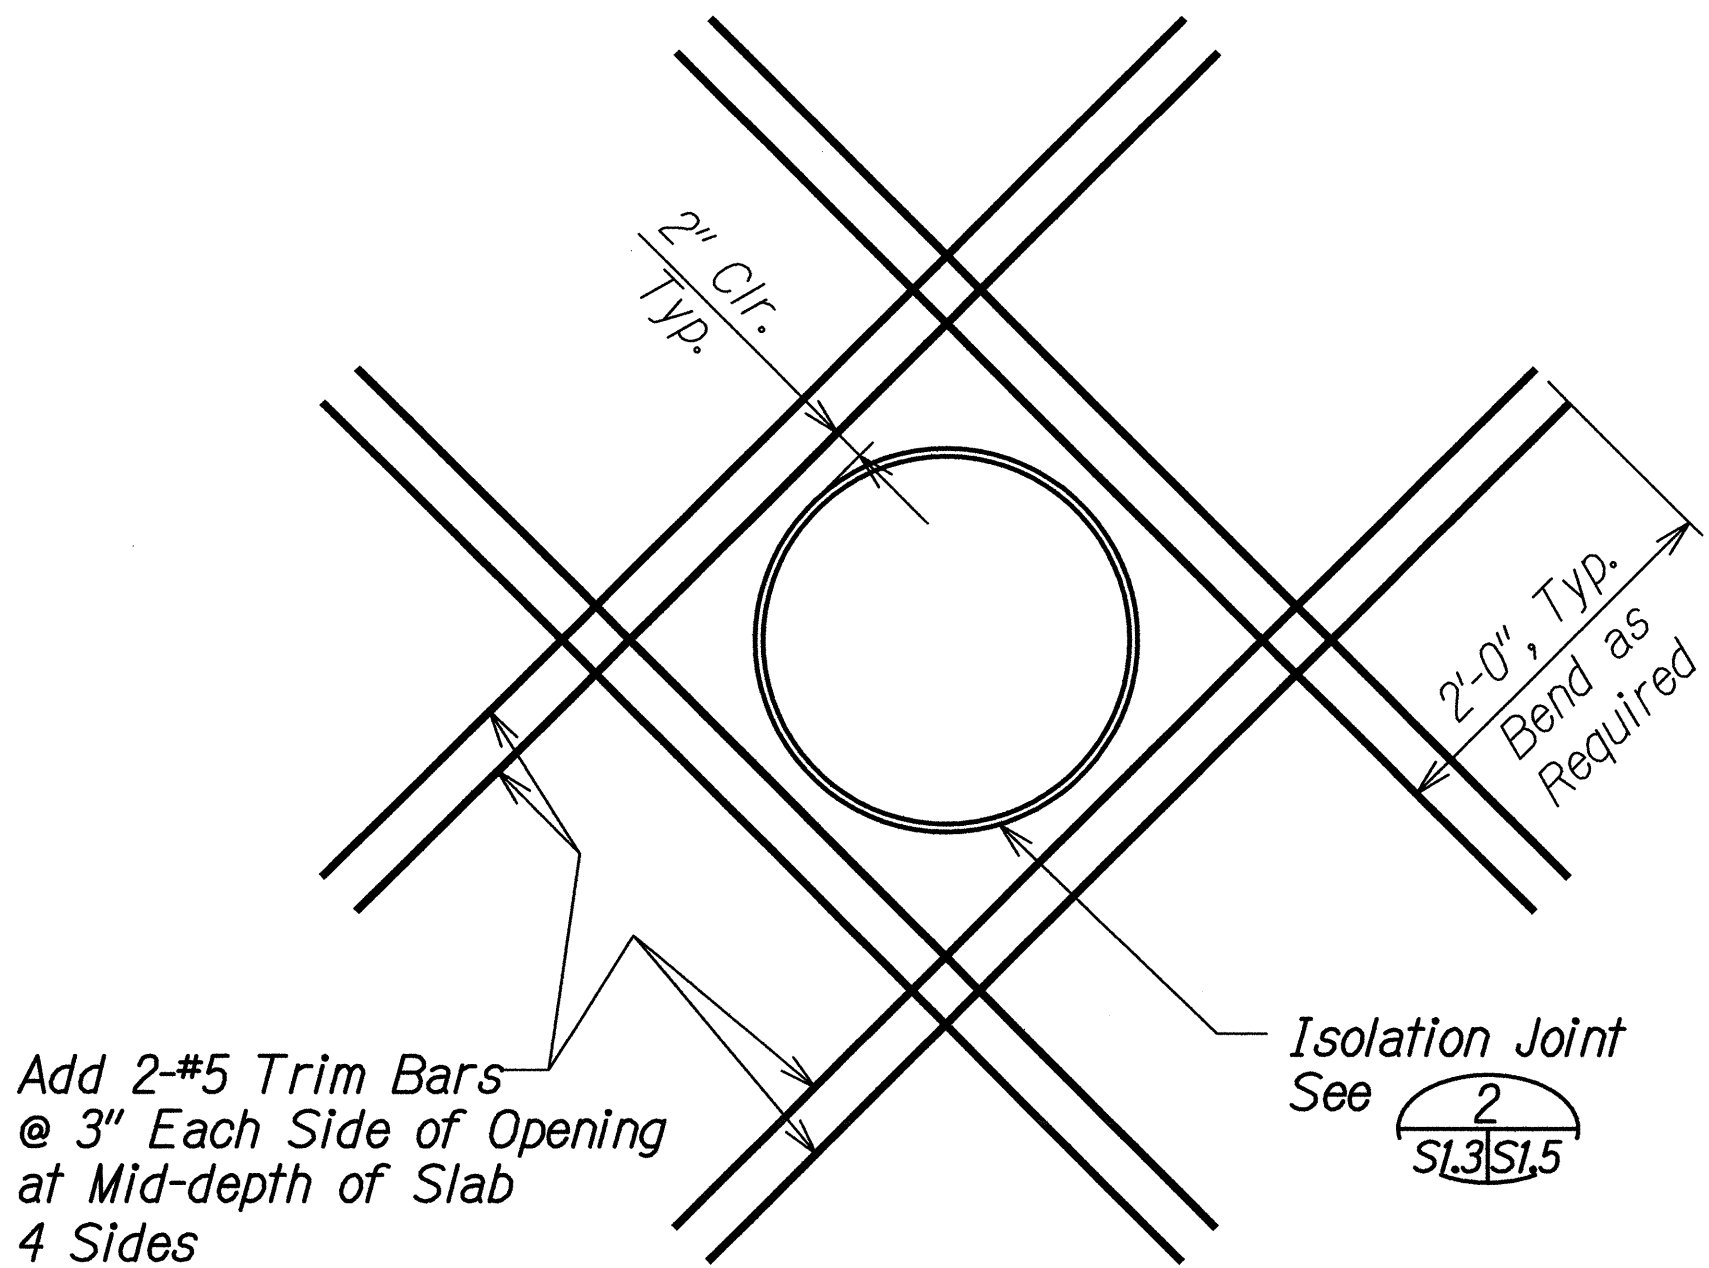


CIRCULAR OPENING DETAIL

Not to Scale

|                   |      |
|-------------------|------|
| SURVEY PLOTTED BY | DATE |
| DRAWN BY          |      |
| DESIGNED BY       |      |
| QUANTITIES BY     |      |
| CHECKED BY        |      |
| NO.               |      |

DRAWING NAME: 2100 DONGWEN12-0331-HFL MIDDLE STREET RECONSTRUCTION-40TH CAD 06-19-14 BDL-HFL-MS101 TO MS106.DWG PLOT TIME: 06-18-14, 6:51 PM

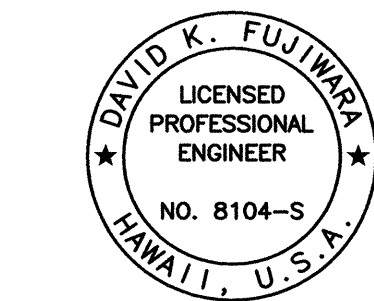


THIS WORK WAS PREPARED BY  
ME OR UNDER MY SUPERVISION.

Signature: *David K. Fujiwara*  
Date: 4-30-16  
EXPIRATION DATE OF THE LICENSE


STATE OF HAWAII  
DEPARTMENT OF TRANSPORTATION  
HIGHWAYS DIVISION  
  
**TYPICAL PCCP JOINT DETAILS**  
MIDDLE STREET PAVEMENT RECONSTRUCTION  
North King Street to Kamehameha Highway  
FAP NO. STP-7415(001)  
Scale: As Noted Date: Jun. 20, 2014  
SHEET No. S1.3 OF 10 SHEETS




| FED. ROAD DIST. NO. | STATE | FEDERAL AID PROJ. NO. | FISCAL YEAR | SHEET NO. | TOTAL SHEETS |
|---------------------|-------|-----------------------|-------------|-----------|--------------|
| HAWAII              | HAW.  | STP-7415(001)         | 2014        | 121       | 173          |

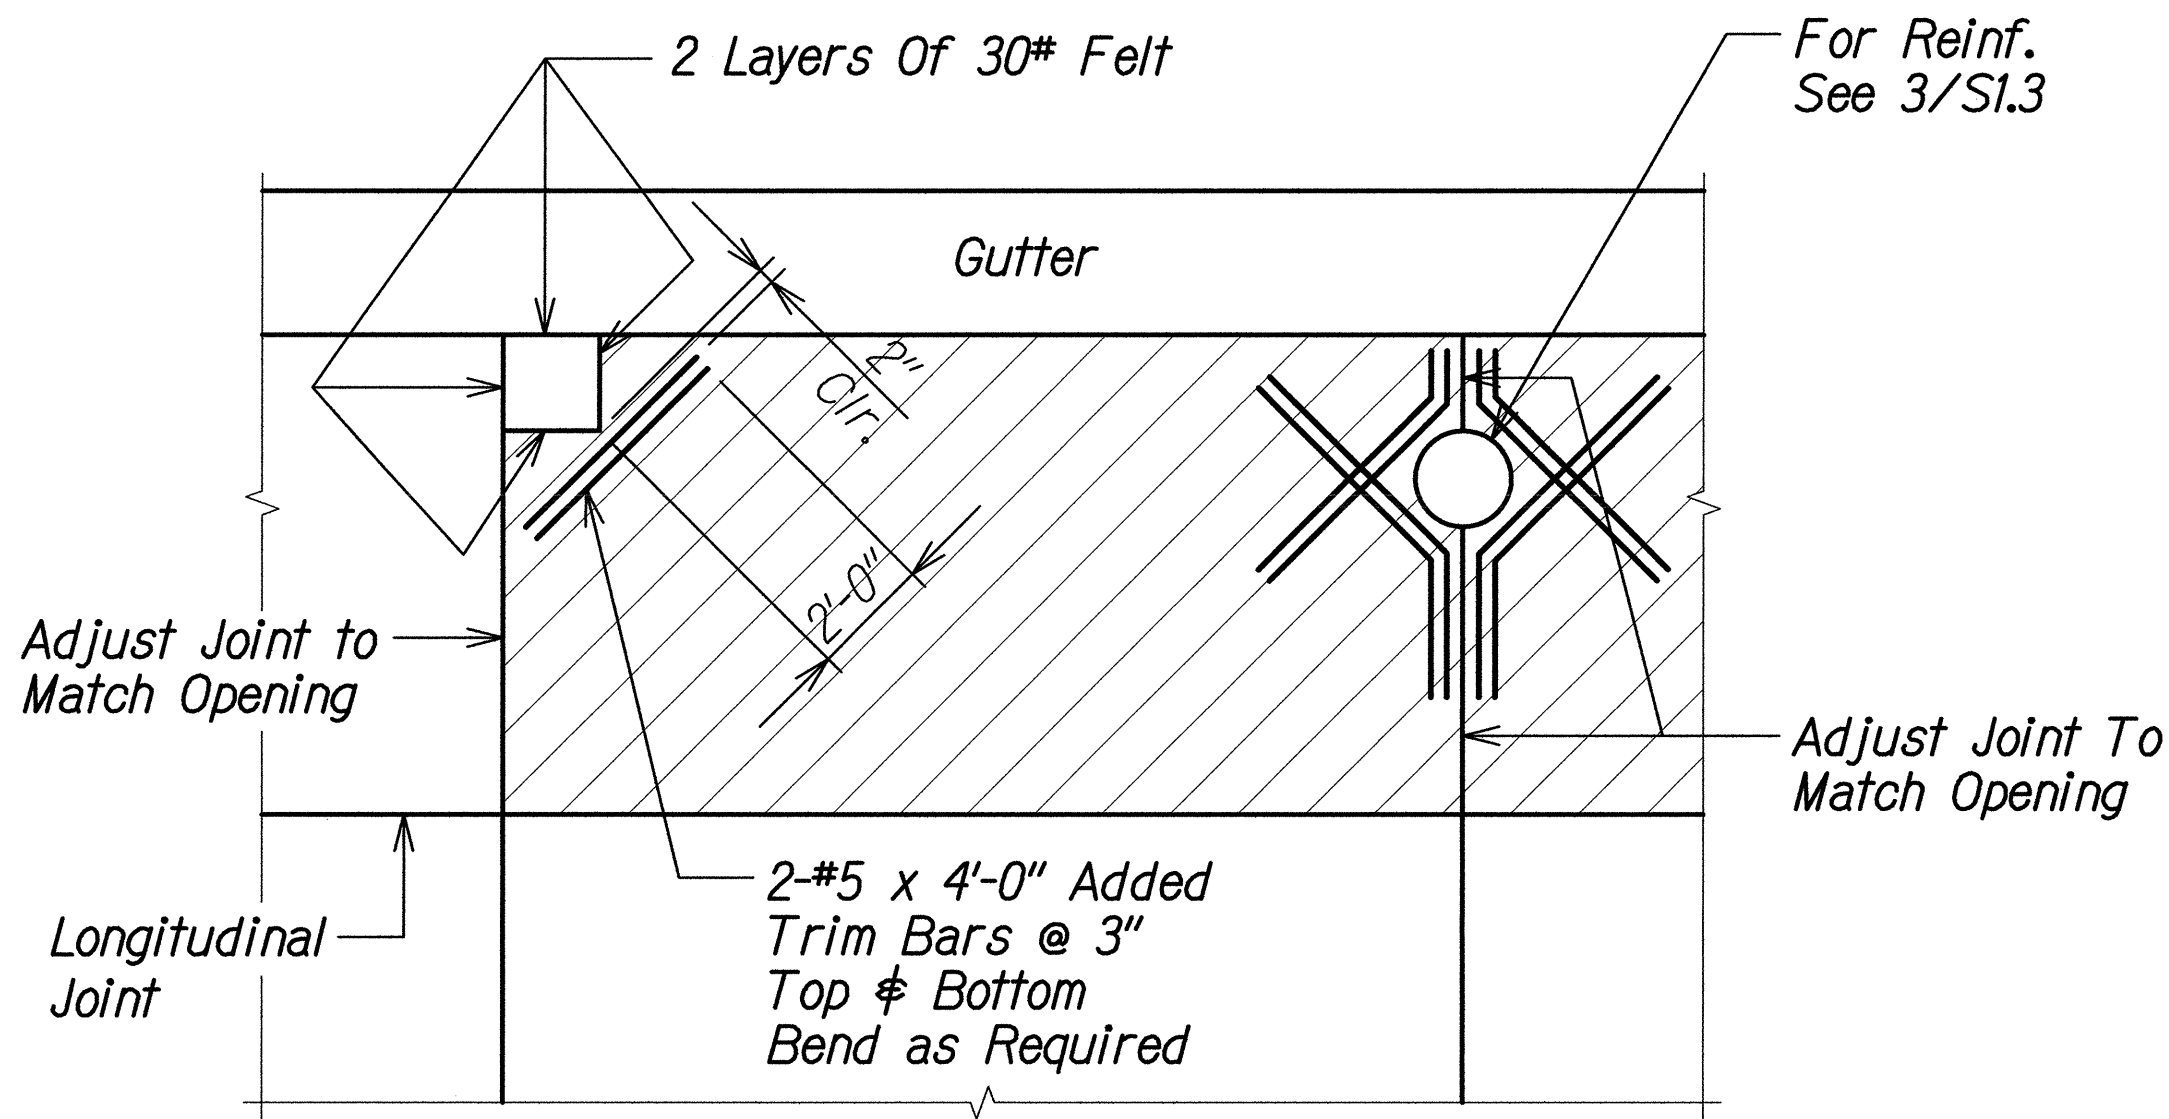

OPENING NEAR JOINTS DETAIL 1  
Not to Scale S1.4 S1.4

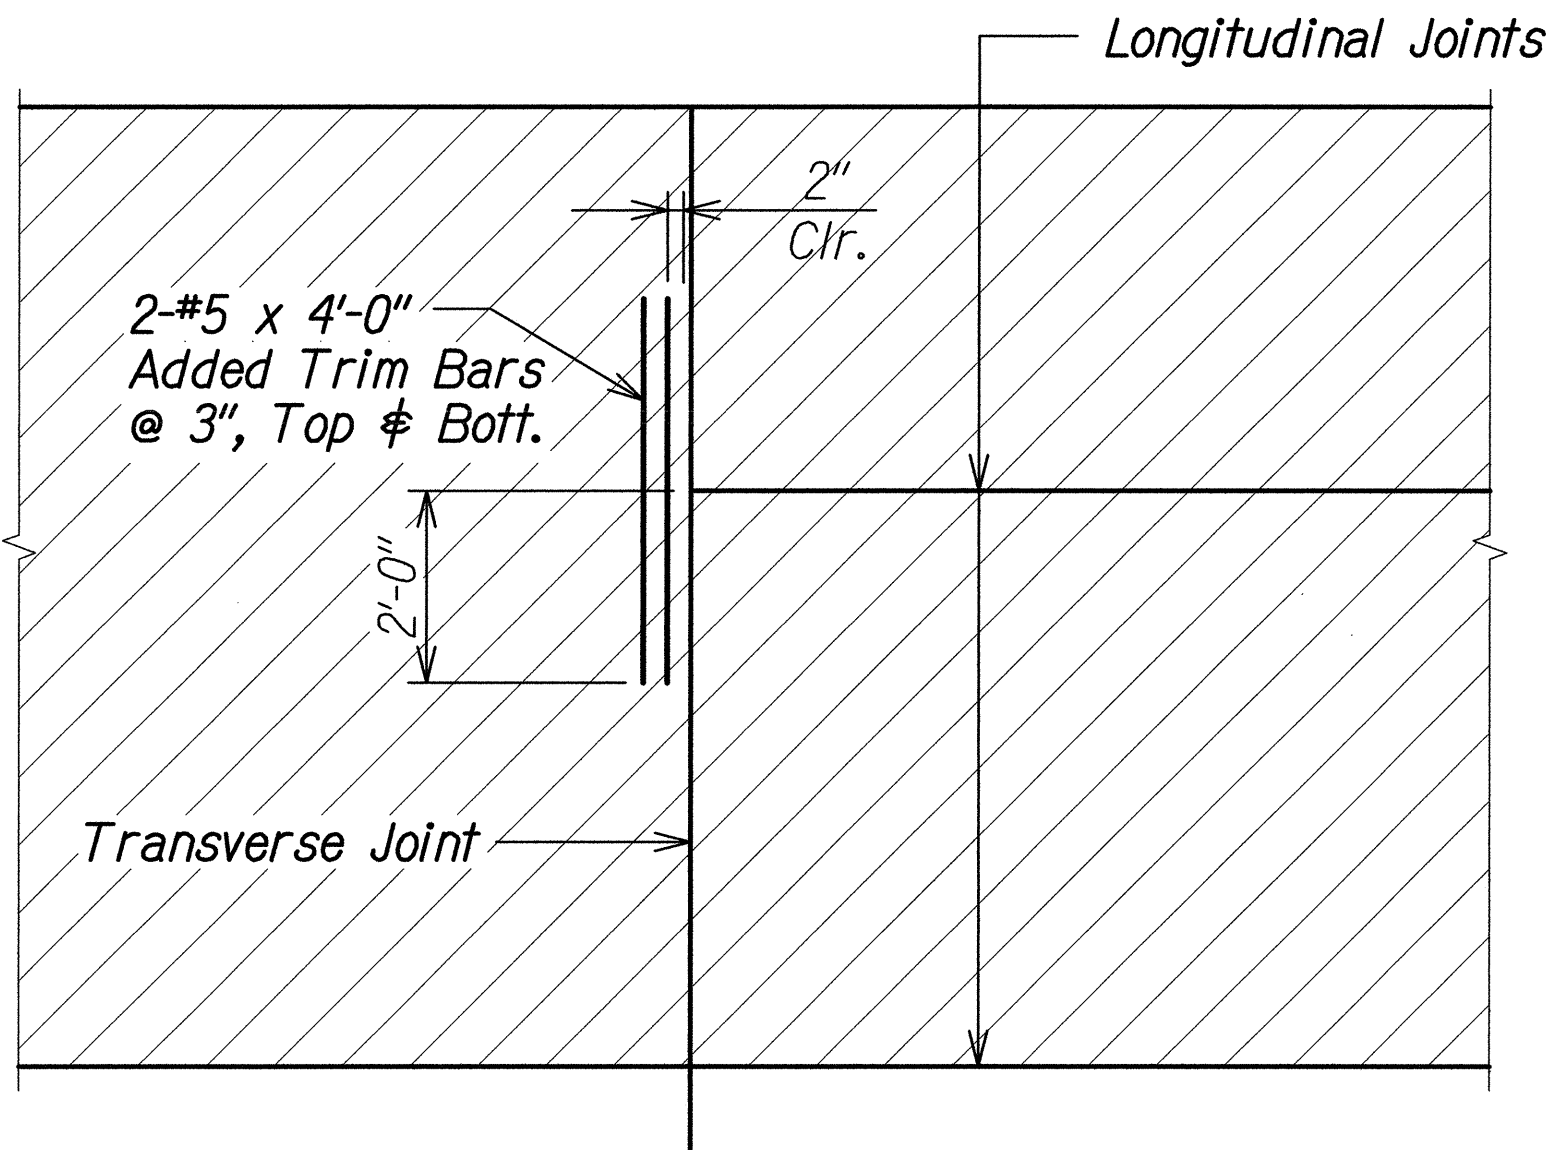


MISMATCHED JOINT DETAIL 2  
Not to Scale S1.4 S1.4

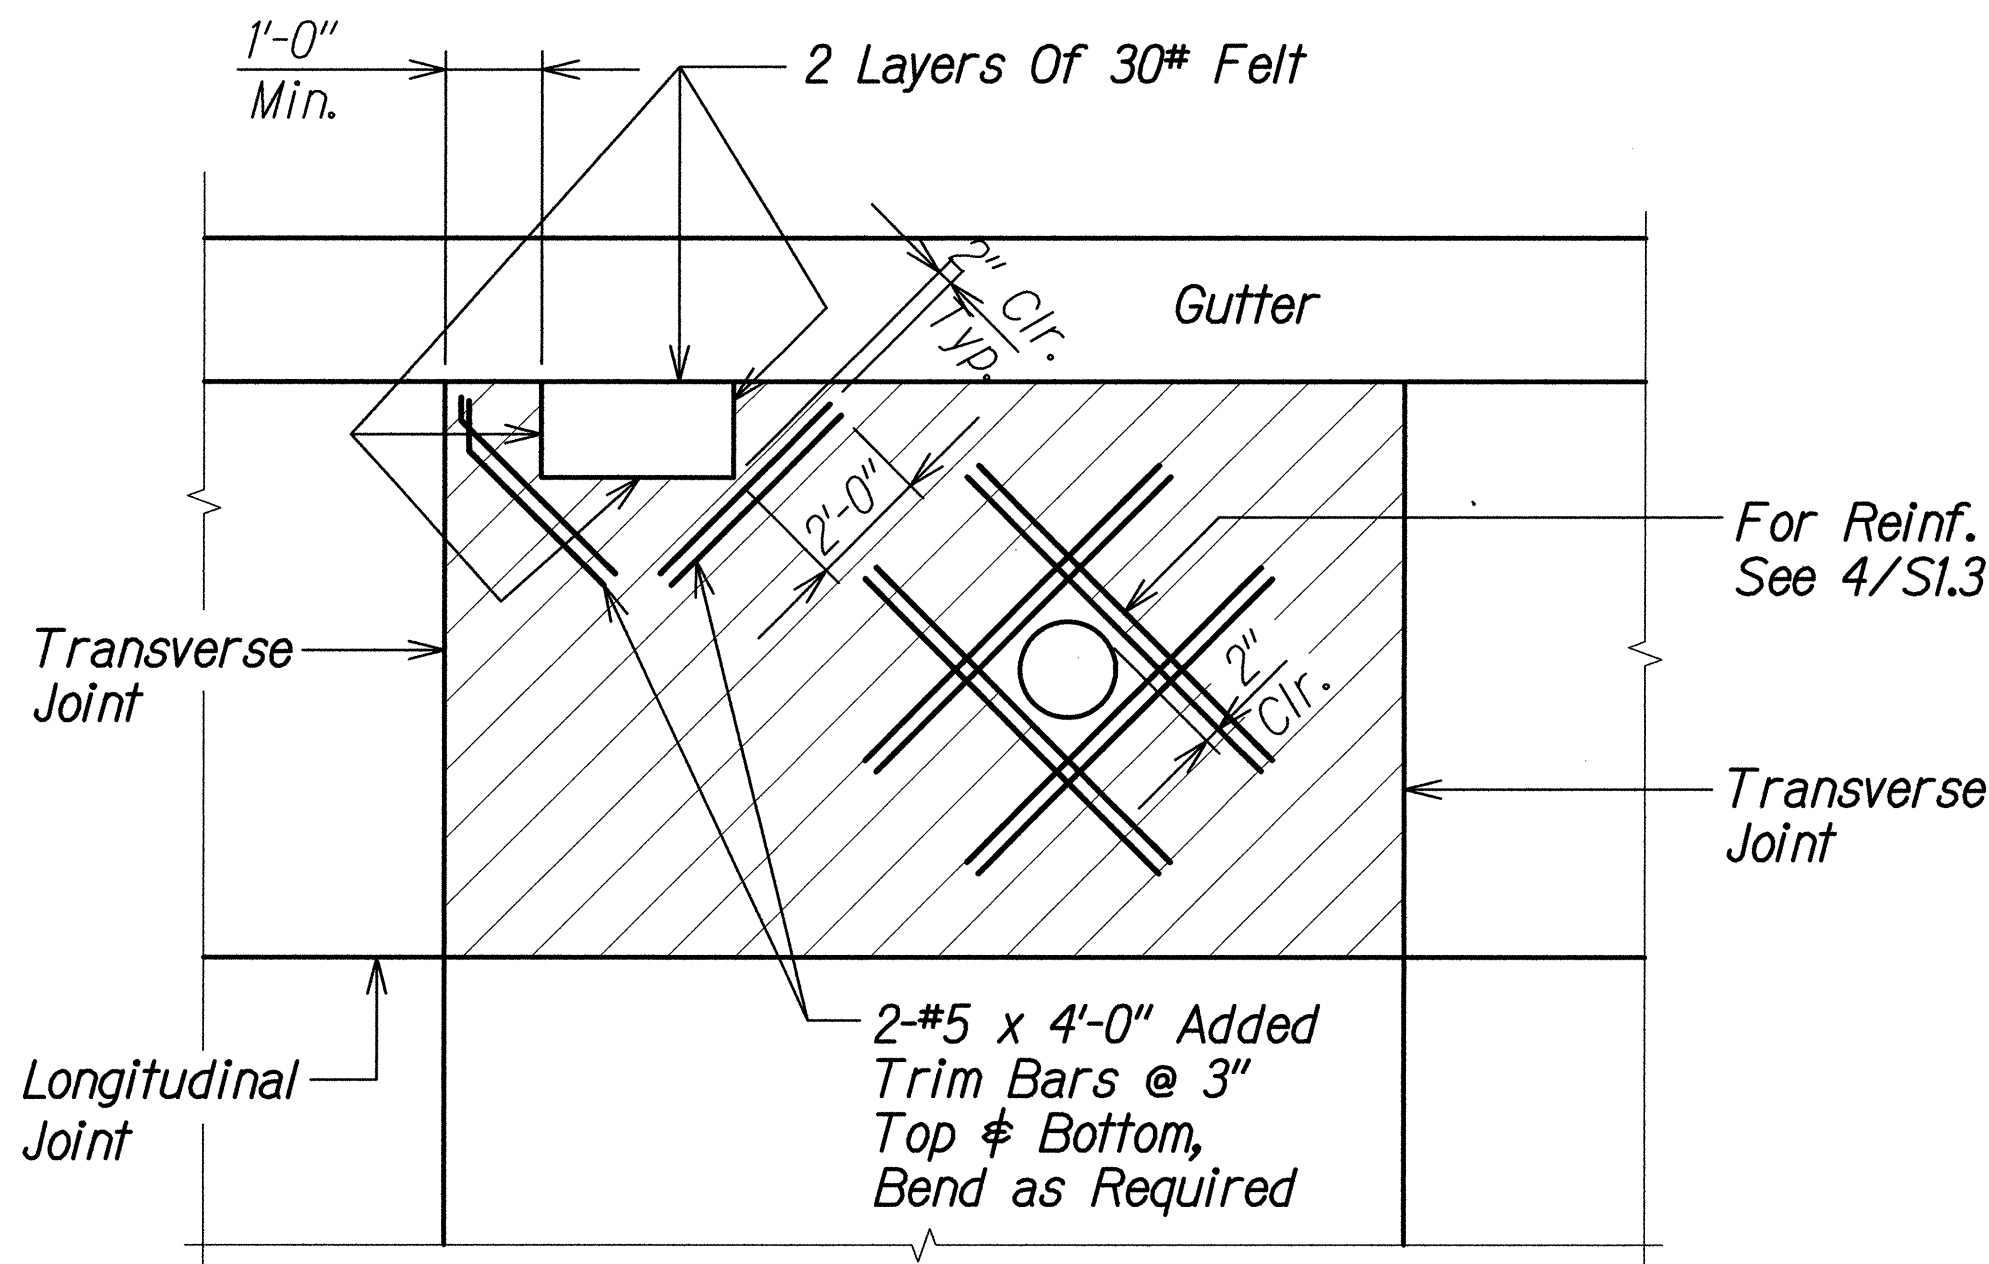

OPENING AWAY FROM JOINTS DETAIL 3  
Not to Scale S1.4 S1.4


LEGEND:

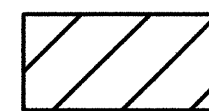

Panels to receive fibers and rebar reinforcing  
For panel fiber and rebar reinforcing see General Notes 4.(F) and 7.(H) on sheet S0.2. For added trim bar reinforcing see sheets S1.3 to S1.6.

|               |               |
|---------------|---------------|
| ORIGINAL PLAN | DATE          |
| NOTE BOOK     | DESIGNED BY   |
|               | QUANTITIES BY |
|               | CHECKED BY    |

DRAWING NAME: 2100-ONGONG-V2-033-HPL MIDDLE STREET RECONSTRUCTION-DOTH CAD 06-19-14 BID/HPL-MS101 TO MS106.DWG PLOT TIME: 06-19-14, 8:21 AM

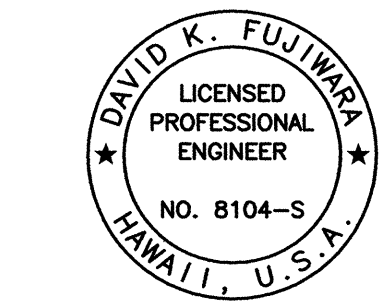

THIS WORK WAS PREPARED BY ME OR UNDER MY SUPERVISION.


SIGNATURE: *David K. Fujiwara* 4-30-18  
EXPIRATION DATE OF THE LICENSE

STATE OF HAWAII  
DEPARTMENT OF TRANSPORTATION  
HIGHWAYS DIVISION


**TYPICAL PCCP JOINT DETAILS**  
  
MIDDLE STREET PAVEMENT RECONSTRUCTION  
North King Street to Kamehameha Highway  
FAP NO. STP-7415(001)  
Scale: As Noted Date: Jun. 20, 2014




| FED. ROAD DIST. NO. | STATE | FEDERAL AID PROJ. NO. | FISCAL YEAR | SHEET NO. | TOTAL SHEETS |
|---------------------|-------|-----------------------|-------------|-----------|--------------|
| HAWAII              | HAW.  | STP-7415(001)         | 2014        | 122       | 173          |

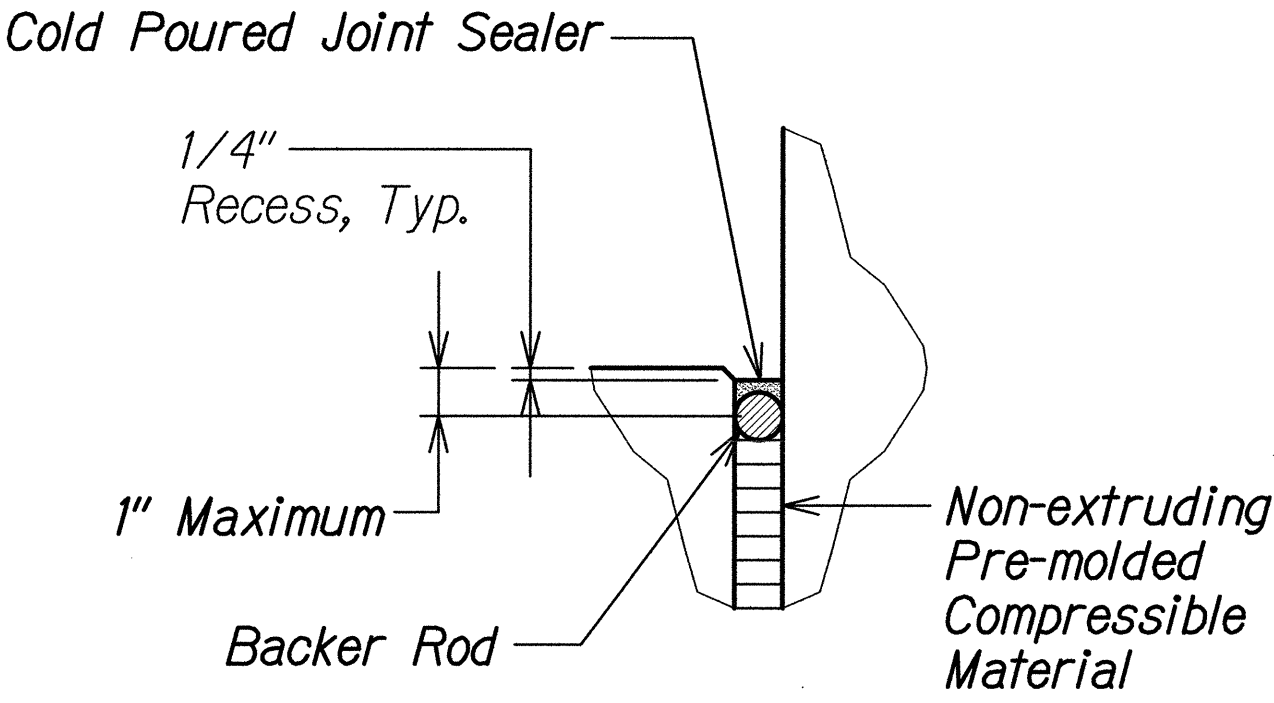


**ISOLATION JOINT** 1  
Not to Scale S1.5 S1.5

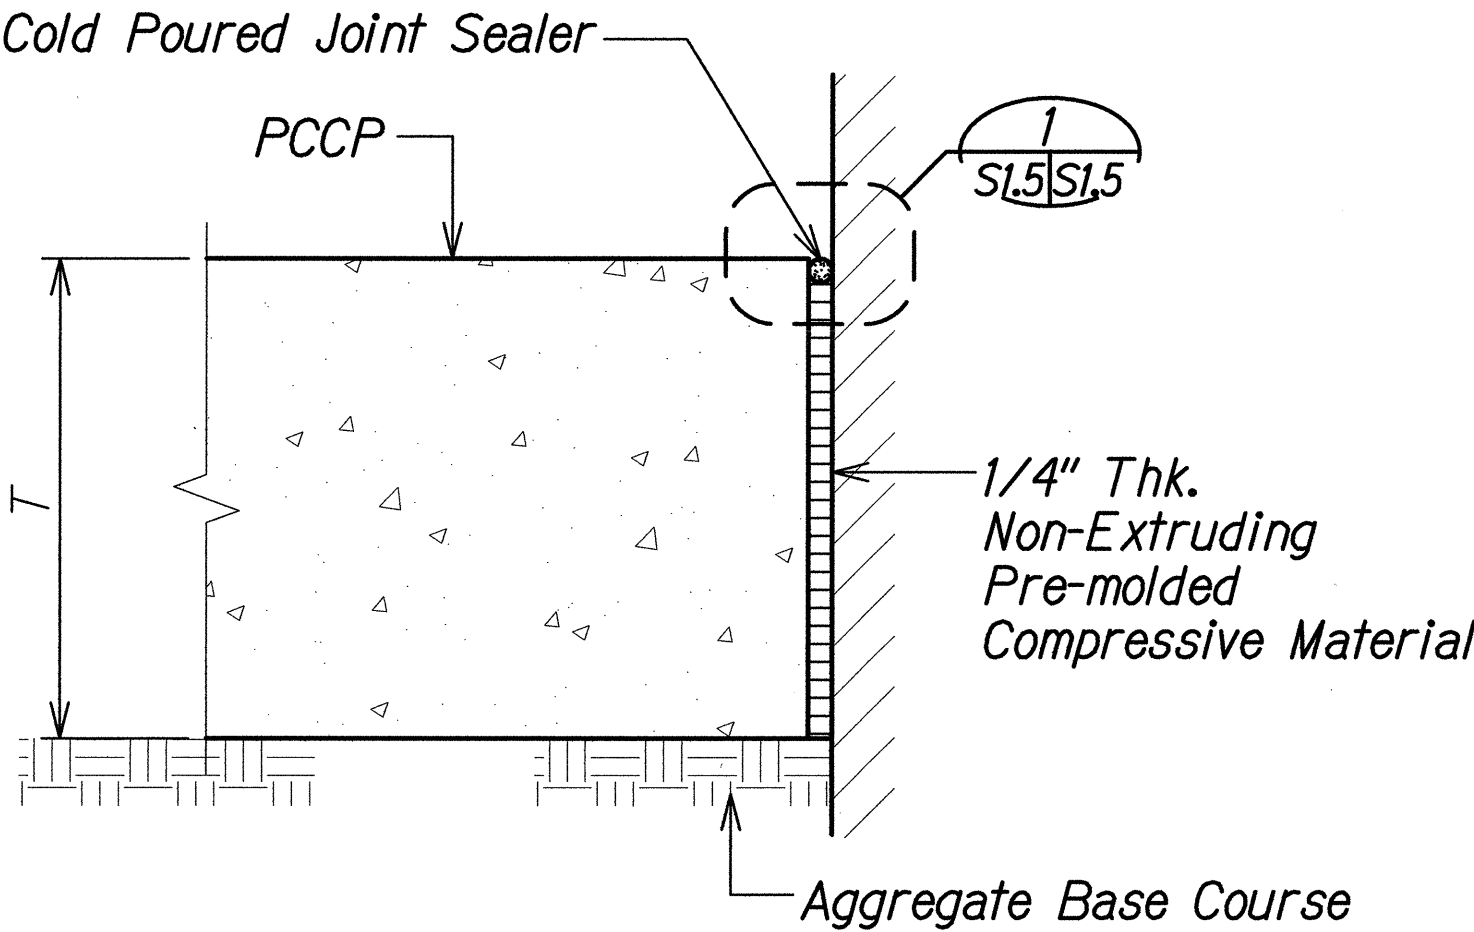

**ISOLATION JOINT** 2  
Not to Scale S1.3 S1.5  
S1.6

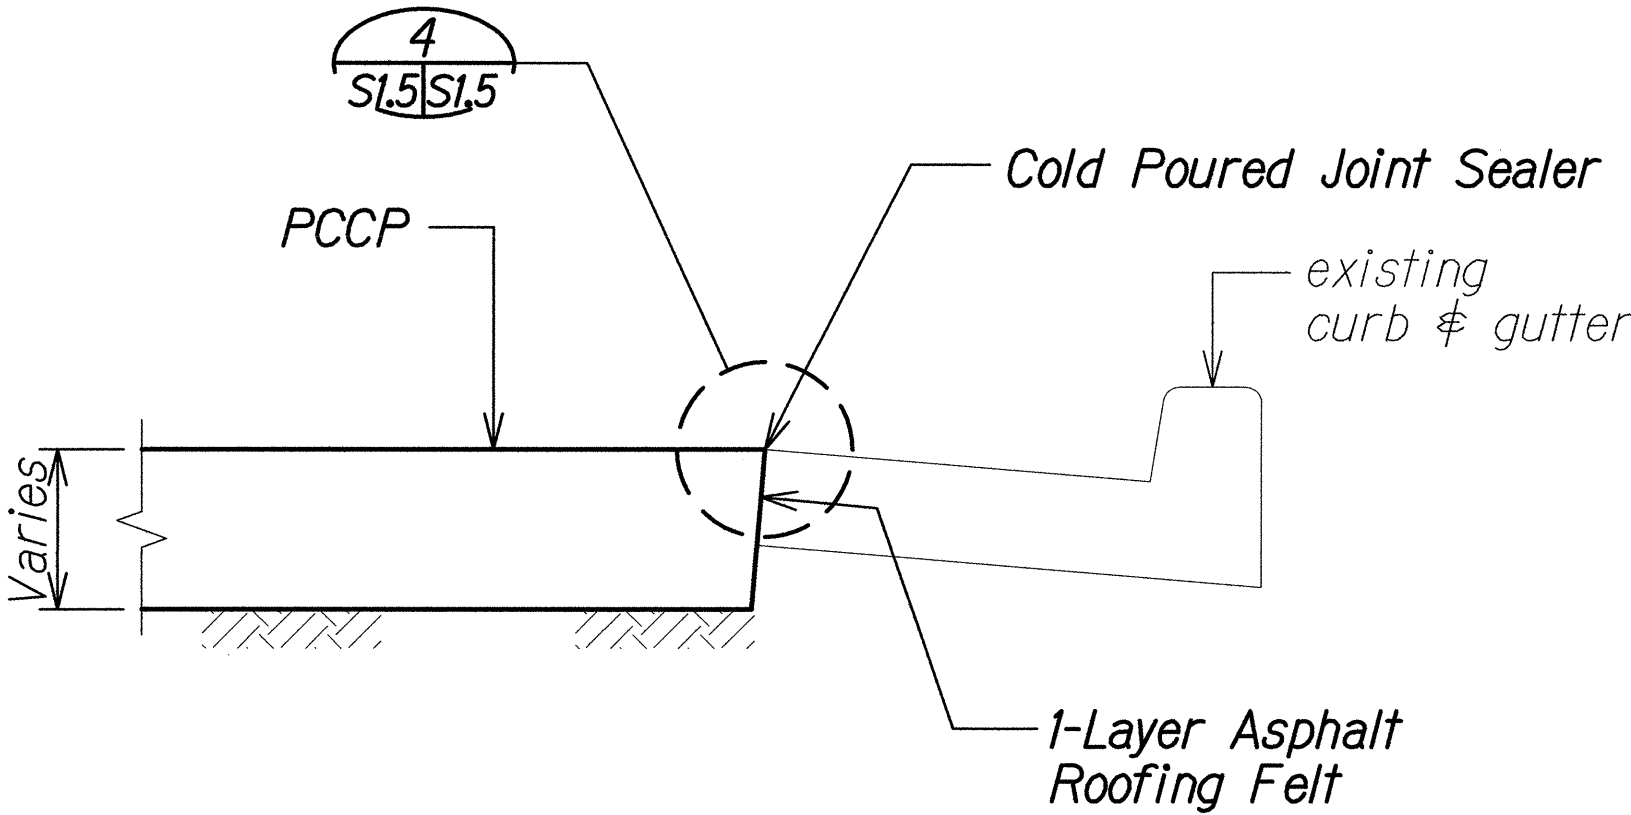


**PCCP AT EXISTING GUTTER** 3  
Scale: 1" = 1'-0" S1.7, S1.8, S1.9, S1.10, S2.9, S2.10, S3.12 S1.1 S1.5

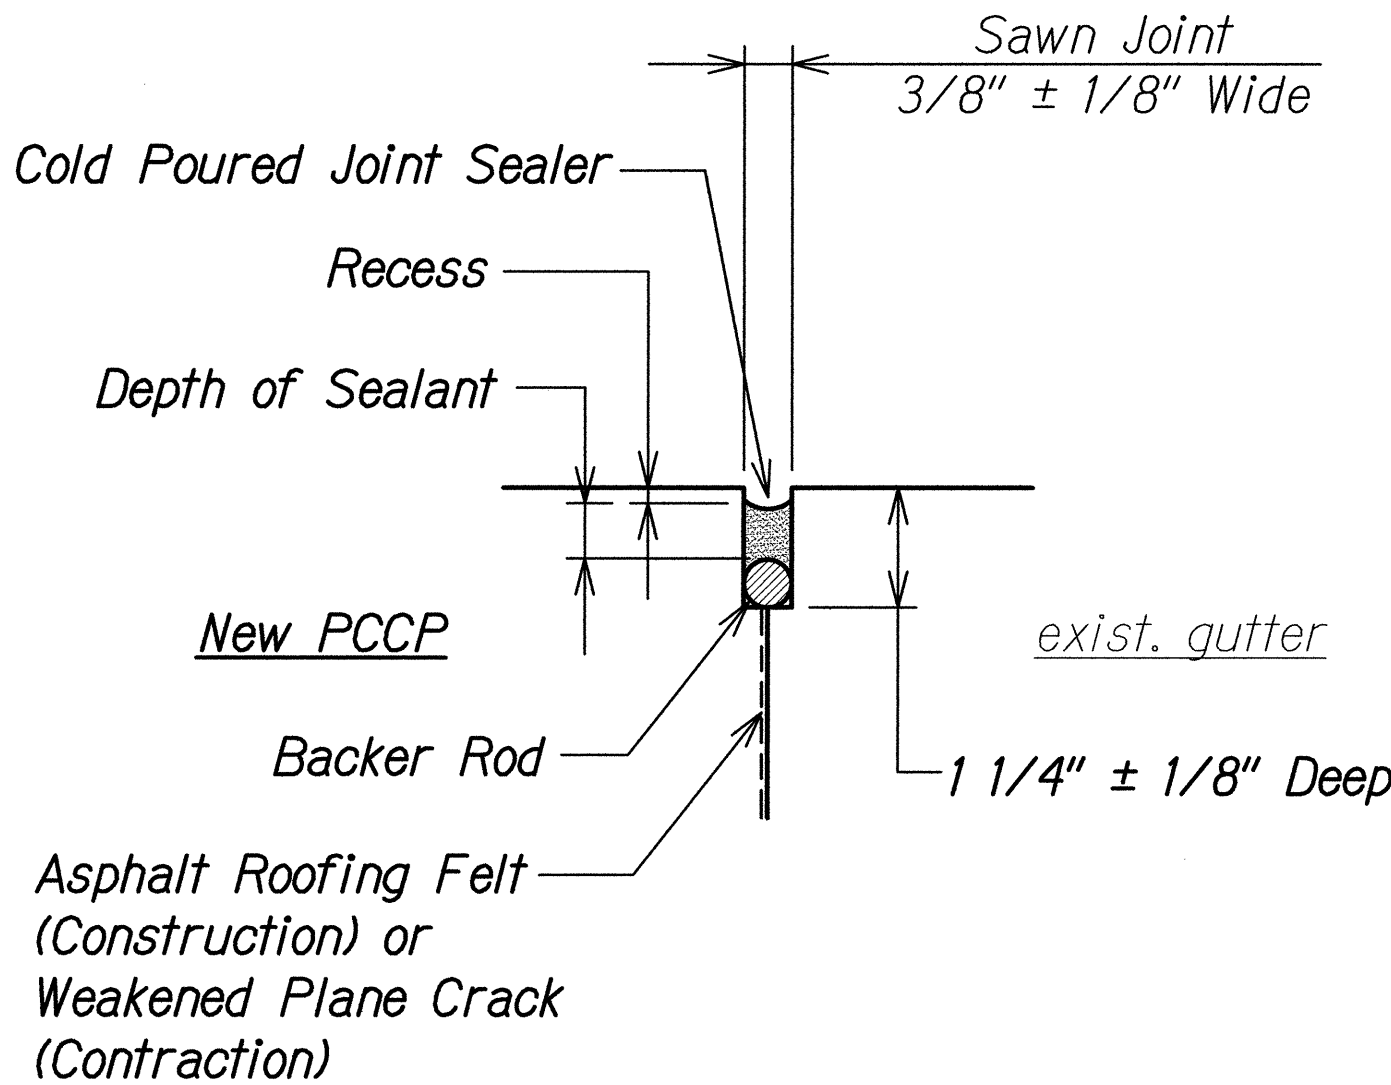


**Note:**  
Follow sealant manufacturer's recommendation for recess and depth of sealant for joint width.

**CONTRACTION / CONSTRUCTION JOINT SEAL** 4  
Not to Scale S1.5 S1.5  
S1.6, S4.7

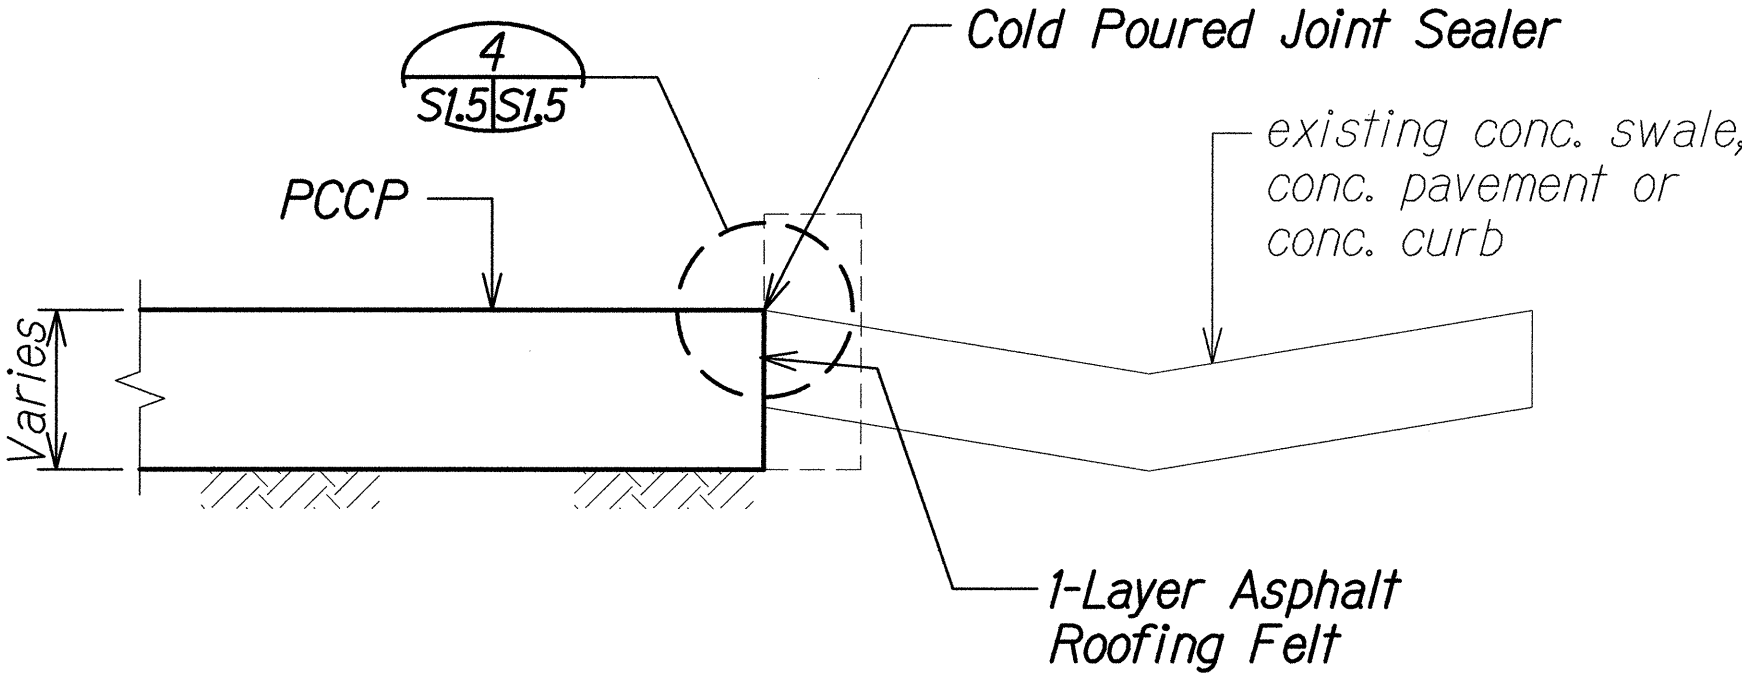


**PCCP AT EXISTING CONCRETE STRUCTURE** 5  
Scale: 1" = 1'-0" S1.7, S1.8, S1.9, S2.8, S3.12 S1.1 S1.5

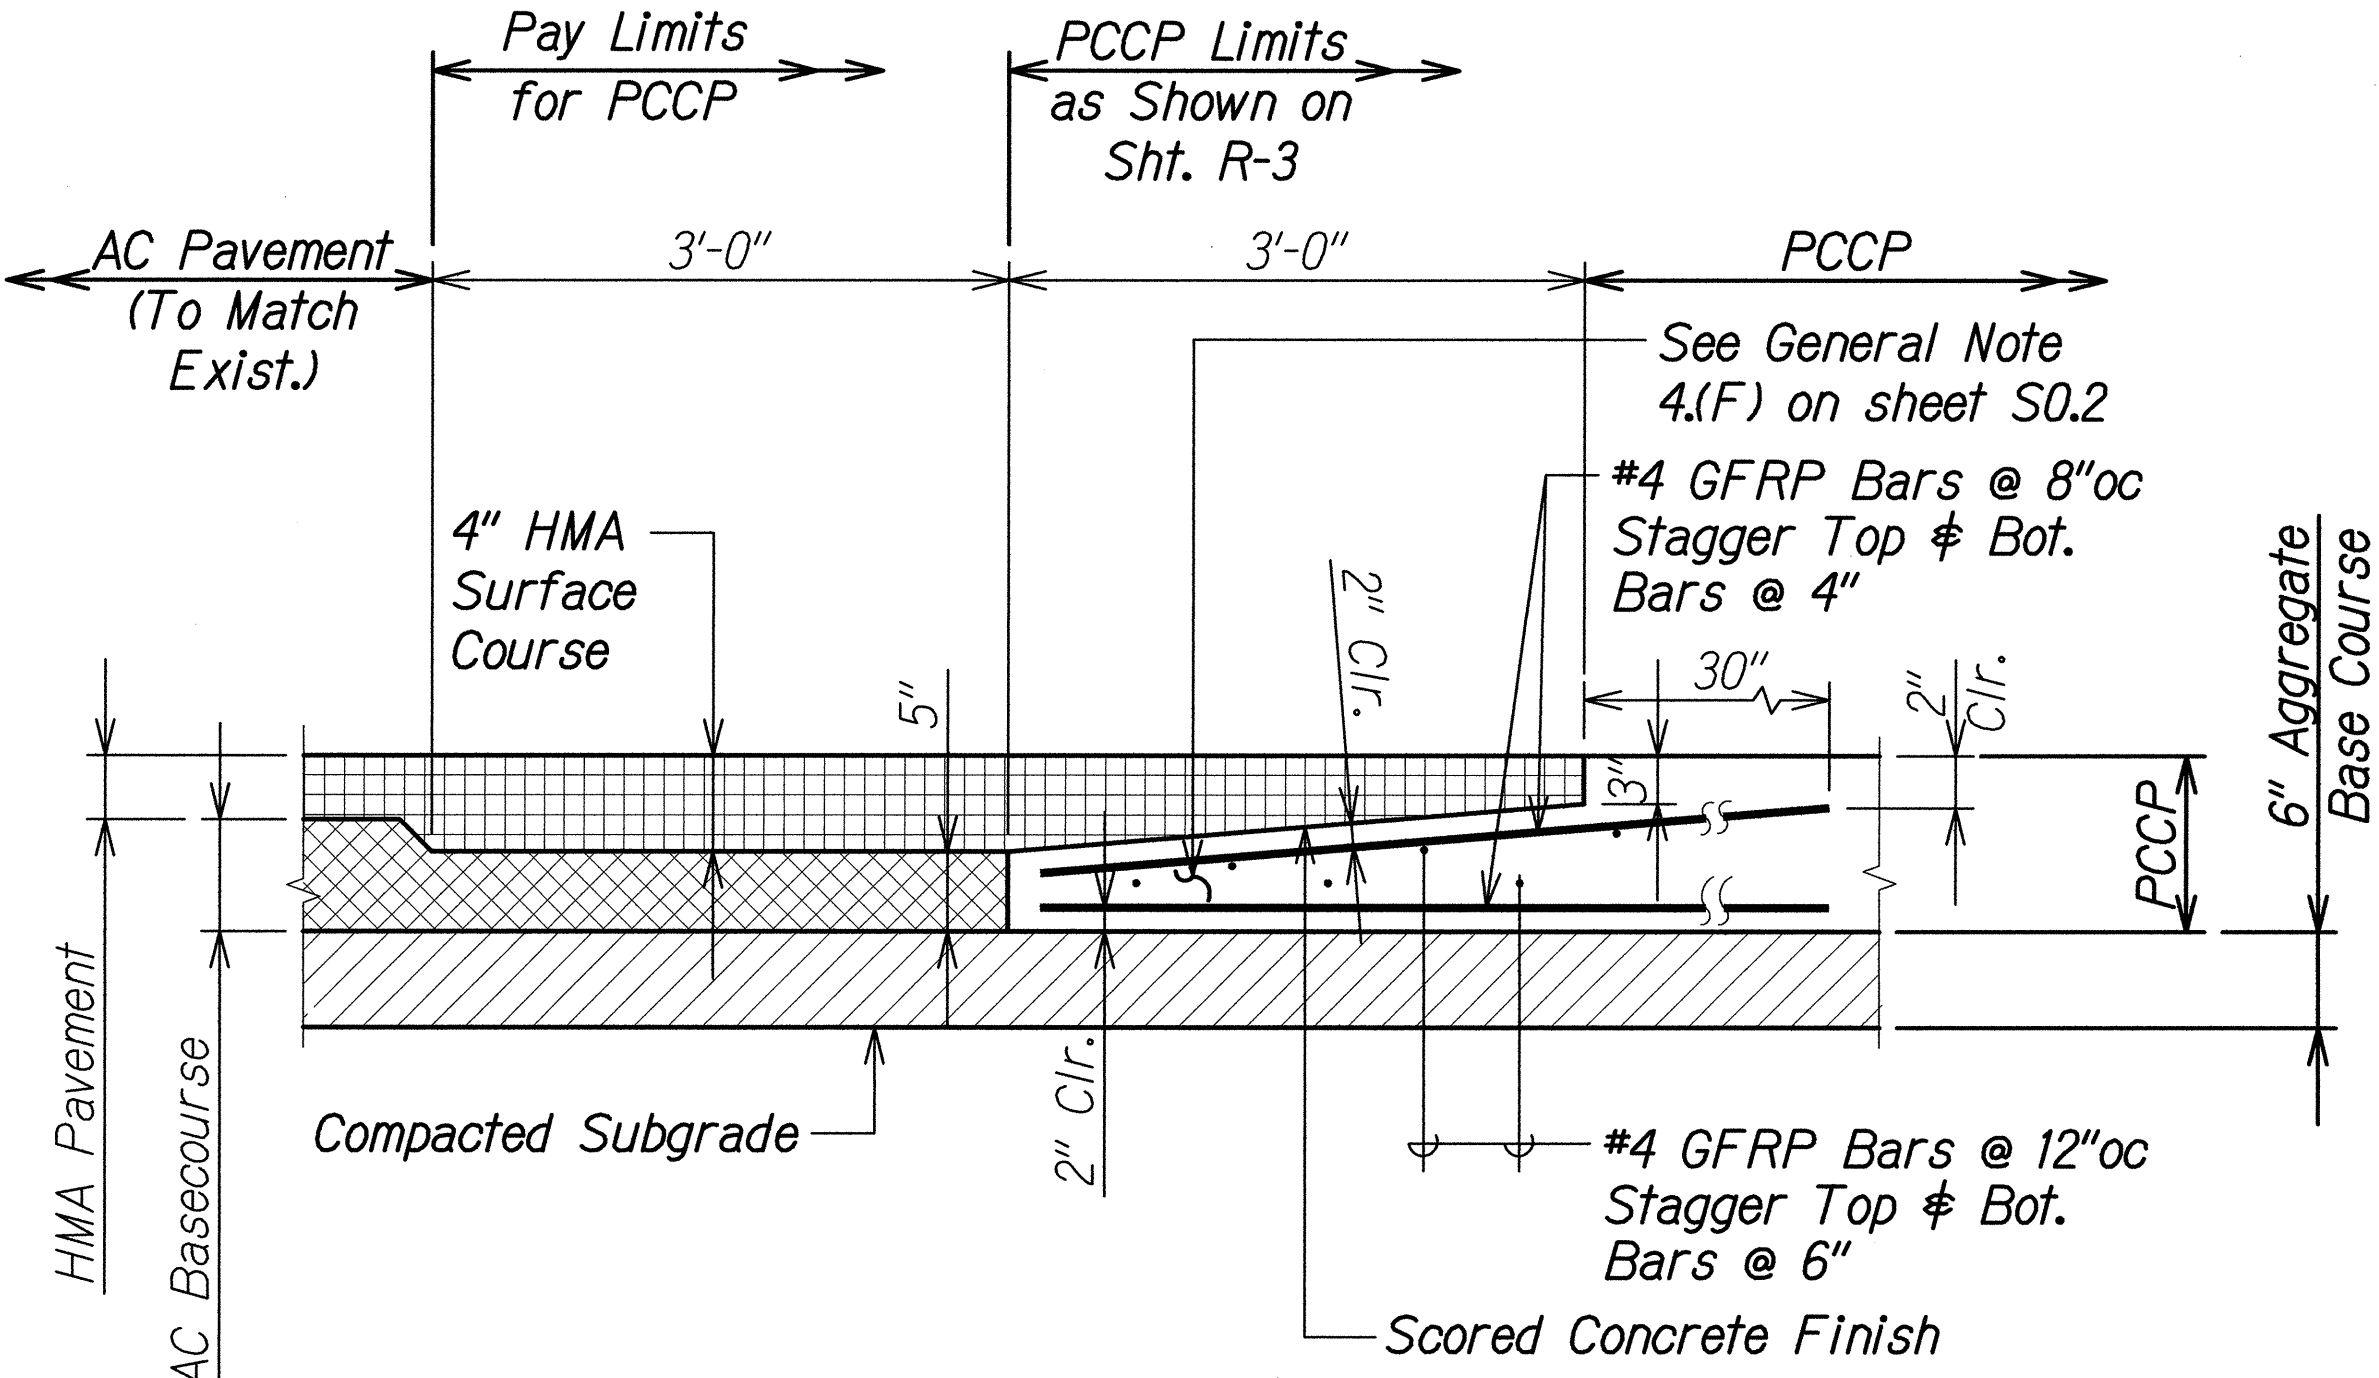

**PCCP-AC TRANSVERSE TRANSITION DETAIL** 6  
Not to Scale S1.5 S1.5

|               |               |
|---------------|---------------|
| ORIGINAL PLAN | DATE          |
| DESIGNED BY   | DESIGNED BY   |
| CHECKED BY    | CHECKED BY    |
| NOTED BY      | NOTED BY      |
| QUANTITIES BY | QUANTITIES BY |
| NO.           | NO.           |

DRAWING NAME: 2100 ONCONC12-033-HEL MIDDLE STREET RECONSTRUCTION-DOTHA CA0106-10-14 BDN-HEL-MS101 TO MS106.DWG PLOT TIME: 06-18-14 6:51 PM

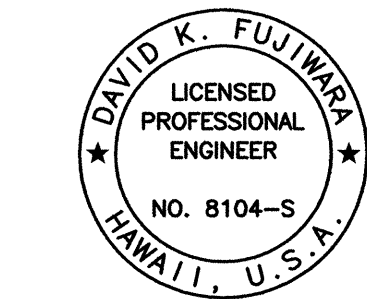

THIS WORK WAS PREPARED BY ME OR UNDER MY SUPERVISION.  
Signature: *David K. Fujiwara*  
EXPIRATION DATE OF THE LICENSE: 4-30-16

STATE OF HAWAII  
DEPARTMENT OF TRANSPORTATION  
HIGHWAYS DIVISION

**TYPICAL PCCP JOINT DETAILS**


MIDDLE STREET PAVEMENT RECONSTRUCTION  
North King Street to Kamehameha Highway  
FAP NO. STP-7415(001)

Scale: As Noted Date: Jun. 20, 2014


SHEET No. **S1.5** OF 10 SHEETS



| FED. ROAD DIST. NO. | STATE | FEDERAL AID PROJ. NO. | FISCAL YEAR | SHEET NO. | TOTAL SHEETS |
|---------------------|-------|-----------------------|-------------|-----------|--------------|
| HAWAII              | HAW.  | STP-7415(001)         | 2014        | 123       | 173          |

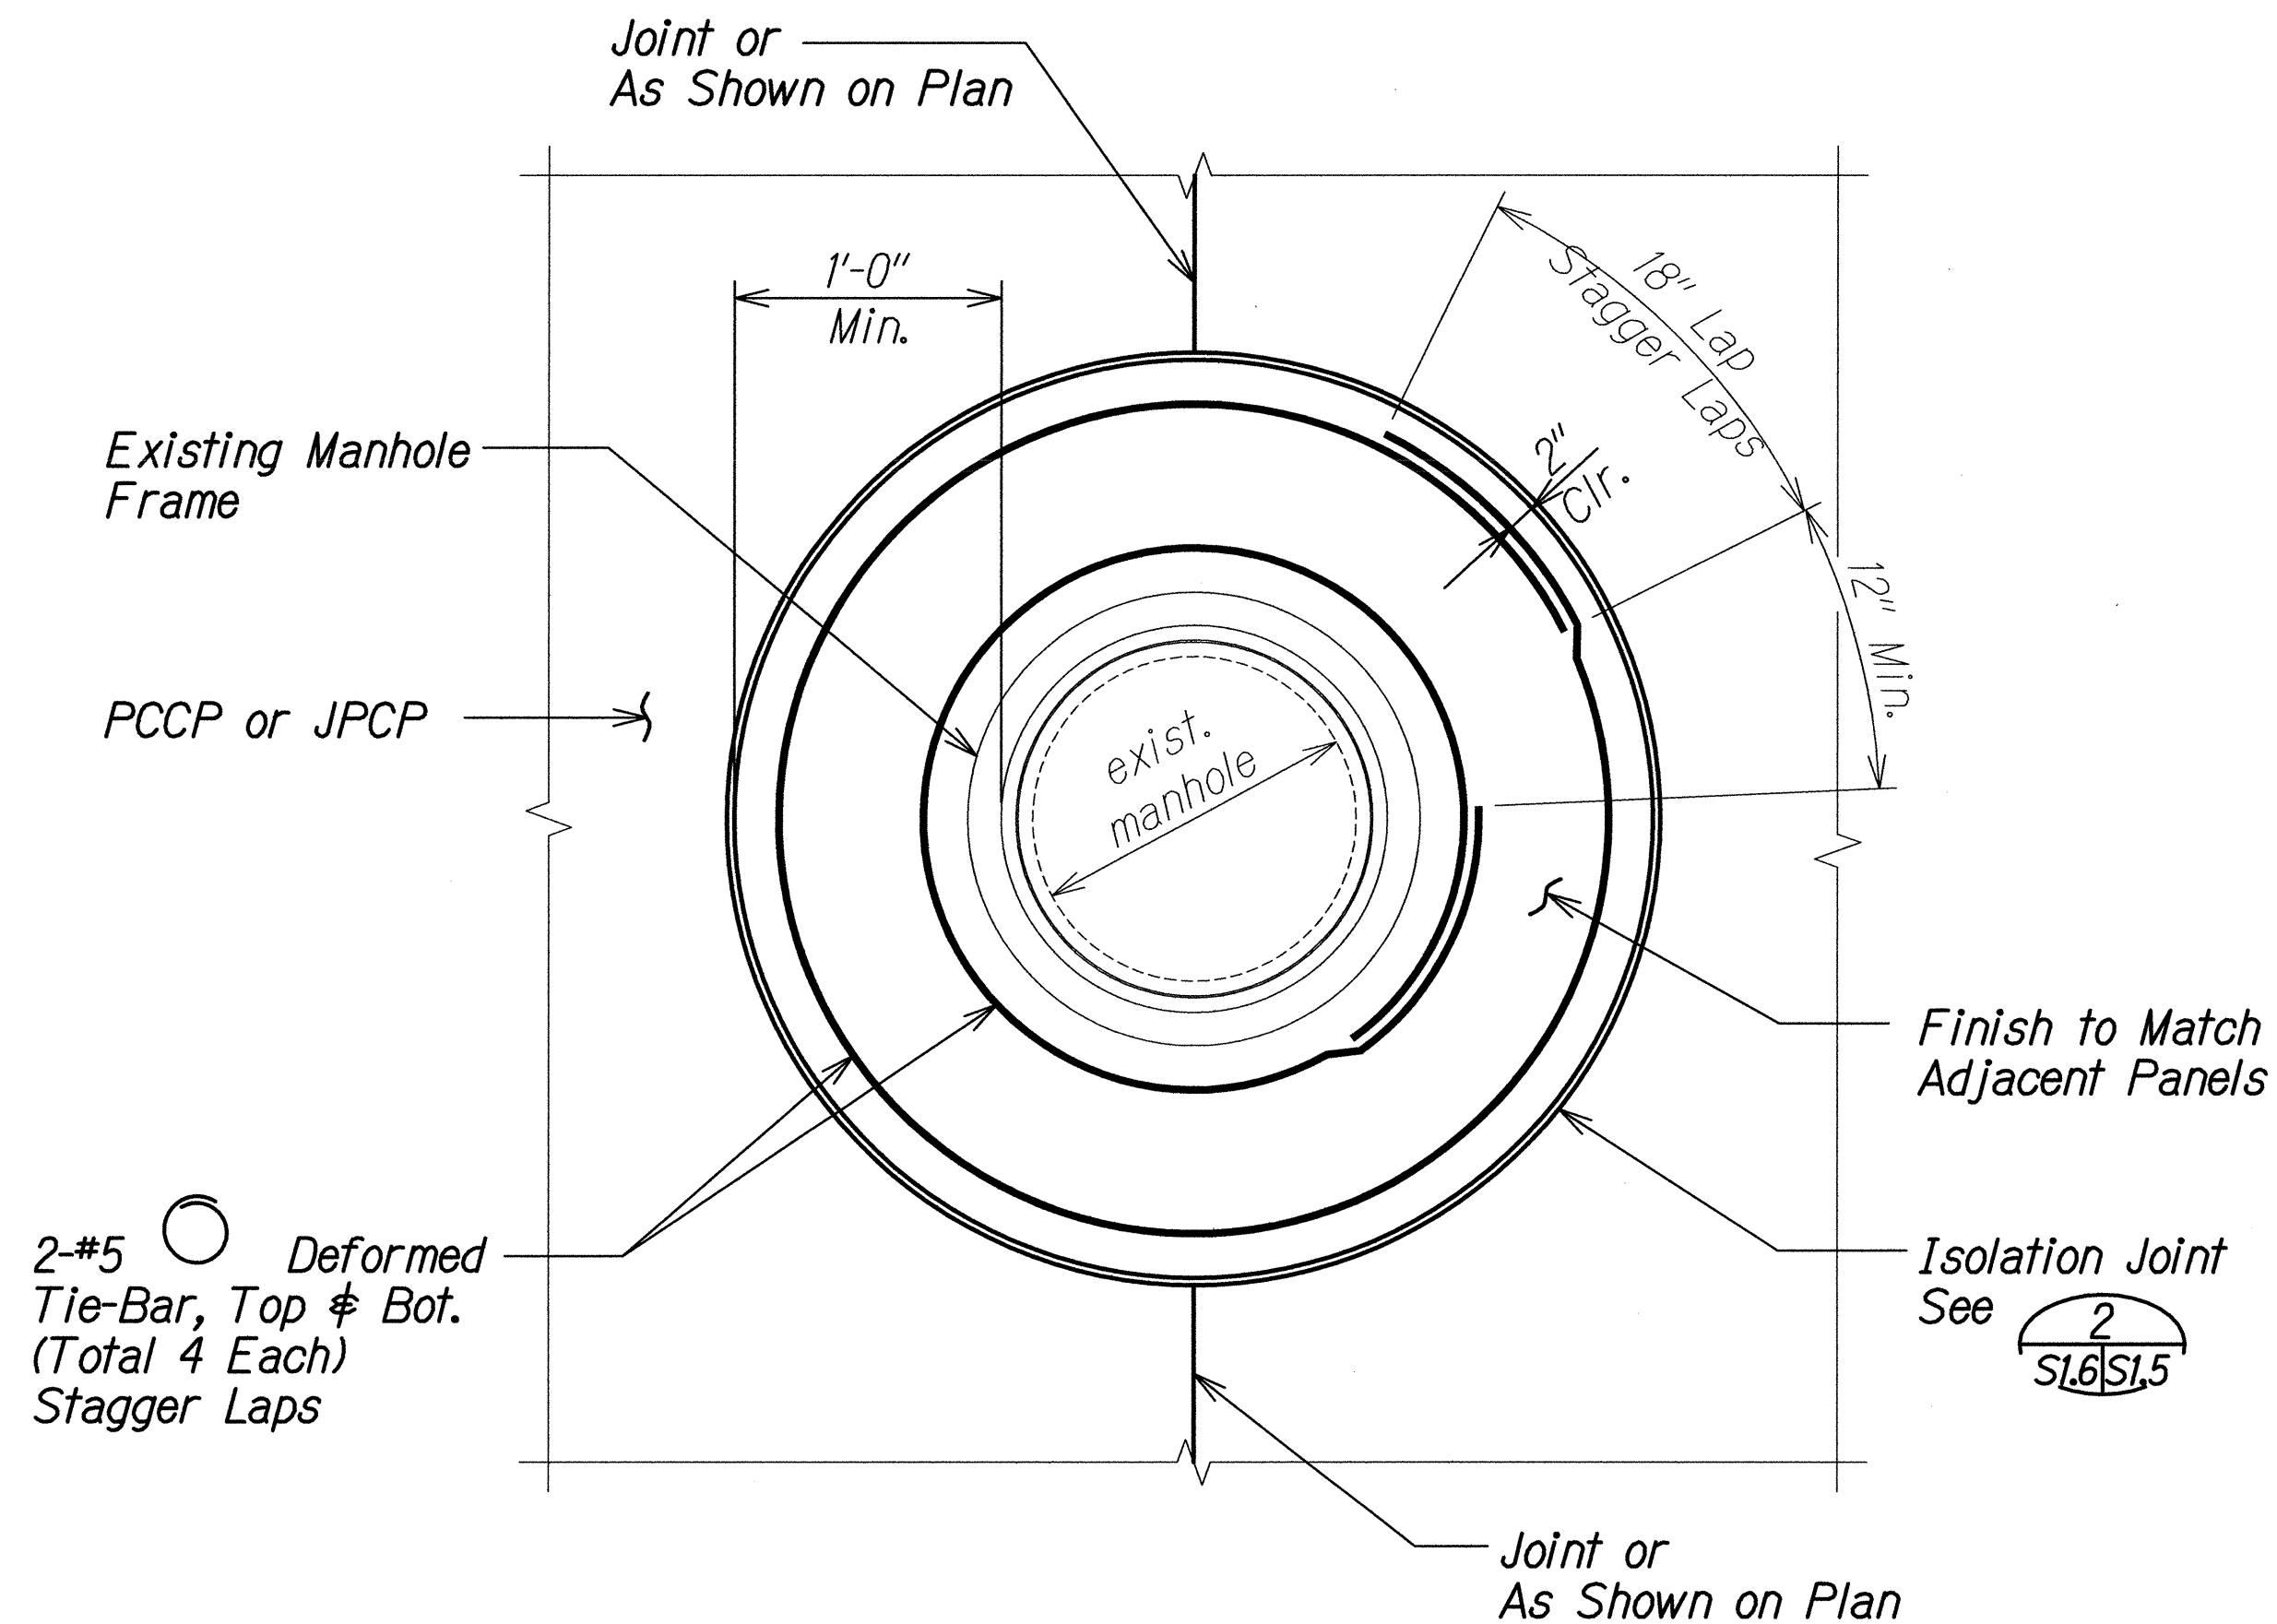


**CONCRETE CLOSURE POUR - PLAN** A  
Scale: 1" = 1'-0"

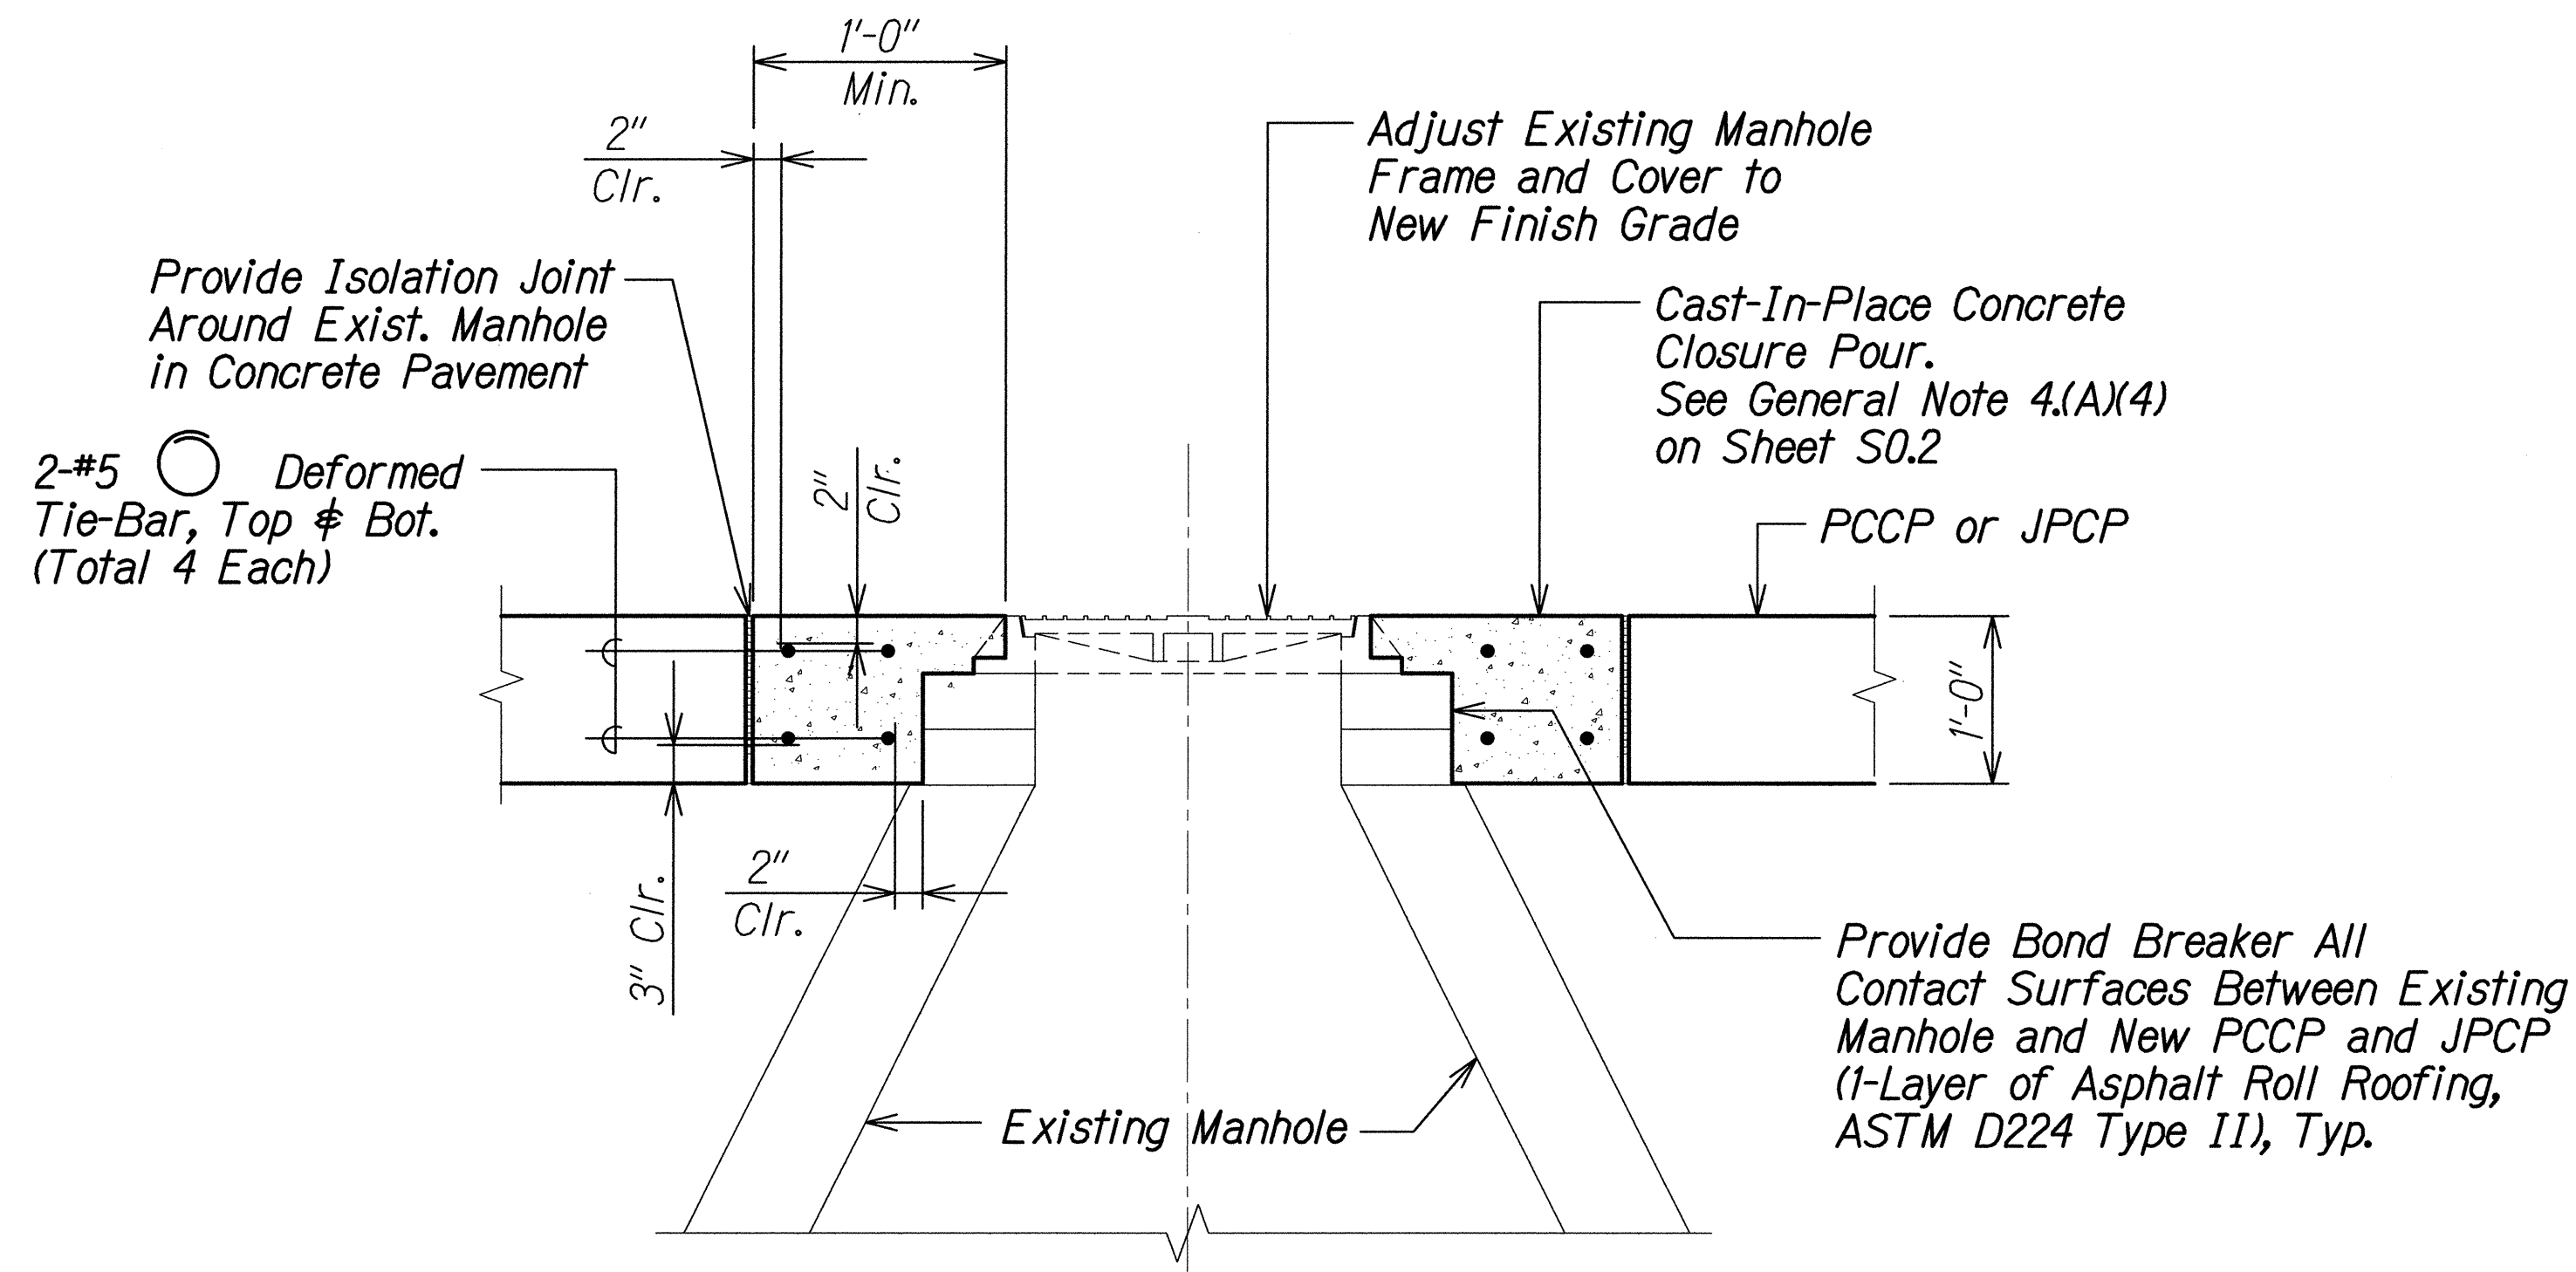

**CONCRETE CLOSURE POUR - SECTION** B  
Scale: 1" = 1'-0"

See General Notes 4.(A)(1) on Sht. S0.2 for Concrete and 4.(F) for Added Fiber Reinforcing

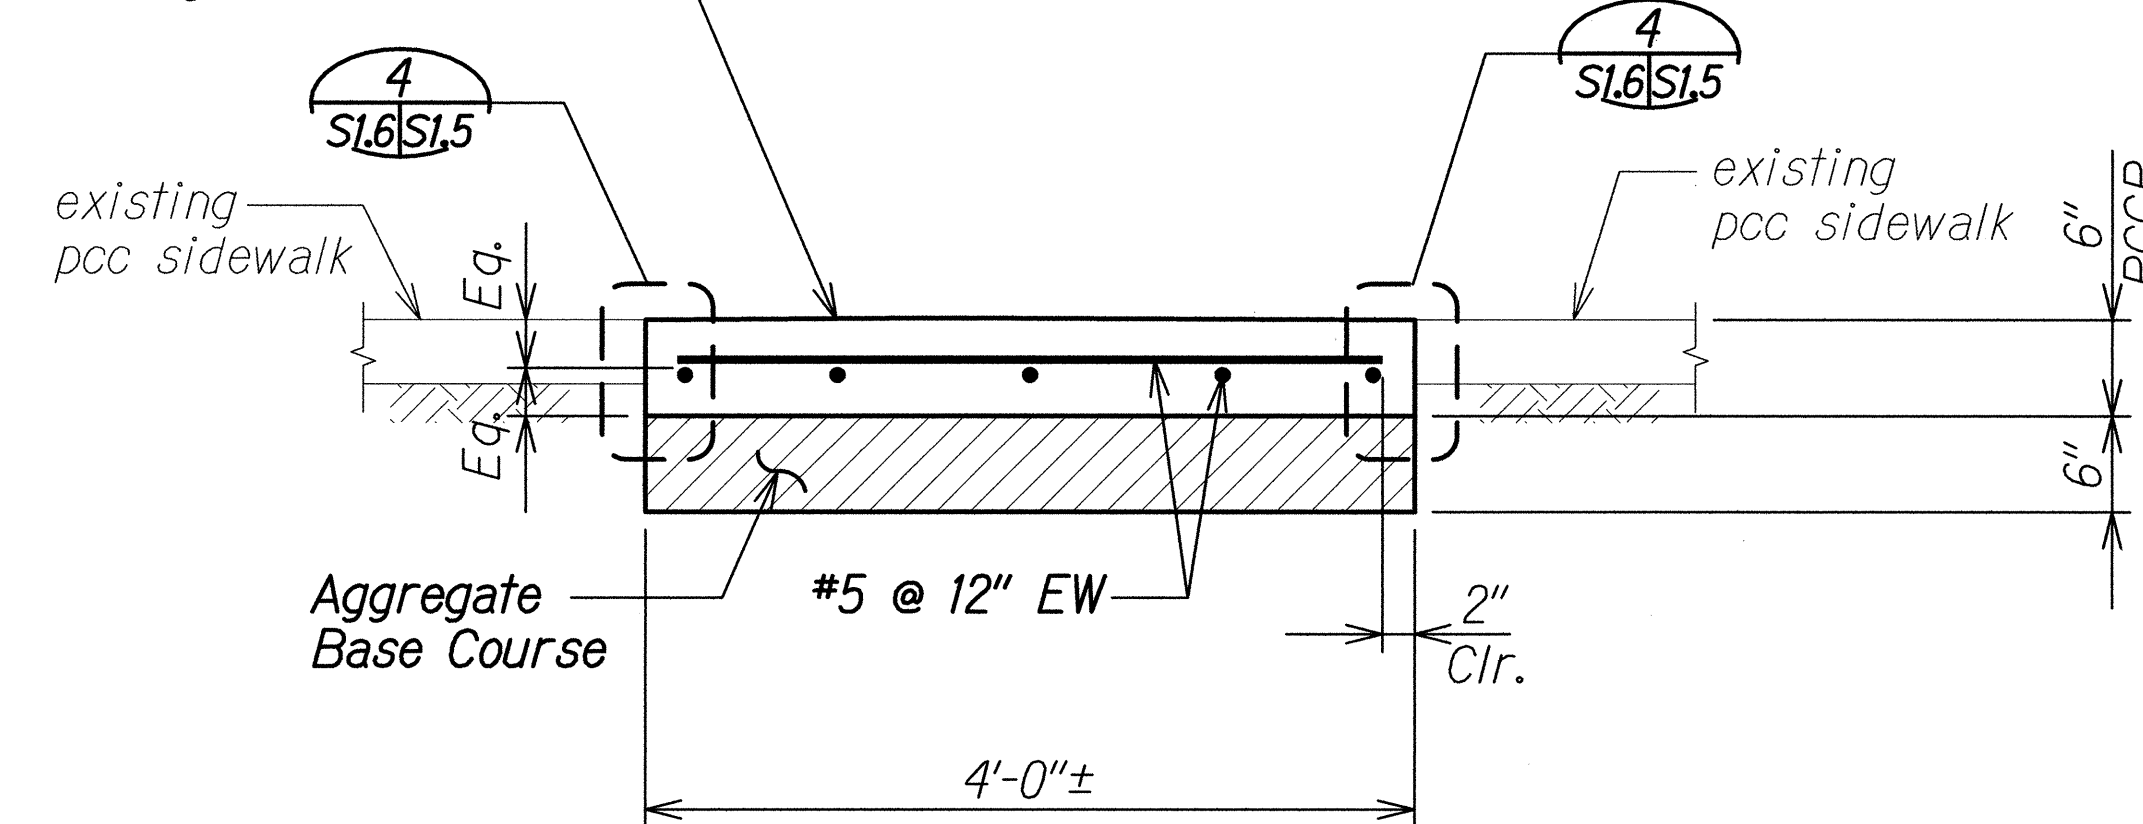

**SIDEWALK EXTENSION SECTION** C  
Scale: 1" = 1'-0"

|                   |      |
|-------------------|------|
| SURVEY PLOTTED BY | DATE |
| DRAWN BY          | "    |
| DESIGNED BY       | "    |
| QUANTITIES BY     | "    |
| CHECKED BY        | "    |
| NOTE BOOK         |      |
| No.               |      |

DRAWING NAME: Z:\000 ONGOING\12-033-HEL MIDDLE STREET RECONSTRUCTION-DOT\A\06-19-14 BDA\HEL-MS101 TO MS106.DWG PLOT TIME: 06-19-14 8:24 AM

DAVID K. FUJIMORI  
LICENSED PROFESSIONAL ENGINEER  
NO. 8104-S  
HAWAII, U.S.A.

THIS WORK WAS PREPARED BY ME OR UNDER MY SUPERVISION.

Signature: David K. Fujimori  
EXPIRATION DATE OF THE LICENSE: 4-30-16

STATE OF HAWAII  
DEPARTMENT OF TRANSPORTATION  
HIGHWAYS DIVISION

**TYPICAL CONCRETE CLOSURE POUR**  
**PLAN AND SECTION**


MIDDLE STREET PAVEMENT RECONSTRUCTION  
North King Street to Kamehameha Highway  
FAP NO. STP-7415(001)

Scale: As Noted Date: Jun. 20, 2014


SHEET No. SL.6 OF 10 SHEETS



| FED. ROAD DIST. NO. | STATE | FEDERAL AID PROJ. NO. | FISCAL YEAR | SHEET NO. | TOTAL SHEETS |
|---------------------|-------|-----------------------|-------------|-----------|--------------|
| HAWAII              | HAW.  | STP-7415(001)         | 2014        | 124       | 173          |

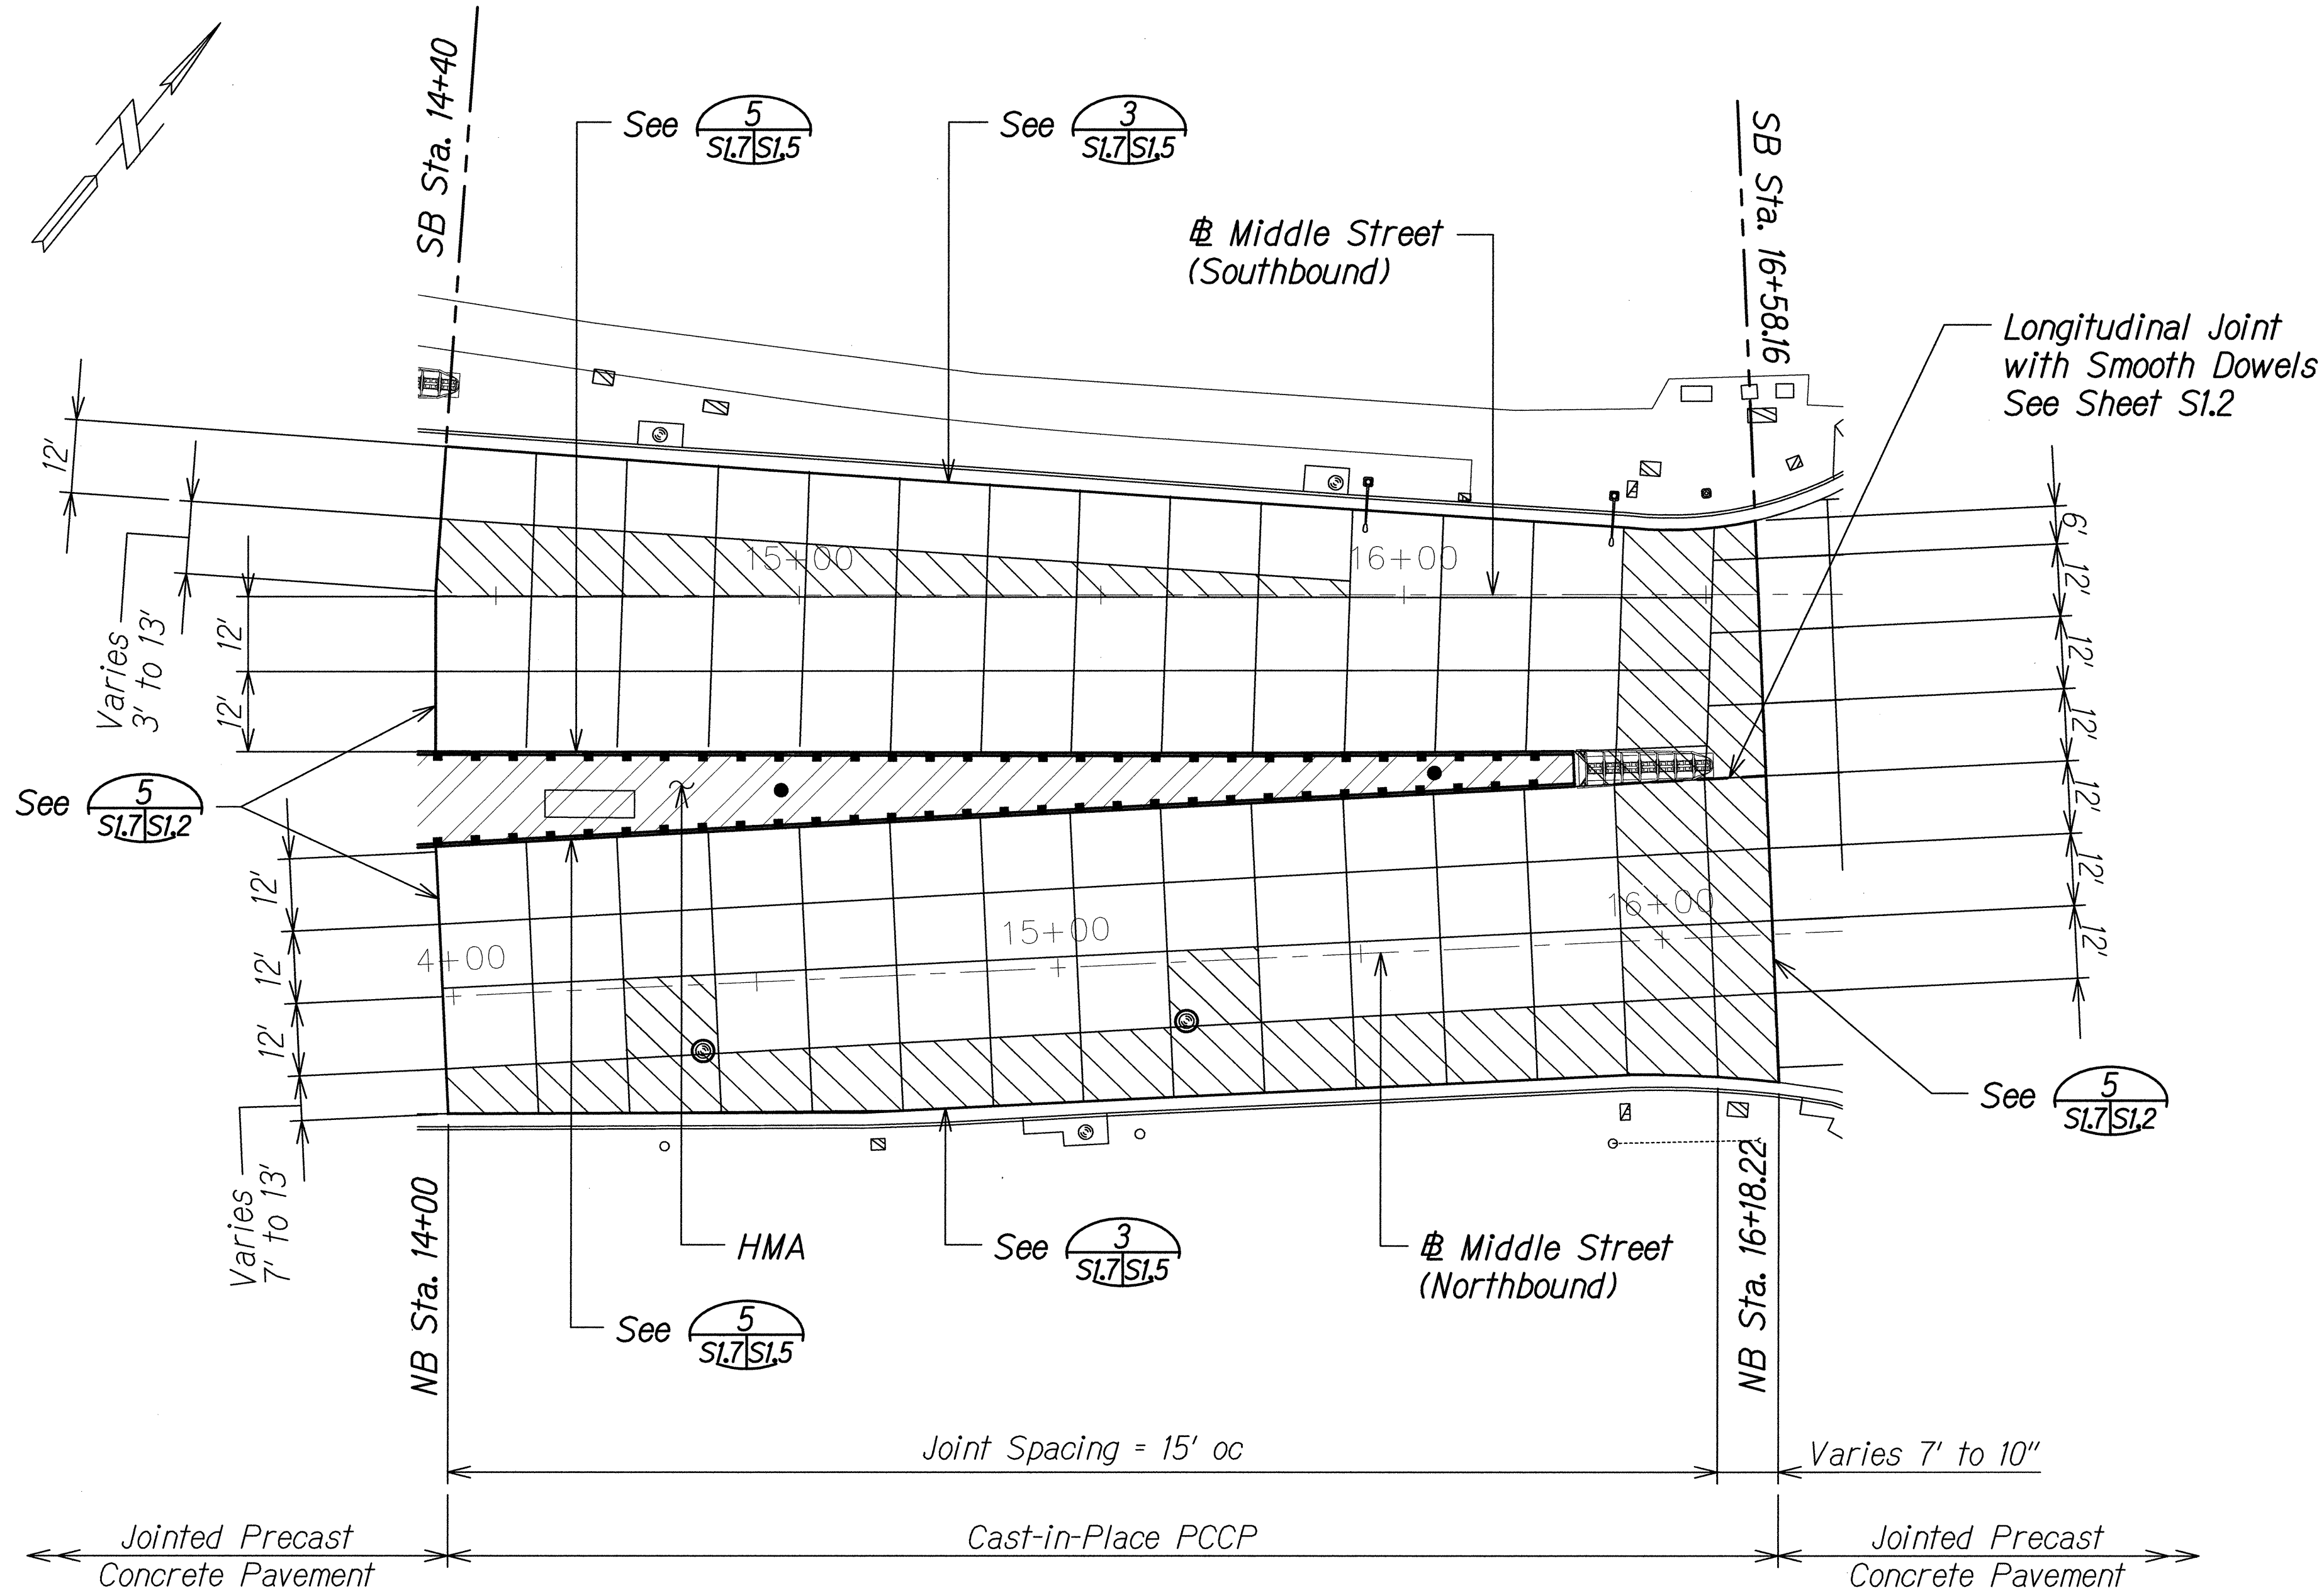


**PCCP JOINTING PLAN**  
 Scale: 1" = 20'-0"

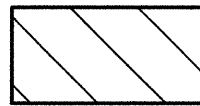**Legend:**  
 Odd Shaped Sections  
 See General Notes 4.(F) and 7. (H)  
 on Sheet S0.2.

|               |      |
|---------------|------|
| ORIGINAL PLAN | DATE |
| DESIGNED BY   |      |
| NOTED BY      |      |
| CHECKED BY    |      |
| NO.           |      |

DRAWING NAME: 23-00-000000-12-033-1-HL MIDDLE STREET RECONSTRUCTION-DOTHA-CAV-06-19-14-BD-HEL-MS107 TO MS110 - MS208 TO MS210 - MS312.DWG PLOT TIME: 06-19-14, 9:04 AM

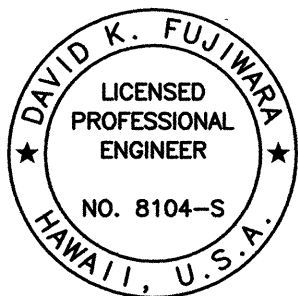

THIS WORK WAS PREPARED BY ME OR UNDER MY SUPERVISION.

*David K. Fujiwara* 4-30-16  
 SIGNATURE EXPIRATION DATE OF THE LICENSE

STATE OF HAWAII  
 DEPARTMENT OF TRANSPORTATION  
 HIGHWAYS DIVISION

**PCCP JOINTING PLAN**


MIDDLE STREET PAVEMENT RECONSTRUCTION  
 North King Street to Kamehameha Highway  
 FAP NO. STP-7415(001)

Scale: As Noted Date: Jun. 20, 2014

SHEET No. S1.7 OF 10 SHEETS




| FED. ROAD DIST. NO. | STATE | FEDERAL AID PROJ. NO. | FISCAL YEAR | SHEET NO. | TOTAL SHEETS |
|---------------------|-------|-----------------------|-------------|-----------|--------------|
| HAWAII              | HAW.  | STP-7415(001)         | 2014        | 125       | 173          |

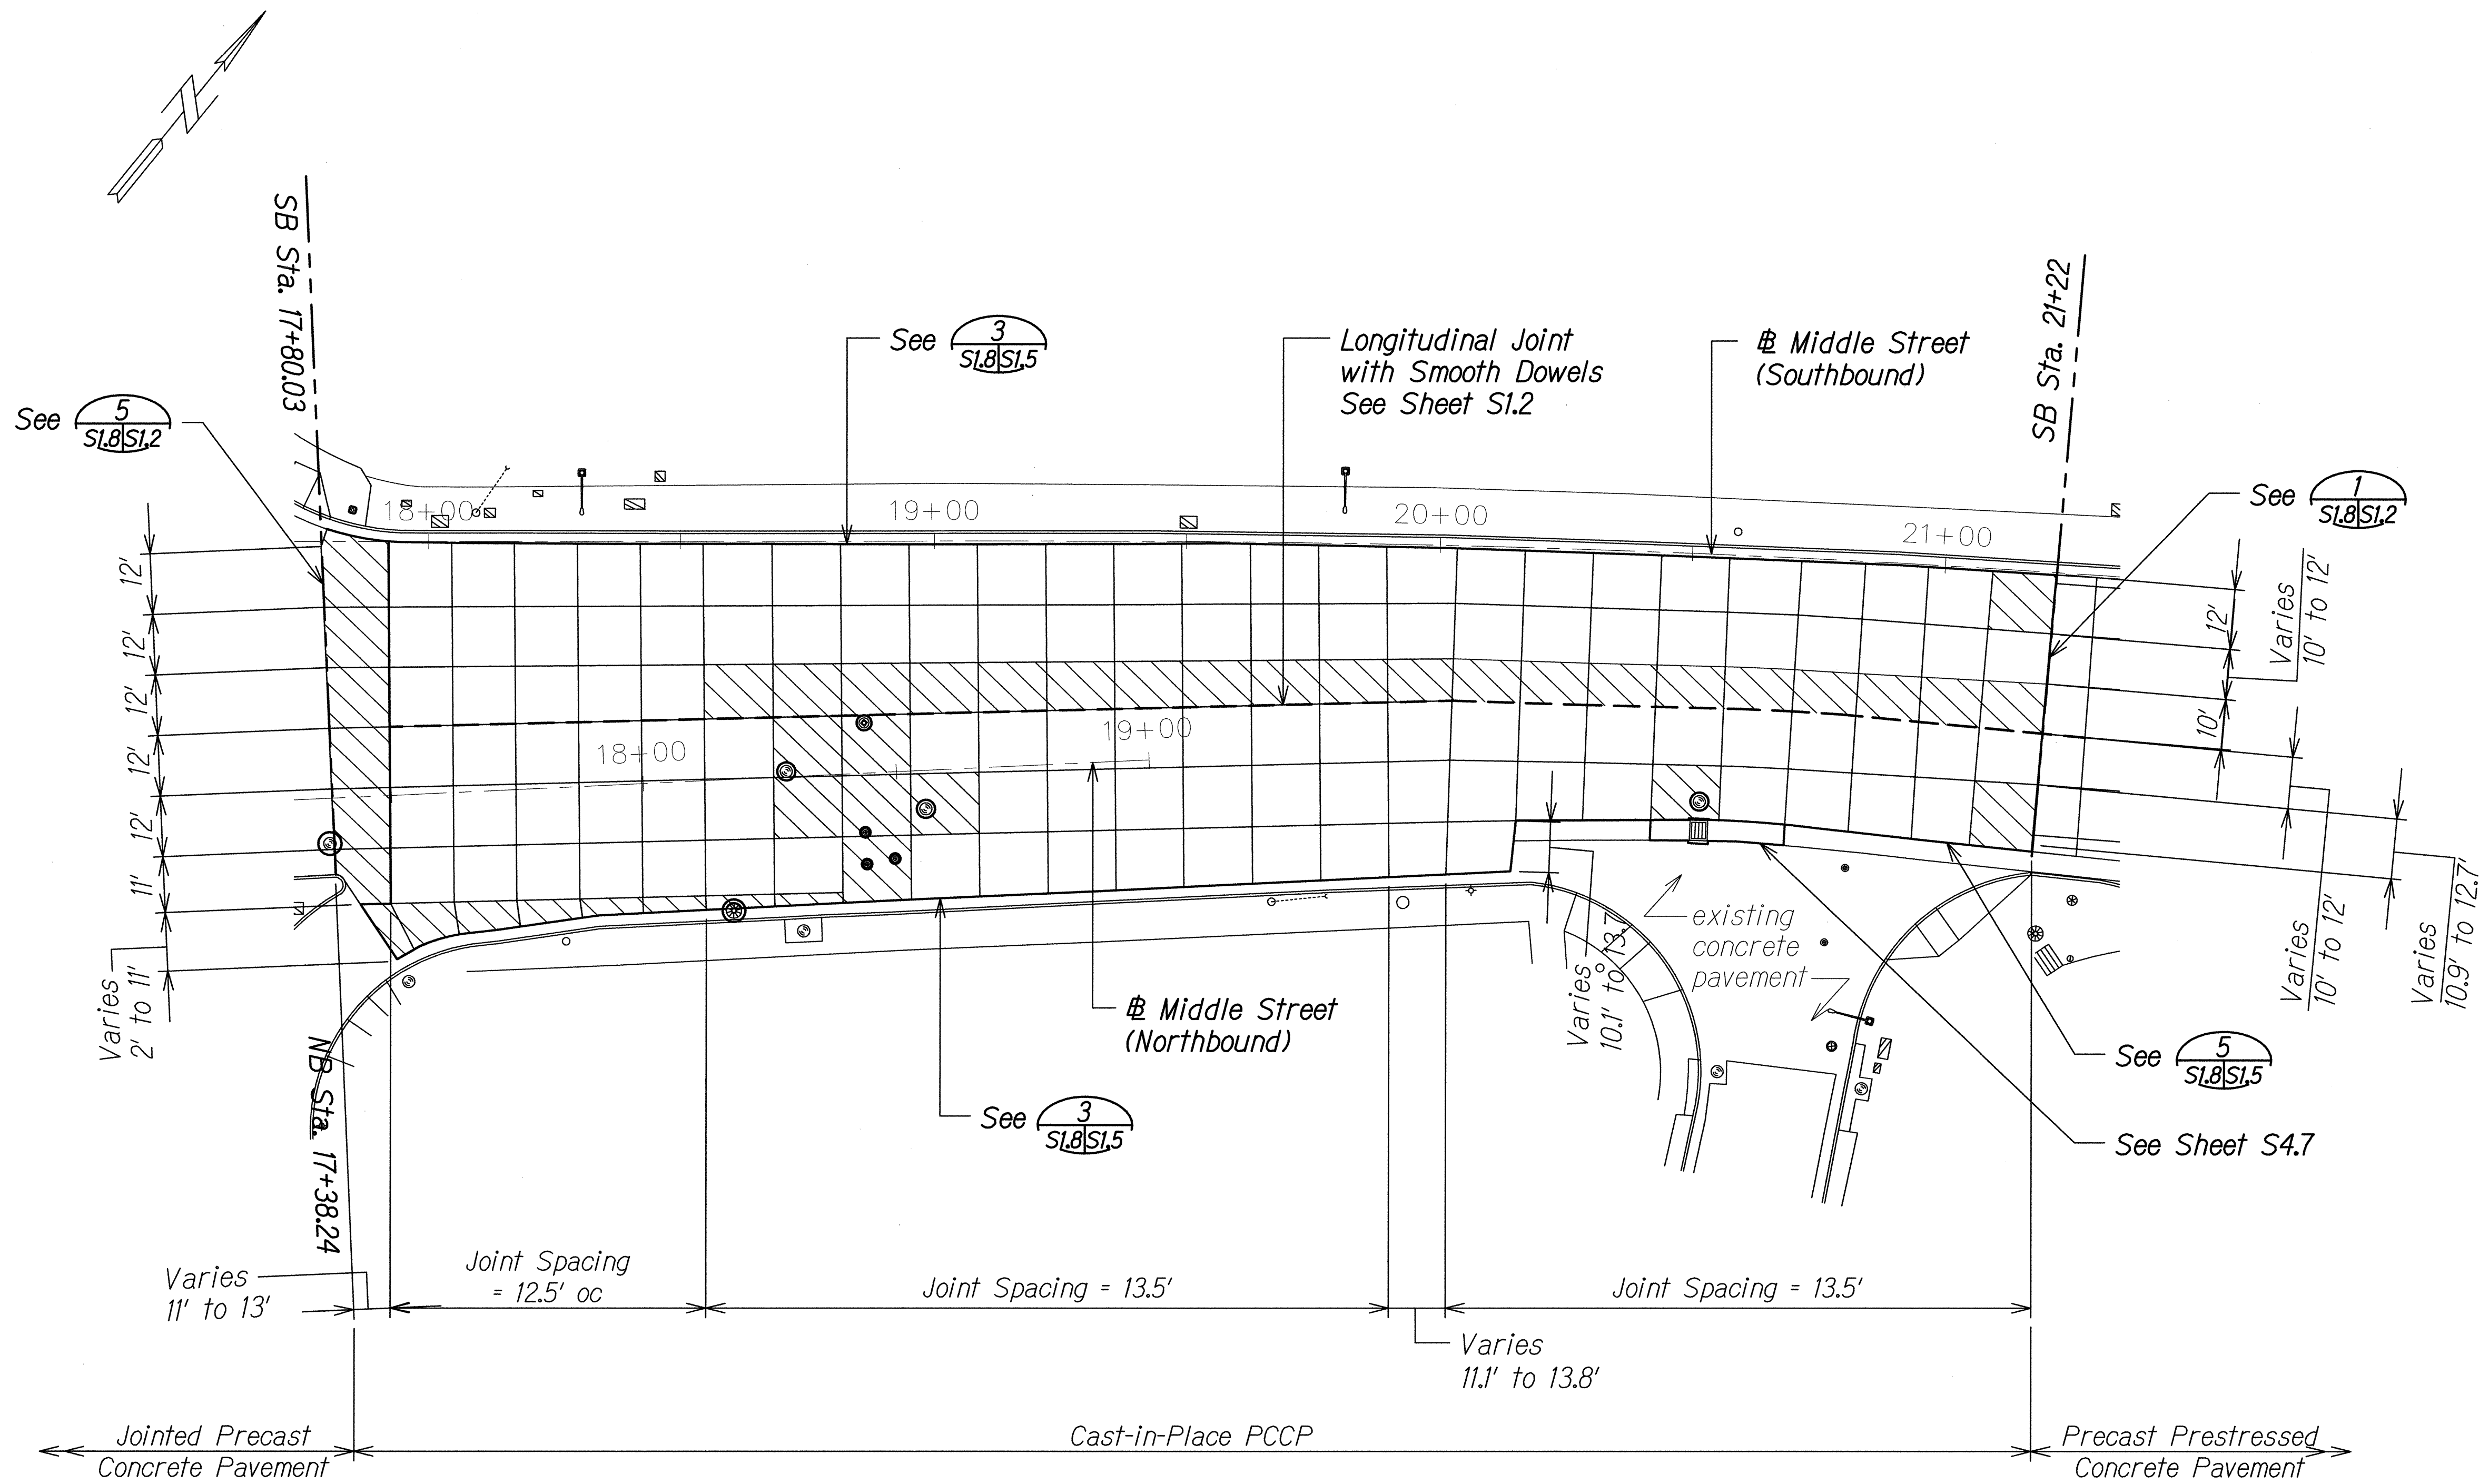

# **PCCP JOINTING PLAN** Scale: 1" = 20'-0"

## **Legend:**

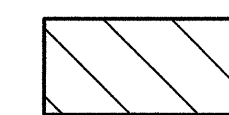

Odd Shaped Sections  
See General Notes 4.(F) and 7.(H)  
on Sheet S0.2.


|                   |      |
|-------------------|------|
| SURVEY PLOTTED BY | DATE |
| DRAWN BY          |      |
| DESIGNED BY       |      |
| QUANTITIES BY     |      |
| CHECKED BY        |      |
| ORIGINAL PLAN     |      |
| NOTE BOOK         |      |
| No.               |      |

DRAWING NAME: 21-00 ONGOING 12-0331-HFL MIDDLE STREET RECONSTRUCTION-00TH CAD 06-19-14 B1A/HFL-MS107 TO MS110 - MS208 TO MS210 - MS312.DWG PLOT TIME: 06-19-14, 9:04 AM


STATE OF HAWAII  
DEPARTMENT OF TRANSPORTATION  
HIGHWAYS DIVISION  
**PCCP JOINTING PLAN**  
MIDDLE STREET PAVEMENT RECONSTRUCTION  
North King Street to Kamehameha Highway  
FAP NO. STP-7415(001)  
Scale: As Noted Date: Jun. 20, 2014  
SHEET No. S1.8 OF 10 SHEETS



| FED. ROAD DIST. NO. | STATE | FEDERAL AID PROJ. NO. | FISCAL YEAR | SHEET NO. | TOTAL SHEETS |
|---------------------|-------|-----------------------|-------------|-----------|--------------|
| HAWAII              | HAW.  | STP-7415(001)         | 2014        | 126       | 173          |

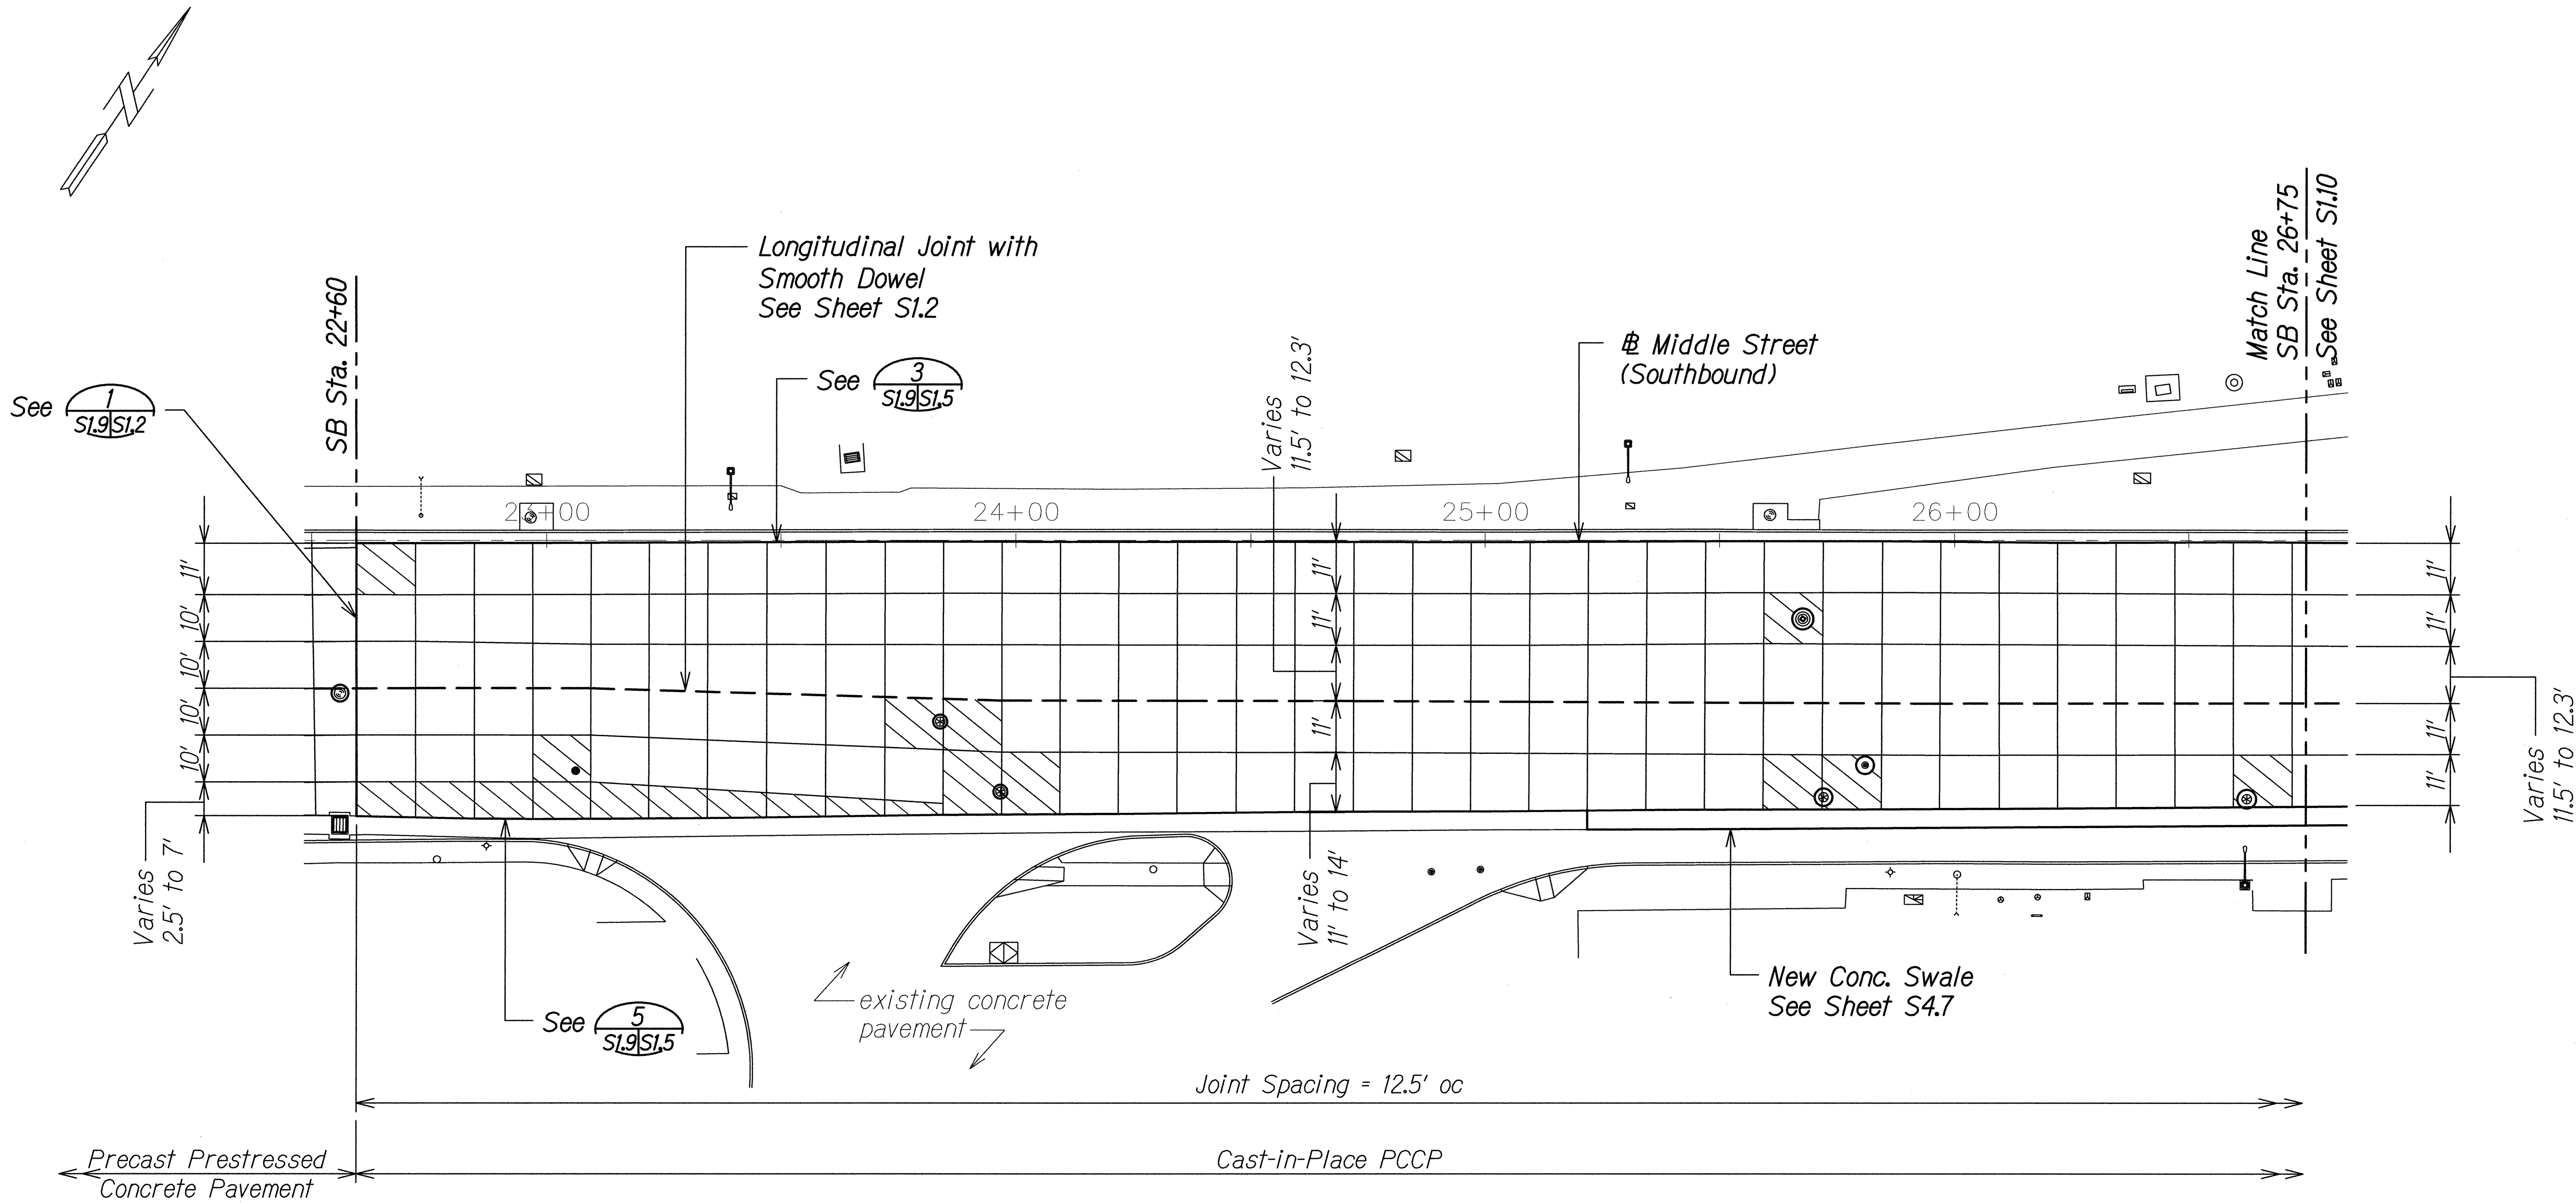


**PCCP JOINTING PLAN**  
 Scale: 1" = 20'-0"

**Legend:**  
 Odd Shaped Sections  
 See General Notes 4.(F) and 7.(H)  
 on Sheet S0.2.

|               |                   |      |
|---------------|-------------------|------|
| ORIGINAL PLAN | SURVEY PLOTTED BY | DATE |
| NOTE BOOK     | DESIGNED BY       |      |
|               | QUANTITIES BY     |      |
|               | CHECKED BY        |      |

DRAWING NAME: 23+00 OONGONGA 12-0331-HFL MIDDLE STREET RECONSTRUCTION-DOTH(CAD)06-19-14 BDL/HFL-MS107 TO MS110 - MS208 TO MS210 - MS312/DWG PLOT TIME: 06-19-14, 9:09 AM

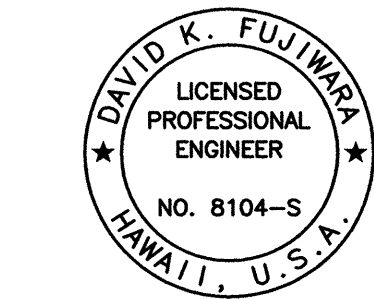


THIS WORK WAS PREPARED BY  
 ME OR UNDER MY SUPERVISION.  
*David K. Fujiwara*  
 SIGNATURE EXPIRATION DATE OF THE LICENSE 4-30-16

STATE OF HAWAII  
 DEPARTMENT OF TRANSPORTATION  
 HIGHWAYS DIVISION  
**PCCP JOINTING PLAN**  
 MIDDLE STREET PAVEMENT RECONSTRUCTION  
 North King Street to Kamehameha Highway  
 FAP NO. STP-7415(001)  
 Scale: As Noted Date: Jun. 20, 2014  
 SHEET No. S1.9 OF 10 SHEETS




| FED. ROAD DIST. NO. | STATE | FEDERAL AID PROJ. NO. | FISCAL YEAR | SHEET NO. | TOTAL SHEETS |
|---------------------|-------|-----------------------|-------------|-----------|--------------|
| HAWAII              | HAW.  | STP-7415(001)         | 2014        | 127       | 173          |

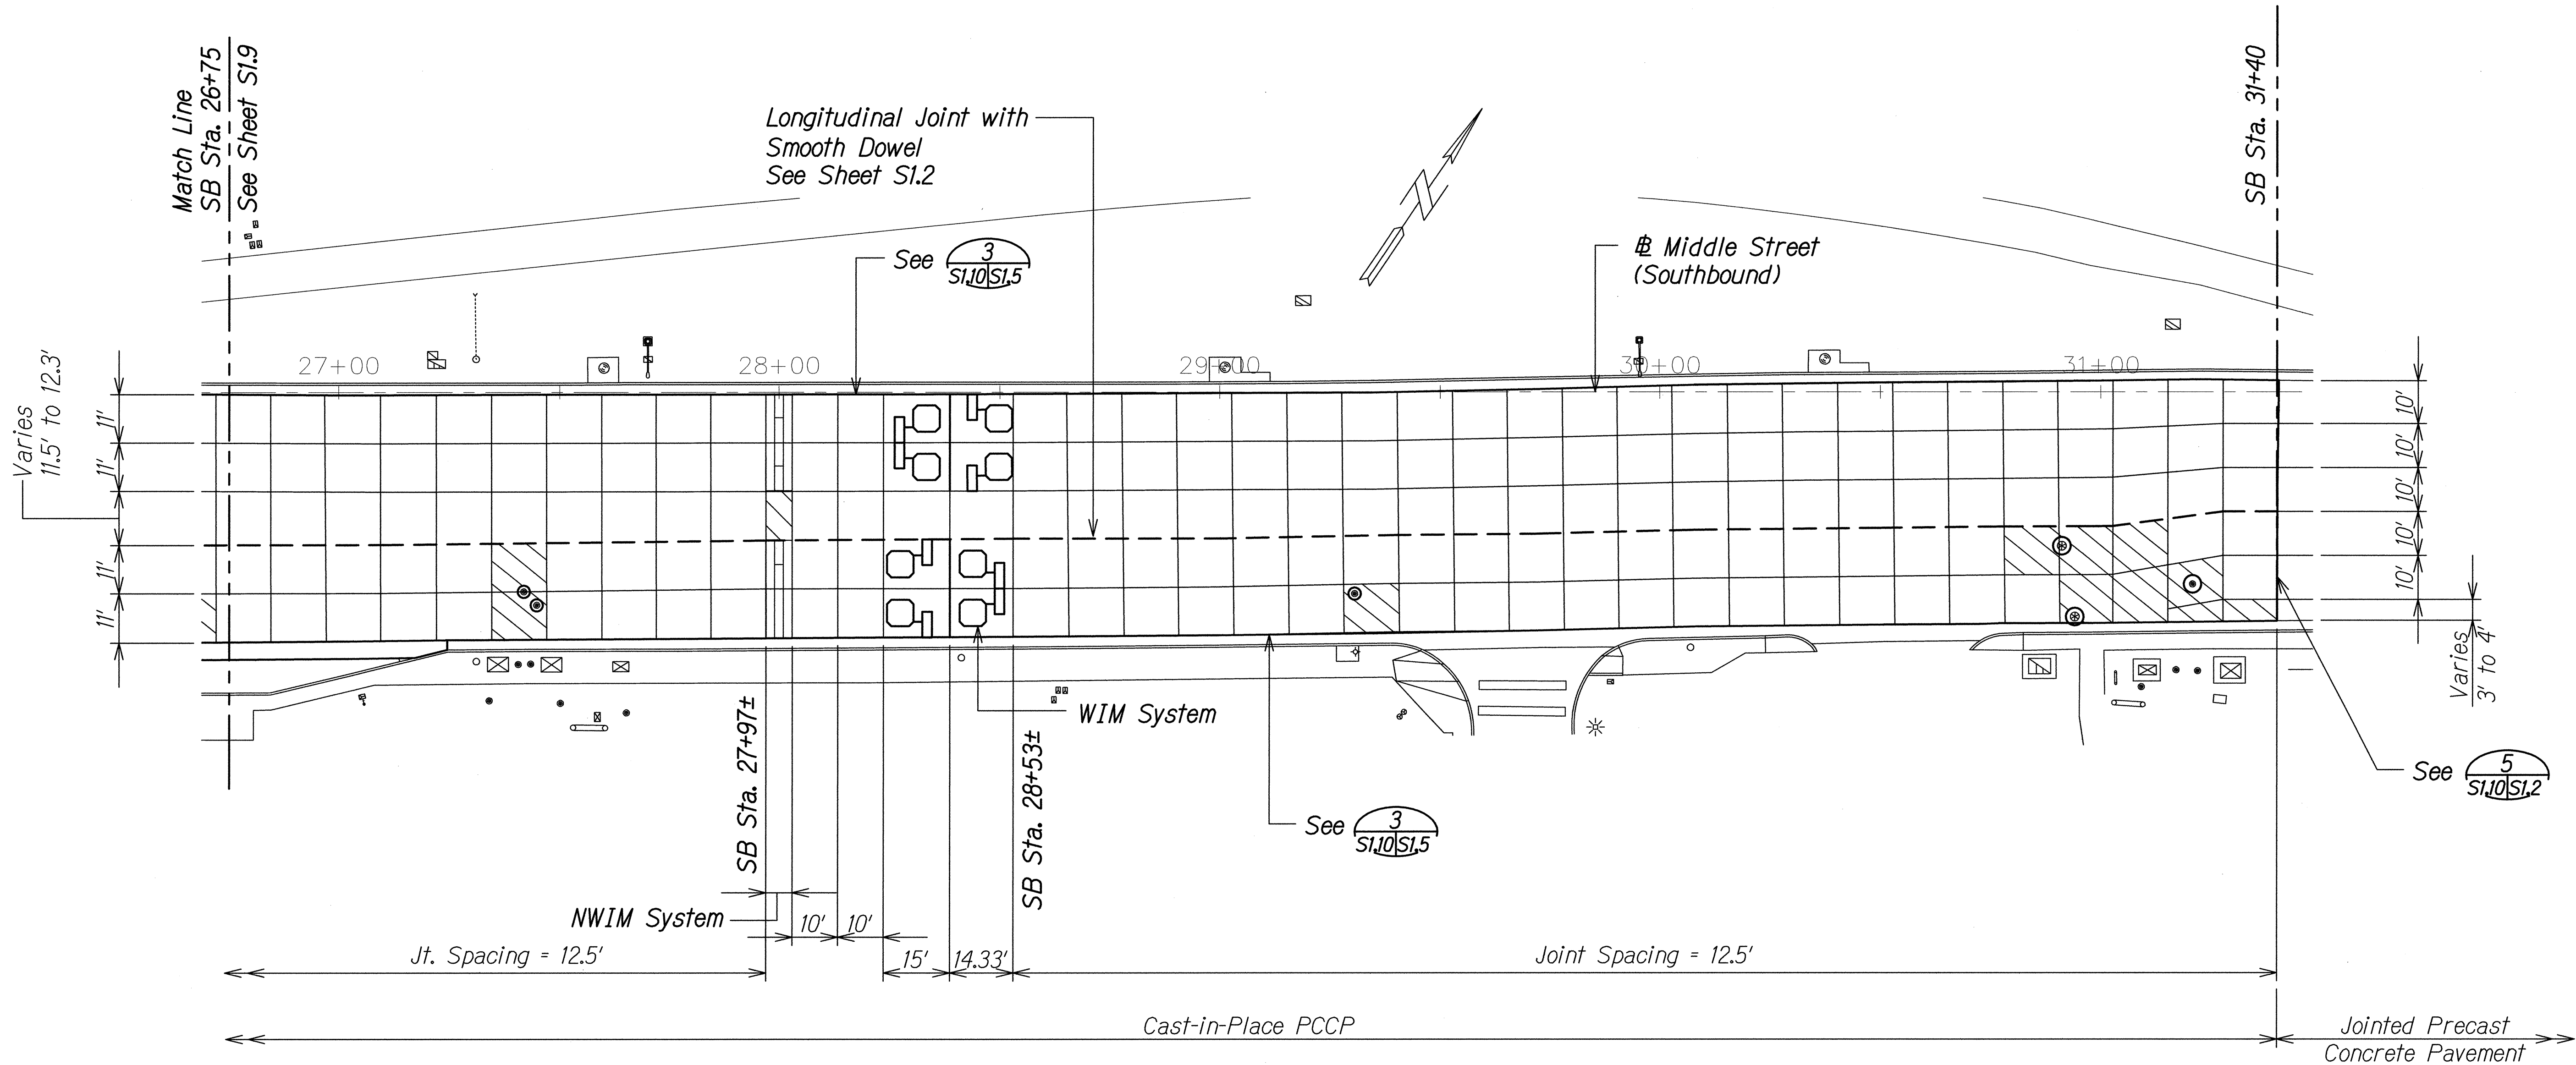


# **PCCP JOINTING PLAN** Scale: 1" = 20'-0"

**Legend:**

 Odd Shaped Sections  
See General Notes 4.(F) and 7.(H)  
on Sheet S0.2.

|               |                   |      |
|---------------|-------------------|------|
| ORIGINAL PLAN | SURVEY PLOTTED BY | DATE |
| NOTE BOOK     | DRAWN BY          | " "  |
| No.           | DESIGNED BY       | " "  |
|               | QUANTITIES BY     | " "  |
|               | CHECKED BY        | " "  |

DRAWING NAME: Z:\000\_OVGCON\12-0331-HEL MIDDLE STREET RECONSTRUCTION-DOT\A\05-19-14\_BD\HEL-MS107 TO MS110 - MS208 TO MS210 - MS312.DWG PLOT TIME: 06-19-14, 9:09 AM

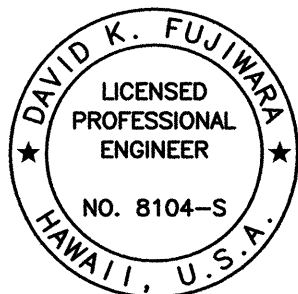

THIS WORK WAS PREPARED BY ME OR UNDER MY SUPERVISION.

*David K. Fujiwara* 4-30-16

SIGNATURE EXPIRATION DATE OF THE LICENSE

STATE OF HAWAII  
DEPARTMENT OF TRANSPORTATION  
HIGHWAYS DIVISION

**PCCP JOINTING PLAN**



MIDDLE STREET PAVEMENT RECONSTRUCTION  
North King Street to Kamehameha Highway  
FAP NO. STP-7415(001)

Scale: As Noted Date: Jun. 20, 2014


SHEET No. S1.10 OF 10 SHEETS



| FED. ROAD DIST. NO. | STATE | FEDERAL AID PROJ. NO. | FISCAL YEAR | SHEET NO. | TOTAL SHEETS |
|---------------------|-------|-----------------------|-------------|-----------|--------------|
| HAWAII              | HAW.  | STP-7415(001)         | 2014        | 128       | 173          |

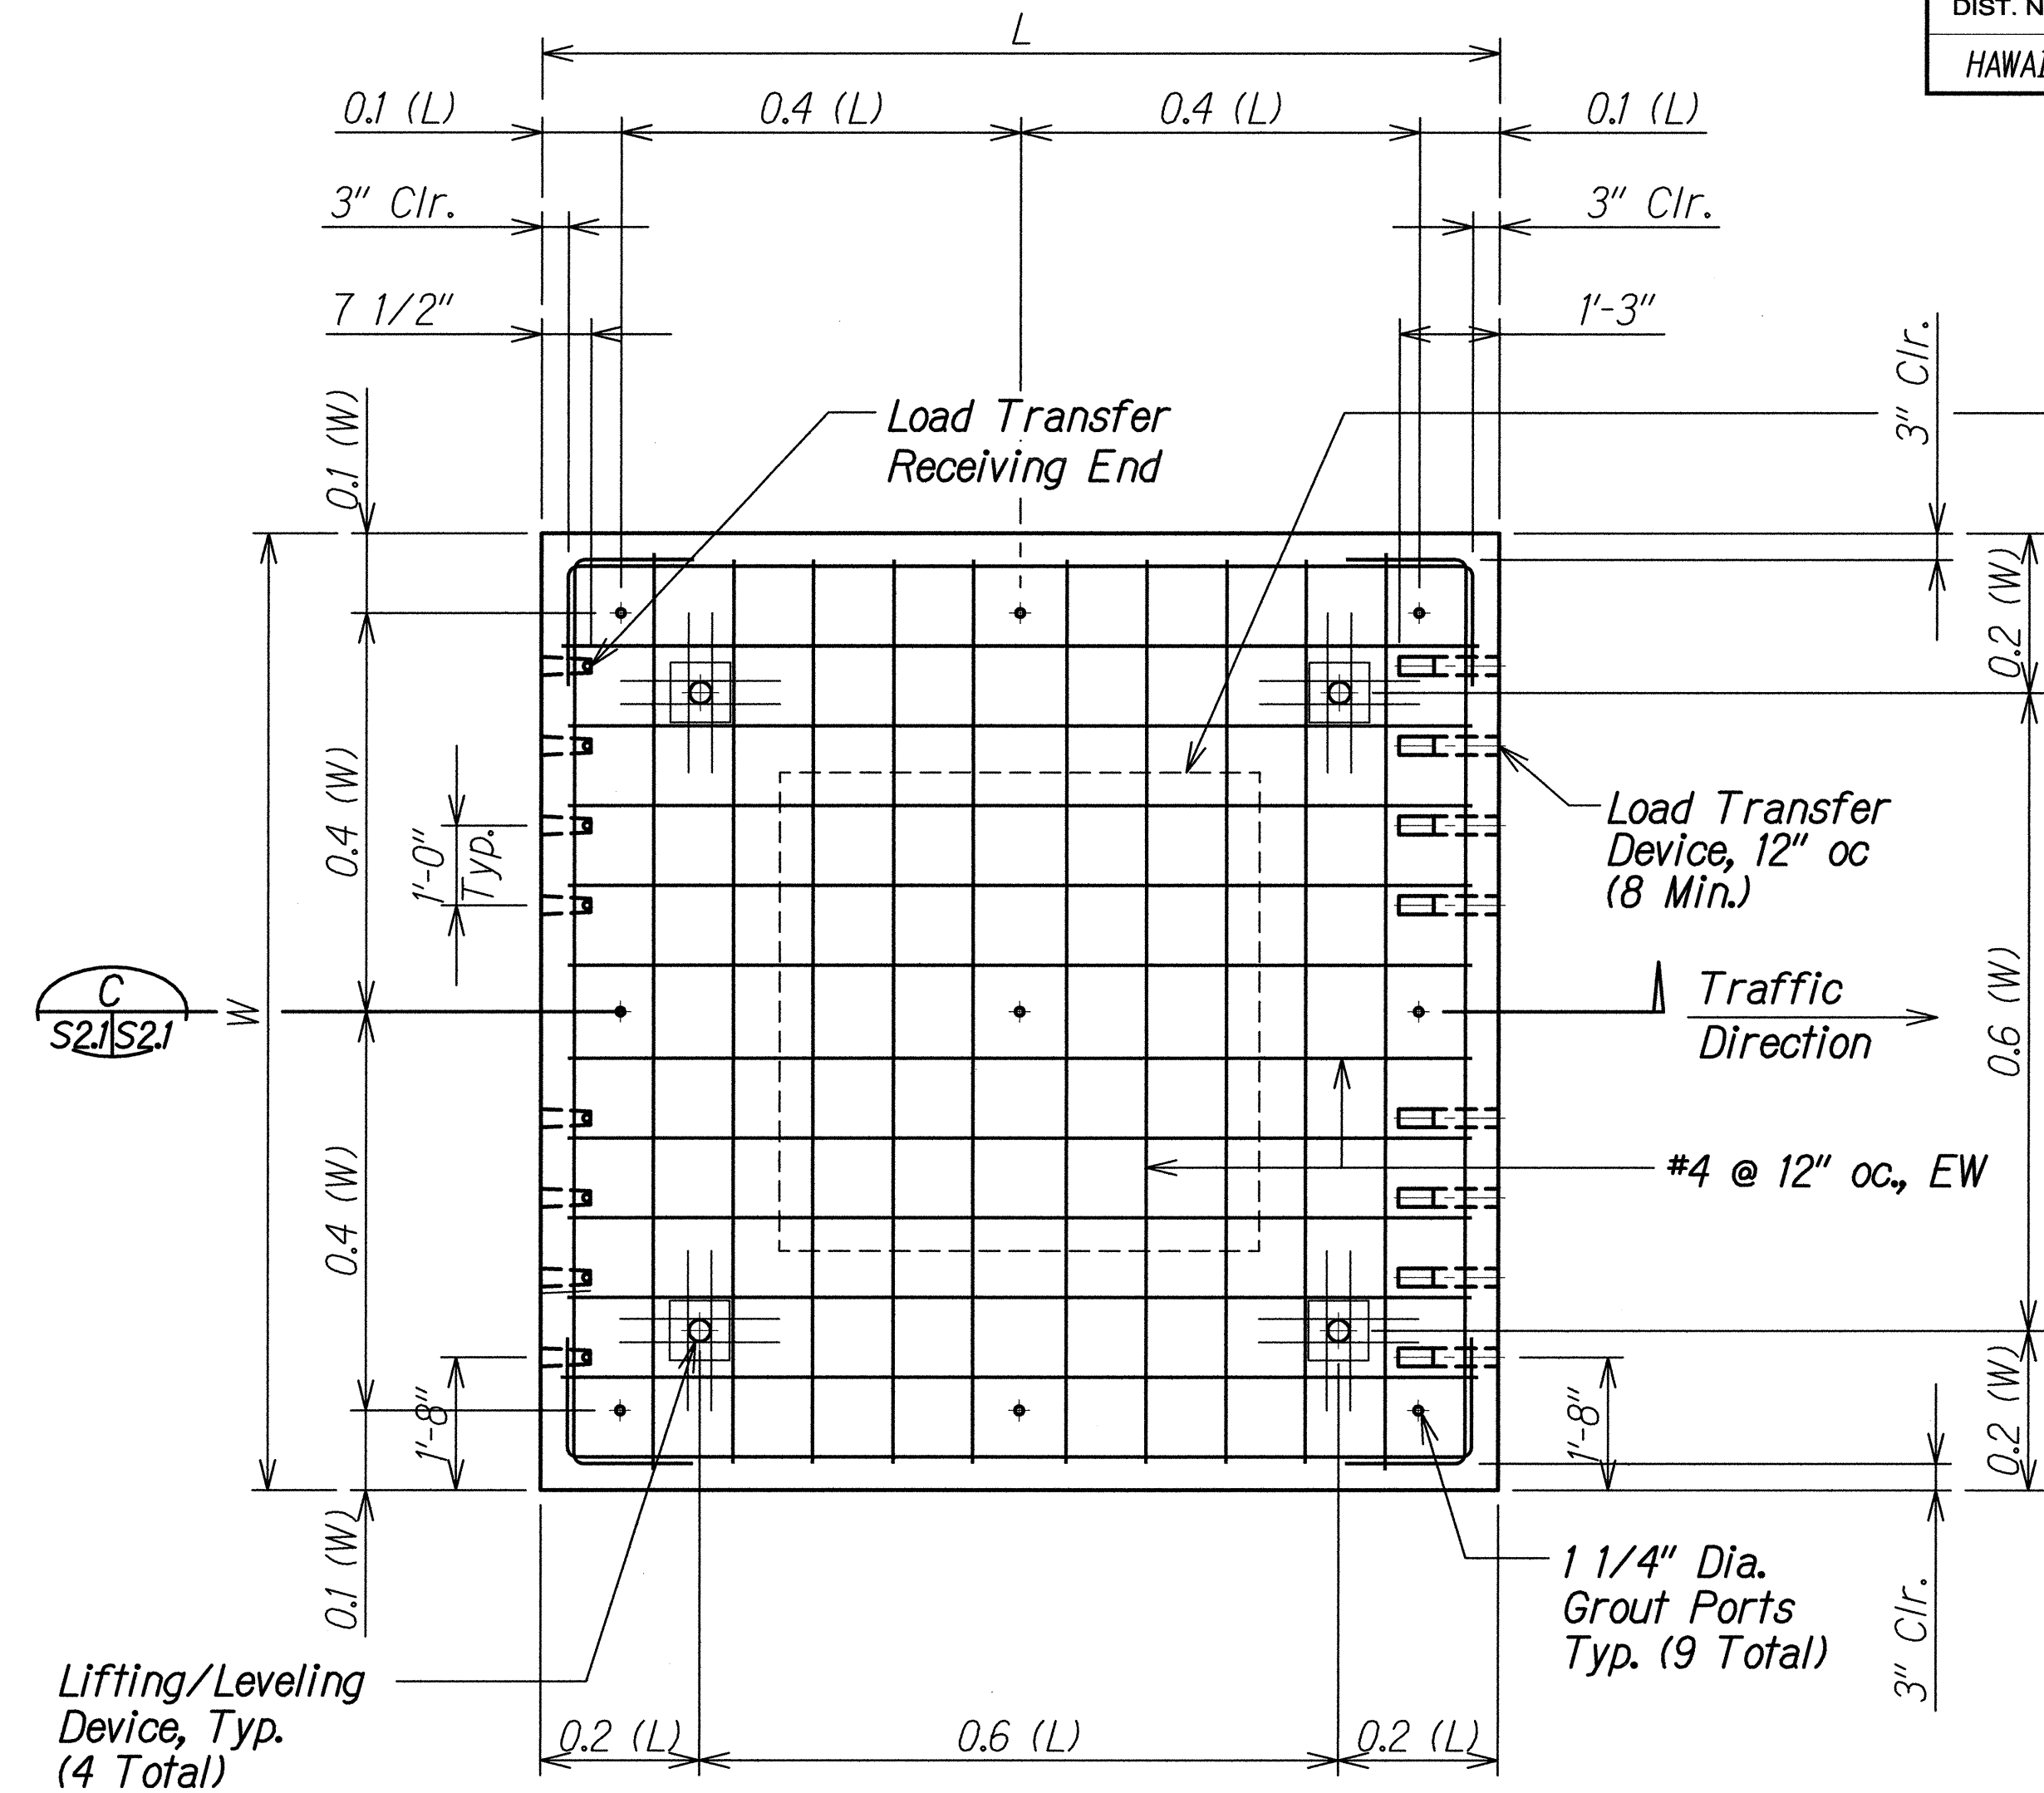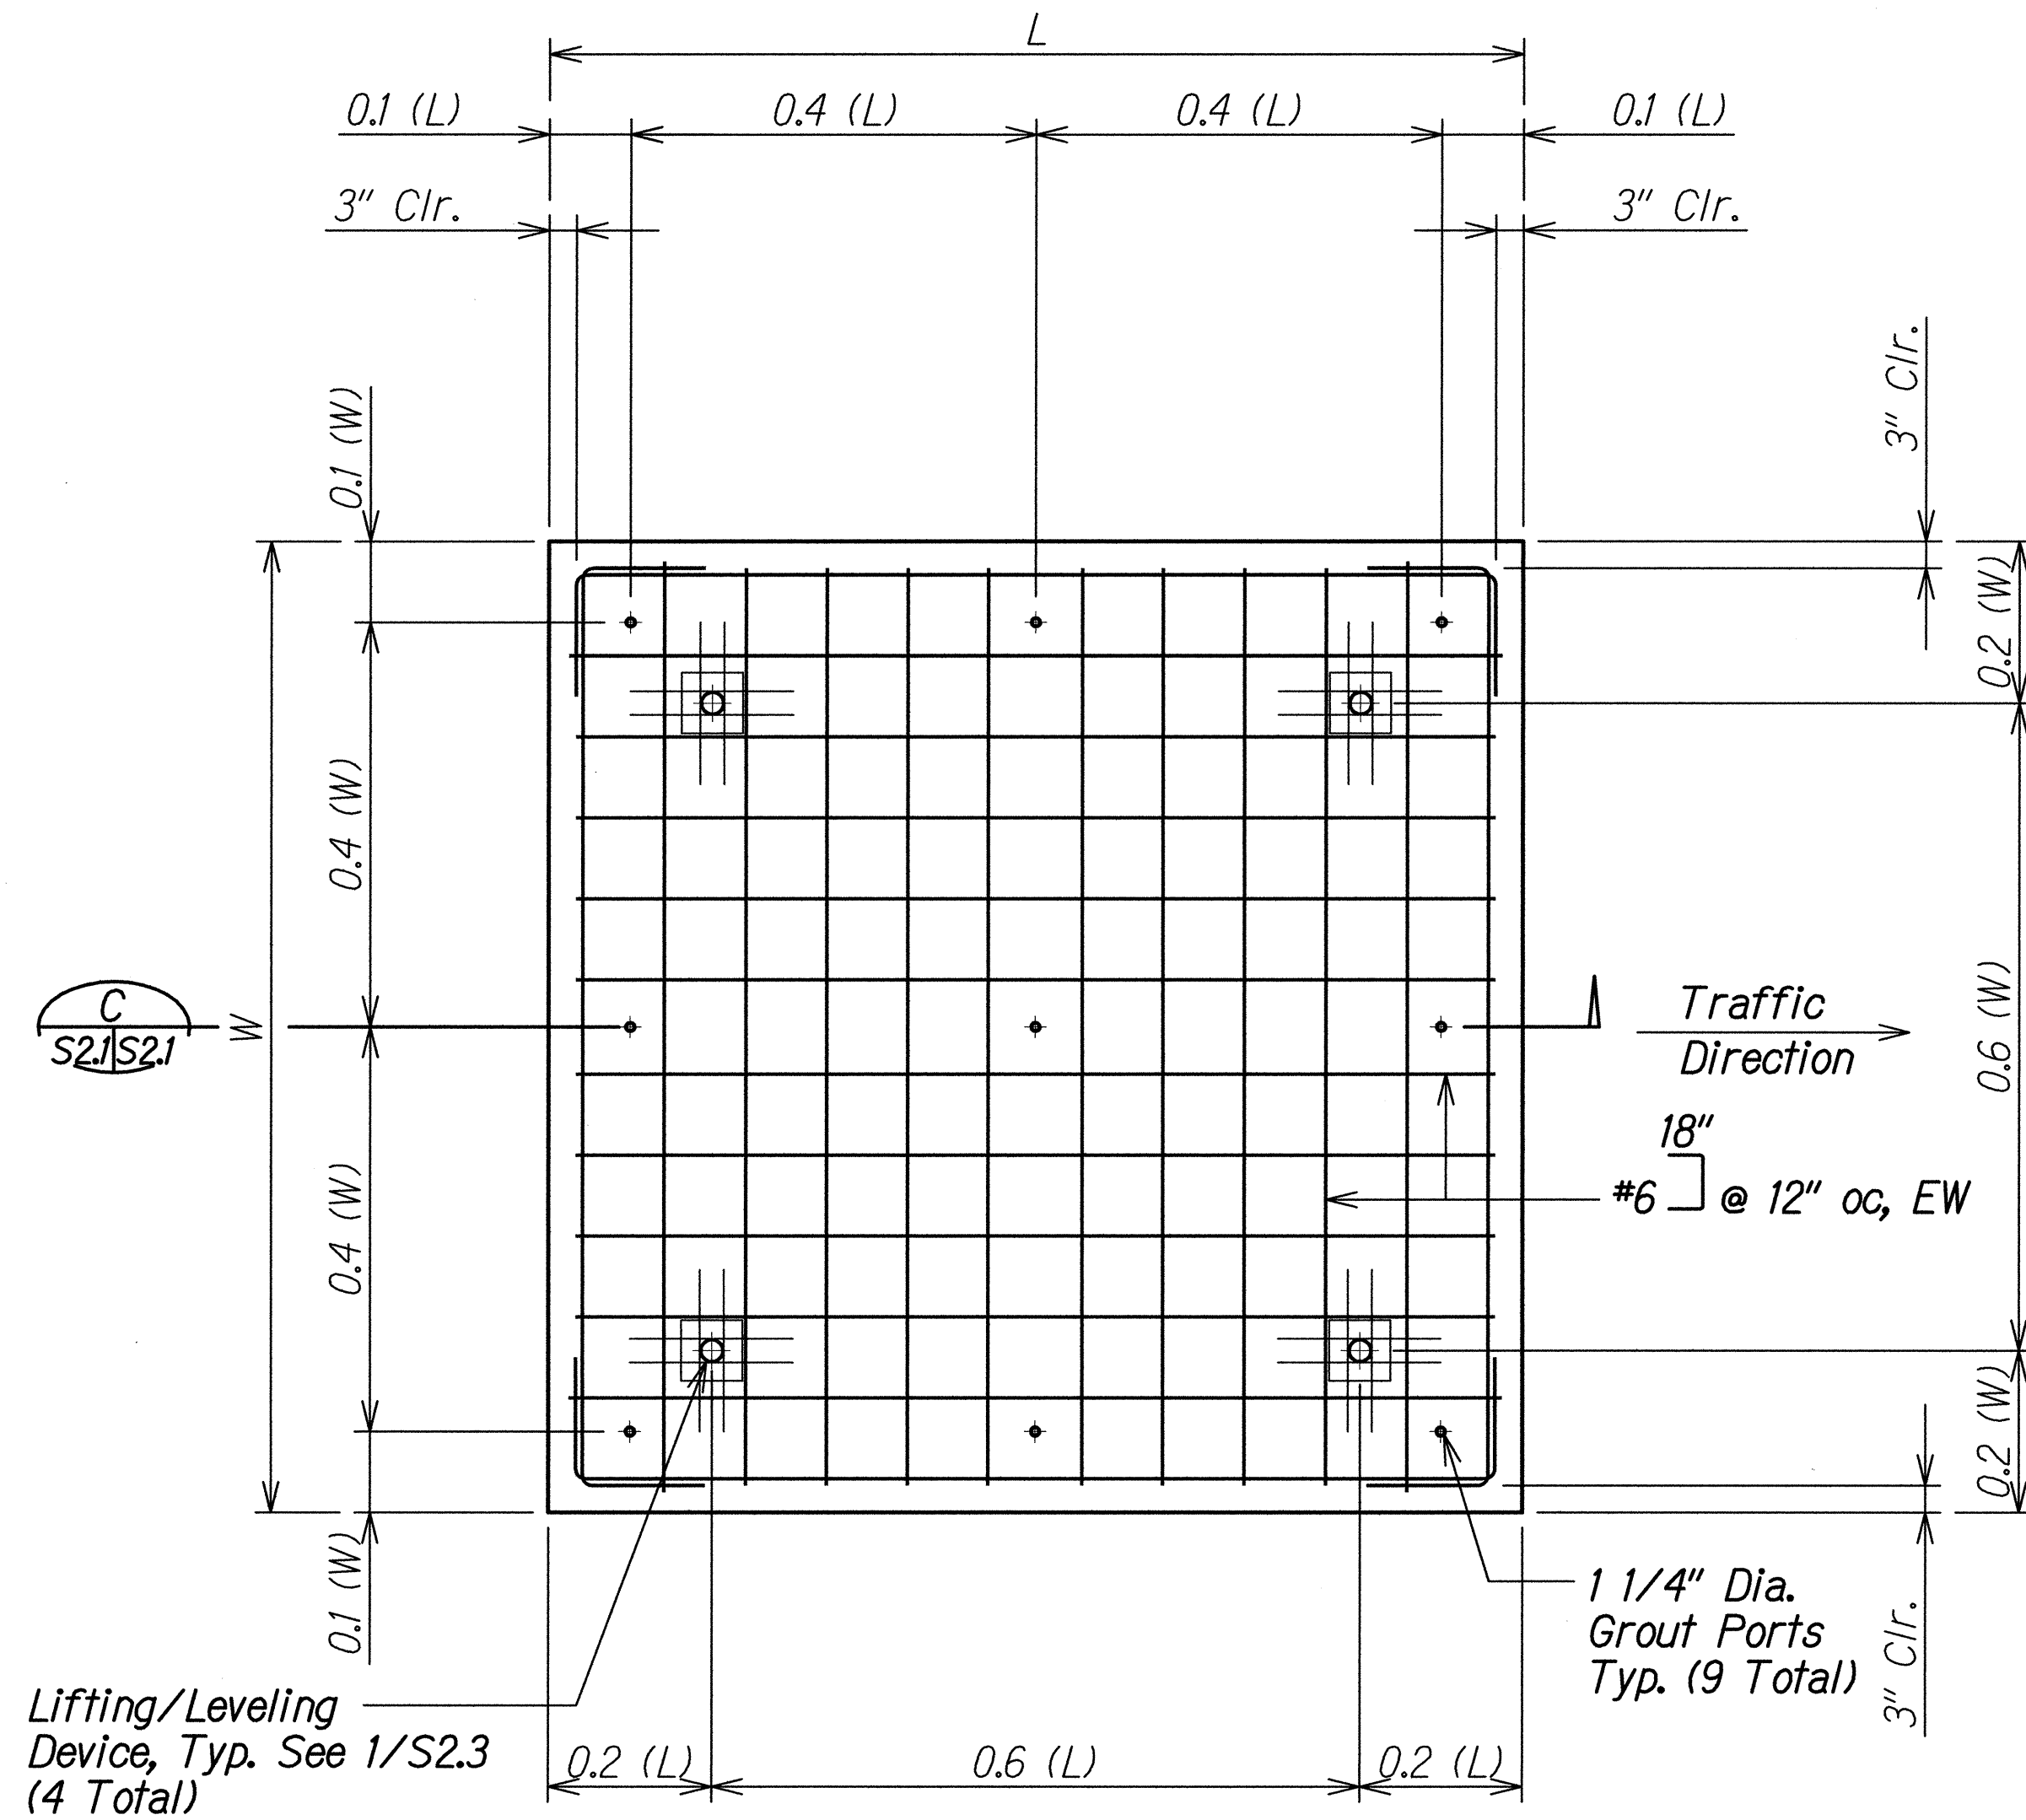


Adjust Top Mat of Reinforcing as Required to Provide 2" Clearance in All Directions to the Vehicle Detector Loop. In all cases vehicle detector loops shall be Placed Above Reinforcing

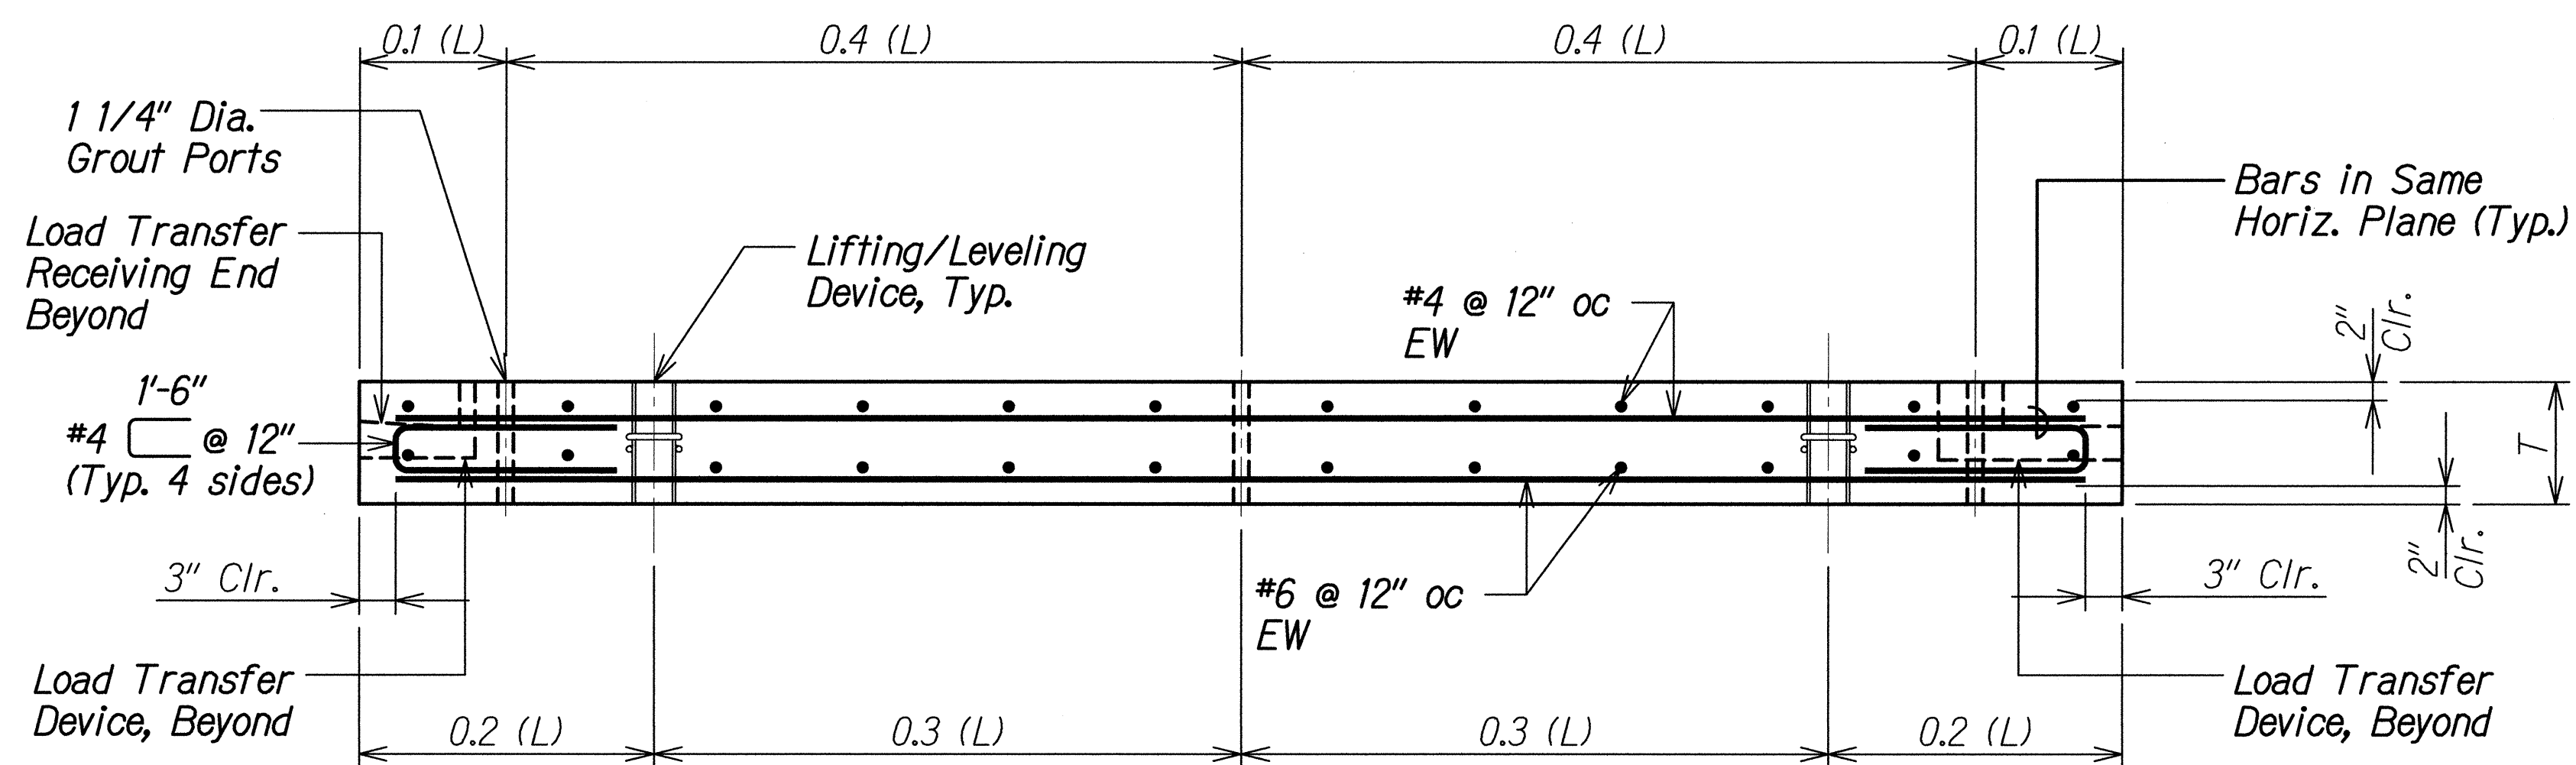

#### Notes:

- 1 1/2" Diameter x 1'-2" Long, Epoxy Coated Smooth dowel bars shall be used.
- For dowel bar placement detail and Foam core insert, see sheet S2.3.
- For grout port details and joint details, see sheet S2.3.
- Adjust reinforcement bars to accommodate dowel bars and dowel bar slots.
- See Sheets T-1 and T-2 for panel thickness.

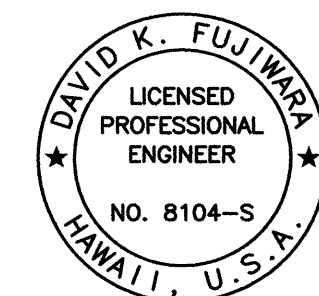

THIS WORK WAS PREPARED BY ME OR UNDER MY SUPERVISION.

Signature: David K. Fujiwara  
Date: 4-30-16  
Expiration Date of the License

STATE OF HAWAII  
DEPARTMENT OF TRANSPORTATION  
HIGHWAYS DIVISION

**TYPICAL JPCP PANEL DETAILS**




MIDDLE STREET PAVEMENT RECONSTRUCTION  
North King Street to Kamehameha Highway  
FAP NO. STP-7415(001)

Scale: As Noted Date: Jun. 20, 2014

SHEET No. S21 OF 10 SHEETS




| FED. ROAD DIST. NO. | STATE | FEDERAL AID PROJ. NO. | FISCAL YEAR | SHEET NO. | TOTAL SHEETS |
|---------------------|-------|-----------------------|-------------|-----------|--------------|
| HAWAII              | HAW.  | STP-7415(001)         | 2014        | 129       | 173          |

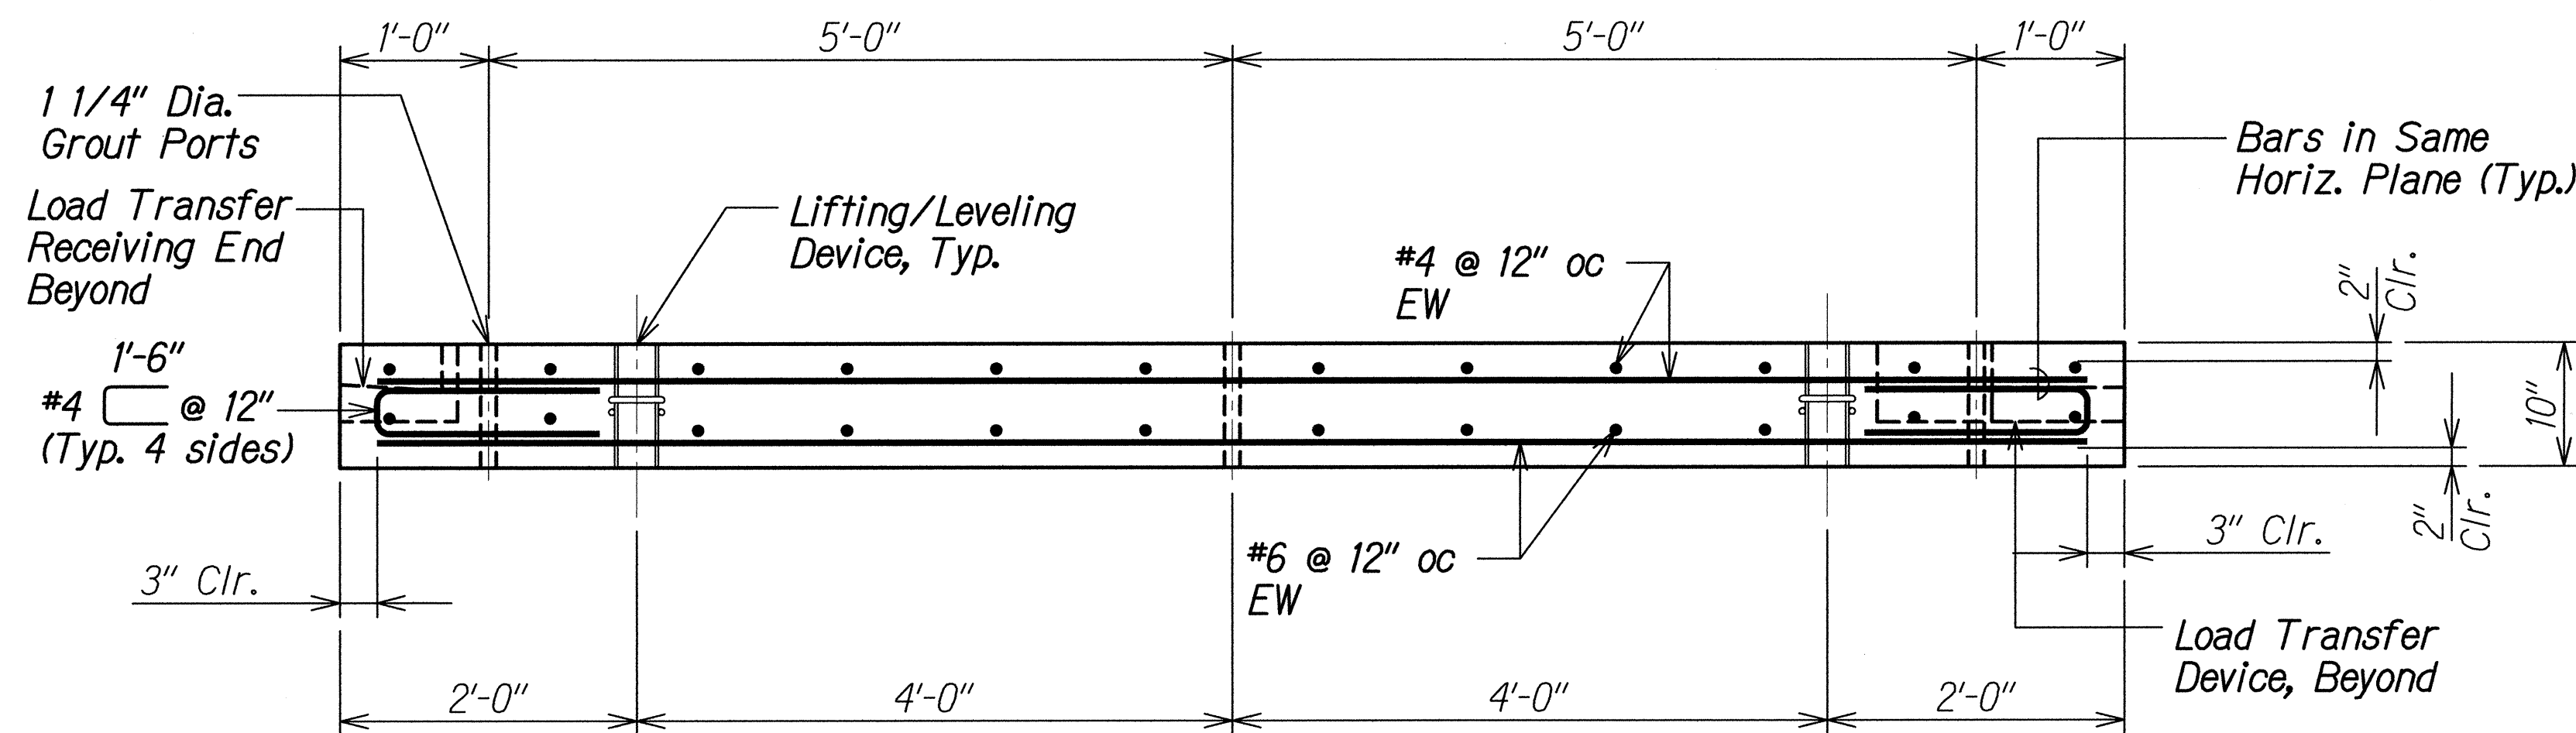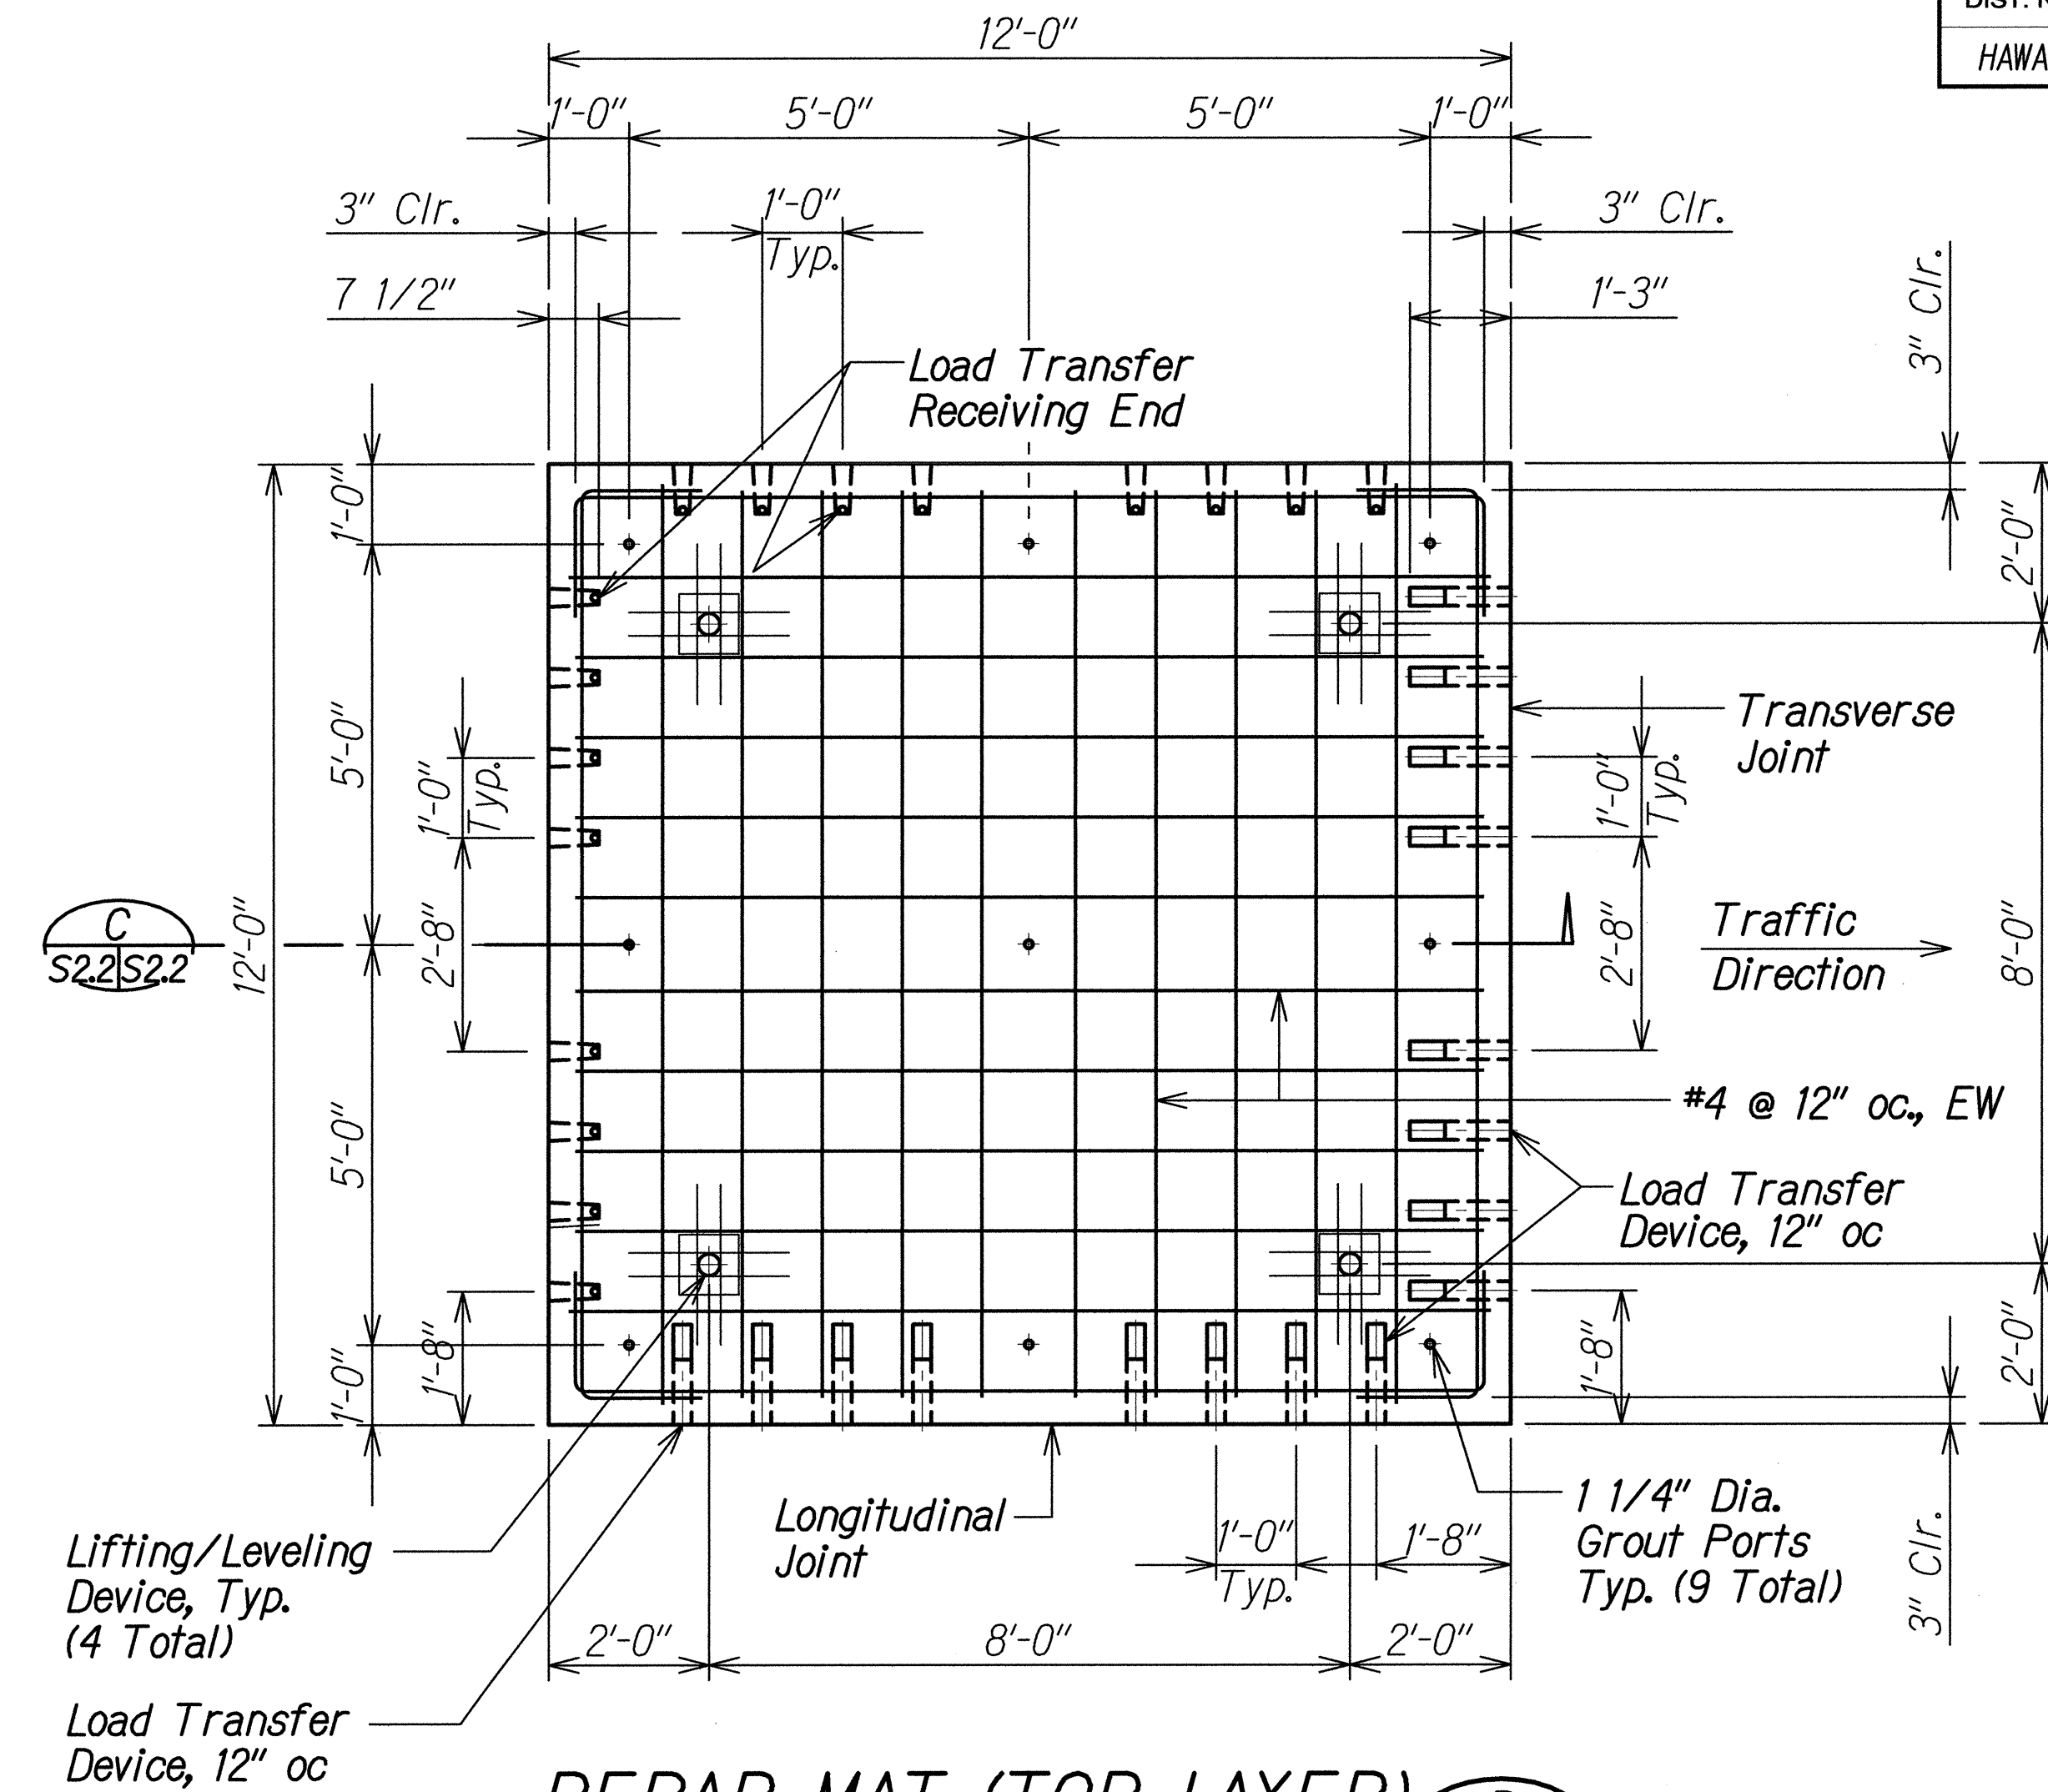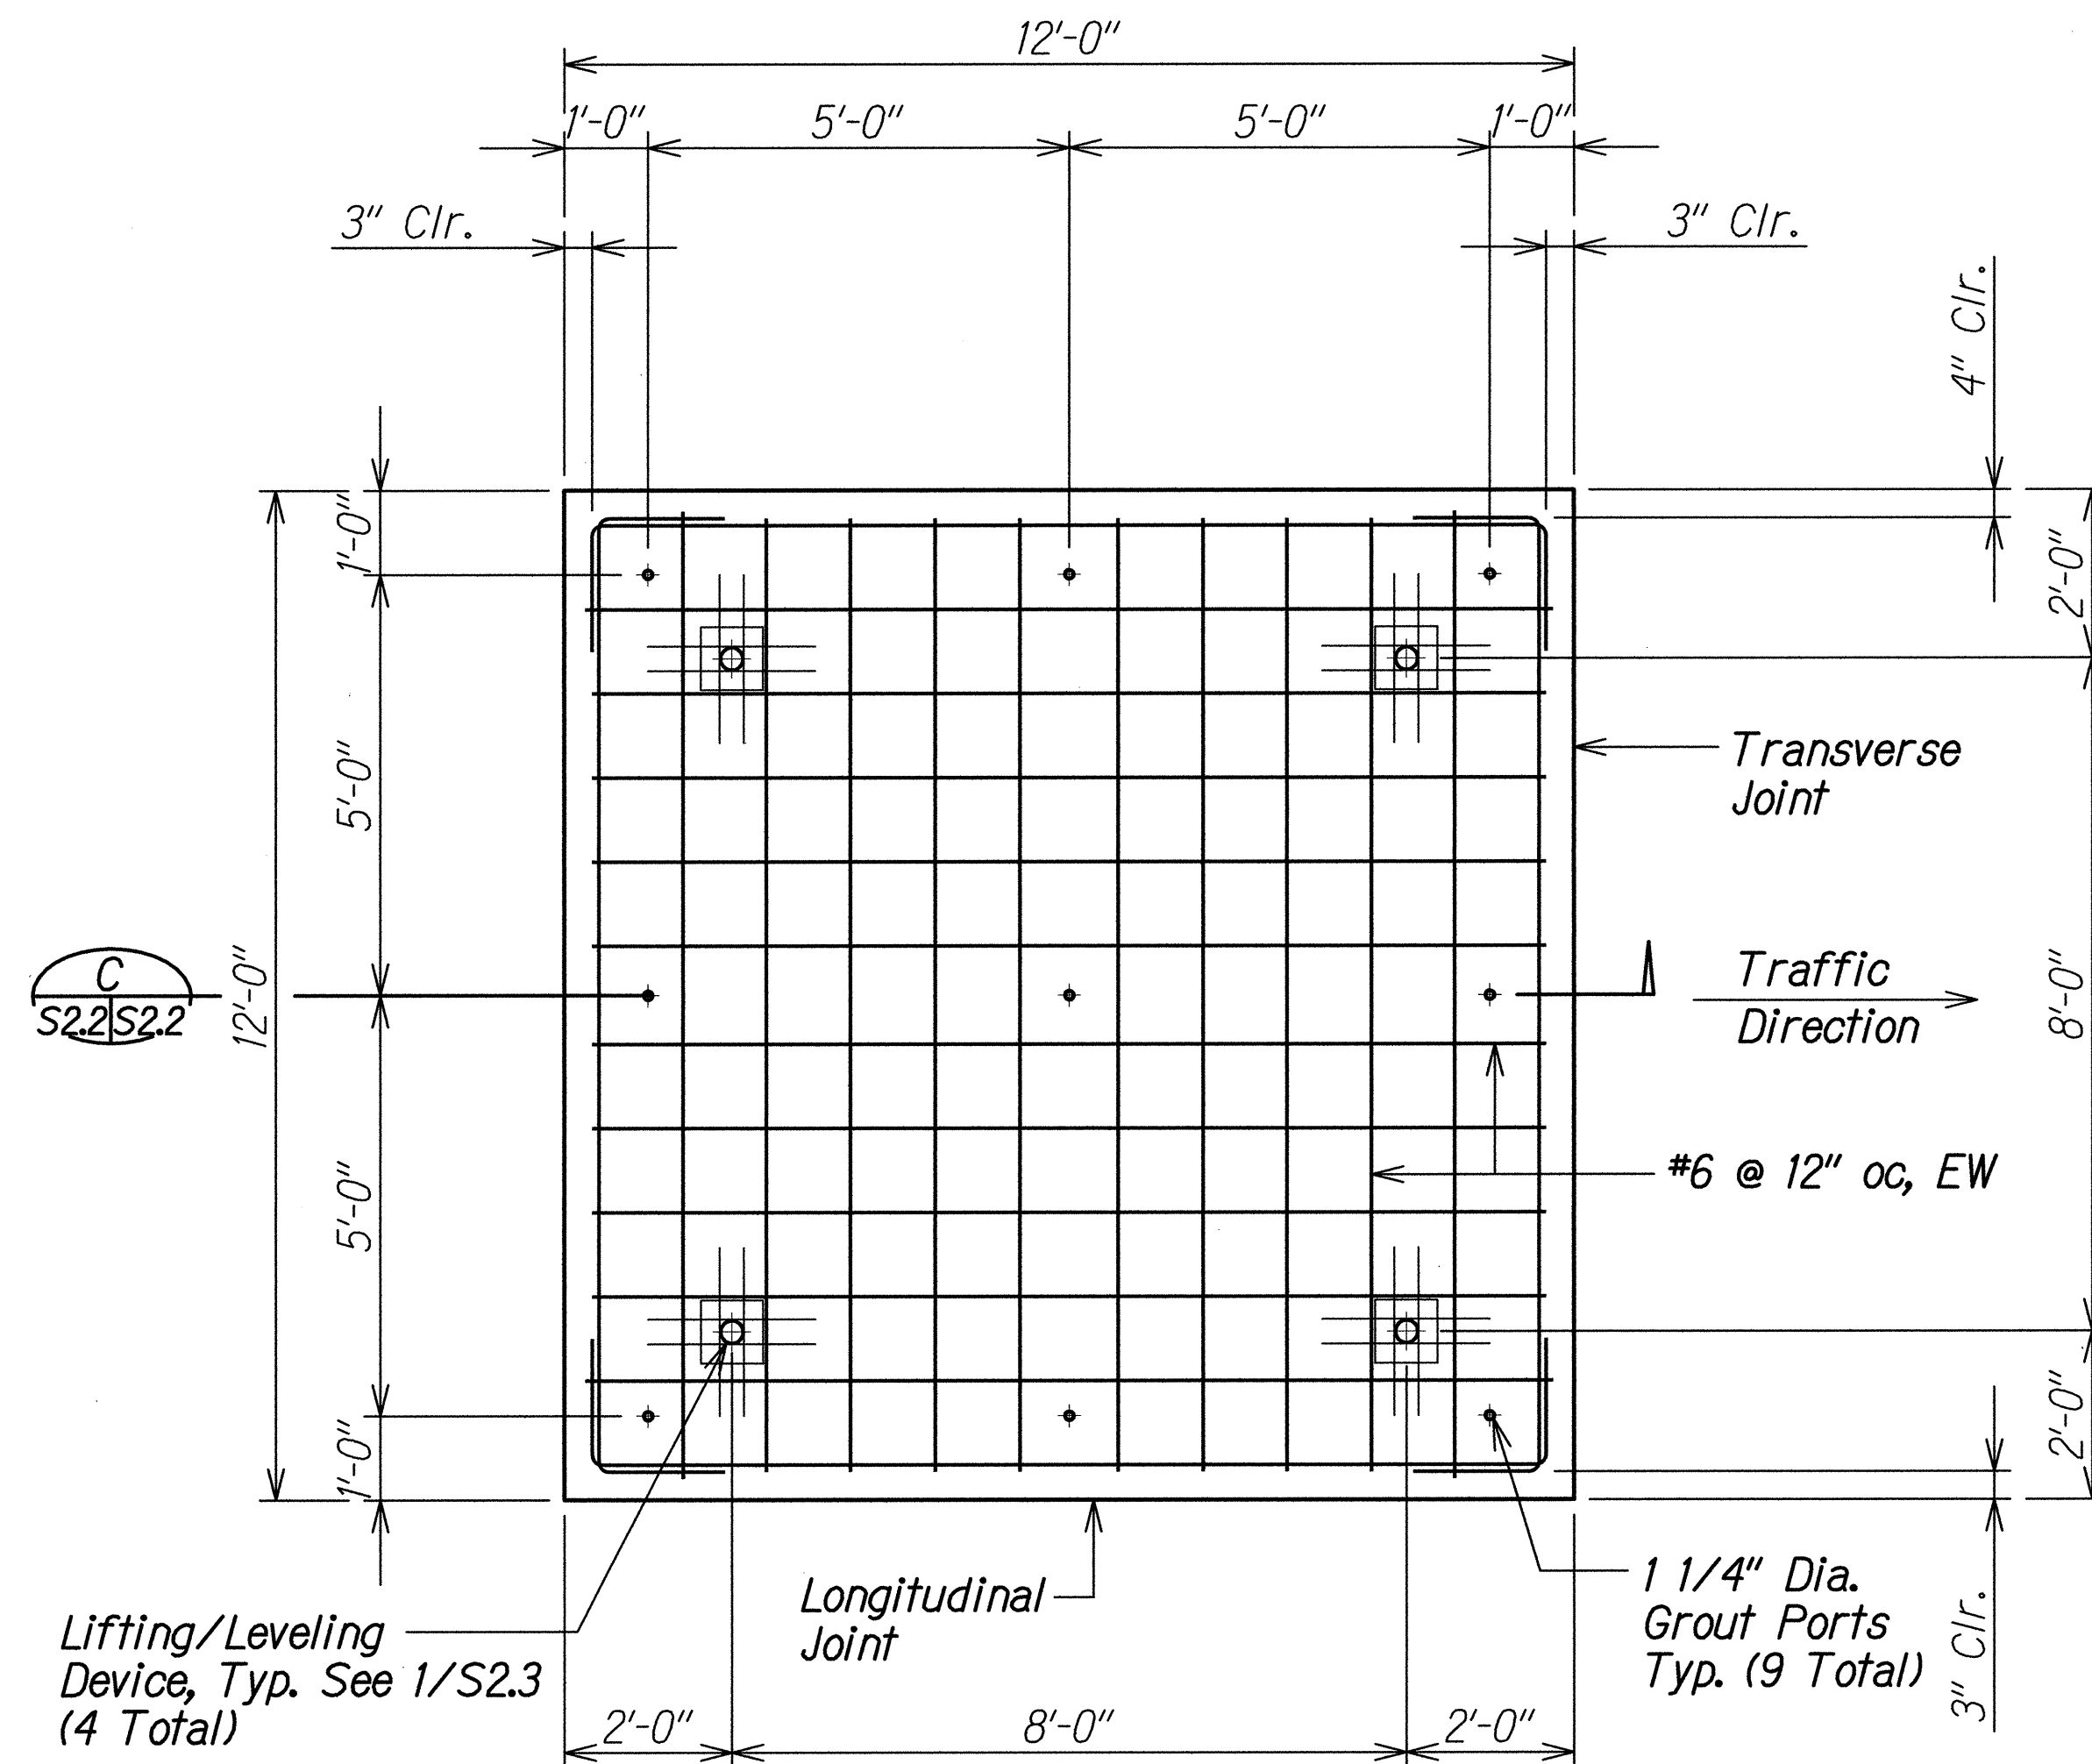

**Notes:**

- 1 1/2" Diameter x 1'-2" Long, Epoxy Coated Smooth dowel bars shall be used for transverse joints.
- 1 1/4" Diameter x 1'-2" Long, Epoxy Coated Smooth dowels shall be used for longitudinal joints.
- For dowel bar placement detail and Foam core insert, see sheet S2.3.
- For grout port details and joint details, see sheet S2.3.
- Adjust reinforcement bars to accommodate dowel bars and dowel bar slots.

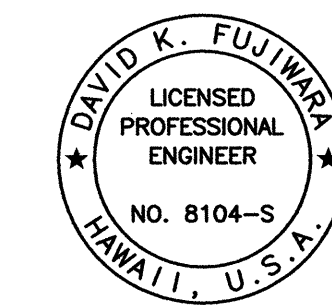

THIS WORK WAS PREPARED BY ME OR UNDER MY SUPERVISION.

Signature: David K. Fujiwara  
Expiration Date of License: 4-30-16

STATE OF HAWAII  
DEPARTMENT OF TRANSPORTATION  
HIGHWAYS DIVISION

**TYPICAL JPCP PANEL**  
**DETAILS AT TRANSFER STATION**


MIDDLE STREET PAVEMENT RECONSTRUCTION  
North King Street to Kamehameha Highway  
FAP NO. STP-7415(001)

Scale: As Noted Date: Jun. 20, 2014

SHEET No. S22 OF 10 SHEETS




| FED. ROAD DIST. NO. | STATE | FEDERAL AID PROJ. NO. | FISCAL YEAR | SHEET NO. | TOTAL SHEETS |
|---------------------|-------|-----------------------|-------------|-----------|--------------|
| HAWAII              | HAW.  | STP-7415(001)         | 2014        | 130       | 173          |

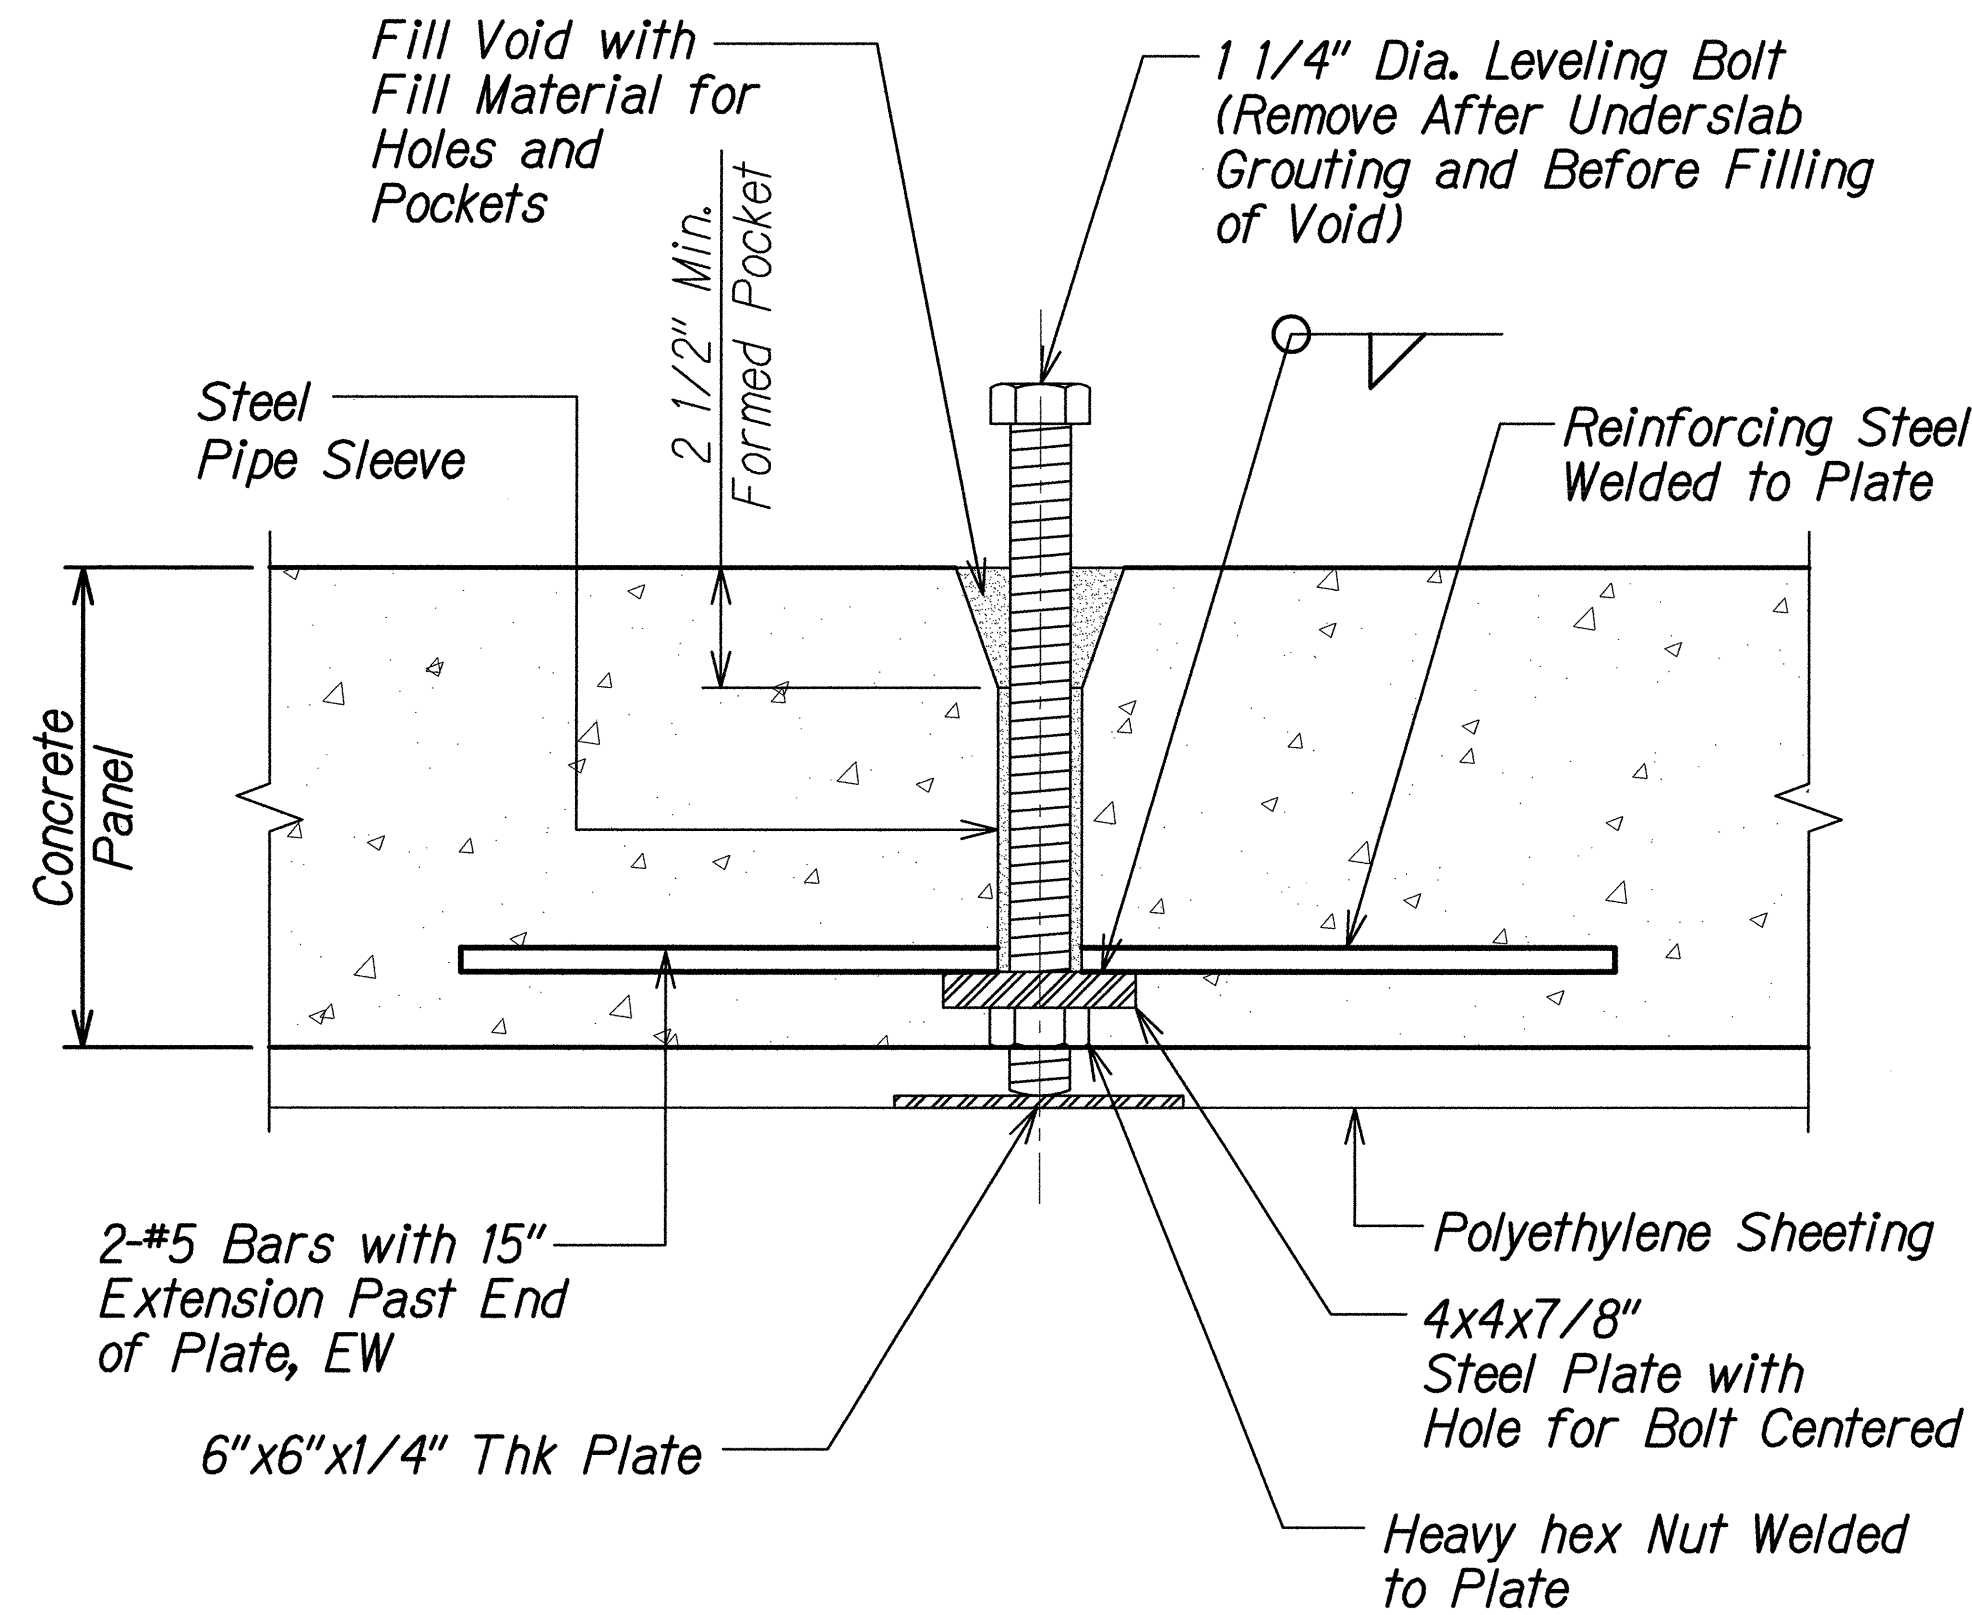

### LIFTING/LEVELING DEVICE DETAIL

Scale: 3" = 1'-0"

S3.2

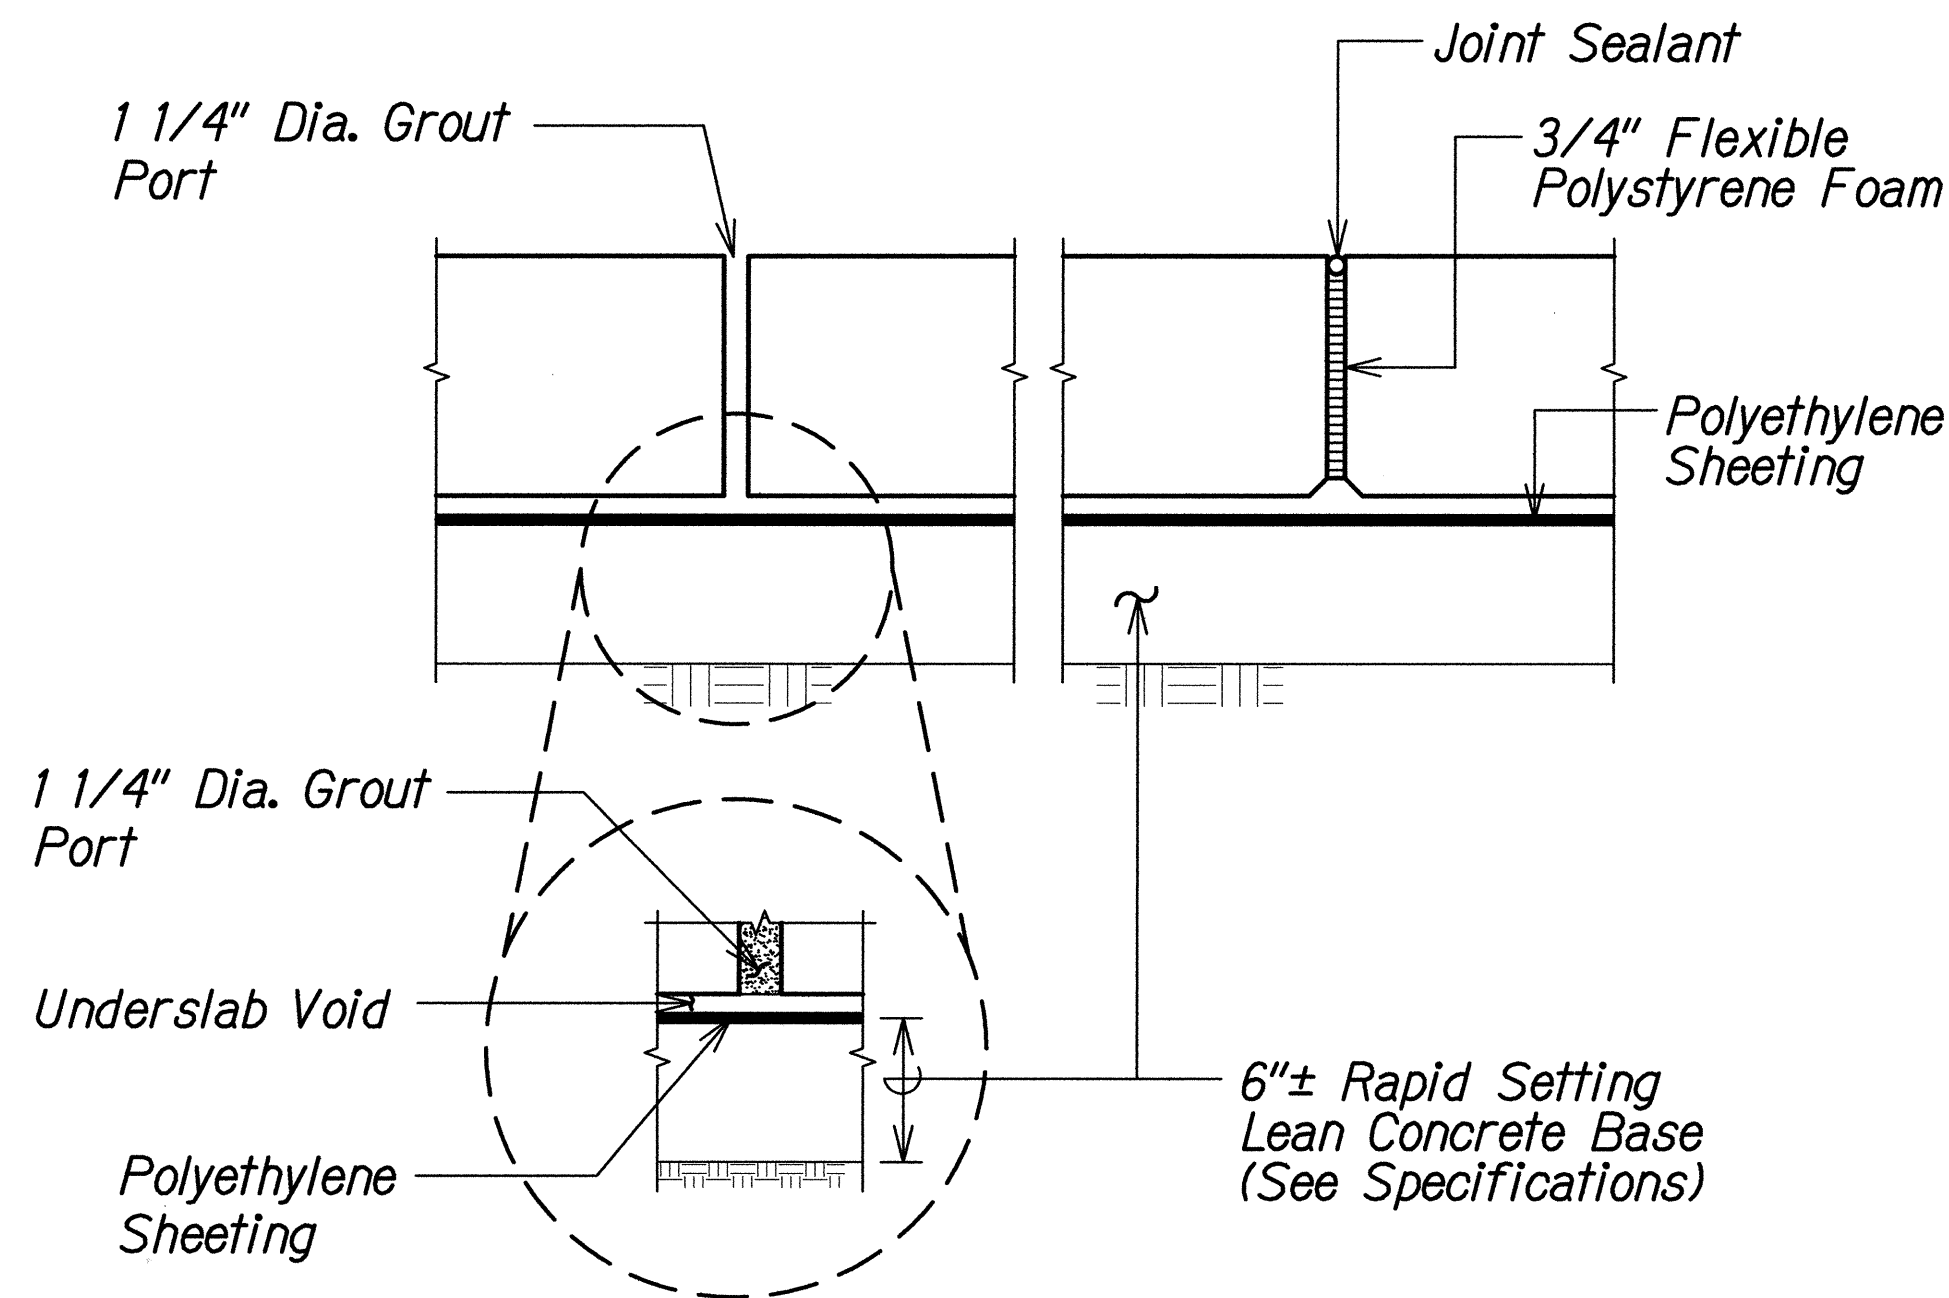


### GROUT PORT UNDERSLAB VOID, AND POLYETHYLENE SHEETING

Not to Scale

S3.3


**Note:**  
Structural Steel ASTM A36 and Reinforcing Steel ASTM A 615 Grade 60 to be Hot-Dip Galvanized ASTM A123.

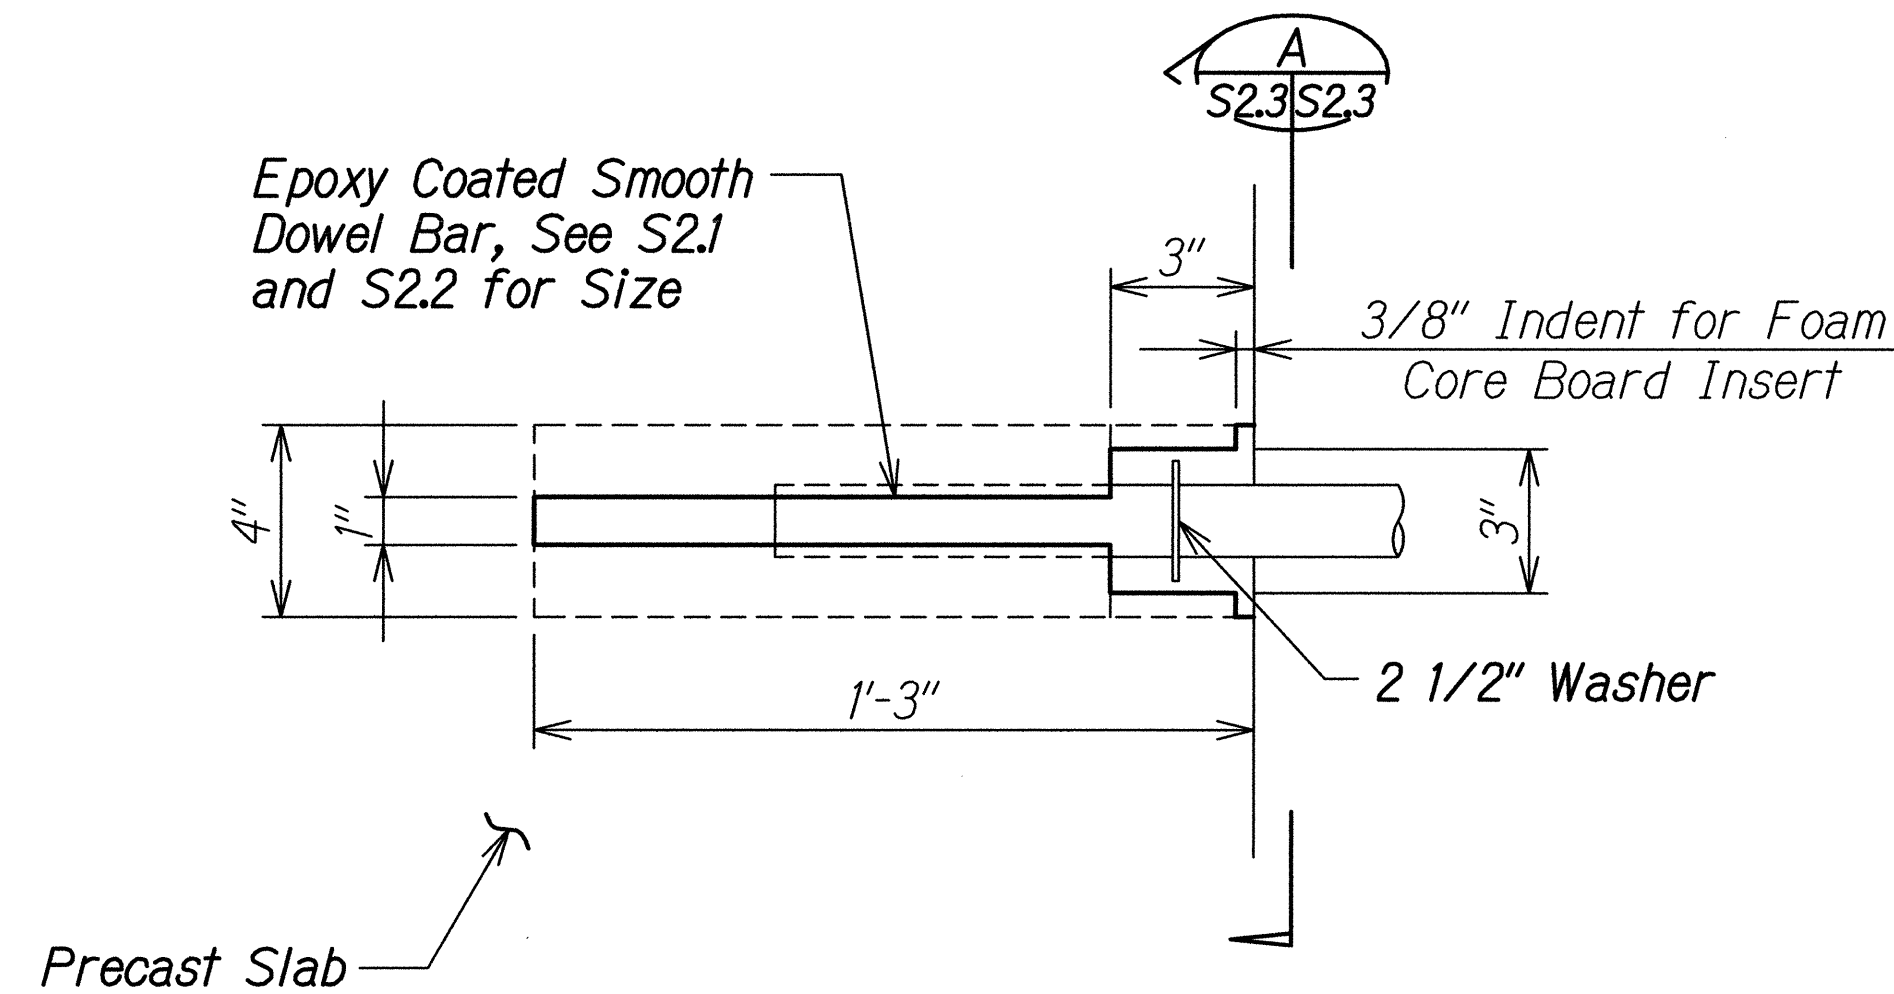

### PARTIAL PLAN LOAD TRANSFER DEVICE

Scale: 3" = 1'-0"

S2.3

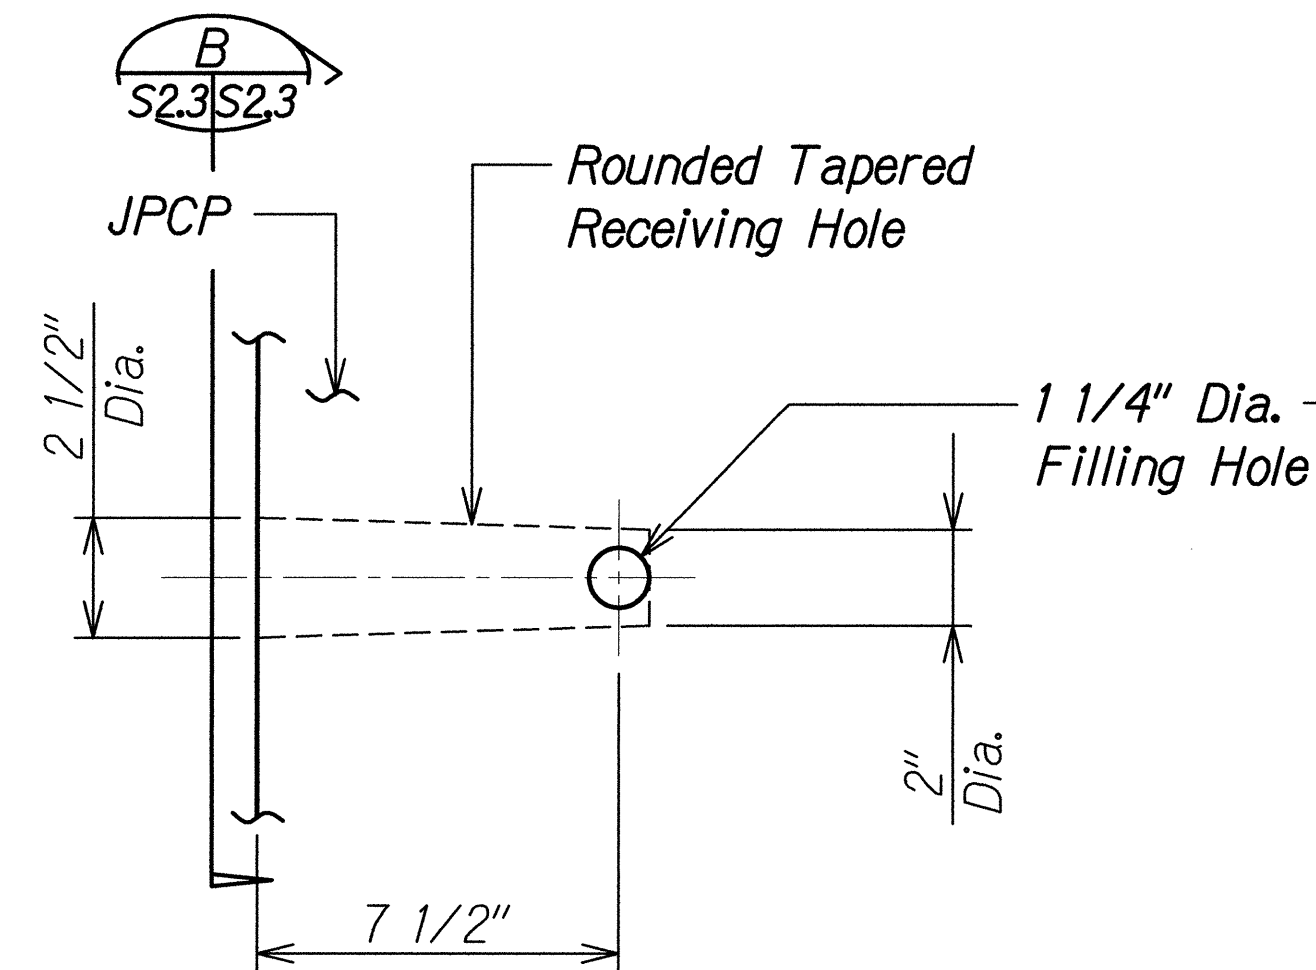


### PARTIAL PLAN

### RECEIVING END LOAD TRANSFER DEVICE

Scale: 3" = 1'-0"


S2.3

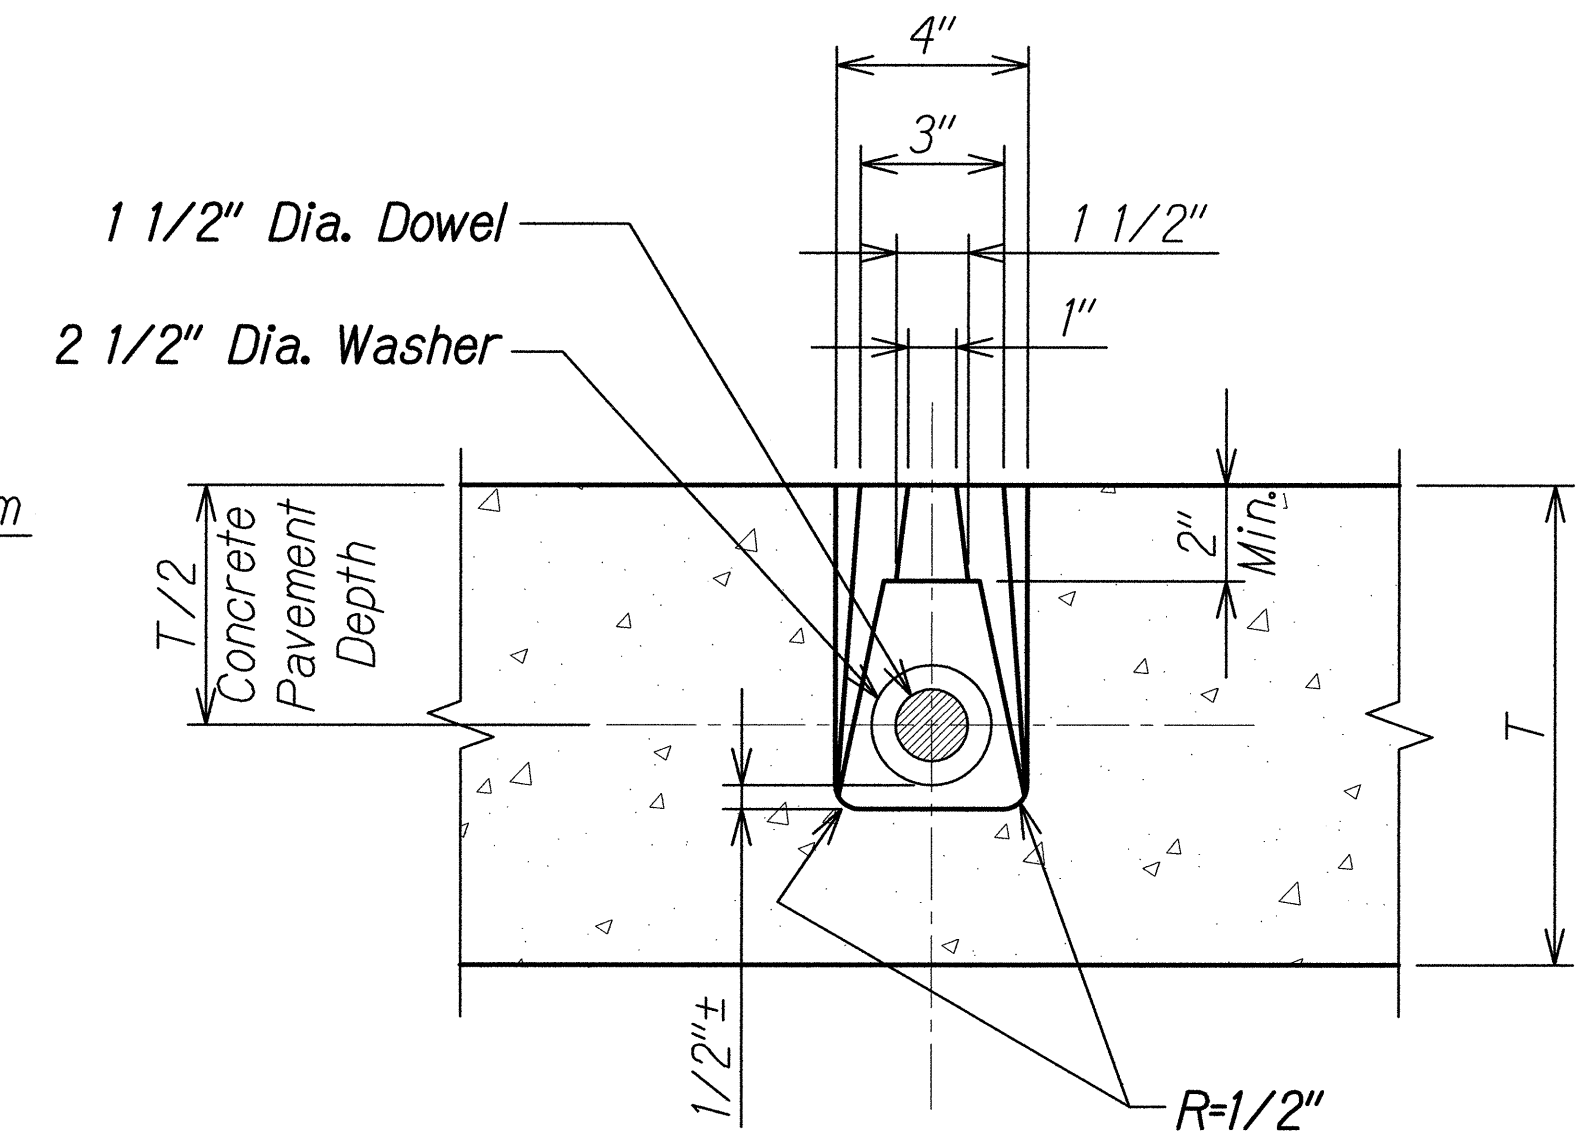

### SECTION


Scale: 3" = 1'-0"

S2.3

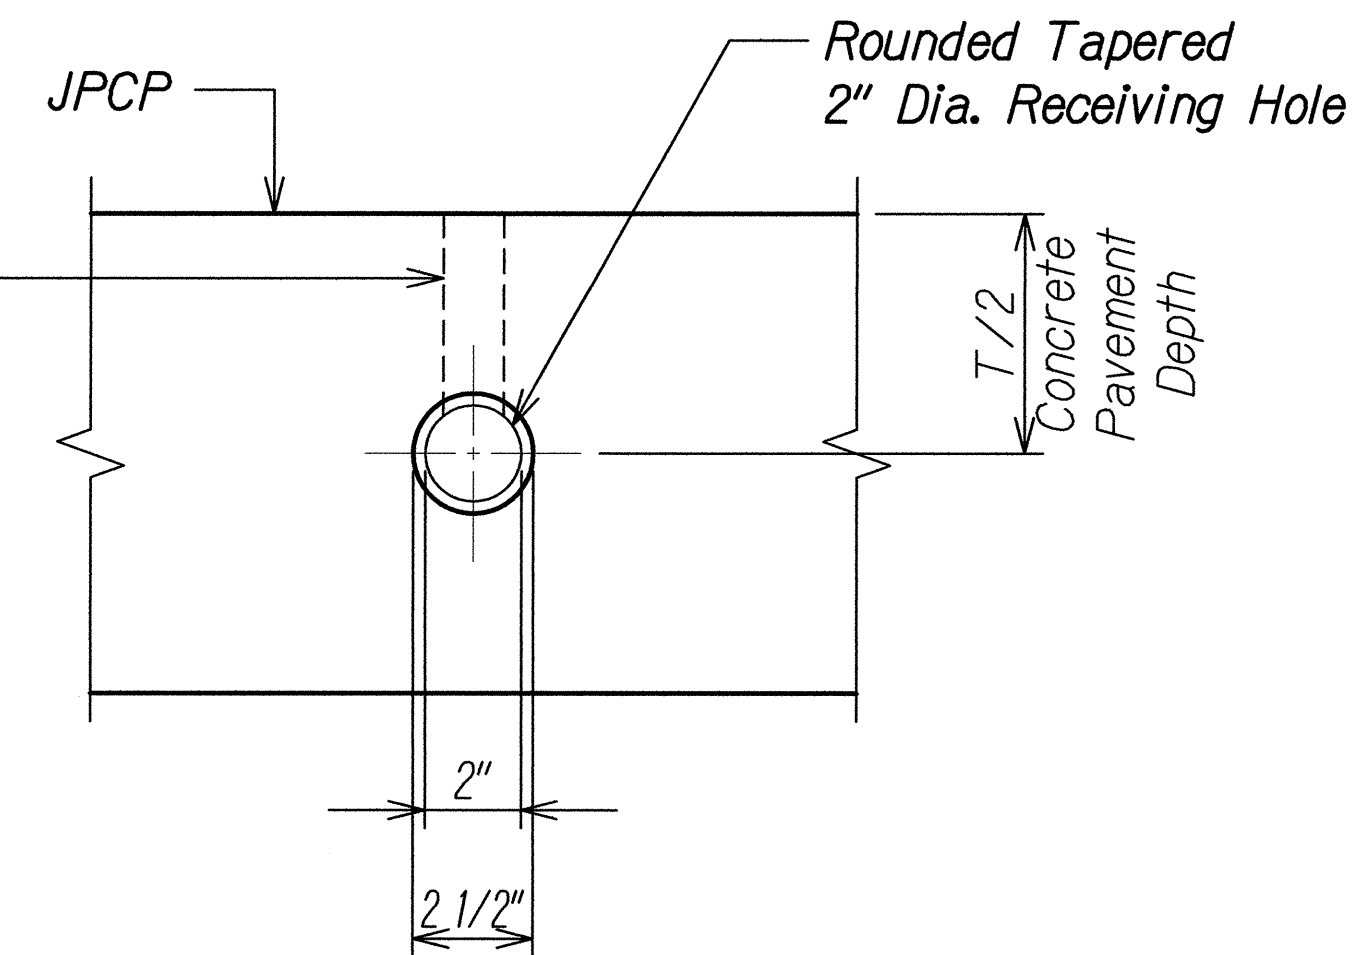

### PARITAL END VIEW

S2.3

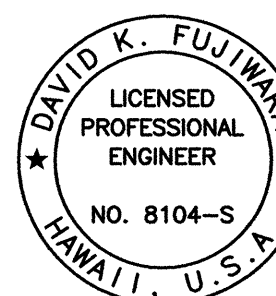

THIS WORK WAS PREPARED BY ME OR UNDER MY SUPERVISION.

Signature: David K. Fujiwara  
Date: 4-30-16  
Expiration Date of the License

STATE OF HAWAII  
DEPARTMENT OF TRANSPORTATION  
HIGHWAYS DIVISION

**TYPICAL LIFTING/LEVELING  
DEVICE DETAILS**


MIDDLE STREET PAVEMENT RECONSTRUCTION  
North King Street to Kamehameha Highway  
FAP NO. STP-7415(001)

Scale: As Noted Date: Jun. 20, 2014

SHEET No. S2.3 OF 10 SHEETS



| FED. ROAD DIST. NO. | STATE | FEDERAL AID PROJ. NO. | FISCAL YEAR | SHEET NO. | TOTAL SHEETS |
|---------------------|-------|-----------------------|-------------|-----------|--------------|
| HAWAII              | HAW.  | STP-7415(001)         | 2014        | 131       | 173          |

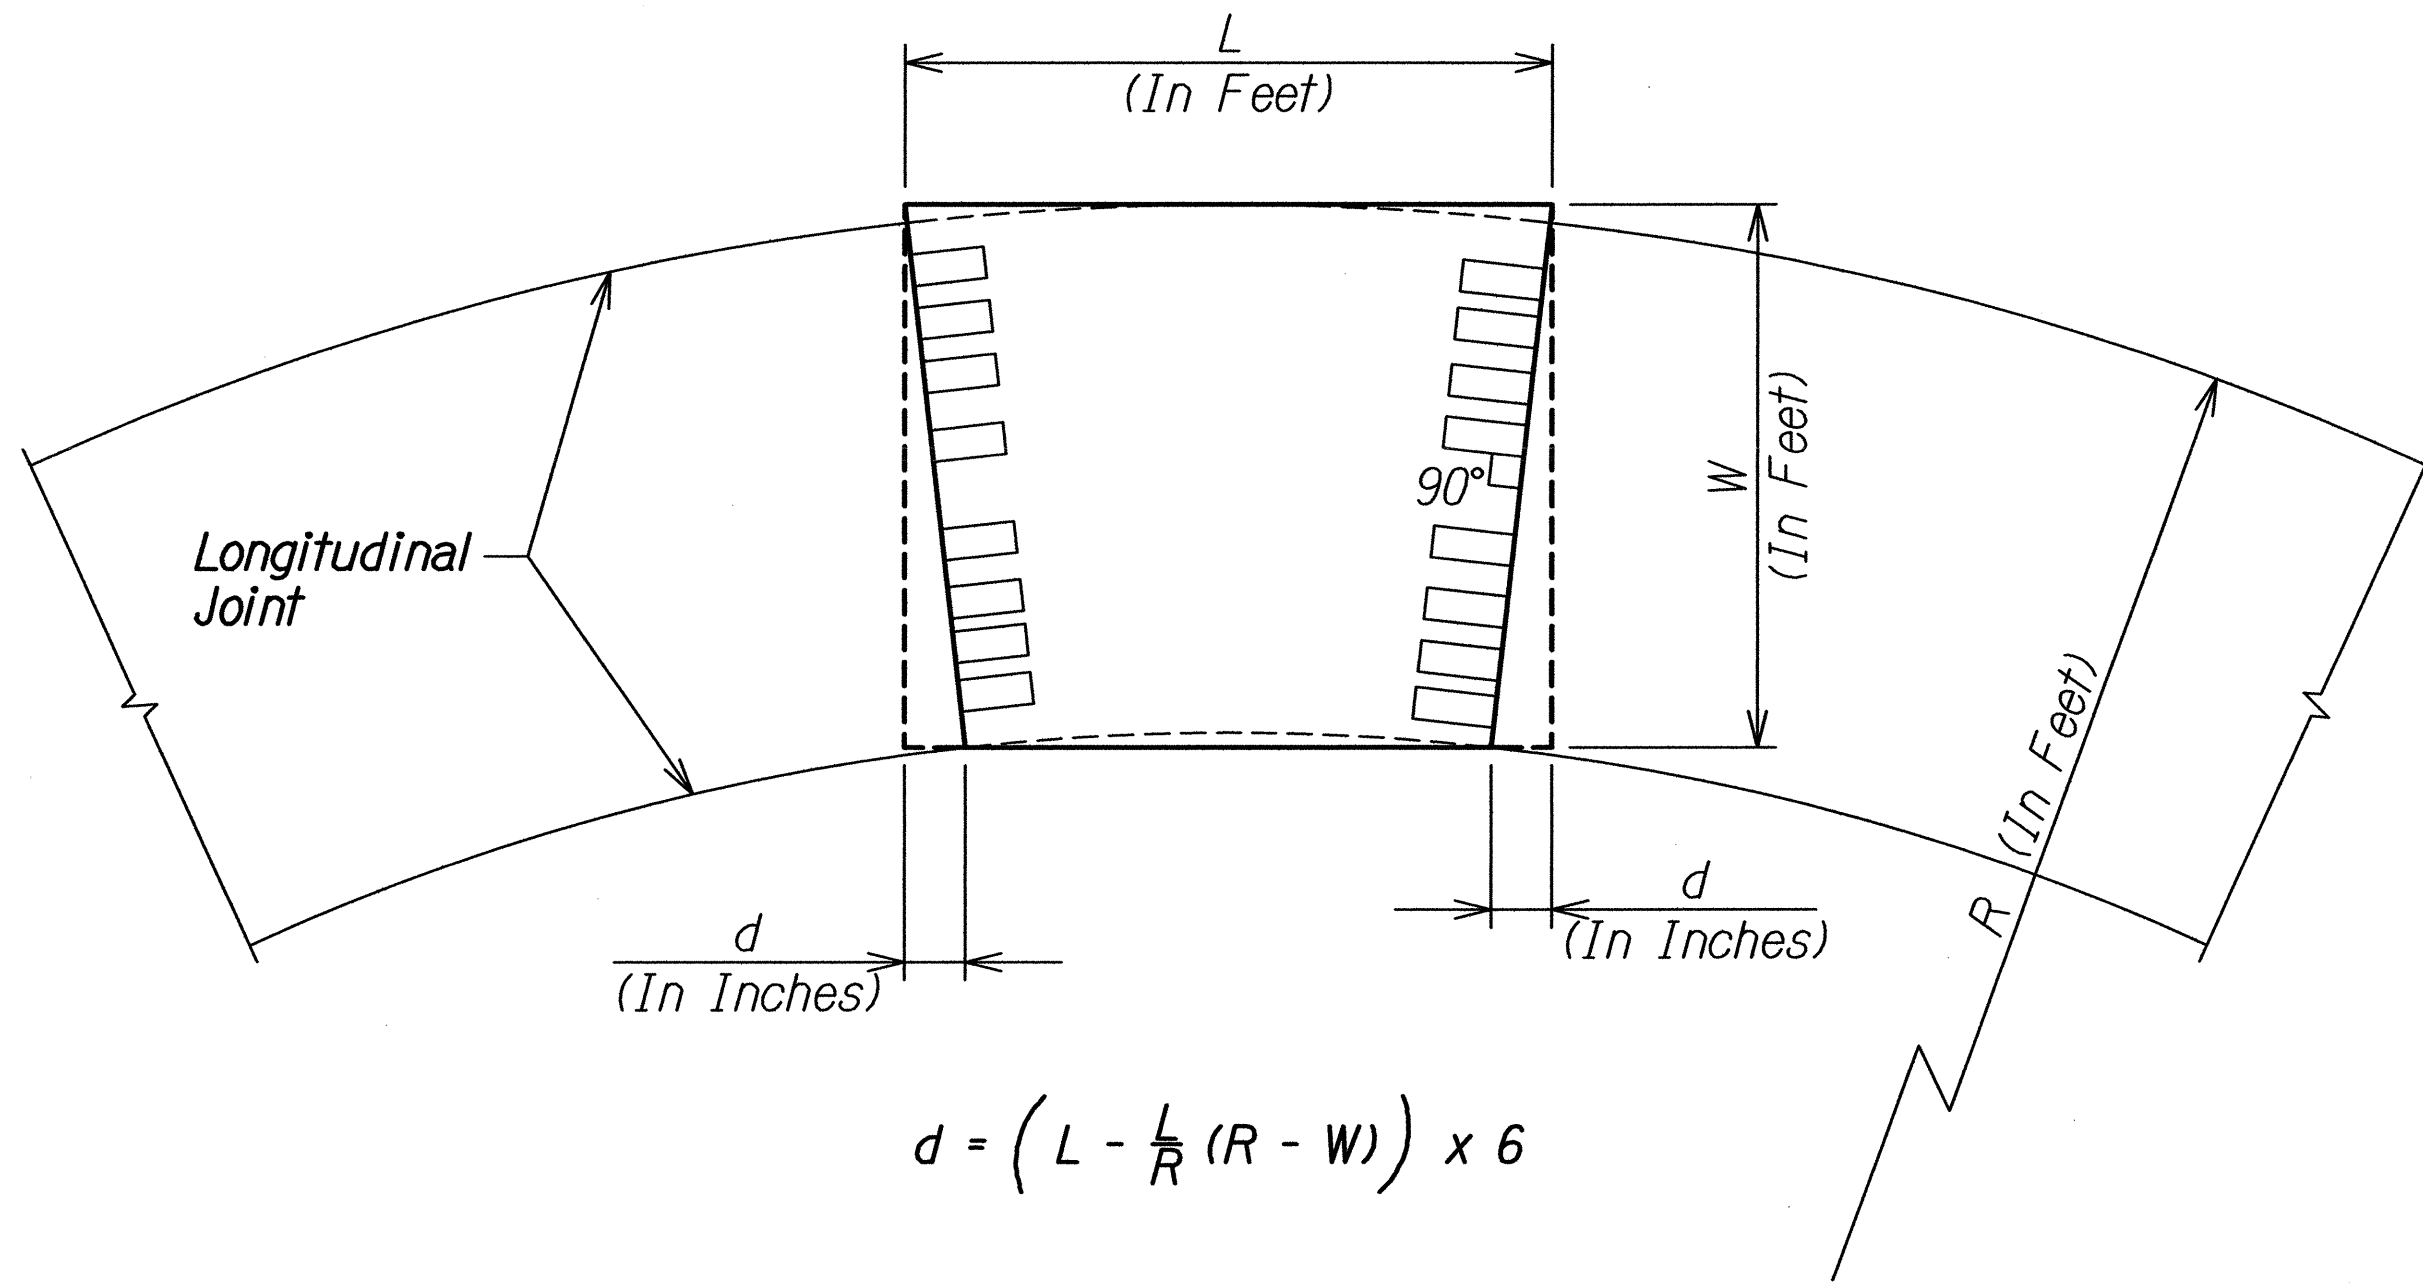


$$d = \left( L - \frac{1}{R} (R - W) \right) \times 6$$

PRECAST REPLACEMENT PANEL ON A CURVE

CURVE INSTALLATION

Not to Scale

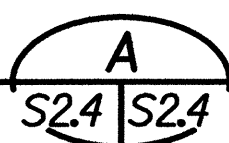

Legend:


- L Length of Panel at Curve Radius  
(Transverse Joint Spacing)
- W Width of Panel  
(Longitudinal Joint Spacing Measured Along Curve Radius)
- R Curve Radius
- d Offset Distance for Inside Length of Panel

Note:

See Special Provision Section 416.03(AX7) for submittal requirements of panel layout and fabrication.

|               |                   |      |
|---------------|-------------------|------|
| ORIGINAL PLAN | SURVEY PLOTTED BY | DATE |
| NOTE BOOK     | DESIGNED BY       |      |
| No.           | QUANTITIES BY     |      |
|               | CHECKED BY        |      |

DRAWING NAME: 2100\_OINGONG\12-0331-HFL MIDDLE STREET RECONSTRUCTION-DOT\A CAD\06-19-14 BD\HFL-MS203 - MS204.DWG PLOT TIME: 06-18-14, 7:15 PM

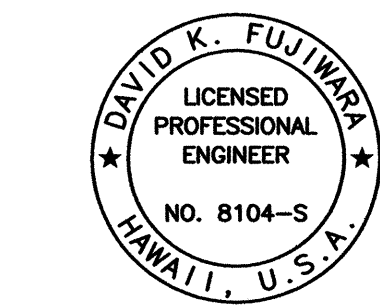

THIS WORK WAS PREPARED BY  
ME OR UNDER MY SUPERVISION.

Signature: David K. Fujiwara  
EXPIRATION DATE OF THE LICENSE: 4-30-16

STATE OF HAWAII  
DEPARTMENT OF TRANSPORTATION  
HIGHWAYS DIVISION

**PRECAST PANEL INSTALLATION**  
**ON A CURVE**


MIDDLE STREET PAVEMENT RECONSTRUCTION  
North King Street to Kamehameha Highway  
FAP NO. STP-7415(001)

Scale: As Noted Date: Jun. 20, 2014

SHEET No. S24 OF 10 SHEETS




| FED. ROAD DIST. NO. | STATE | FEDERAL AID PROJ. NO. | FISCAL YEAR | SHEET NO. | TOTAL SHEETS |
|---------------------|-------|-----------------------|-------------|-----------|--------------|
| HAWAII              | HAW.  | STP-7415(001)         | 2014        | 132       | 173          |

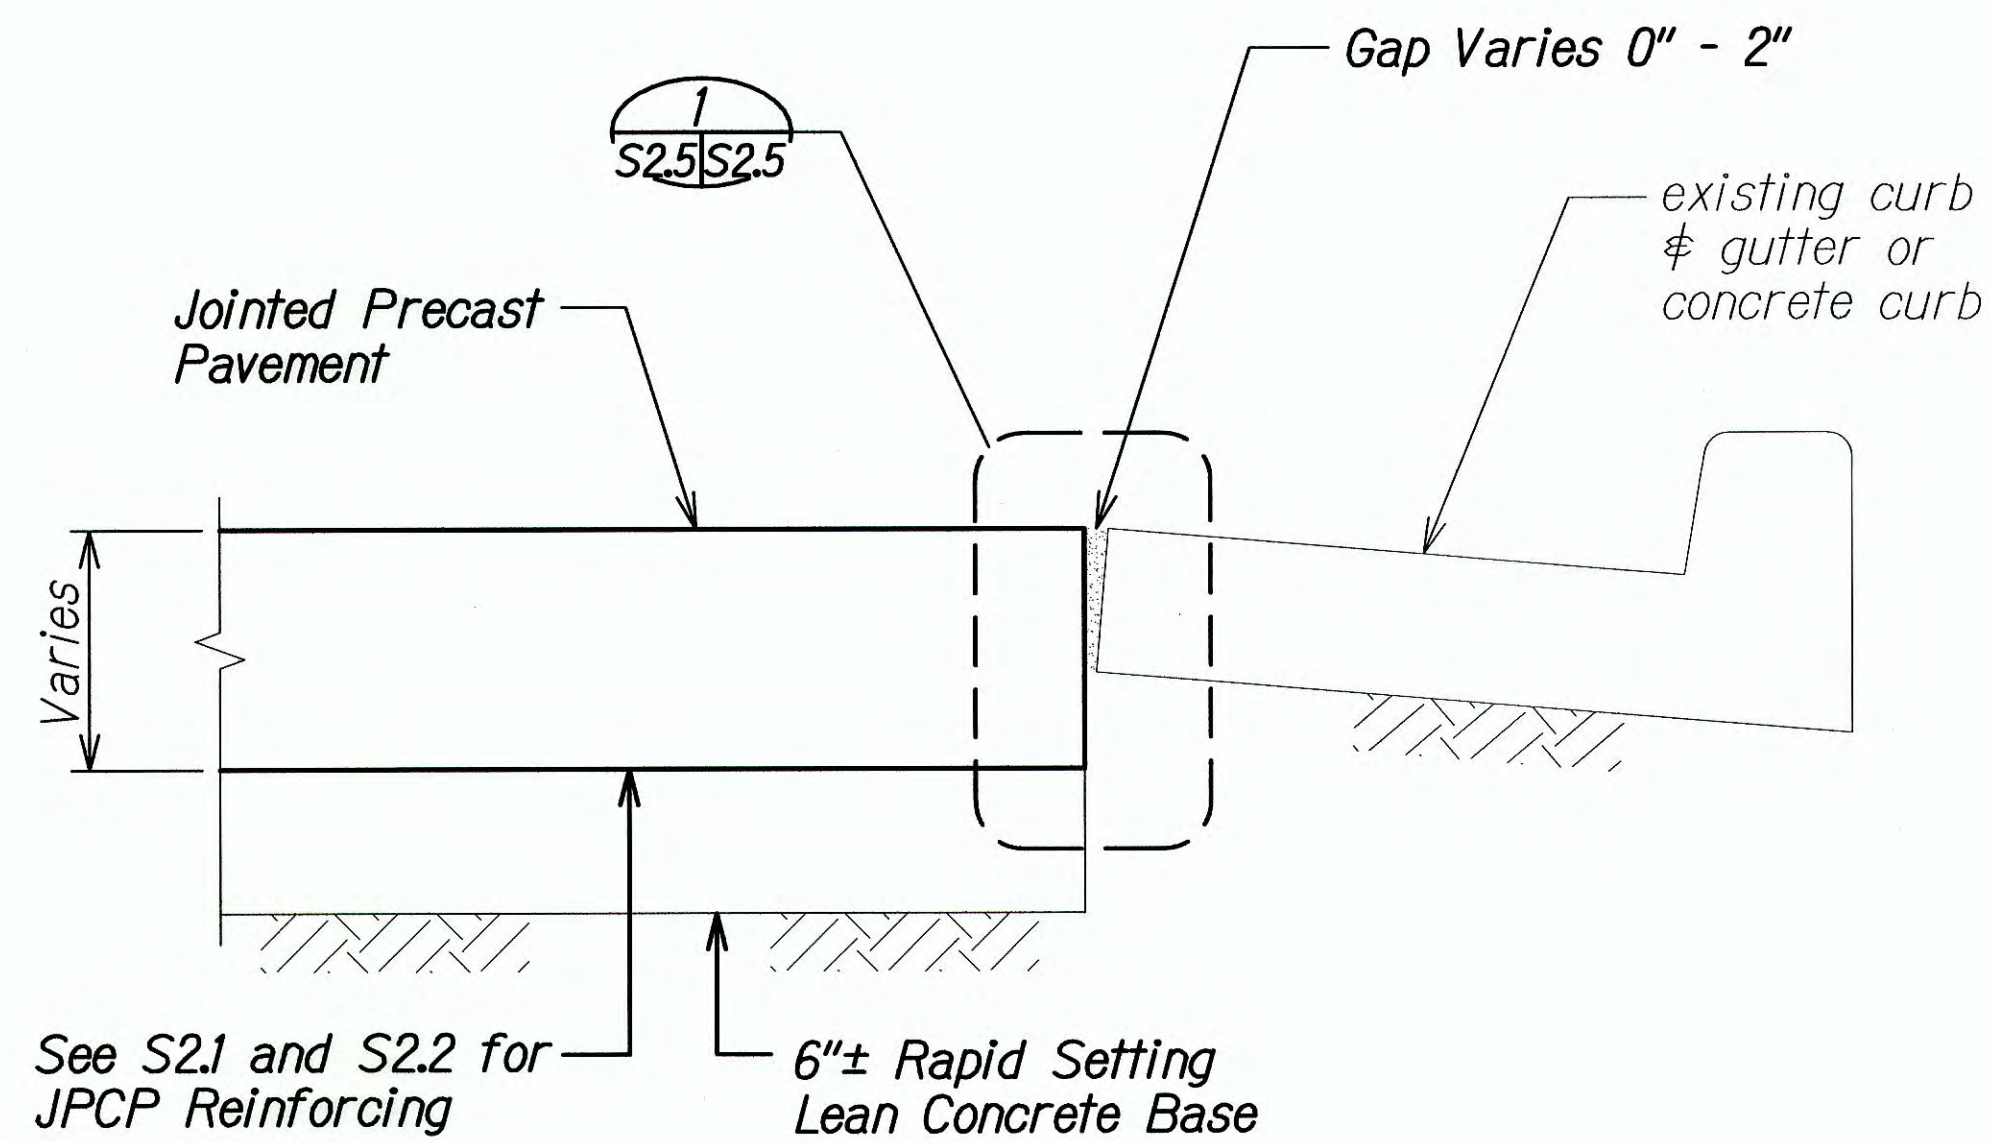


**JPCP AT EXISTING GUTTER SECTION**  
Scale: 1 1/2" = 1'-0"

A  
S2.8 S2.5  
S2.10

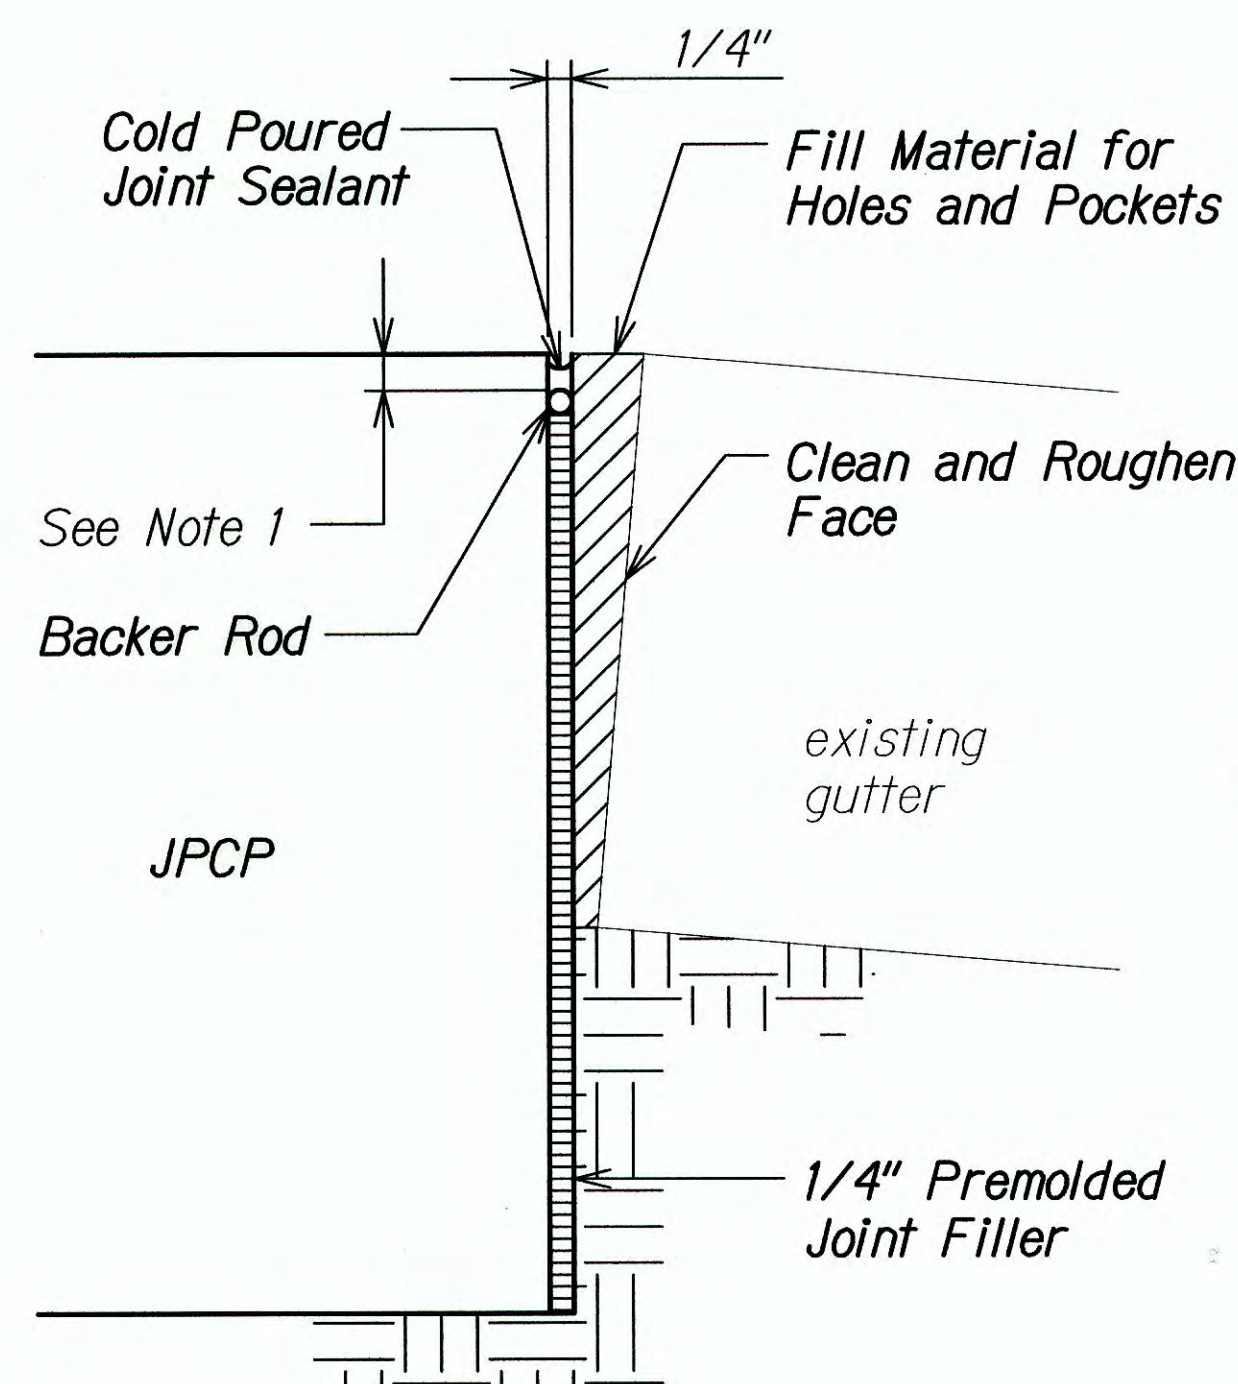

**JPCP JOINT DETAIL AT GUTTER**  
Not to Scale

1  
S2.5 S2.5

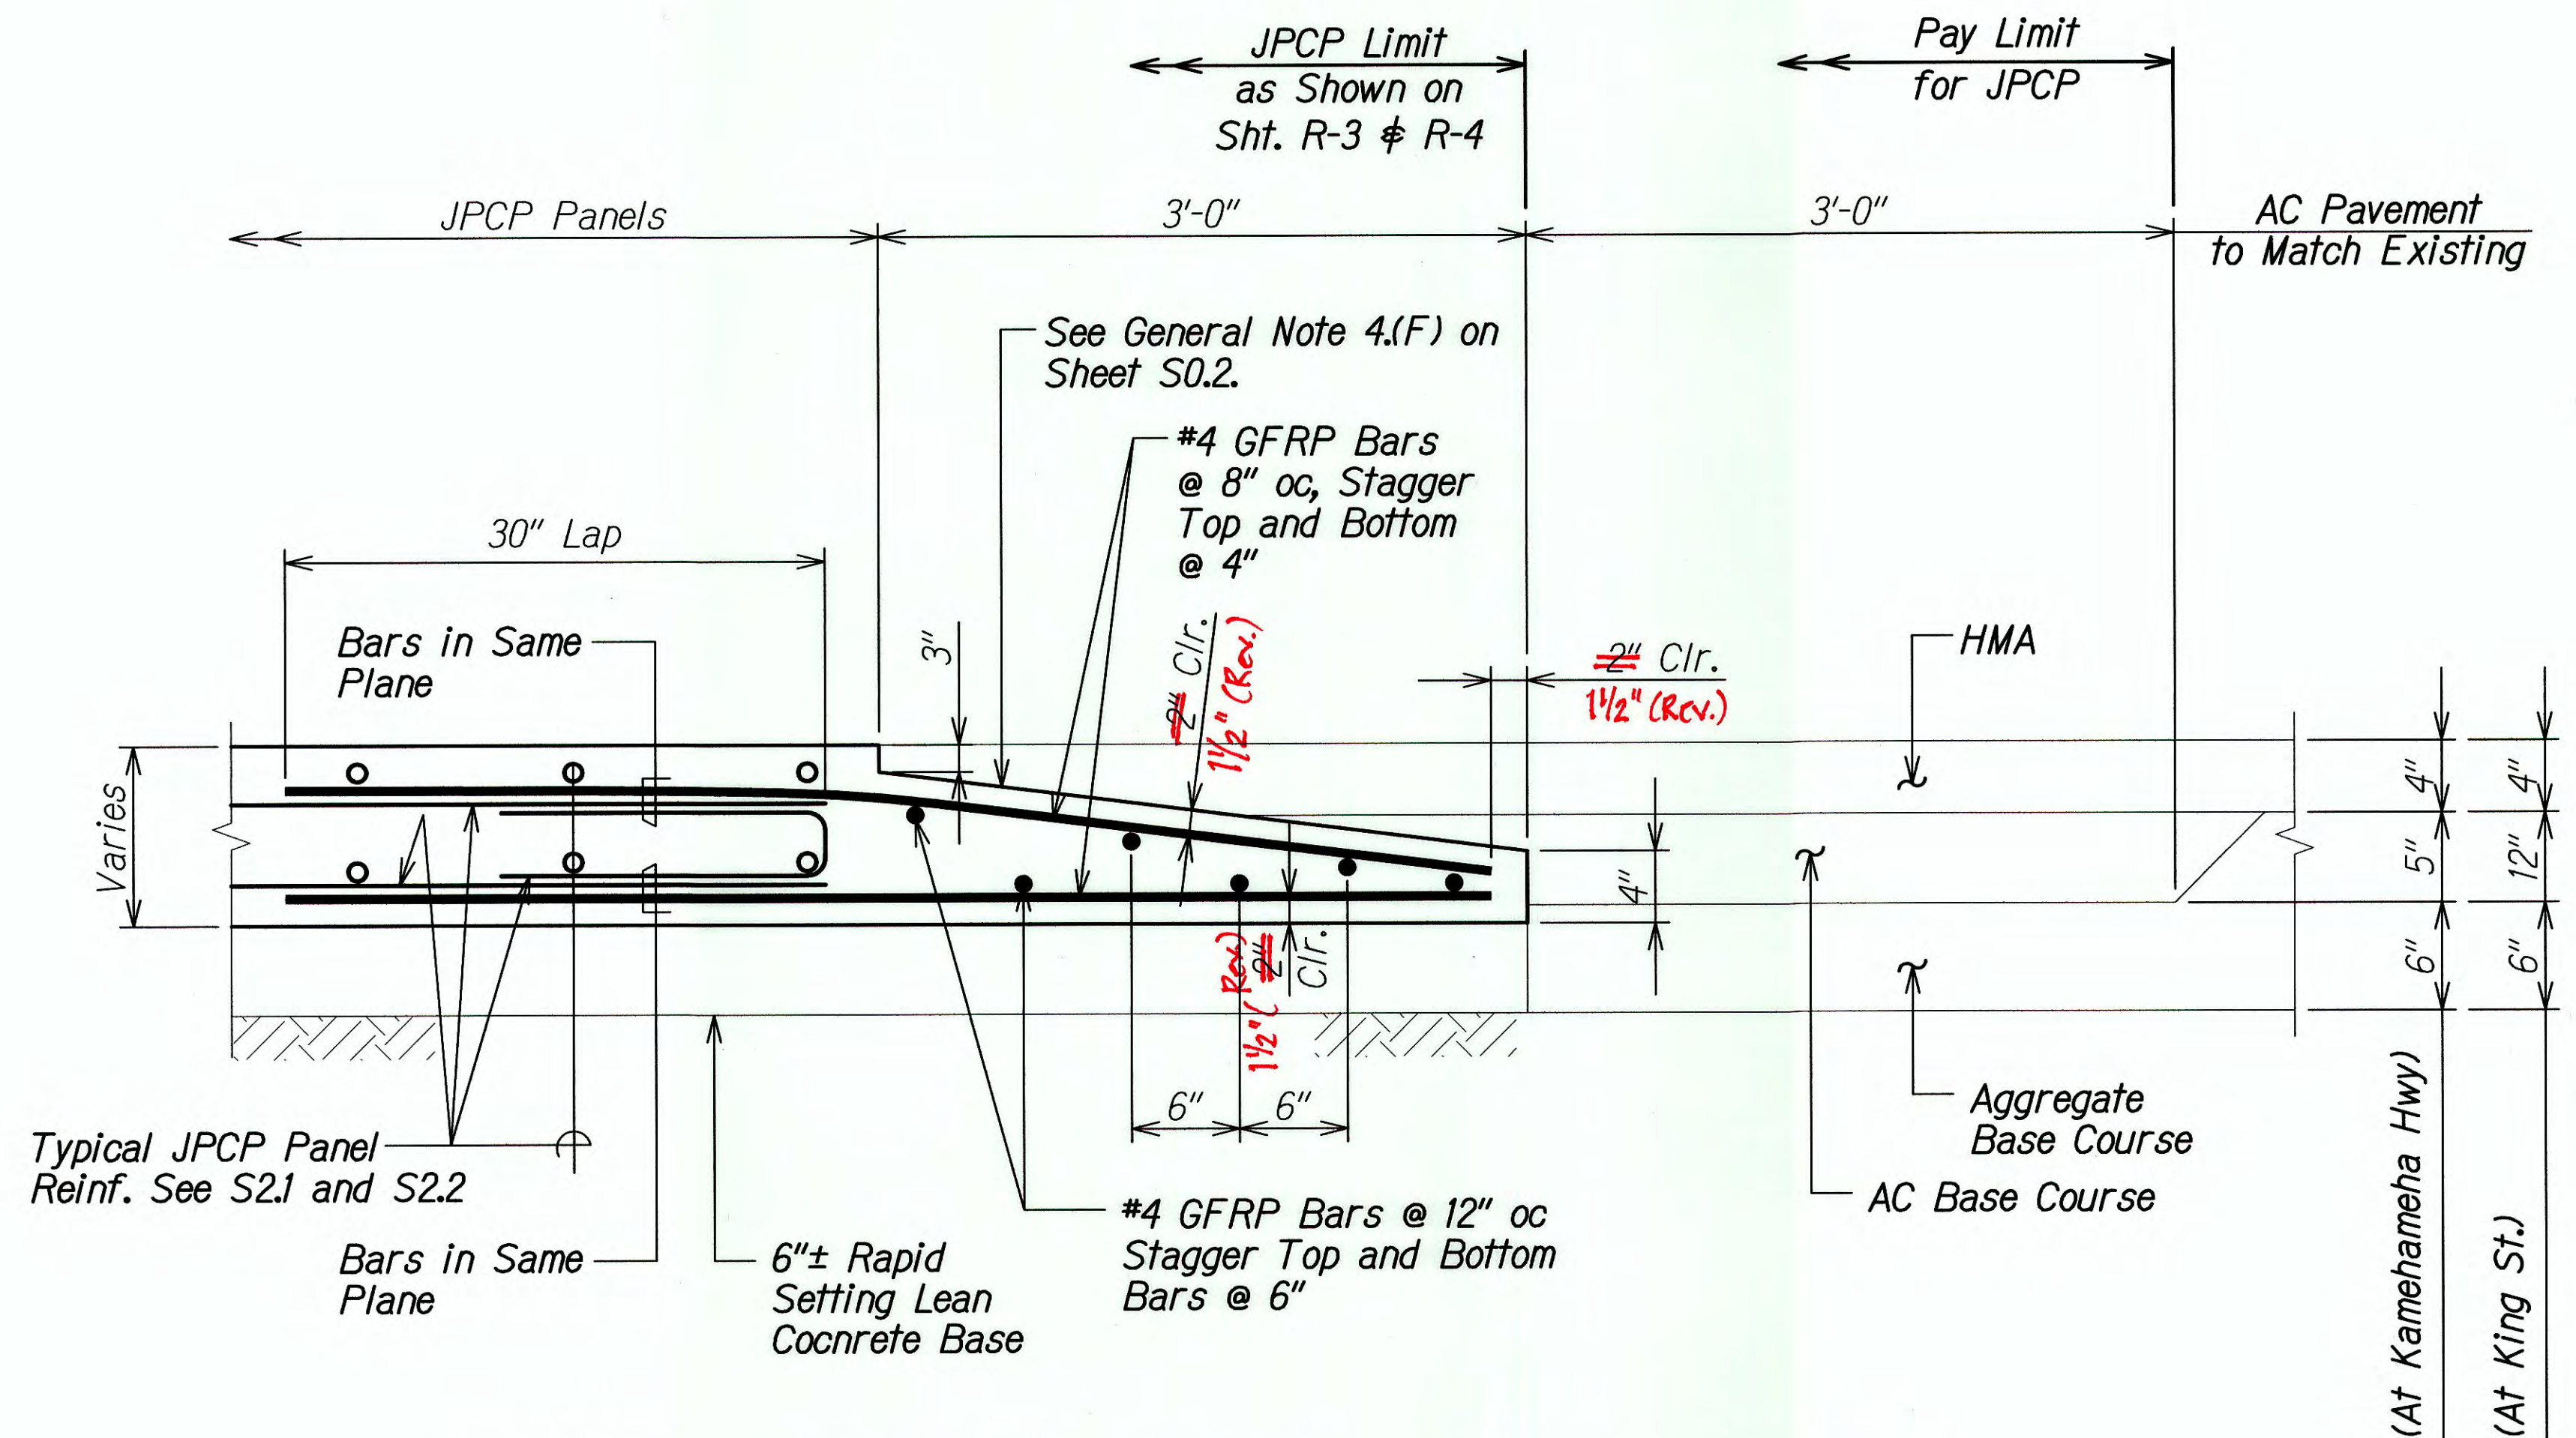

**JPCP TRANSITION PANEL AT EXISTING AC**  
Scale: 1 1/2" = 1'-0"

B  
S2.5 S2.5

- Note:**
1. Follow Sealant Manufacturer's recommendation for recess from top of pavement and sealant depth for actual joint width.

|                   |      |
|-------------------|------|
| SURVEY PLOTTED BY | DATE |
| DRAWN BY          |      |
| TRACED BY         |      |
| NOTED BY          |      |
| CHECKED BY        |      |
| NO.               |      |

DRAWING NAME: Z:\00 ONGOING\12-033.1-HEL MIDDLE STREET RECONSTRUCTION-DOTH\CAD\08-19-14 BID\HEL-MS205.DWG PLOT TIME: 08-18-14 7:18 PM



THIS WORK WAS PREPARED BY ME OR UNDER MY SUPERVISION.  
Signature: David K. Fujiwara  
EXPIRATION DATE OF THE LICENSE: 4-30-16

STATE OF HAWAII  
DEPARTMENT OF TRANSPORTATION  
HIGHWAYS DIVISION

**JPCP AT EXISTING PAVEMENT SECTIONS**

MIDDLE STREET PAVEMENT RECONSTRUCTION  
North King Street to Kamehameha Highway  
FAP NO. STP-7415(001)


Scale: As Noted Date: Jun. 20, 2014

SHEET No. S2.5 OF 10 SHEETS


"AS-BUILT"



| FED. ROAD DIST. NO. | STATE | FEDERAL AID PROJ. NO. | FISCAL YEAR | SHEET NO. | TOTAL SHEETS |
|---------------------|-------|-----------------------|-------------|-----------|--------------|
| HAWAII              | HAW.  | STP-7415(001)         | 2014        | 133       | 173          |

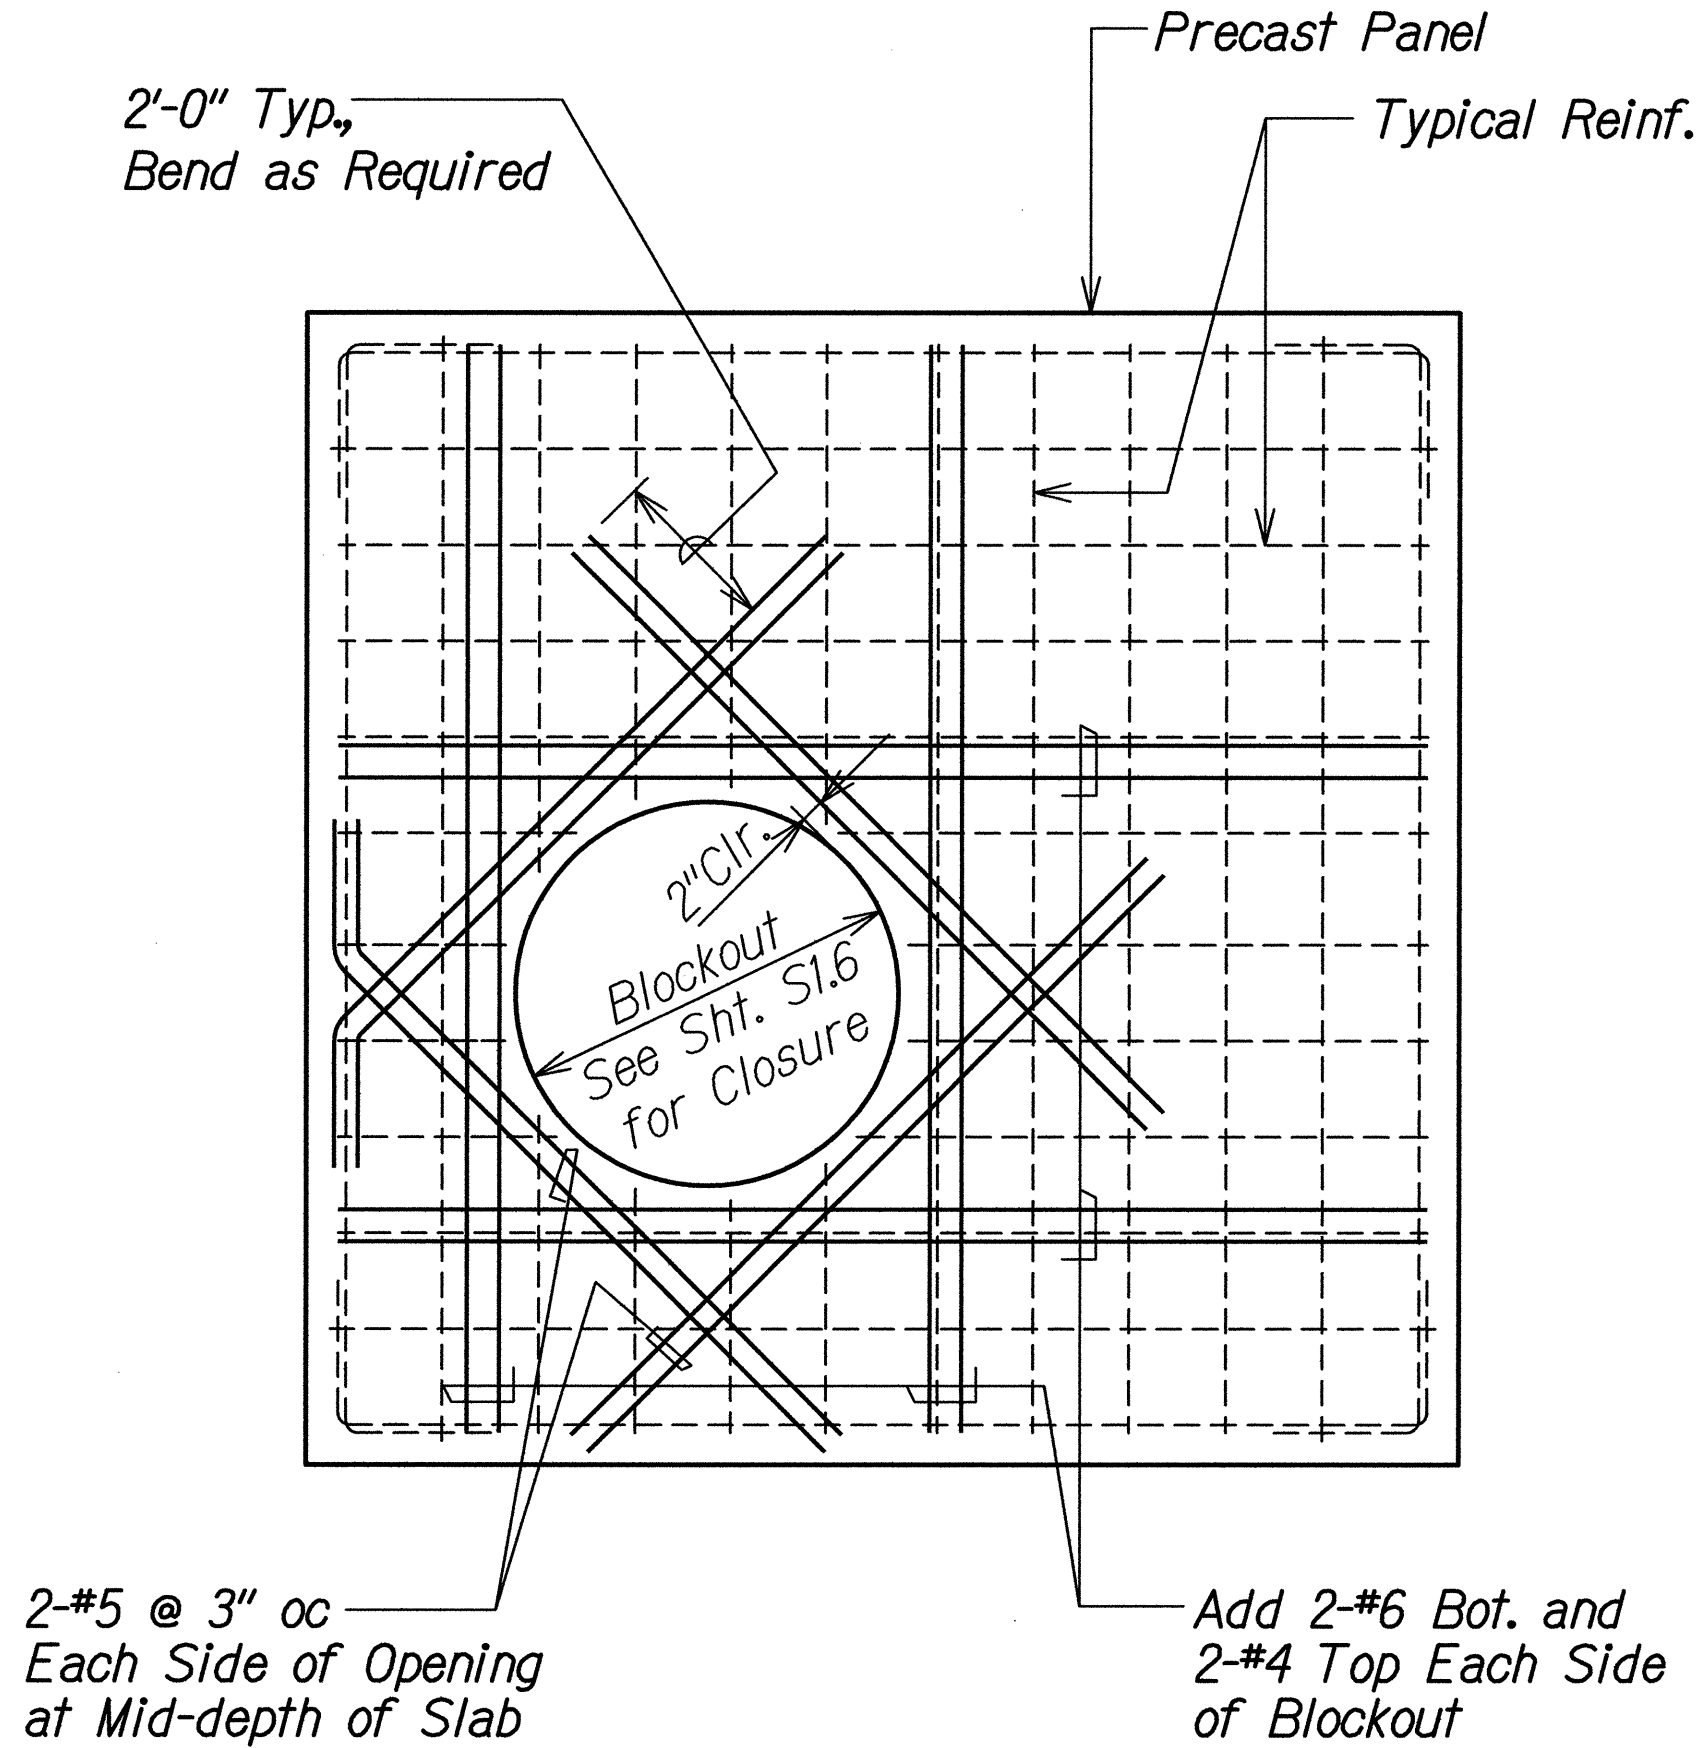

CIRCULAR BLOCKOUT A  
 Scale: 1/2" = 1'-0" S2.6 S2.6

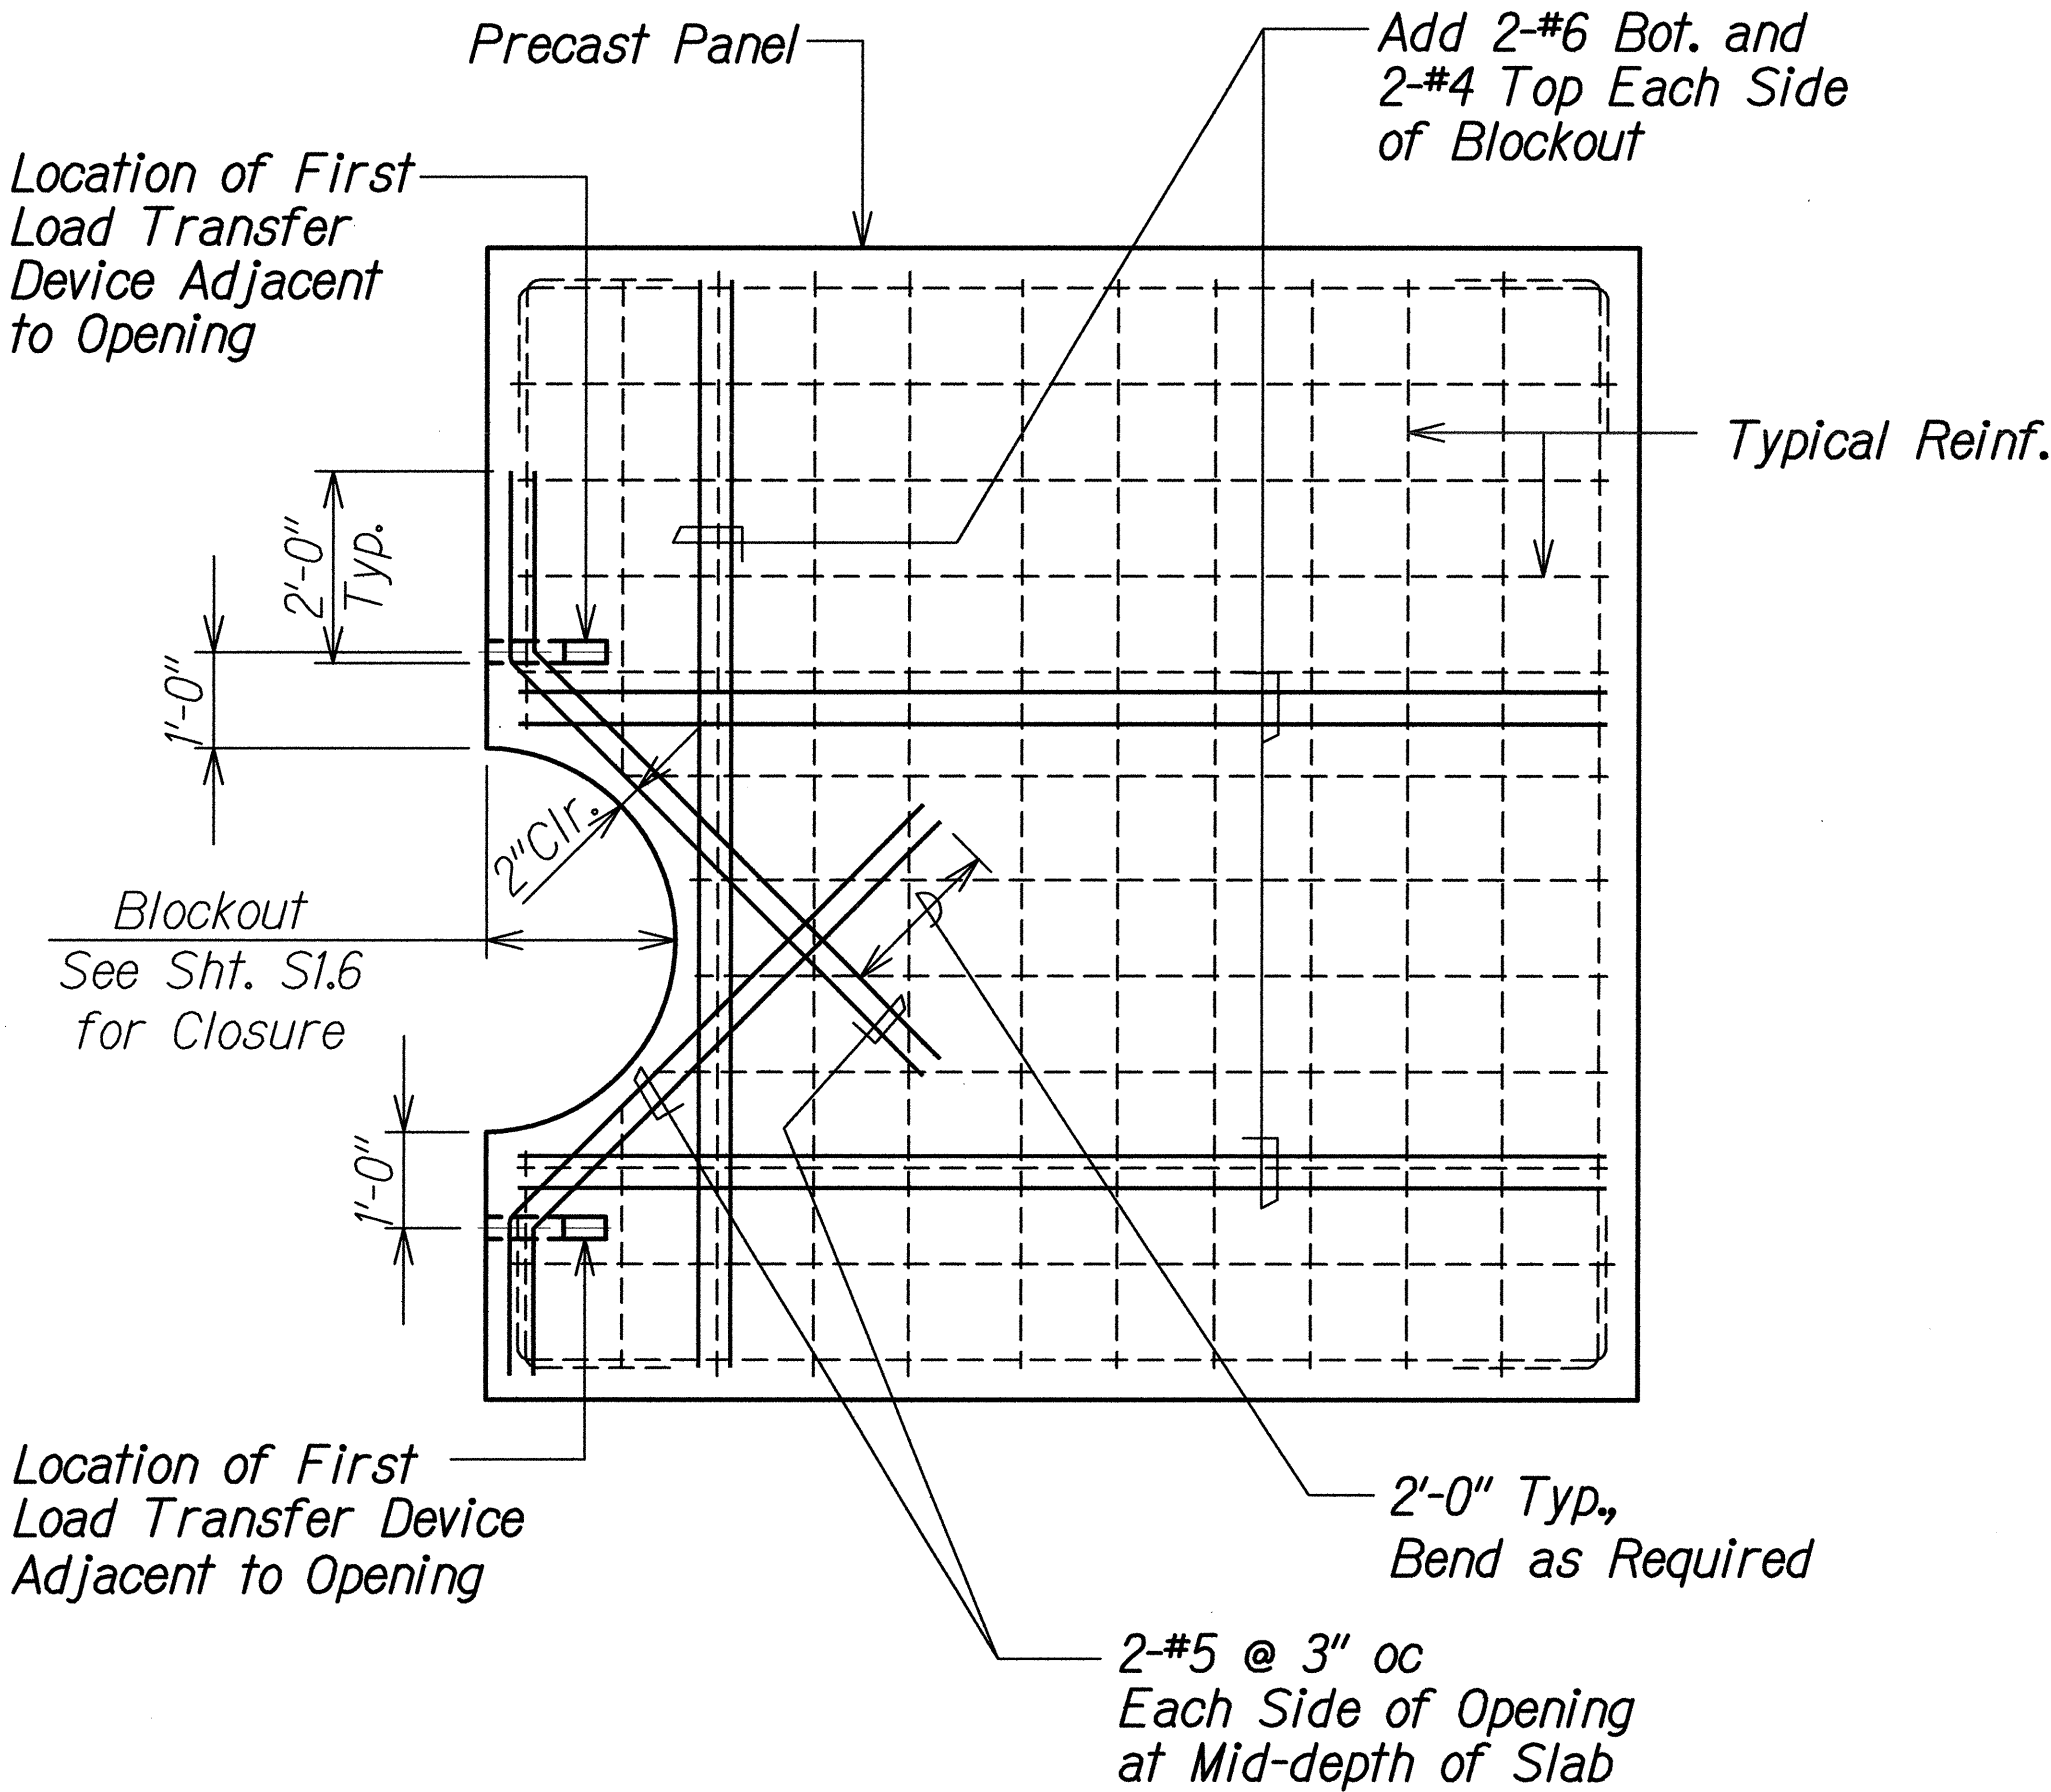


CIRCULAR BLOCKOUT AT JOINT B  
 Scale: 1/2" = 1'-0" S2.6 S2.6

- Notes:
1. Typical load transfer devices not shown for clarity. See S2.1 and S2.2 for location and spacing.
  2. All JCPG panels with blocks shall also be reinforced with fiber. See General Notes 4.(F) on sheet S0.2.

|               |      |
|---------------|------|
| DESIGNED BY   | DATE |
| TRACED BY     |      |
| DESIGNED BY   |      |
| QUANTITIES BY |      |
| CHECKED BY    |      |
| ORIGINAL PLAN |      |
| NOTE BOOK     |      |
| No.           |      |

DRAWING NAME: 2100 ONCONC12-0331-HFL MIDDLE STREET RECONSTRUCTION-DOTD(CAD)06-19-14 BID VFL-MS206.DWG PLOT TIME: 06-19-14, 9:55 AM

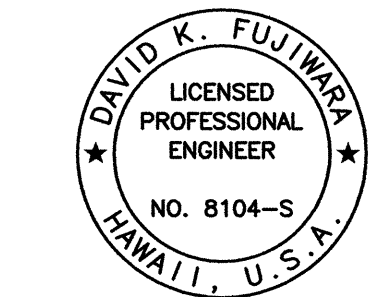


THIS WORK WAS PREPARED BY  
 ME OR UNDER MY SUPERVISION.  
*David K. Fujiwara*  
 SIGNATURE 4-30-16  
 EXPIRATION DATE OF THE LICENSE

STATE OF HAWAII  
DEPARTMENT OF TRANSPORTATION  
HIGHWAYS DIVISION  
**CIRCULAR BLOCKOUT**  
**DETAILS**  
MIDDLE STREET PAVEMENT RECONSTRUCTION  
North King Street to Kamehameha Highway  
FAP NO. STP-7415(001)  
Scale: As Noted Date: Jun. 20, 2014  
SHEET No. S26 OF 10 SHEETS

133



| FED. ROAD DIST. NO. | STATE | FEDERAL AID PROJ. NO. | FISCAL YEAR | SHEET NO. | TOTAL SHEETS |
|---------------------|-------|-----------------------|-------------|-----------|--------------|
| HAWAII              | HAW.  | STP-7415(001)         | 2014        | 134       | 173          |

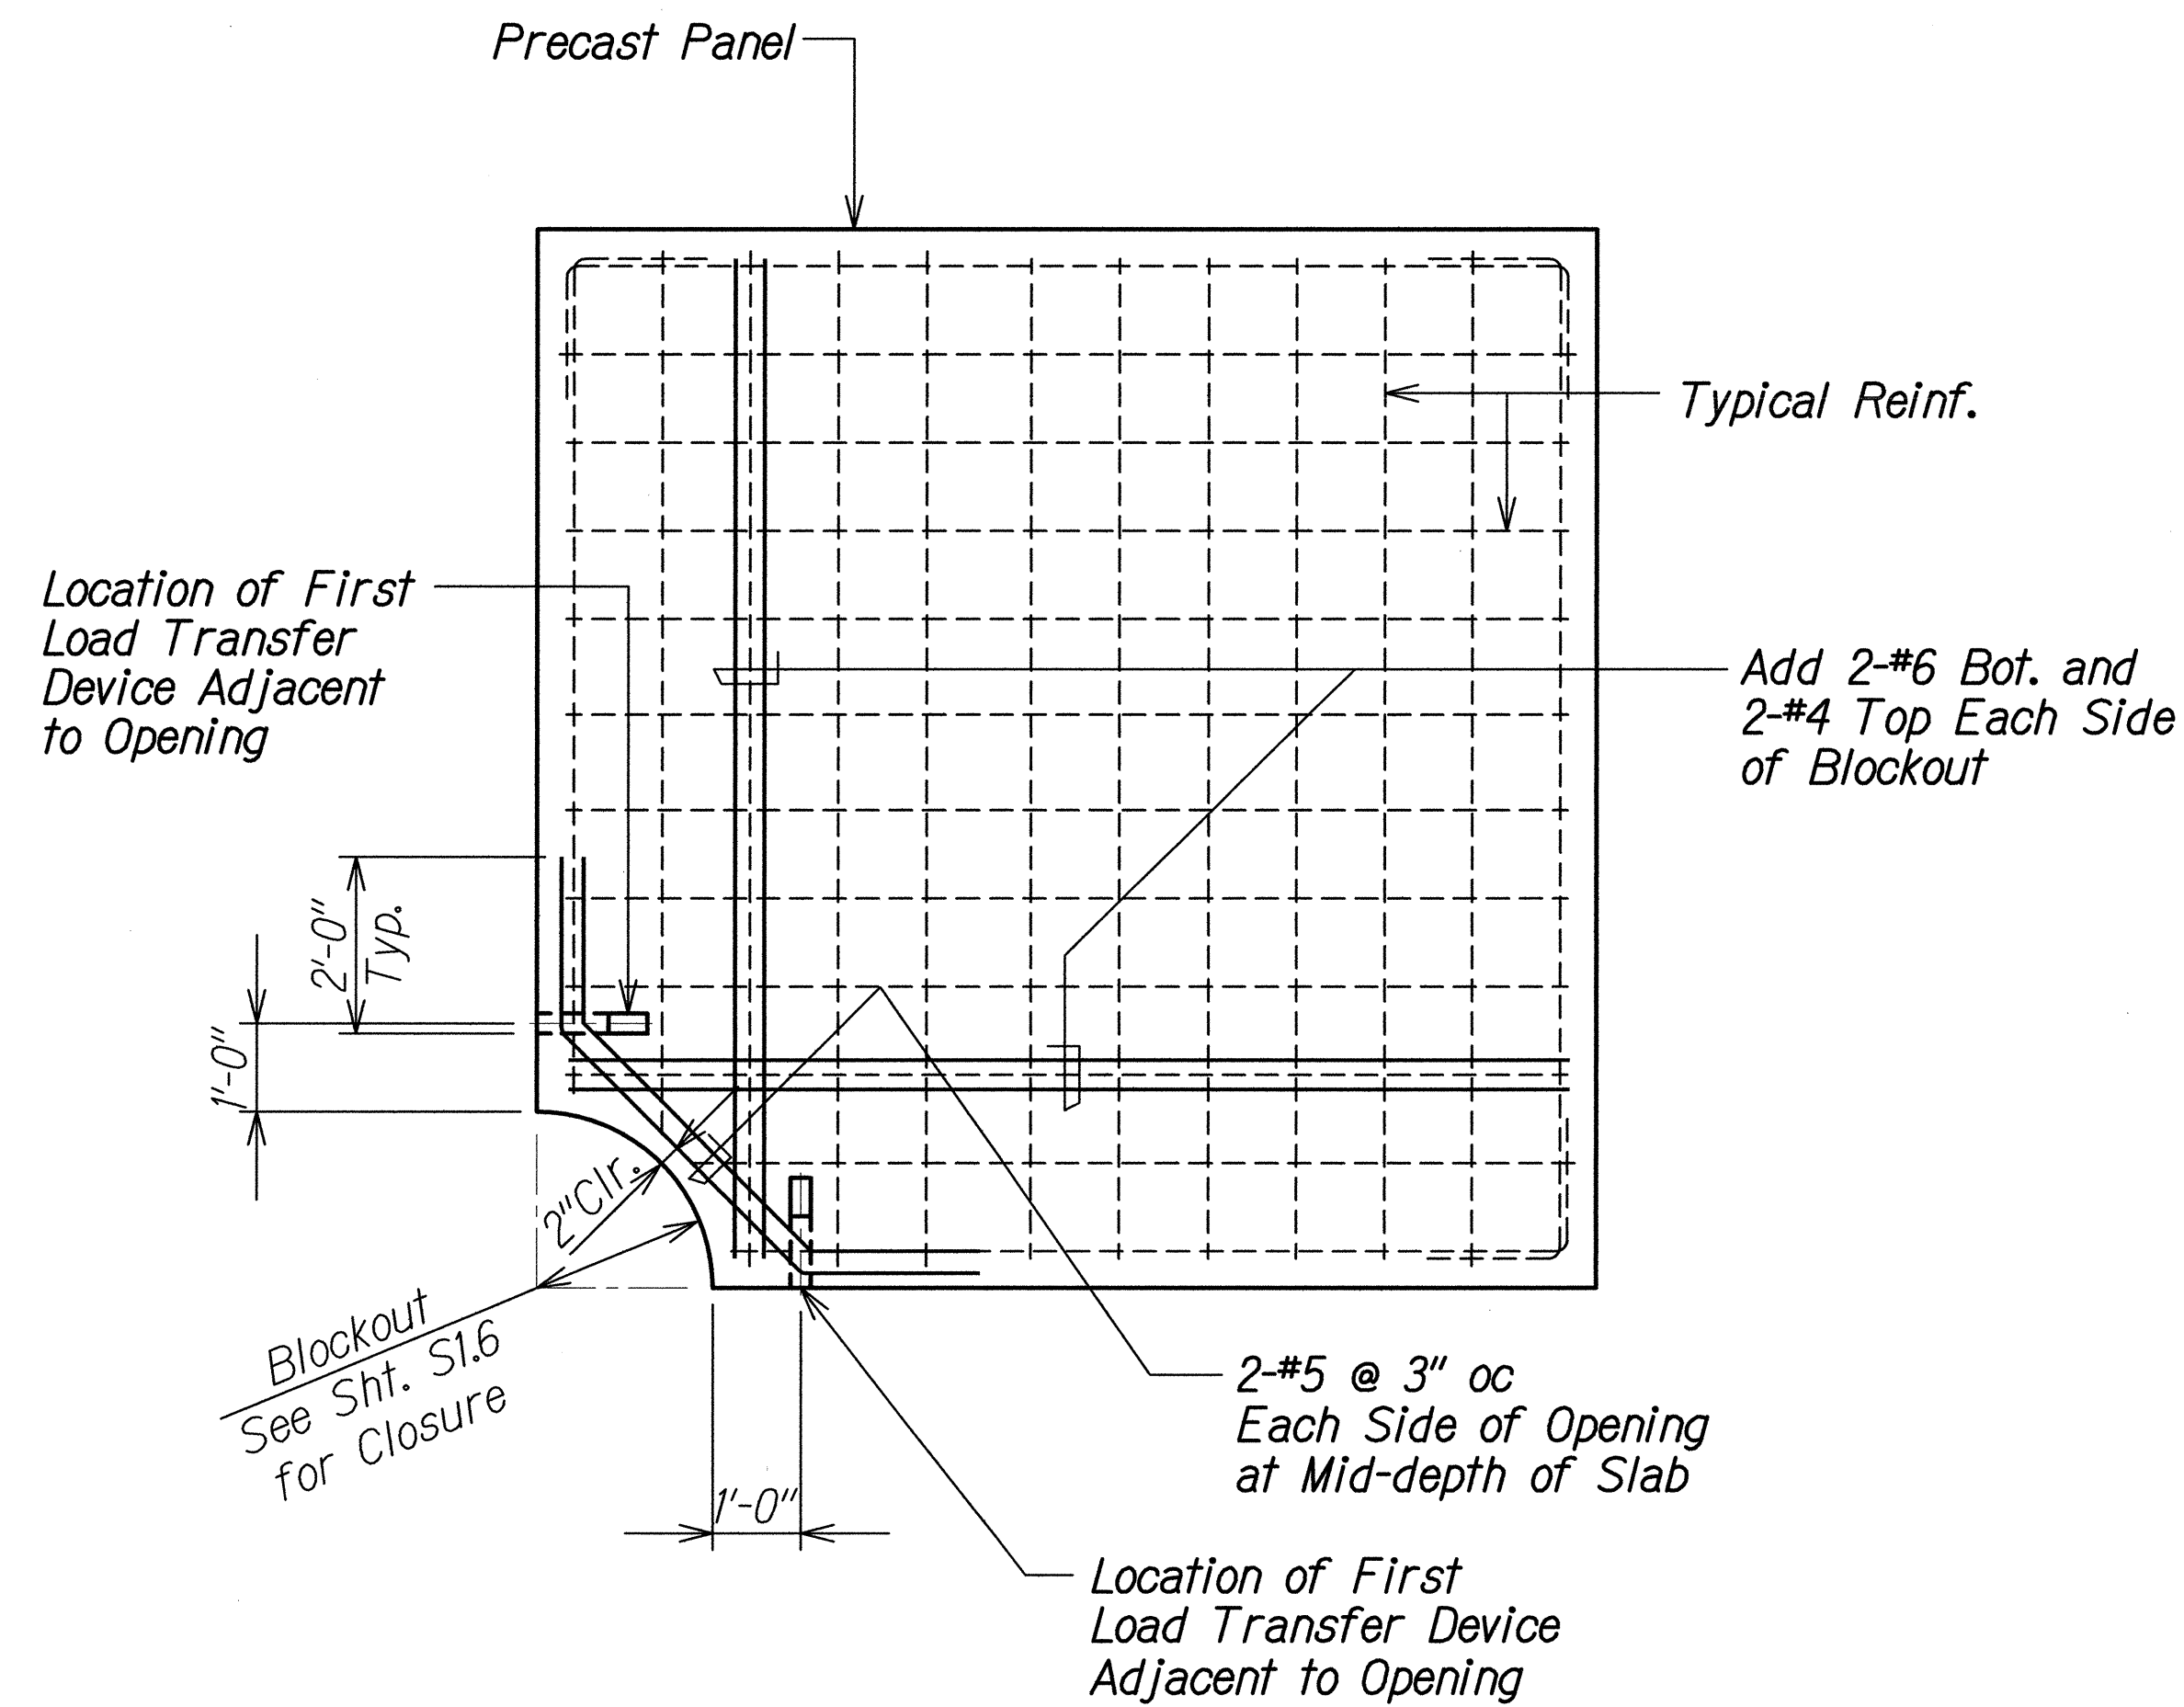


- Notes:
1. Typical load transfer devices not shown for clarity. See S2.1 and S2.2 for location and spacing.
  2. All JCPC panels with blocks shall also be reinforced with fiber. See General Notes 4.(F) on sheet S0.2.

**CIRCULAR BLOCKOUT AT JOINT**  
 Scale: 1/2" = 1'-0"  
 A  
 S2.7 S2.7

|               |                   |      |
|---------------|-------------------|------|
| ORIGINAL PLAN | SURVEY PLOTTED BY | DATE |
| NOTE BOOK     | DESIGNED BY       |      |
| No.           | QUANTITIES BY     |      |
|               | CHECKED BY        |      |

DRAWING NAME: 2100-ONGONG\12-0331-HFL MIDDLE STREET RECONSTRUCTION-DOTH\CA01\06-19-14 BD\HFL-MS206.DWG PLOT TIME: 06-19-14, 9:56 AM

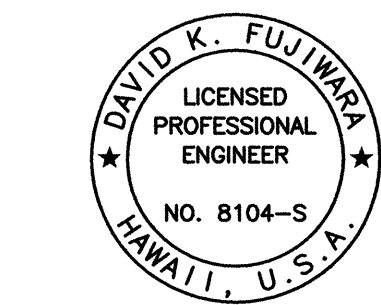

THIS WORK WAS PREPARED BY  
 ME OR UNDER MY SUPERVISION.  
*David K. Fujiwara*  
 SIGNATURE EXPIRATION DATE OF THE LICENSE 4-30-16

STATE OF HAWAII  
DEPARTMENT OF TRANSPORTATION  
HIGHWAYS DIVISION  
**CIRCULAR BLOCKOUT**  
**DETAIL**  
MIDDLE STREET PAVEMENT RECONSTRUCTION  
North King Street to Kamehameha Highway  
FAP NO. STP-7415(001)  
Scale: As Noted Date: Jun. 20, 2014  
SHEET No. S27 OF 10 SHEETS


134



| FED. ROAD DIST. NO. | STATE | FEDERAL AID PROJ. NO. | FISCAL YEAR | SHEET NO. | TOTAL SHEETS |
|---------------------|-------|-----------------------|-------------|-----------|--------------|
| HAWAII              | HAW.  | STP-7415(001)         | 2014        | 135       | 173          |

DRAWING NAME: 2400 OONGONG 12-033 - HEL MIDDLE STREET RECONSTRUCTION-DOTHA CAD 06-19-14 BDA HEL-MS107 TO MS110 - MS208 TO MS210 - MS312.DWG PLOT TIME: 06-18-14, 7:01 PM


|               |                    |      |
|---------------|--------------------|------|
| ORIGINAL PLAN | SURVEY PROVIDED BY | DATE |
| NOTE BOOK     | DRAWN BY           | "    |
| No.           | DESIGNED BY        | "    |
|               | QUANTITIES BY      | "    |
|               | CHECKED BY         | "    |

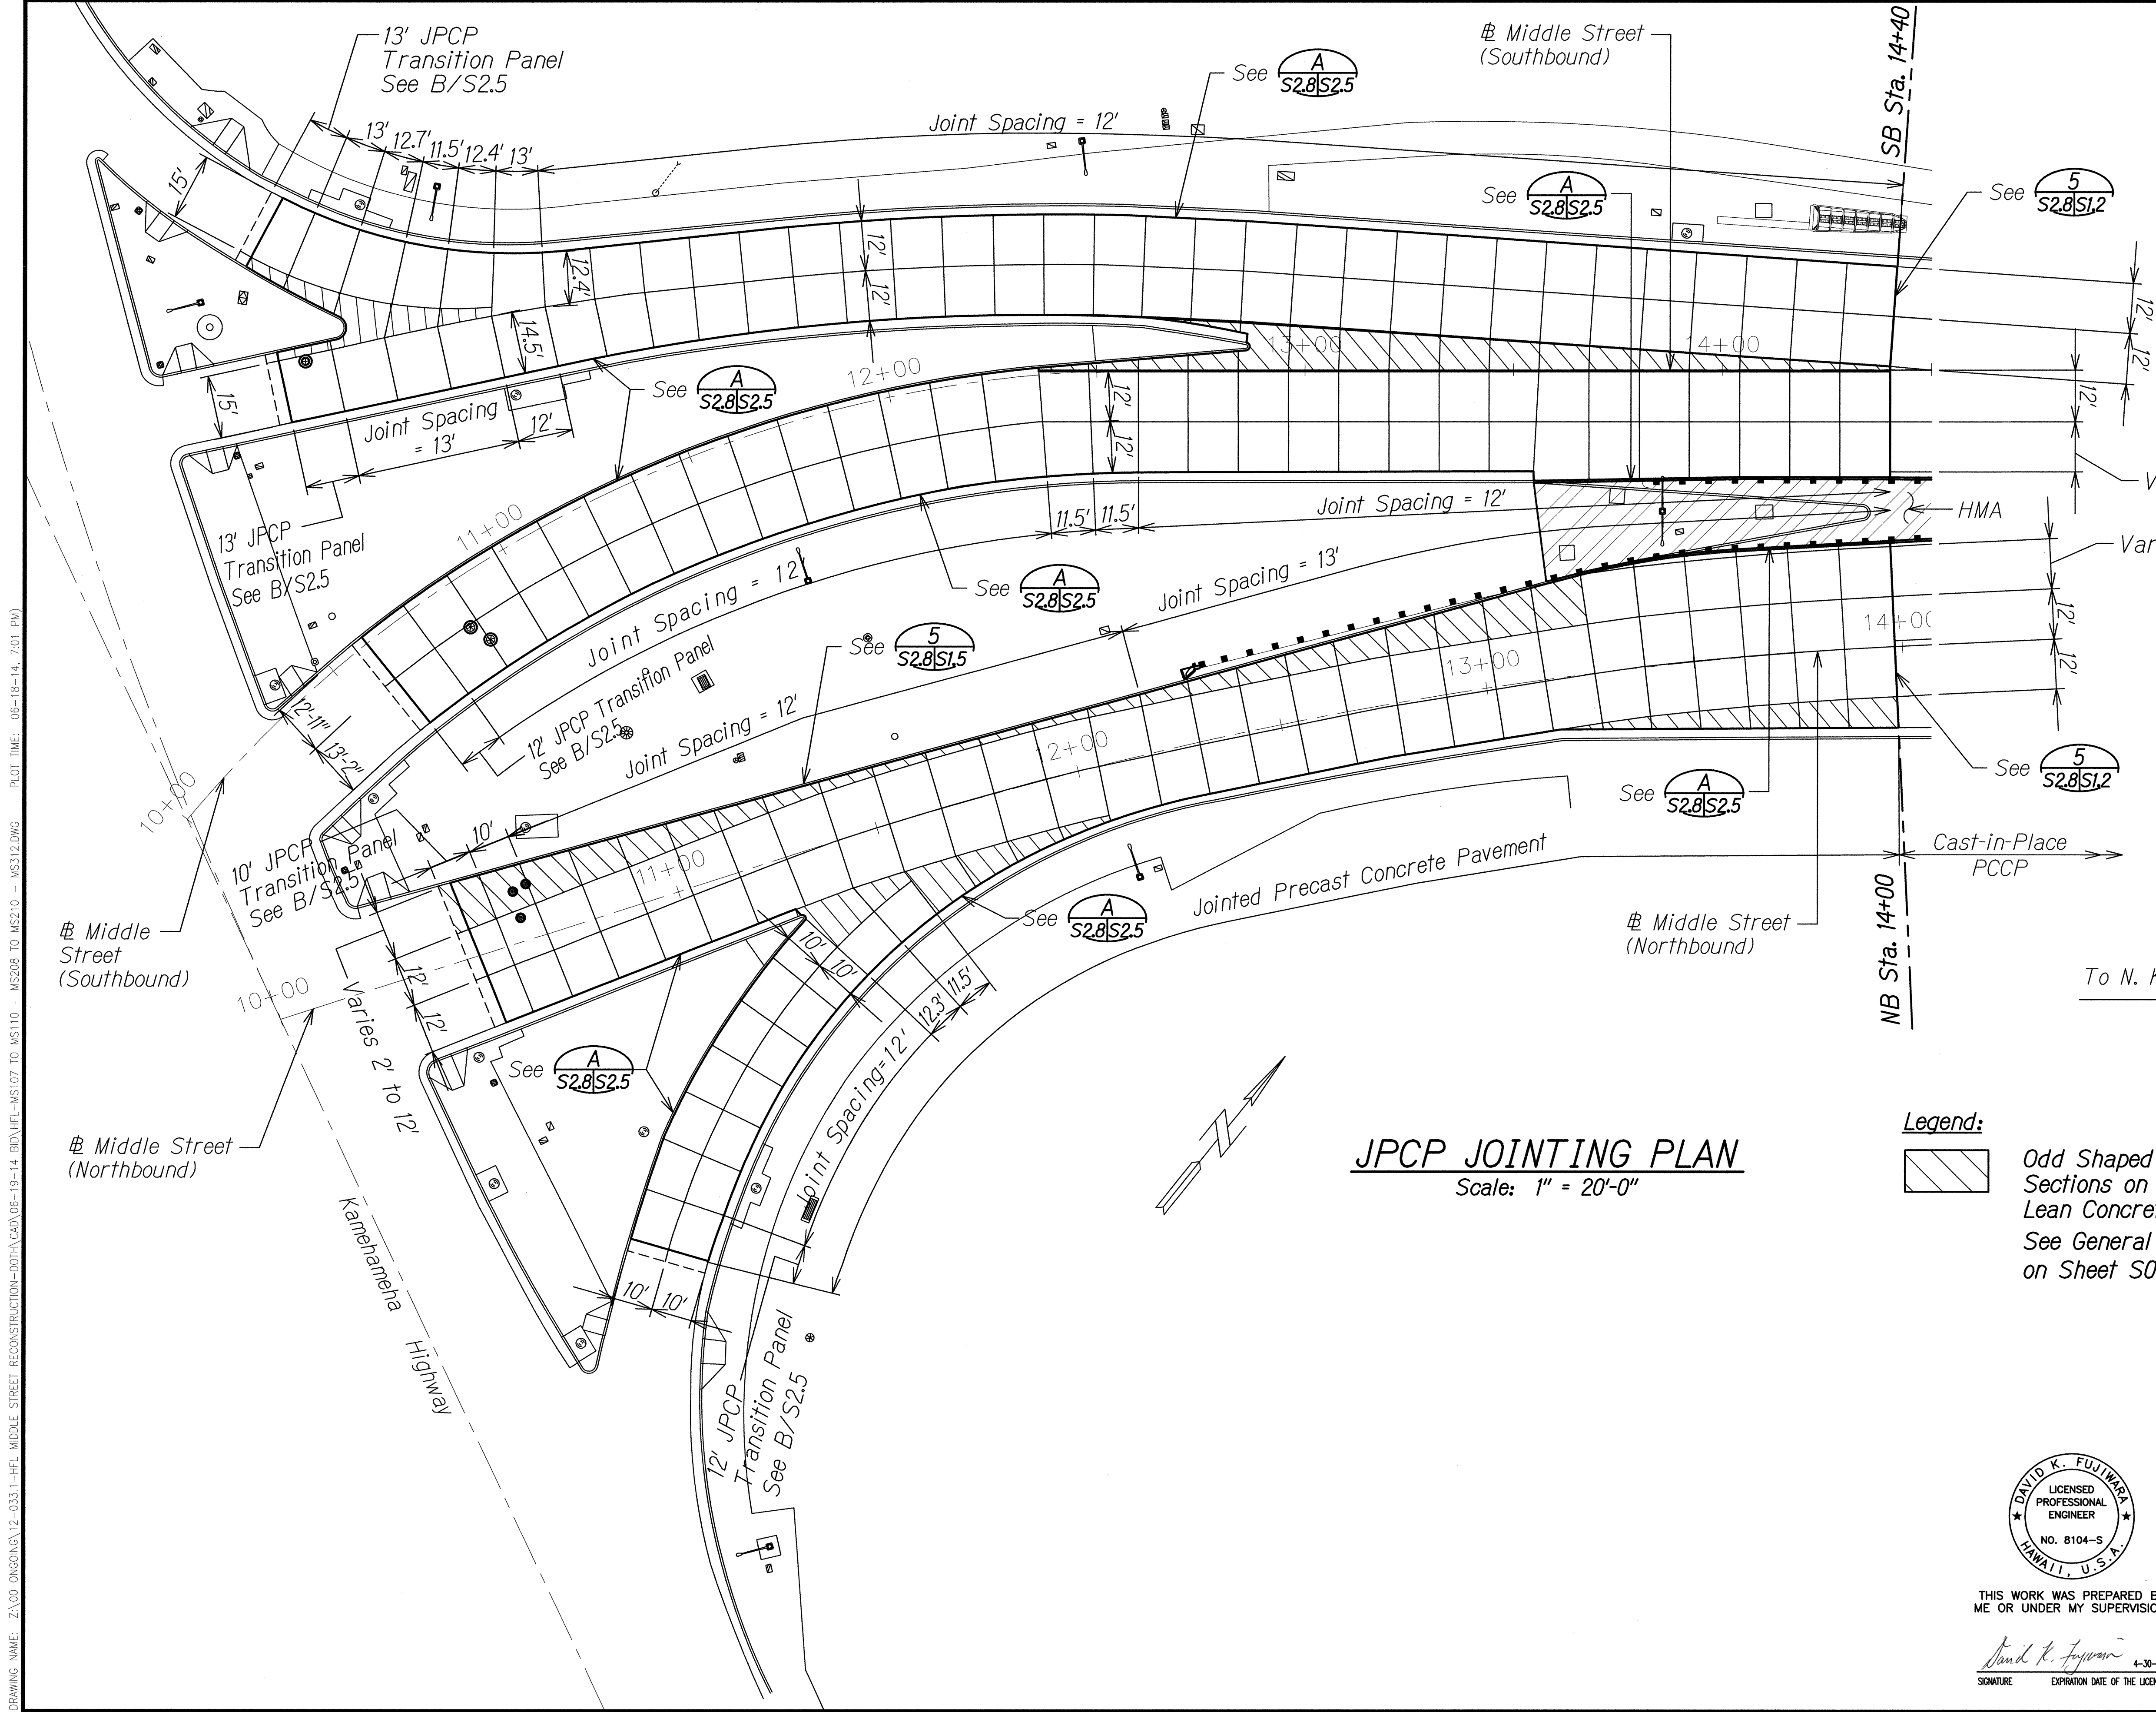


# **JPCP JOINTING PLAN**

Scale: 1" = 20'-0"

## **Legend:**

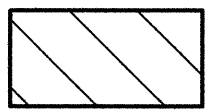

Odd Shaped / Cast-in-Place  
Sections on 6" Rapid Setting  
Lean Concrete Base  
See General Notes 4.(F) and 7. (H)  
on Sheet S0.2.

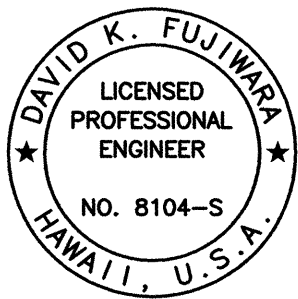

THIS WORK WAS PREPARED BY  
ME OR UNDER MY SUPERVISION.

Signature: *David K. Fujiwara*  
EXPIRATION DATE OF THE LICENSE: 4-30-16

STATE OF HAWAII  
DEPARTMENT OF TRANSPORTATION  
HIGHWAYS DIVISION

## **JPCP JOINTING PLAN**


**MIDDLE STREET PAVEMENT RECONSTRUCTION**  
**North King Street to Kamehameha Highway**  
**FAP NO. STP-7415(001)**

Scale: As Noted Date: Jun. 20, 2014

SHEET No. S28 OF 10 SHEETS



| FED. ROAD DIST. NO. | STATE | FEDERAL AID PROJ. NO. | FISCAL YEAR | SHEET NO. | TOTAL SHEETS |
|---------------------|-------|-----------------------|-------------|-----------|--------------|
| HAWAII              | HAW.  | STP-7415(001)         | 2014        | 136       | 173          |

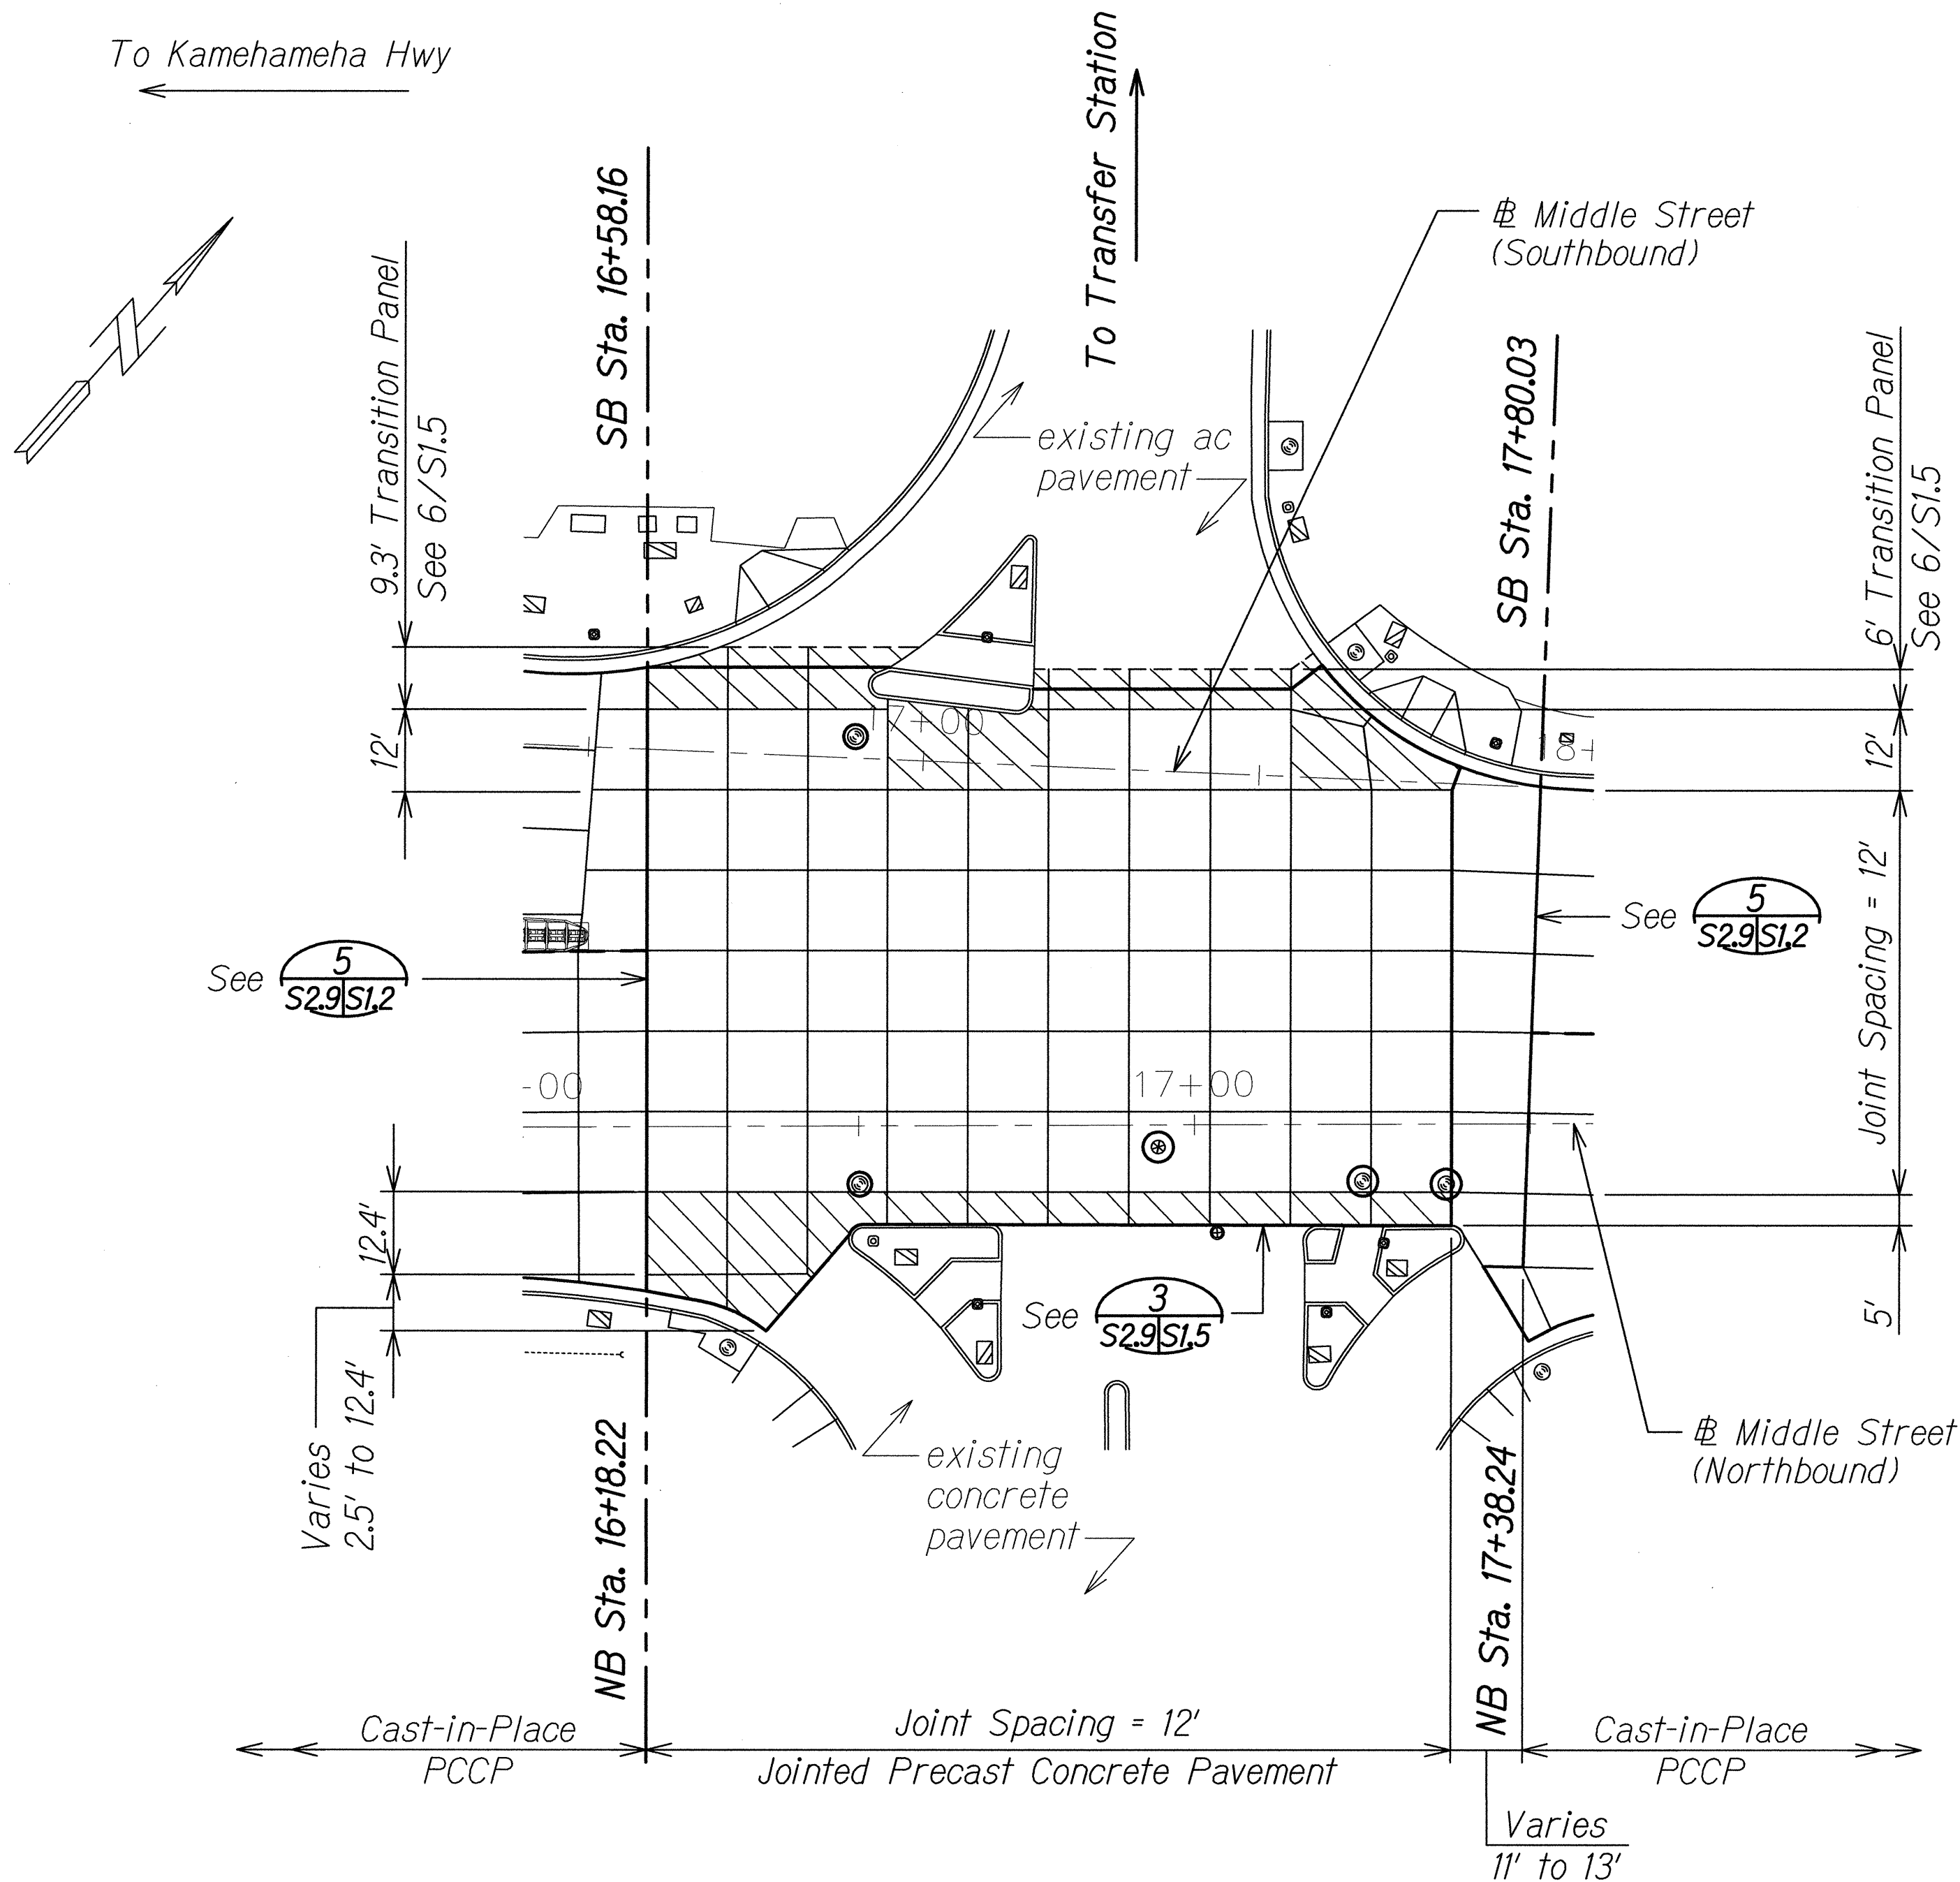

**JPCP JOINTING PLAN**  
Scale: 1" = 20'-0"


Legend:



Odd Shaped / Cast-in-Place  
Sections on 6" Rapid Setting  
Lean Concrete Base  
See General Notes 4.(F) and 7. (H)  
on Sheet S0.2.

|               |                  |      |
|---------------|------------------|------|
| ORIGINAL PLAN | SURVEY DOTTED BY | DATE |
| NOTE BOOK     | DRAWN BY         | "    |
| No.           | DESIGNED BY      | "    |
|               | QUANTITIES BY    | "    |
|               | CHECKED BY       | "    |

DRAWING NAME: 2A00 ONCONC12-033-1-HL MIDDLE STREET RECONSTRUCTION-DOTD(CAD)06-19-14 BID/VFL-MS107 TO MS110 - MS208 TO MS210 - MS312.DWG PLOT TIME: 06-18-14, 7:01 PM

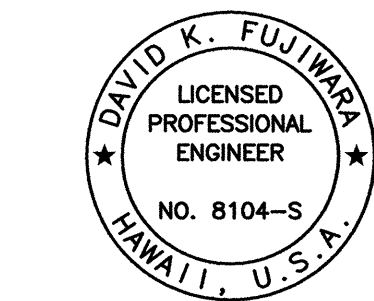

THIS WORK WAS PREPARED BY  
ME OR UNDER MY SUPERVISION.


Signature: *David K. Fujiwara* 4-30-16  
SIGNATURE EXPIRATION DATE OF THE LICENSE

STATE OF HAWAII  
DEPARTMENT OF TRANSPORTATION  
HIGHWAYS DIVISION  
**JPCP JOINTING PLAN**  
MIDDLE STREET PAVEMENT RECONSTRUCTION  
North King Street to Kamehameha Highway  
FAP NO. STP-7415(001)  
Scale: As Noted Date: Jun. 20, 2014  
SHEET No. S29 OF 10 SHEETS



| FED. ROAD DIST. NO. | STATE | FEDERAL AID PROJ. NO. | FISCAL YEAR | SHEET NO. | TOTAL SHEETS |
|---------------------|-------|-----------------------|-------------|-----------|--------------|
| HAWAII              | HAW.  | STP-7415(001)         | 2014        | 137       | 173          |


To Kamehameha Hwy

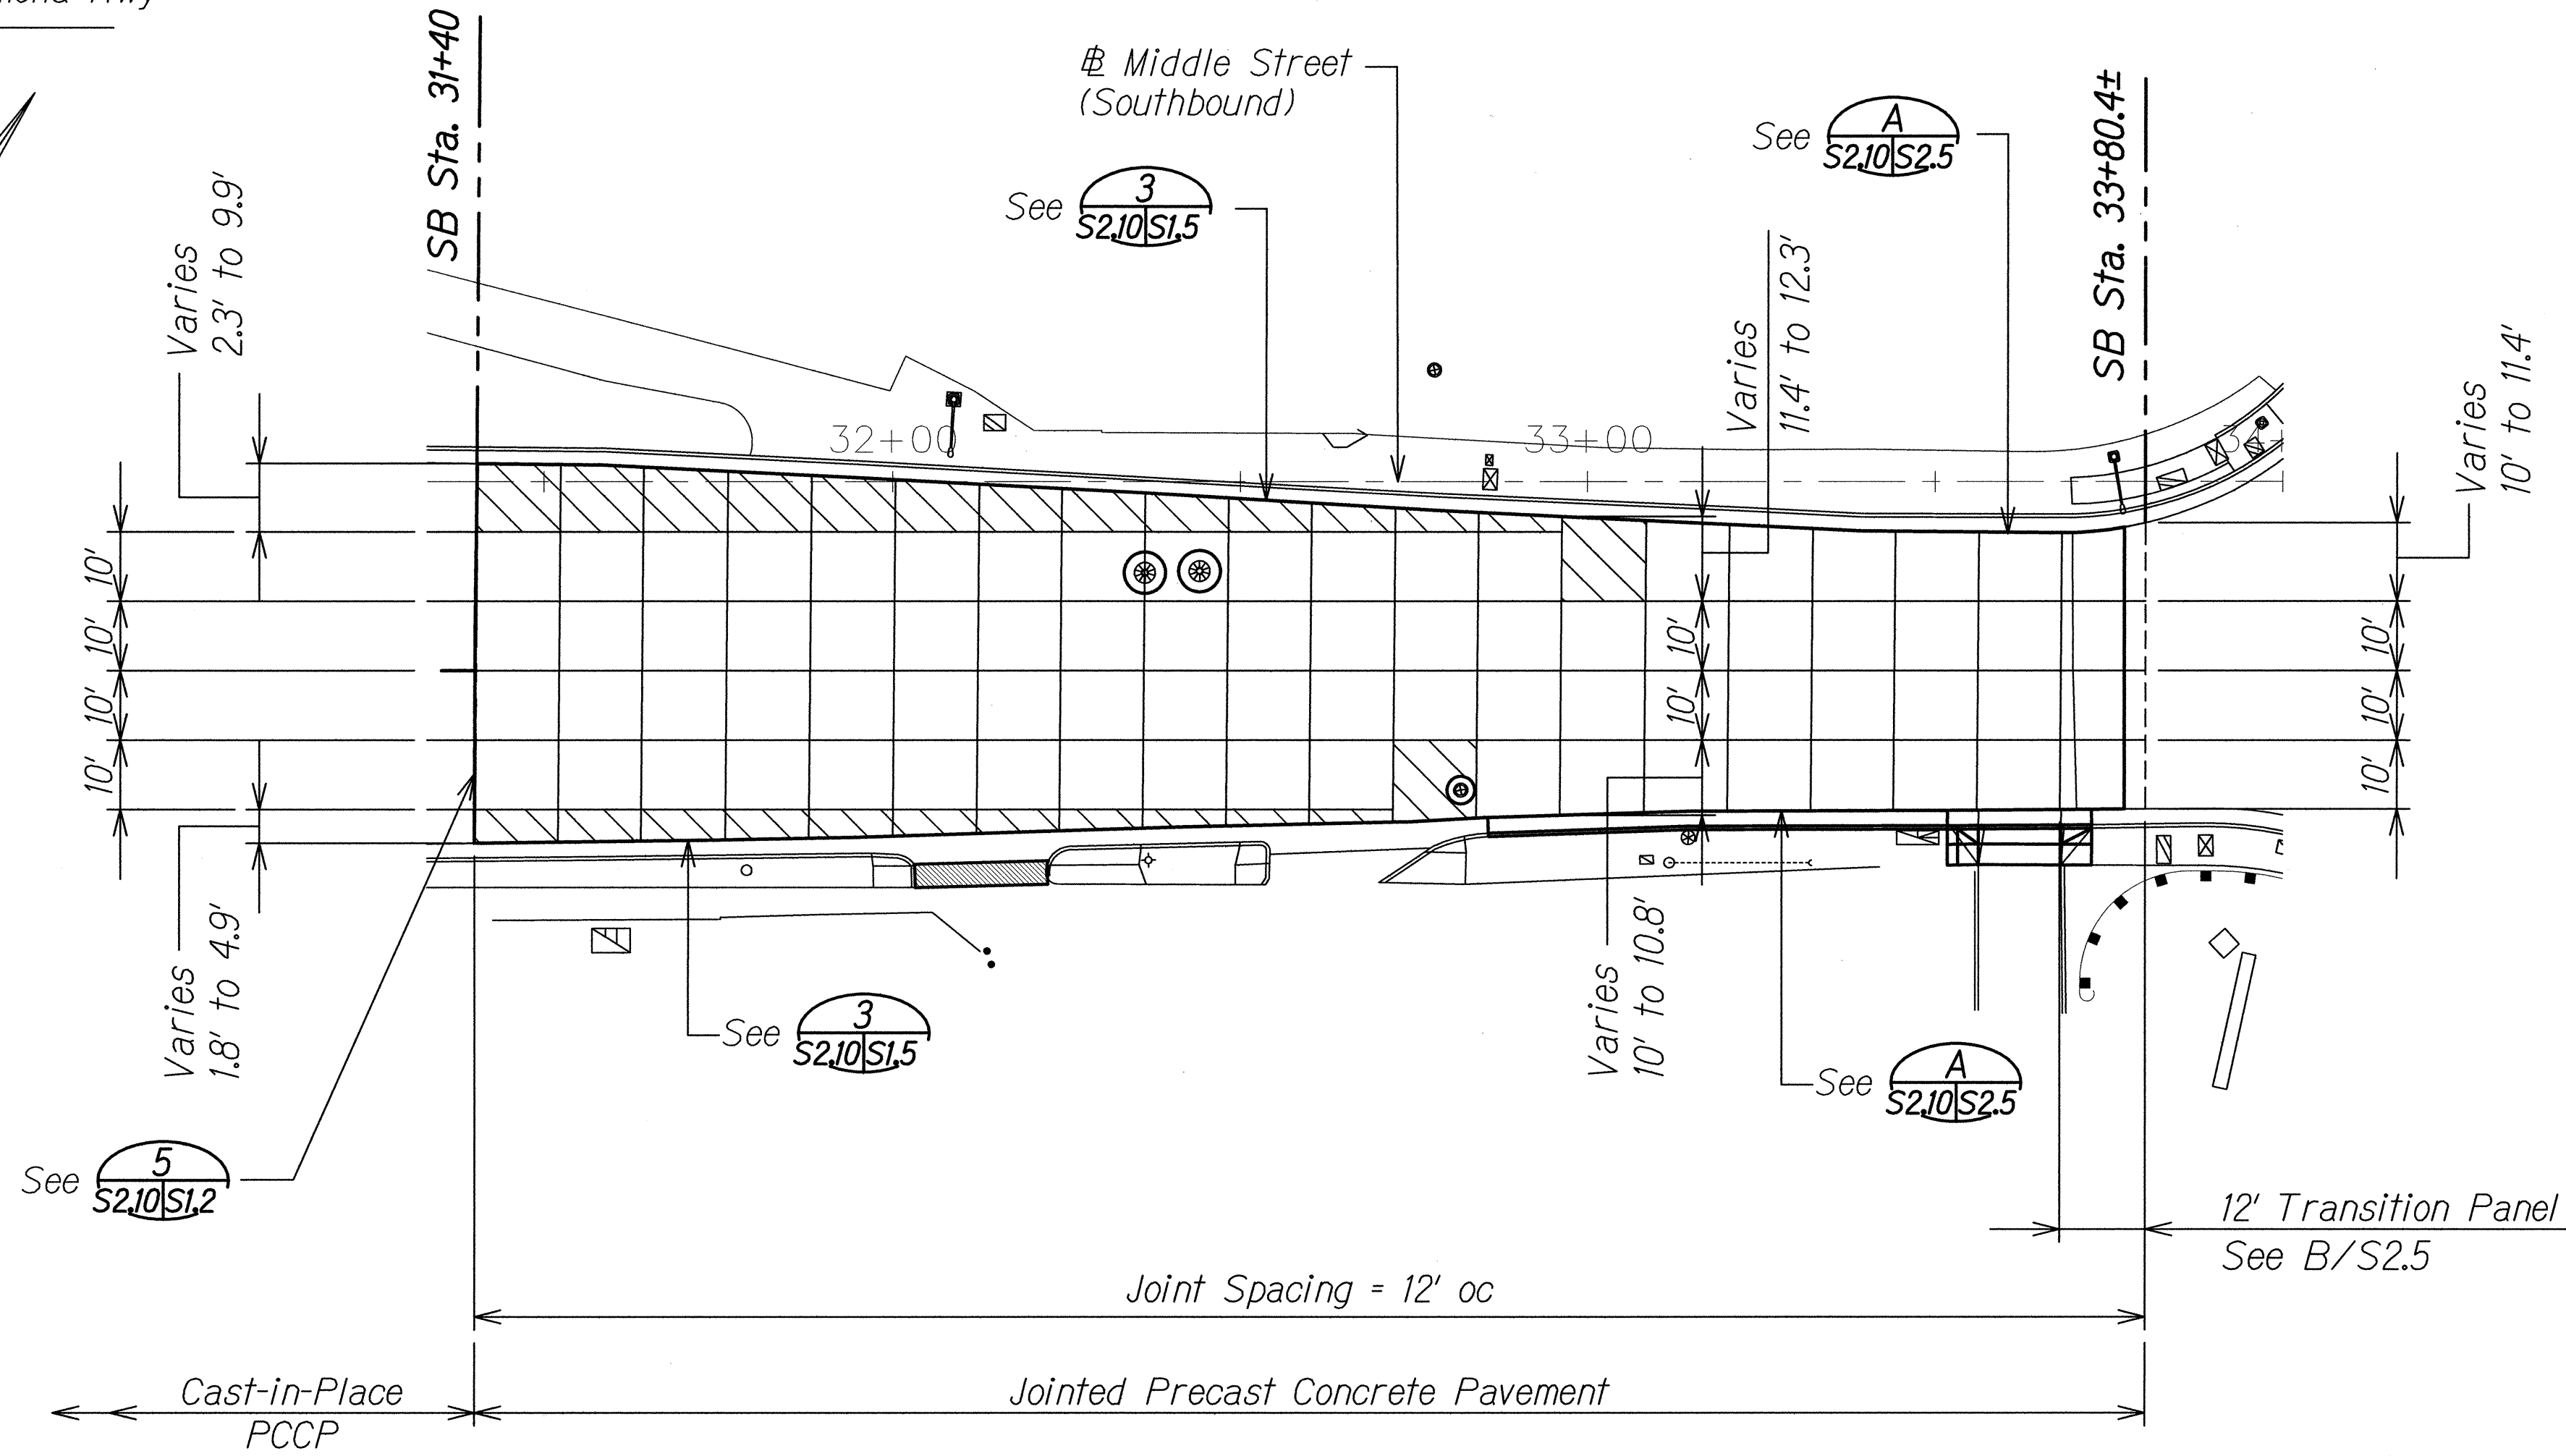

### JPCP JOINTING PLAN

Scale: 1" = 20'-0"


**Legend:**

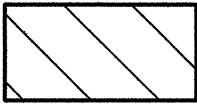 Odd Shaped / Cast-in-Place Sections on 6" Rapid Setting Lean Concrete Base

See General Notes 4.(F) and 7. (H) on Sheet S0.2.

|               |                   |      |
|---------------|-------------------|------|
| ORIGINAL PLAN | SURVEY PLOTTED BY | DATE |
| NOTE BOOK     | DESIGNED BY       |      |
| No.           | QUANTITIES BY     |      |
|               | CHECKED BY        |      |

DRAWING NAME: 2100 OINGONG 12-0331-HFL MIDDLE STREET RECONSTRUCTION-DOT&CAO 06-19-14 BID VFL-MS107 TO MS110 - MS208 TO MS210 - MS312.DWG PLOT TIME: 06-19-14, 10:57 AM

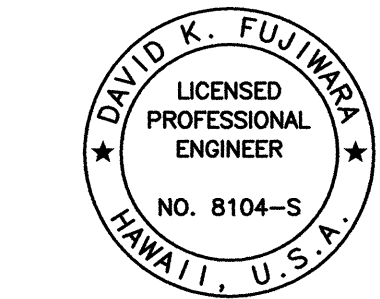

THIS WORK WAS PREPARED BY ME OR UNDER MY SUPERVISION.

*David K. Fujiwara* 4-30-16

SIGNATURE EXPIRATION DATE OF THE LICENSE

STATE OF HAWAII  
DEPARTMENT OF TRANSPORTATION  
HIGHWAYS DIVISION

### JPCP JOINTING PLAN


MIDDLE STREET PAVEMENT RECONSTRUCTION  
North King Street to Kamehameha Highway  
FAP NO. STP-7415(001)

Scale: As Noted Date: Jun. 20, 2014


SHEET No. S210 OF 10 SHEETS




| FED. ROAD DIST. NO. | STATE | FEDERAL AID PROJ. NO. | FISCAL YEAR | SHEET NO. | TOTAL SHEETS |
|---------------------|-------|-----------------------|-------------|-----------|--------------|
| HAWAII              | HAW.  | STP-7415(001)         | 2014        | 138       | 173          |

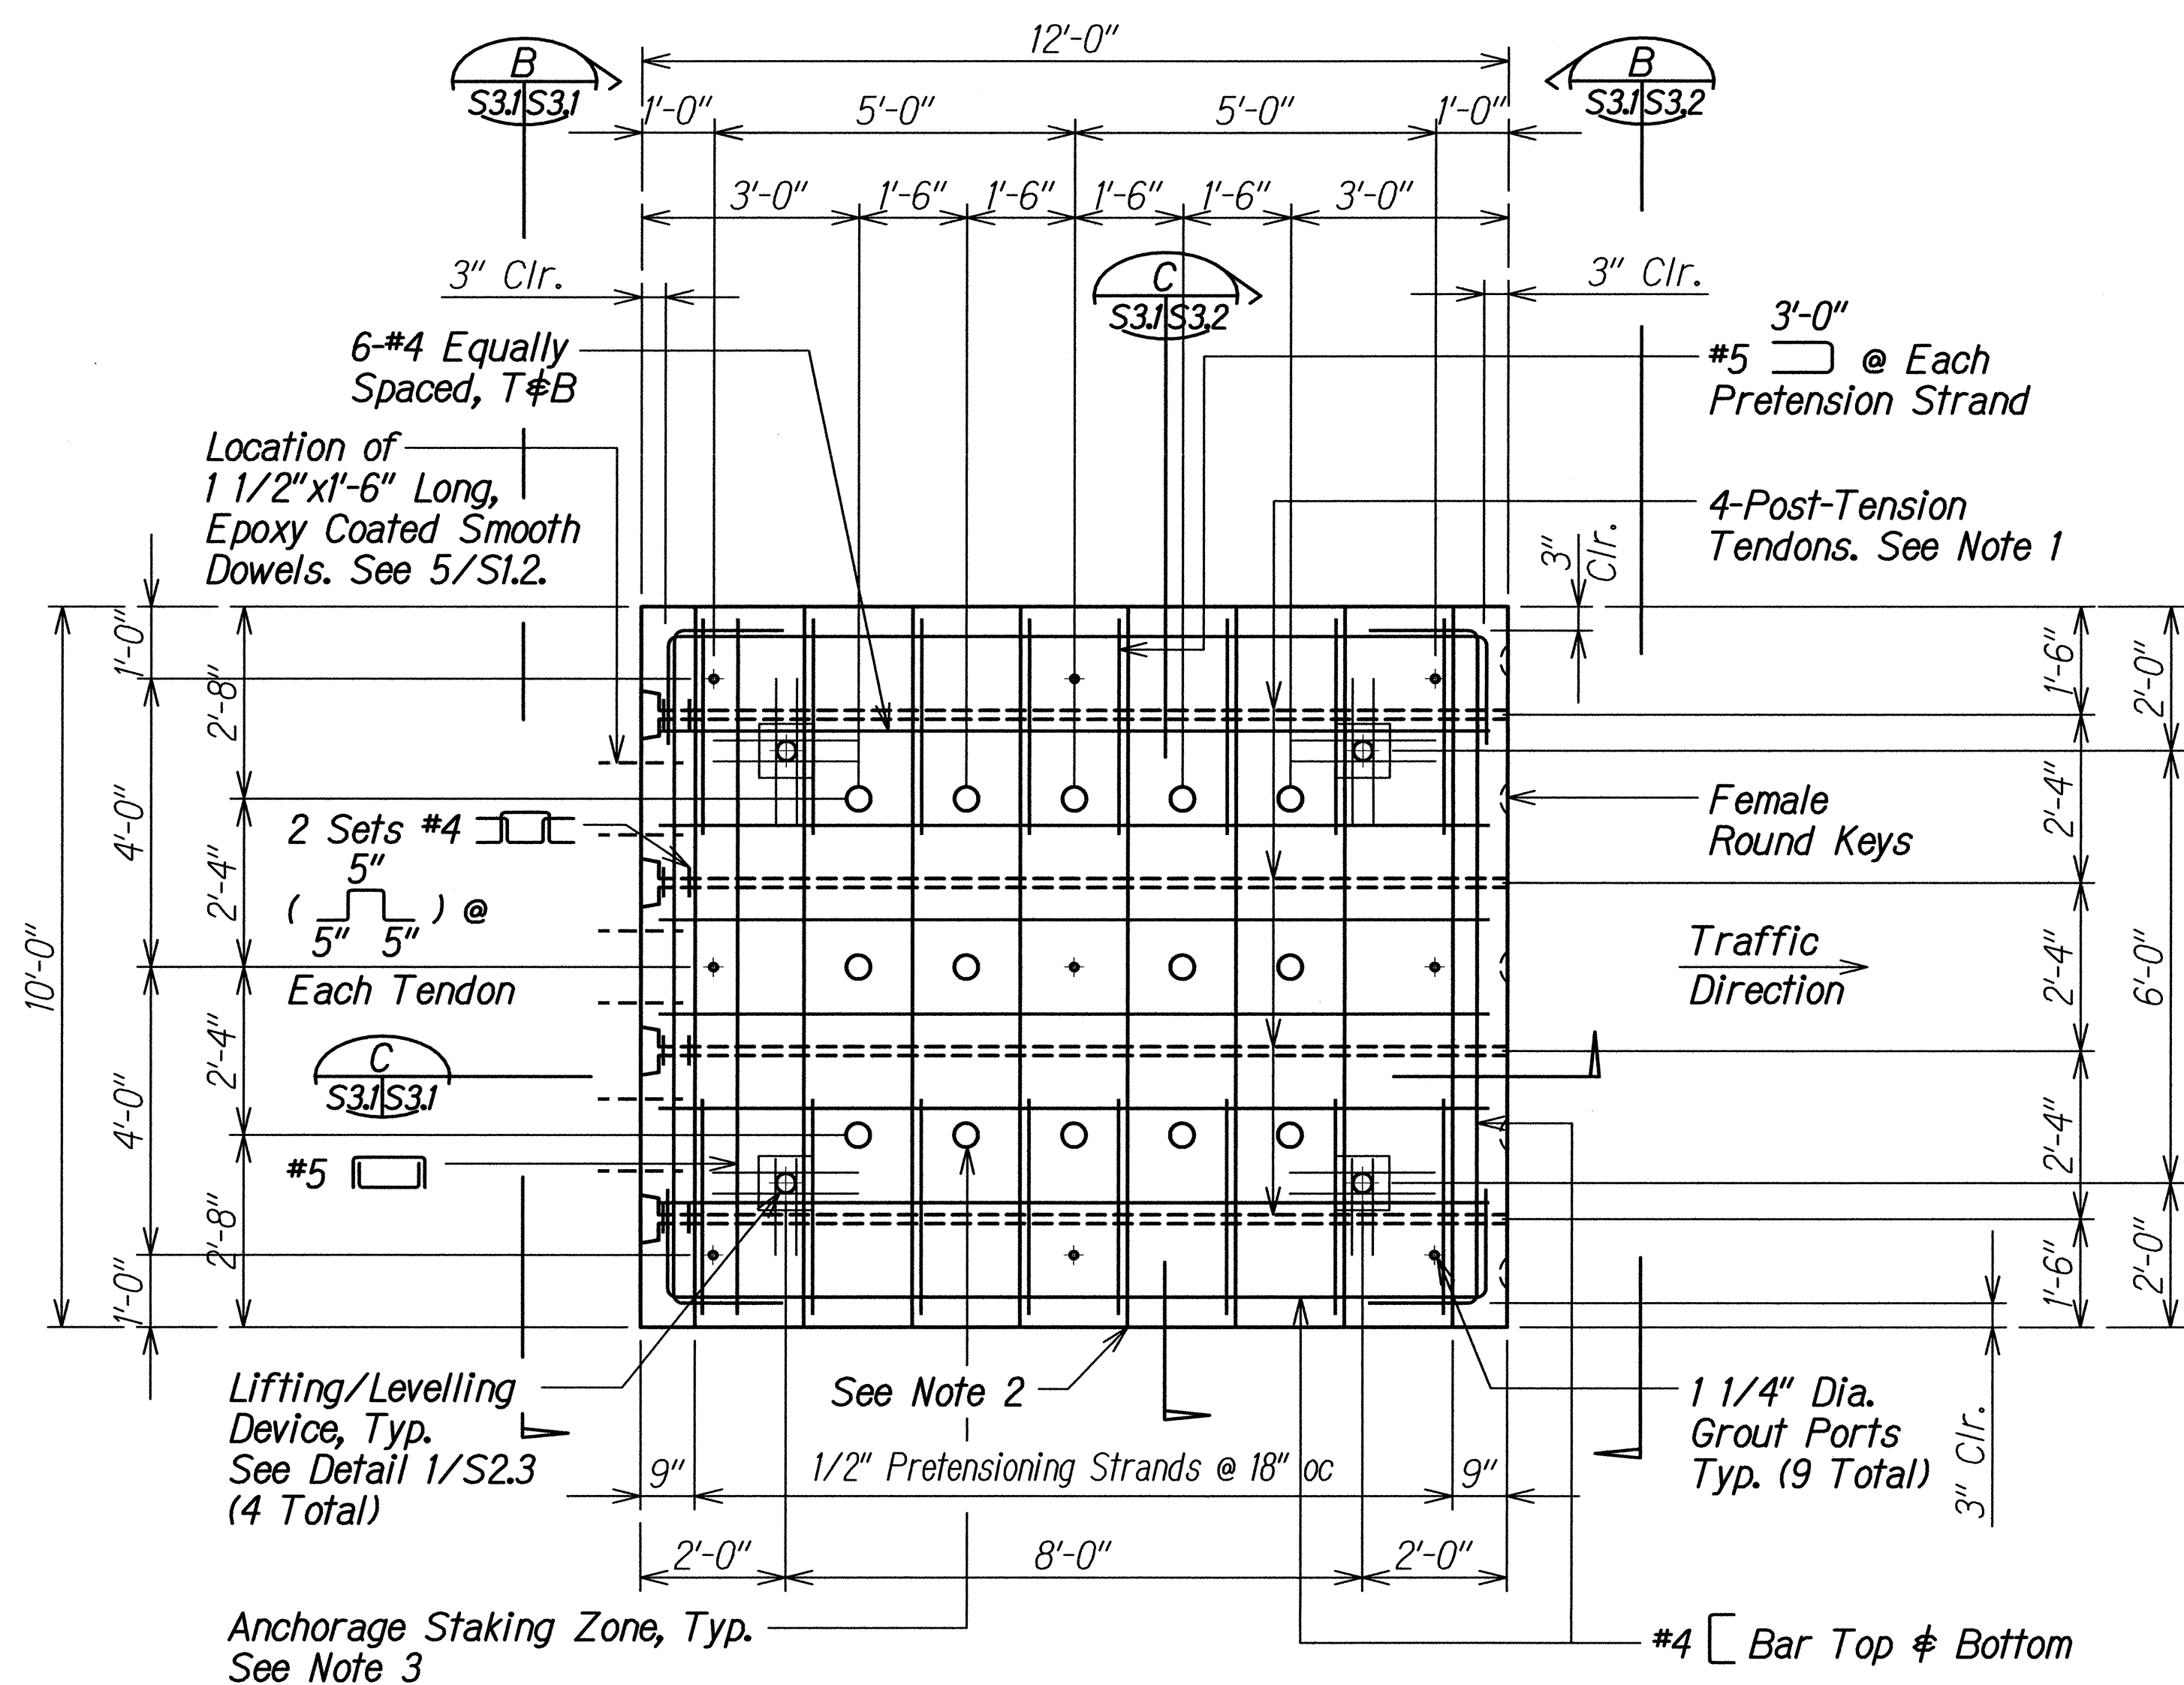

REBAR MAT (TOP & BOTTOM LAYER) A  
Scale: 1/2" = 1'-0"

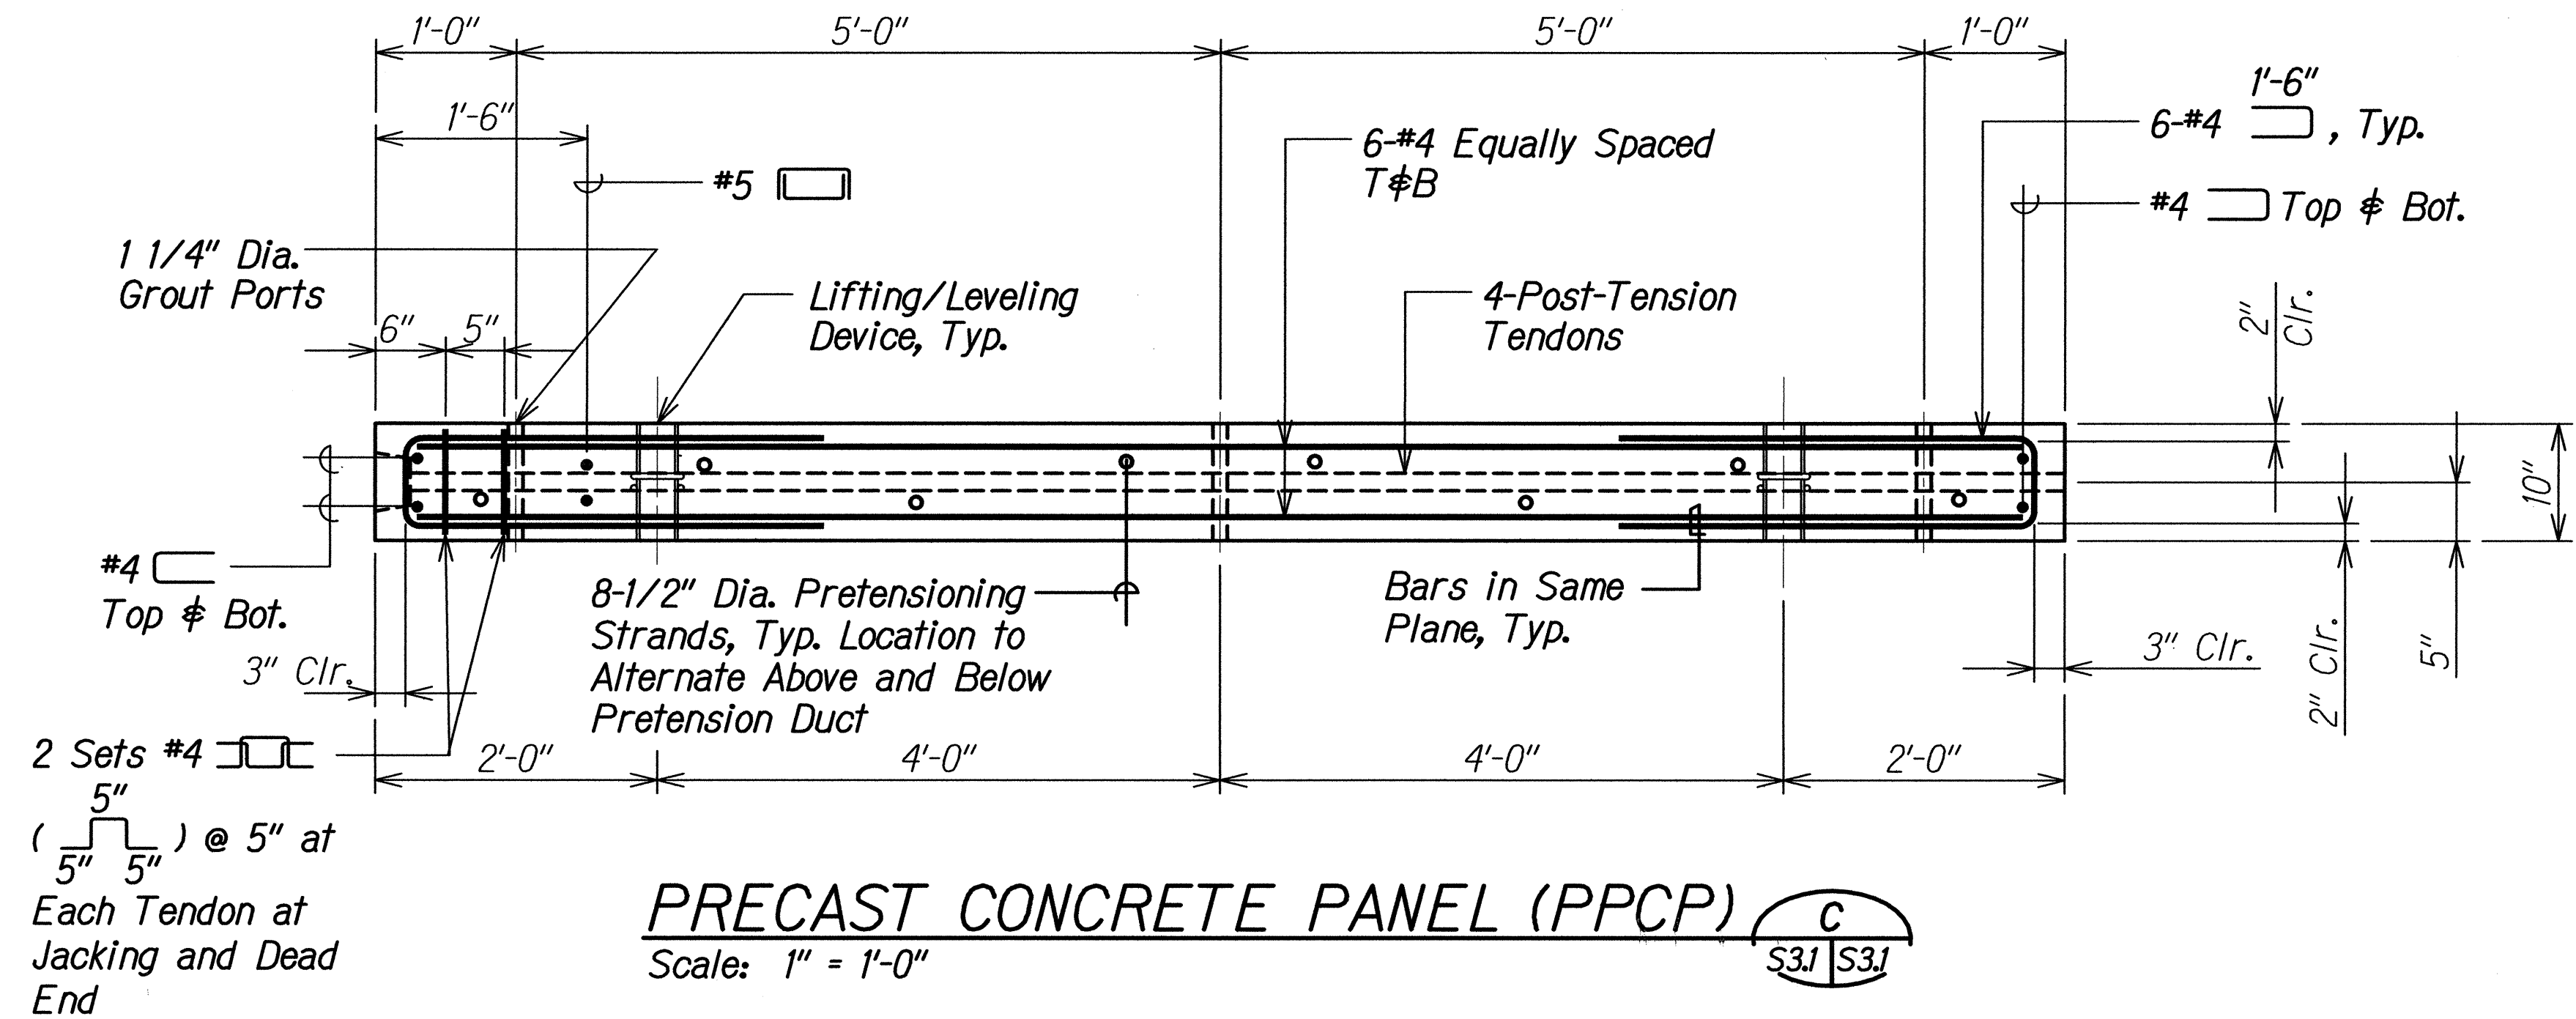

PRECAST CONCRETE PANEL (PPCP) C  
Scale: 1" = 1'-0"

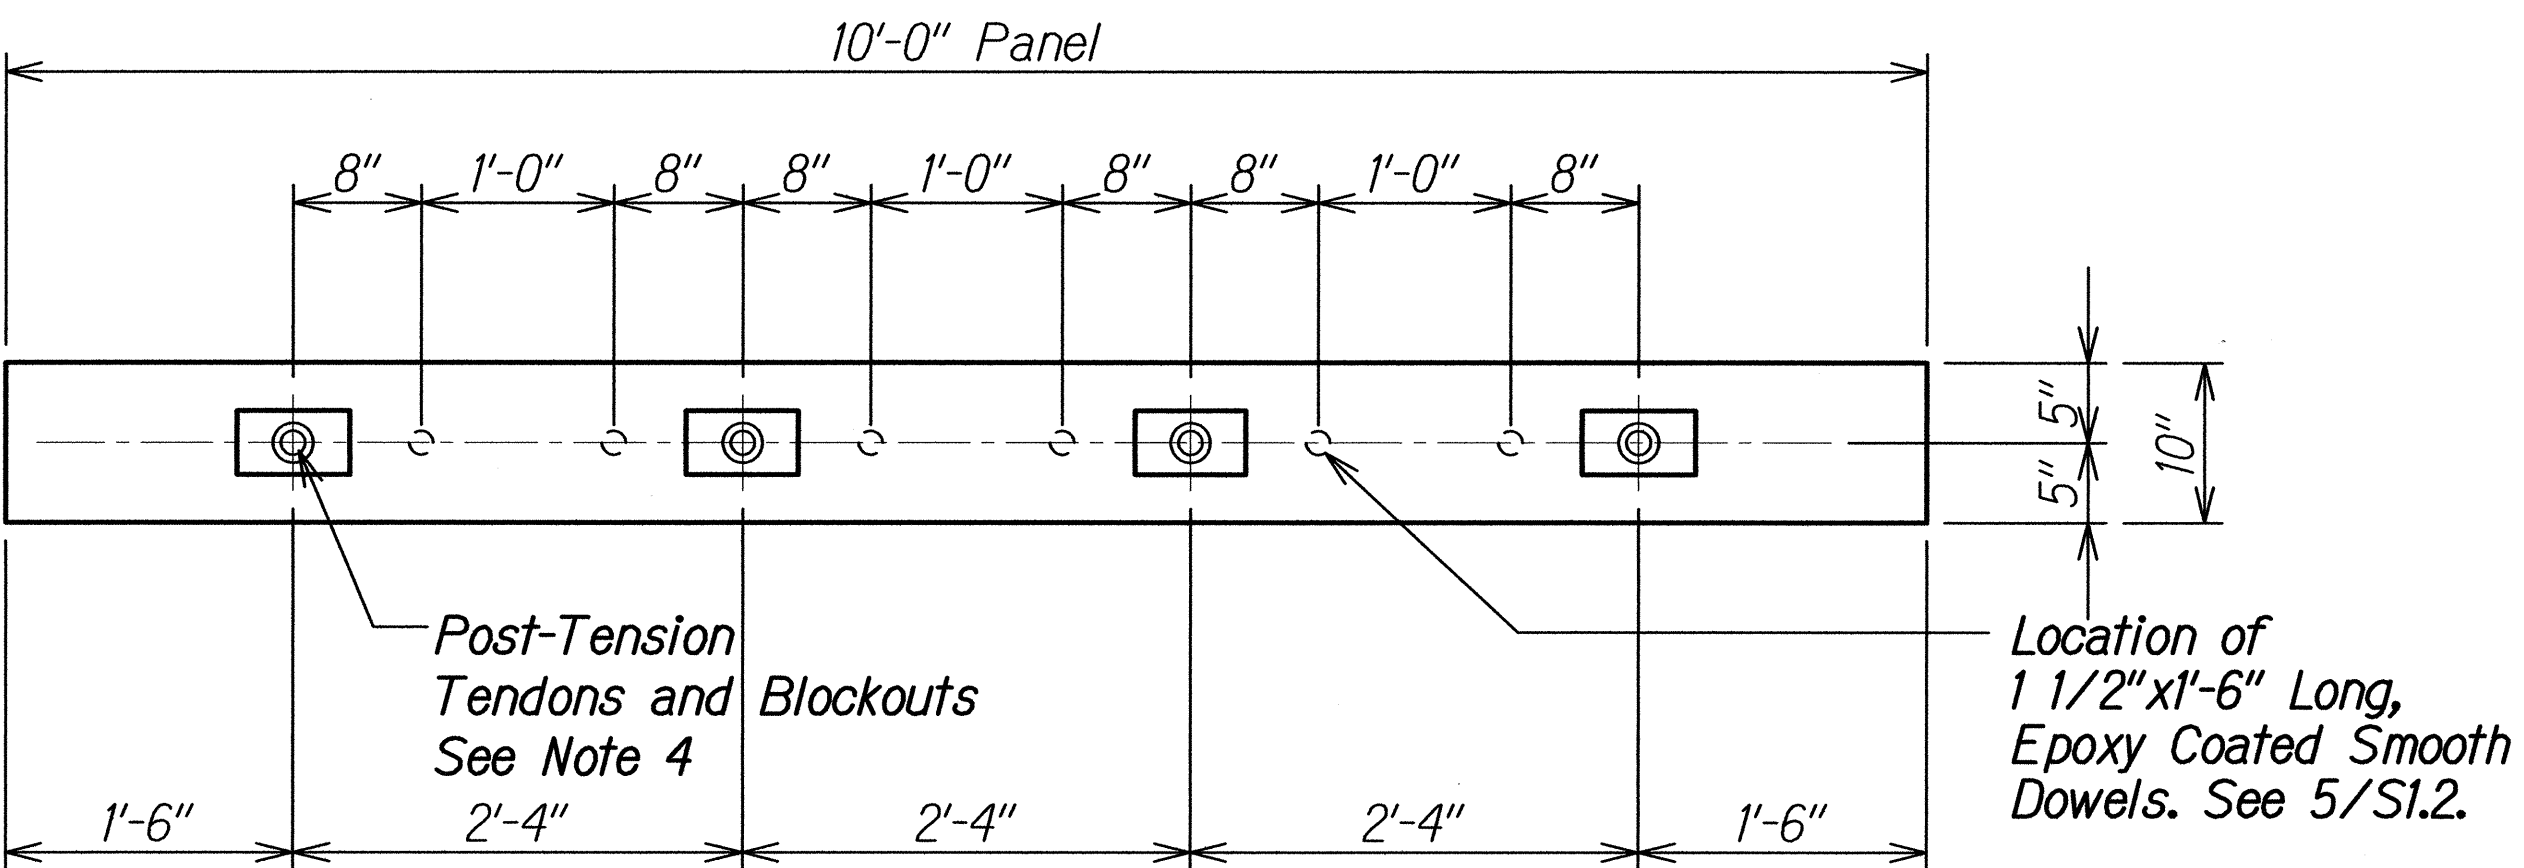

POST-TENSION BLOCKOUT ELEVATION B  
Scale: 1" = 1'-0"

- Notes:**
- Each Post-Tension Tendon shall contain two (2) - 0.6" Dia. Strands. Design Jacking force at end of each 2x0.6 tendon = 88\*
  - Release pretensioning symetrically starting with middle strands and work outward.
  - Contractor to determine location and number of stakes to be used. Anchorage stakes shall have sufficient capacity to prevent any movement of the panels during post-tensioning.
  - Size of blockout shall be per anchorage system manufacturer's recommendation.




THIS WORK WAS PREPARED BY  
ME OR UNDER MY SUPERVISION.  
*David K. Fujiwara*  
SIGNATURE EXPIRATION DATE OF THE LICENSE 4-30-16


STATE OF HAWAII  
DEPARTMENT OF TRANSPORTATION  
HIGHWAYS DIVISION  
**TYPICAL PPCP END PANEL**  
**DETAILS**  
MIDDLE STREET PAVEMENT RECONSTRUCTION  
North King Street to Kamehameha Highway  
FAP NO. STP-7415(001)  
Scale: As Noted Date: Jun. 20, 2014  
SHEET No. S31 OF 12 SHEETS




| FED. ROAD DIST. NO. | STATE | FEDERAL AID PROJ. NO. | FISCAL YEAR | SHEET NO. | TOTAL SHEETS |
|---------------------|-------|-----------------------|-------------|-----------|--------------|
| HAWAII              | HAW.  | STP-7415(001)         | 2014        | 139       | 173          |

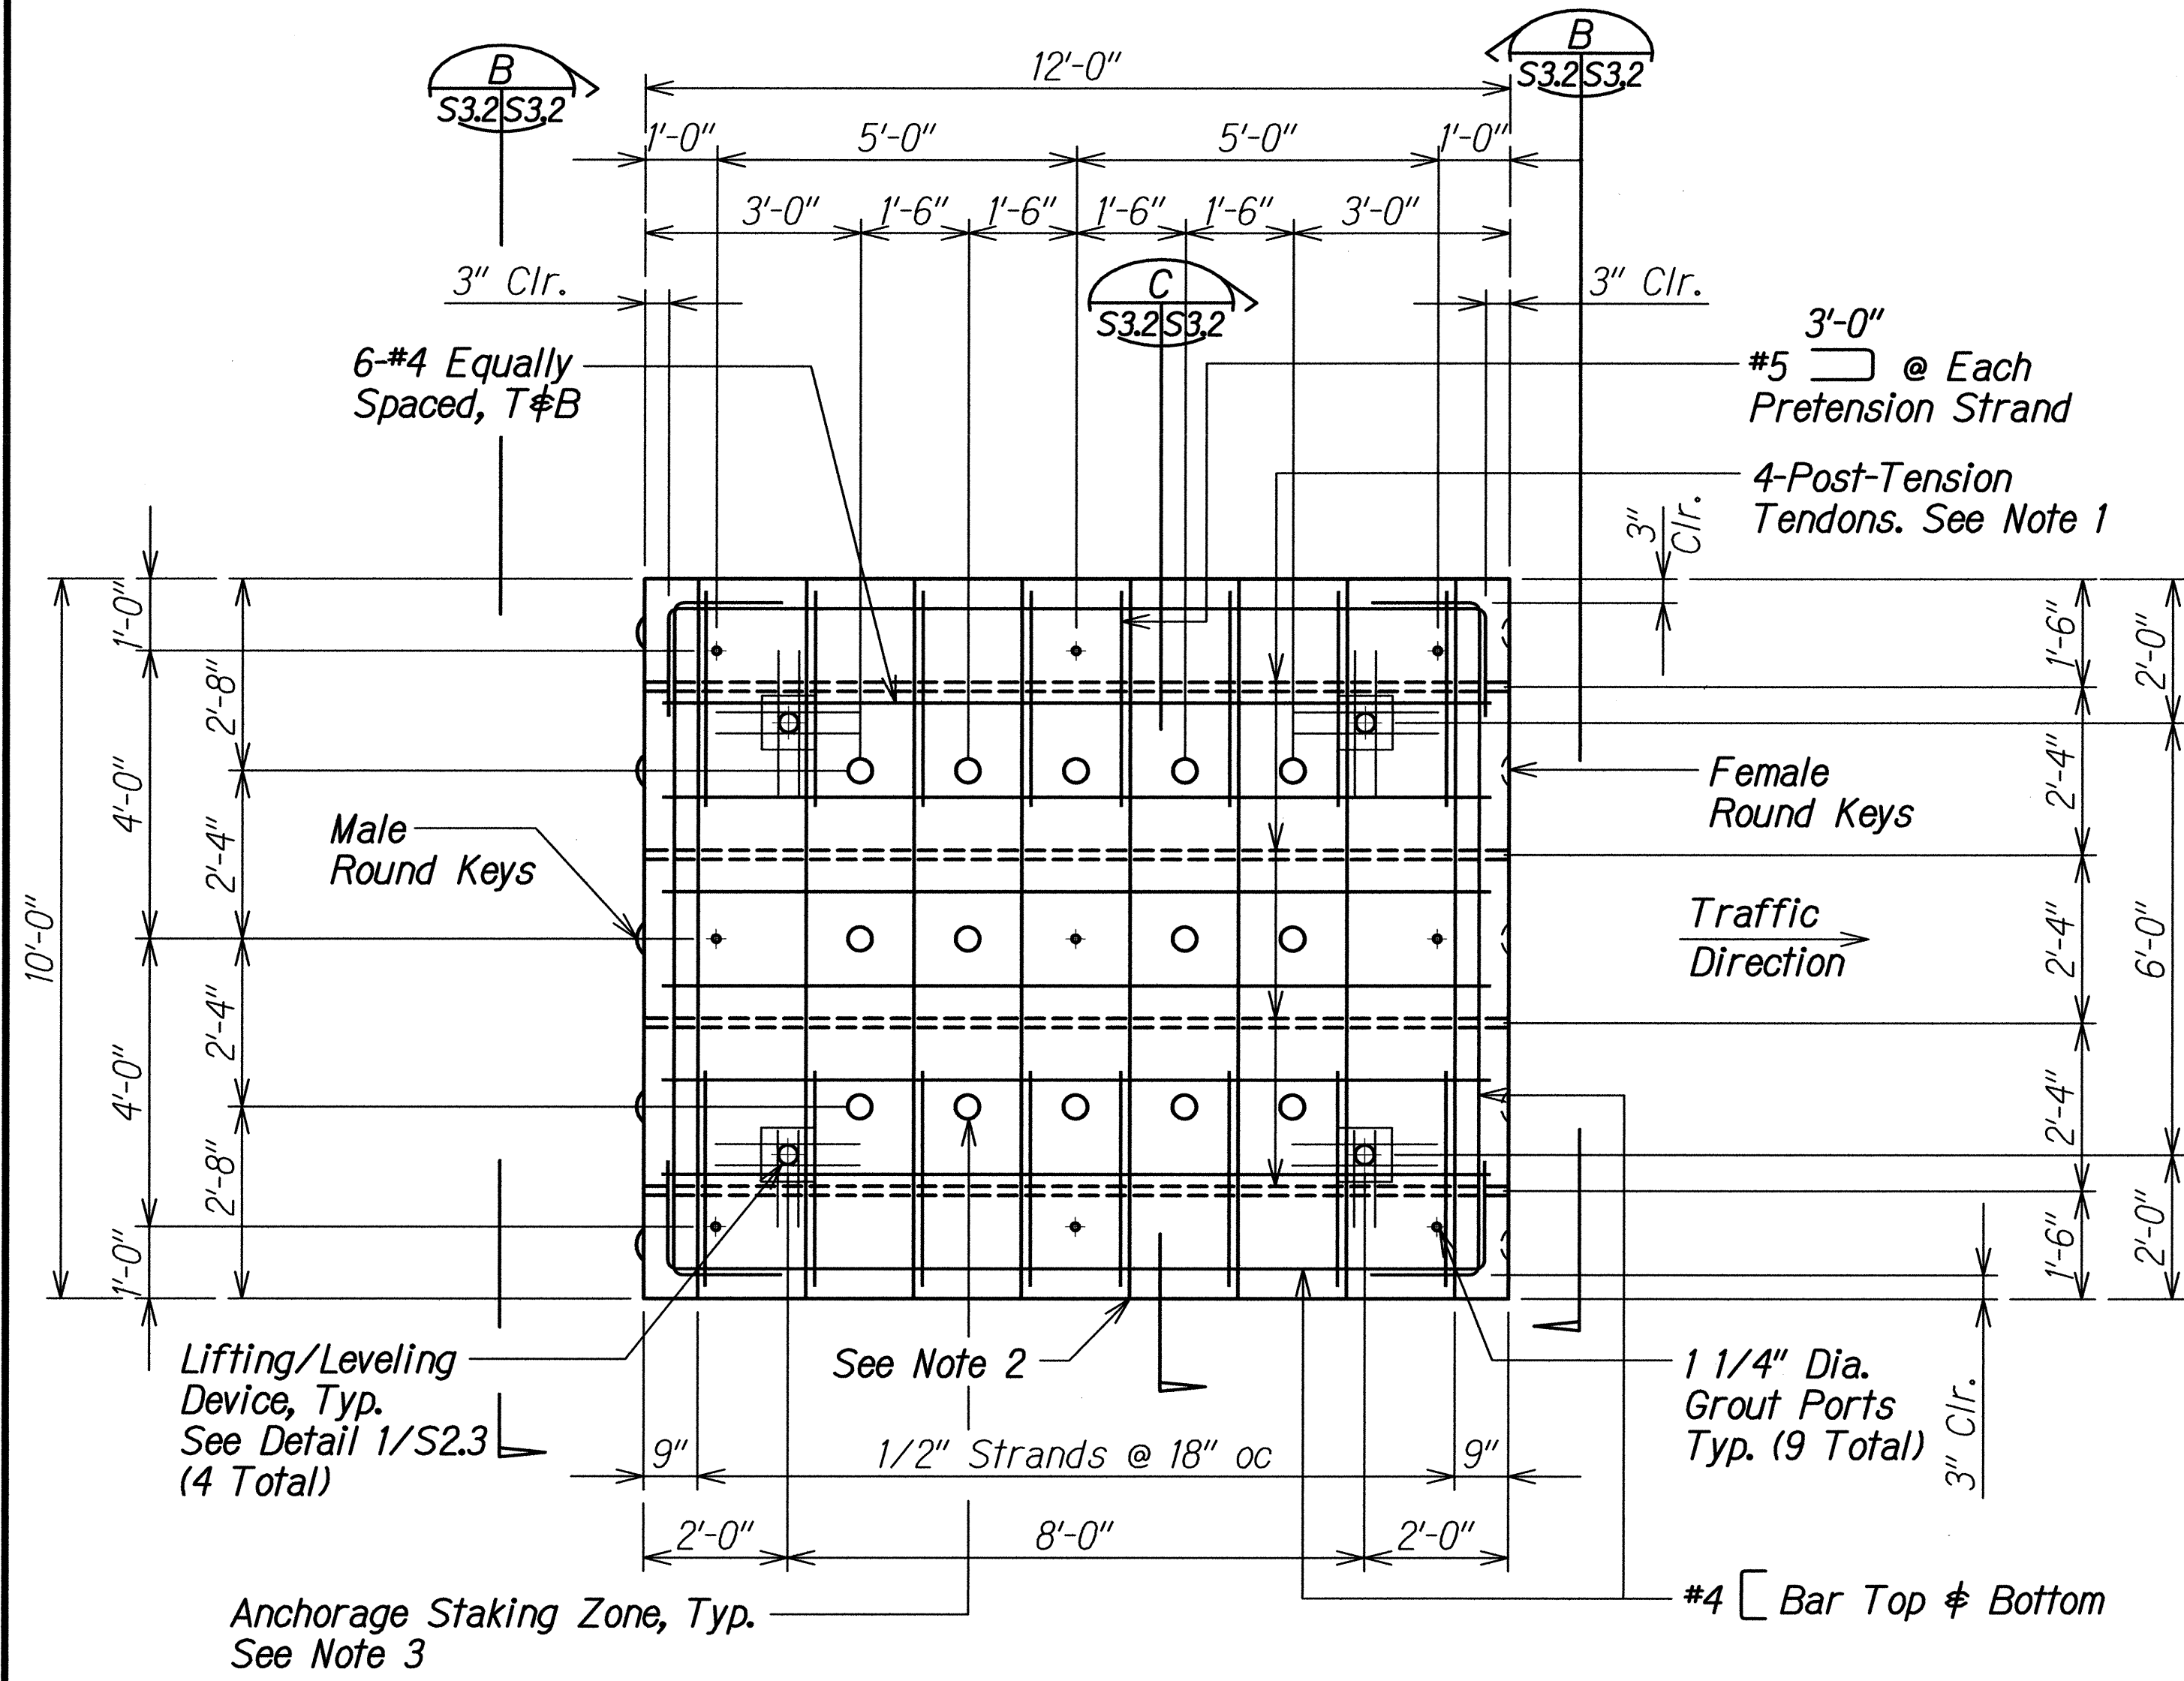


**REBAR MAT (TOP & BOTTOM LAYER)**  
Scale: 1/2" = 1'-0"

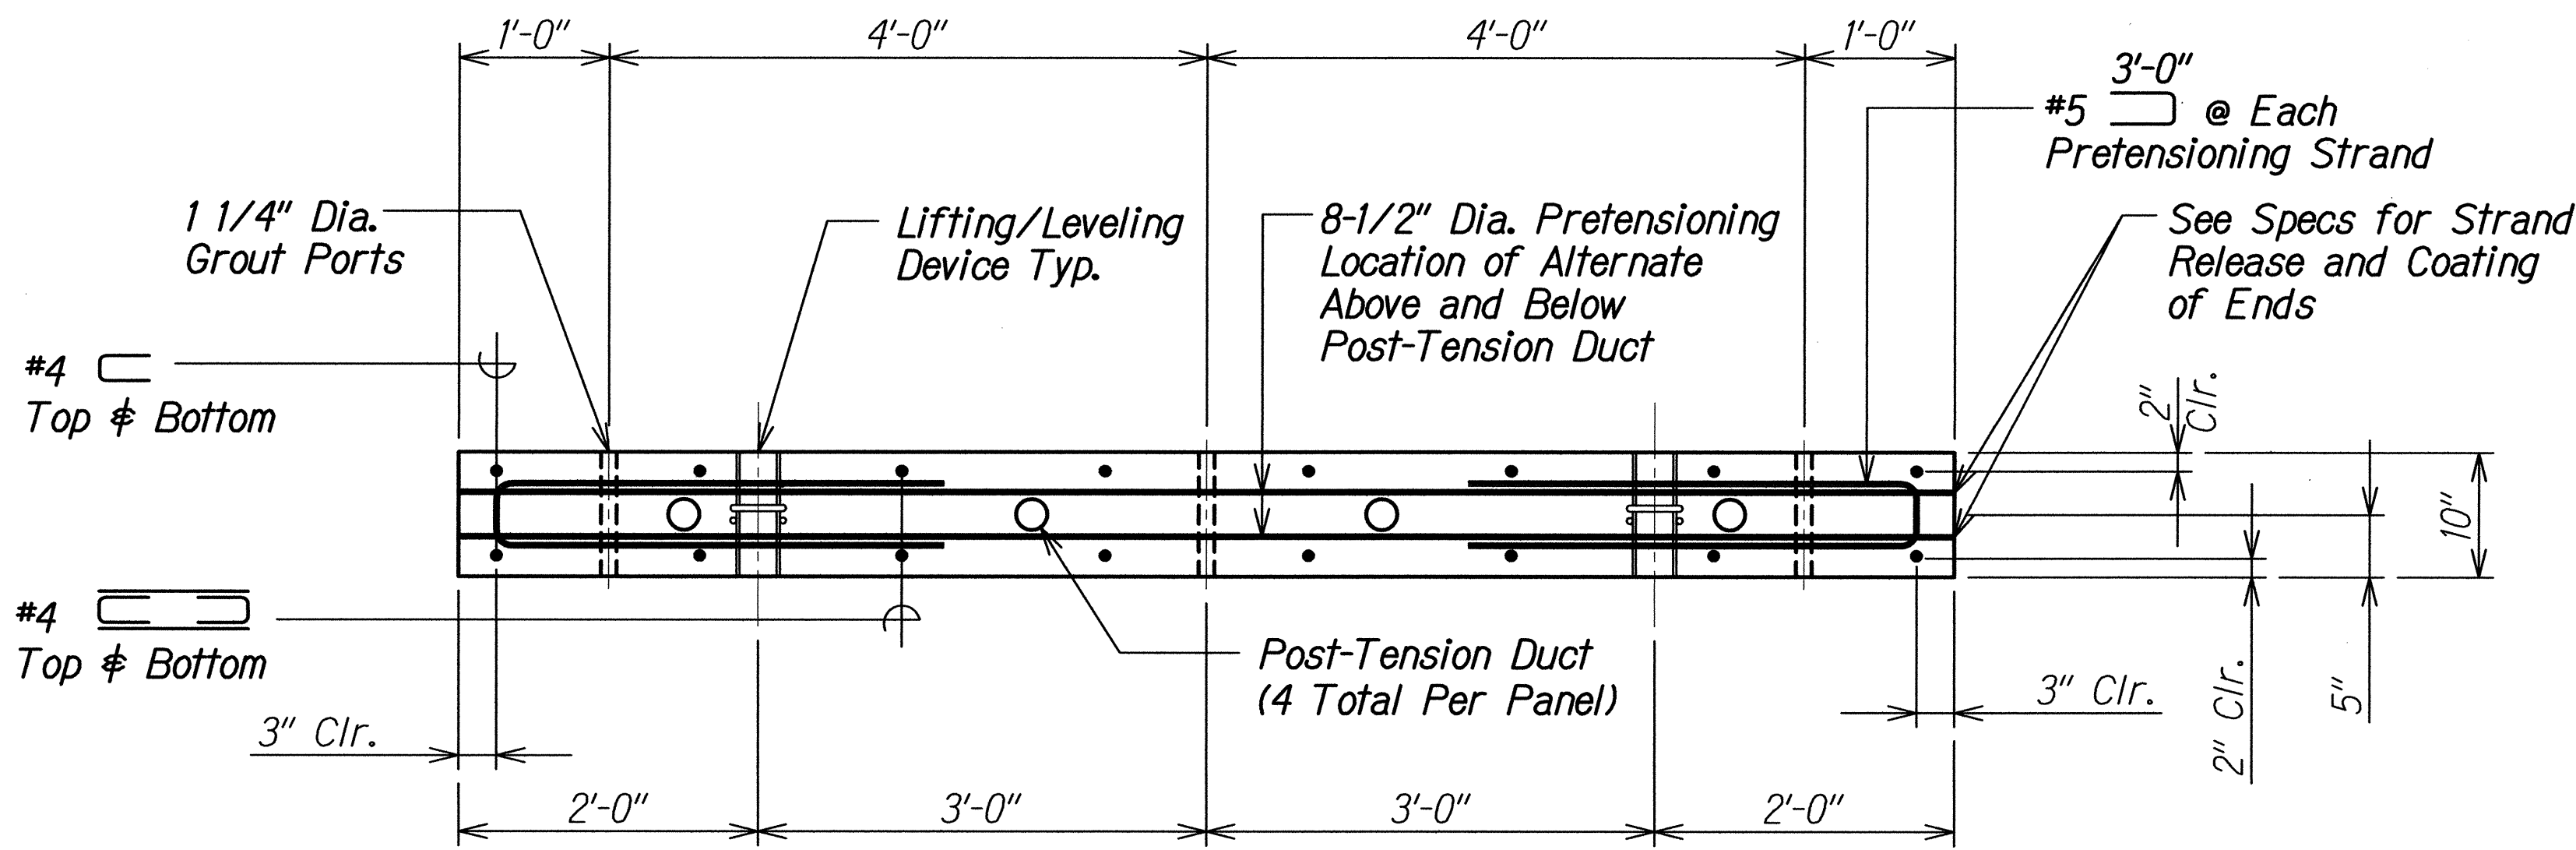

**PRECAST CONCRETE PANEL (PPCP)**  
Scale: 1" = 1'-0"

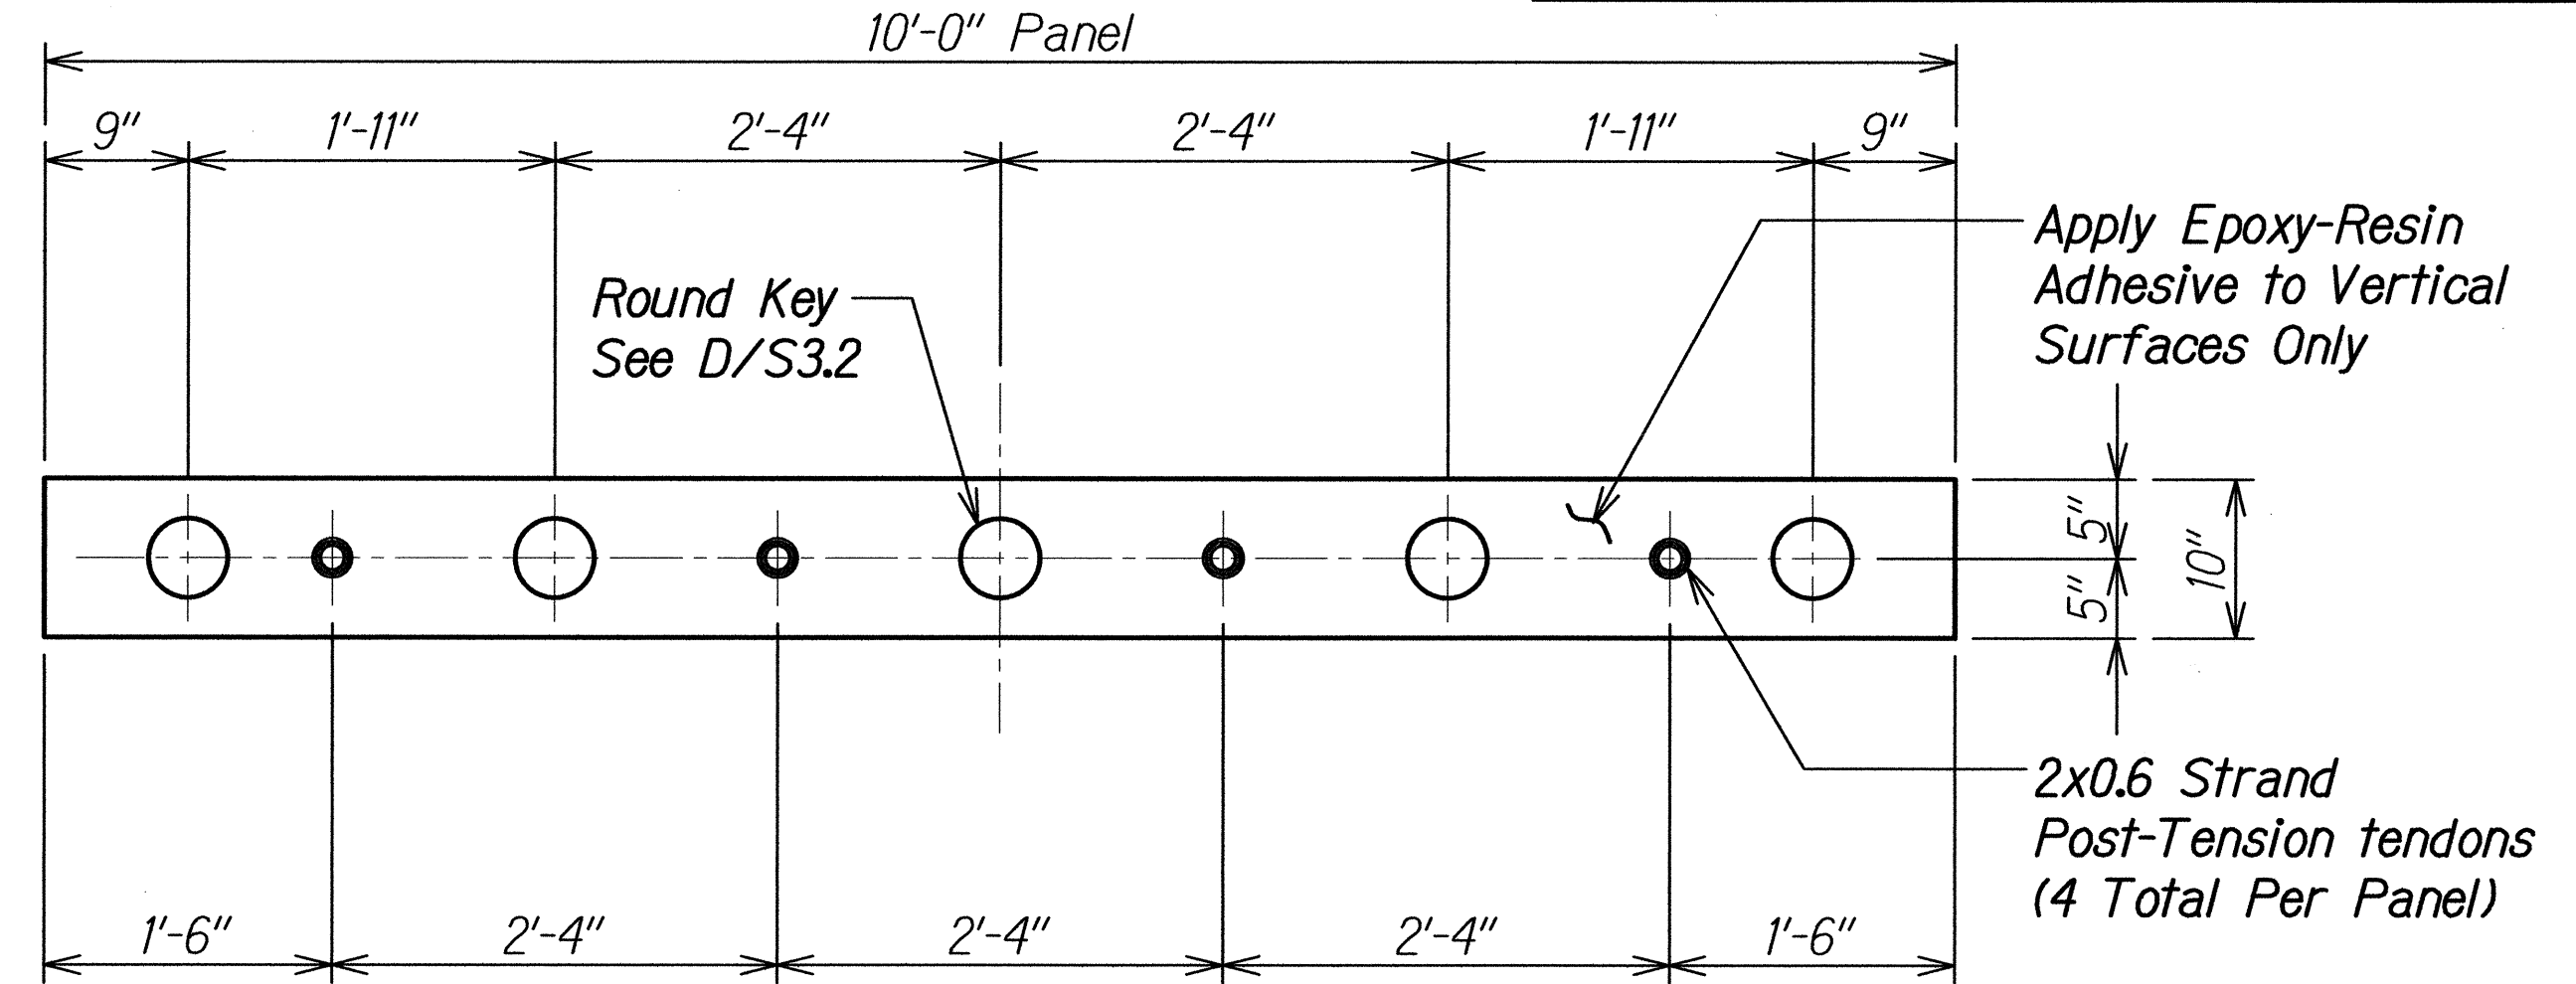

**ROUND KEYS JOINT ELEVATION**  
Scale: 1" = 1'-0"

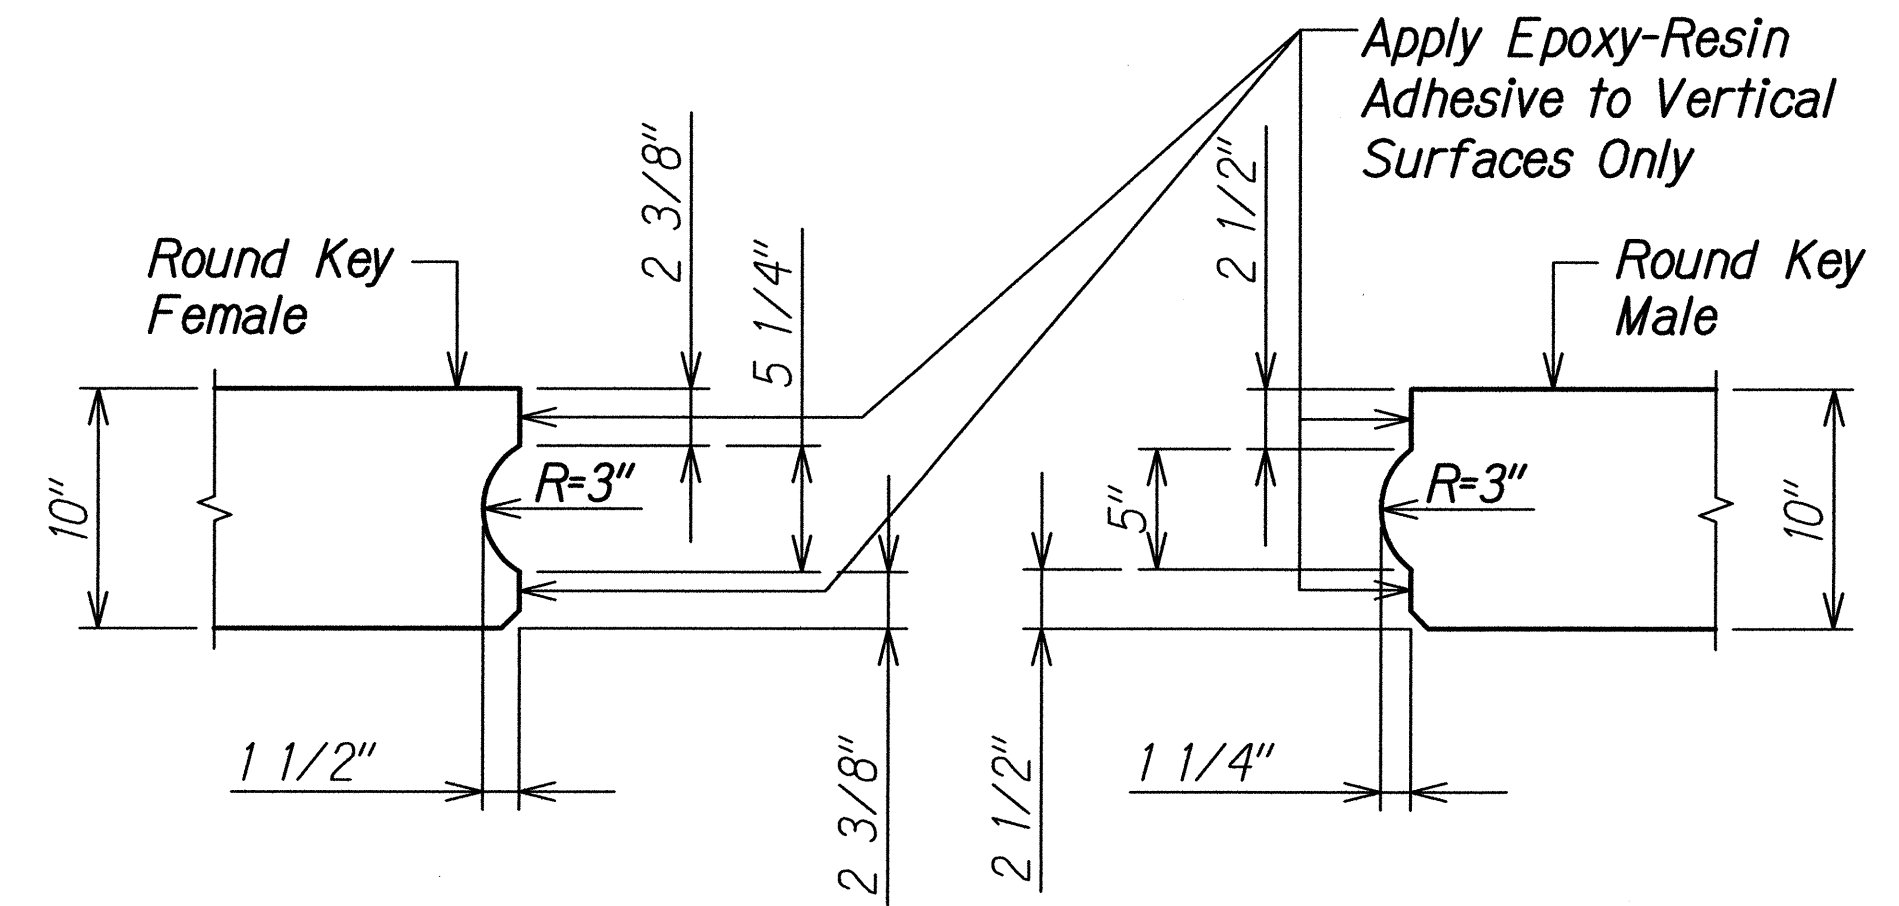

**ROUND KEY JOINT DETAILS**  
Scale: 1 1/2" = 1'-0"

**Notes:**

- Each Post-Tension Tendon shall contain two (2) - 0.6" Dia. Strands. Design Jacking force at end of each 2x0.6 tendon = 88
- Release pretensioning symmetrically starting with middle strands and work outward.
- Contractor to determine location and number of stakes to be used. Anchorage stakes shall have sufficient capacity to prevent any movement of the panels during post-tensioning.

|                   |      |
|-------------------|------|
| SURVEY PLOTTED BY | DATE |
| DRAWN BY          |      |
| DESIGNED BY       |      |
| QUANTITIES BY     |      |
| CHECKED BY        |      |
| ORIGINAL PLAN     |      |
| NOTE BOOK         |      |
| No.               |      |

DRAWING NAME: 2100 ONGONG\12-0331-HFL MIDDLE STREET RECONSTRUCTION-BOTH CAD\06-19-14 BID\HFL-MS301.DWG PLOT TIME: 06:18:14, 7/22 PM

DAVID K. FUJIMURA  
LICENSED PROFESSIONAL ENGINEER  
NO. 8104-S  
HAWAII, U.S.A.

THIS WORK WAS PREPARED BY ME OR UNDER MY SUPERVISION.

Signature: David K. Fujimura  
EXPIRATION DATE OF THE LICENSE: 4-30-16

STATE OF HAWAII  
DEPARTMENT OF TRANSPORTATION  
HIGHWAYS DIVISION

**TYPICAL PPCP INTERIOR PANEL**

**DETAILS**


MIDDLE STREET PAVEMENT RECONSTRUCTION  
North King Street to Kamehameha Highway  
FAP NO. STP-7415(001)

Scale: As Noted Date: Jun. 20, 2014

SHEET No. S32 OF 12 SHEETS




| FED. ROAD DIST. NO. | STATE | FEDERAL AID PROJ. NO. | FISCAL YEAR | SHEET NO. | TOTAL SHEETS |
|---------------------|-------|-----------------------|-------------|-----------|--------------|
| HAWAII              | HAW.  | STP-7415(001)         | 2014        | 140       | 173          |

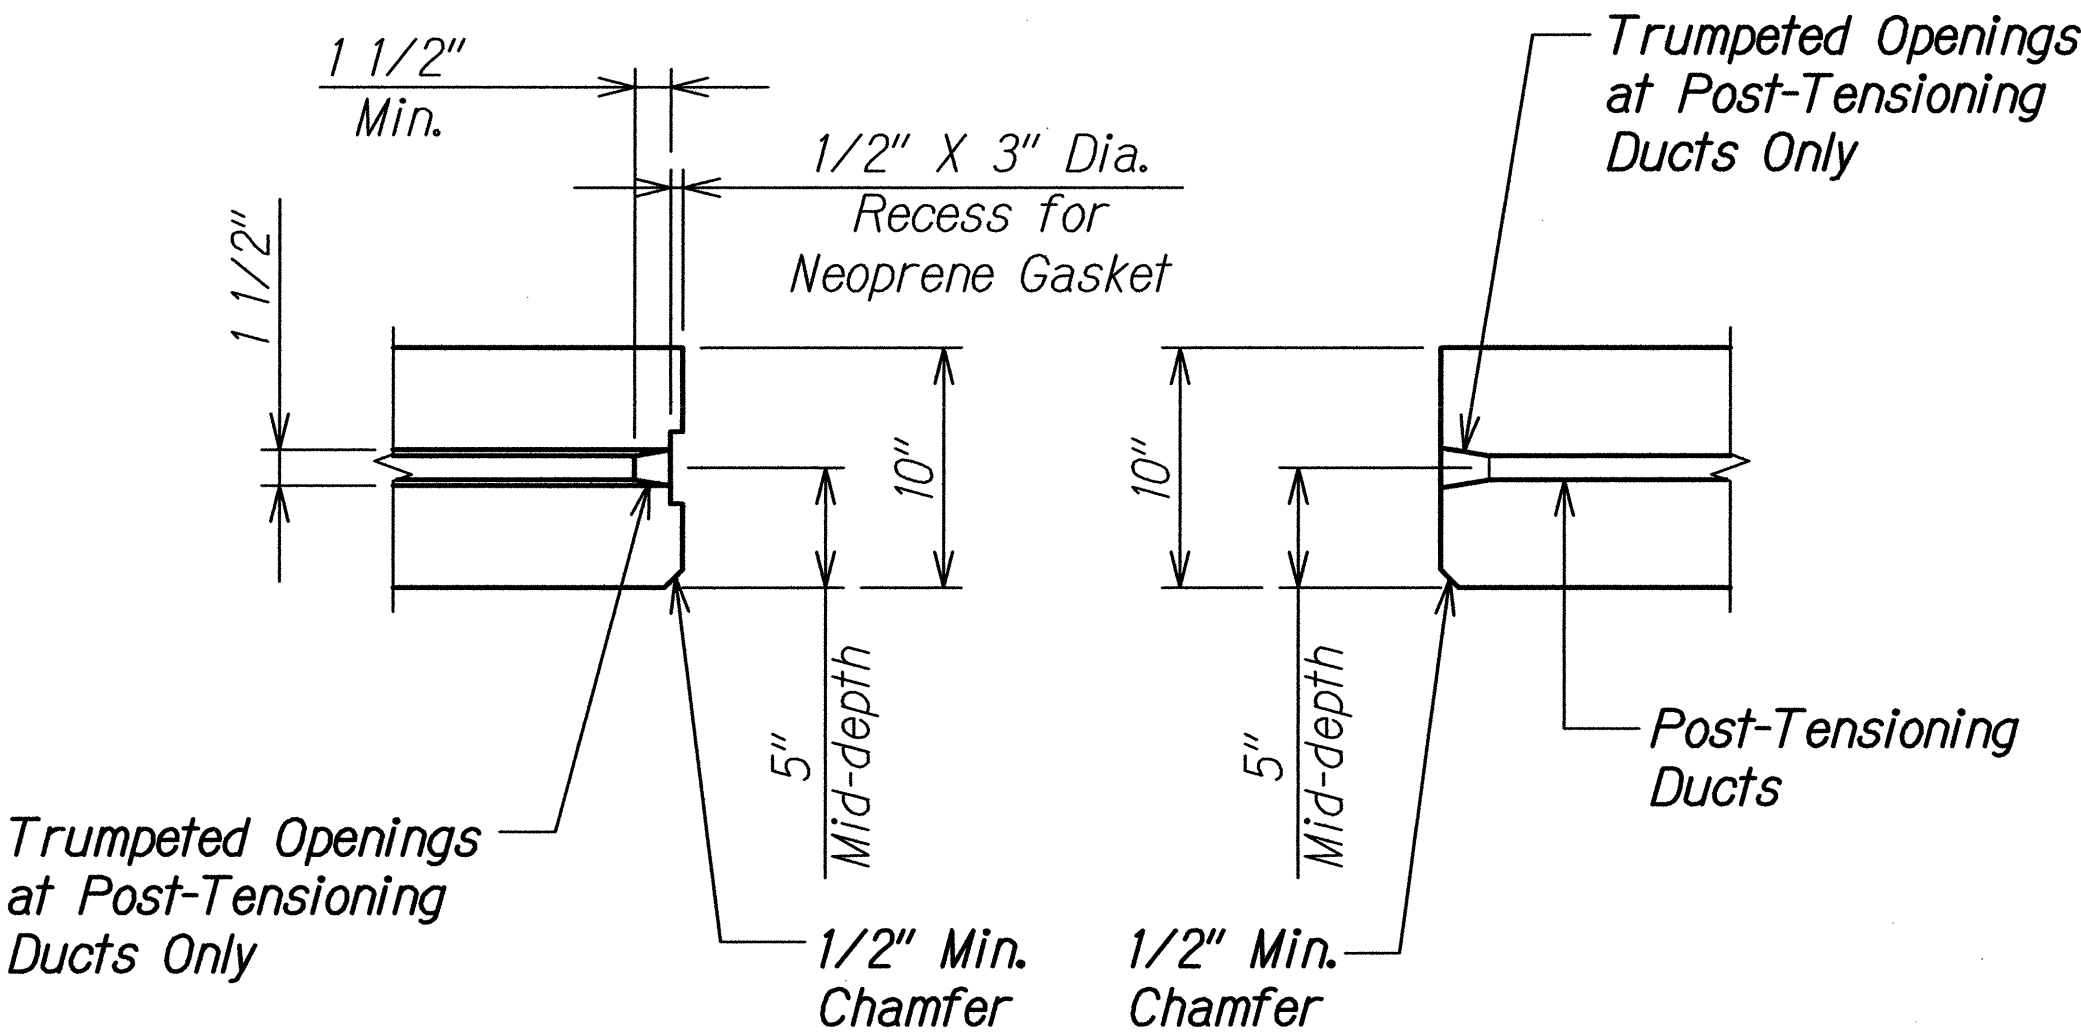

POST-TENSIONING DUCTS  
AT PANEL JOINTS

Not to Scale


1  
S3.3 S3.3

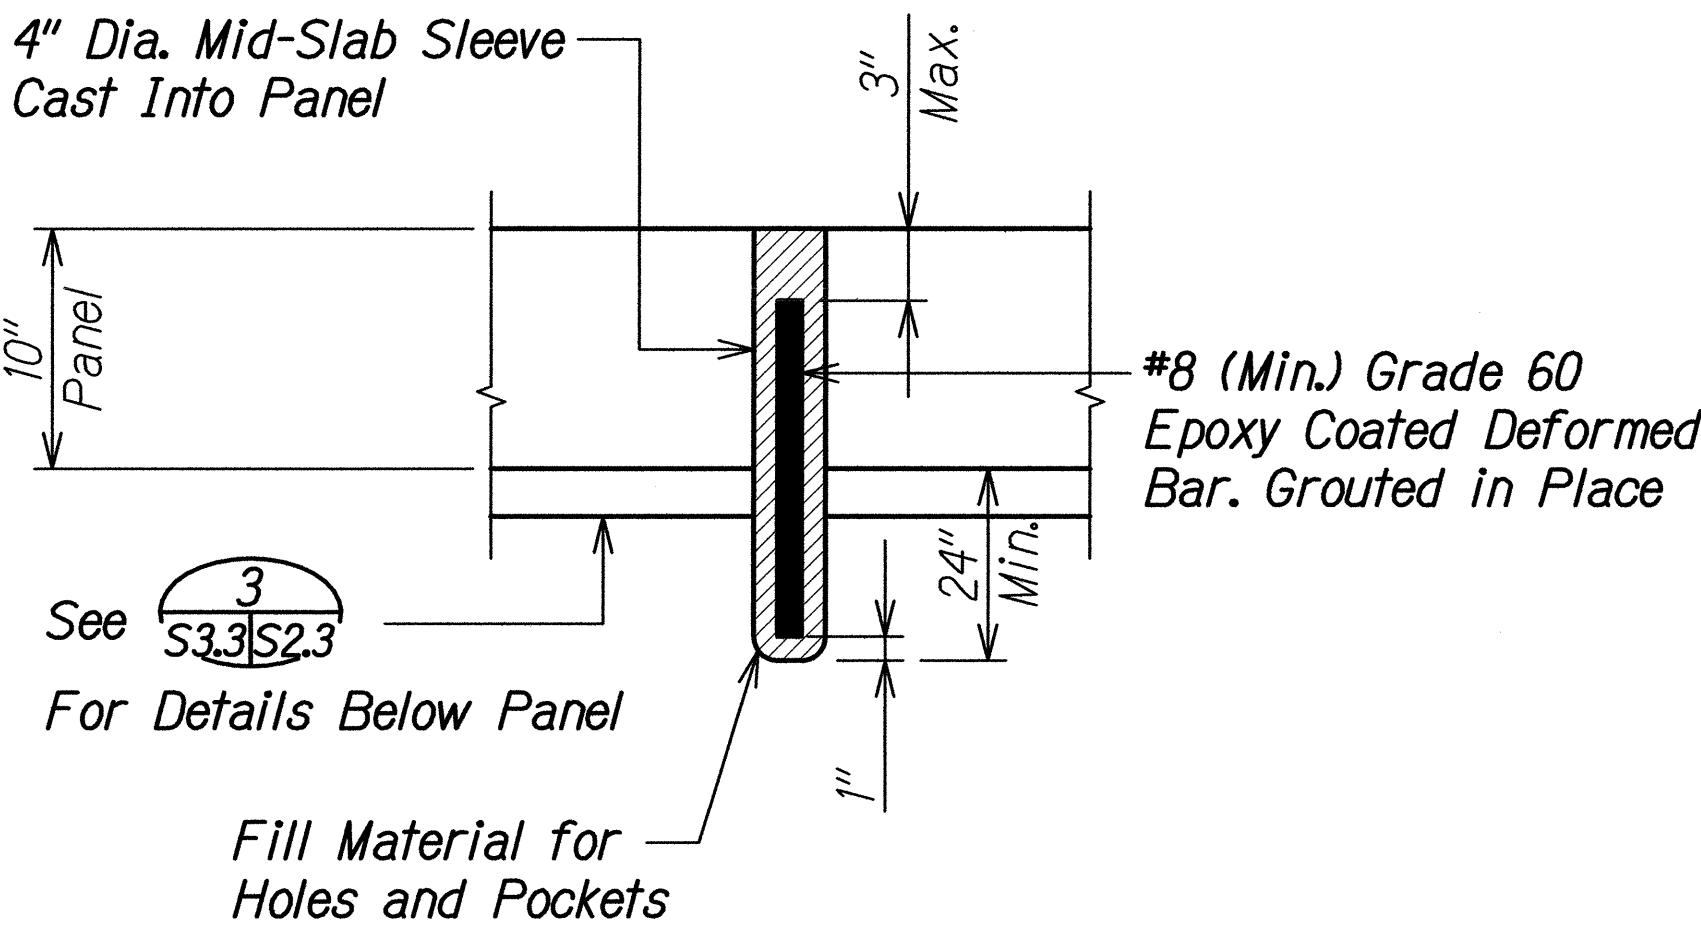

FINAL ANCHOR STAKING DETAIL

Not to Scale

2  
S3.3 S3.3

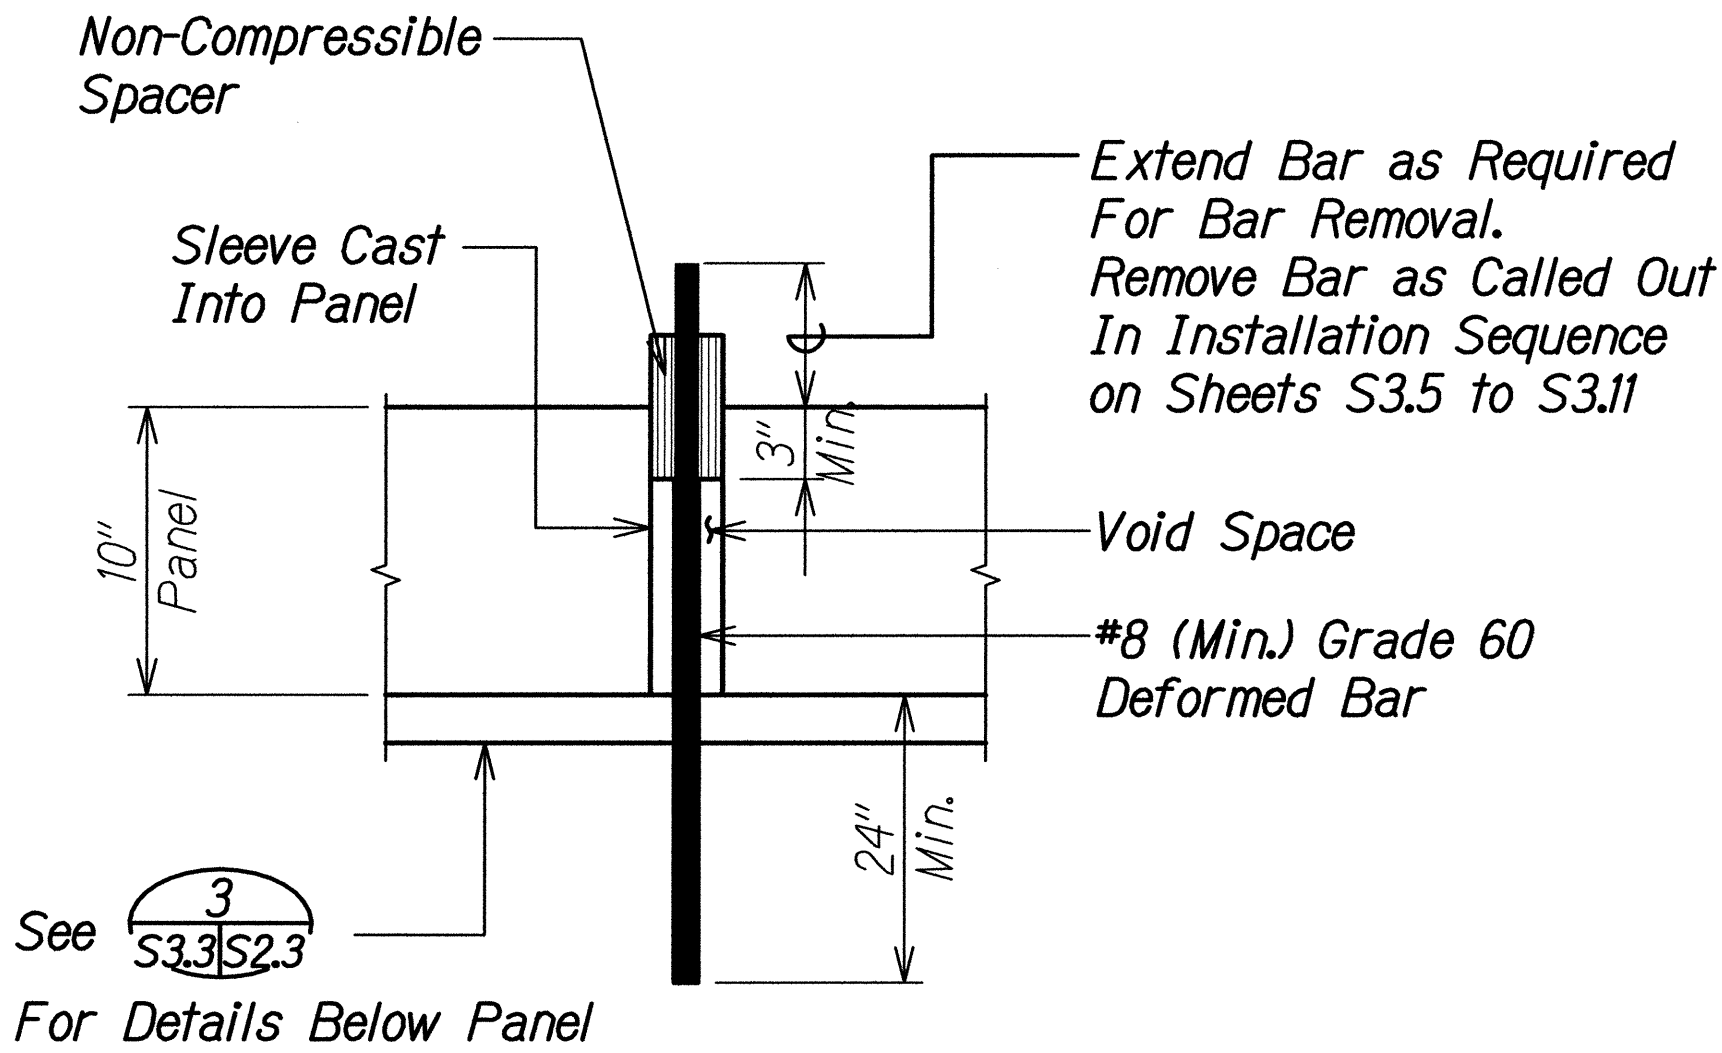


TEMPORARY ANCHOR STAKING DETAIL

Not to Scale

3  
S3.3 S3.3

|               |      |
|---------------|------|
| ORIGINAL PLAN | DATE |
| DESIGNED BY   |      |
| TRACED BY     |      |
| QUANTITIES BY |      |
| CHECKED BY    |      |
| NO.           |      |

DRAWING NAME: 2100 ONCONC12-033-1-HFL MIDDLE STREET RECONSTRUCTION-DOTD(CAD)06-19-14 BID\HFL-MS03.DWG PLOT TIME: 06-18-14, 7:23 PM)

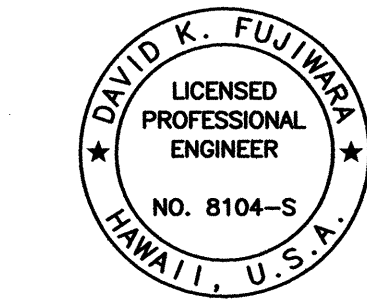


THIS WORK WAS PREPARED BY  
ME OR UNDER MY SUPERVISION.

SIGNATURE: *David K. Fujiwara*  
EXPIRATION DATE OF THE LICENSE: 4-30-16


STATE OF HAWAII  
DEPARTMENT OF TRANSPORTATION  
HIGHWAYS DIVISION  
**TYPICAL PPCP DETAILS**  
MIDDLE STREET PAVEMENT RECONSTRUCTION  
North King Street to Kamehameha Highway  
FAP NO. STP-7415(001)  
Scale: As Noted Date: Jun. 20, 2014  
SHEET No. S3.3 OF 12 SHEETS



| FED. ROAD DIST. NO. | STATE | FEDERAL AID PROJ. NO. | FISCAL YEAR | SHEET NO. | TOTAL SHEETS |
|---------------------|-------|-----------------------|-------------|-----------|--------------|
| HAWAII              | HAW.  | STP-7415(001)         | 2014        | 141       | 173          |

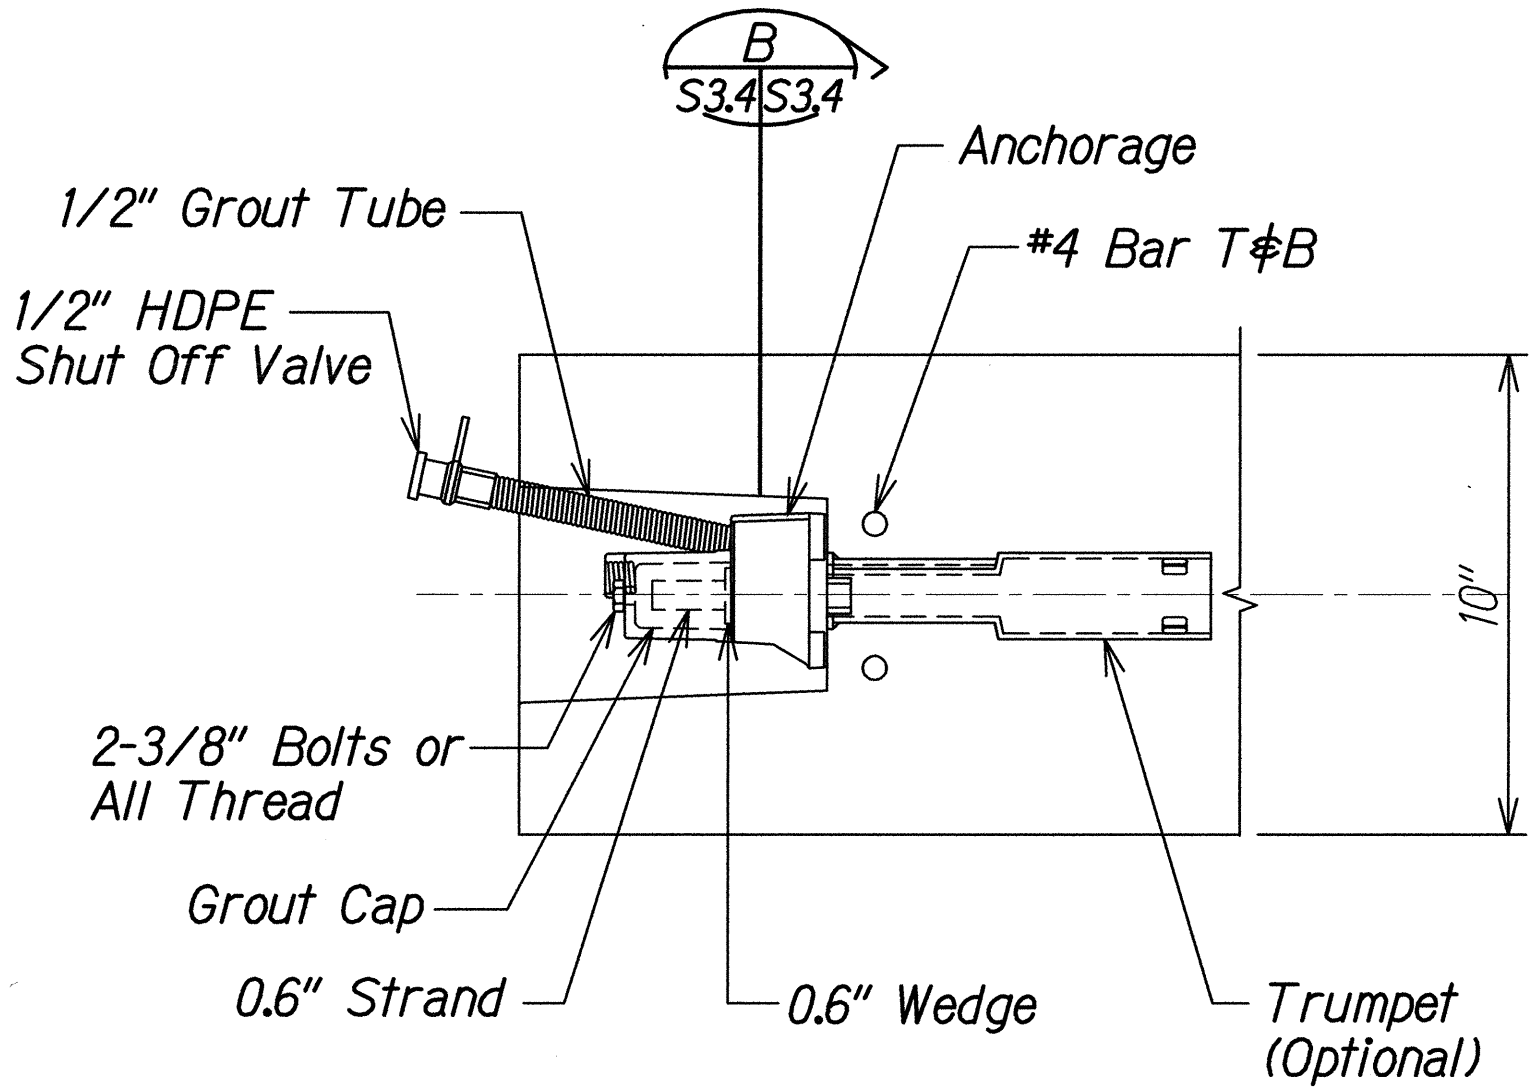

SECTION - 2 x 0.6" ANCHORAGE SYSTEM  
Not to Scale

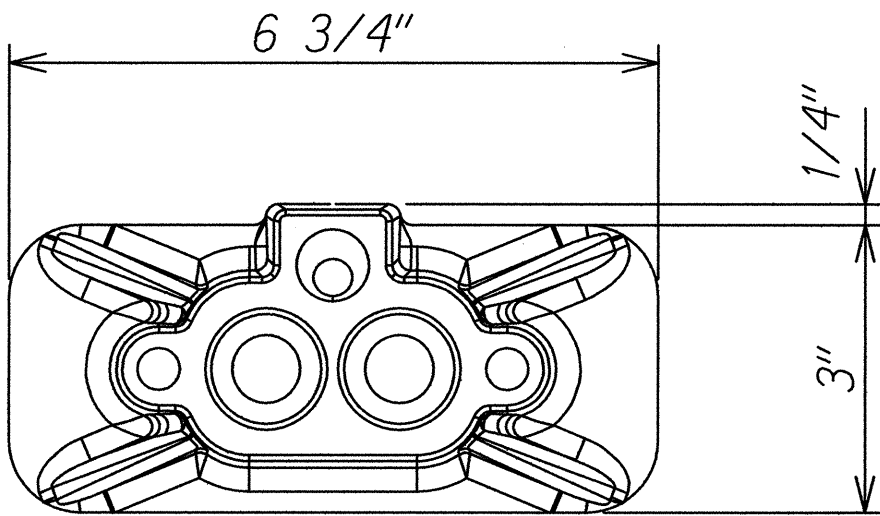


SECTION - 2 x 0.6" ANCHORAGE SYSTEM  
Not to Scale

- Notes:**
1. Anchorage system is for illustrative purposed only. Contractor shall submit proposed anchorage system for 2 x 0.6" strand tendon for approval.
  2. See Note 9.(FX10) on sheet S0.3 for anchorage protection and blockout fill material.

|               |                   |      |
|---------------|-------------------|------|
| ORIGINAL PLAN | SURVEY PLOTTED BY | DATE |
| NOTE BOOK     | DESIGNED BY       |      |
| No.           | QUANTITIES BY     |      |
|               | CHECKED BY        |      |

DRAWING NAME: 2100-ONGONG\12-033-1-HFL MIDDLE STREET RECONSTRUCTION-DOTH(CAD)06-19-14 BID\HFL-MS03.DWG PLOT TIME: 06-19-14, 9:56 AM

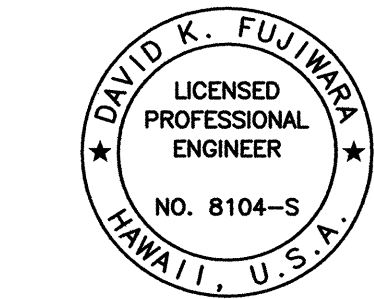


THIS WORK WAS PREPARED BY  
ME OR UNDER MY SUPERVISION.

*David K. Fujiwara*  
SIGNATURE EXPIRATION DATE OF THE LICENSE: 4-30-16

STATE OF HAWAII  
DEPARTMENT OF TRANSPORTATION  
HIGHWAYS DIVISION  
**TYPICAL PPCP ANCHORAGE**  
**SYSTEM DETAILS**  
MIDDLE STREET PAVEMENT RECONSTRUCTION  
North King Street to Kamehameha Highway  
FAP NO. STP-7415(001)  
Scale: As Noted Date: Jun. 20, 2014  
SHEET No. S34 OF 12 SHEETS



| FED. ROAD DIST. NO. | STATE | FEDERAL AID PROJ. NO. | FISCAL YEAR | SHEET NO. | TOTAL SHEETS |
|---------------------|-------|-----------------------|-------------|-----------|--------------|
| HAWAII              | HAW.  | STP-7415(001)         | 2014        | 142       | 173          |

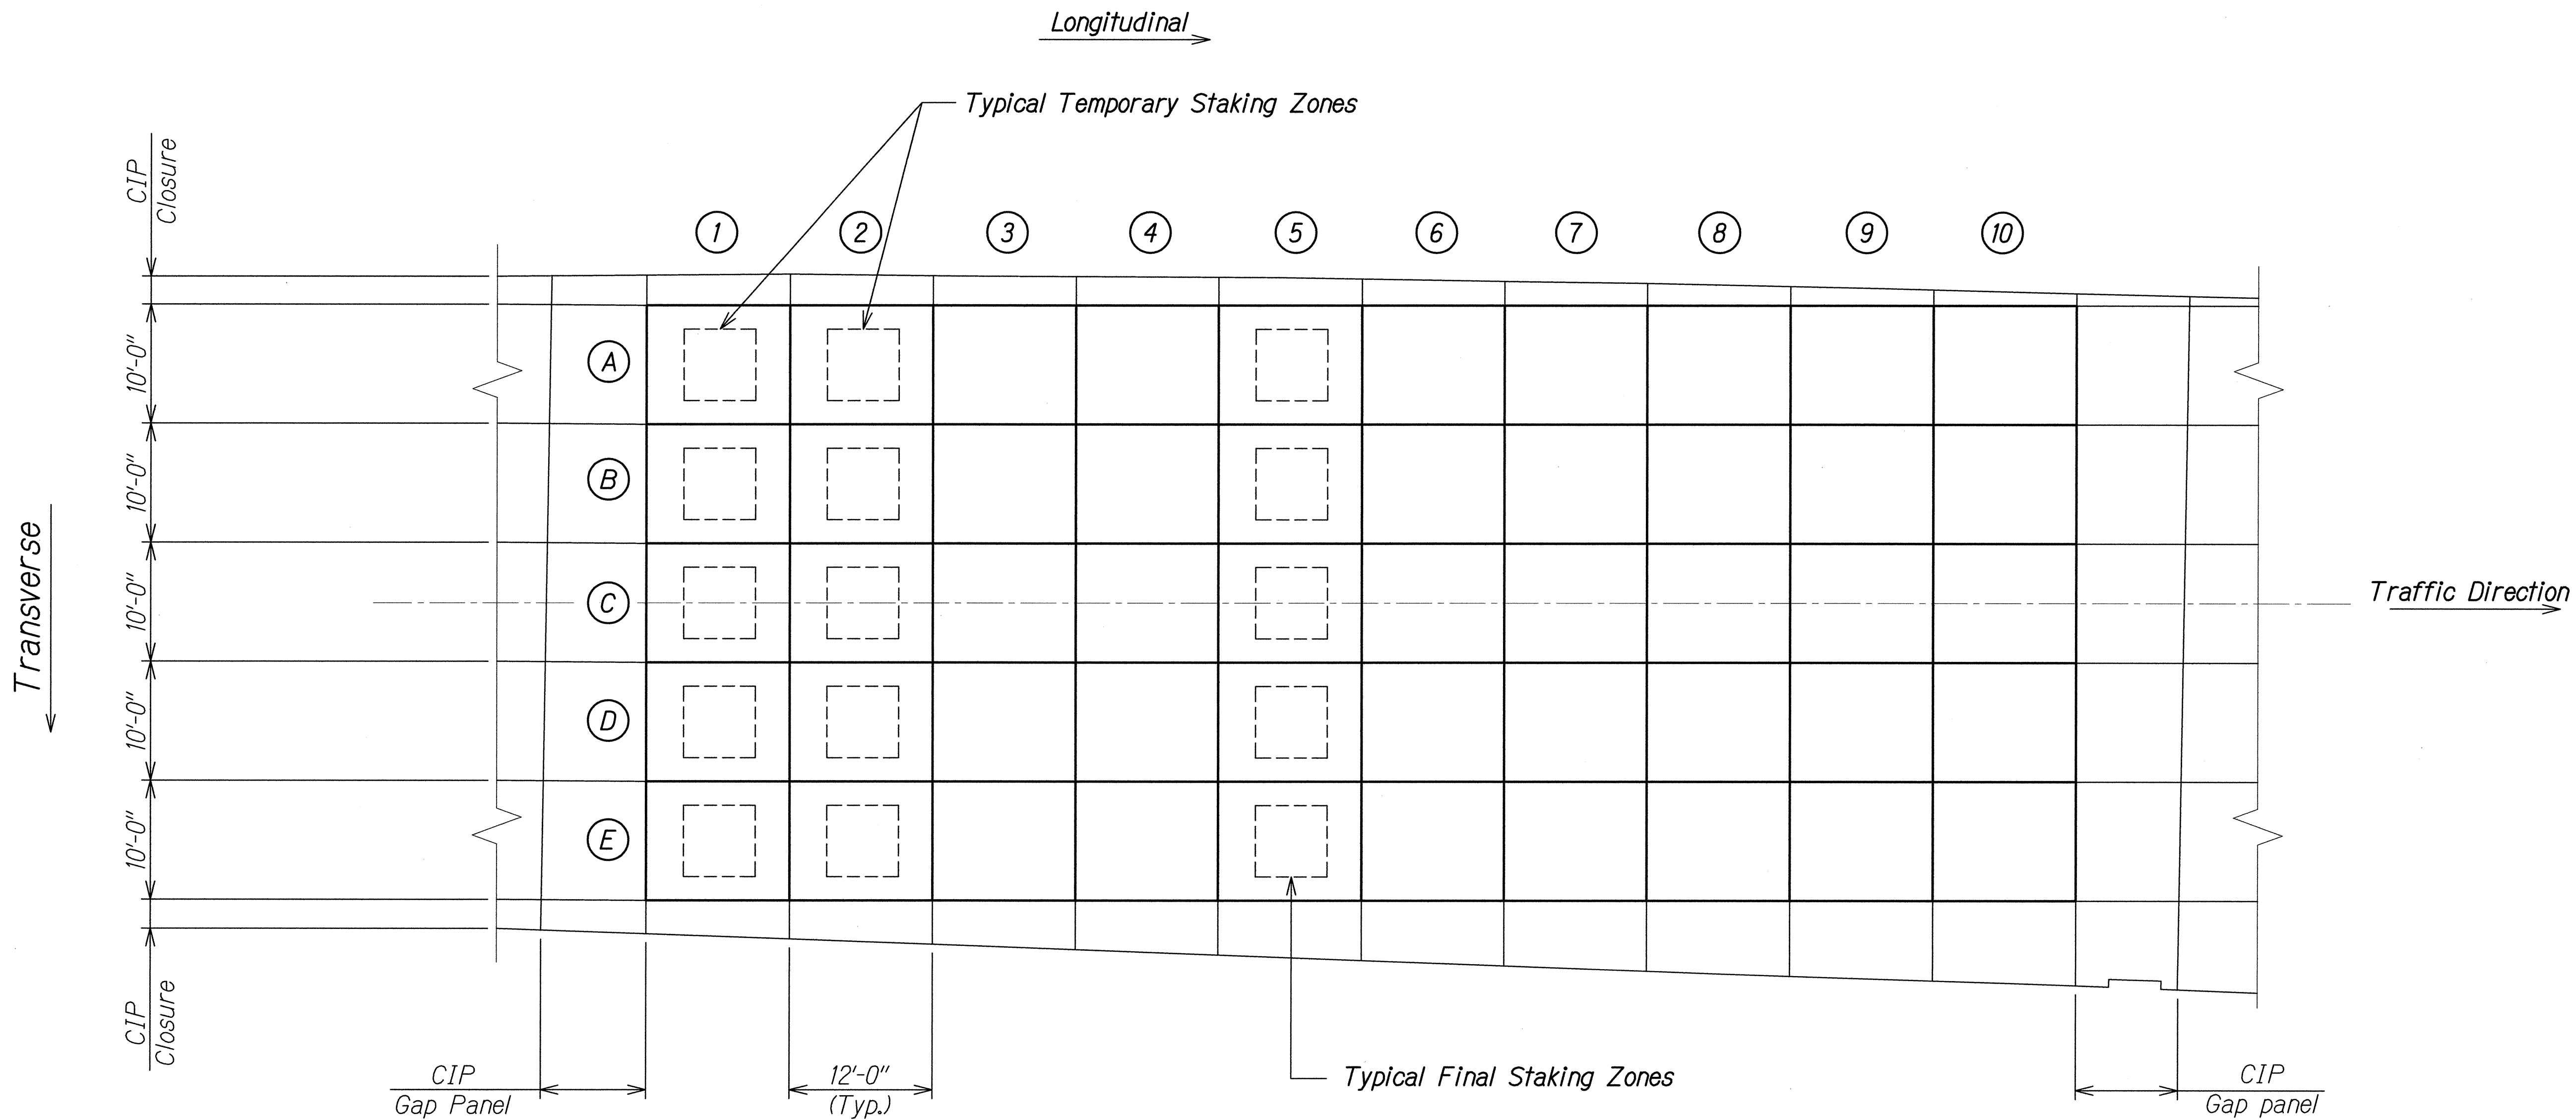

Legend:


- ① Column Designations
- Ⓐ Row Designations

TYPICAL POST-TENSION SEGMENT LAYOUT PLAN

Scale: 1/8" = 1'-0"

|               |                   |      |
|---------------|-------------------|------|
| ORIGINAL PLAN | SURVEY PLOTTED BY | DATE |
| NOTE BOOK     | DESIGNED BY       |      |
| No.           | QUANTITIES BY     |      |
|               | CHECKED BY        |      |

DRAWING NAME: Z:\06 ONGOING\12-0331-HFL MIDDLE STREET RECONSTRUCTION-001\CAU\06-19-14 BID\VEL-MS305 TO MS311.DWG PLOT TIME: 06-19-14, 8:28 AM

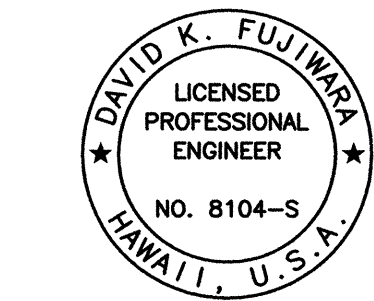

THIS WORK WAS PREPARED BY ME OR UNDER MY SUPERVISION.

Signature: David K. Fujiwara  
4-30-16  
SIGNATURE EXPIRATION DATE OF THE LICENSE

STATE OF HAWAII  
DEPARTMENT OF TRANSPORTATION  
HIGHWAYS DIVISION

**TYPICAL PPCP PANEL  
LAYOUT PLAN**





MIDDLE STREET PAVEMENT RECONSTRUCTION  
North King Street to Kamehameha Highway  
FAP NO. STP-7415(001)

Scale: As Noted Date: Jun. 20, 2014

SHEET No. S3.5 OF 12 SHEETS



| FED. ROAD DIST. NO. | STATE | FEDERAL AID PROJ. NO. | FISCAL YEAR | SHEET NO. | TOTAL SHEETS |
|---------------------|-------|-----------------------|-------------|-----------|--------------|
| HAWAII              | HAW.  | STP-7415(001)         | 2014        | 143       | 173          |

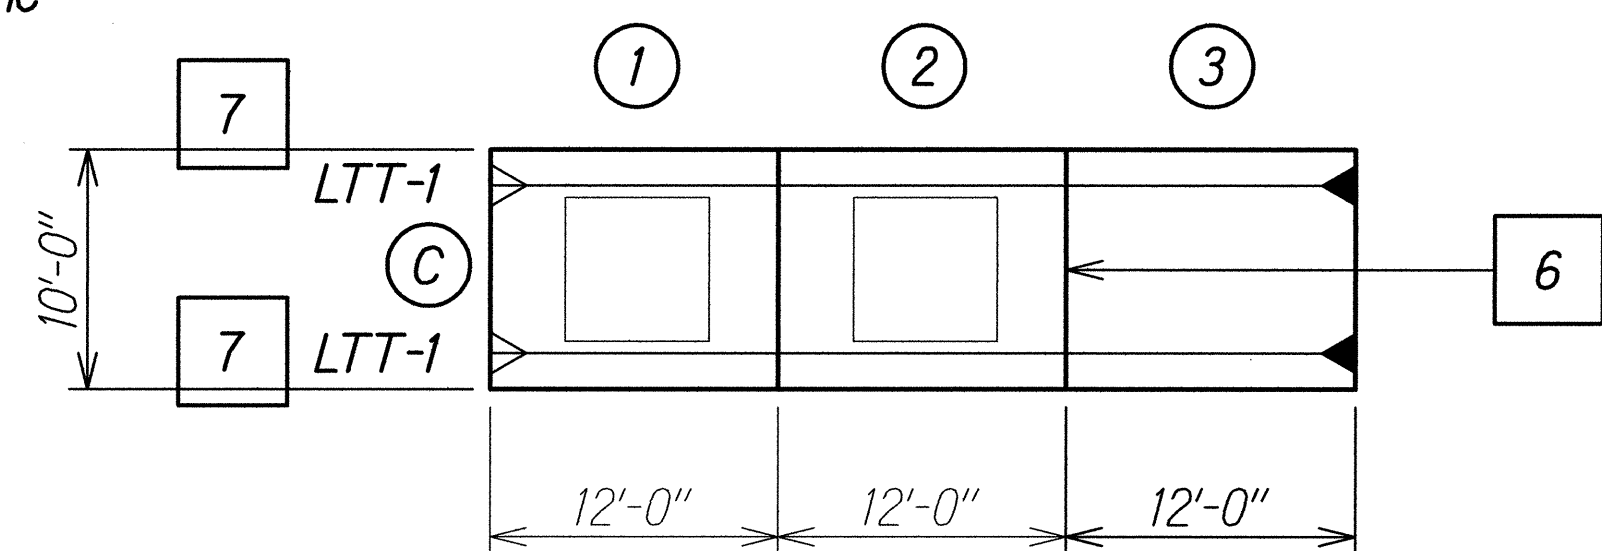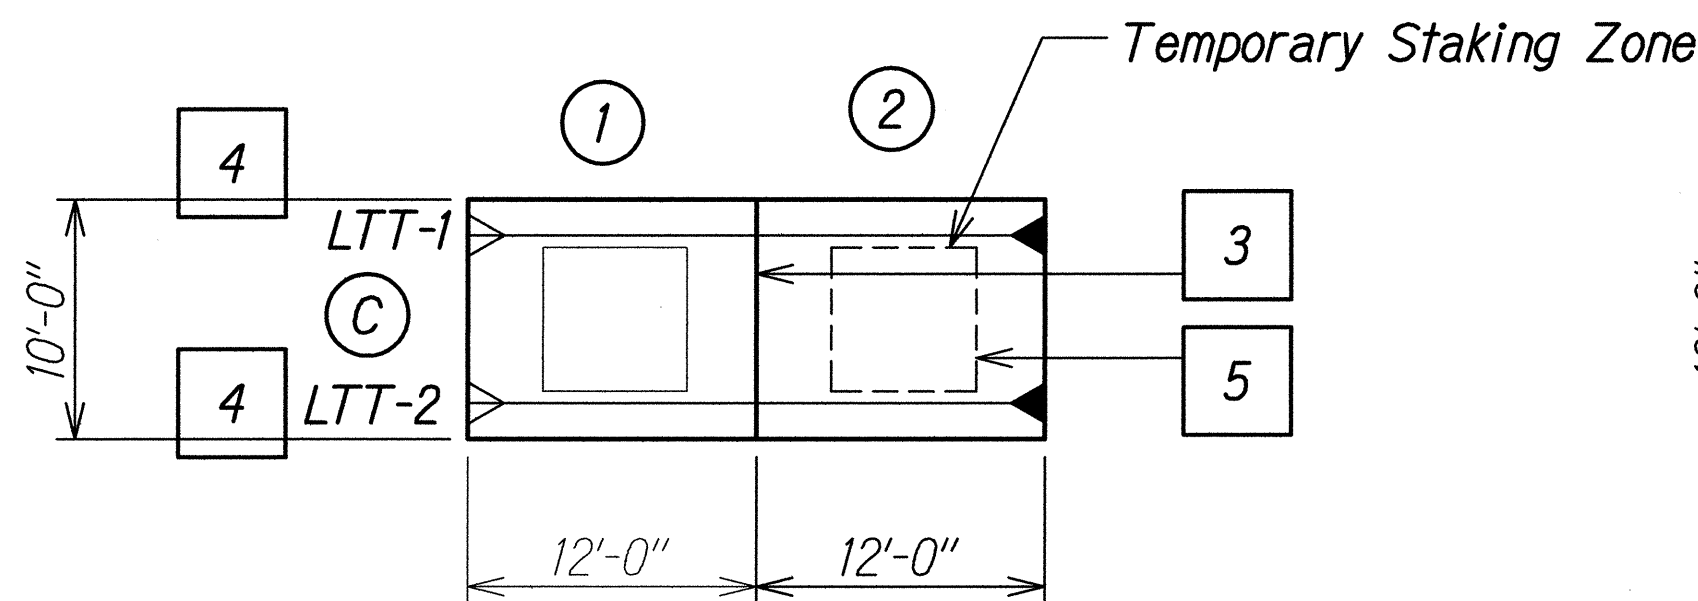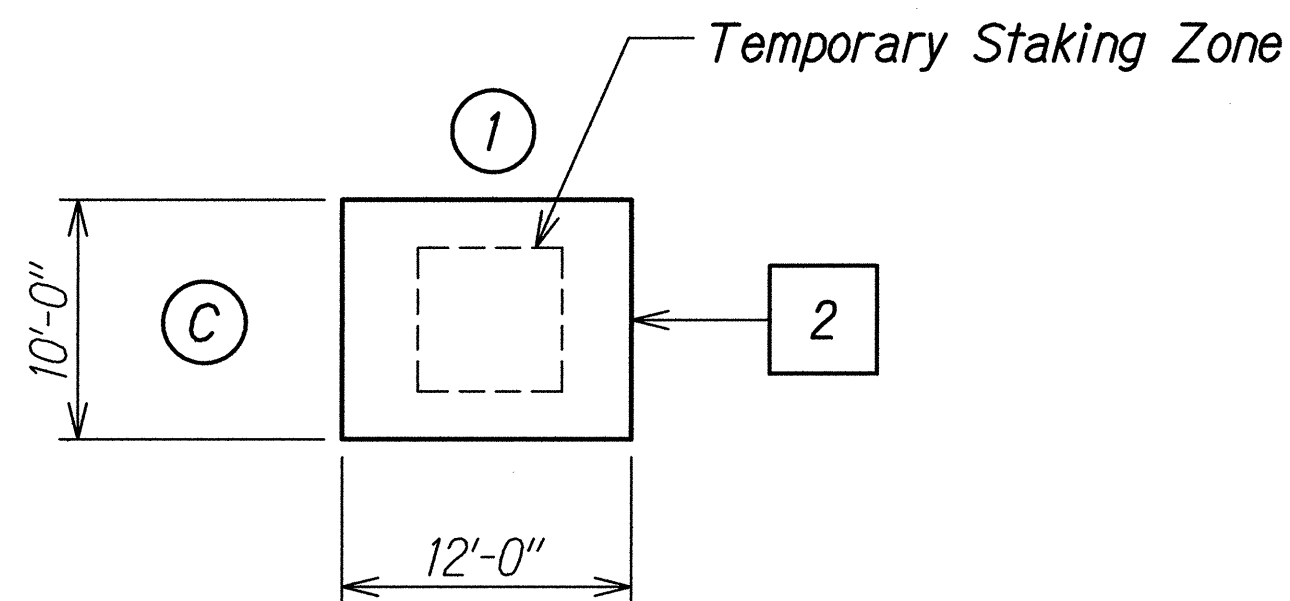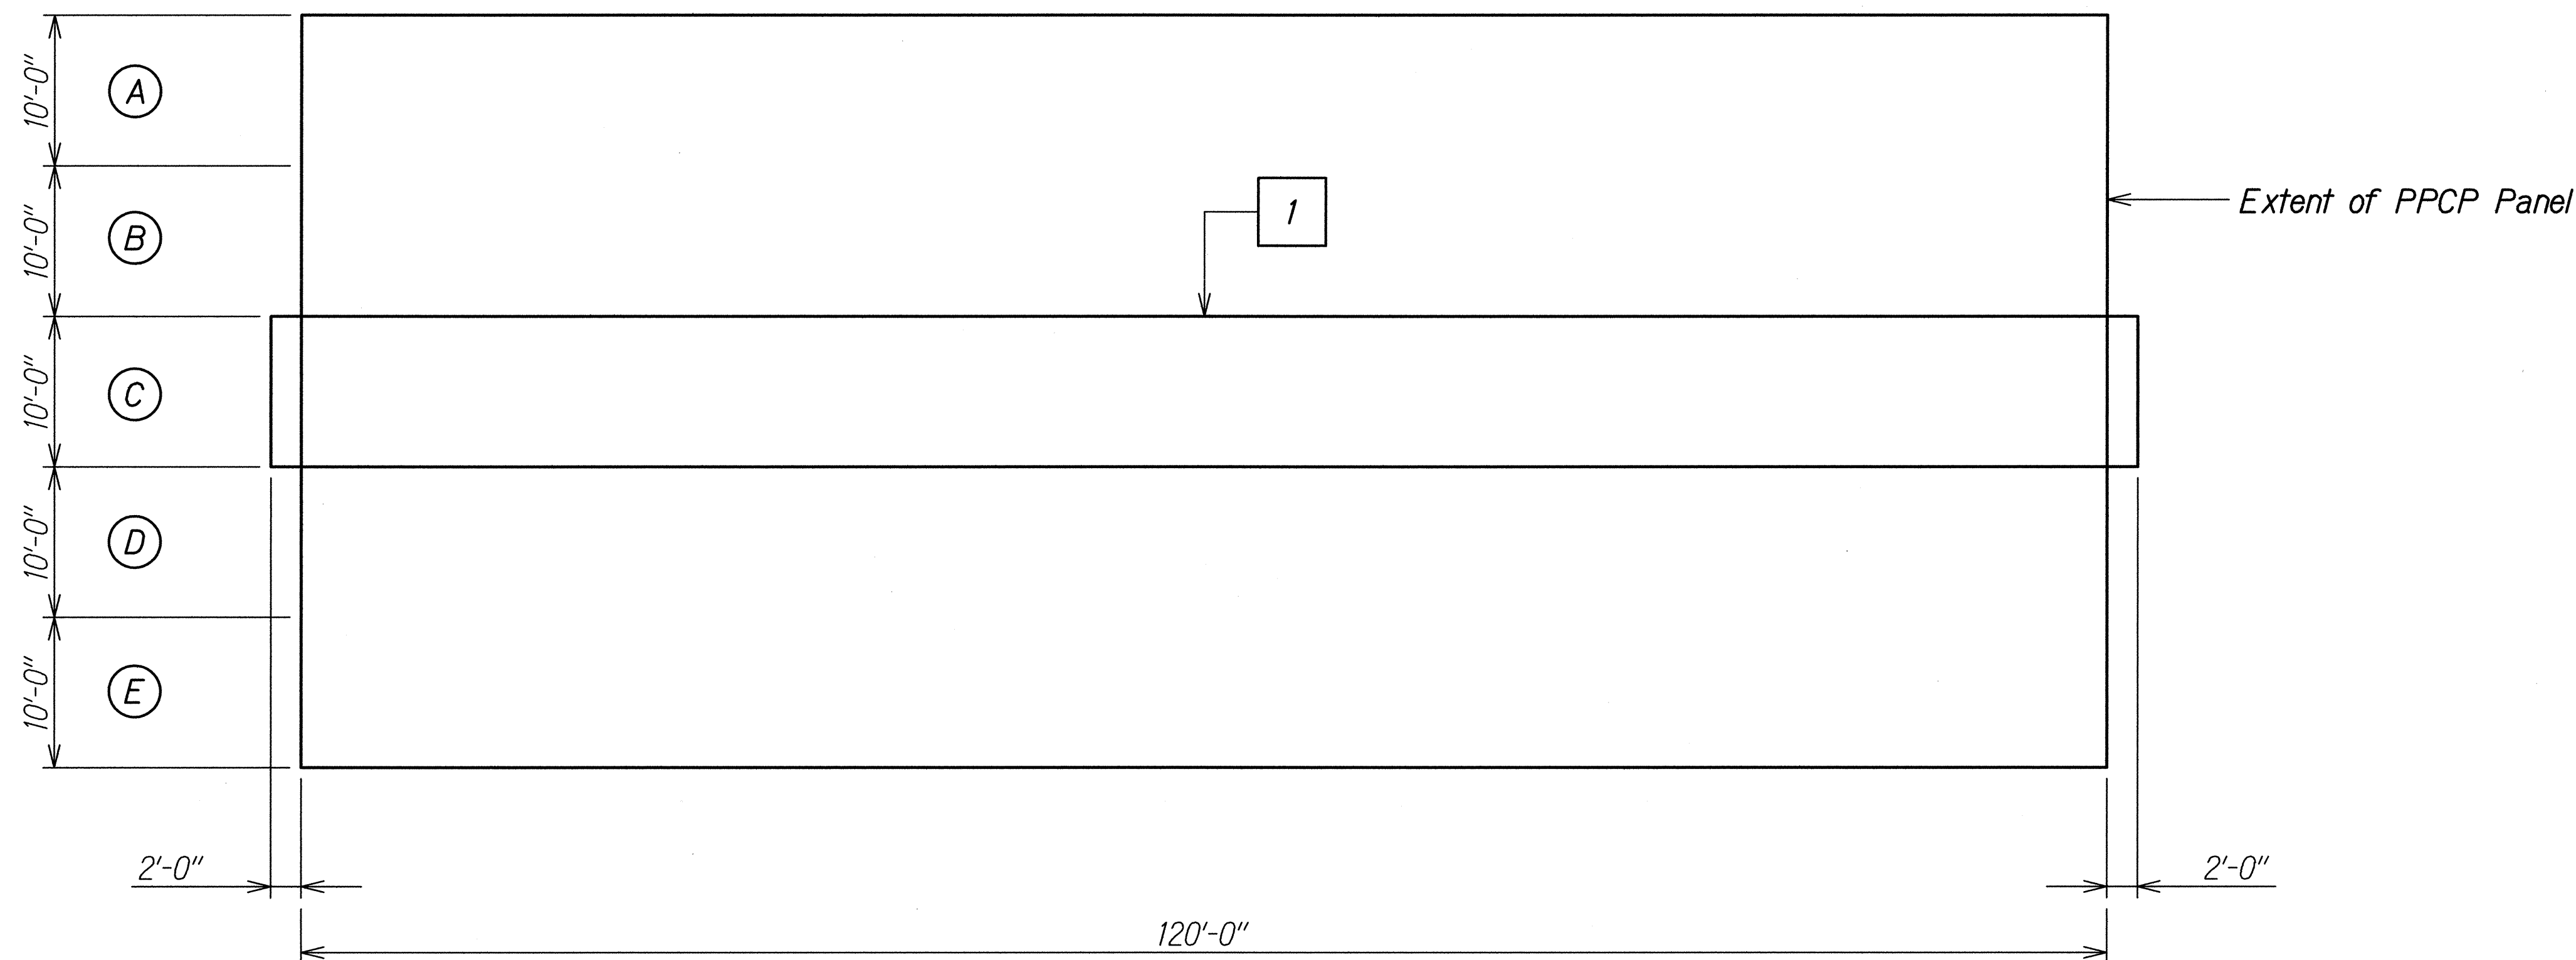

- 1 Saw Cut Existing Pavement at Row (C) Plus an Additional 2'-0" on Each End for Jacking. Remove Existing Pavement. Prepare subgrade. Pour 6" Rapid Setting Lean Concrete Base.
- 2 Set Panel C-1, Adjust to Elevations Shown in Civil Drawings. Stake within Temporary Staking Zone.

- 3 Set Panel C-2 Apply Epoxy to Transverse Joints Between Columns (1) and (2)

- 4 Stress LTT-1 and LTT-2 Concurrently as Required to Close Gap in Panels. Adjust Panel Height as Required.

- 5 Stake Panel C-2 within Temporary Staking Zone.

- 6 Set Panel C-3 Apply Epoxy to Transverse Joints Between Columns (2) and (3)

- 7 Stress LTT-1 And LTT-2 Concurrently as Required to Close Gap in Panels. Adjust Panel Height as Required.

- 8 Repeat Sequence 6 To 7 For Panels C-4 To C-10.

**Legend:**

- (1) Column Designation
- (A) Row Designation

LTT-# Longitudinal Temporary Tendon


LPT-# Longitudinal Permanent Tendon

▷ Jacking Ends

◀ Dead Ends

**INSTALLATION SEQUENCE**

Scale: 1/8" = 1'-0"

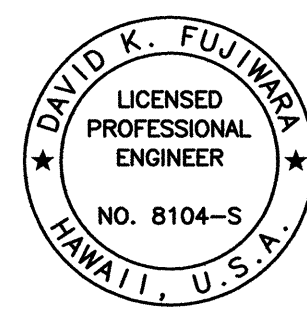

THIS WORK WAS PREPARED BY ME OR UNDER MY SUPERVISION.

SIGNATURE: David K. Fujiwara  
EXPIRATION DATE OF THE LICENSE: 4-30-16

STATE OF HAWAII  
DEPARTMENT OF TRANSPORTATION  
HIGHWAYS DIVISION

**PPCP LAYOUT PANEL**

**INSTALLATION SEQUENCE**


MIDDLE STREET PAVEMENT RECONSTRUCTION  
North King Street to Kamehameha Highway  
FAP NO. STP-7415(001)

Scale: As Noted Date: Jun. 20, 2014


SHEET No. S36 OF 12 SHEETS



| FED. ROAD DIST. NO. | STATE | FEDERAL AID PROJ. NO. | FISCAL YEAR | SHEET NO. | TOTAL SHEETS |
|---------------------|-------|-----------------------|-------------|-----------|--------------|
| HAWAII              | HAW.  | STP-7415(001)         | 2014        | 144       | 173          |

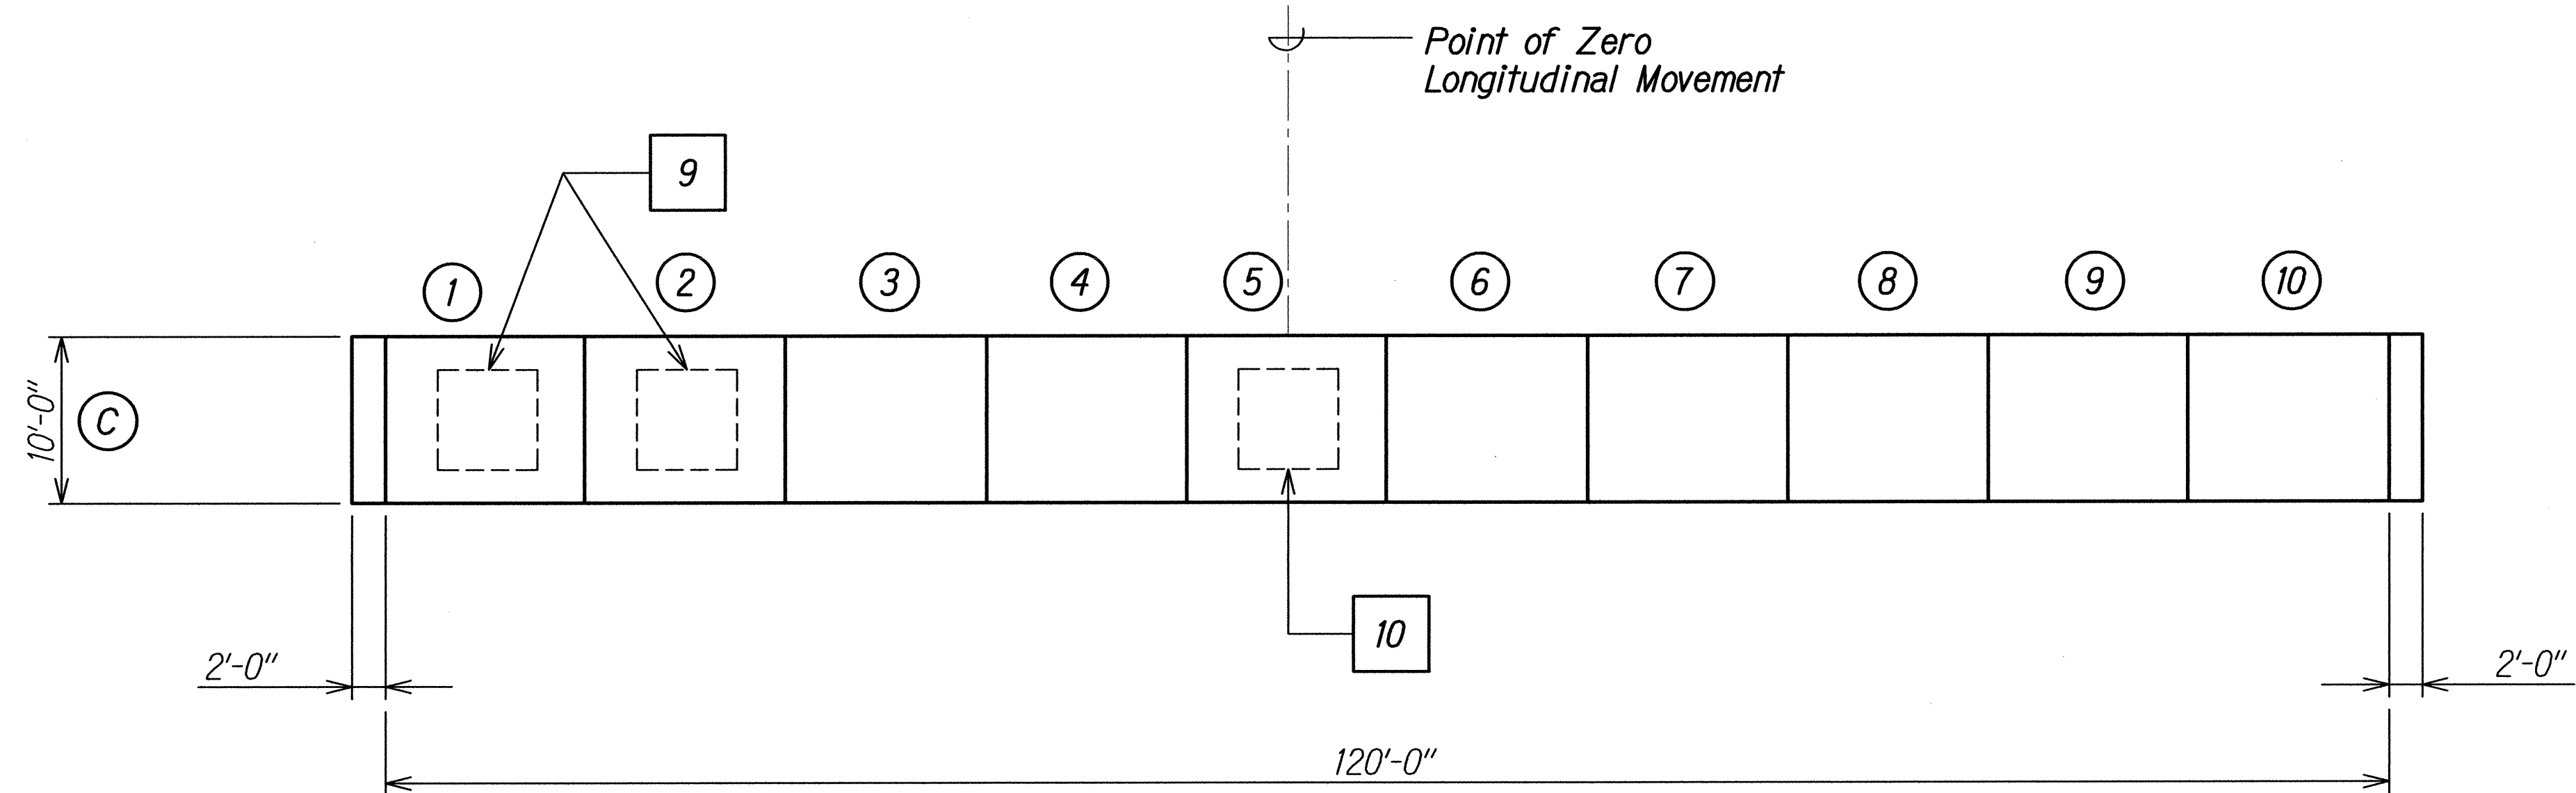

- 9 Remove Temporary Stakes From Panels C-1 and C-2.
- 10 Stake Panels C-5 Within Final Staking Zone

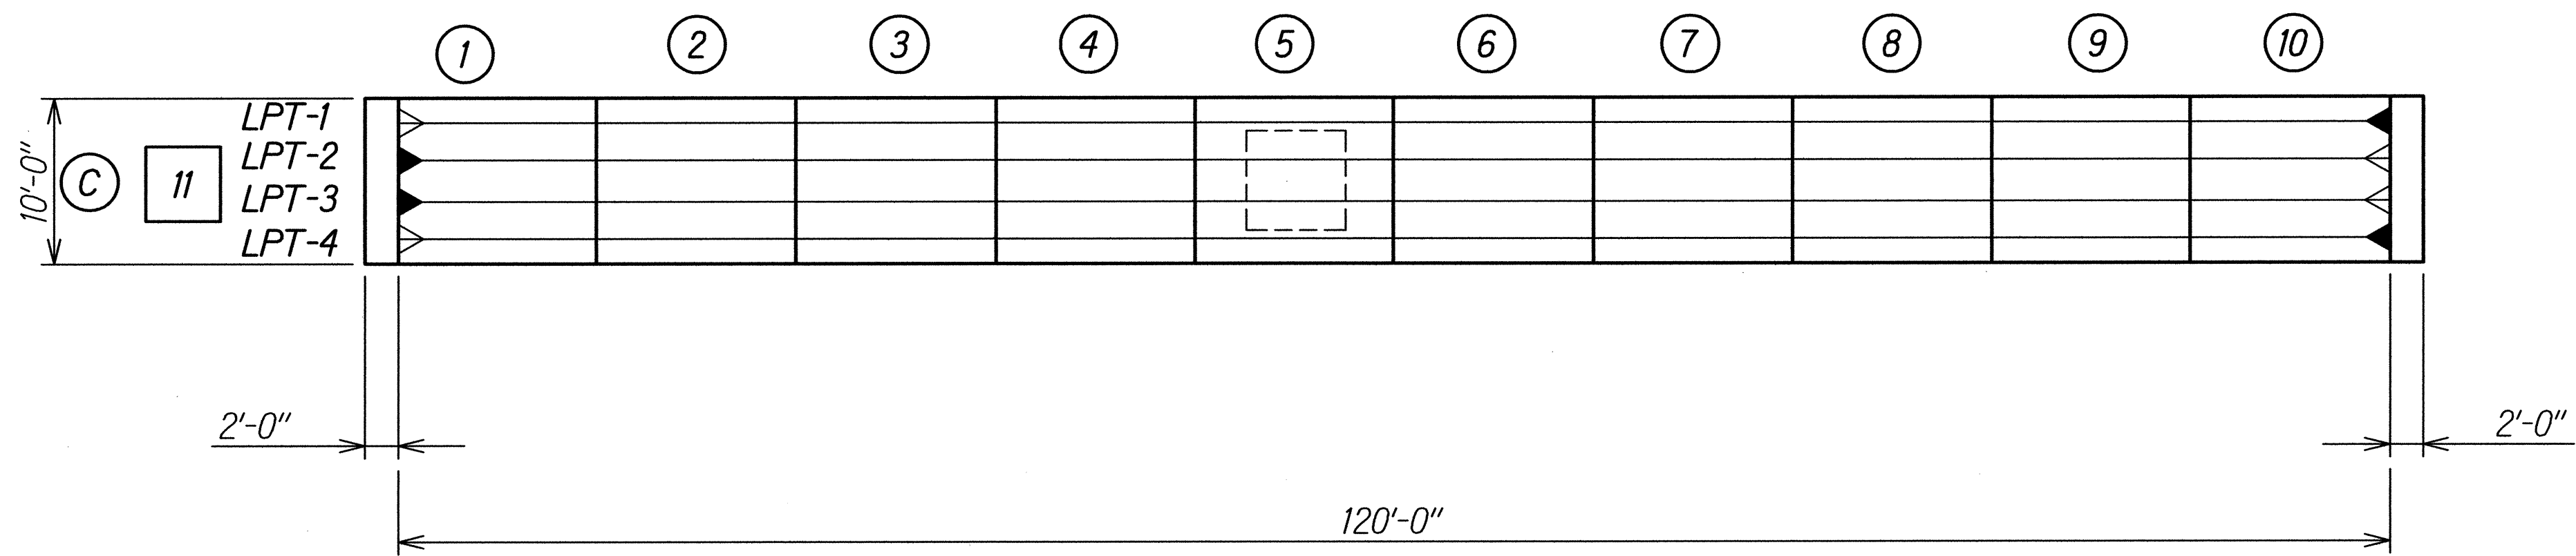

- 11 Stress Longitudinal Permanent Tendons  
A. Stress LPT-2 and LPT-3 Concurrently to 100% of PJack (See General Note 9.F. (7) on sheet S0.3)  
B. Stress LPT-1 and LPT-4 Concurrently to 100% of PJack
- 12 Blow Amine Carboxylate Powder into Ducts.
- 13 Grout all Tendons.  
Grout all Voids Beneath Panels.
- 14 Remove Leveling Bolts. Fill Holes Vents, and Pockets with fill material for holes and pockets. Fill Blockouts for anchor heads with anchor head blockout fill material.

### INSTALLATION SEQUENCE


Scale: 1/8" = 1'-0"

#### Legend:

- ① Column Designation
- Ⓐ Row Designation
- LTT-# Longitudinal Temporary Tendon
- LPT-# Longitudinal Permanent Tendon
- ▷ Jacking Ends
- ◀ Dead Ends

|               |      |
|---------------|------|
| ORIGINAL PLAN | DATE |
| DRAWN BY      |      |
| DESIGNED BY   |      |
| NOTED BY      |      |
| CHECKED BY    |      |

DRAWING NAME: 2100 ONGONG\12-0331-HFL MIDDLE STREET RECONSTRUCTION-D0TH\CAD\06-19-14 BD\HFL-MS305 TO MS311.DWG PLOT TIME: 06-18-14, 7:25 PM

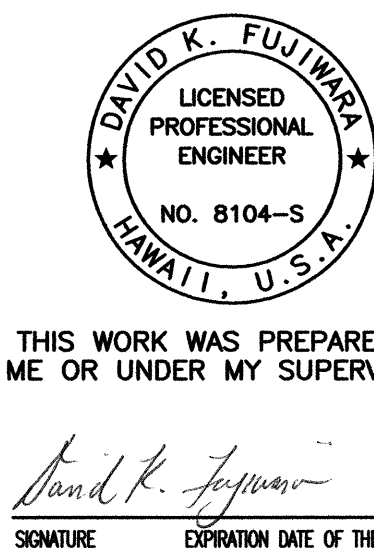


THIS WORK WAS PREPARED BY  
ME OR UNDER MY SUPERVISION.  
Signature: David K. Fujiwara  
EXPIRATION DATE OF THE LICENSE: 4-30-16

STATE OF HAWAII  
DEPARTMENT OF TRANSPORTATION  
HIGHWAYS DIVISION  
**PPCP LAYOUT PANEL**  
**INSTALLATION SEQUENCE**  
MIDDLE STREET PAVEMENT RECONSTRUCTION  
North King Street to Kamehameha Highway  
FAP NO. STP-7415(001)  
Scale: As Noted Date: Jun. 20, 2014  
SHEET No. S37 OF 12 SHEETS



| FED. ROAD DIST. NO. | STATE | FEDERAL AID PROJ. NO. | FISCAL YEAR | SHEET NO. | TOTAL SHEETS |
|---------------------|-------|-----------------------|-------------|-----------|--------------|
| HAWAII              | HAW.  | STP-7415(001)         | 2014        | 145       | 173          |

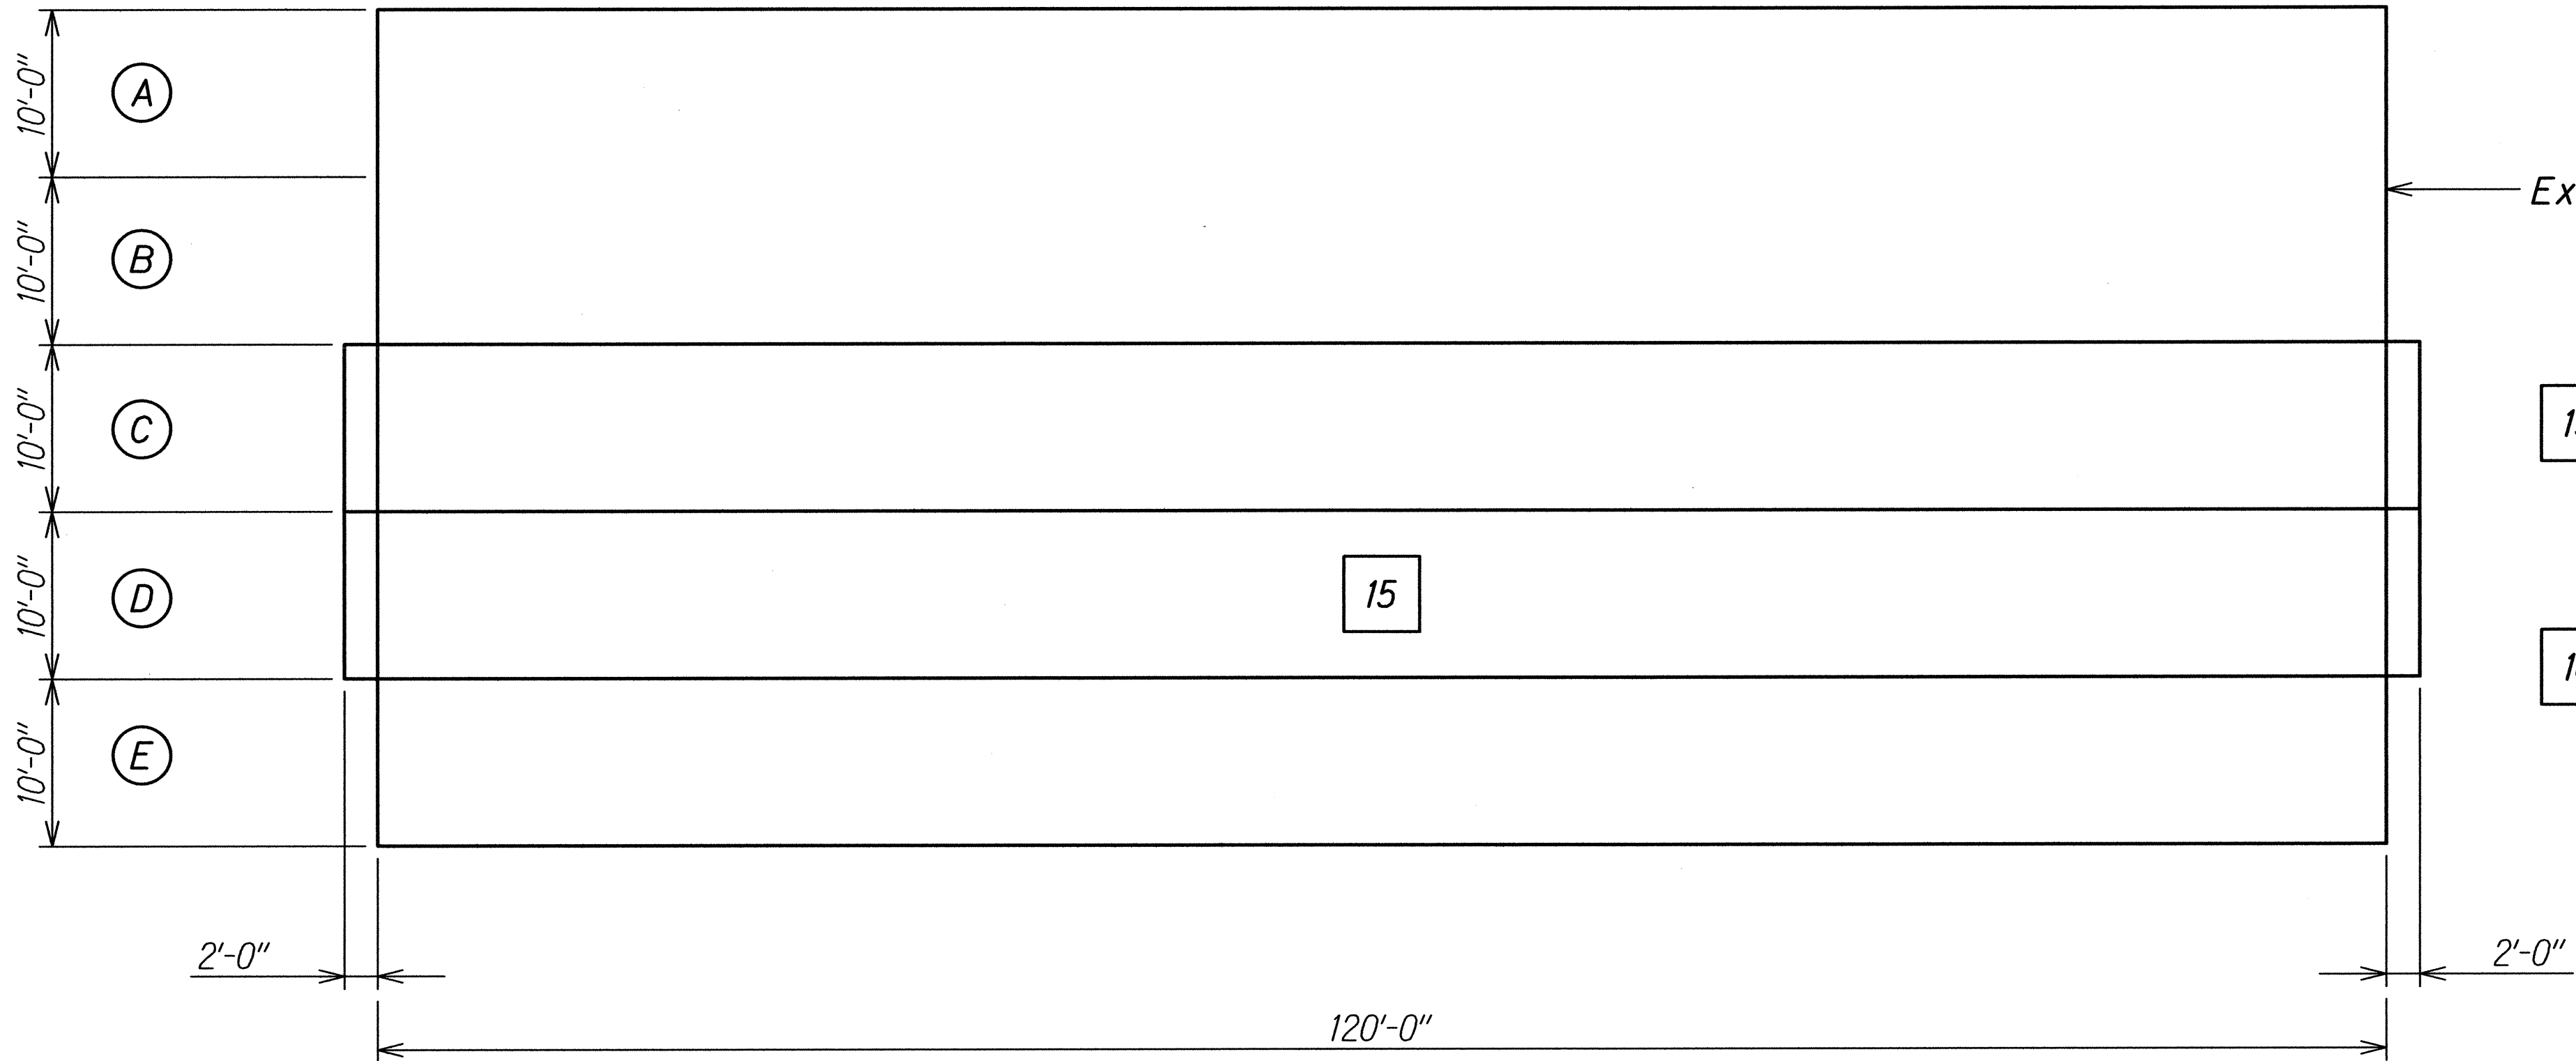

15 Saw Cut Existing Pavement at Row **D** Plus an Additional 2'-0" on Each End for Jacking. Remove Existing Pavement. Prepare subgrade. Pour 6" Rapid Setting Lean Concrete Base.

16 Repeat Sequence **2** to **14** for Panels D-1 to D-10.

Legend:


- 1** Column Designation  
**A** Row Designation

LTT-# Longitudinal Temporary Tendon

LPT-# Longitudinal Permanent Tendon

▷ Jacking Ends

◀ Dead Ends

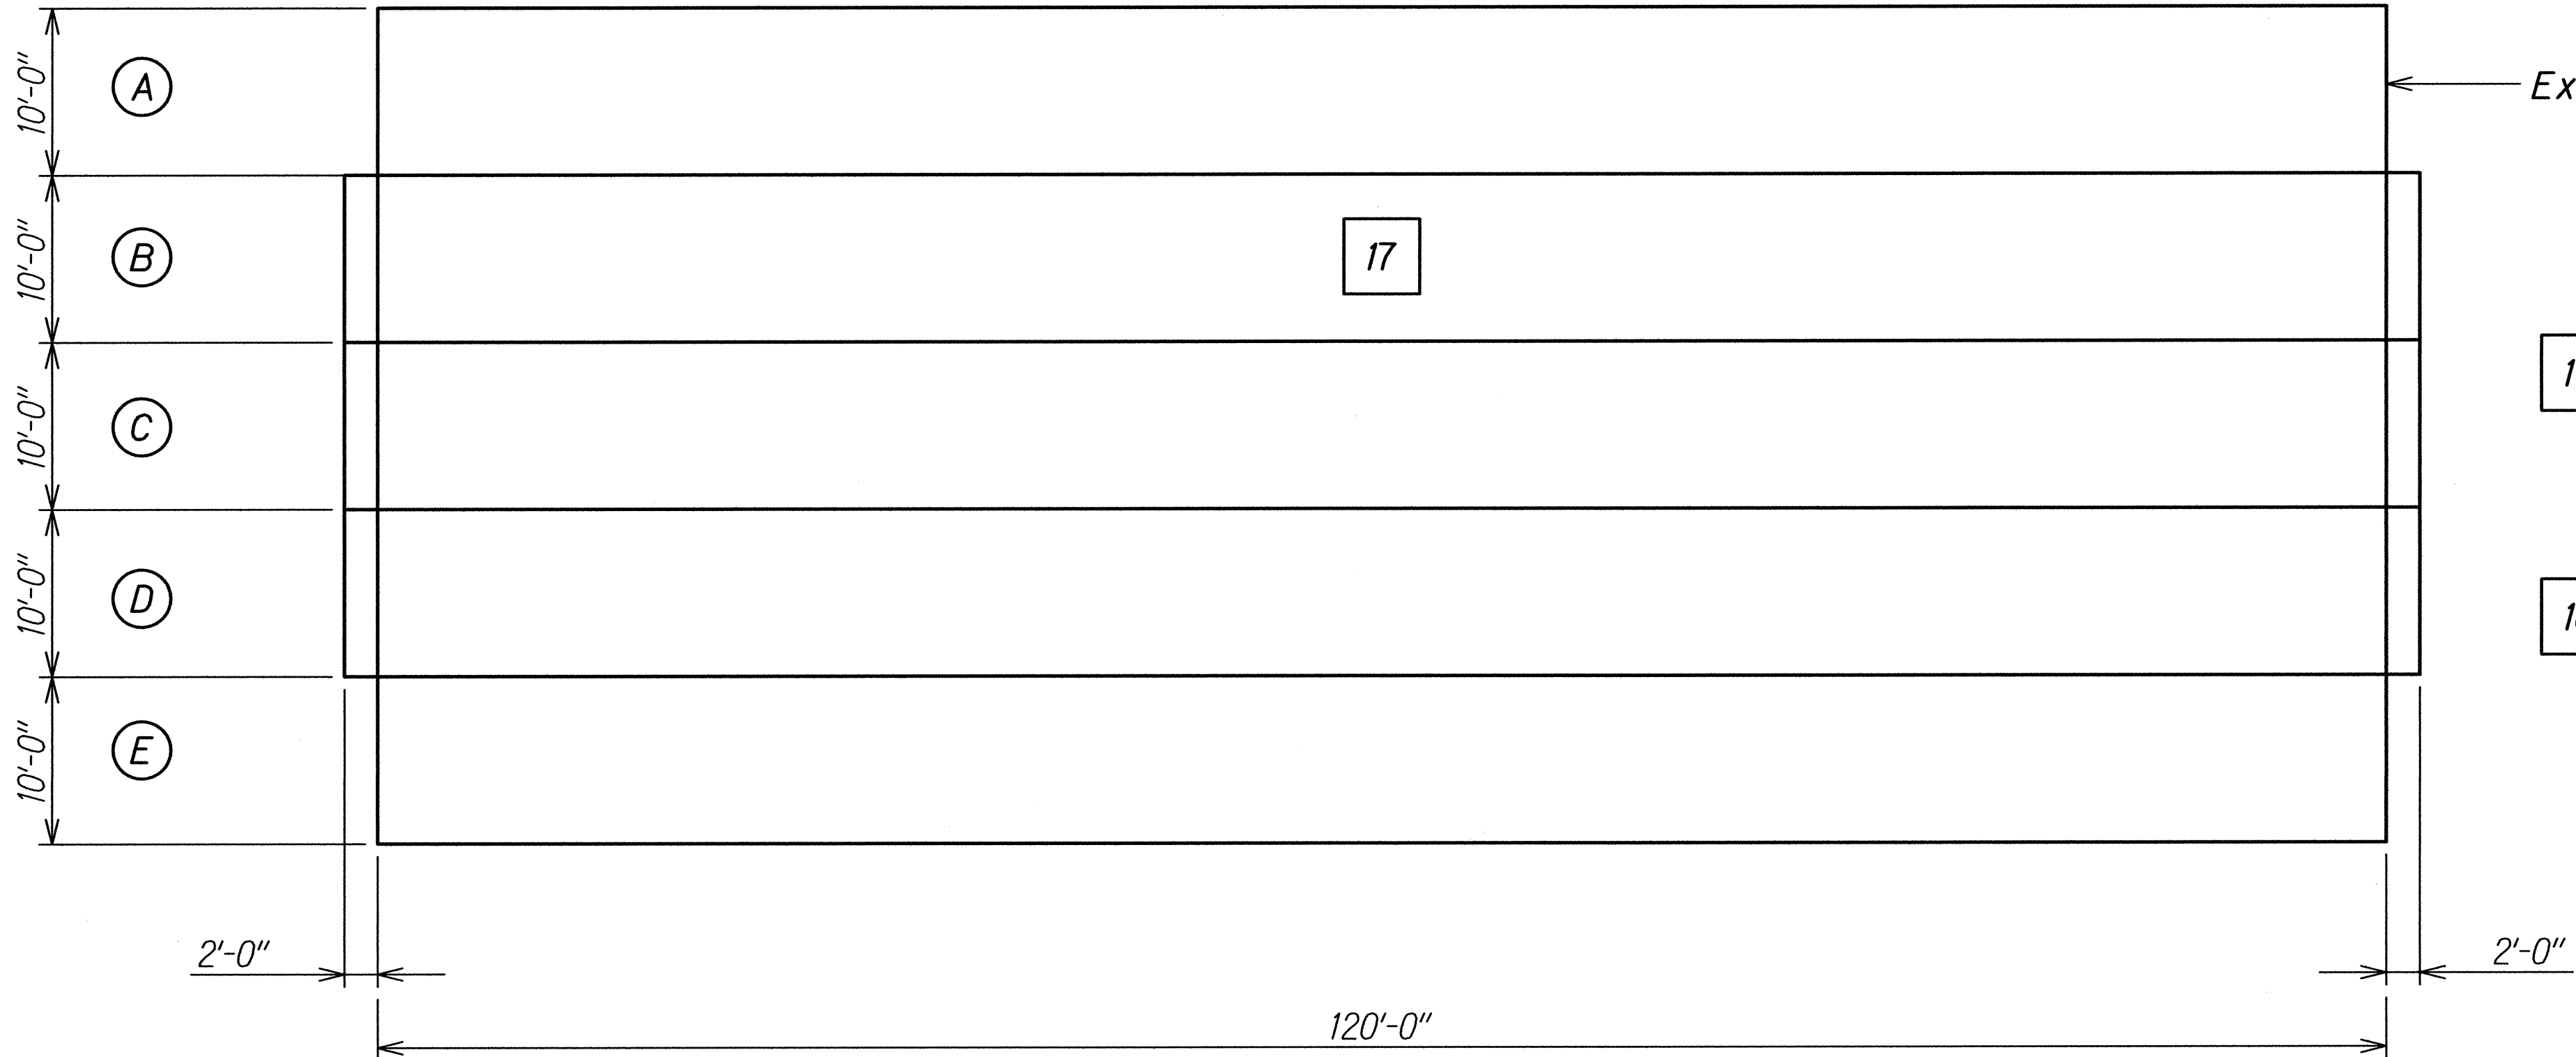

17 Saw Cut Existing Pavement at Row **B** Plus an Additional 2'-0" on Each End for Jacking. Remove Existing Pavement. Prepare subgrade. Pour 6" Rapid Setting Lean Concrete Base.


18 Repeat Sequence **2** to **14** for Panels B-1 to B-10.

INSTALLATION SEQUENCE

Scale: 1/8" = 1'-0"

|               |                   |      |
|---------------|-------------------|------|
| ORIGINAL PLAN | SURVEY PLOTTED BY | DATE |
| NOTE BOOK     | DESIGNED BY       |      |
| No.           | QUANTITIES BY     |      |
|               | CHECKED BY        |      |


DRAWING NAME: 2100\_OINGONG\12-0331-HFL MIDDLE STREET RECONSTRUCTION-DOT\HAWAII-MS305 TO MS311.DWG PLOT TIME: 06-18-14, 7:25 PM

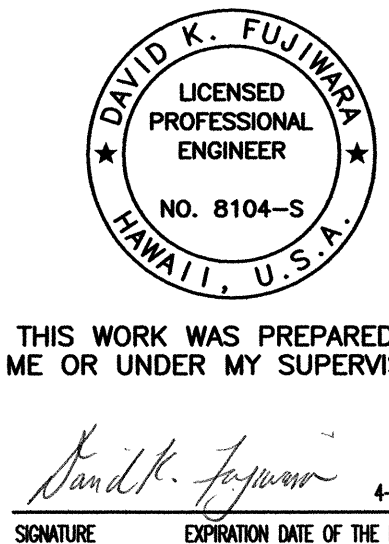

STATE OF HAWAII  
DEPARTMENT OF TRANSPORTATION  
HIGHWAYS DIVISION  
**PPCP LAYOUT PANEL**  
**INSTALLATION SEQUENCE**  
MIDDLE STREET PAVEMENT RECONSTRUCTION  
North King Street to Kamehameha Highway  
FAP NO. STP-7415(001)  
Scale: As Noted Date: Jun. 20, 2014  
SHEET No. 538 OF 12 SHEETS



| FED. ROAD DIST. NO. | STATE | FEDERAL AID PROJ. NO. | FISCAL YEAR | SHEET NO. | TOTAL SHEETS |
|---------------------|-------|-----------------------|-------------|-----------|--------------|
| HAWAII              | HAW.  | STP-7415(001)         | 2014        | 146       | 173          |

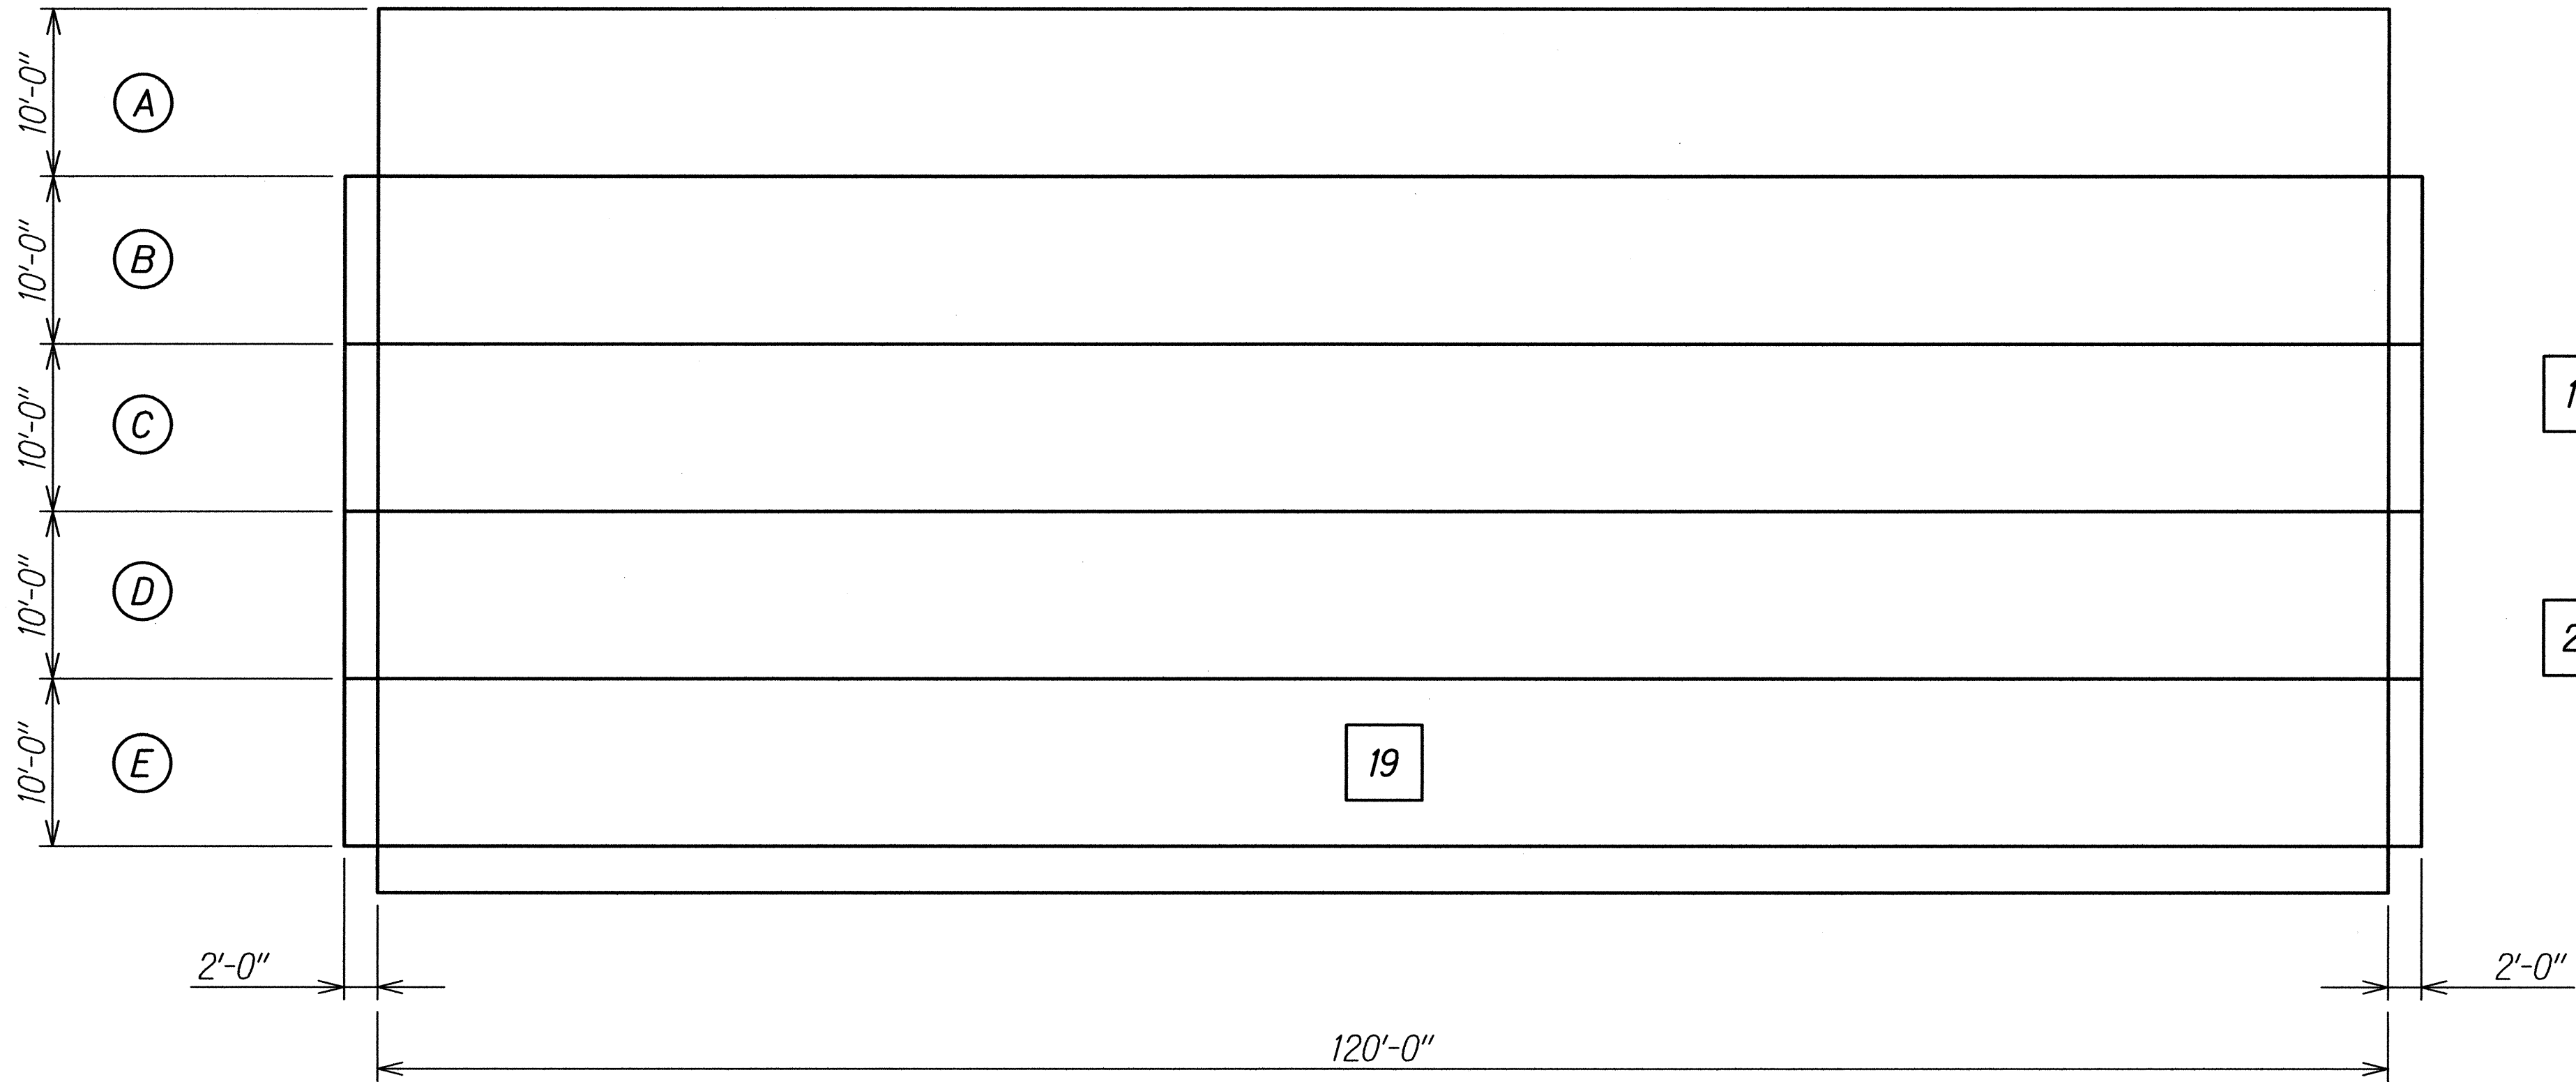

19 Saw Cut Existing Pavement at Row E Plus an Additional 2'-0" on Each End for Jacking. Remove Existing Pavement. Prepare subgrade. Pour 6" Rapid Setting Lean Concrete Base.

20 Repeat Sequence 2 to 14 for Panels E-1 to E-10.

Legend:

① Column Designation


Ⓐ Row Designation

LTT-# Longitudinal Temporary Tendon

LPT-# Longitudinal Permanent Tendon

↗ Jacking Ends

➡ Dead Ends

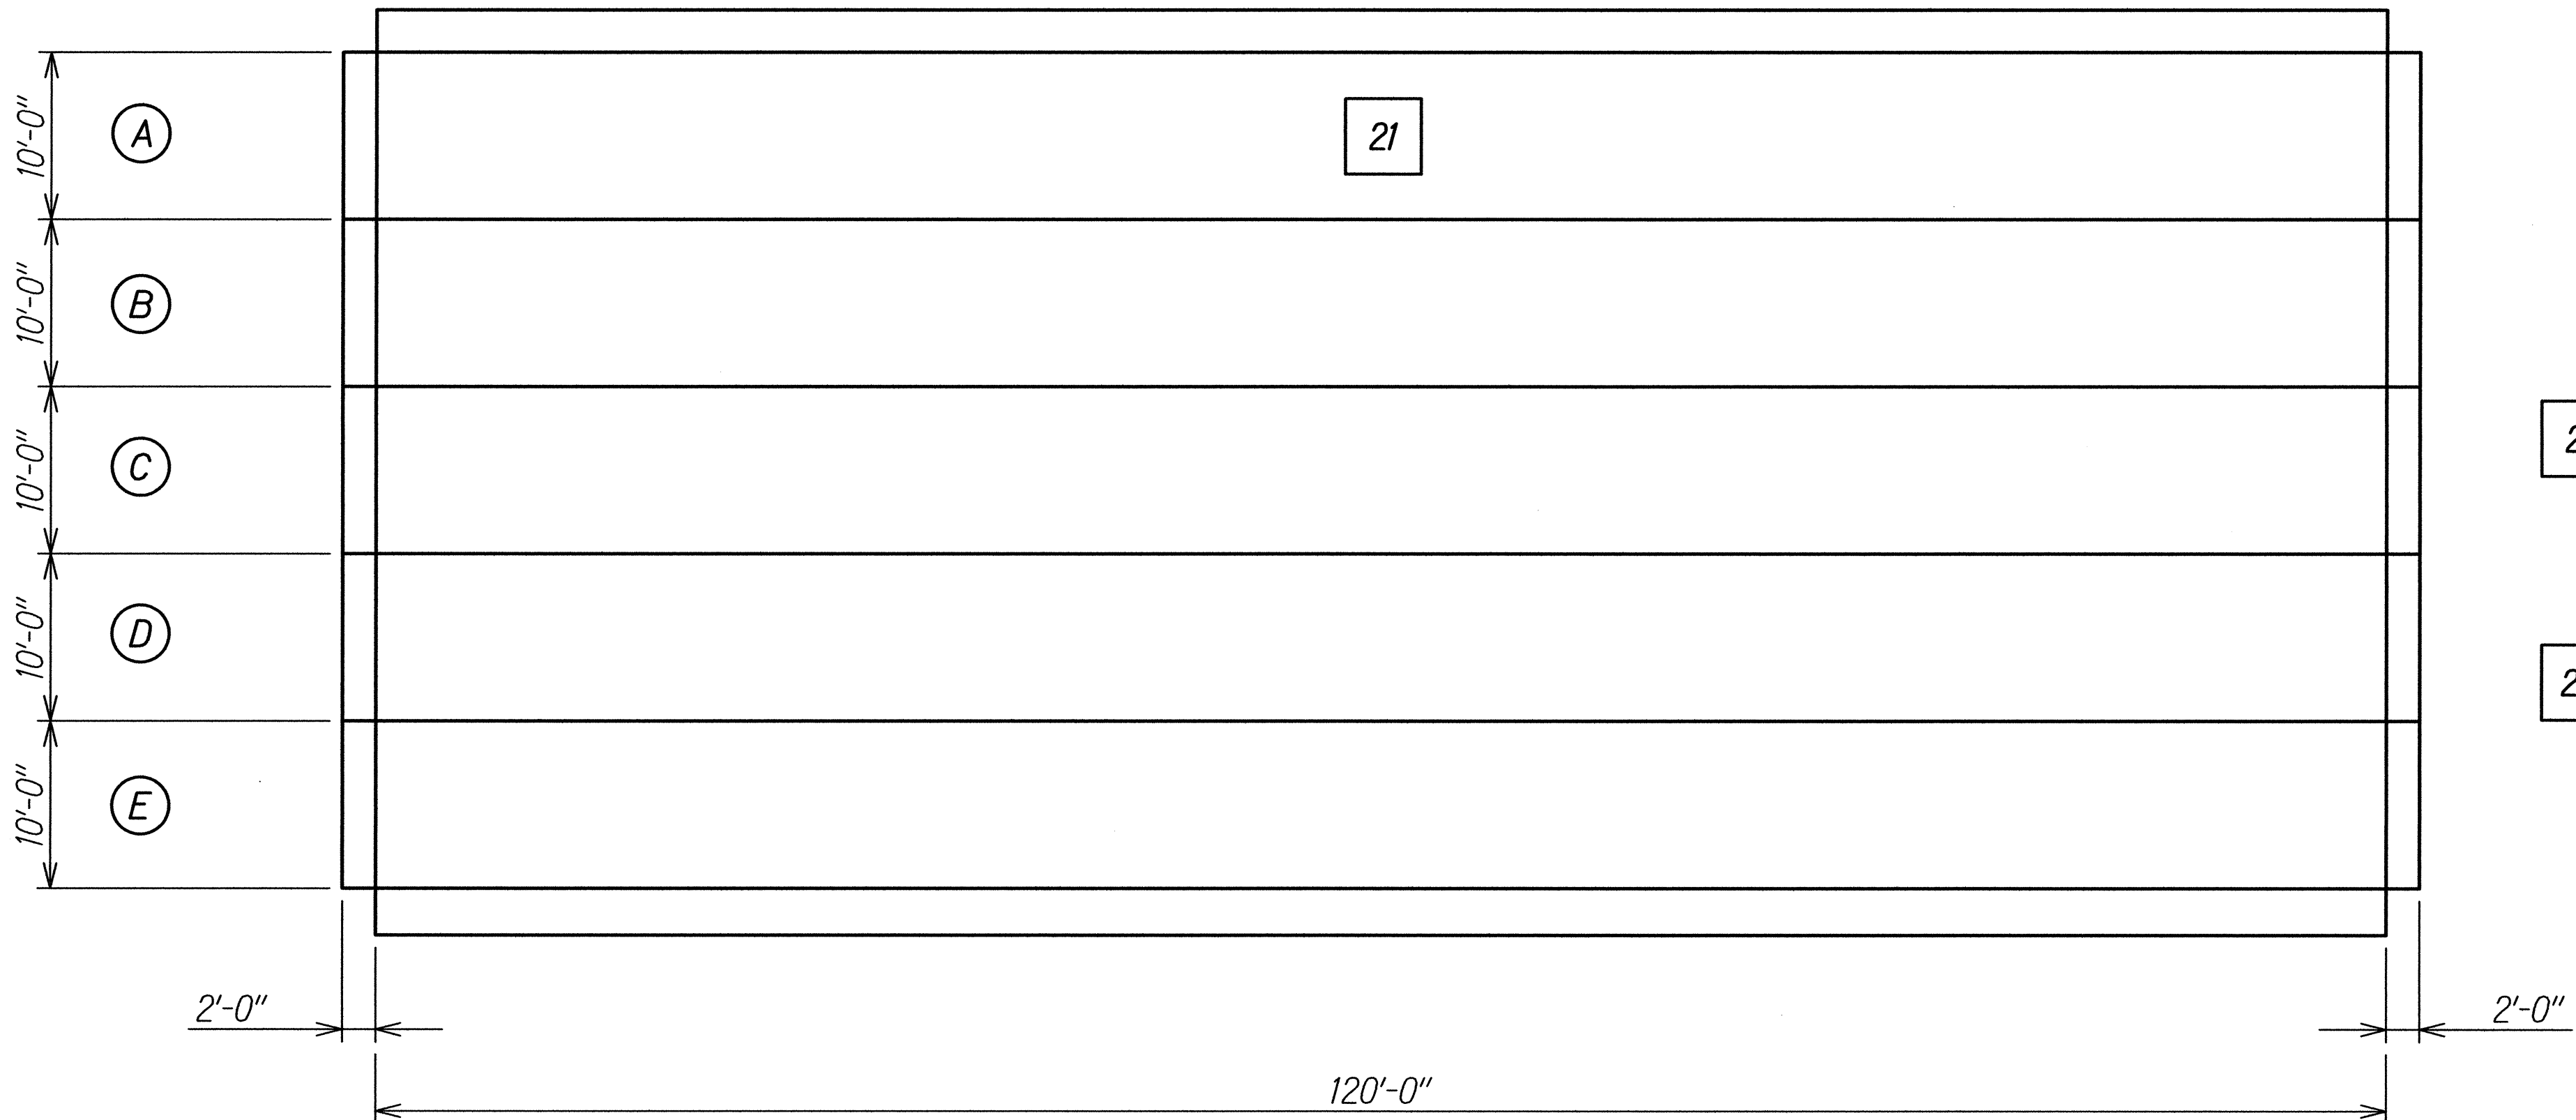

21 Saw Cut Existing Pavement at Row A Plus an Additional 2'-0" on Each End for Jacking. Remove Existing Pavement. Prepare subgrade. Pour 6" Rapid Setting Lean Concrete Base.

22 Repeat Sequence 2 to 14 for Panels A-1 to A-10.

INSTALLATION SEQUENCE

Scale: 1/8" = 1'-0"




THIS WORK WAS PREPARED BY ME OR UNDER MY SUPERVISION.

Signature: David K. Fujiwara  
Date: 4-30-16  
Signature: David K. Fujiwara  
Expiration Date of the License: 4-30-16

STATE OF HAWAII  
DEPARTMENT OF TRANSPORTATION  
HIGHWAYS DIVISION  
**PPCP LAYOUT PANEL**  
**INSTALLATION SEQUENCE**  
MIDDLE STREET PAVEMENT RECONSTRUCTION  
North King Street to Kamehameha Highway  
FAP NO. STP-7415(001)  
Scale: As Noted Date: Jun. 20, 2014  
SHEET No. S39 OF 12 SHEETS



| FED. ROAD DIST. NO. | STATE | FEDERAL AID PROJ. NO. | FISCAL YEAR | SHEET NO. | TOTAL SHEETS |
|---------------------|-------|-----------------------|-------------|-----------|--------------|
| HAWAII              | HAW.  | STP-7415(001)         | 2014        | 147       | 173          |

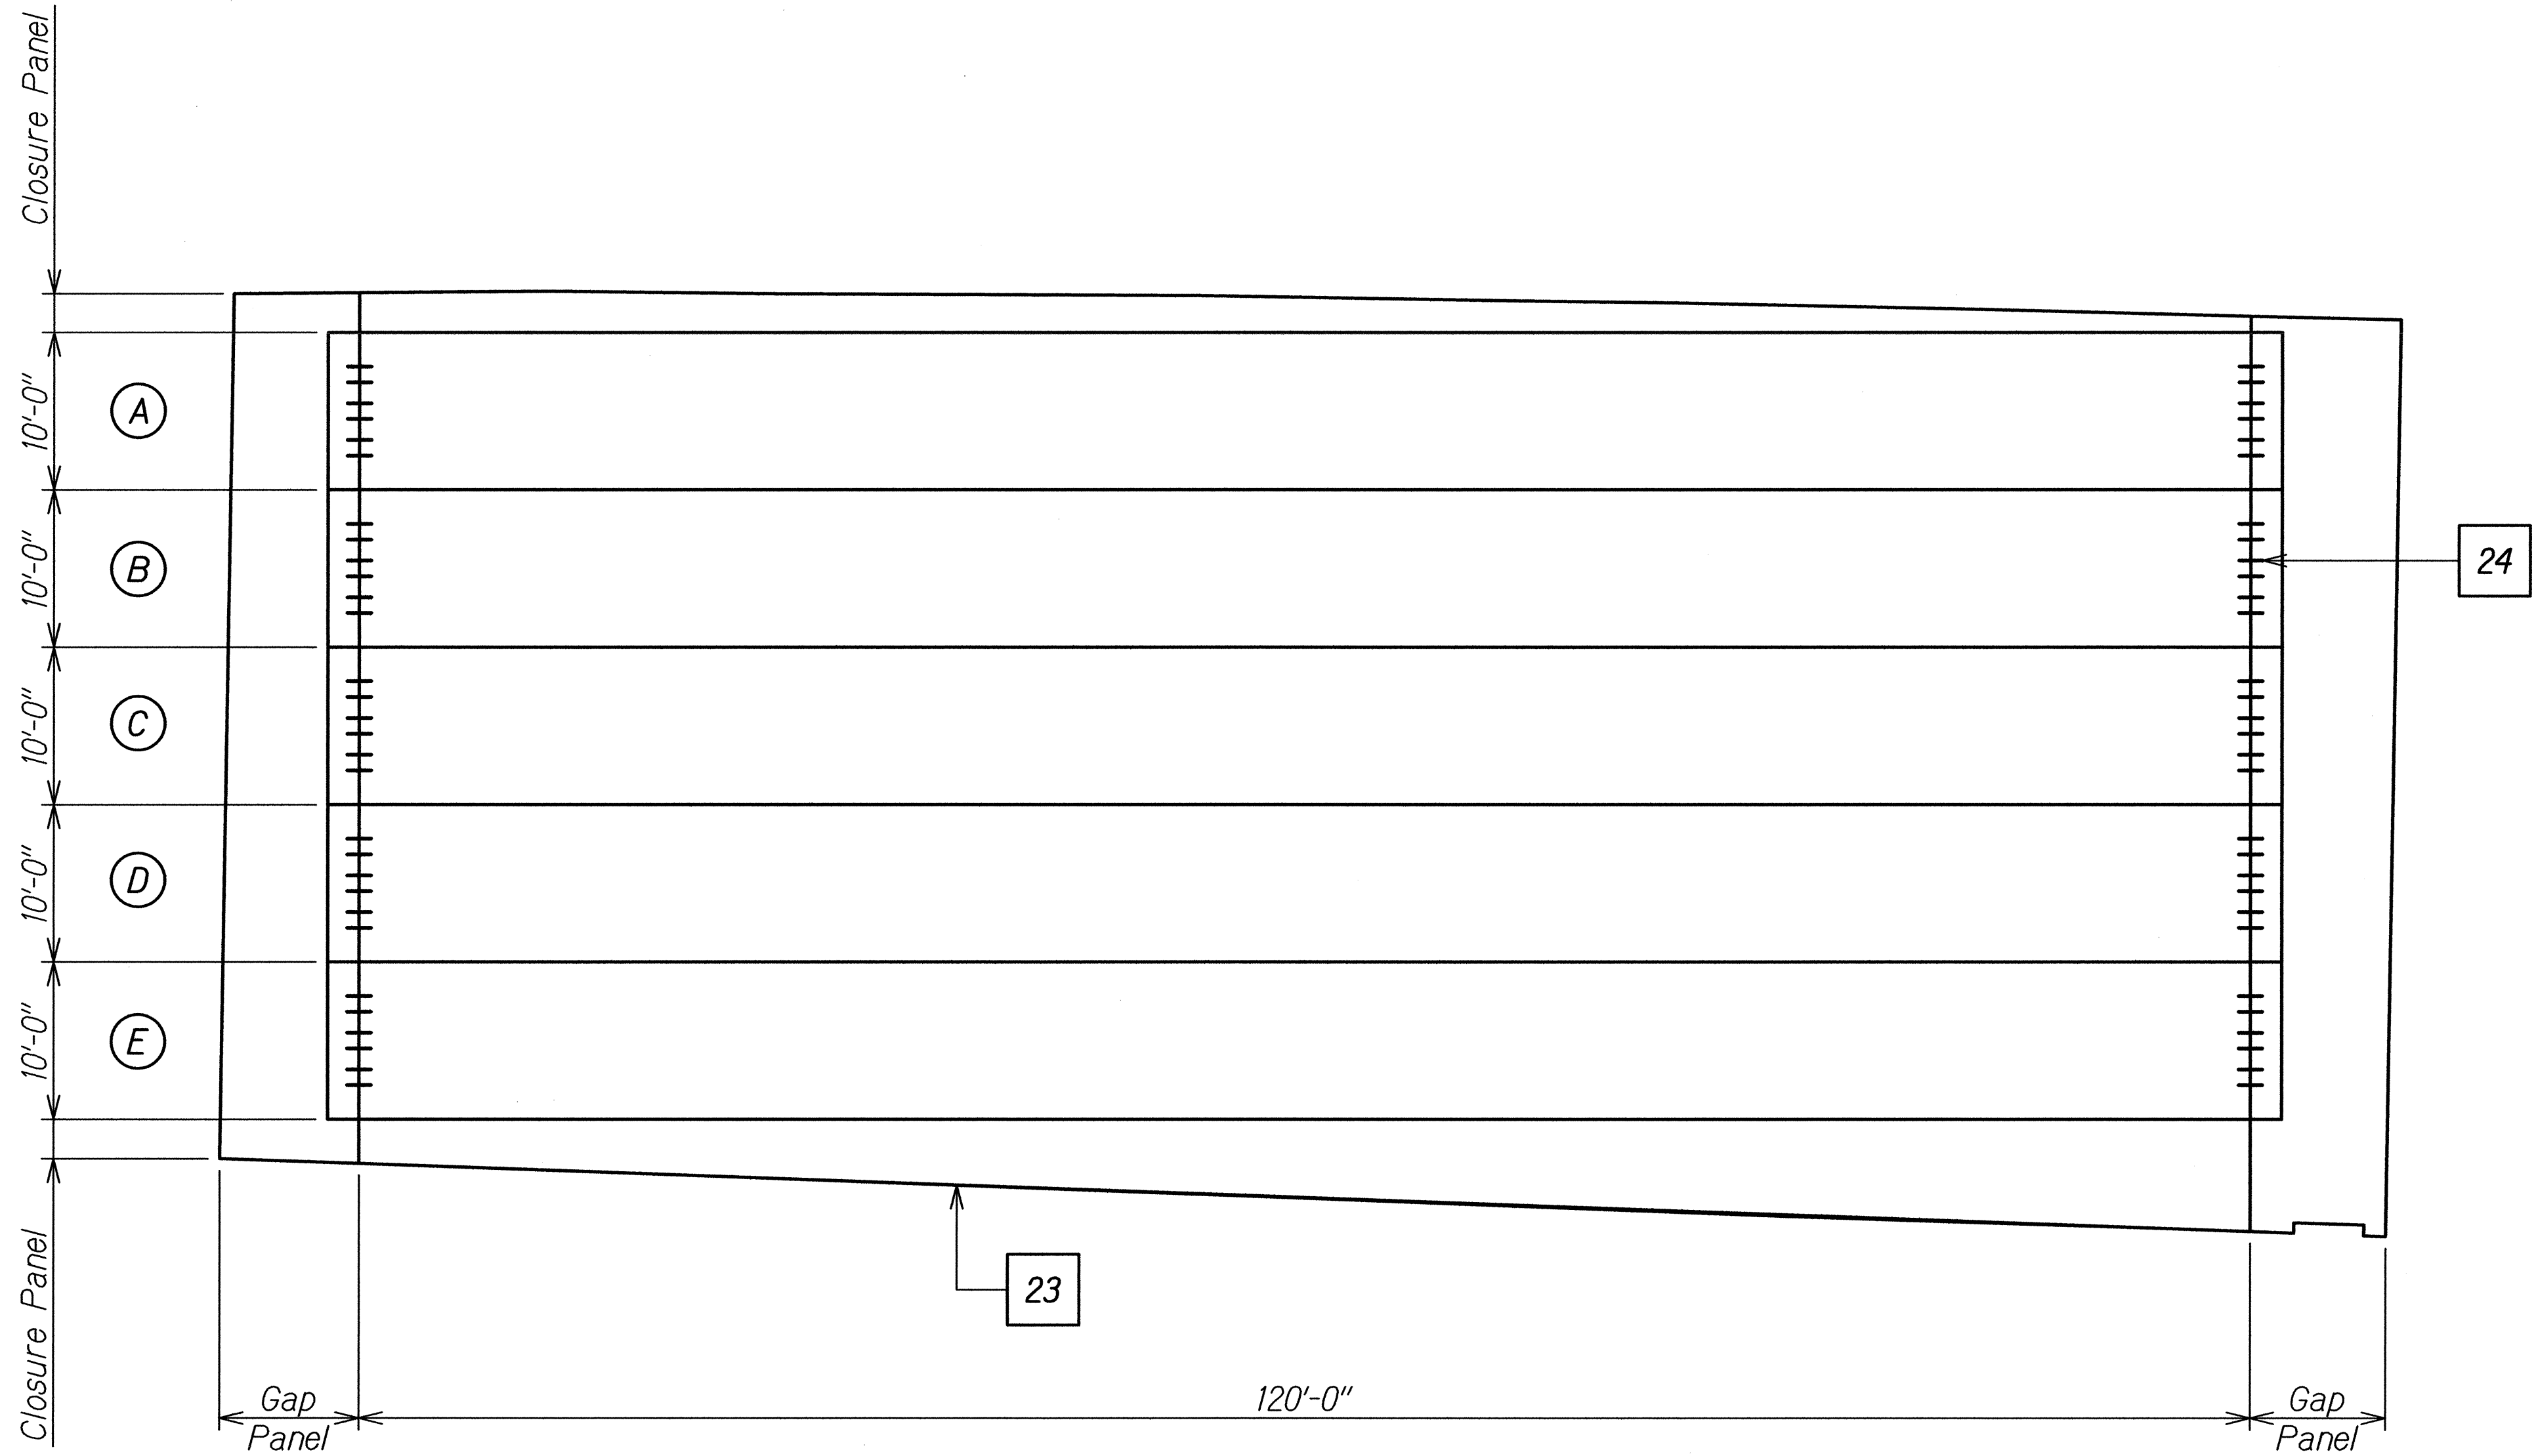


- 23 Saw Cut Existing Pavement For Gap Panels And Closure Panels. Remove Existing Pavement. Prepare subgrade. Pour 6" Rapid Setting Lean Concrete Base.
- 24 Install Epoxy Coated Smooth Dowels at Gap Panel. See 5/S1.2.

Note:  
Construction of gap panels and closure panels, Sequence 23 to 26 may be phased and need not occur concurrently.

**INSTALLATION SEQUENCE**  
Scale: 1/8" = 1'-0"

|               |                   |      |
|---------------|-------------------|------|
| ORIGINAL PLAN | SURVEY PLOTTED BY | DATE |
| NOTE BOOK     | DRAWN BY          |      |
| No.           | DESIGNED BY       |      |
|               | QUANTITIES BY     |      |
|               | CHECKED BY        |      |


DRAWING NAME: 2100 ONGOING 12-0331-HFL MIDDLE STREET RECONSTRUCTION-DOTH CAD 06-19-14 BID/HFL-MS305 TO MS31 LDWG PLOT TIME: 06-18-14, 7:26 PM

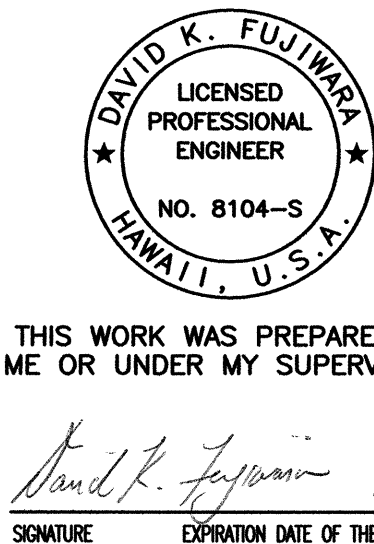

THIS WORK WAS PREPARED BY  
ME OR UNDER MY SUPERVISION.  
*David K. Fujiwara*  
SIGNATURE EXPIRATION DATE OF THE LICENSE 4-30-16

STATE OF HAWAII  
DEPARTMENT OF TRANSPORTATION  
HIGHWAYS DIVISION  
**PPCP LAYOUT PANEL**  
**INSTALLATION SEQUENCE**  
MIDDLE STREET PAVEMENT RECONSTRUCTION  
North King Street to Kamehameha Highway  
FAP NO. STP-7415(001)  
Scale: As Noted Date: Jun. 20, 2014  
SHEET No. S310 OF 12 SHEETS

| FED. ROAD DIST. NO. | STATE | FEDERAL AID PROJ. NO. | FISCAL YEAR | SHEET NO. | TOTAL SHEETS |
|---------------------|-------|-----------------------|-------------|-----------|--------------|
| HAWAII              | HAW.  | STP-7415(001)         | 2014        | 148       | 173          |

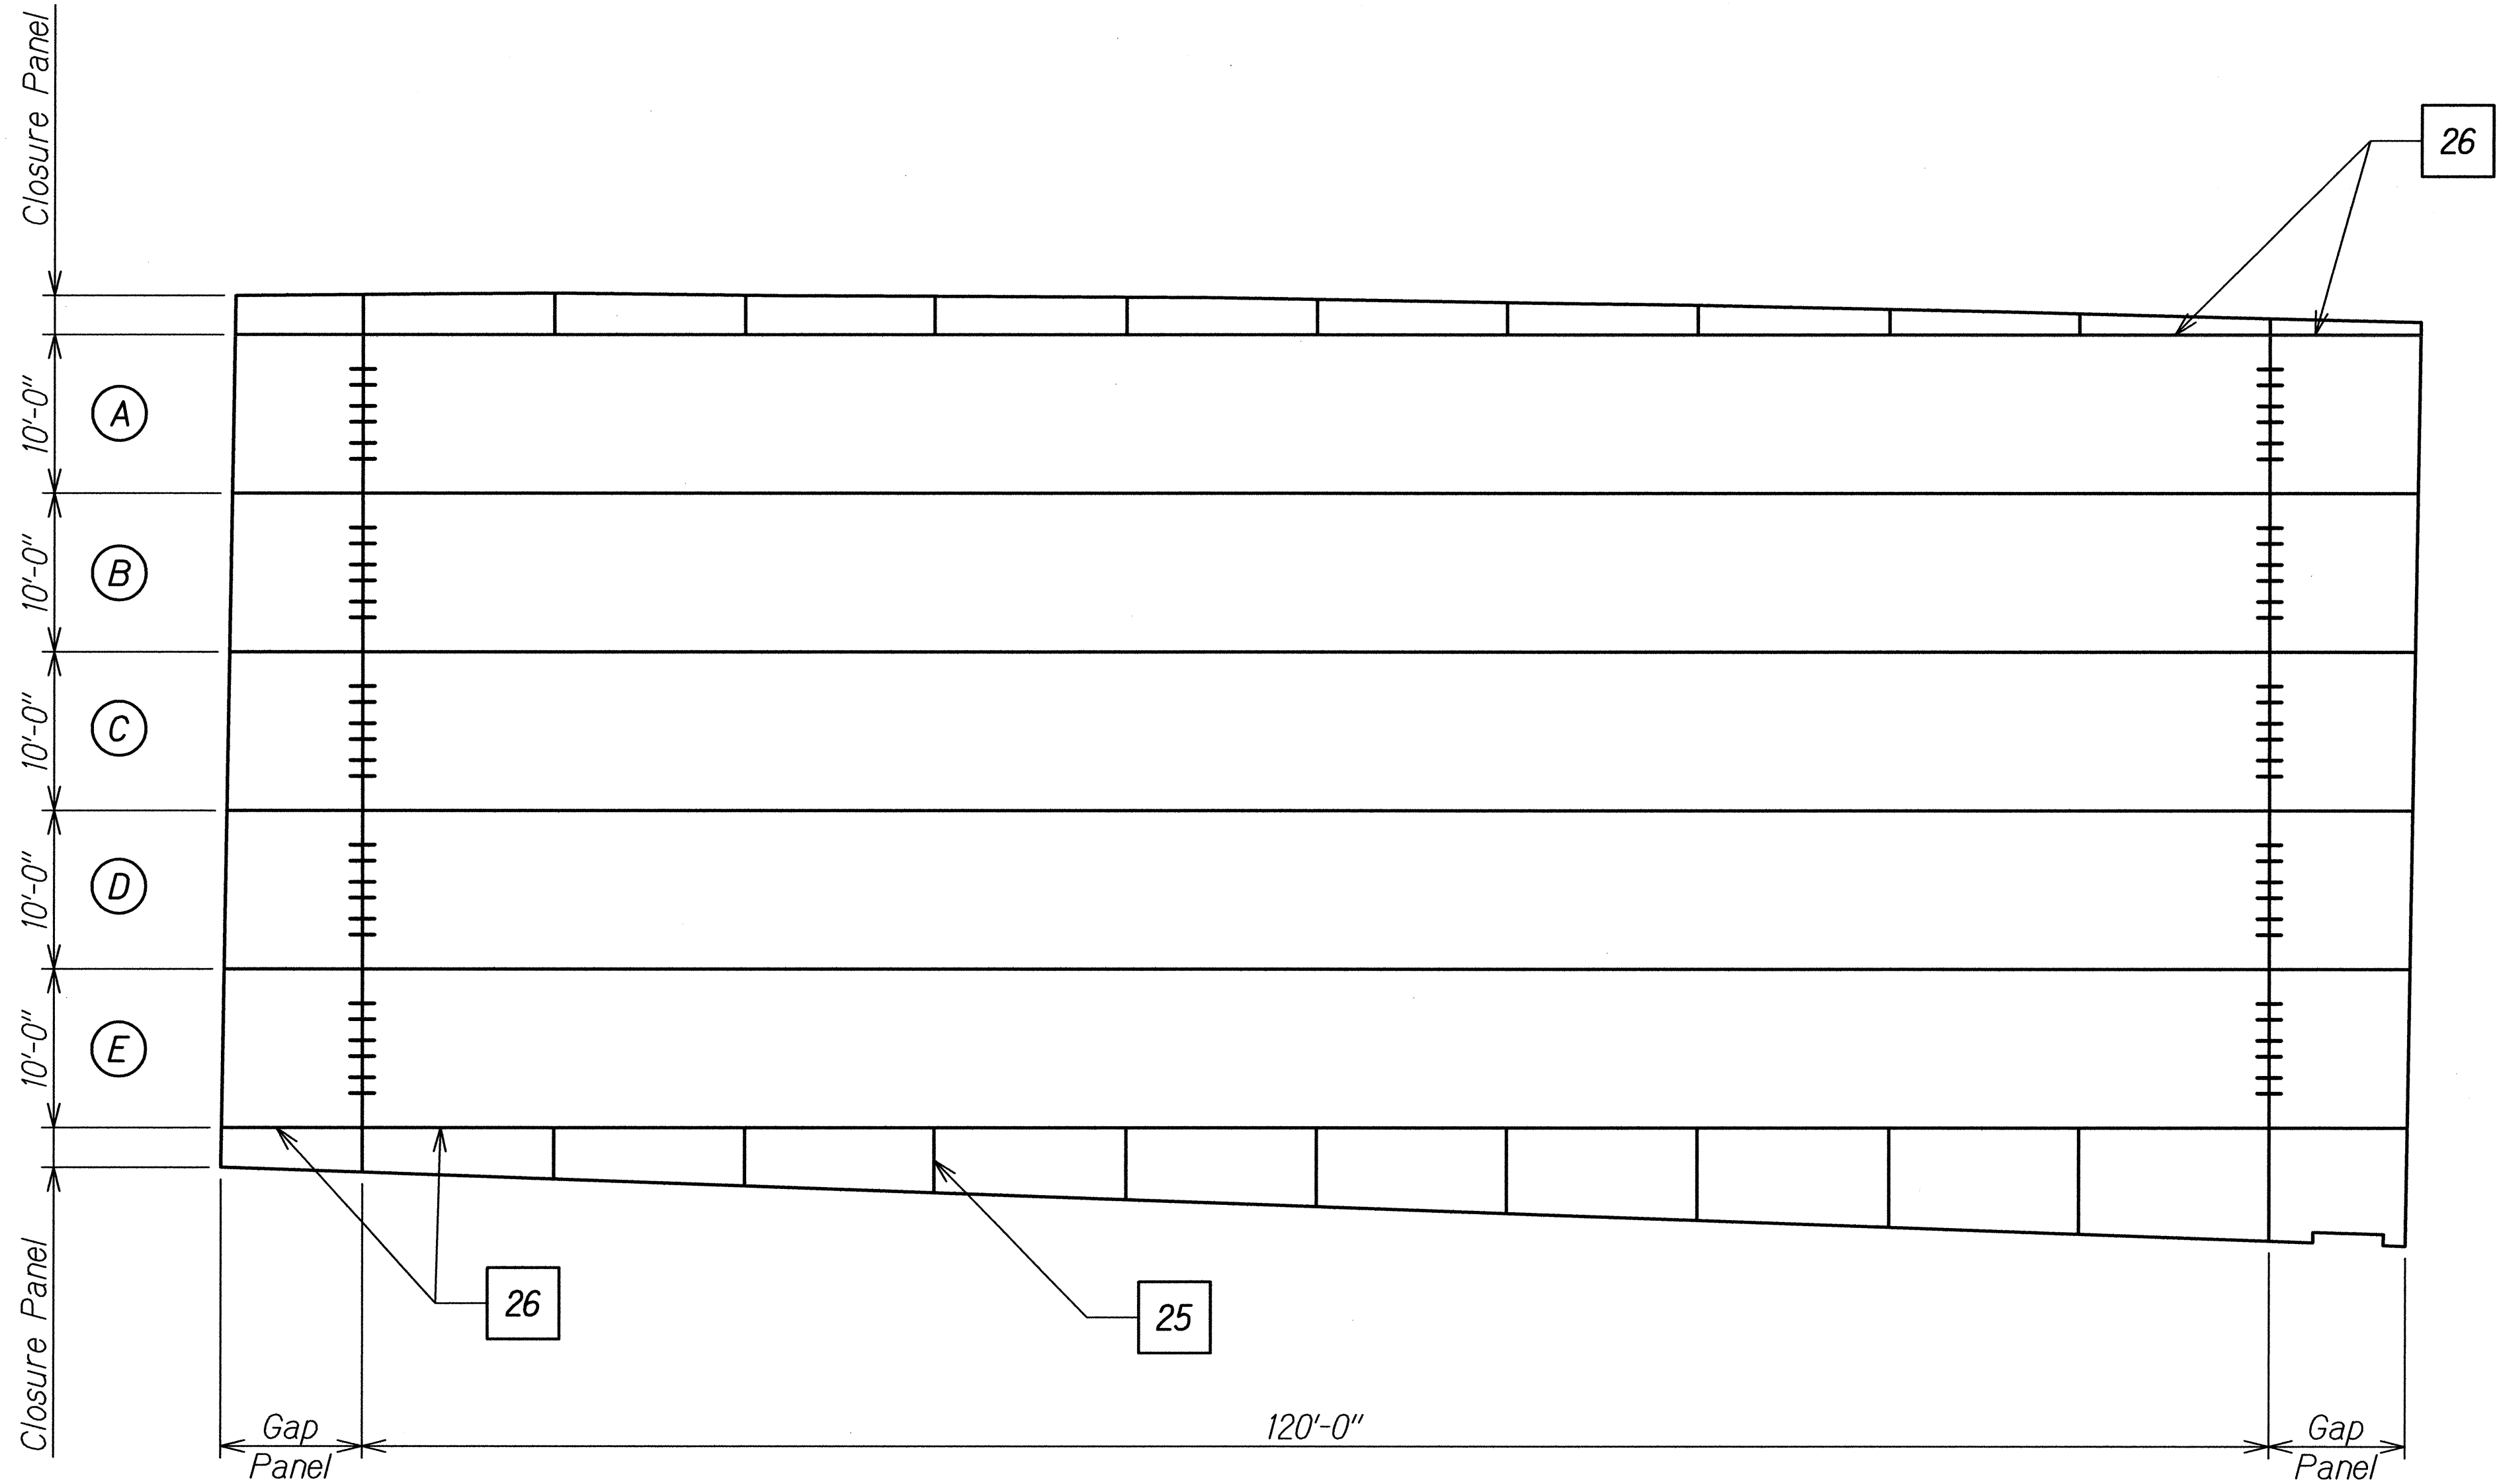

- Legend:**
- ① Column Designation
  - Ⓐ Row Designation
  - LTT-# Longitudinal Temporary Tendon
  - LPT-# Longitudinal Permanent Tendon
  - ▷ Jacking Ends
  - ◀ Dead Ends

- 25

Install Epoxy Coated Smooth Dowels And Epoxy Coated #5 Deformed Bars As Required In Gap Panels And Closure Panels. See Sheet S1.2.
- 26

Pour Gap Panels And Closure Panels.
- Note:

Construction of gap panels, Sequence 23 to 26 and closure panels may be phased and need not occur concurrently.

### INSTALLATION SEQUENCE

Scale: 1/8" = 1'-0"

|               |                   |      |
|---------------|-------------------|------|
| ORIGINAL PLAN | SURVEY PLOTTED BY | DATE |
| NOTE BOOK     | DRAWN BY          |      |
| No.           | DESIGNED BY       |      |
|               | QUANTITIES BY     |      |
|               | CHECKED BY        |      |

DRAWING NAME: Z:\00 ONGOING\12-0331-HFL MIDDLE STREET RECONSTRUCTION-BOTH CAD\06-19-14 BID\HFL-MS305 TO MS31.DWG PLOT TIME: 06-18-14, 7:26 PM

THIS WORK WAS PREPARED BY ME OR UNDER MY SUPERVISION.

*David K. Fujiwara*

SIGNATURE

4-30-16

EXPIRATION DATE OF THE LICENSE

STATE OF HAWAII

DEPARTMENT OF TRANSPORTATION

HIGHWAYS DIVISION

**PPCP LAYOUT PANEL**

**INSTALLATION SEQUENCE**

MIDDLE STREET PAVEMENT RECONSTRUCTION

North King Street to Kamehameha Highway


FAP NO. STP-7415(001)

Scale: As Noted Date: Jun. 20, 2014

SHEET No. S311 OF 12 SHEETS




| FED. ROAD DIST. NO. | STATE | FEDERAL AID PROJ. NO. | FISCAL YEAR | SHEET NO. | TOTAL SHEETS |
|---------------------|-------|-----------------------|-------------|-----------|--------------|
| HAWAII              | HAW.  | STP-7415(001)         | 2014        | 149       | 173          |

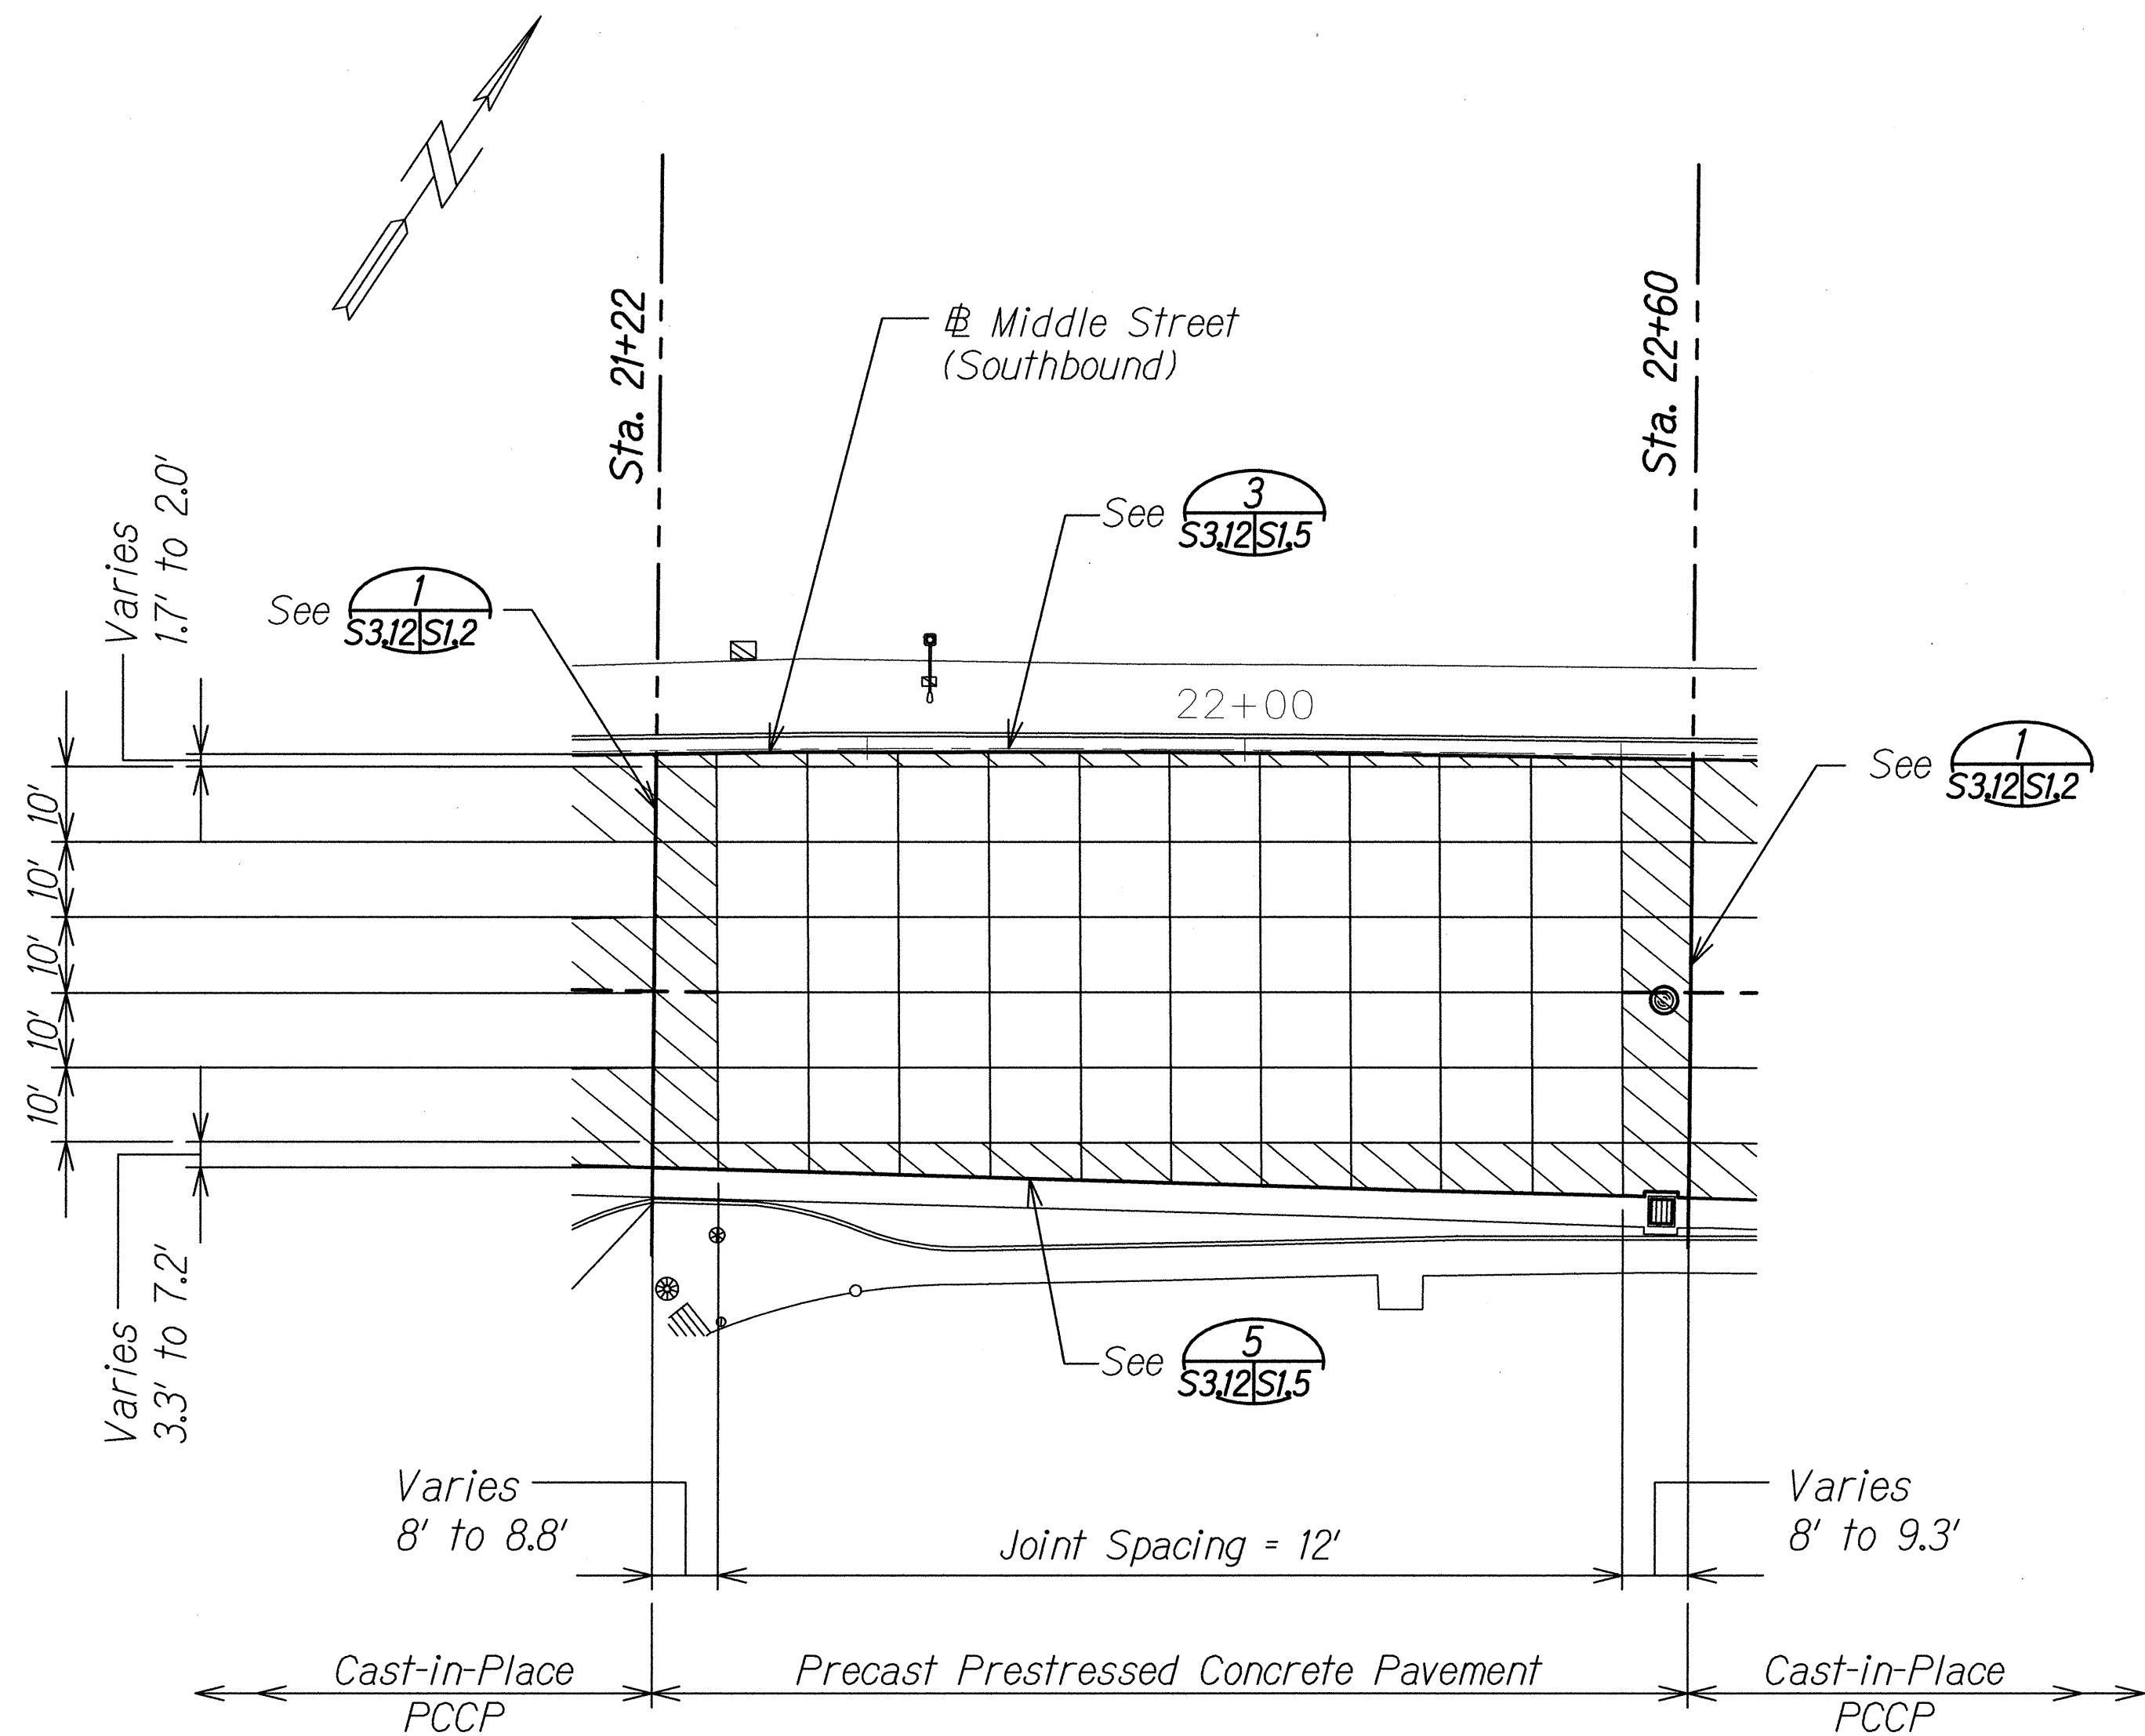

**PPCP JOINTING PLAN**  
 Scale: 1" = 20'-0"


**Legend:**

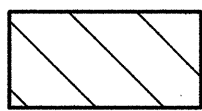 Odd Shaped / Cast-in-Place Sections on 6" Rapid Setting Lean Concrete Base

See General Notes 4.(F) and 7. (H) on Sheet S0.2.

|               |      |
|---------------|------|
| ORIGINAL PLAN | DATE |
| DESIGNED BY   |      |
| TRACED BY     |      |
| DESIGNED BY   |      |
| QUANTITIES BY |      |
| CHECKED BY    |      |
| No.           |      |

DRAWING NAME: 21+00 OINGONG V2-0331-HPL MIDDLE STREET RECONSTRUCTION-DOTHA CAD 06-19-14 BDA\VEL-MS\07 TO MS110 - MS208 TO MS210 - MS312.DWG PLOT TIME: 06-19-14, 9:11 AM

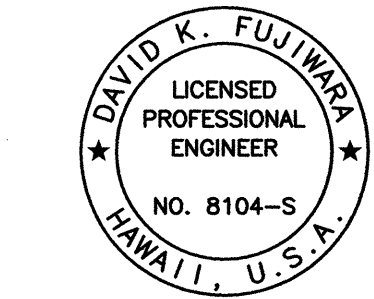





THIS WORK WAS PREPARED BY ME OR UNDER MY SUPERVISION.

*David K. Fujiwara*  
 SIGNATURE EXPIRATION DATE OF THE LICENSE: 4-30-16

STATE OF HAWAII  
 DEPARTMENT OF TRANSPORTATION  
 HIGHWAYS DIVISION


**PPCP JOINTING PLAN**  
 MIDDLE STREET PAVEMENT RECONSTRUCTION  
 North King Street to Kamehameha Highway  
 FAP NO. STP-7415(001)  
 Scale: As Noted Date: Jun. 20, 2014  
 SHEET No. S3/2 OF 12 SHEETS

| FED. ROAD DIST. NO. | STATE | FEDERAL AID PROJ. NO. | FISCAL YEAR | SHEET NO. | TOTAL SHEETS |
|---------------------|-------|-----------------------|-------------|-----------|--------------|
| HAWAII              | HAW.  | STP-7415(001)         | 2014        | 150       | 173          |

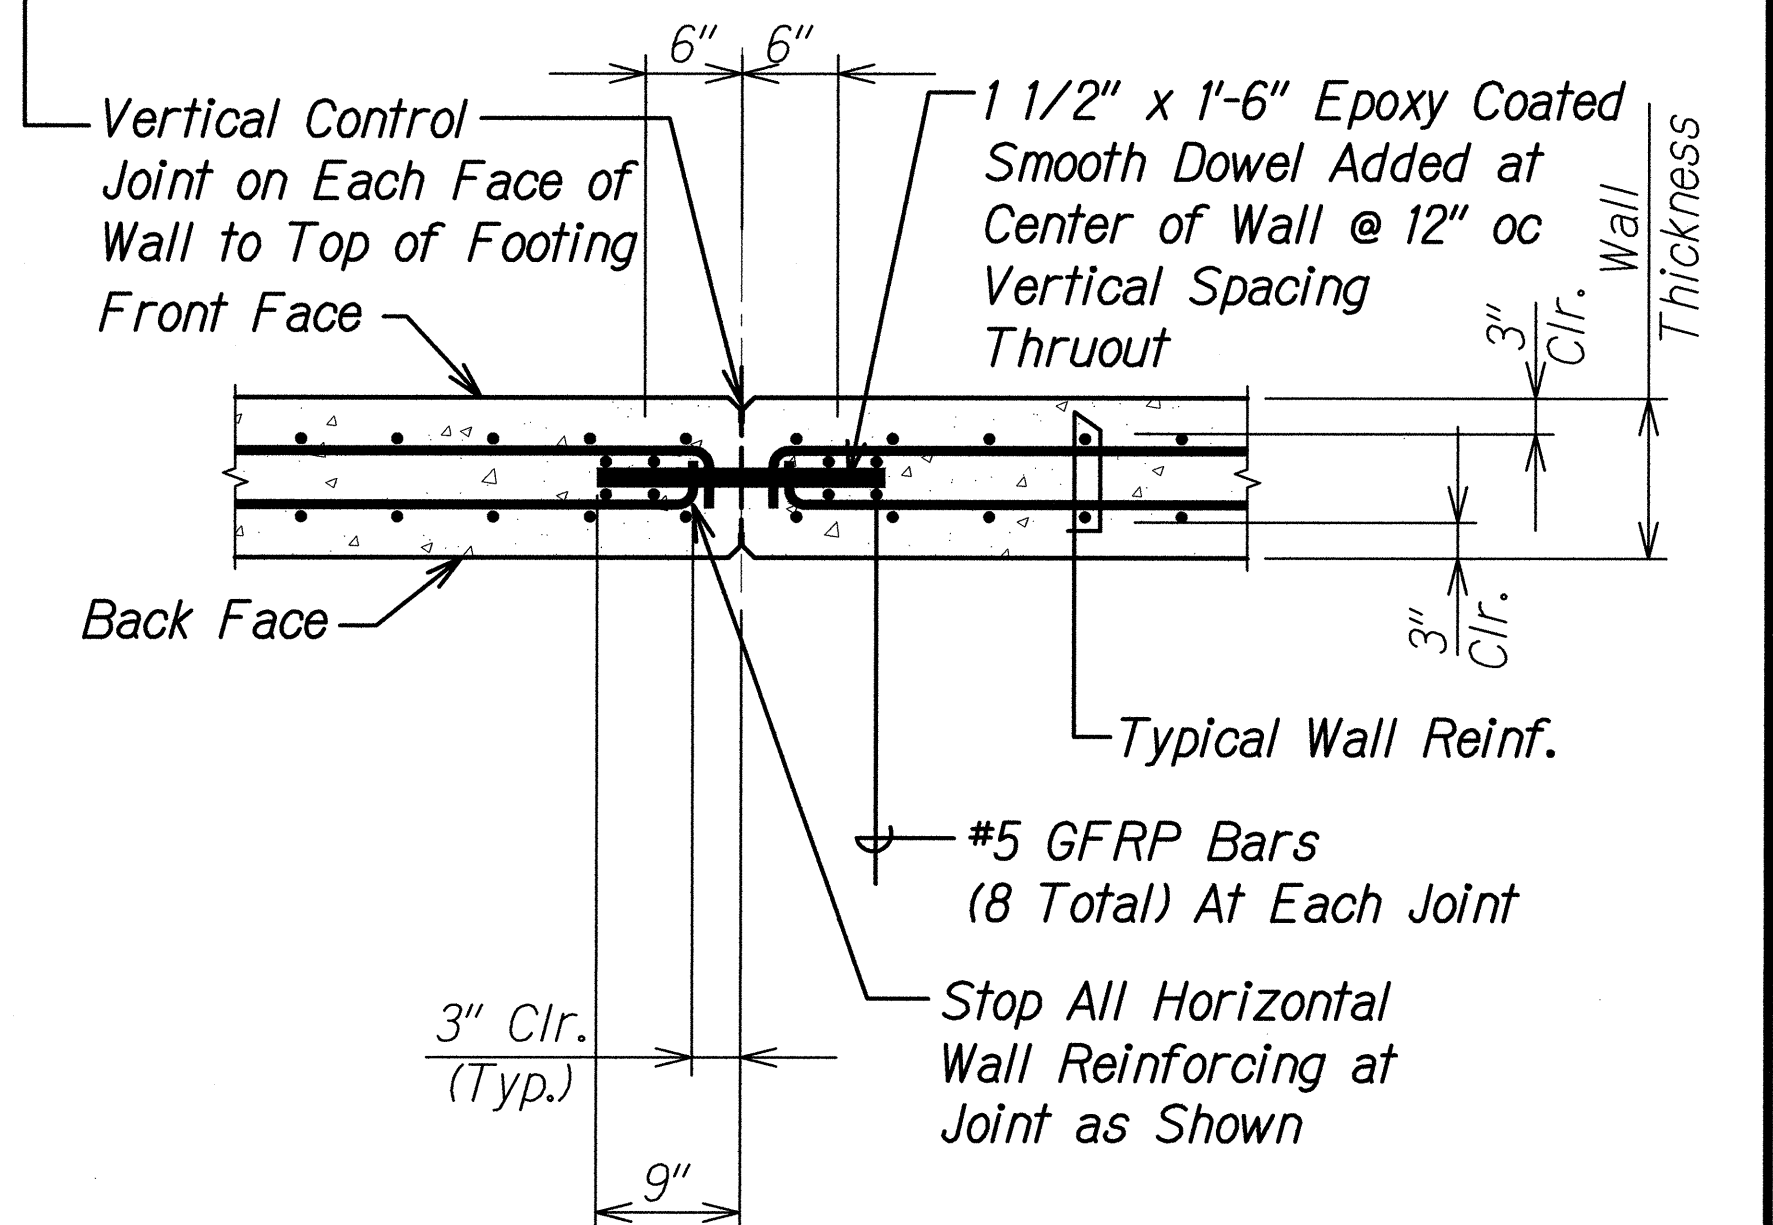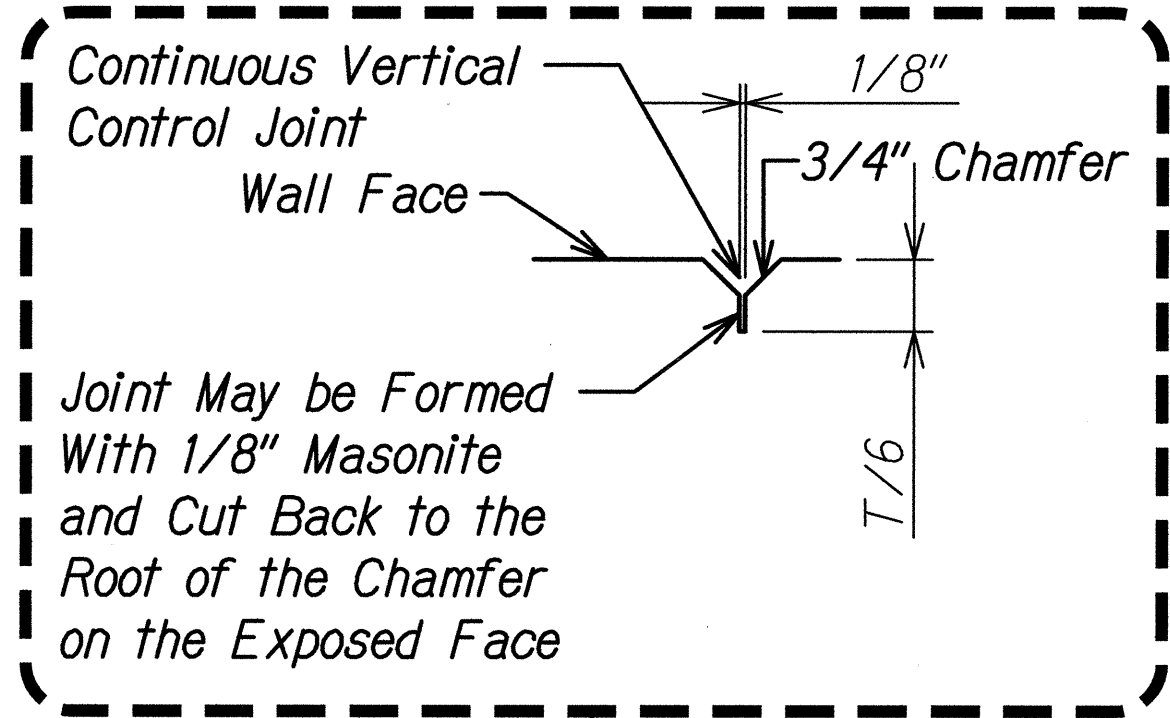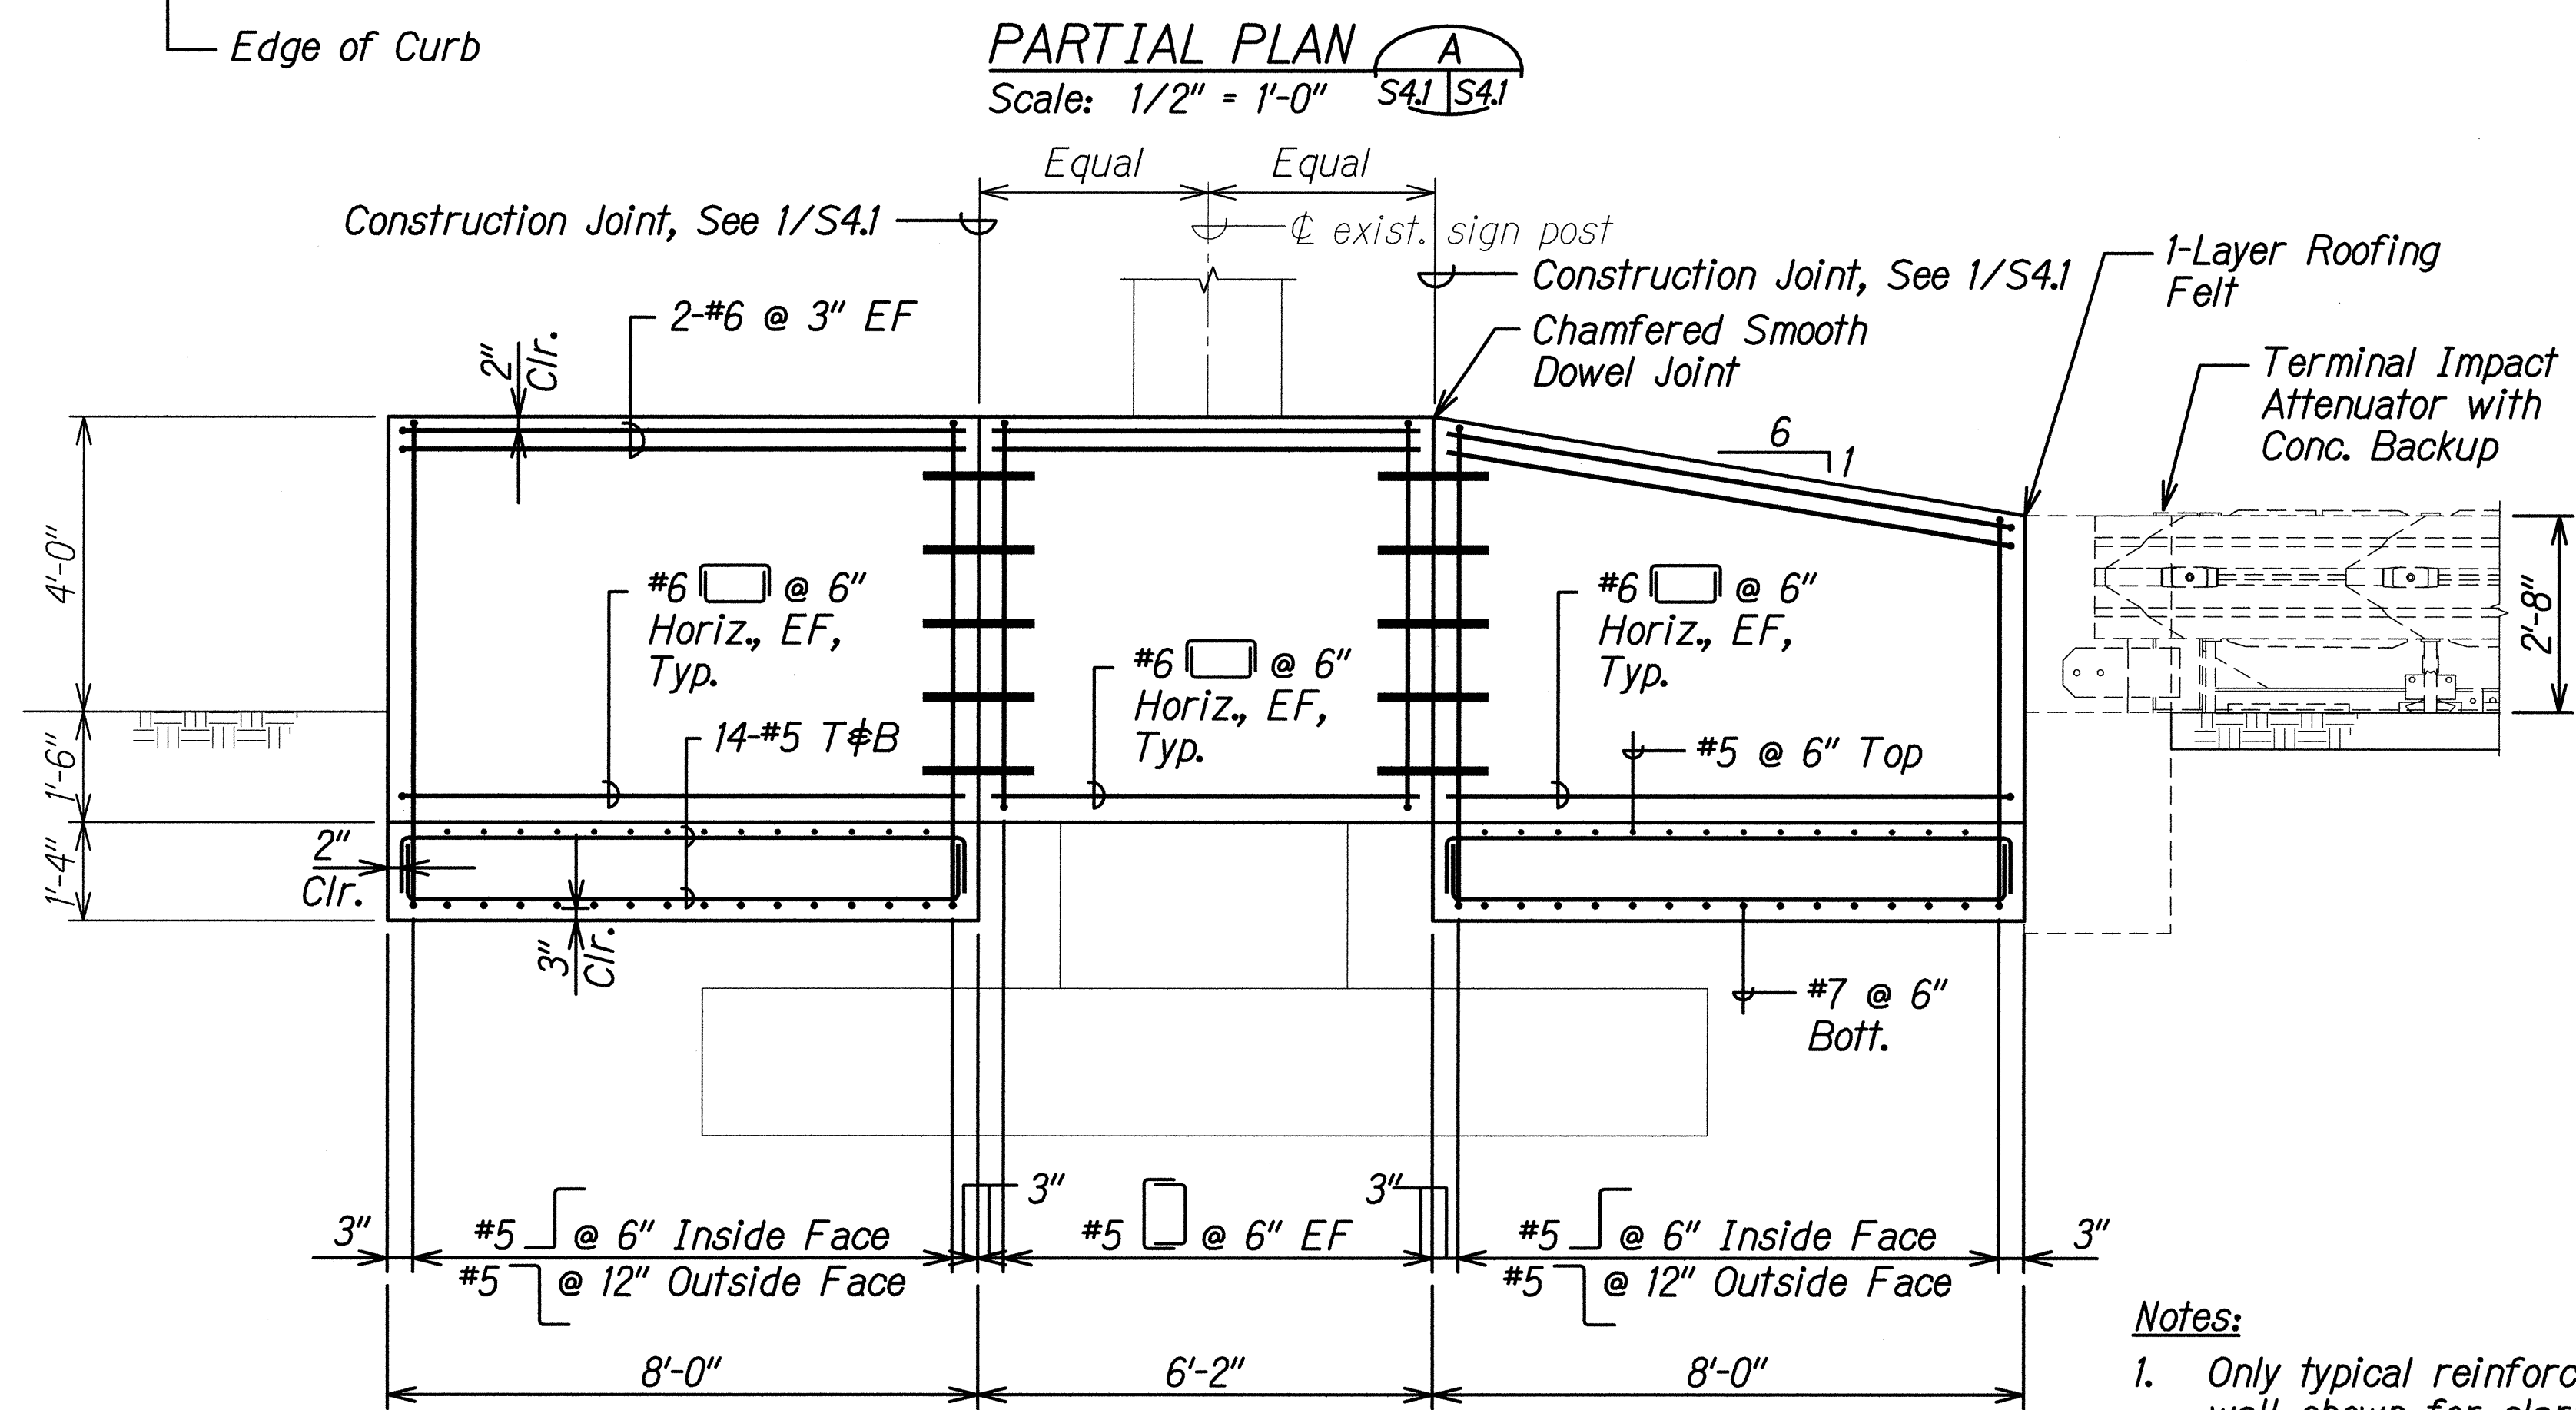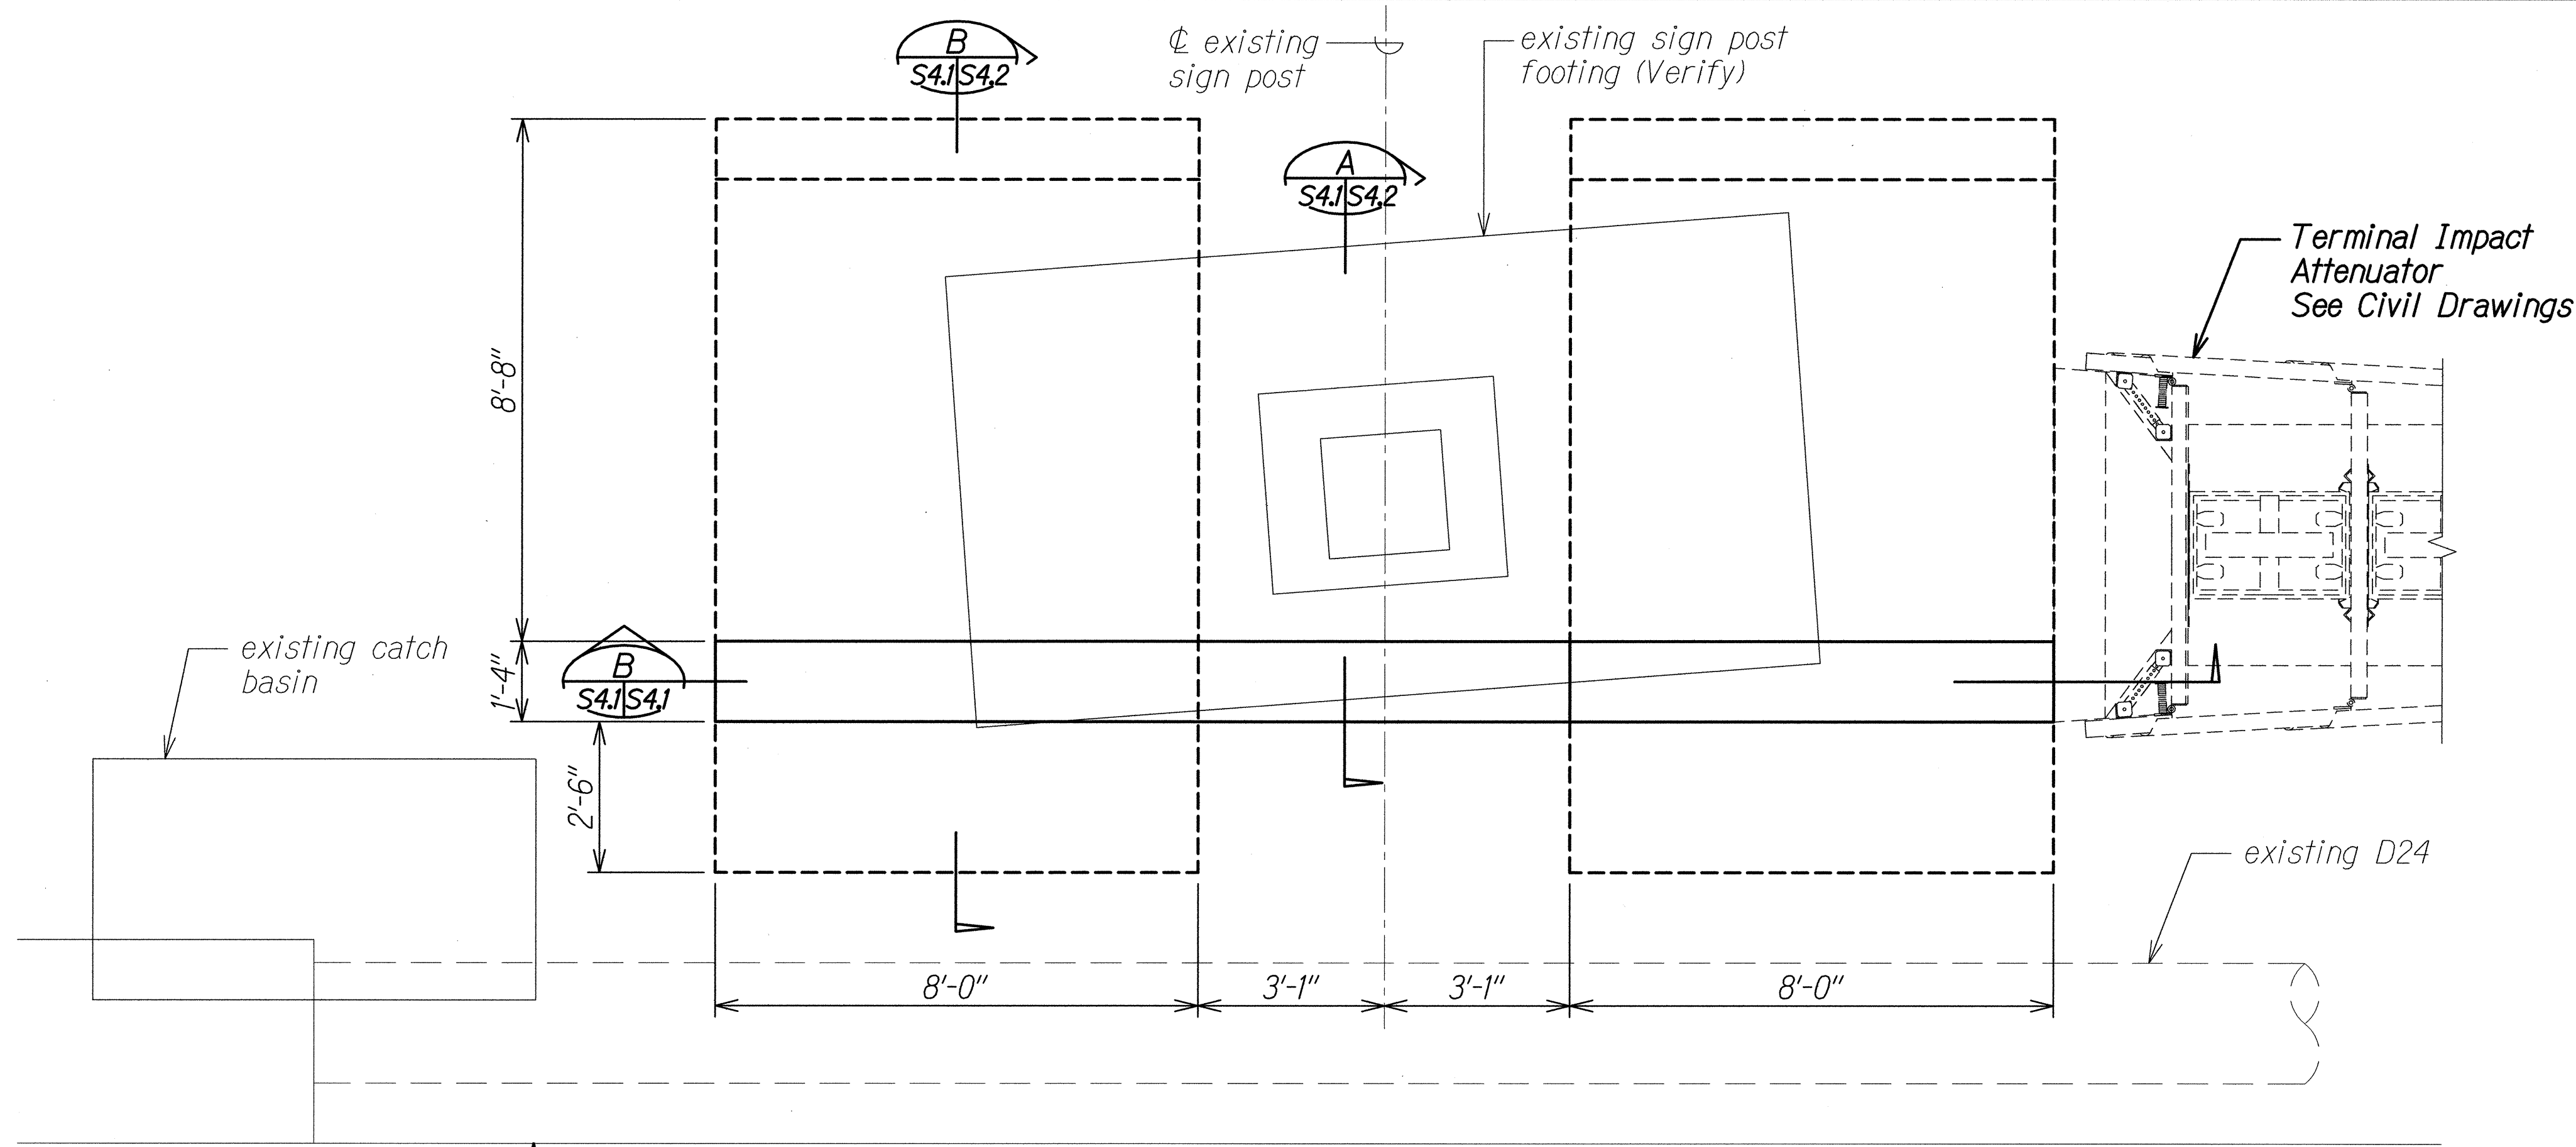

TYPICAL WALL VERTICAL CONSTRUCTION JOINT DETAIL  
Scale: 1/2" = 1'-0"

- Notes:
- Only typical reinforcing steel in wall shown for clarity.
  - For location see sheets RD-1.

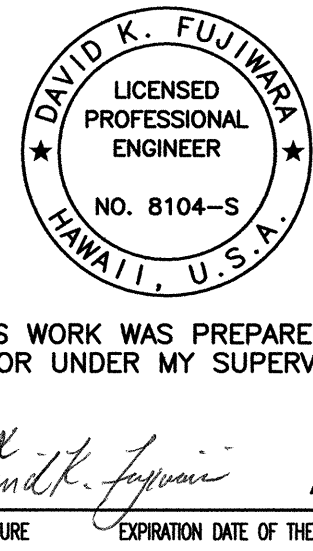

STATE OF HAWAII  
DEPARTMENT OF TRANSPORTATION  
HIGHWAYS DIVISION

**CONCRETE BARRIER**  
**AT SIGN POST**

MIDDLE STREET PAVEMENT RECONSTRUCTION  
North King Street to Kamehameha Highway  
FAP NO. STP-7415(001)

Scale: As Noted Date: Jun. 20, 2014



SHEET No. S41 OF 7 SHEETS

|      |             |            |
|------|-------------|------------|
| DATE | DESIGNED BY | CHECKED BY |
| NO.  | DESIGNED BY | CHECKED BY |

DRAWING NAME: 2100 ONGOING 12-0331-HL MIDDLE STREET RECONSTRUCTION-DOTD CAD 06-19-14 BID VFL-MS-01.DWG PLOT TIME: 06-19-14, 11:06 AM




| FED. ROAD DIST. NO. | STATE | FEDERAL AID PROJ. NO. | FISCAL YEAR | SHEET NO. | TOTAL SHEETS |
|---------------------|-------|-----------------------|-------------|-----------|--------------|
| HAWAII              | HAW.  | STP-7415(001)         | 2014        | 151       | 173          |

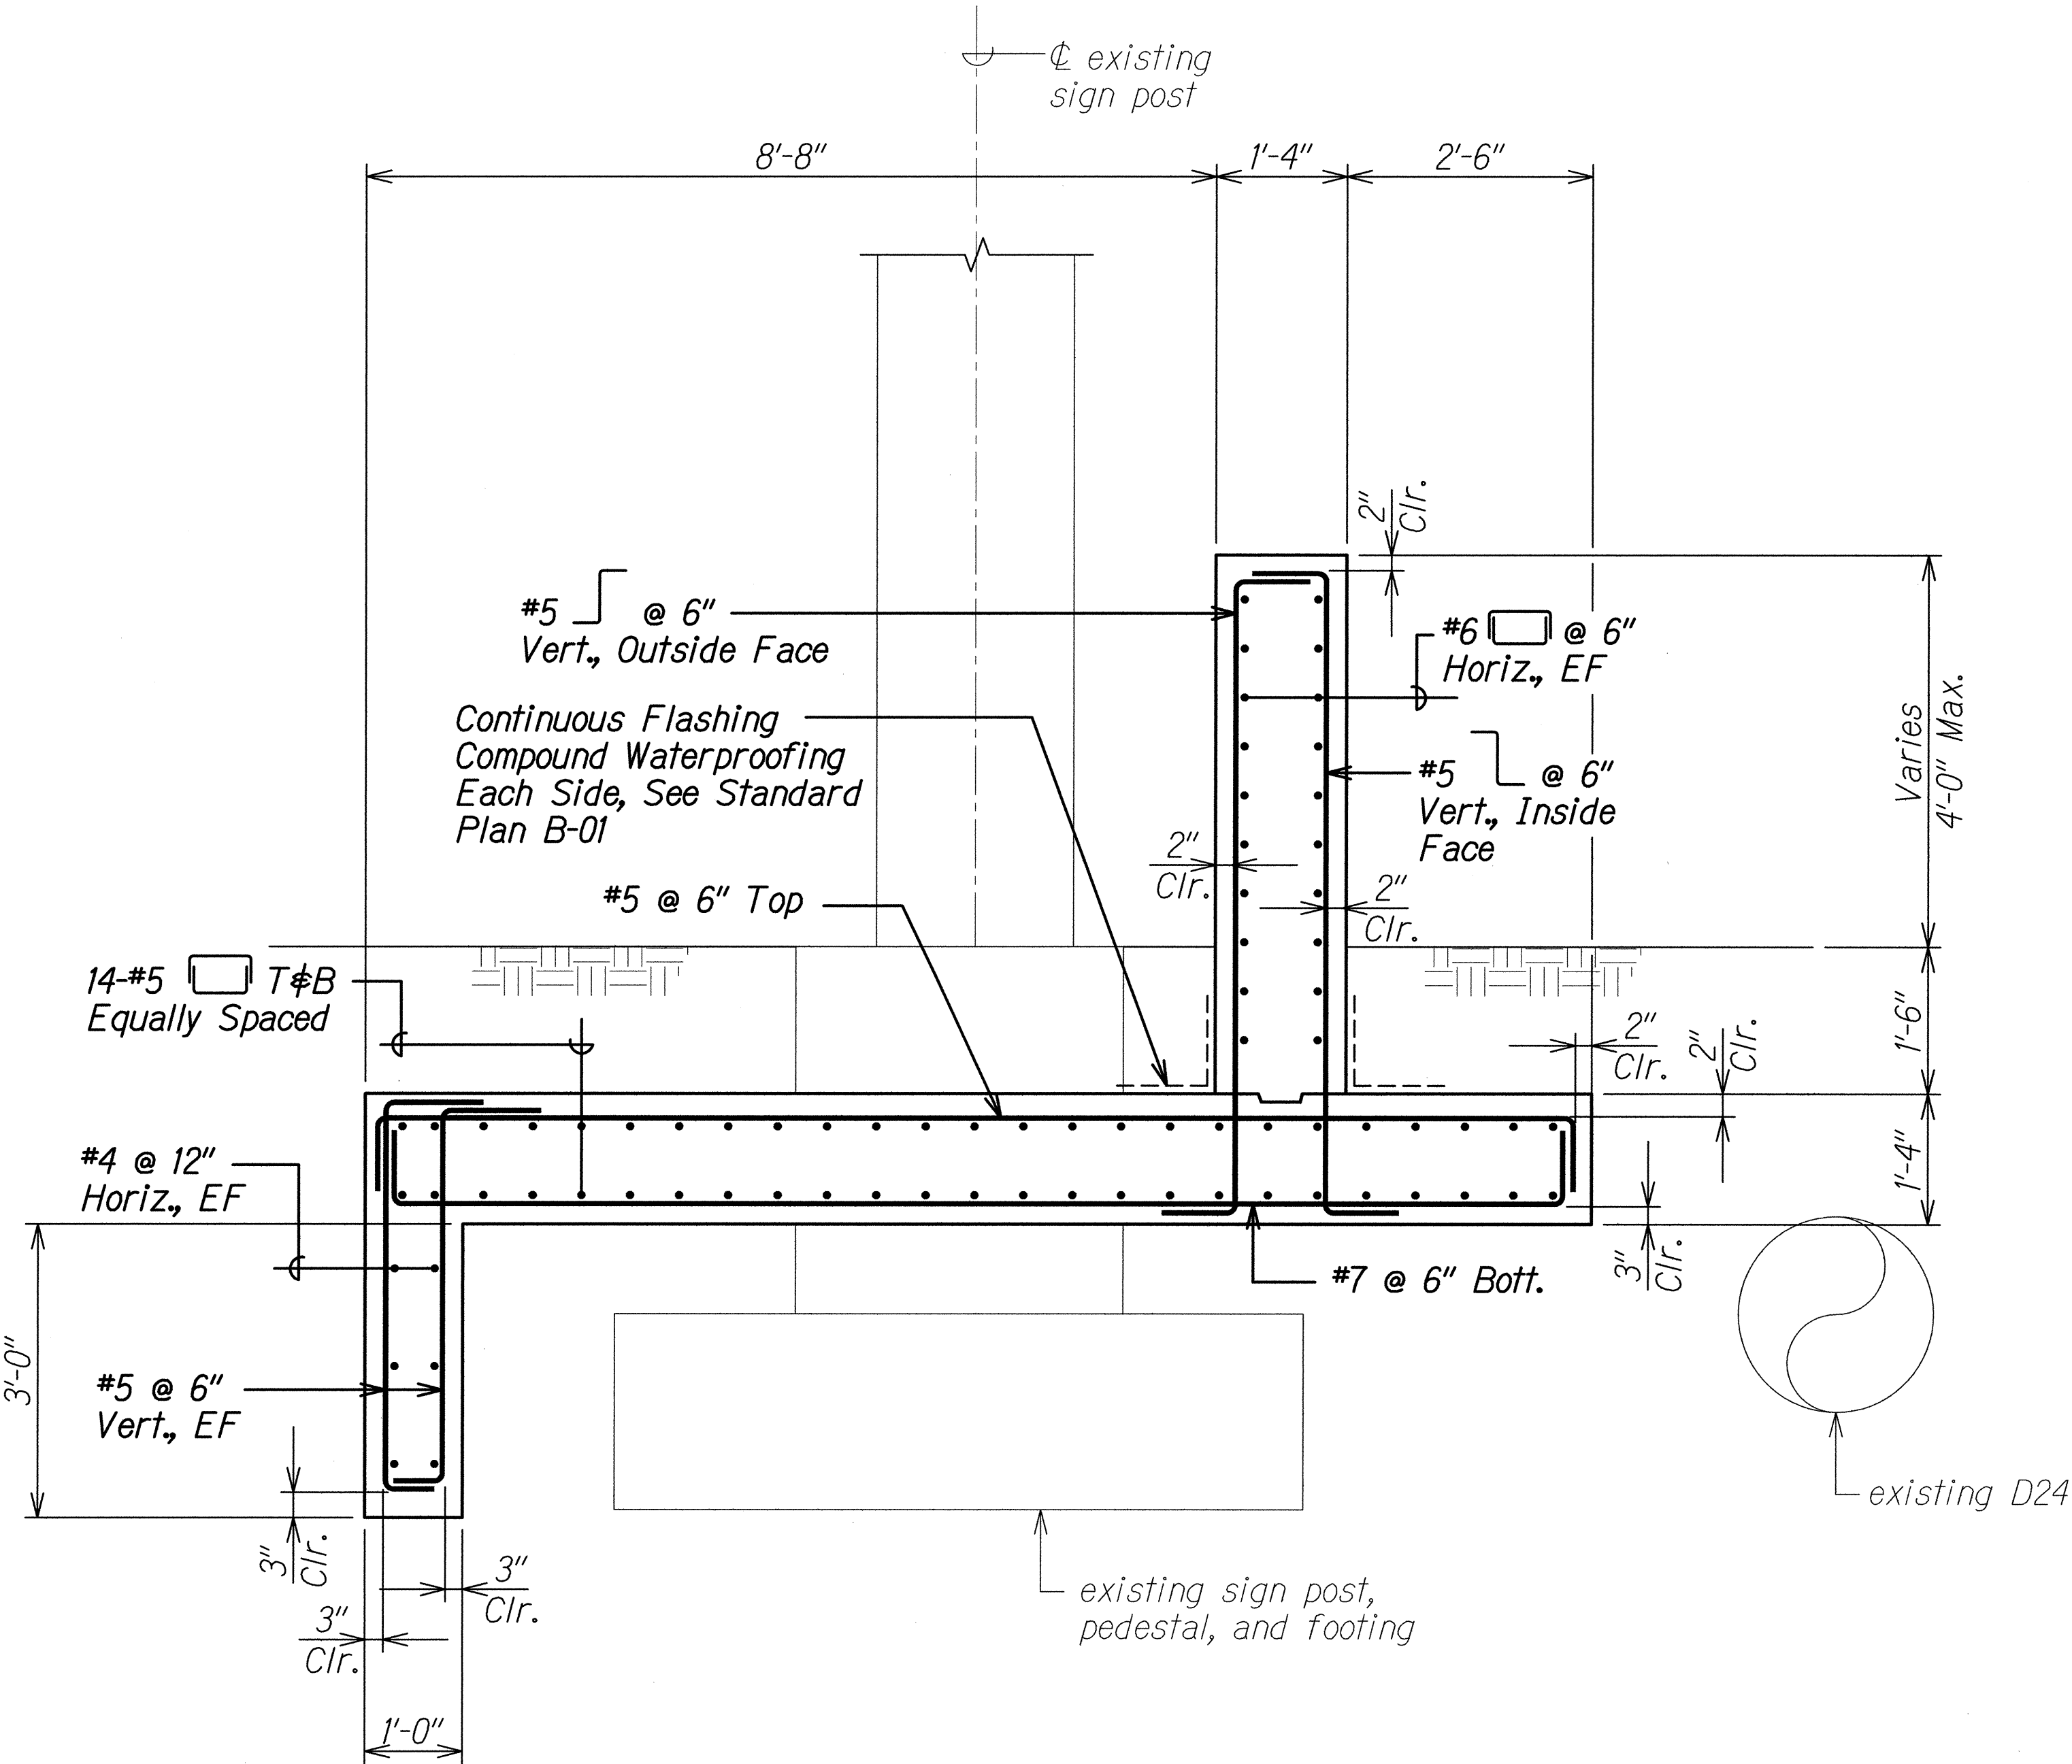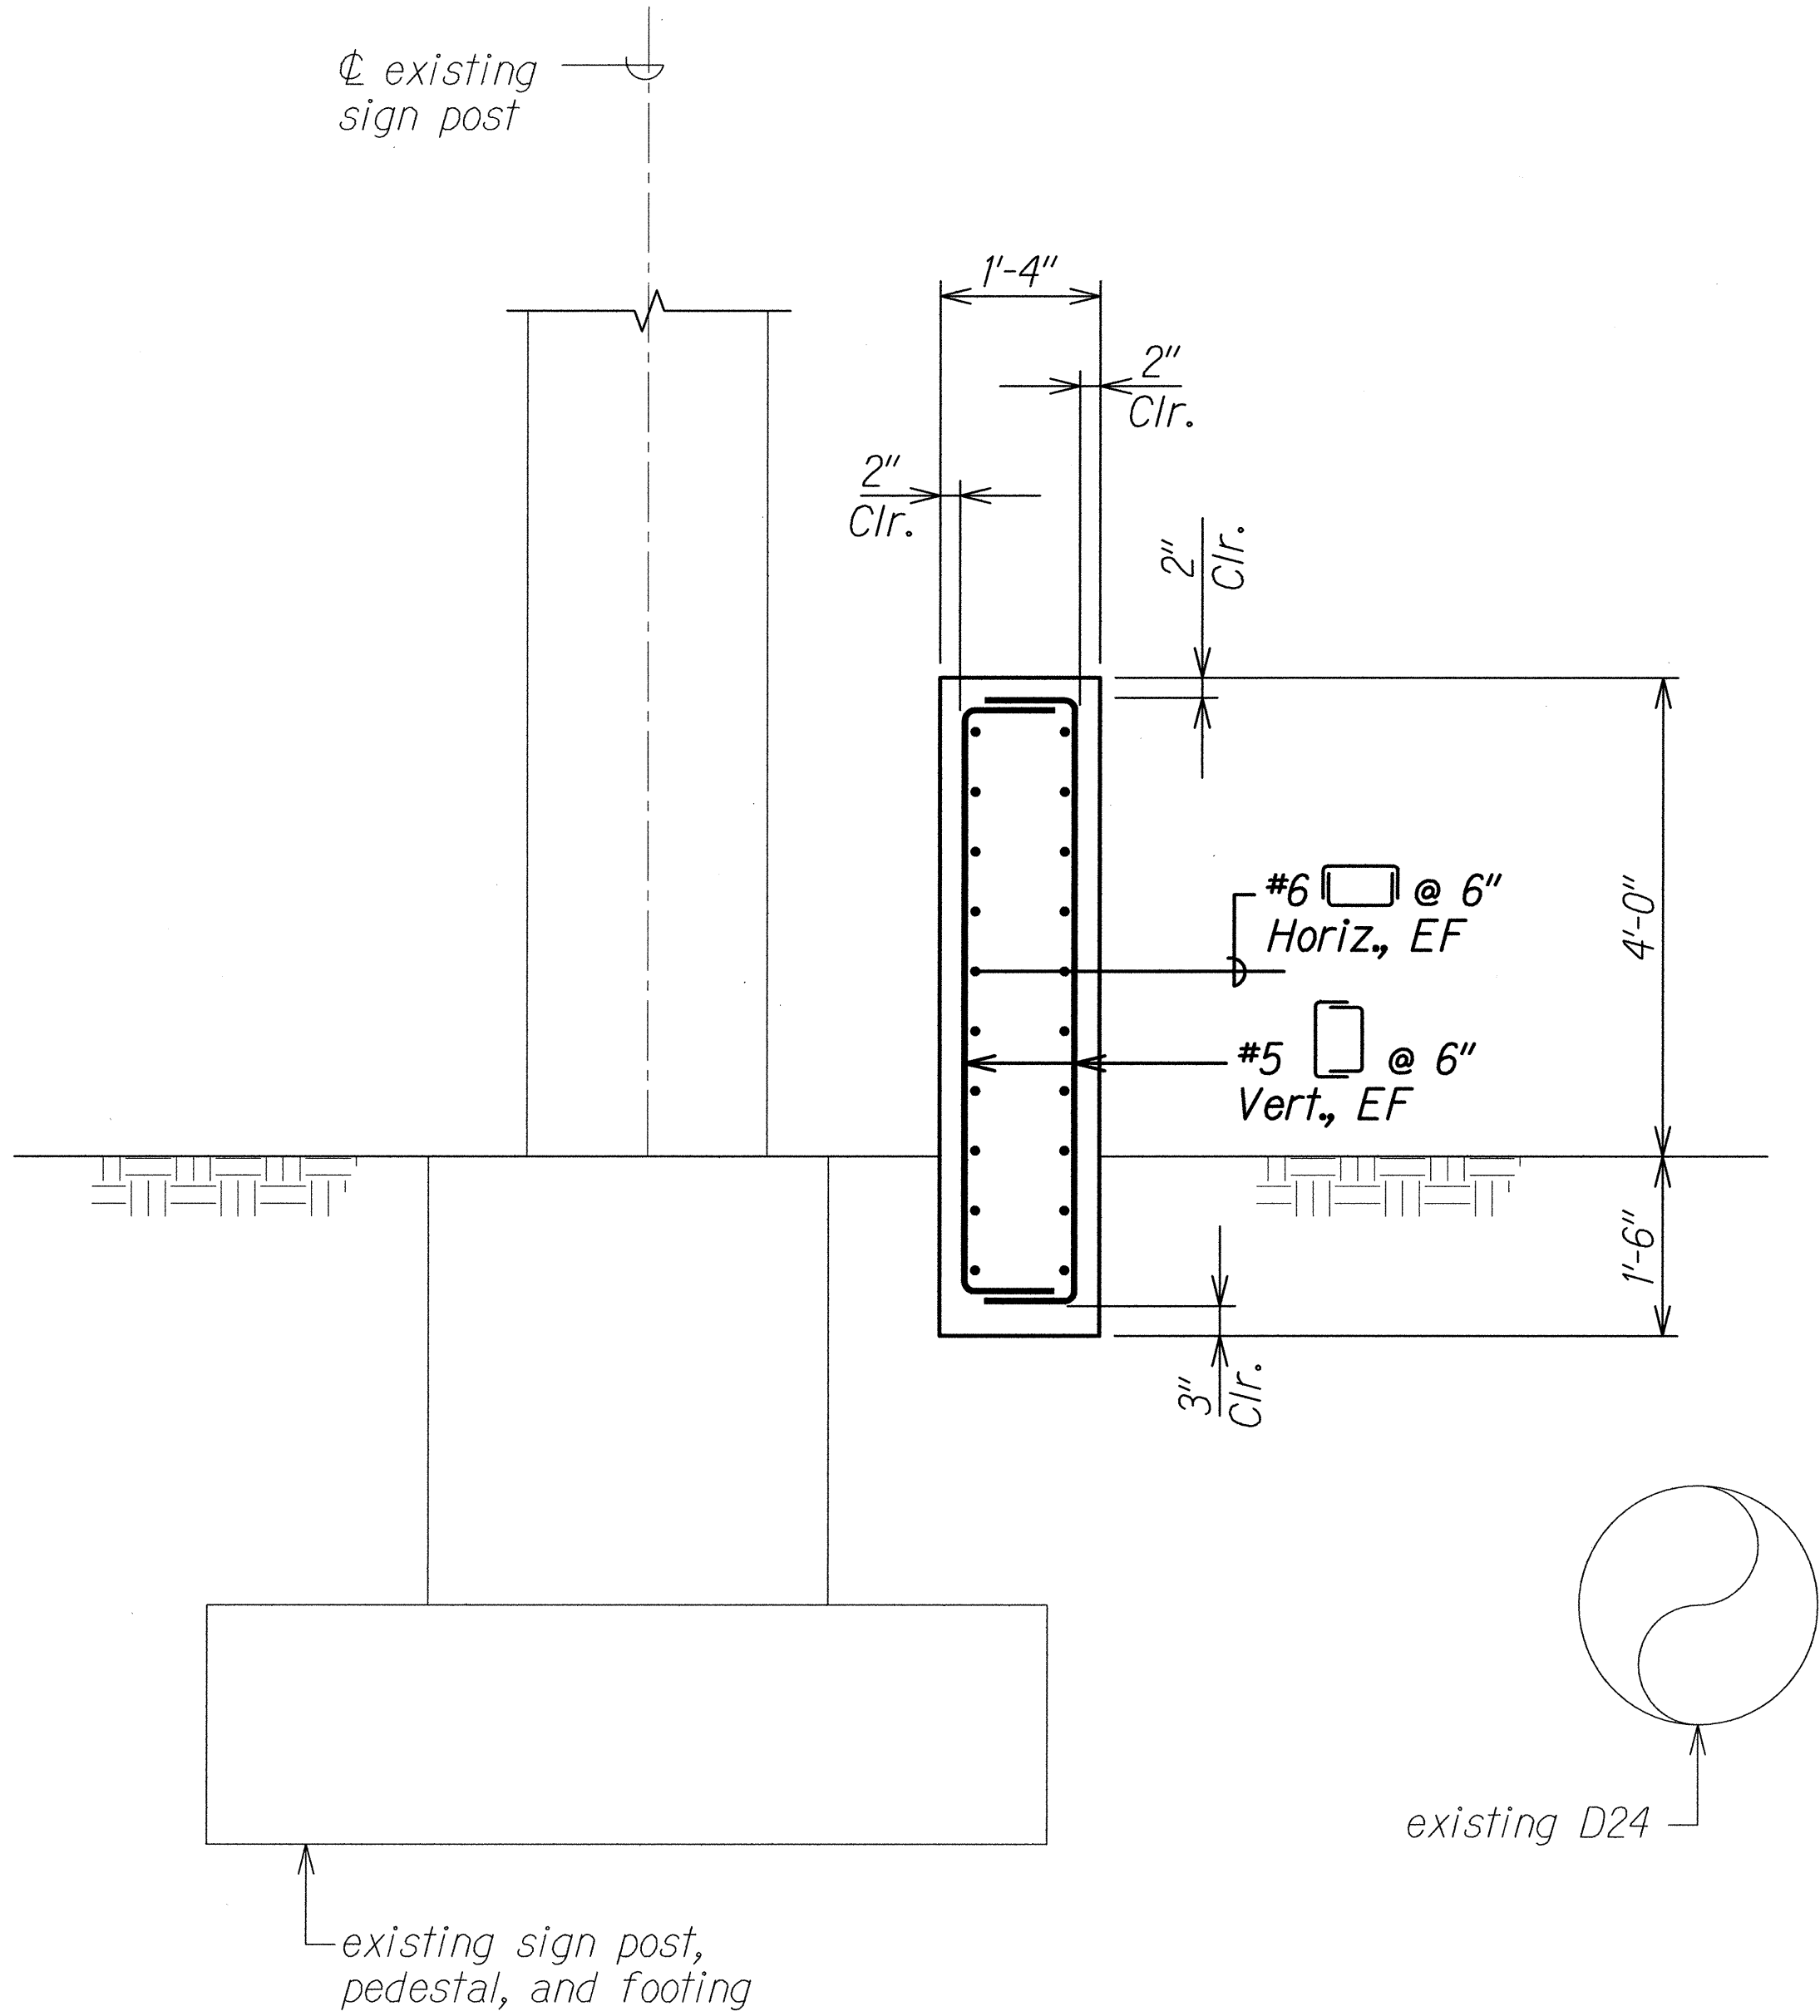

|                   |      |
|-------------------|------|
| SURVEY PLOTTED BY | DATE |
| DESIGNED BY       |      |
| TRACED BY         |      |
| NOTE BOOK         |      |
| QUANTITIES BY     |      |
| CHECKED BY        |      |
| No.               |      |

DRAWING NAME: 2100-ONGONG\12-0331-HFL MIDDLE STREET RECONSTRUCTION-40TH(CAD)06-19-14 BD\HFL-MS401.DWG PLOT TIME: 06-19-14, 11:06 AM

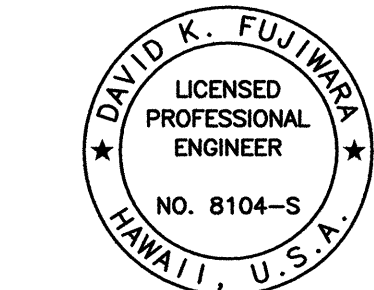


THIS WORK WAS PREPARED BY ME OR UNDER MY SUPERVISION.

SIGNATURE: *David K. Fujiwara* 4-30-16 EXPIRATION DATE OF THE LICENSE


STATE OF HAWAII  
DEPARTMENT OF TRANSPORTATION  
HIGHWAYS DIVISION  
**CONCRETE BARRIER**  
**AT SIGN POST SECTIONS**  
MIDDLE STREET PAVEMENT RECONSTRUCTION  
North King Street to Kamehameha Highway  
FAP NO. STP-7415(001)  
Scale: As Noted Date: Jun. 20, 2014  
SHEET No. S42 OF 7 SHEETS

151

| FED. ROAD DIST. NO. | STATE | FEDERAL AID PROJ. NO. | FISCAL YEAR | SHEET NO. | TOTAL SHEETS |
|---------------------|-------|-----------------------|-------------|-----------|--------------|
| HAWAII              | HAW.  | STP-7415(001)         | 2014        | 152       | 173          |

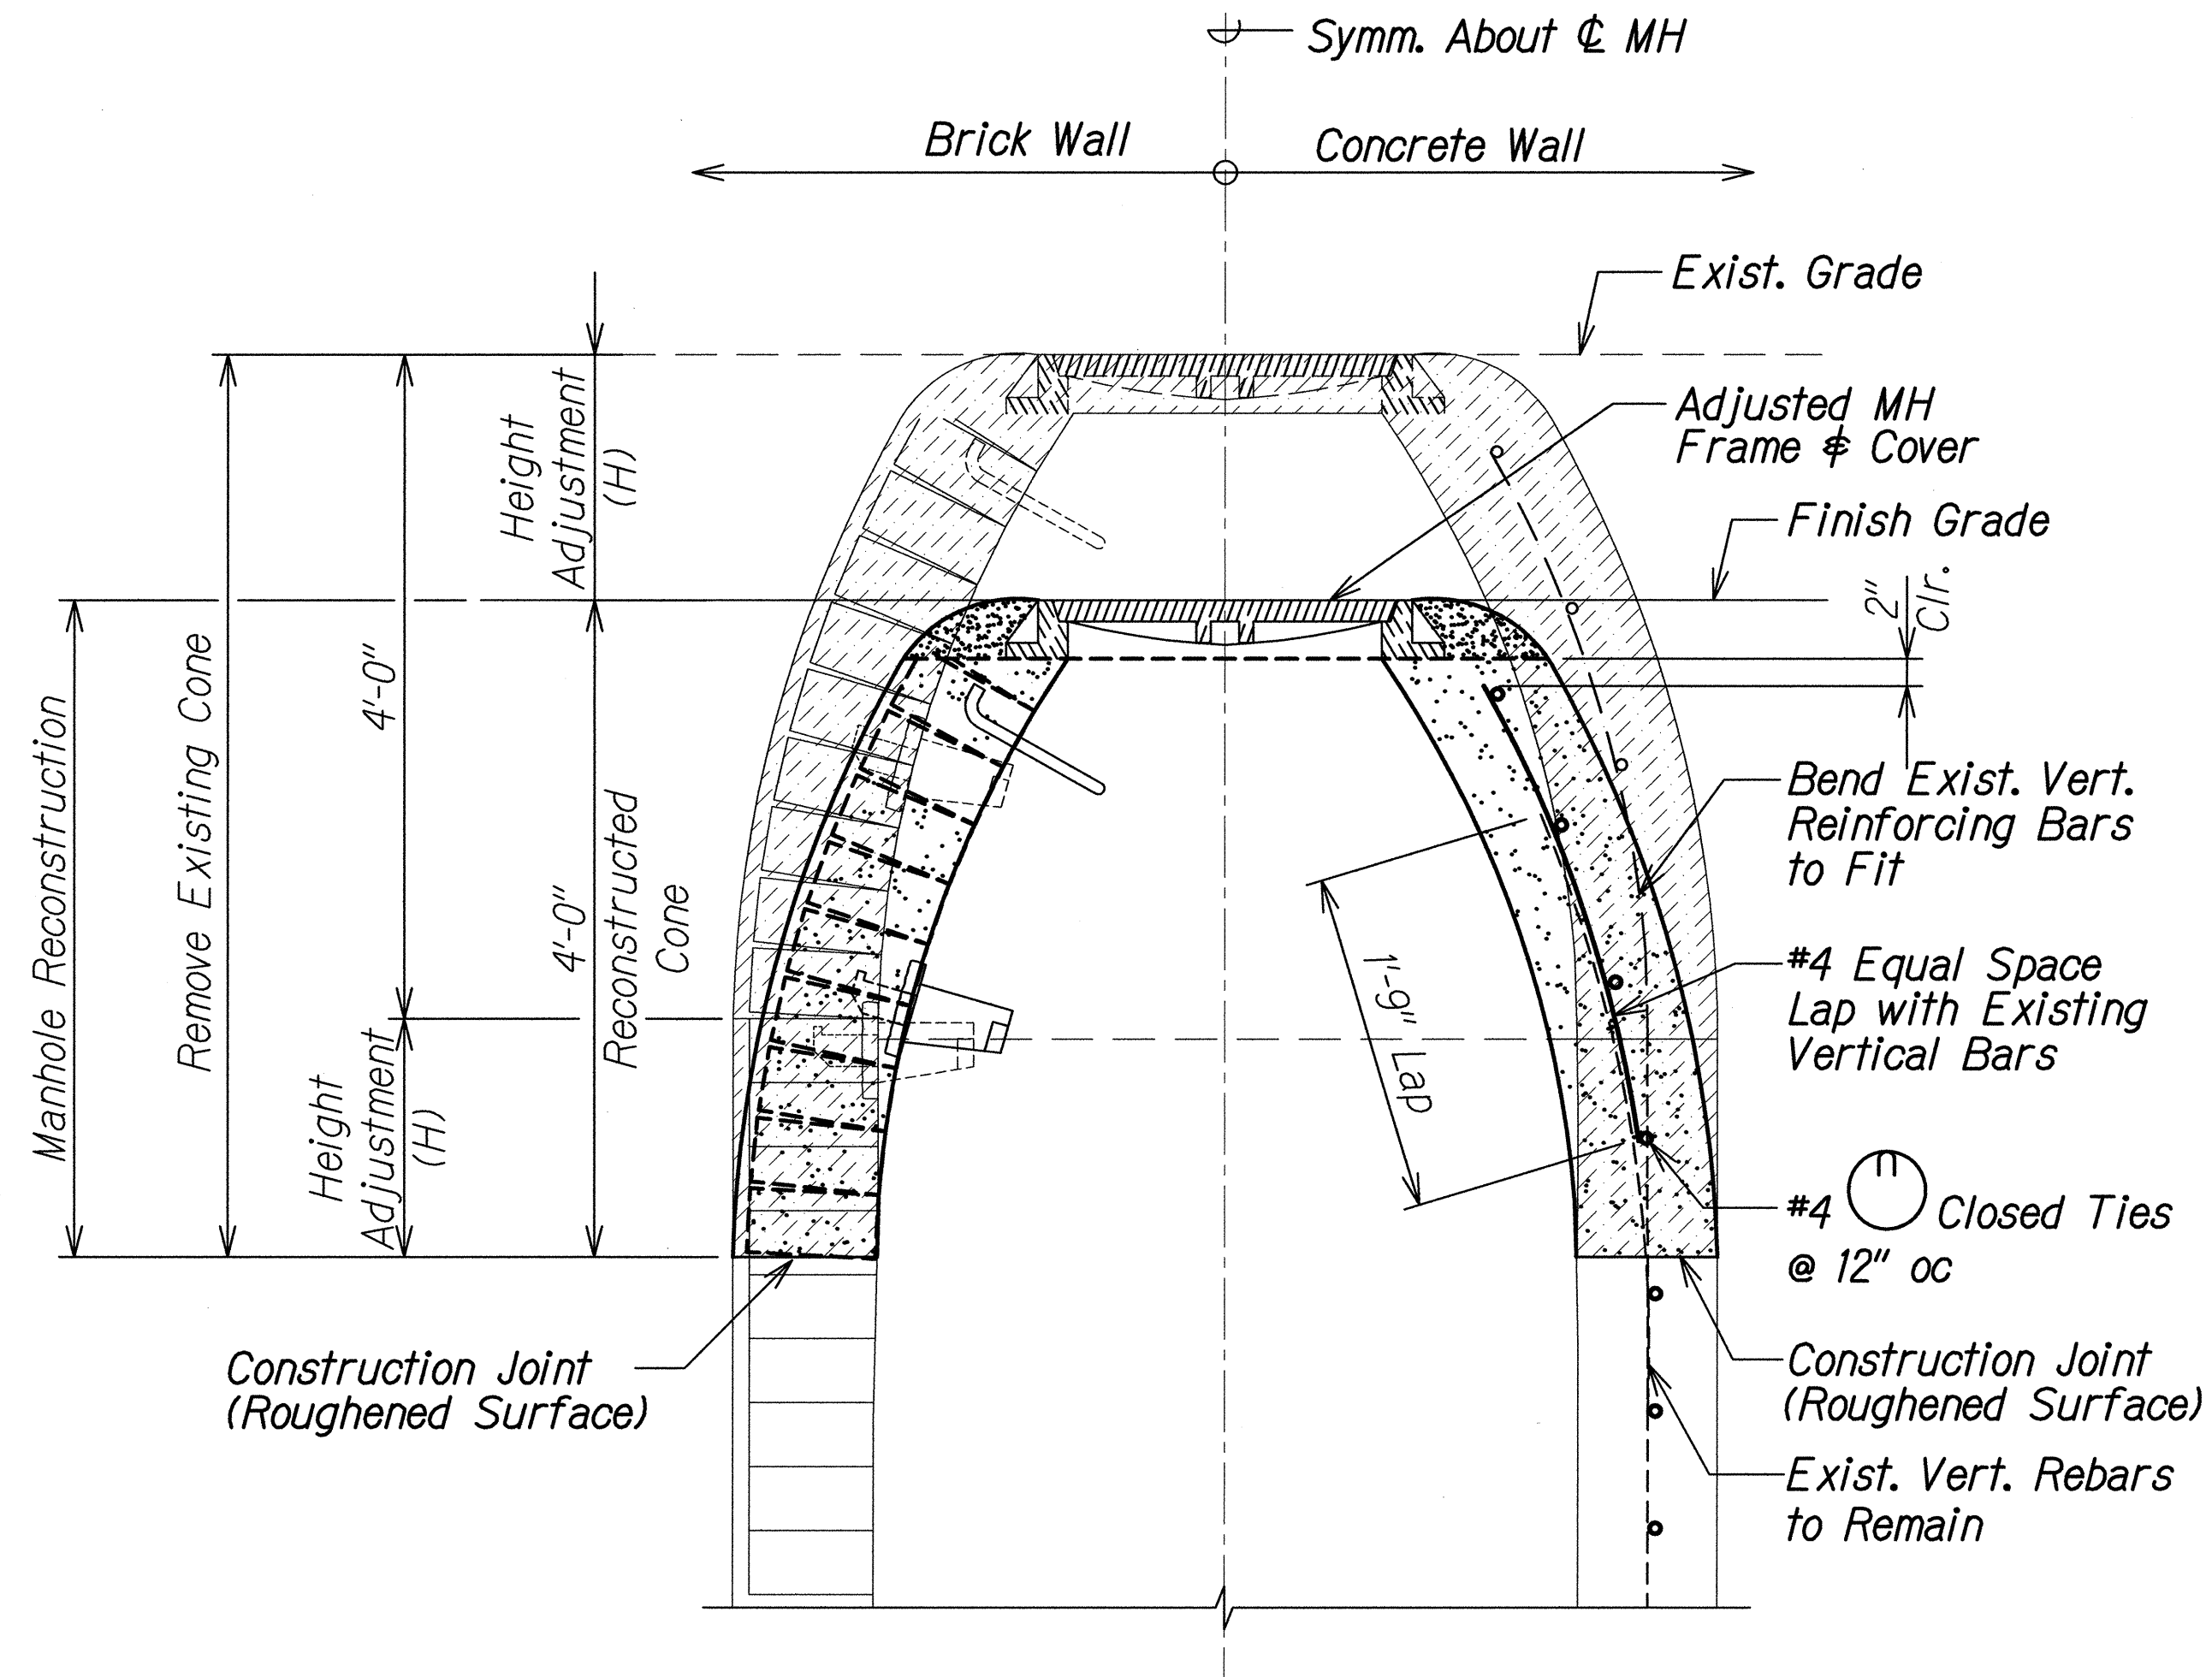

LOWERING

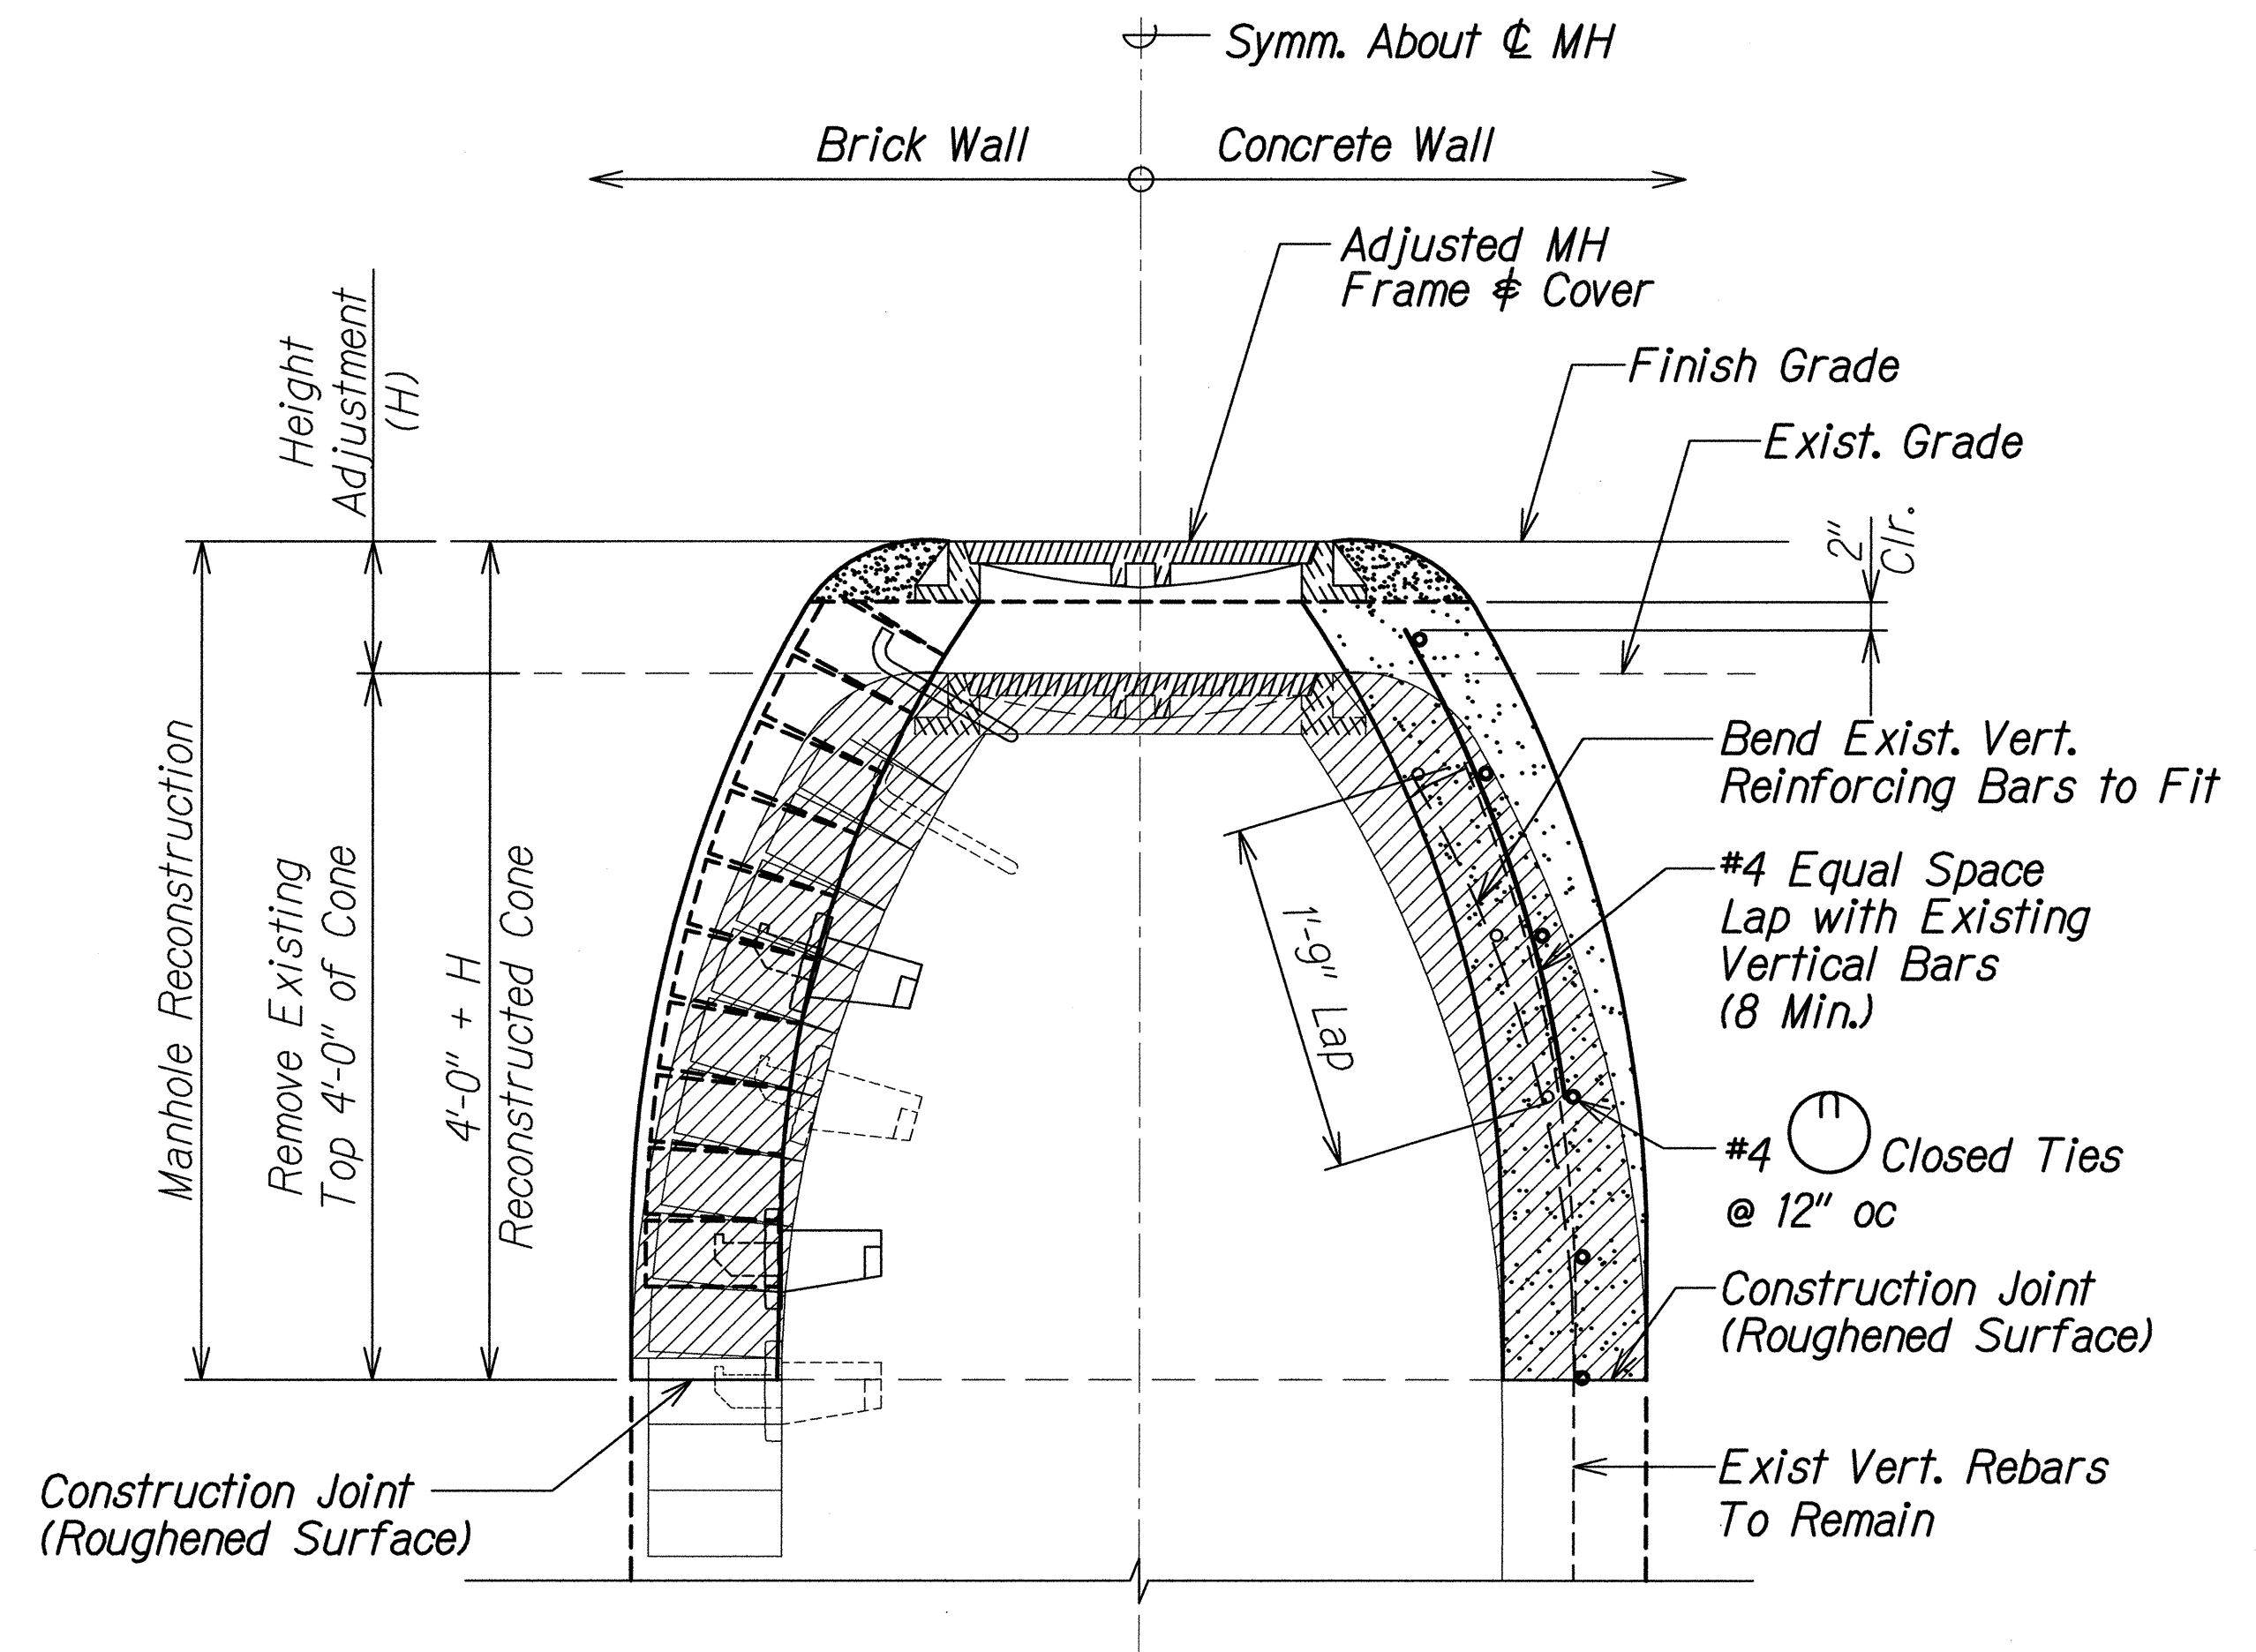


RAISING

## ADJUSTMENT / RECONSTRUCTION OF EXISTING MANHOLE COVER - CONICAL

Scale: 1" = 1'-0"

|               |                   |      |
|---------------|-------------------|------|
| ORIGINAL PLAN | SURVEY PLOTTED BY | DATE |
| NOTE BOOK     | DRAWN BY          |      |
| No.           | DESIGNED BY       |      |
|               | CHECKED BY        |      |

DRAWING NAME: Z:\00 ONGOING\12-033\1-HFL MIDDLE STREET RECONSTRUCTION-DOH\CAD\06-19-14 BID\HFL-MS403.DWG PLOT TIME: 06-18-14, 8:12 PM

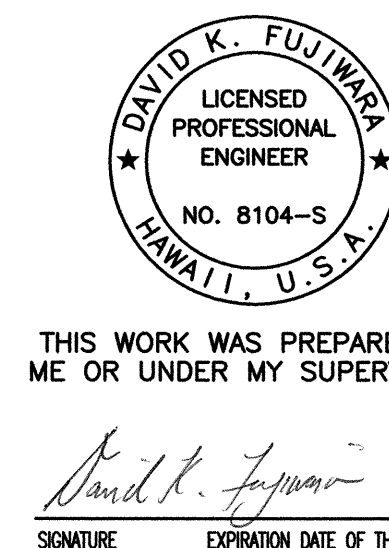

STATE OF HAWAII  
DEPARTMENT OF TRANSPORTATION  
HIGHWAYS DIVISION

**ROADWAY CONSTRUCTION DETAILS**  
**MANHOLE ADJUSTMENT/RECONSTRUCTION DETAILS**


MIDDLE STREET PAVEMENT RECONSTRUCTION  
North King Street to Kamehameha Highway  
FAP NO. STP-7415(001)

Scale: As Noted Date: Jun. 20, 2014

SHEET No. 543 OF 7 SHEETS



| FED. ROAD<br>DIST. NO. | STATE | FEDERAL AID<br>PROJ. NO. | FISCAL<br>YEAR | SHEET<br>NO. | TOTAL<br>SHEETS |
|------------------------|-------|--------------------------|----------------|--------------|-----------------|
| HAWAII                 | HAW.  | STP-7415(001)            | 2014           | 153          | 173             |

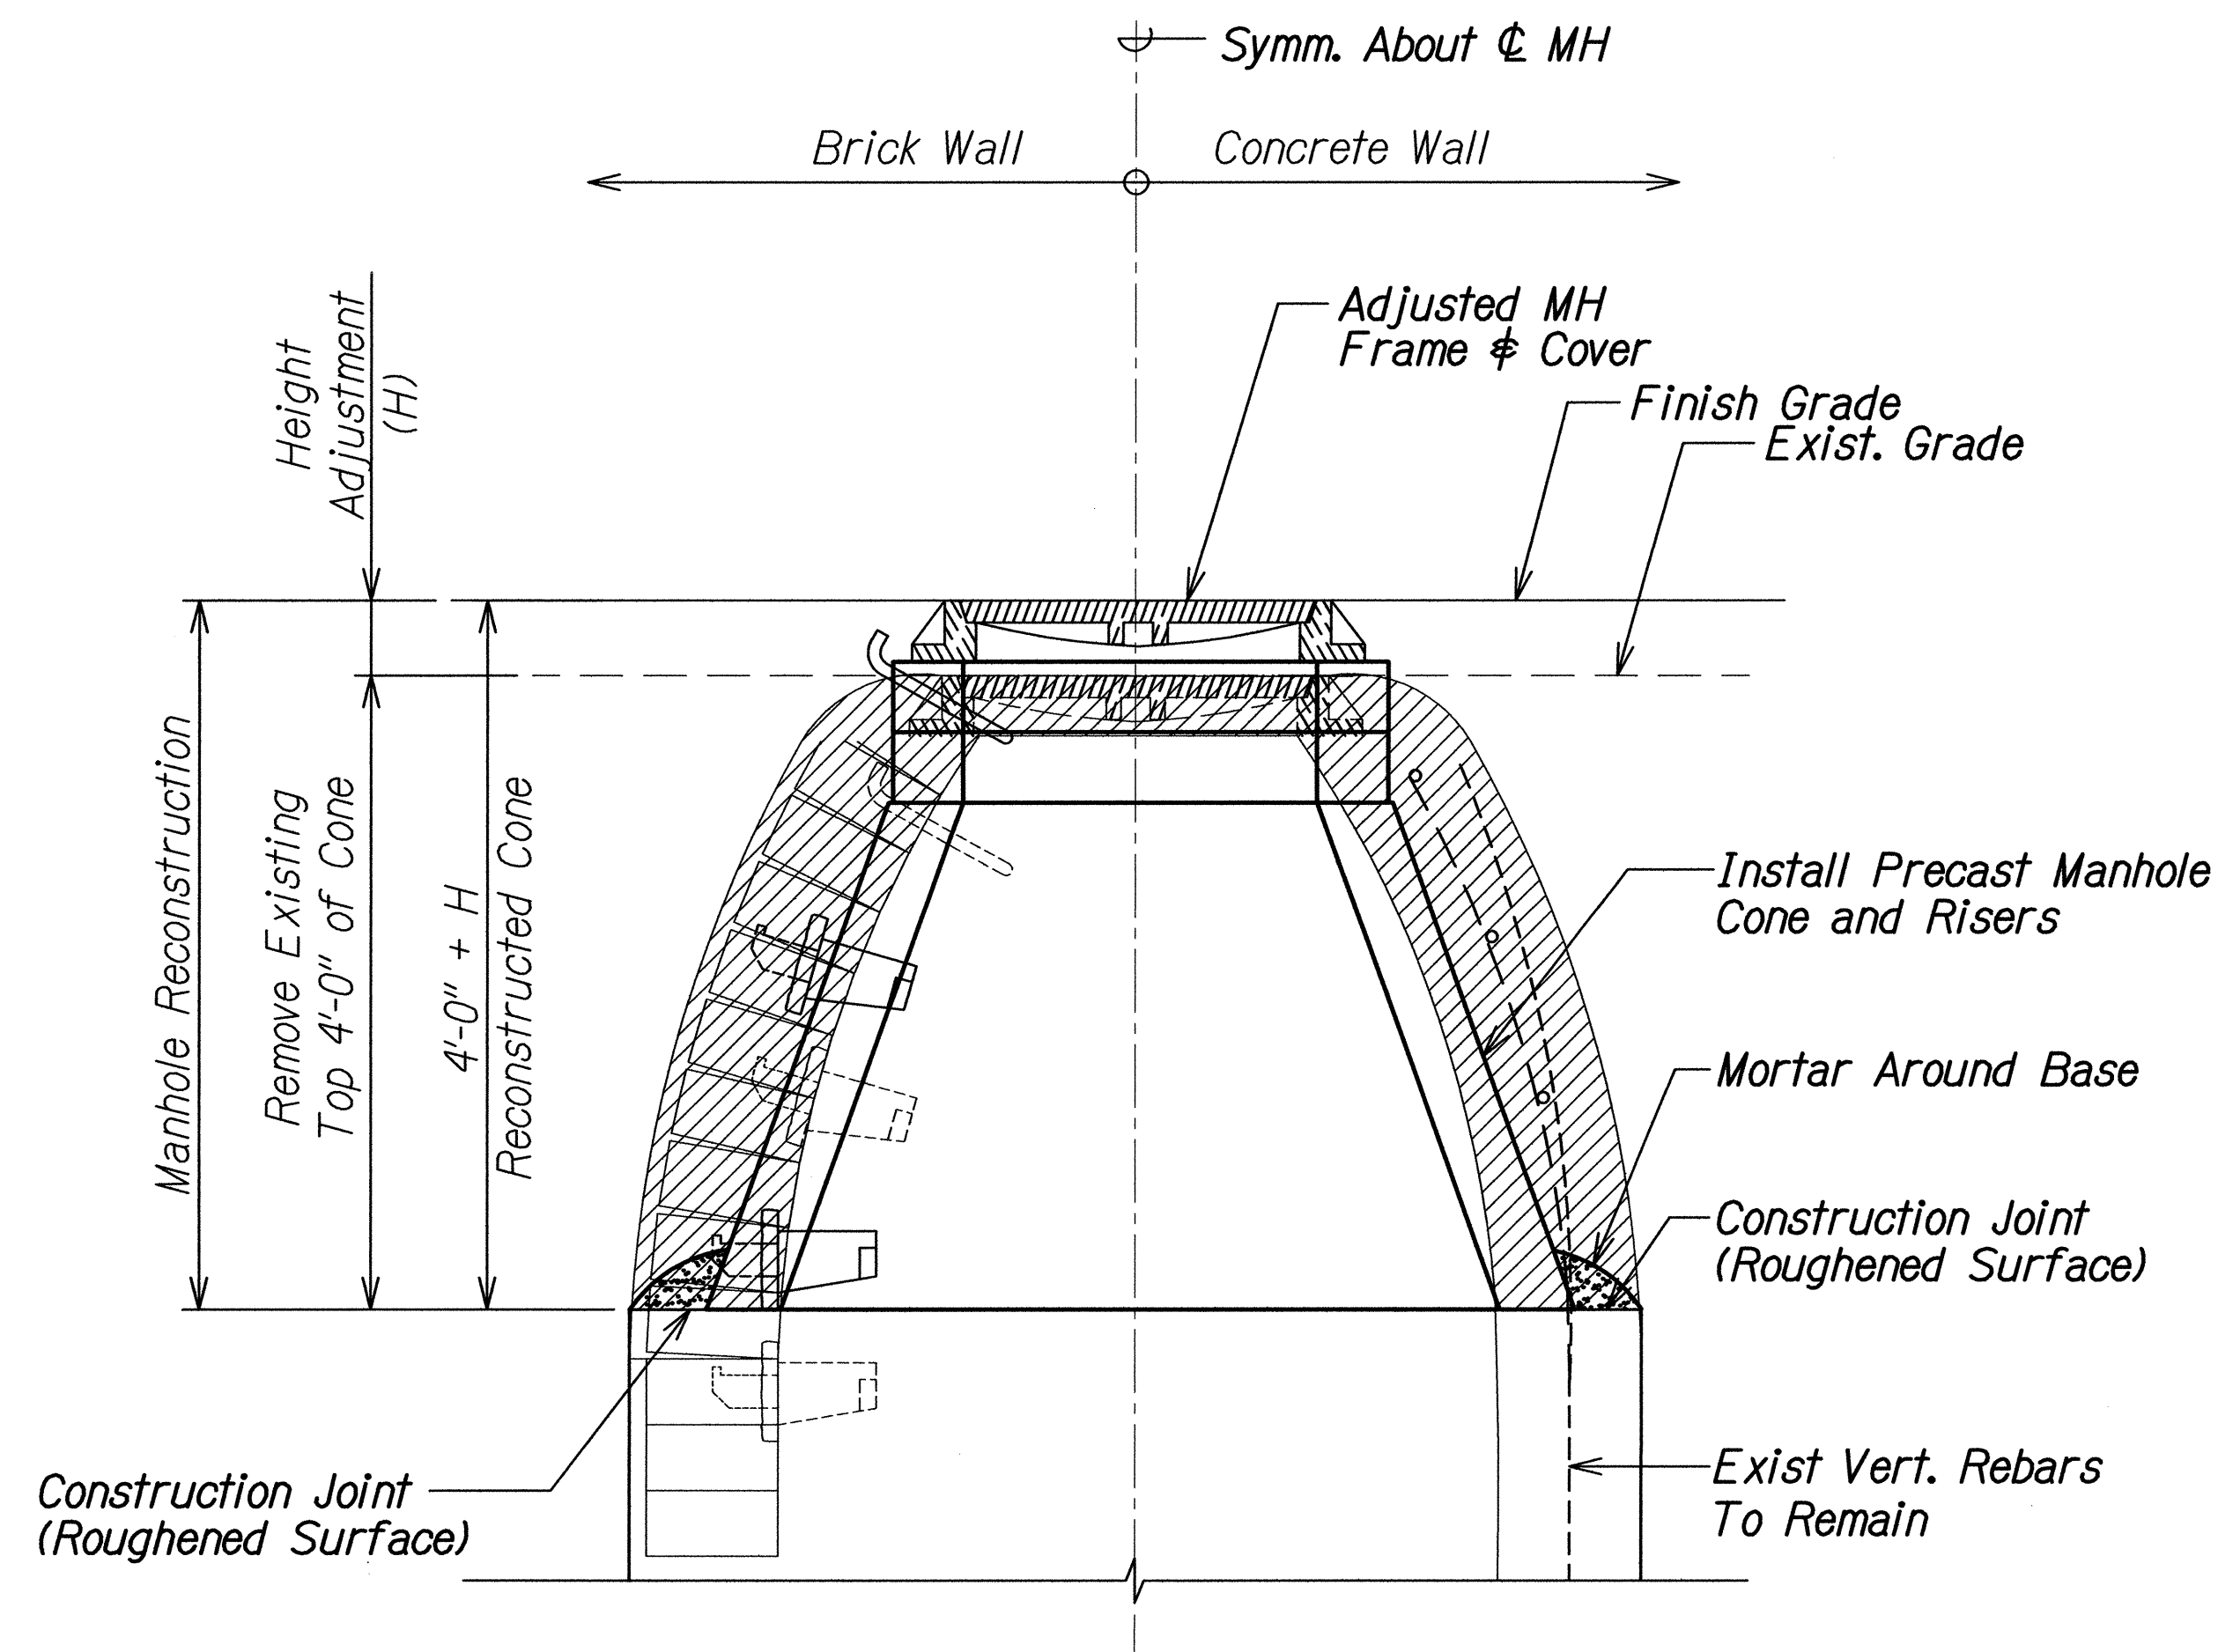

OPTIONAL ADJUSTMENT / RECONSTRUCTION  
OF EXISTING MANHOLE COVER - CONICAL  
Scale: 1" = 1'-0"

|                  |                   |      |
|------------------|-------------------|------|
| ORIGINAL<br>PLAN | SURVEY PLOTTED BY | DATE |
| NOTE BOOK        | DRAWN BY          | " "  |
| No.              | DESIGNED BY       | " "  |
|                  | QUANTITIES BY     | " "  |
|                  | CHECKED BY        | " "  |

DRAWING NAME: Z:\00 ONCON\12-0331-HFL MIDDLE STREET RECONSTRUCTION-20TH CA\06-19-14 BID\HFL-MS-03.DWG PLOT TIME: 06-18-14, 8:13 PM

THIS WORK WAS PREPARED BY  
ME OR UNDER MY SUPERVISION.

*David K. Fujiwara* 4-30-16  
SIGNATURE EXPIRATION DATE OF THE LICENSE

STATE OF HAWAII  
DEPARTMENT OF TRANSPORTATION  
HIGHWAYS DIVISION

**ROADWAY CONSTRUCTION DETAILS**


**MANHOLE ADJUSTMENT/RECONSTRUCTION DETAILS**

MIDDLE STREET PAVEMENT RECONSTRUCTION  
North King Street to Kamehameha Highway  
FAP NO. STP-7415(001)

Scale: As Noted Date: Jun. 20, 2014


SHEET No. **S44** OF 7 SHEETS

| FED. ROAD DIST. NO. | STATE | FEDERAL AID PROJ. NO. | FISCAL YEAR | SHEET NO. | TOTAL SHEETS |
|---------------------|-------|-----------------------|-------------|-----------|--------------|
| HAWAII              | HAW.  | STP-7415(001)         | 2014        | 154       | 173          |

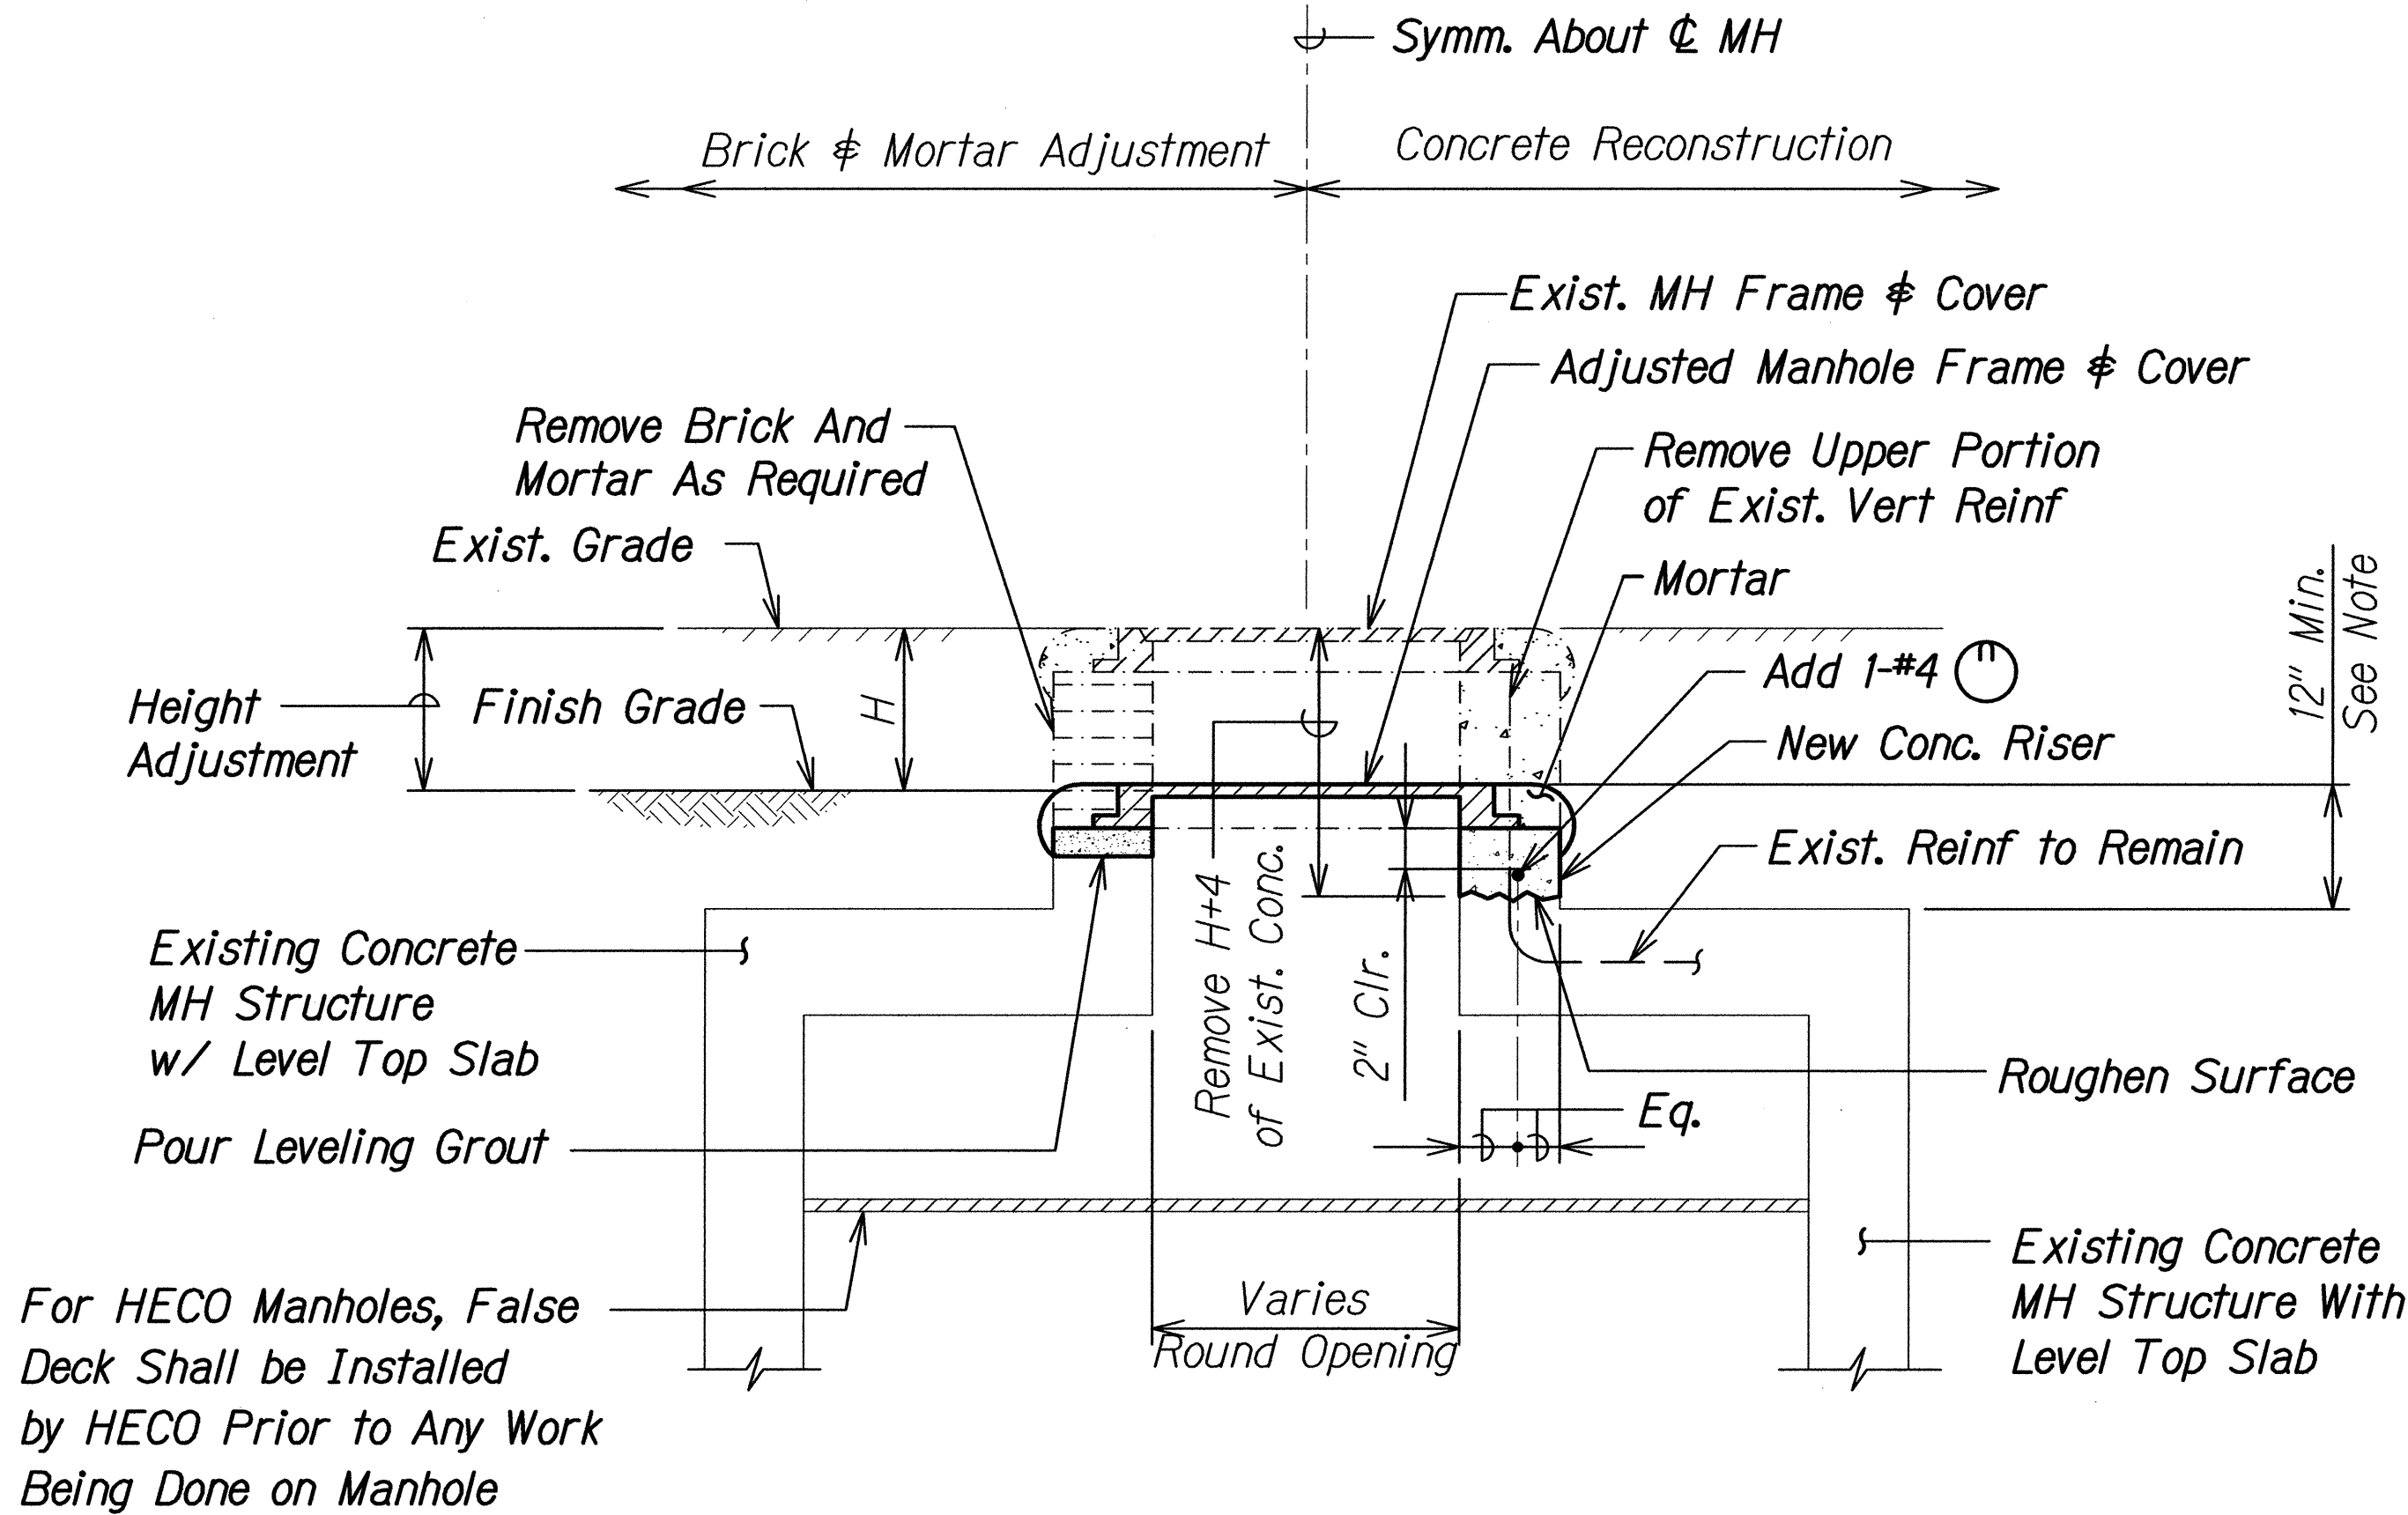

Note:  
If top of manhole is less than 12", Contractor shall notify the Engineer immediately.

### LOWERING

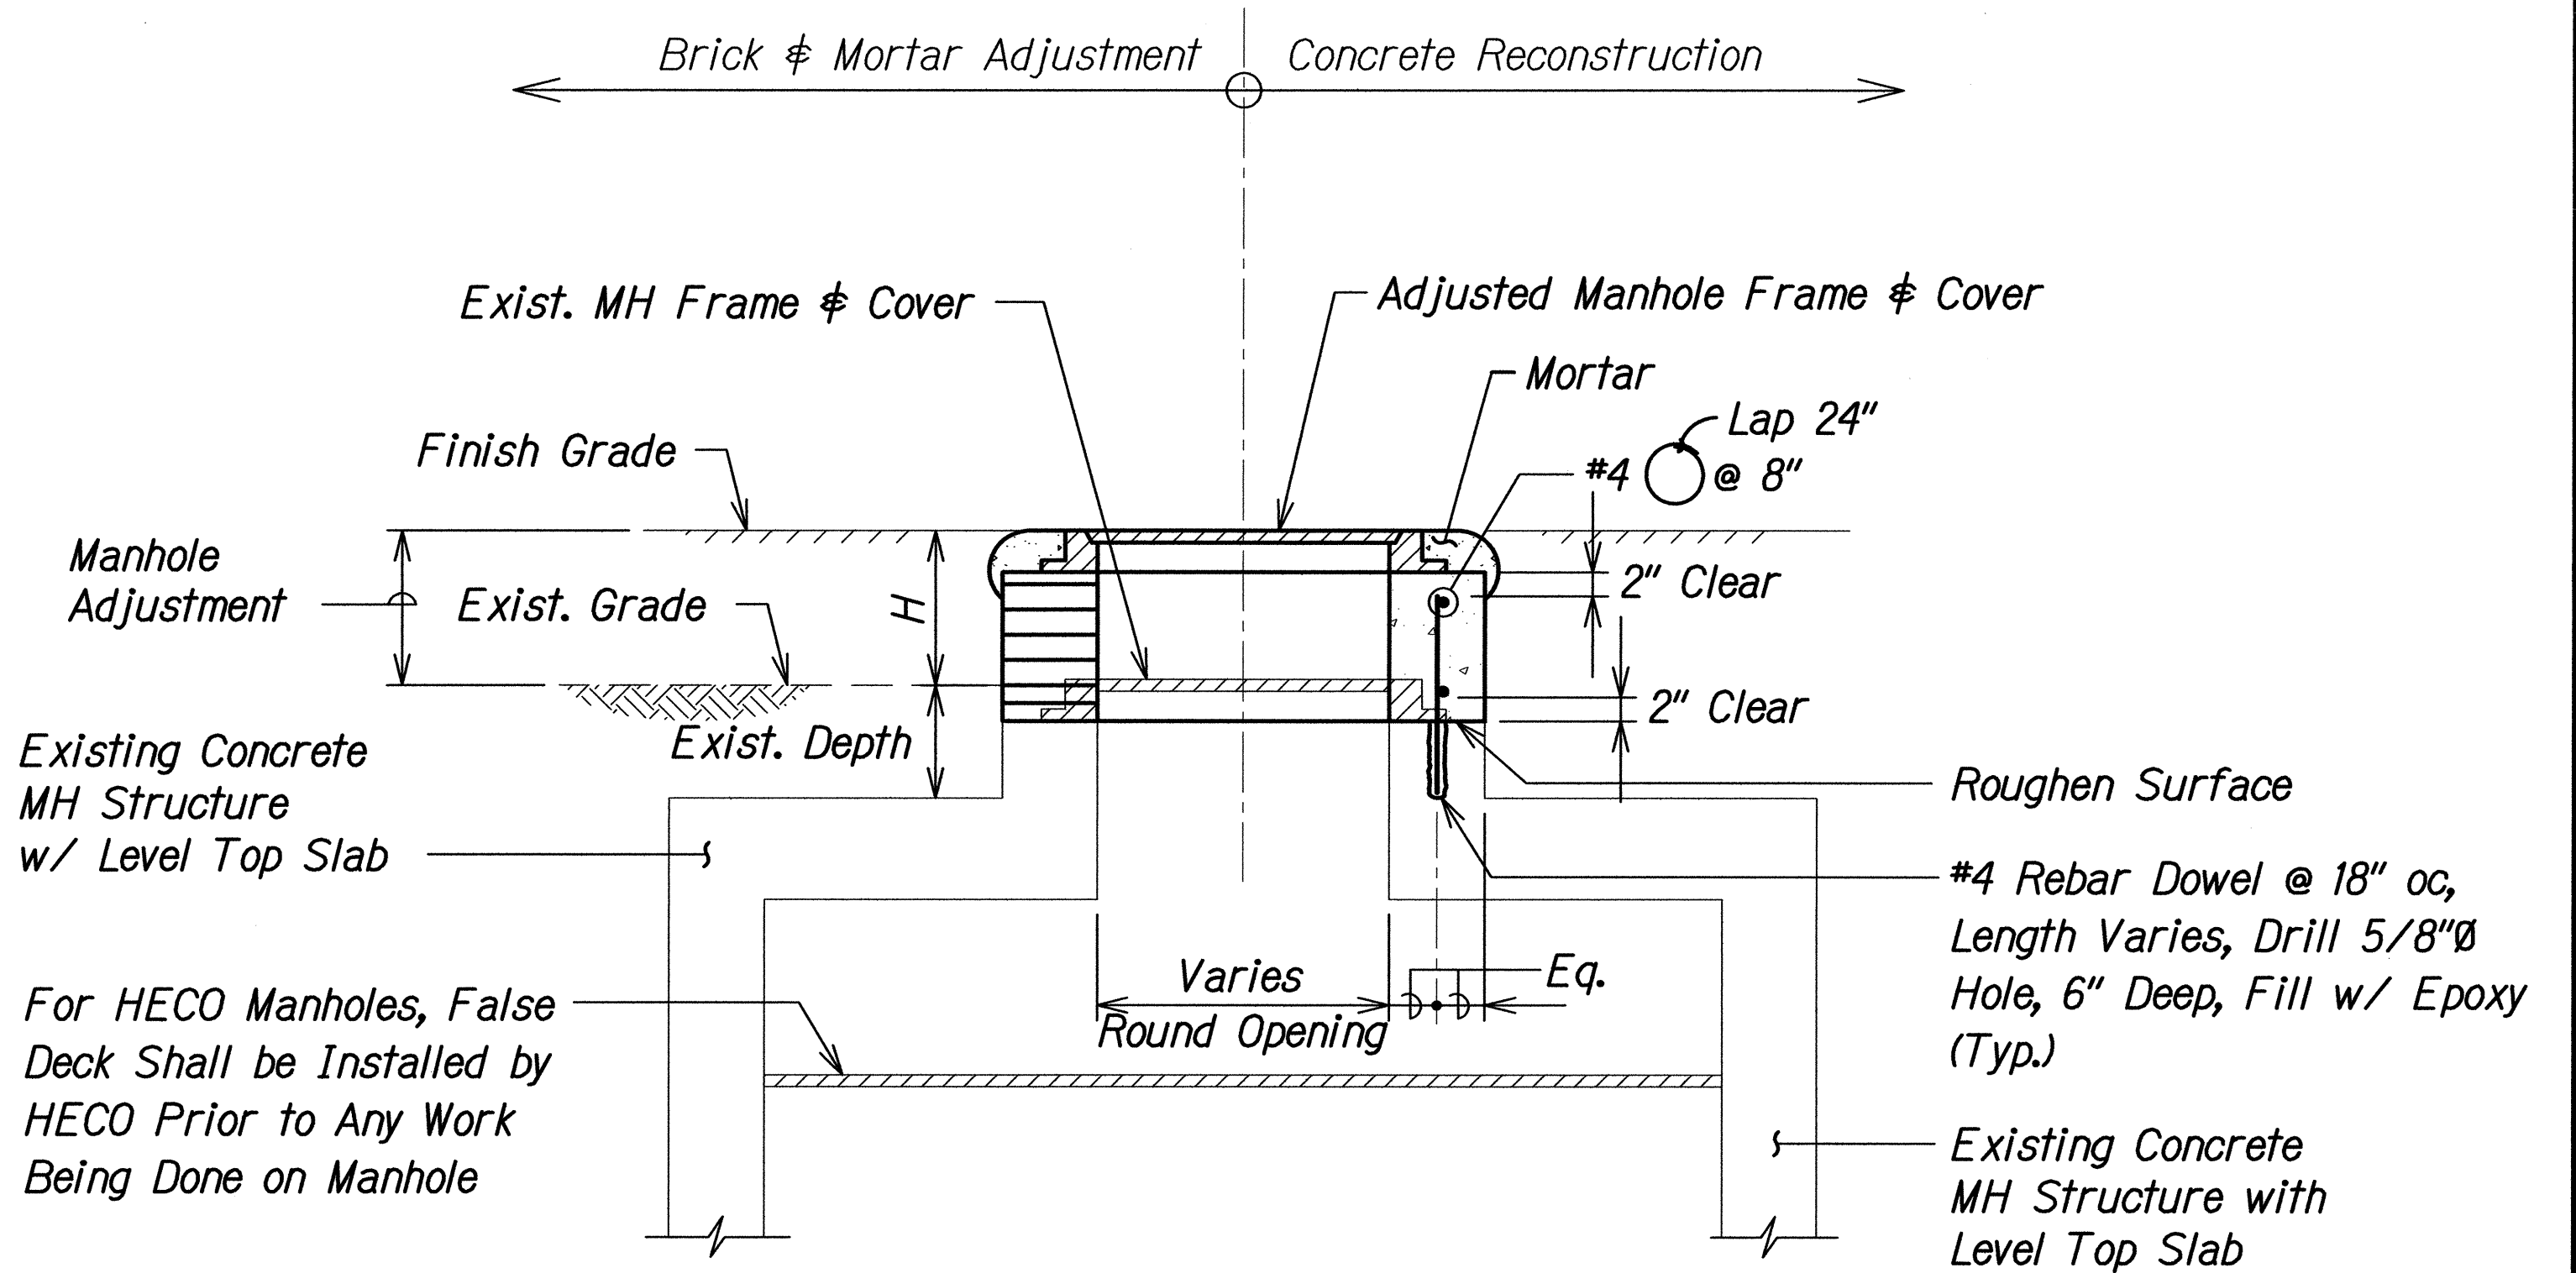


### RAISING

## ADJUSTMENT/RECONSTRUCTION OF EXISTING MANHOLE COVER - LEVEL TOP SLAB WITH RISER

Not to Scale

|               |                   |      |
|---------------|-------------------|------|
| ORIGINAL PLAN | SURVEY PLOTTED BY | DATE |
| NOTE BOOK     | DESIGNED BY       |      |
| No.           | QUANTITIES BY     |      |
|               | CHECKED BY        |      |

DRAWING NAME: 2100-ONGONGA\12-0331-HFL MIDDLE STREET RECONSTRUCTION-00TH(CAD)06-19-14 BID\HFL-MS403.DWG PLOT TIME: 06-18-14, 8:13 PM

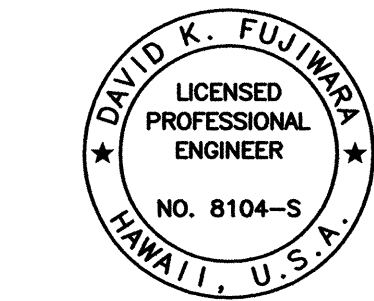


THIS WORK WAS PREPARED BY ME OR UNDER MY SUPERVISION.

SIGNATURE: *David K. Fujiwara* 4-30-16  
EXPIRATION DATE OF THE LICENSE


STATE OF HAWAII  
DEPARTMENT OF TRANSPORTATION  
HIGHWAYS DIVISION  
**ROADWAY CONSTRUCTION DETAILS**  
**MANHOLE ADJUSTMENT/RECONSTRUCTION DETAILS**  
MIDDLE STREET PAVEMENT RECONSTRUCTION  
North King Street to Kamehameha Highway  
FAP NO. STP-7415(001)  
Scale: As Noted Date: Jun. 20, 2014  
SHEET No. S4.5 OF 7 SHEETS




| FED. ROAD DIST. NO. | STATE | FEDERAL AID PROJ. NO. | FISCAL YEAR | SHEET NO. | TOTAL SHEETS |
|---------------------|-------|-----------------------|-------------|-----------|--------------|
| HAWAII              | HAW.  | STP-7415(001)         | 2014        | 155       | 173          |

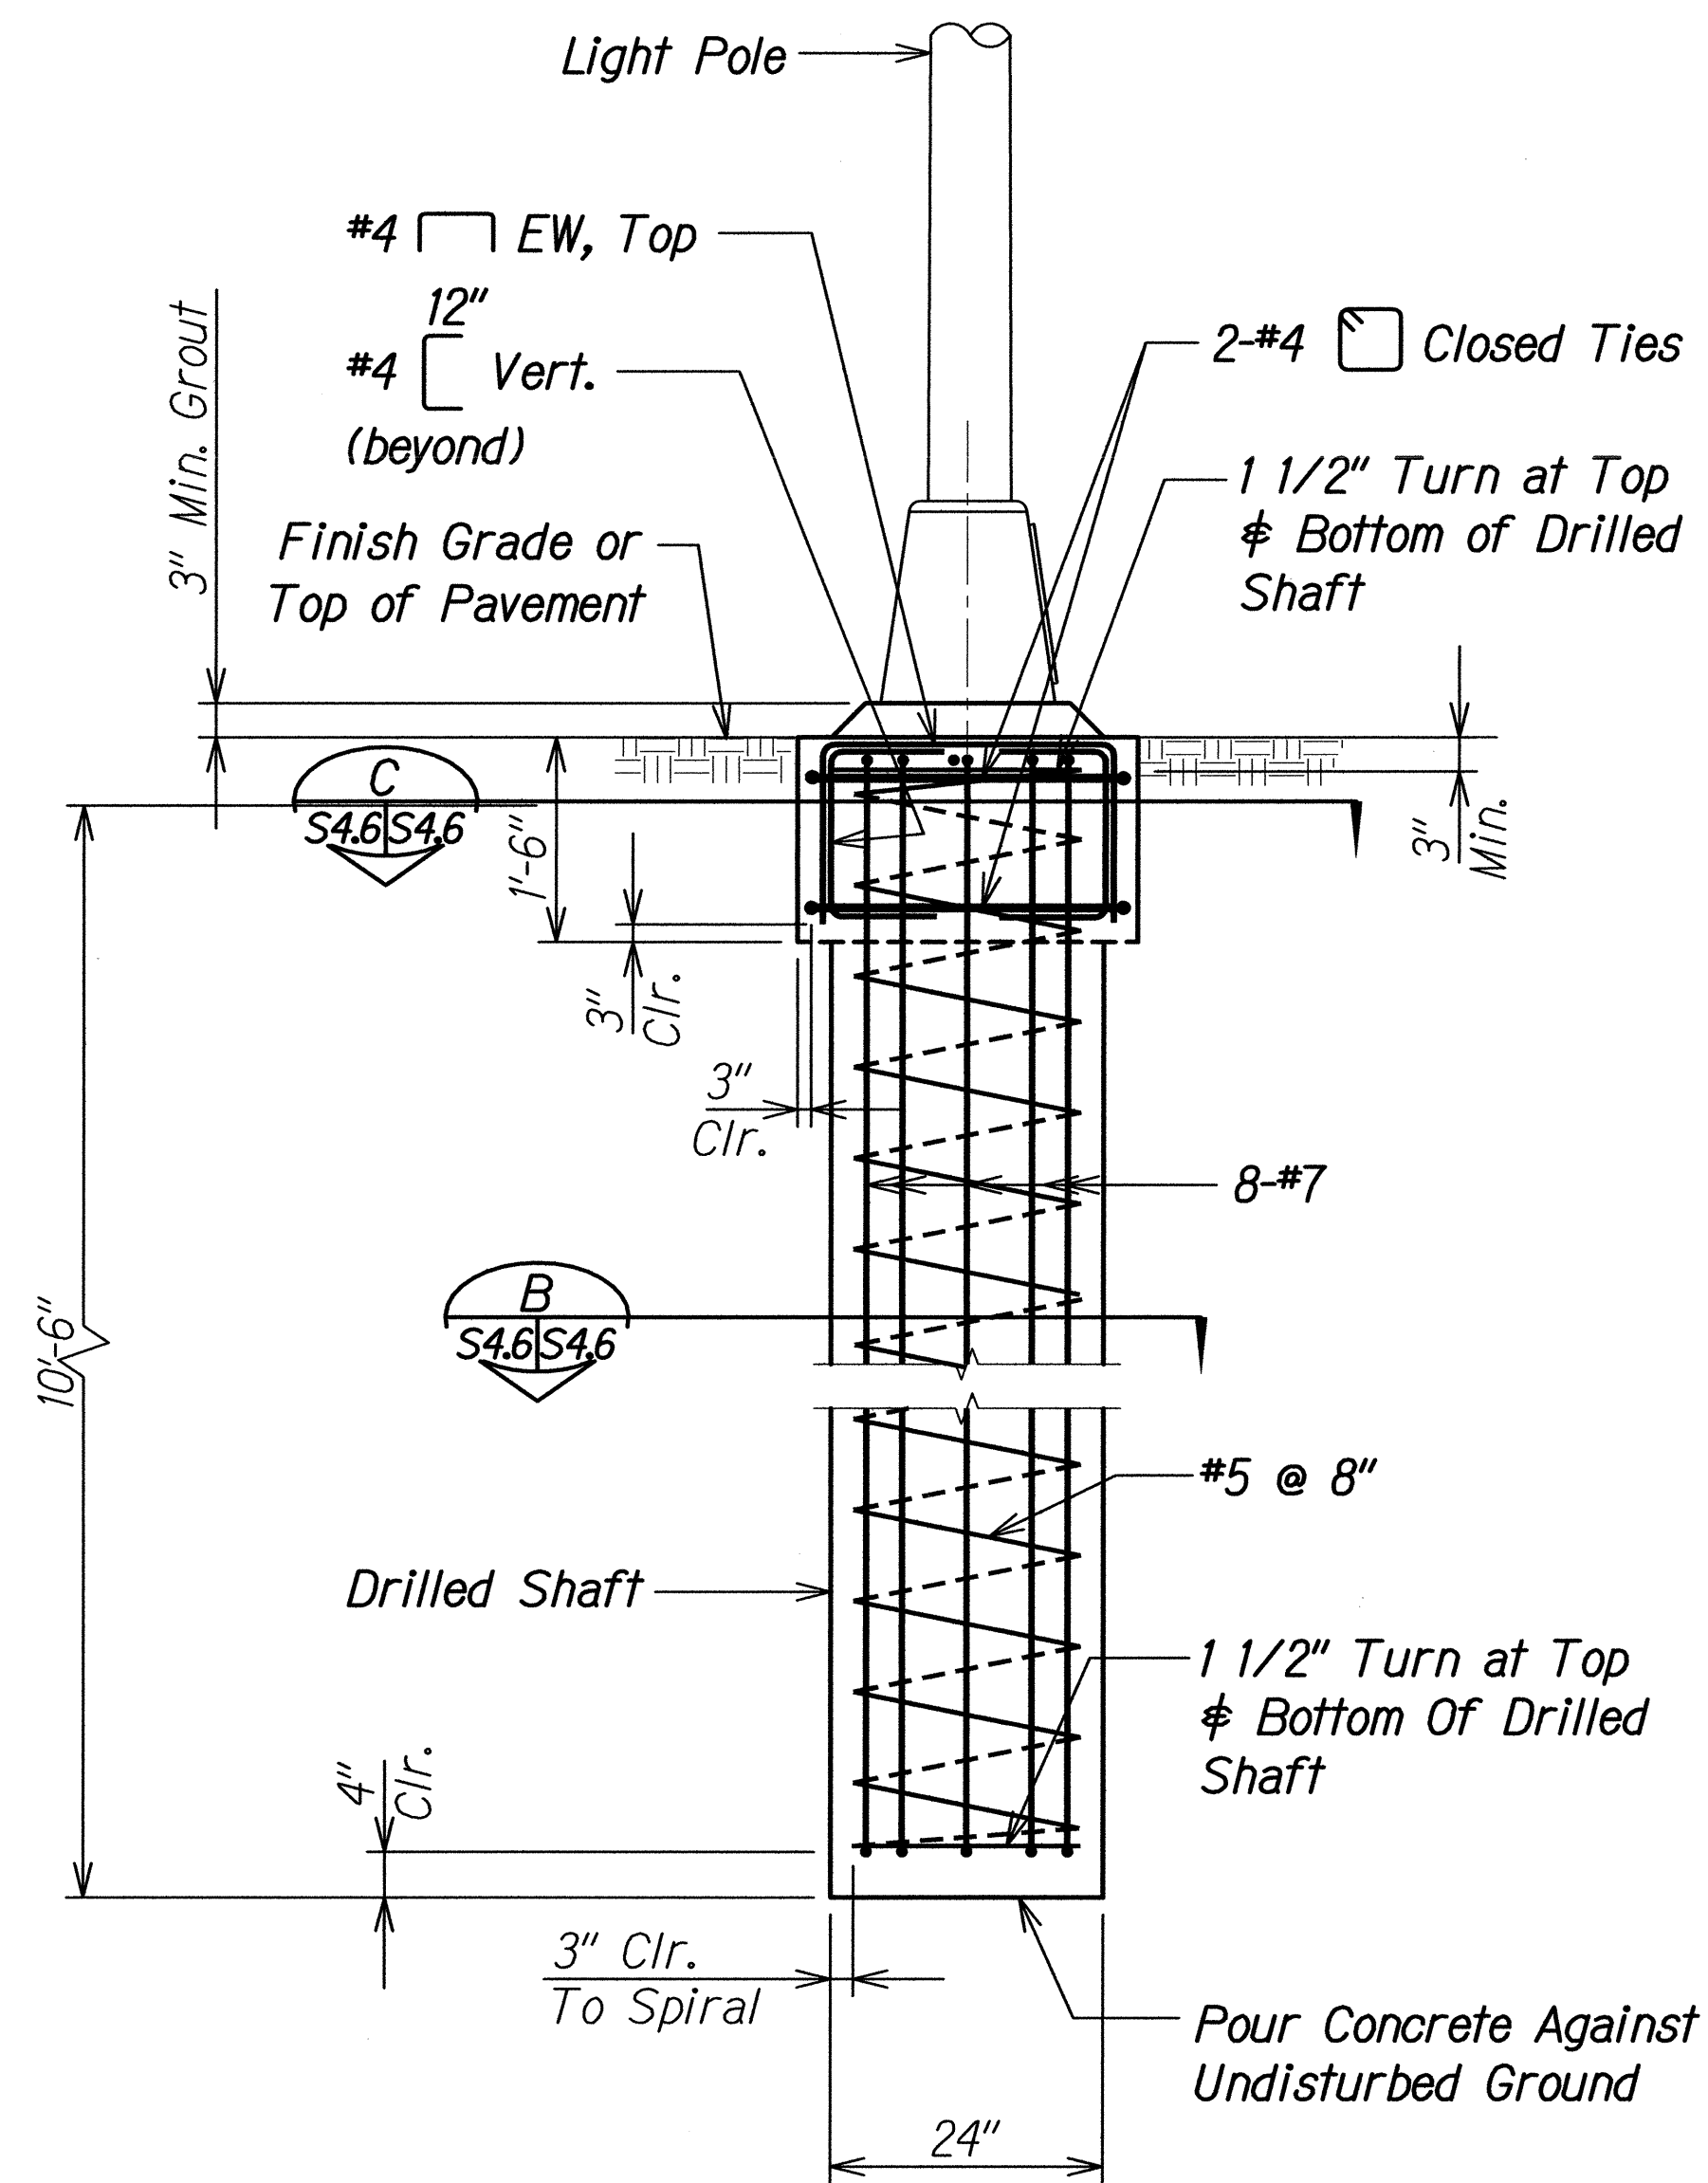

**TYPICAL LIGHT POLE FOUNDATION**  
Scale: 3/4" = 1'-0" A S4.6 S4.6

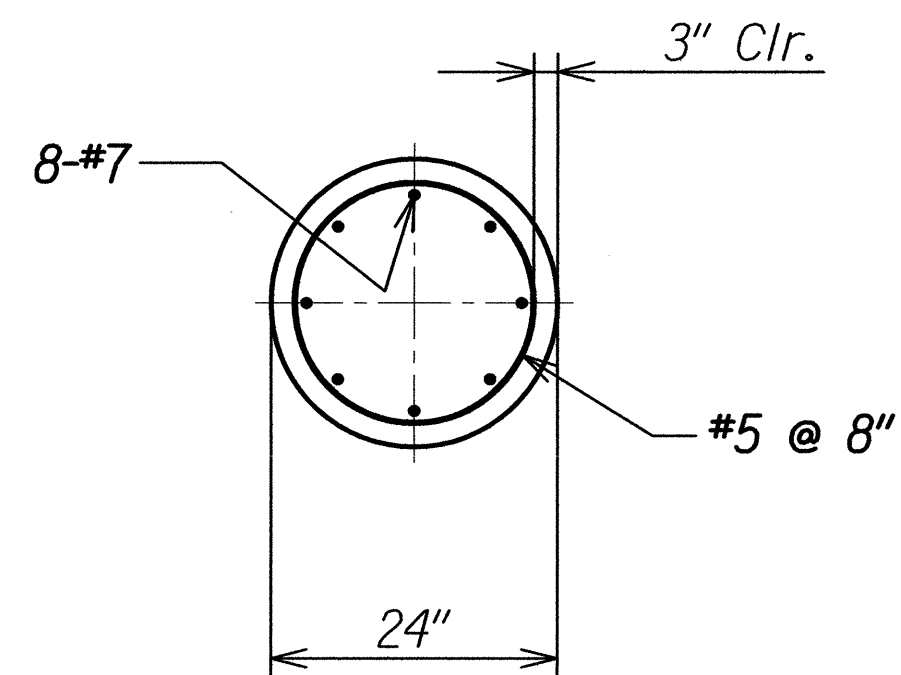

**SECTION B**  
Scale: 3/4" = 1'-0" S4.6 S4.6

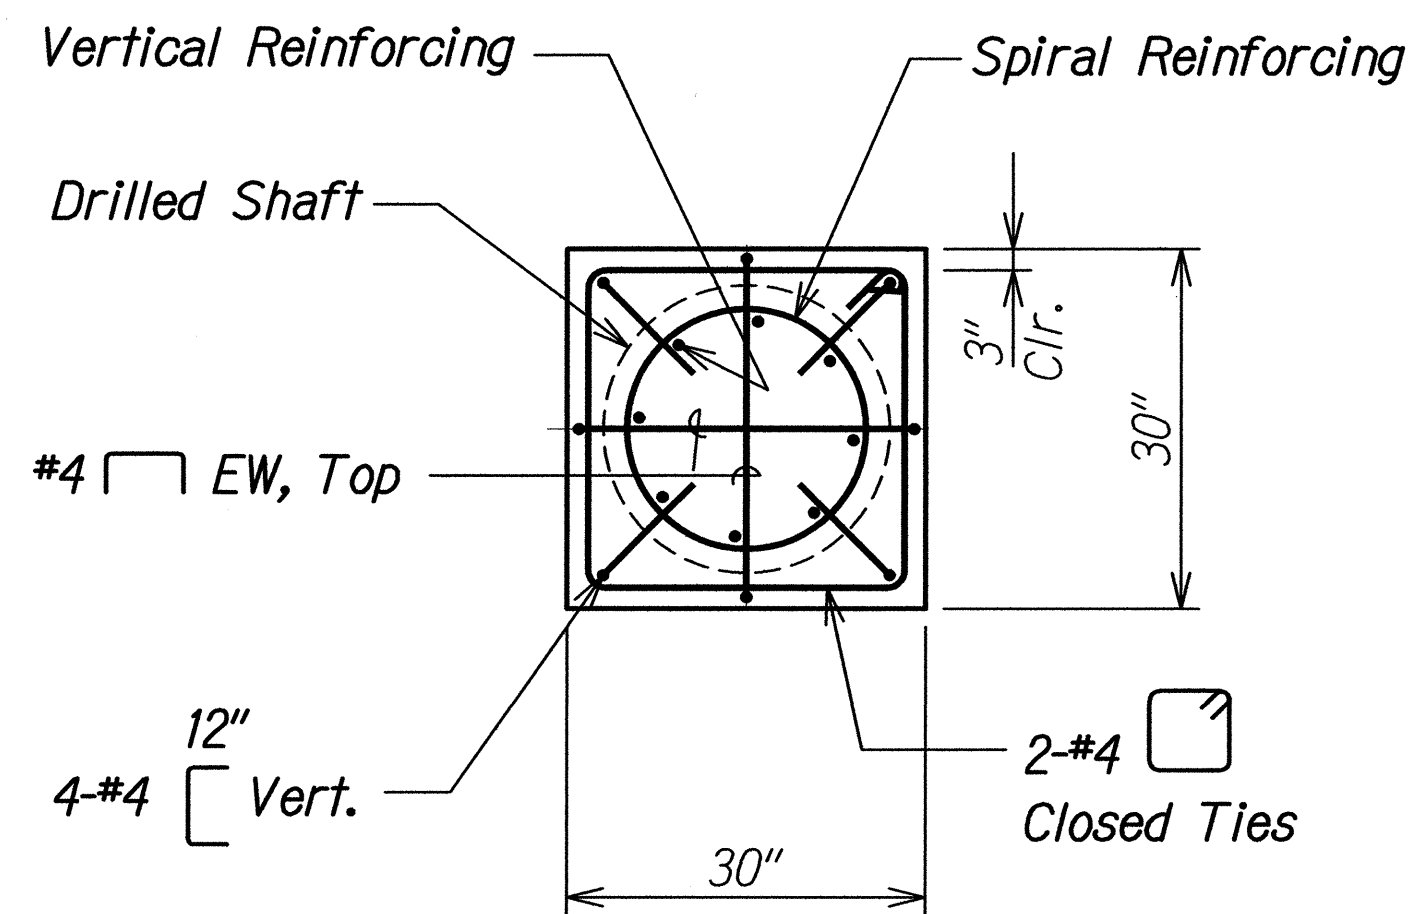

**SECTION C**  
Scale: 3/4" = 1'-0" S4.6 S4.6

Note:  
See electrical drawings for additional details.

|               |                   |      |
|---------------|-------------------|------|
| ORIGINAL PLAN | SURVEY PLOTTED BY | DATE |
| NOTE BOOK     | DRAWN BY          |      |
|               | DESIGNED BY       |      |
|               | QUANTITIES BY     |      |
|               | CHECKED BY        |      |


DRAWING NAME: 2100 ONGOING 12-0331-HFL MIDDLE STREET RECONSTRUCTION-BOTH C&D 06-18-14 BID/HFL-MS406.DWG PLOT TIME: 06-18-14, 7:31 PM

THIS WORK WAS PREPARED BY  
ME OR UNDER MY SUPERVISION.  
*David K. Fujiwara*  
SIGNATURE EXPIRATION DATE OF THE LICENSE 4-30-16

STATE OF HAWAII  
DEPARTMENT OF TRANSPORTATION  
HIGHWAYS DIVISION


**LIGHT POLE FOUNDATION**  
MIDDLE STREET PAVEMENT RECONSTRUCTION  
North King Street to Kamehameha Highway  
FAP NO. STP-7415(001)  
Scale: As Noted Date: Jun. 20, 2014  
SHEET No. S4.6 OF 7 SHEETS

| FED. ROAD DIST. NO. | STATE | FEDERAL AID PROJ. NO. | FISCAL YEAR | SHEET NO. | TOTAL SHEETS |
|---------------------|-------|-----------------------|-------------|-----------|--------------|
| HAWAII              | HAW.  | STP-7415(001)         | 2014        | 156       | 173          |

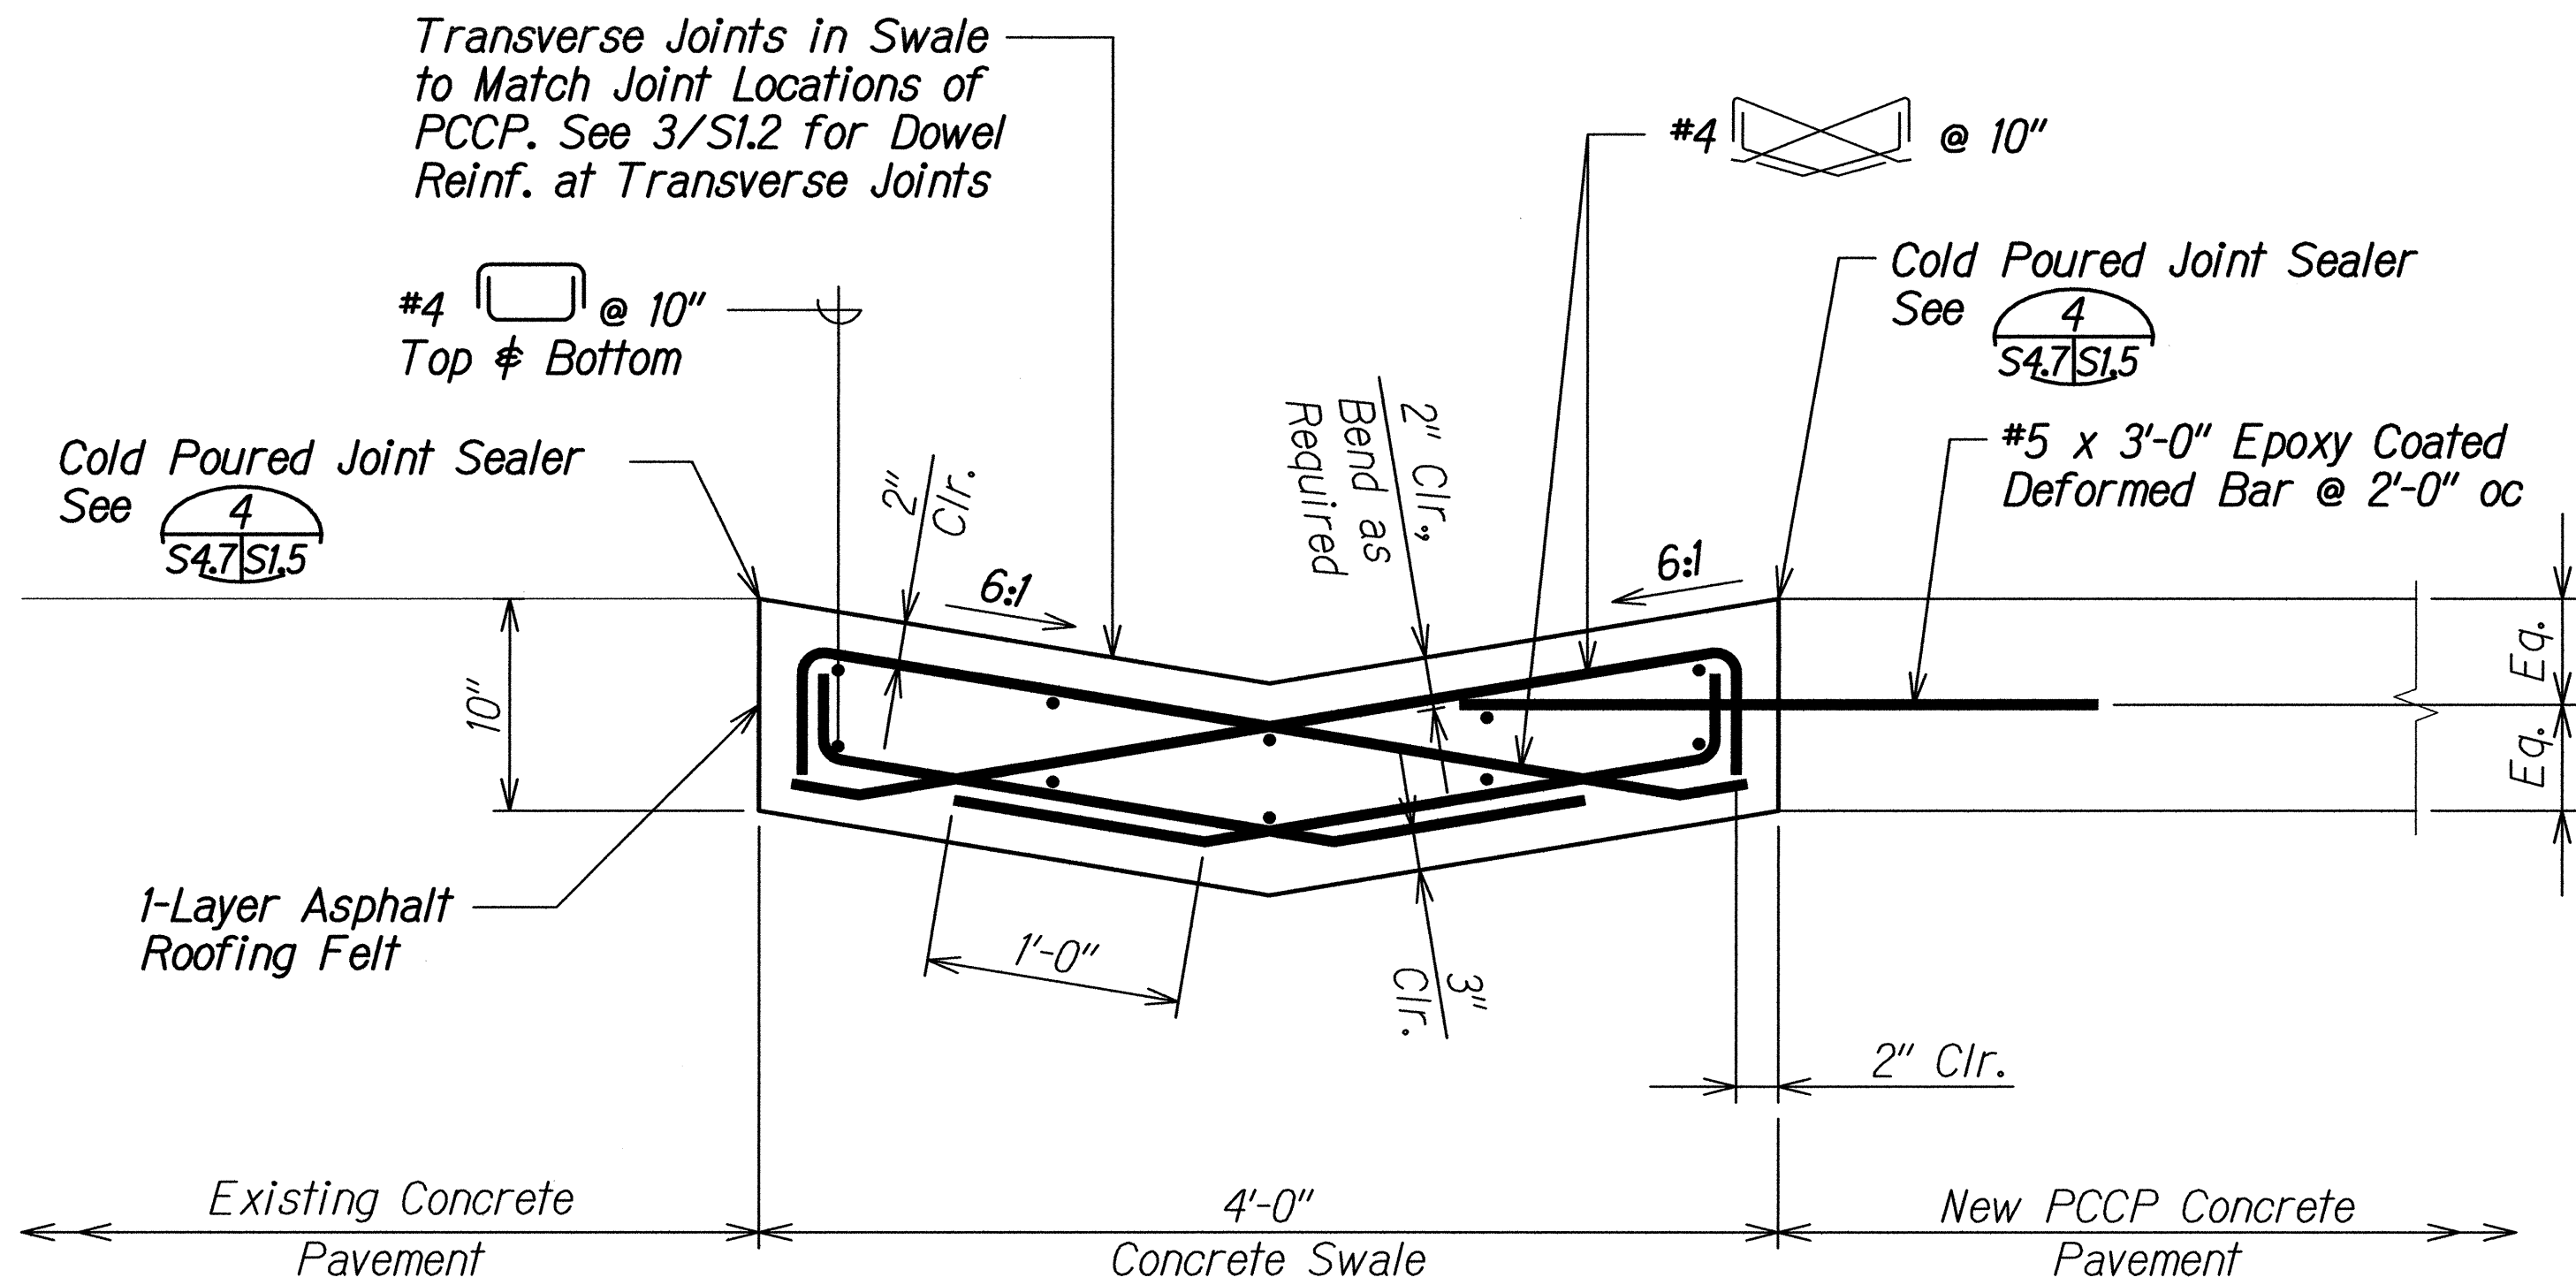

**SECTION AT SWALE** A  
 Scale: 1 1/2" = 1'-0" S4.7 | S4.7


**Note:**  
 Begin and end of concrete swale repair to match nearest transverse joint.

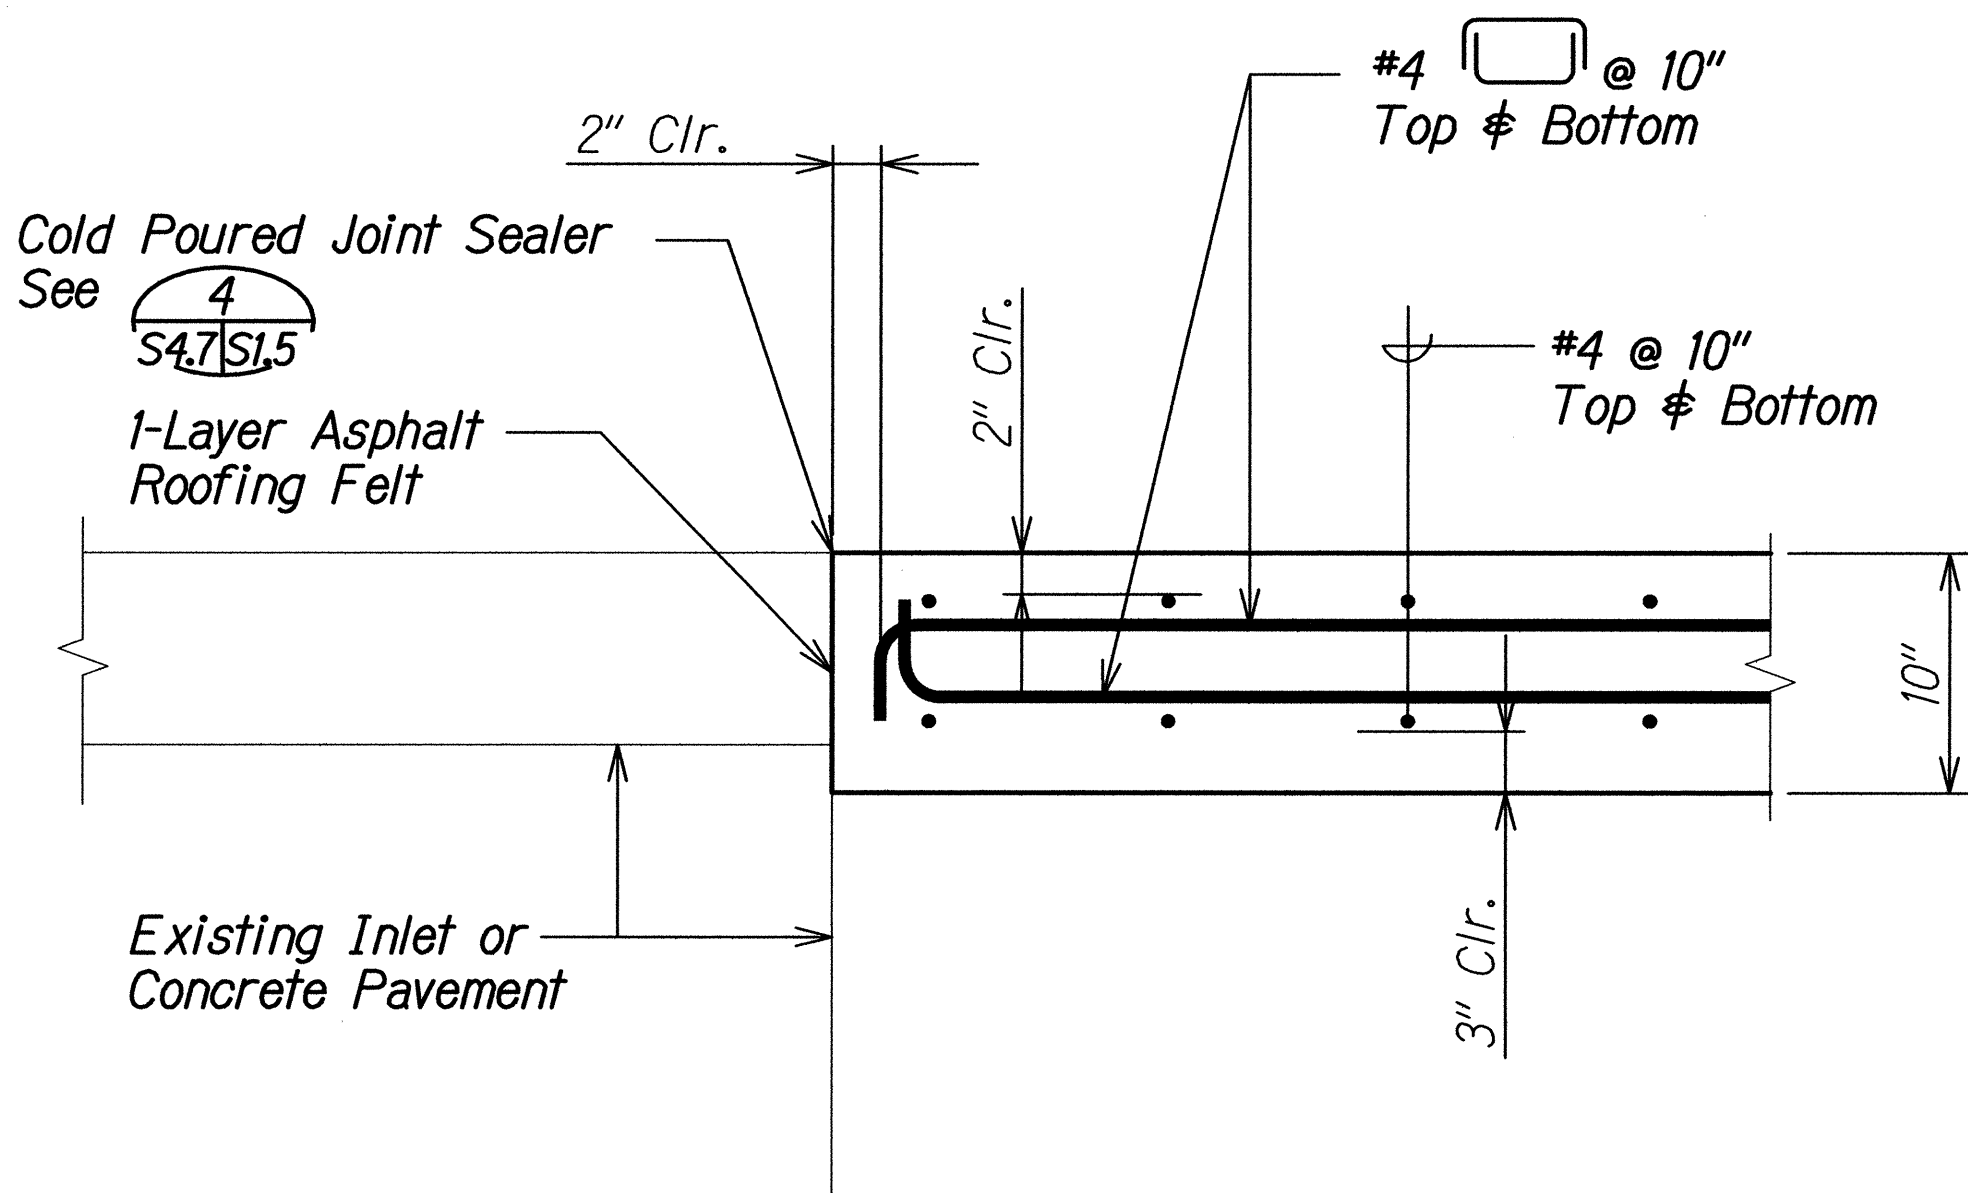

**SWALE AT EXISTING STRUCTURE** A  
 Scale: 1 1/2" = 1'-0" S4.7 | S4.7

|               |                   |      |
|---------------|-------------------|------|
| ORIGINAL PLAN | SURVEY PLOTTED BY | DATE |
| NOTE BOOK     | DRAWN BY          |      |
| No.           | DESIGNED BY       |      |
|               | QUANTITIES BY     |      |
|               | CHECKED BY        |      |

DRAWING NAME: 2100 OONGONE12-0331-HFL MIDDLE STREET RECONSTRUCTION-BOTH CAD 06-19-14 BD\HFL-MS407.DWG PLOT TIME: 06-18-14, 7:32 PM

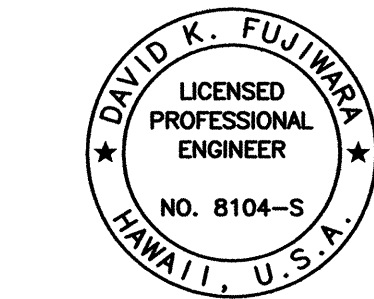

THIS WORK WAS PREPARED BY ME OR UNDER MY SUPERVISION.

*David K. Fujiwara*  
 SIGNATURE EXPIRATION DATE OF THE LICENSE 4-30-16

STATE OF HAWAII  
 DEPARTMENT OF TRANSPORTATION  
 HIGHWAYS DIVISION  
**CONCRETE SWALE SECTIONS**  
 MIDDLE STREET PAVEMENT RECONSTRUCTION  
 North King Street to Kamehameha Highway  
 FAP NO. STP-7415(001)  
 Scale: As Noted Date: Jun. 20, 2014  
 SHEET No. S4.7 OF 7 SHEETS