


FED. ROAD DIST. NO.	STATE	FED. AID PROJ. NO.	FISCAL YEAR	SHEET NO.	TOTAL SHEETS
HAWAII	HAW.	F 50 (7)	1953	11	39

SURVEY PLOTTED BY	DATE
DESIGNED BY	
DRAWN BY	
NOTED BY	
QUANTITIES CHECKED BY	
CHECKED BY	
ORIGINAL PLAN	
NOTE BOOK	
No.	

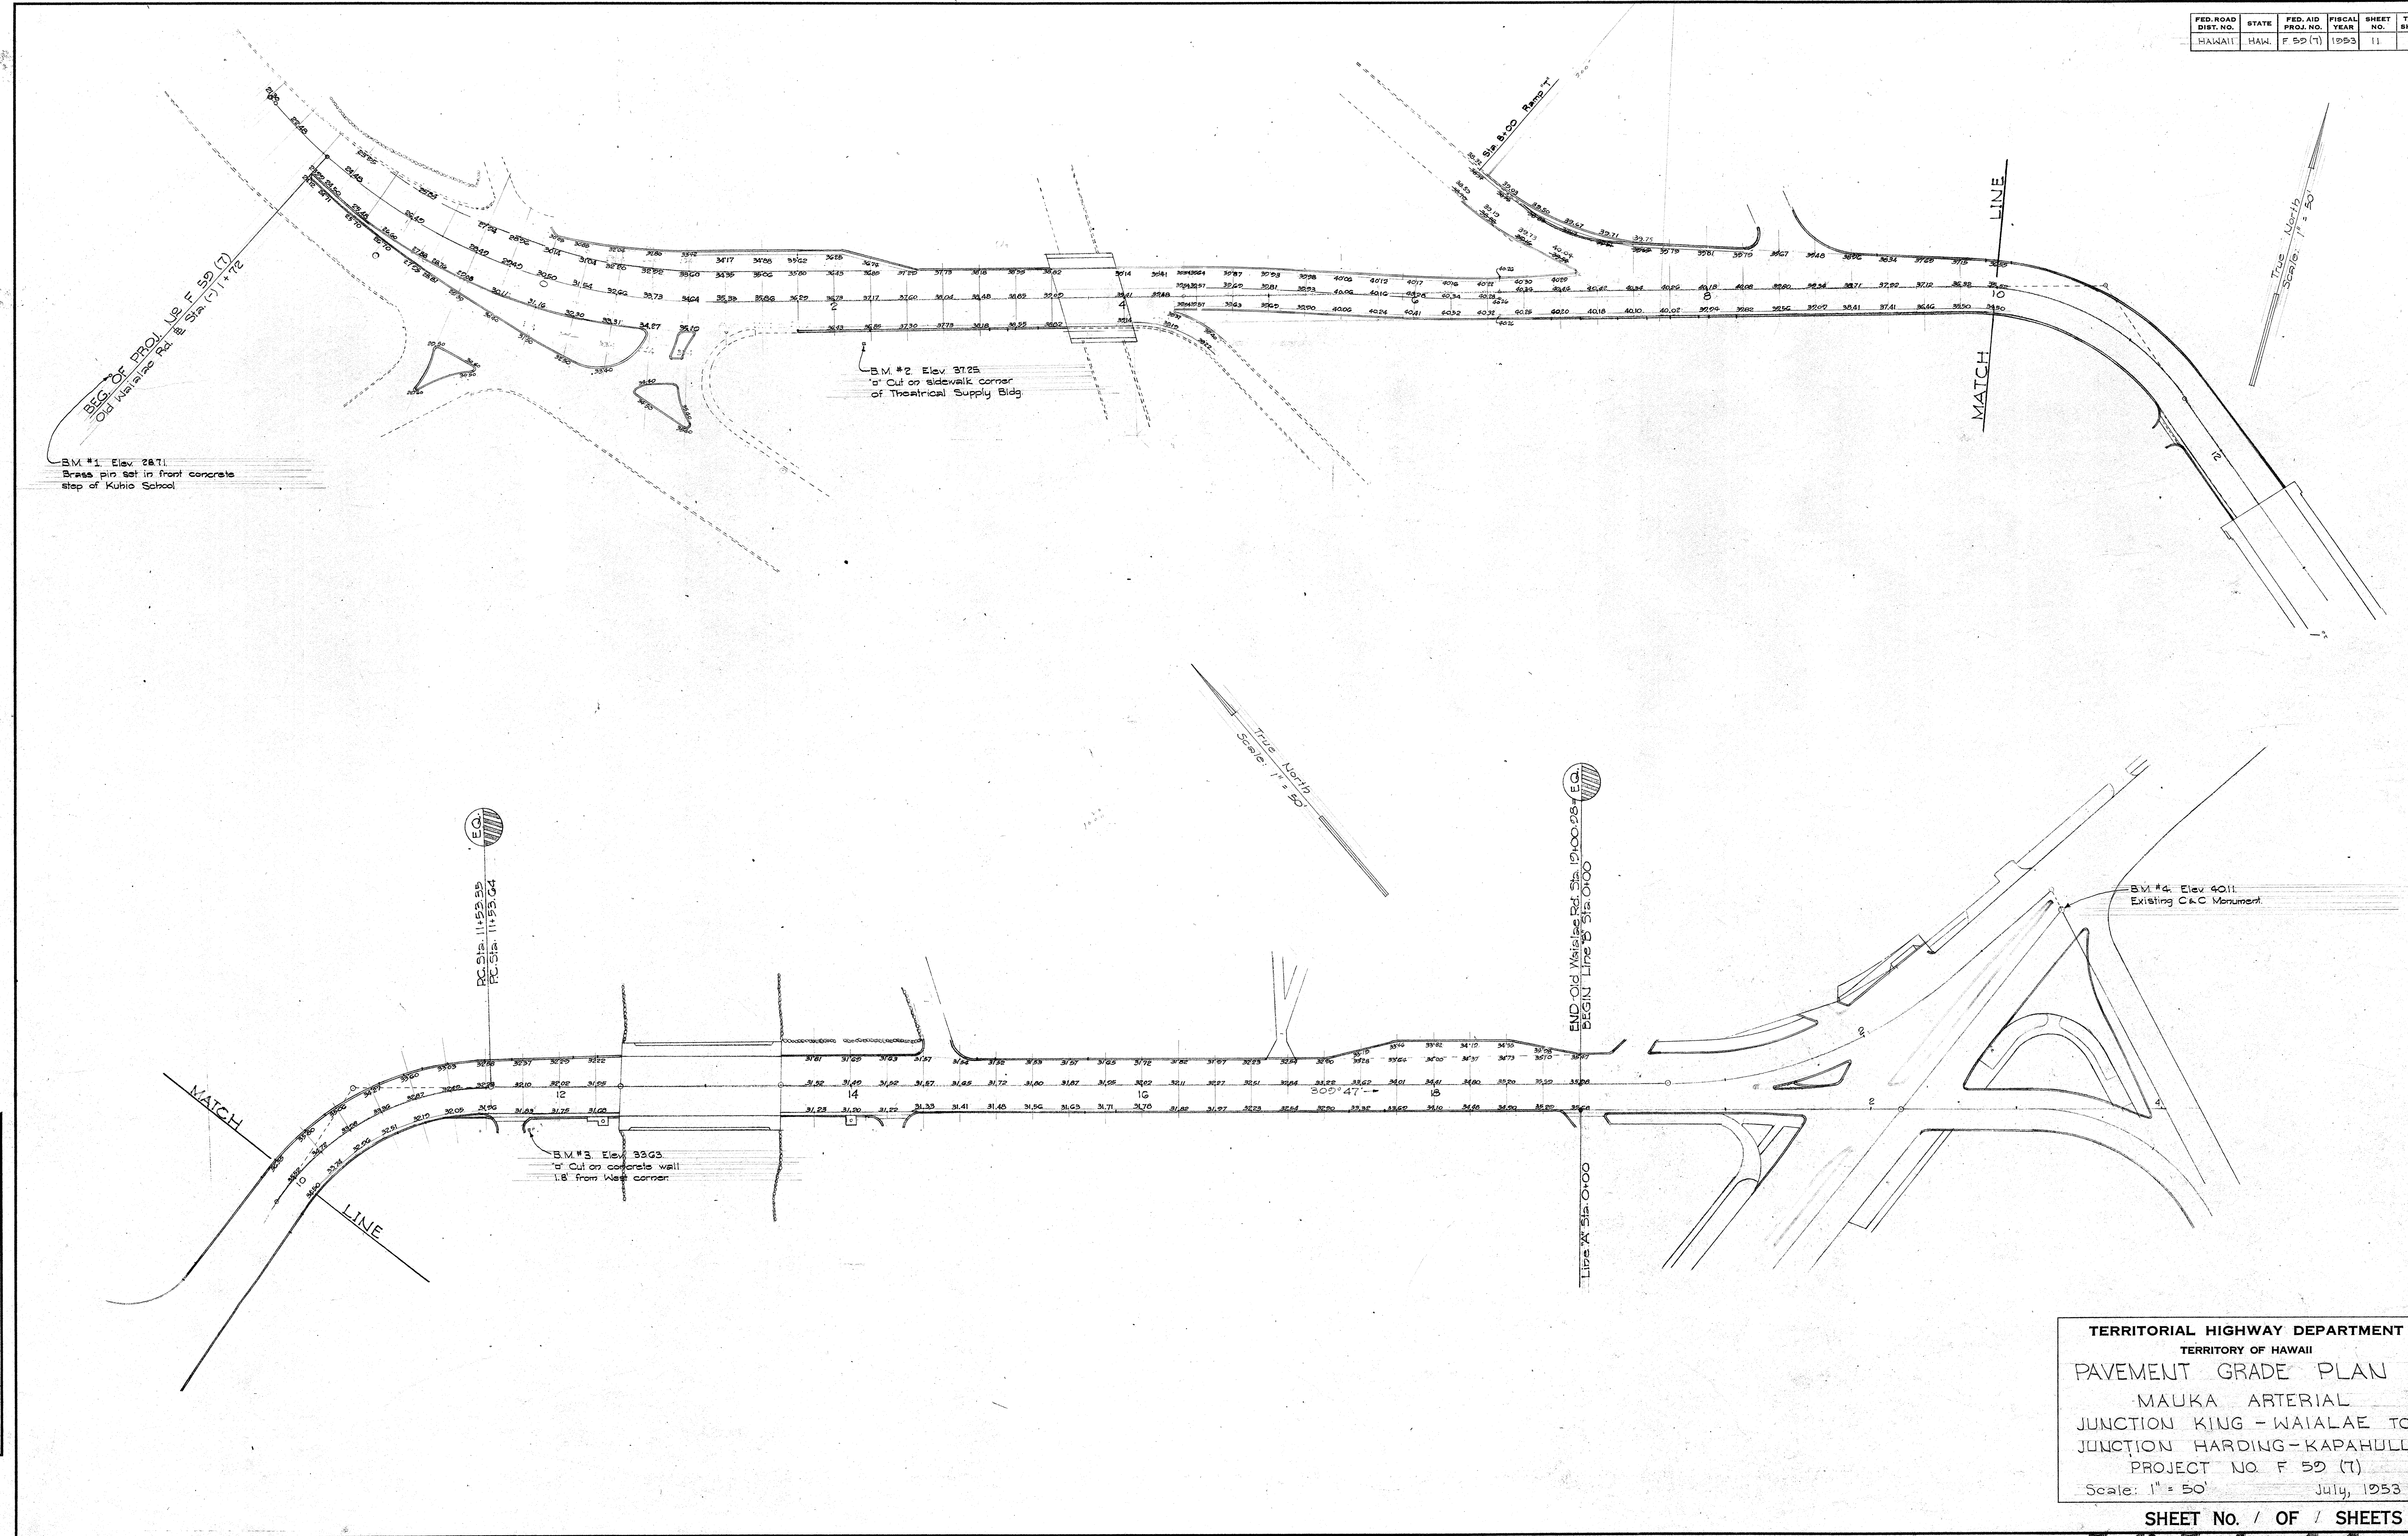

TERRITORIAL HIGHWAY DEPARTMENT
TERRITORY OF HAWAII
PAVEMENT GRADE PLAN
MAUKA ARTERIAL
JUNCTION KING - WAIALAE TO
JUNCTION HARDING-KAPAHULU
PROJECT NO. F 50 (7)
 Scale: 1" = 50' July, 1953