



FED. ROAD DIST. NO.	STATE	FED. AID PROJ. NO.	FISCAL YEAR	SHEET NO.	TOTAL SHEETS
HAWAII	HAW.	F 59 (7)	1953	18	25

NOTE: Pavement Markings not part of this Contract

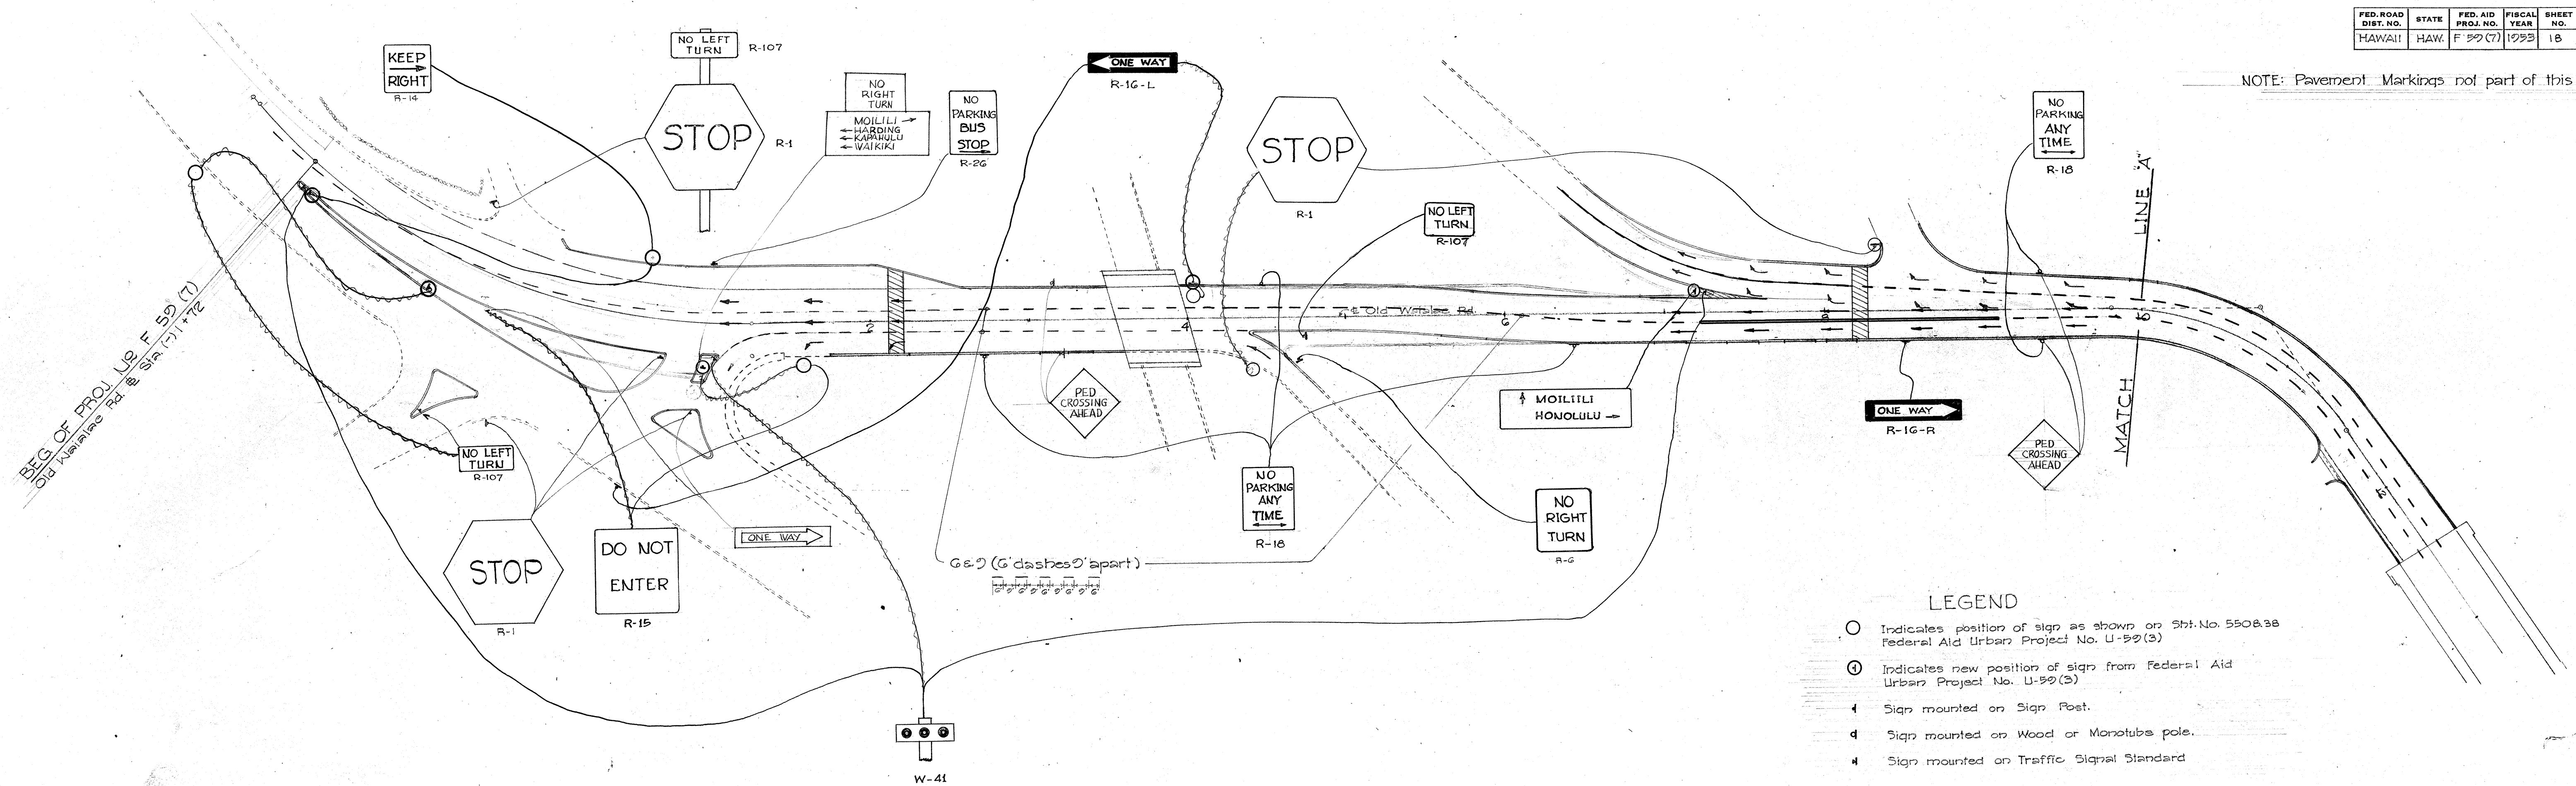

- LEGEND**
- Indicates position of sign as shown on Stt. No. 550&38 Federal Aid Urban Project No. U-59(3)
 - ④ Indicates new position of sign from Federal Aid Urban Project No. U-59(3)
 - † Sign mounted on Sign Post.
 - ‡ Sign mounted on Wood or Monotube pole.
 - Sign mounted on Traffic Signal Standard

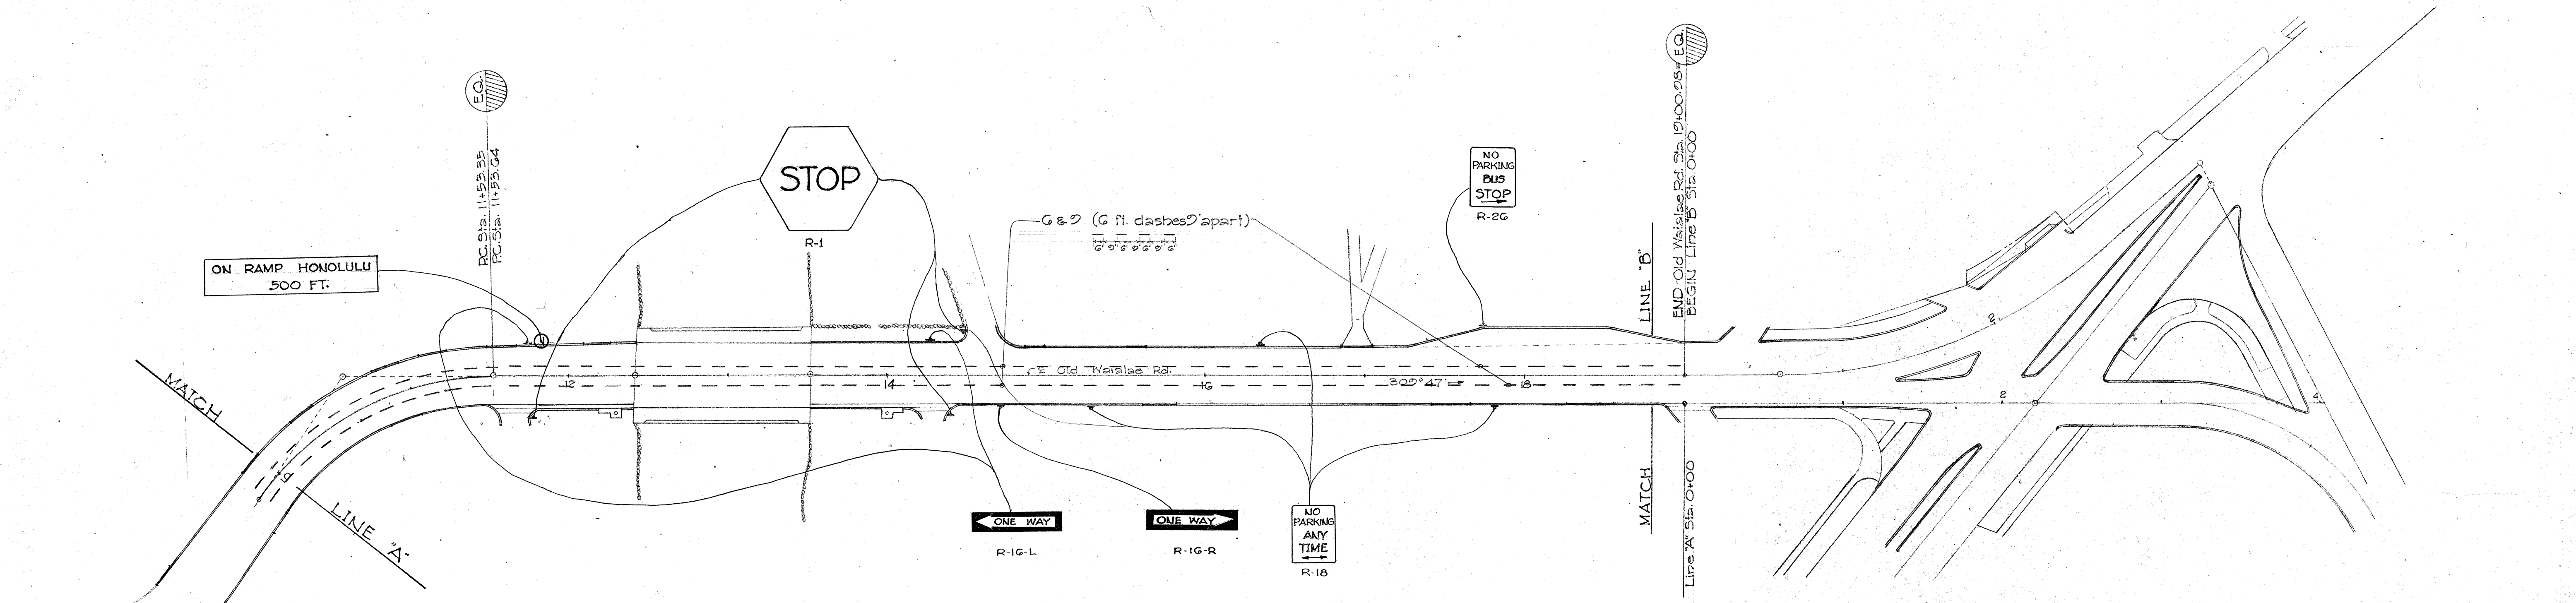

TERRITORIAL HIGHWAY DEPARTMENT
TERRITORY OF HAWAII
TRAFFIC SIGNS & PAVEMENT MARKINGS
MAUKA ARTERIAL
JUNCTION KING - WAIALAE TO
JUNCTION HARDING - KAPAHULU
PROJECT NO F 59 (7)
 Scale: 1" = 50' July, 1953

SHEET No. 1 OF 2 SHEETS



5654.18

SURVEY PLOTTED BY	DATE
DRAWN BY	
TRACED BY	
QUANTITIES CHECKED BY	
NOTE BOOK NO.	

SUMMARY			
CODE NO.	SIGN	NEW	RELOCATED
R-1	Stop	7	1
R-6	No Right Turn	4	
R-14	Keep Right	1	
R-15	Do Not Enter	1	
R-16-L	One Way (Left)	5	
R-16-R	One Way (Right)	3	
R-18	No Parking Any Time	22	
R-22	No Parking Bus Stop	3	
R-106	Turn Right Any Time With Caution	9	
R-107	Turn Left Any Time With Caution	3	
R-107-B	No Left Turn		
W-14-A	Watch Traffic Signals	12	
W-41	Roadside Delineators	4	
	Directional Signs		
	Destination Signs		
	P.A. Markers	2	

FED. ROAD DIST. NO.	STATE	FED. AID PROJ. NO.	FISCAL YEAR	SHEET NO.	TOTAL SHEETS
HAWAII	HAW.	F 50 (7)	1953	12A	35

NOTE: Pavement Markings not part of this Contract.

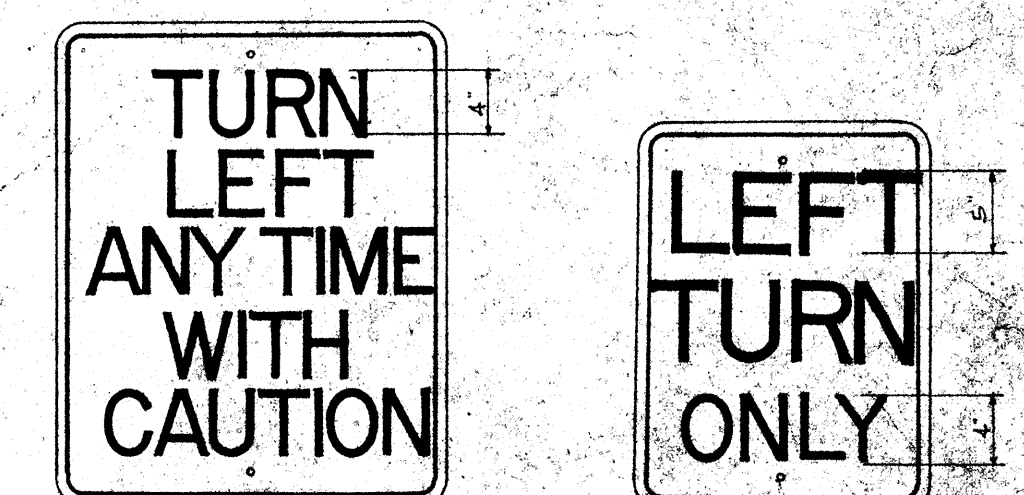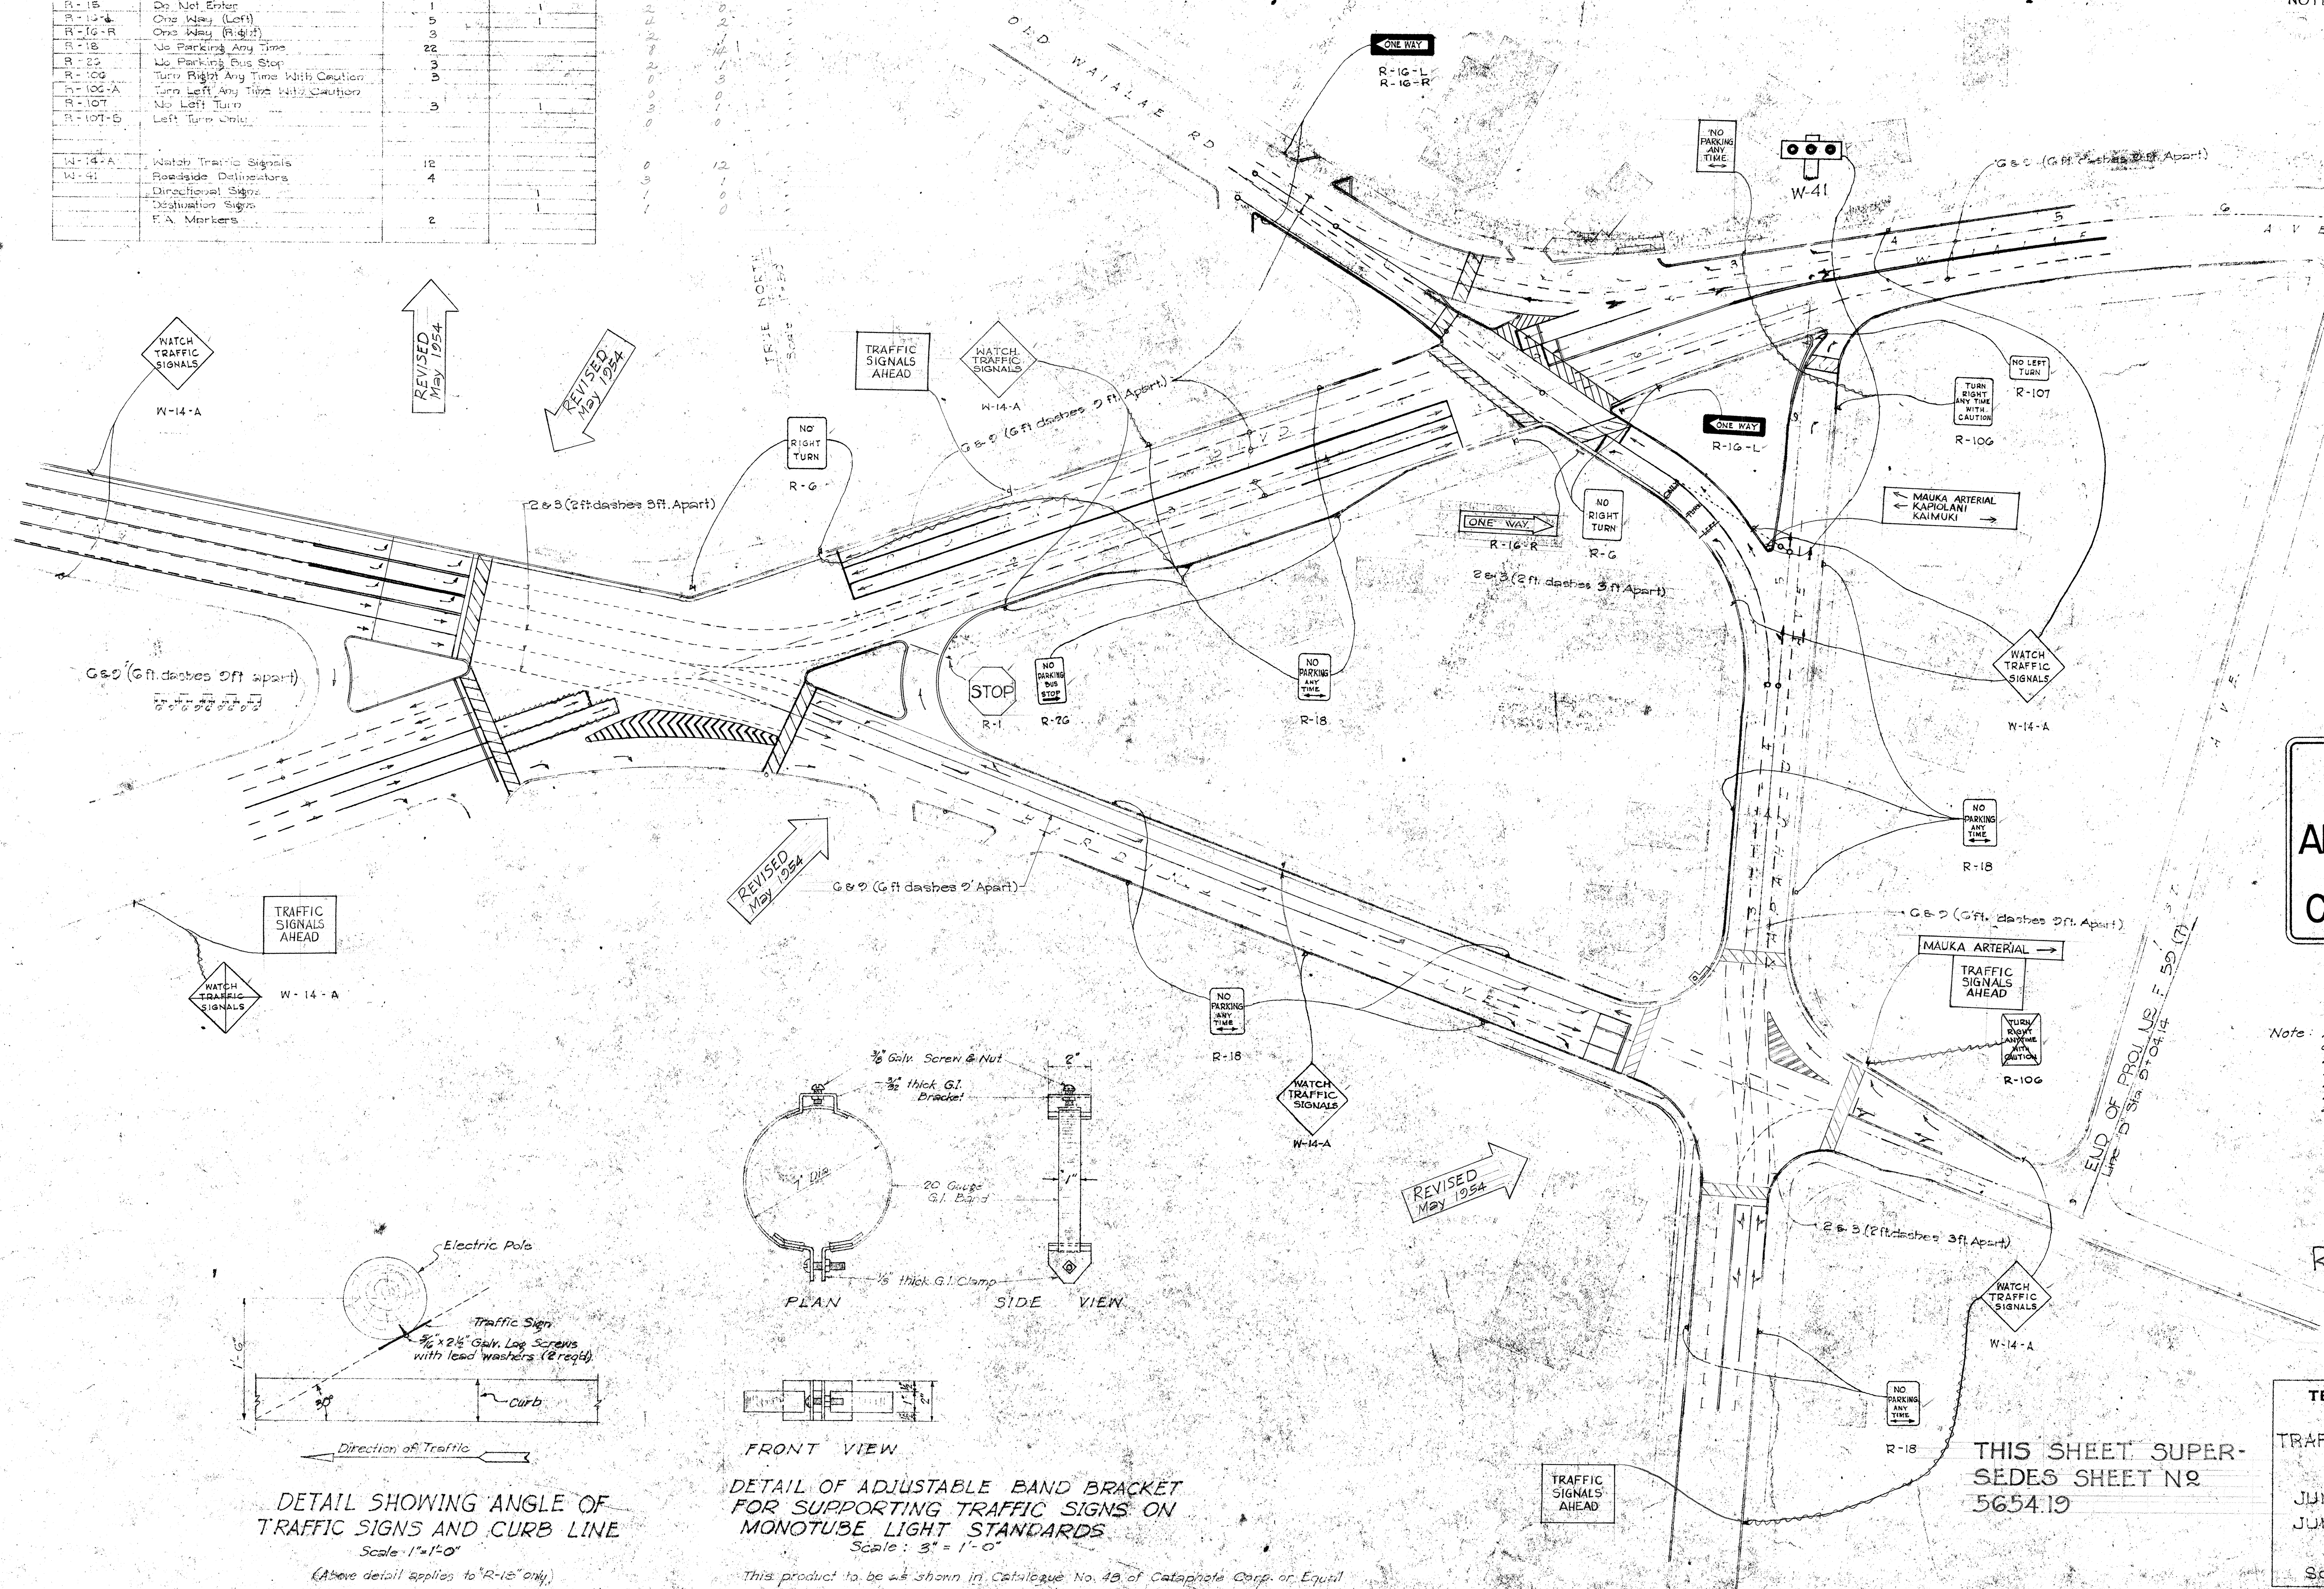

R-106-A 24' x 30'
R-107-B 18' x 24'

Note: All Regulatory (R) Signs shall have black letters on a white background except where noted. All letters and figures shall be of size and design shown and shall conform with "Standard Alphabet for Highway Signs" as set forth by the Public Roads Administration Federal Works Agency. Series "C" letters and Series "D" numerals shall be used, except where noted.

LEGEND

- 1 Sign mounted on Sign Post
- 2 Sign mounted on Wood or Monotube Pole
- 3 Sign mounted on Traffic Signal Standard

REVISED MAY 1954


TERRITORIAL HIGHWAY DEPARTMENT
TERRITORY OF HAWAII
TRAFFIC SIGNS & PAVEMENT MARKINGS
MAUKA ARTERIAL
JUNCTION KING - WAIALAE TO
JUNCTION HARDING - KAPAHULU
PROJECT NO F 50 (7)
Scale: 1" = 50' July, 1953

THIS SHEET SUPERSEDES SHEET NO 5654.19

SHEET NO. 2 OF 2 SHEETS

5654.19A

DETAIL SHOWING ANGLE OF TRAFFIC SIGNS AND CURB LINE
Scale: 1" = 1'-0"
(Above detail applies to "R-18" only.)

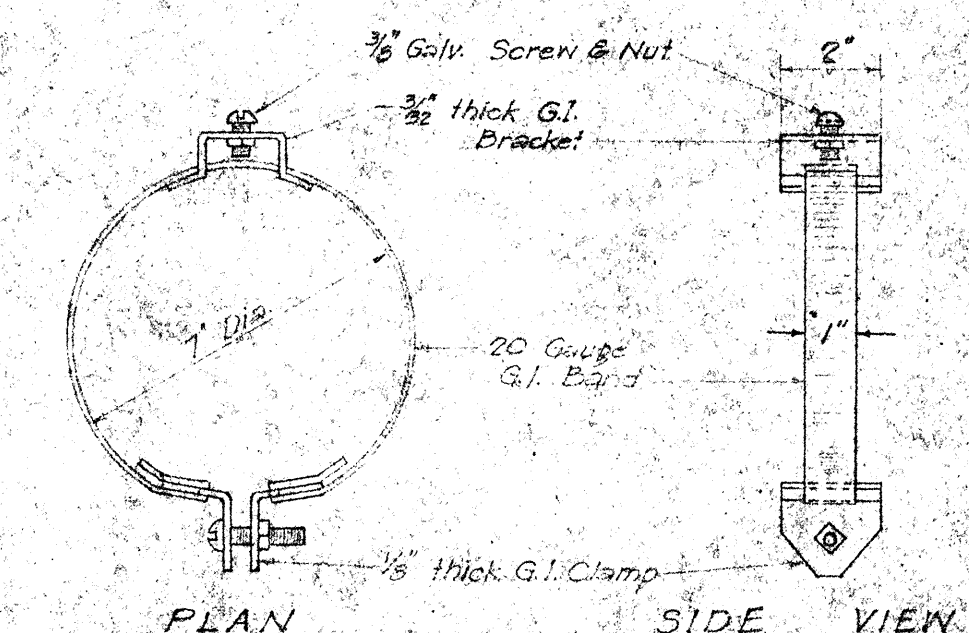

FRONT VIEW
DETAIL OF ADJUSTABLE BAND BRACKET FOR SUPPORTING TRAFFIC SIGNS ON MONOTUBE LIGHT STANDARDS
Scale: 3" = 1'-0"

This product to be as shown in Catalogue No. 46 of Cataphote Corp. or Equal

SURVEY PLOTTED BY	DATE
DESIGNED BY	
TRACED BY	
QUANTITIES CHECKED BY	
NOTE BOOK	
No.	