



| FED. ROAD DIST. NO. | STATE | FED. AID PROJ. NO. | FISCAL YEAR | SHEET NO. | TOTAL SHEETS |
|---------------------|-------|--------------------|-------------|-----------|--------------|
| HAWAII              | HAW.  | I-H-1(5)24         | 1965        | 53        | 276          |


# LEGEND FOR DEMOLITION PLANS

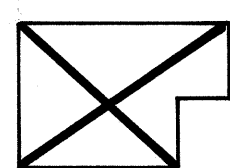


Denotes building already demolished, or to be demolished before this contract. (N.I.C.)

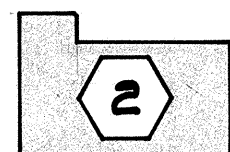

Denotes building to be demolished under Contract Item No. 124

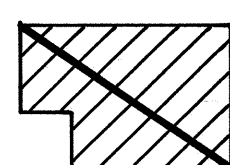


Dwelling not in this contract. To be removed by others before this contract.

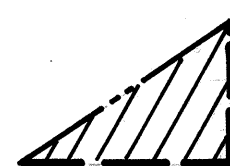


Area to be used only during demolition of all buildings designated on the plans and other existing improvements and/or removal of debris.

Contractor shall remove all equipment and material from this area upon completion of demolition and removal of debris.

Work shall be scheduled conforming to Sect. 7 of the Standard Specification, minimizing inconvenience to the property owners.

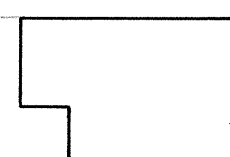

Denotes building outside of highway right-of-way and to remain.

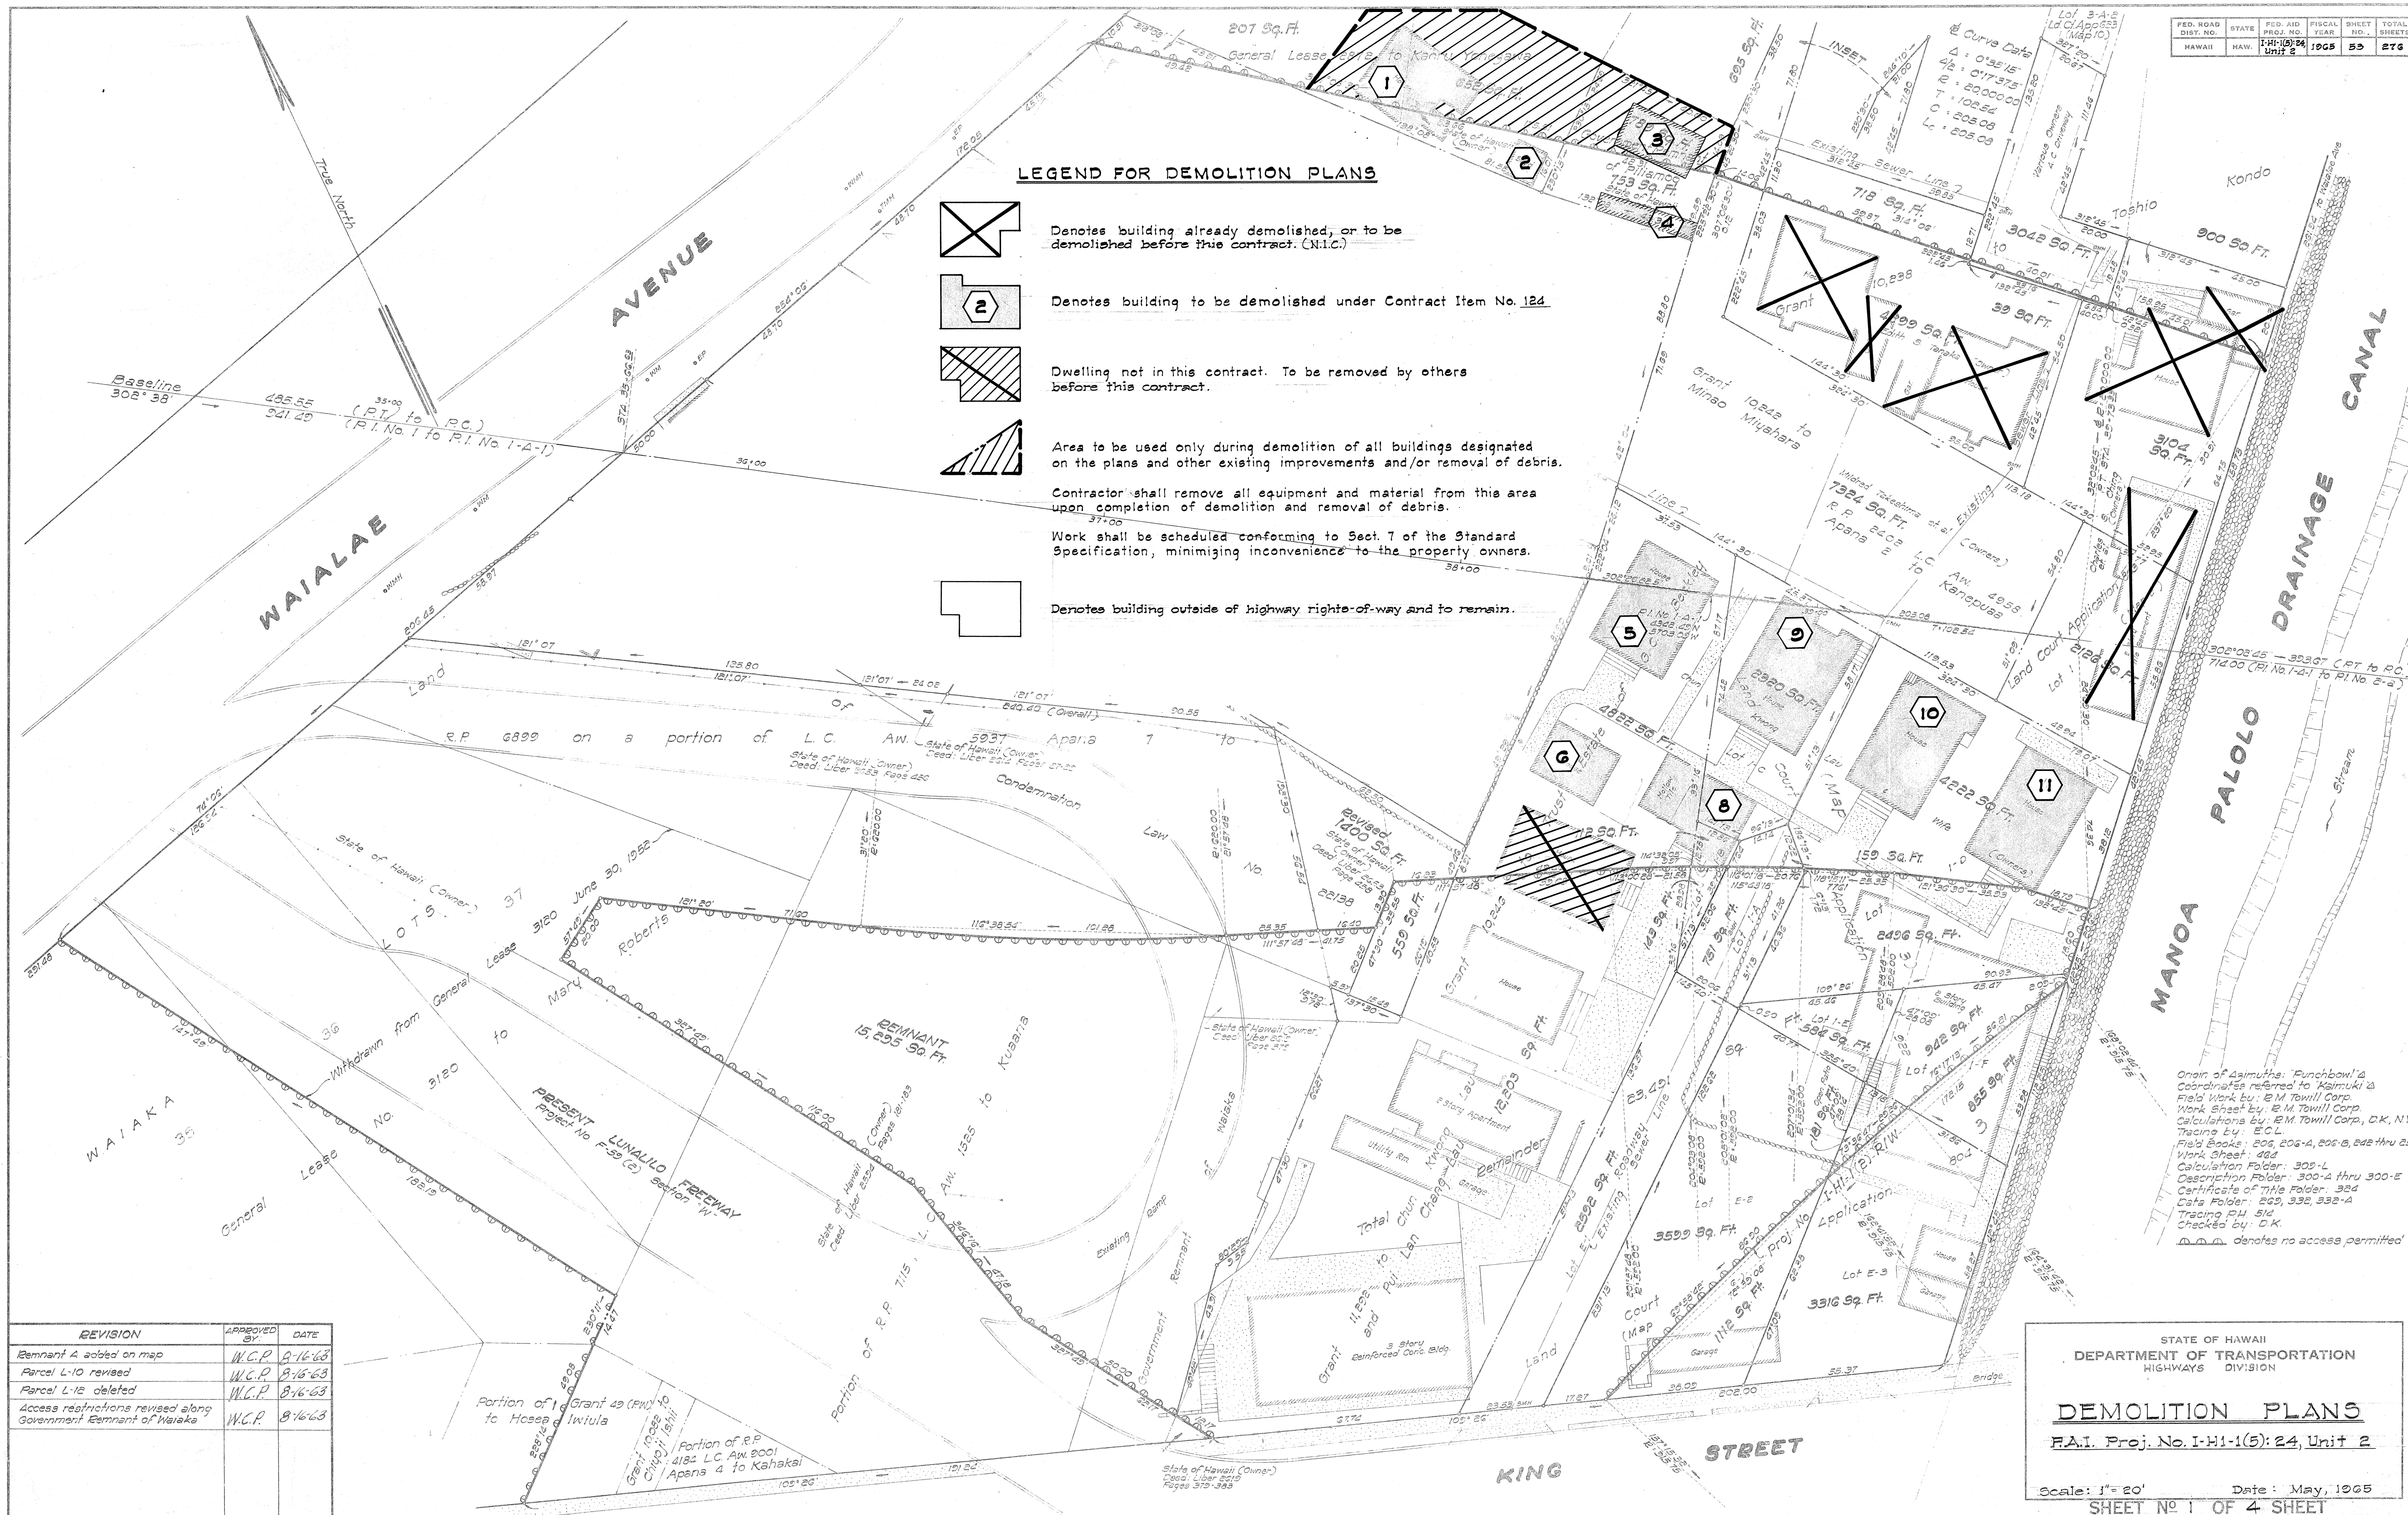


| REVISION                                                        | APPROVED BY | DATE    |
|-----------------------------------------------------------------|-------------|---------|
| Remnant A added on map                                          | W.C.P.      | 8-16-63 |
| Parcel L-10 revised                                             | W.C.P.      | 8-16-63 |
| Parcel L-12 deleted                                             | W.C.P.      | 8-16-63 |
| Access restrictions revised along Government Remnant of Waiakae | W.C.P.      | 8-16-63 |

Tax Map Key: 192 DM 2-7-20

STATE OF HAWAII  
DEPARTMENT OF TRANSPORTATION  
HIGHWAYS DIVISION

**DEMOLITION PLANS**  
F.A.I. Proj. No. I-H-1(5) 24, Unit 2

Scale: 1" = 20' Date: May, 1965  
SHEET NO. 1 OF 4 SHEET

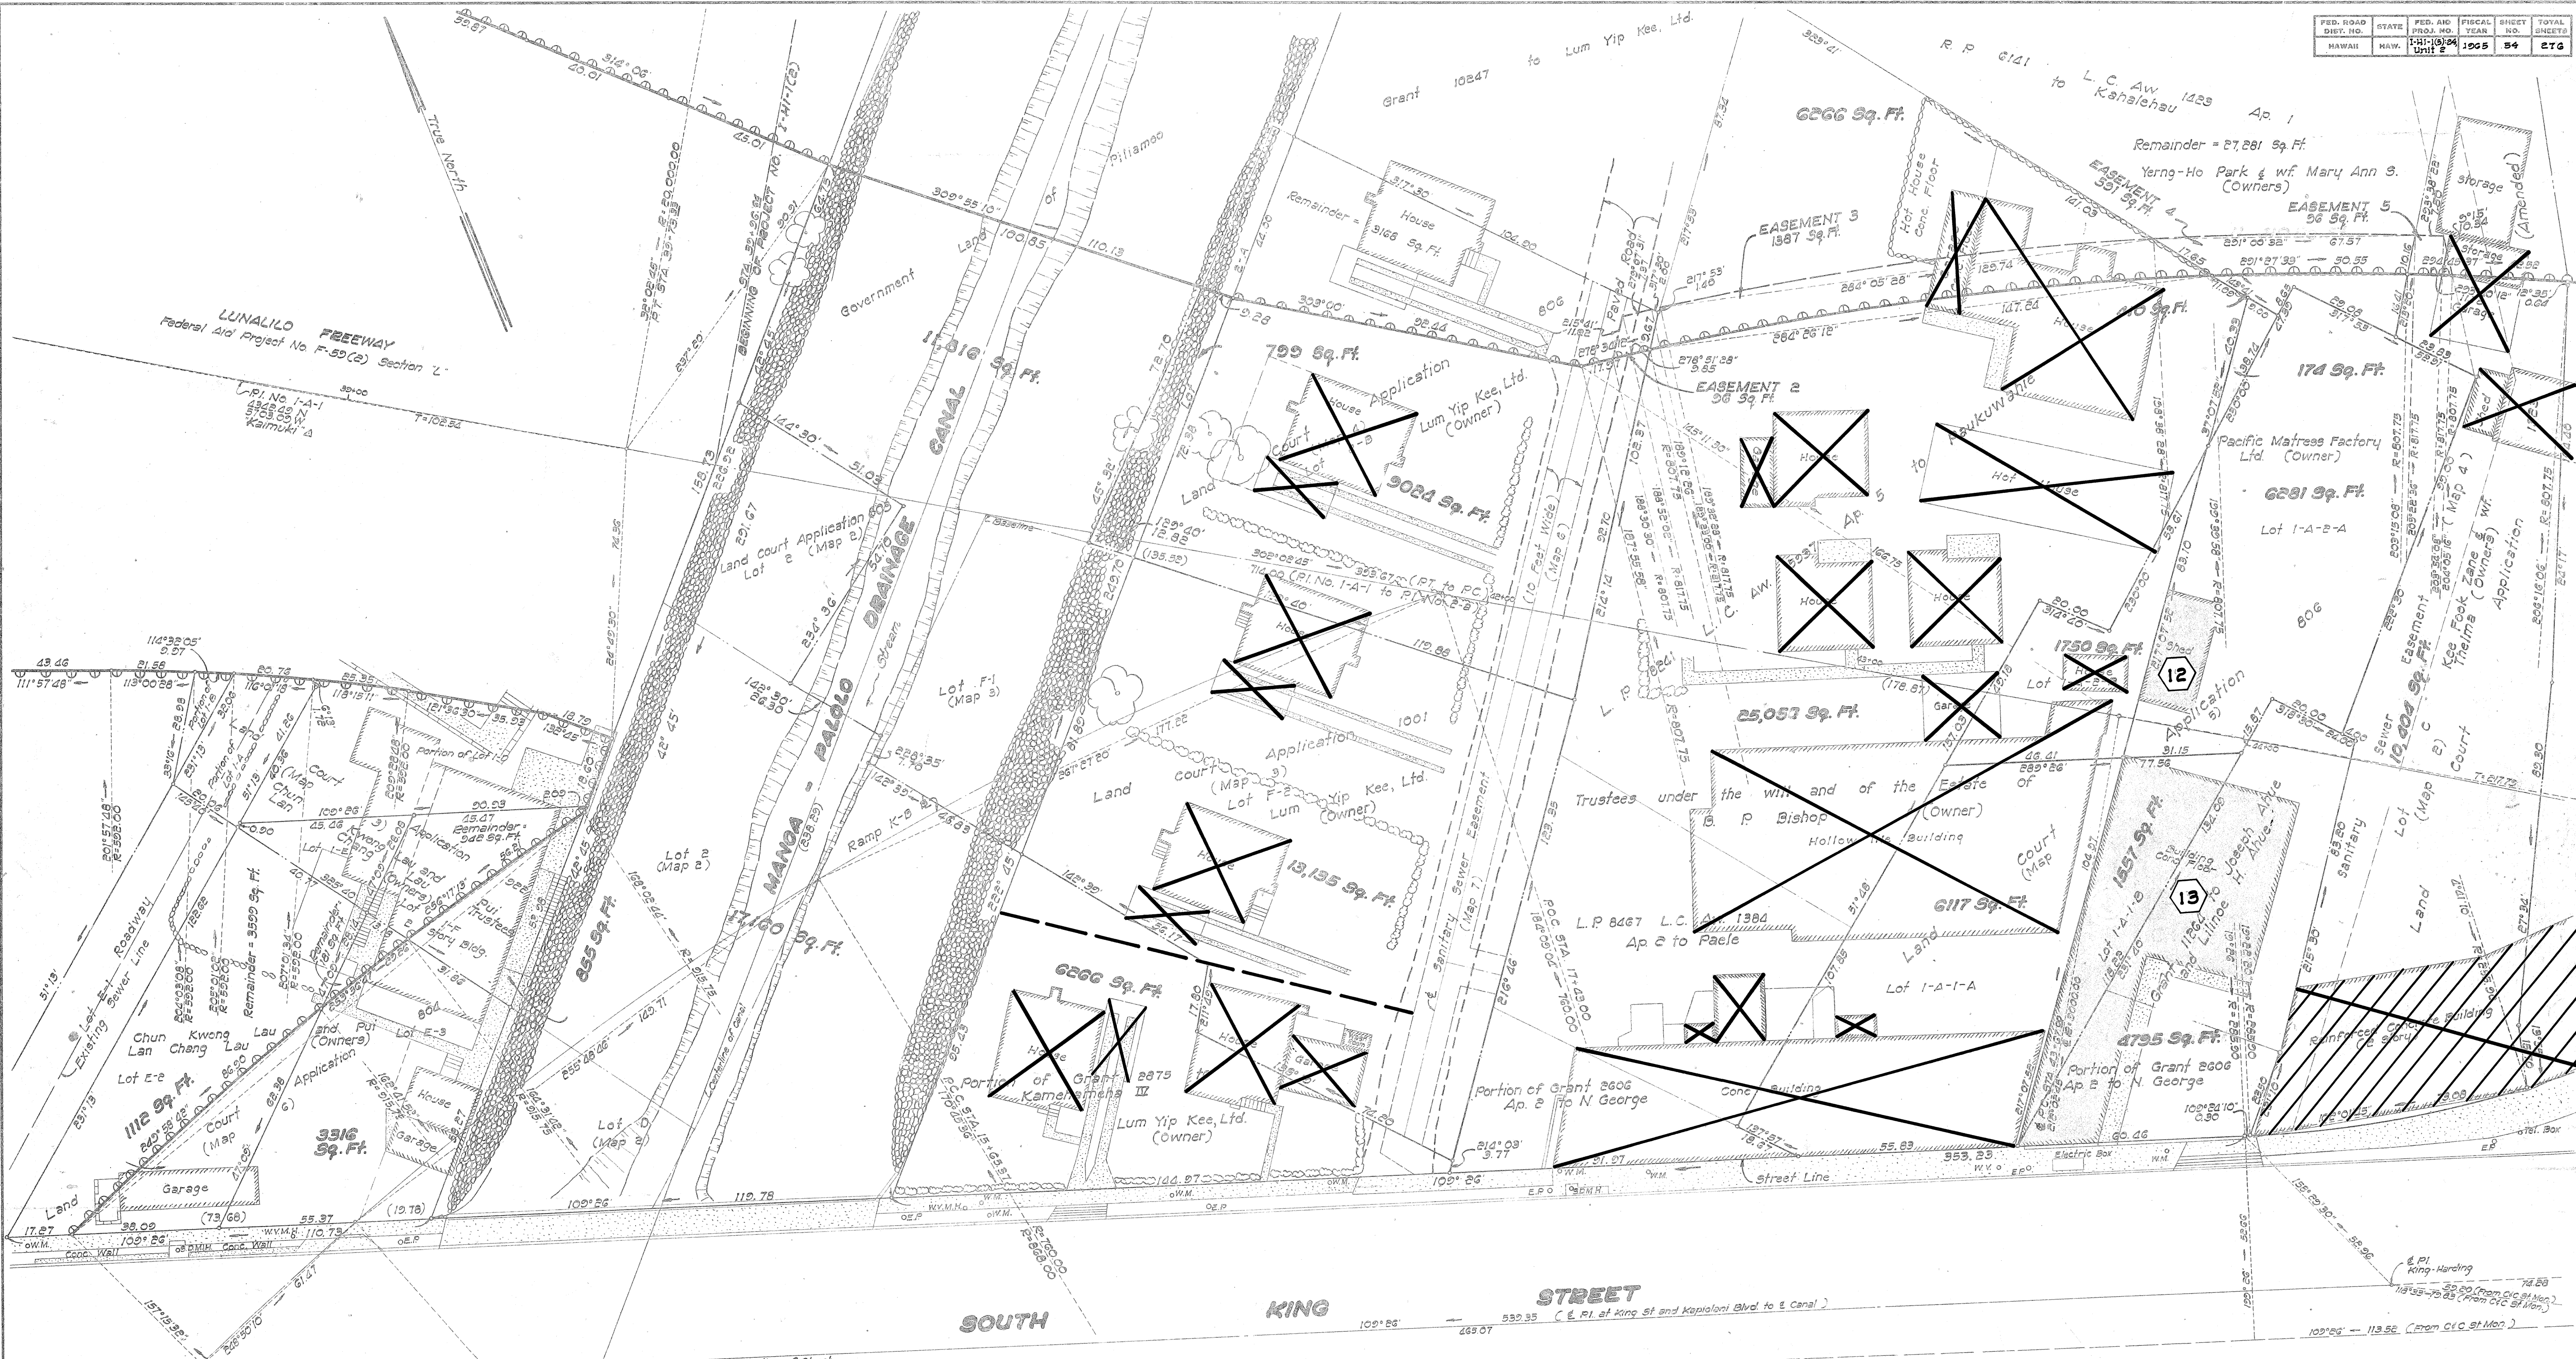


Note:  
Origin of Azimuths "Punchbowl" Δ unless otherwise noted  
Coordinates as shown for Parcels Ewa of Kapiolani Boulevard referred to C & C St. Mon. Harding Ave. & Kapiolani Blvd.  
Coordinates as shown referred to "Kaimuki" Δ are based on "Punchbowl" Δ origin of Azimuths  
Field Work by: R. M. Towill Corp.  
Work Sheet by: R. M. Towill Corp.  
Calculations by: R. M. Towill Corp., B.G. & D.W.L.  
Tracing by: V.M.  
Field Books: 206, 206-A, 206-B, 206-C, 206-D, 244, 249 & 250  
Work Sheet: 464  
Calculation Folder: 309-D, 309-E, 309-F, 309-J & 371  
Description Folder: 366  
Certificate of Title Folder: 384-C  
Data Folder: 478  
Tracing P.H.: 515  
Checked by: D.W.L.

denotes no access permitted  
Parcel No. 3-A added on map Oct 11, 1963

DATE \_\_\_\_\_  
SURVEY PLOTTED BY \_\_\_\_\_  
ORIGINAL PLAN \_\_\_\_\_  
DESIGNED BY \_\_\_\_\_  
NOTE BOOK \_\_\_\_\_  
CHECKED BY \_\_\_\_\_

| FED. ROAD<br>DIST. NO. | STATE | FED. AID<br>PROJ. NO. | FISCAL<br>YEAR | SHEET<br>NO. | TOTAL<br>SHEETS |
|------------------------|-------|-----------------------|----------------|--------------|-----------------|
| HAWAII                 | HAW.  | I-11(5)-24,<br>Unit 2 | 1965           | 55           | 276             |

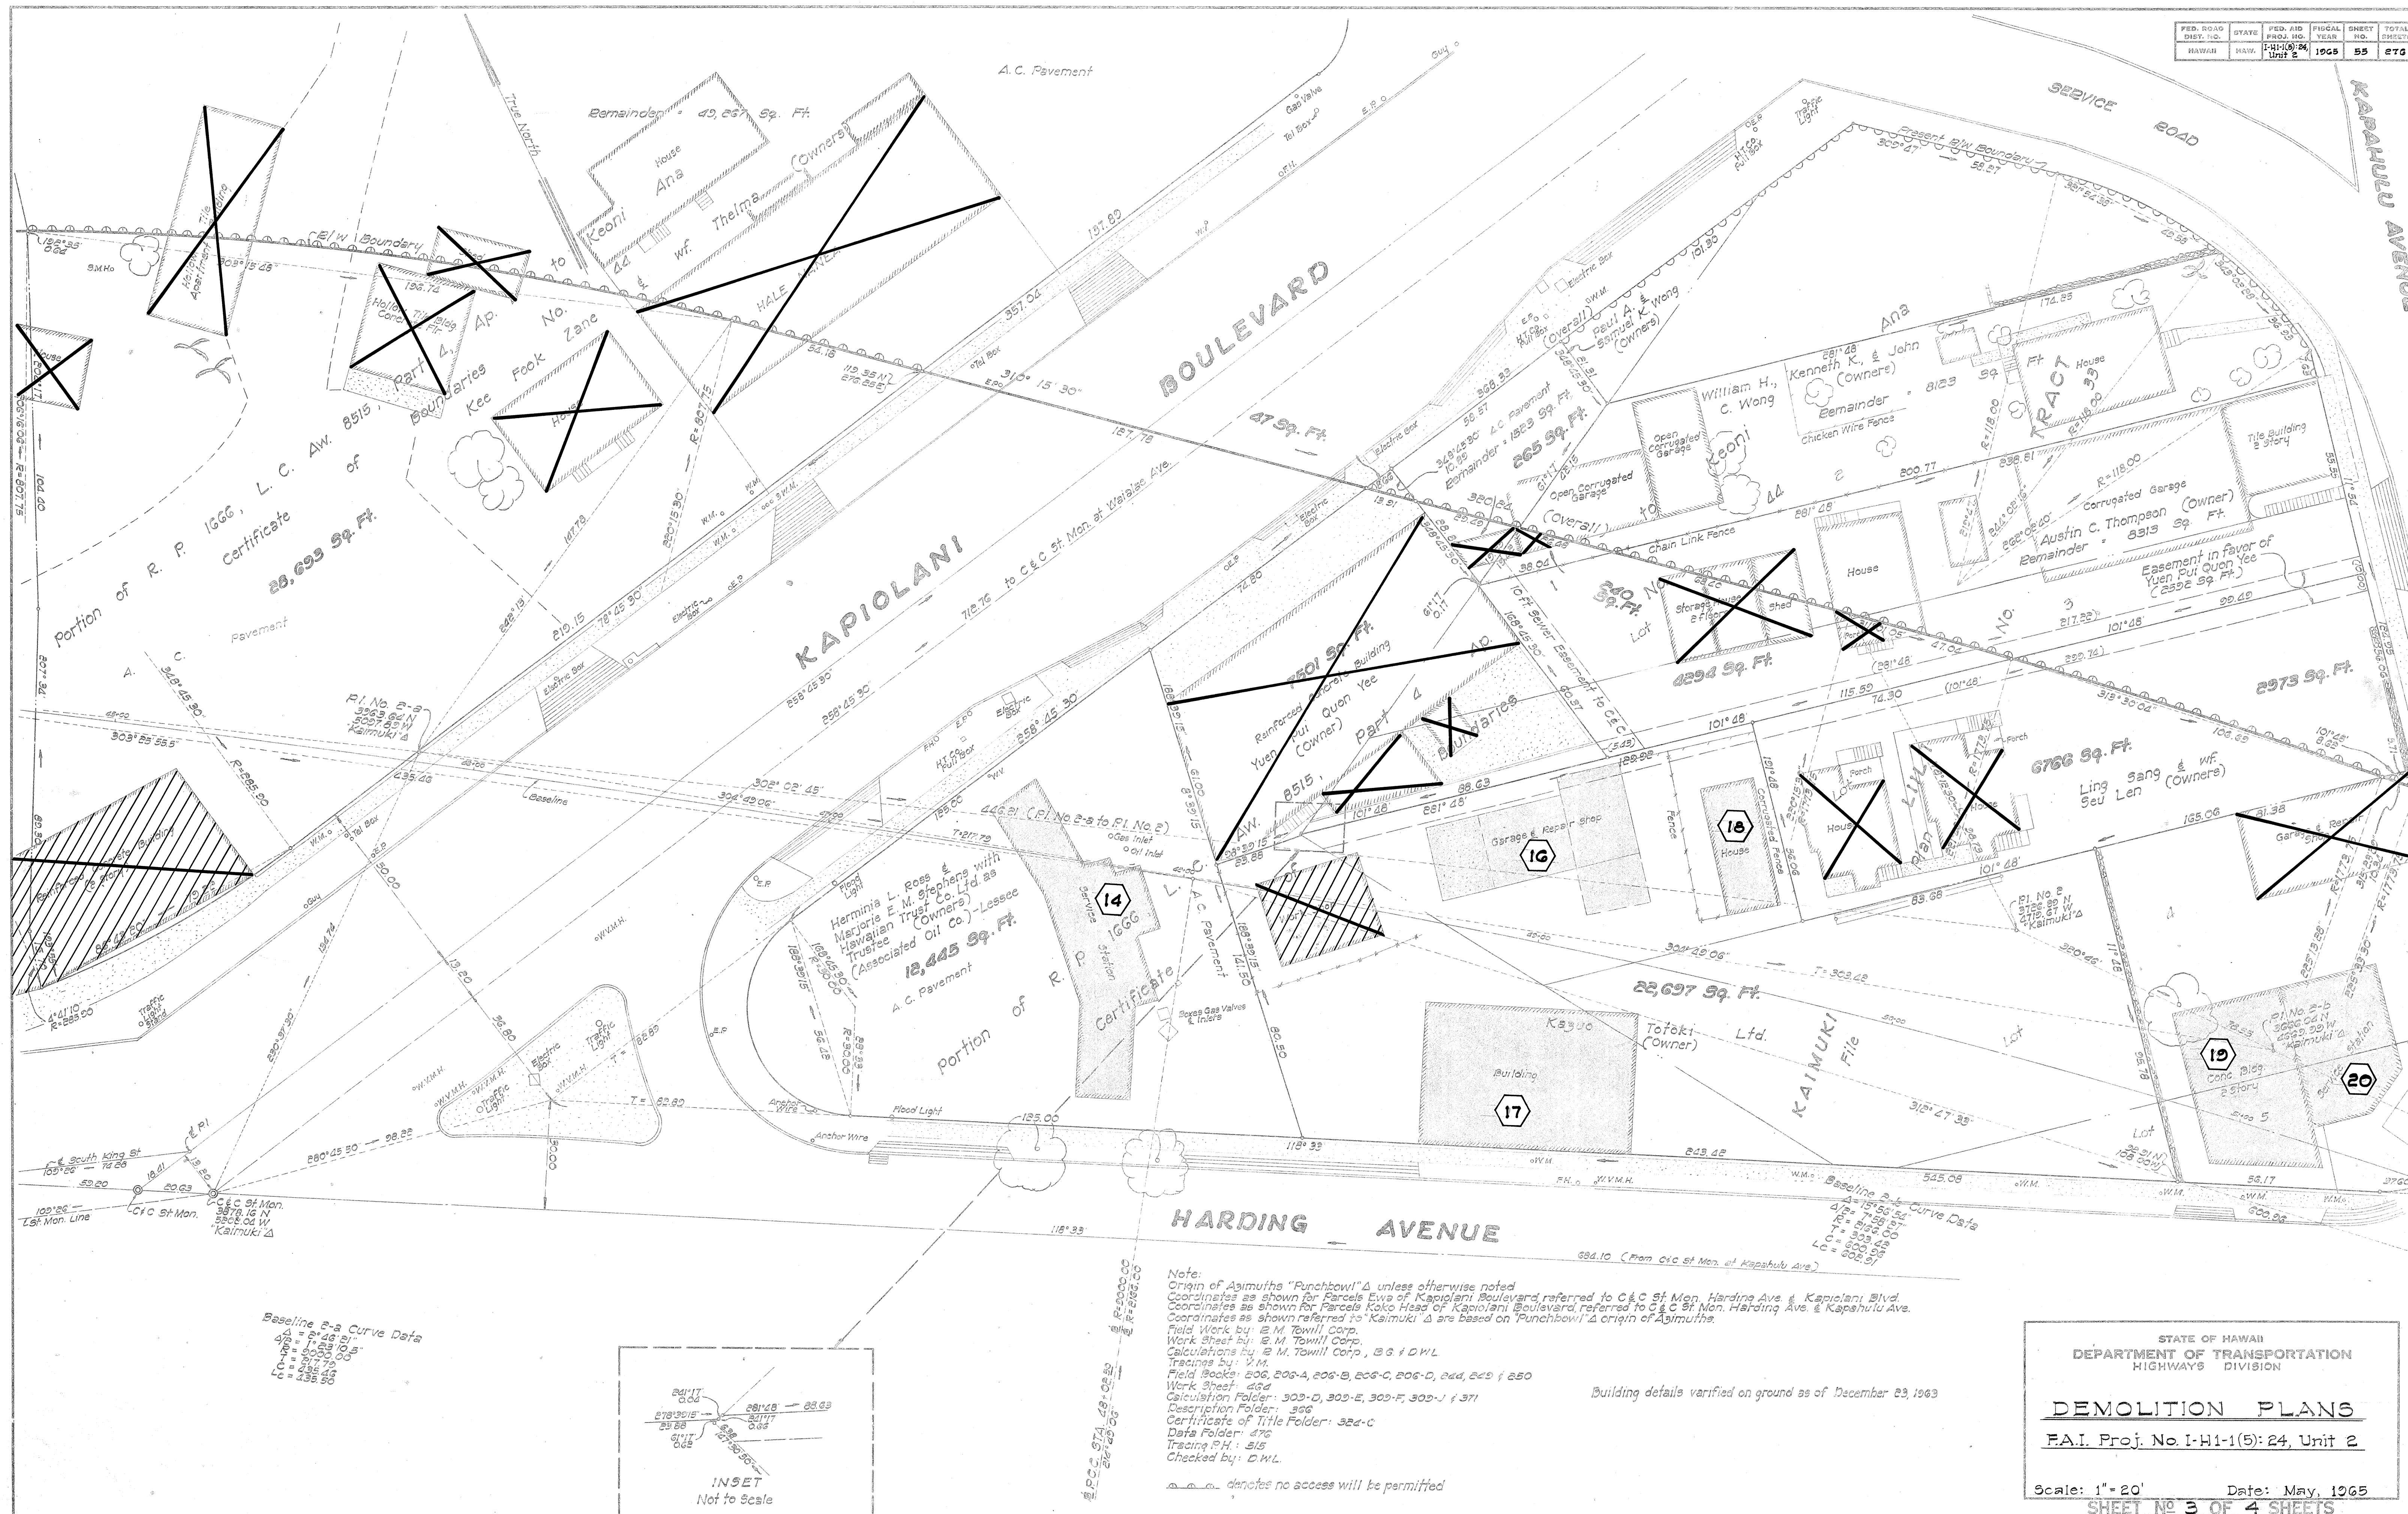

Note: Origin of *Azimuths* "Punchbowl"  $\Delta$  unless otherwise noted  
Coordinates as shown for Parcels Ewa of Kapoliani Boulevard referred to C & C St Mon, Harding Ave. & Kapoliani Blvd  
Coordinates as shown for Parcels Koko Hsao of Kapoliani Boulevard referred to C & C St Mon, Harding Ave. & Kapahulu Ave.  
Coordinates as shown referred to "Kaimuki"  $\Delta$  are based on "Punchbowl"  $\Delta$  origin of *Azimuths*.  
Field Work by: B. M. Towill Corp.  
Work Sheet by: B. M. Towill Corp.  
Calculations by: B. M. Towill Corp., B.G. & D.W.L.  
Tracing by: Y.M.  
Field Books: 200, 203-A, 206-B, 203-C, 206-D, 24d, 249 & 250  
Work Sheet: 45d  
Calculation Folder: 302-D, 303-E, 303-F, 303-J & 371  
Description Folder: 360  
Certificate of Title Folder: 32d-c  
Data Folder: 47c  
Tracing P.H.: 515  
Checked by: D.W.L.

*Building details verified on ground as of December 23, 1963*

STATE OF HAWAII  
DEPARTMENT OF TRANSPORTATION  
HIGHWAYS DIVISION

DEMOLITION PLANS

F.A.I. Proj. No. I-H1-1(5): 24, Unit 2

Scale: 1" = 20'      Date: May, 1965

SHEET NO 3 OF 4 SHEETS

