



FED. ROAD DIST. NO.	STATE	FED. AID PROJ. NO.	FISCAL YEAR	SHEET NO.	TOTAL SHEETS
HAWAII	HAW.	144-10-24 Unit 2	1965	14A	276


Revised: July 16, 1965
Jan. 9, 1967

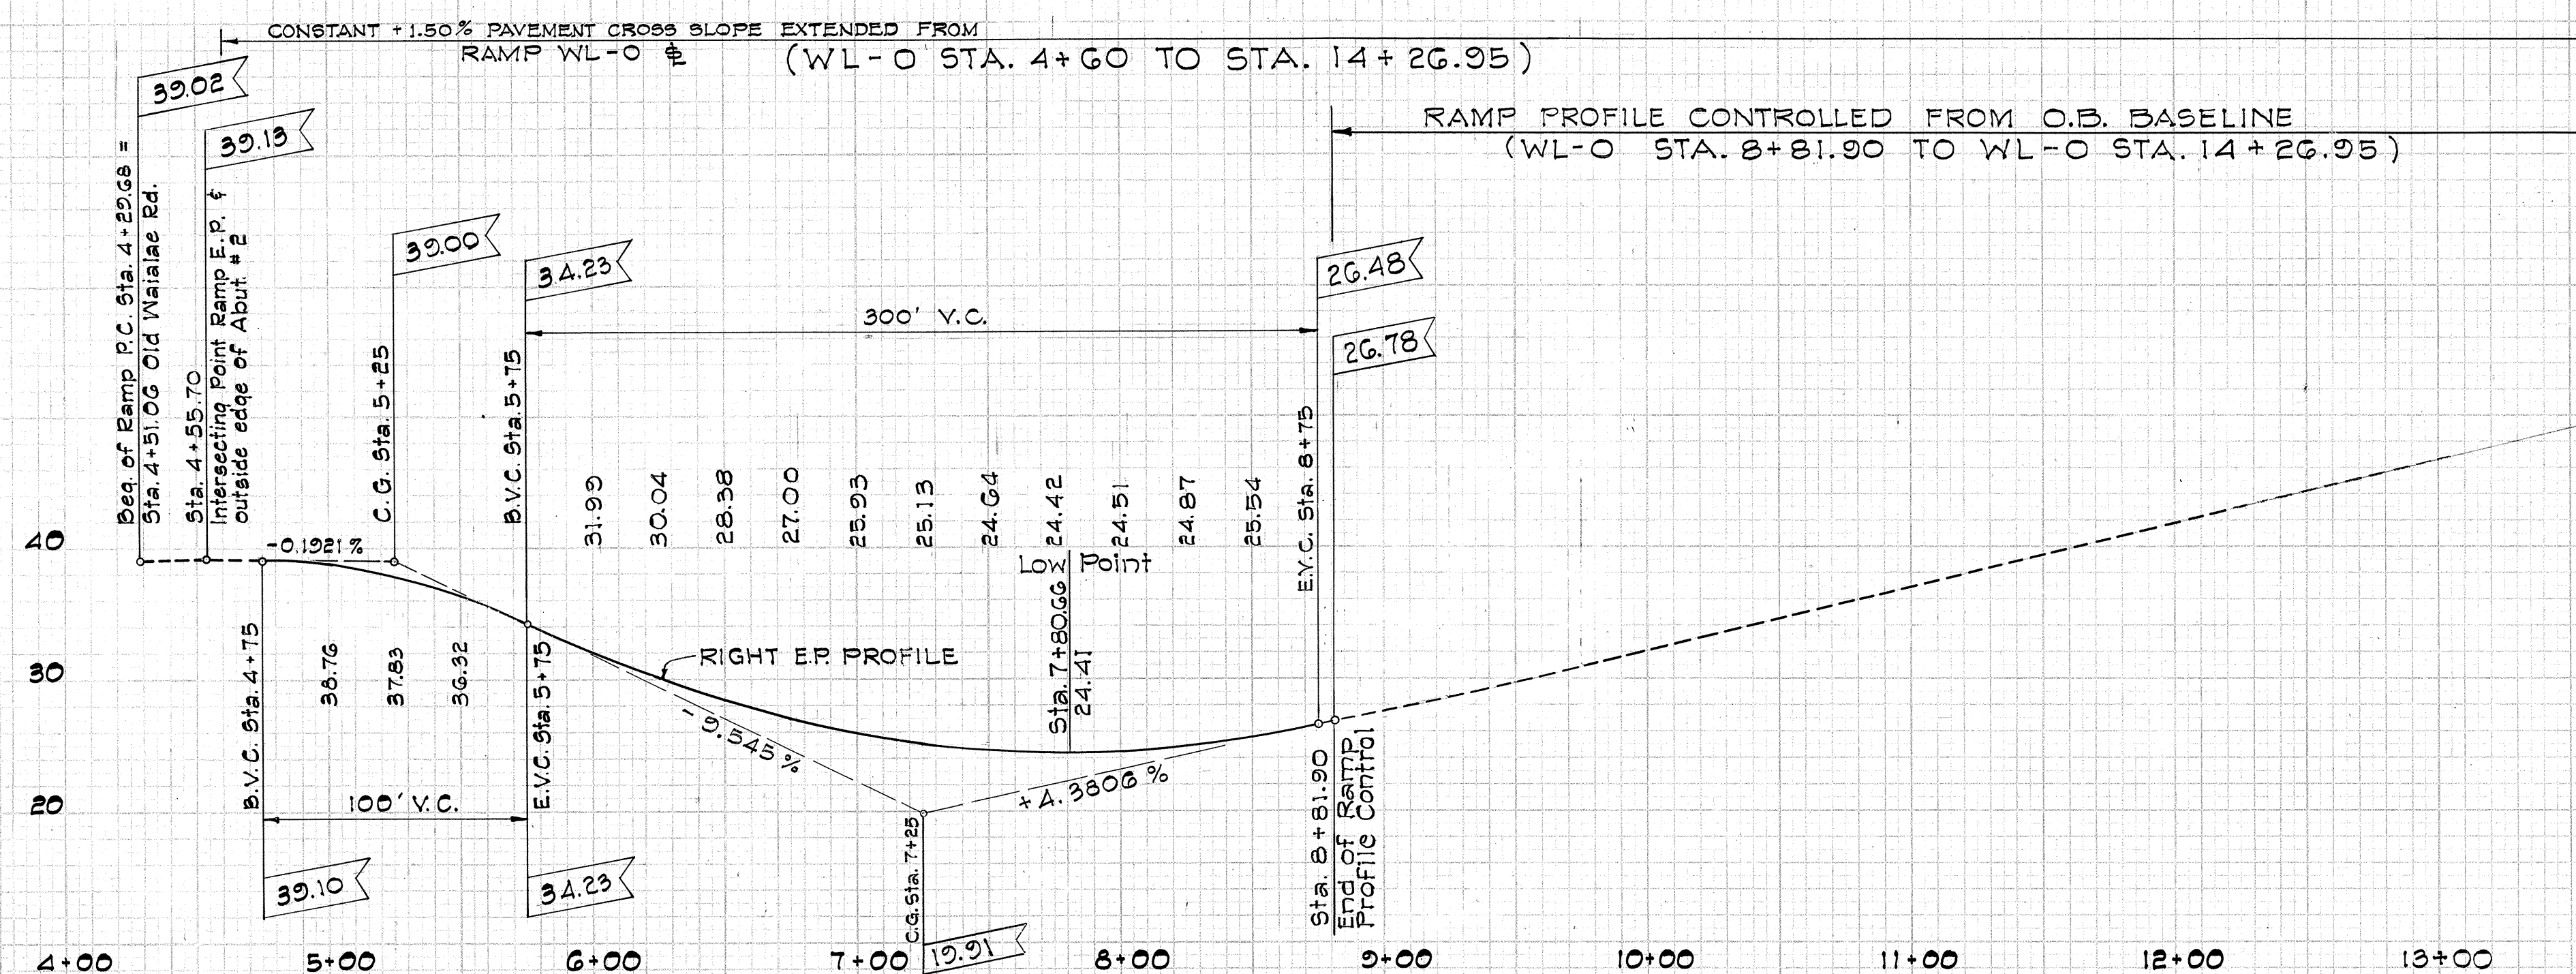

PROFILE RAMP WL-0

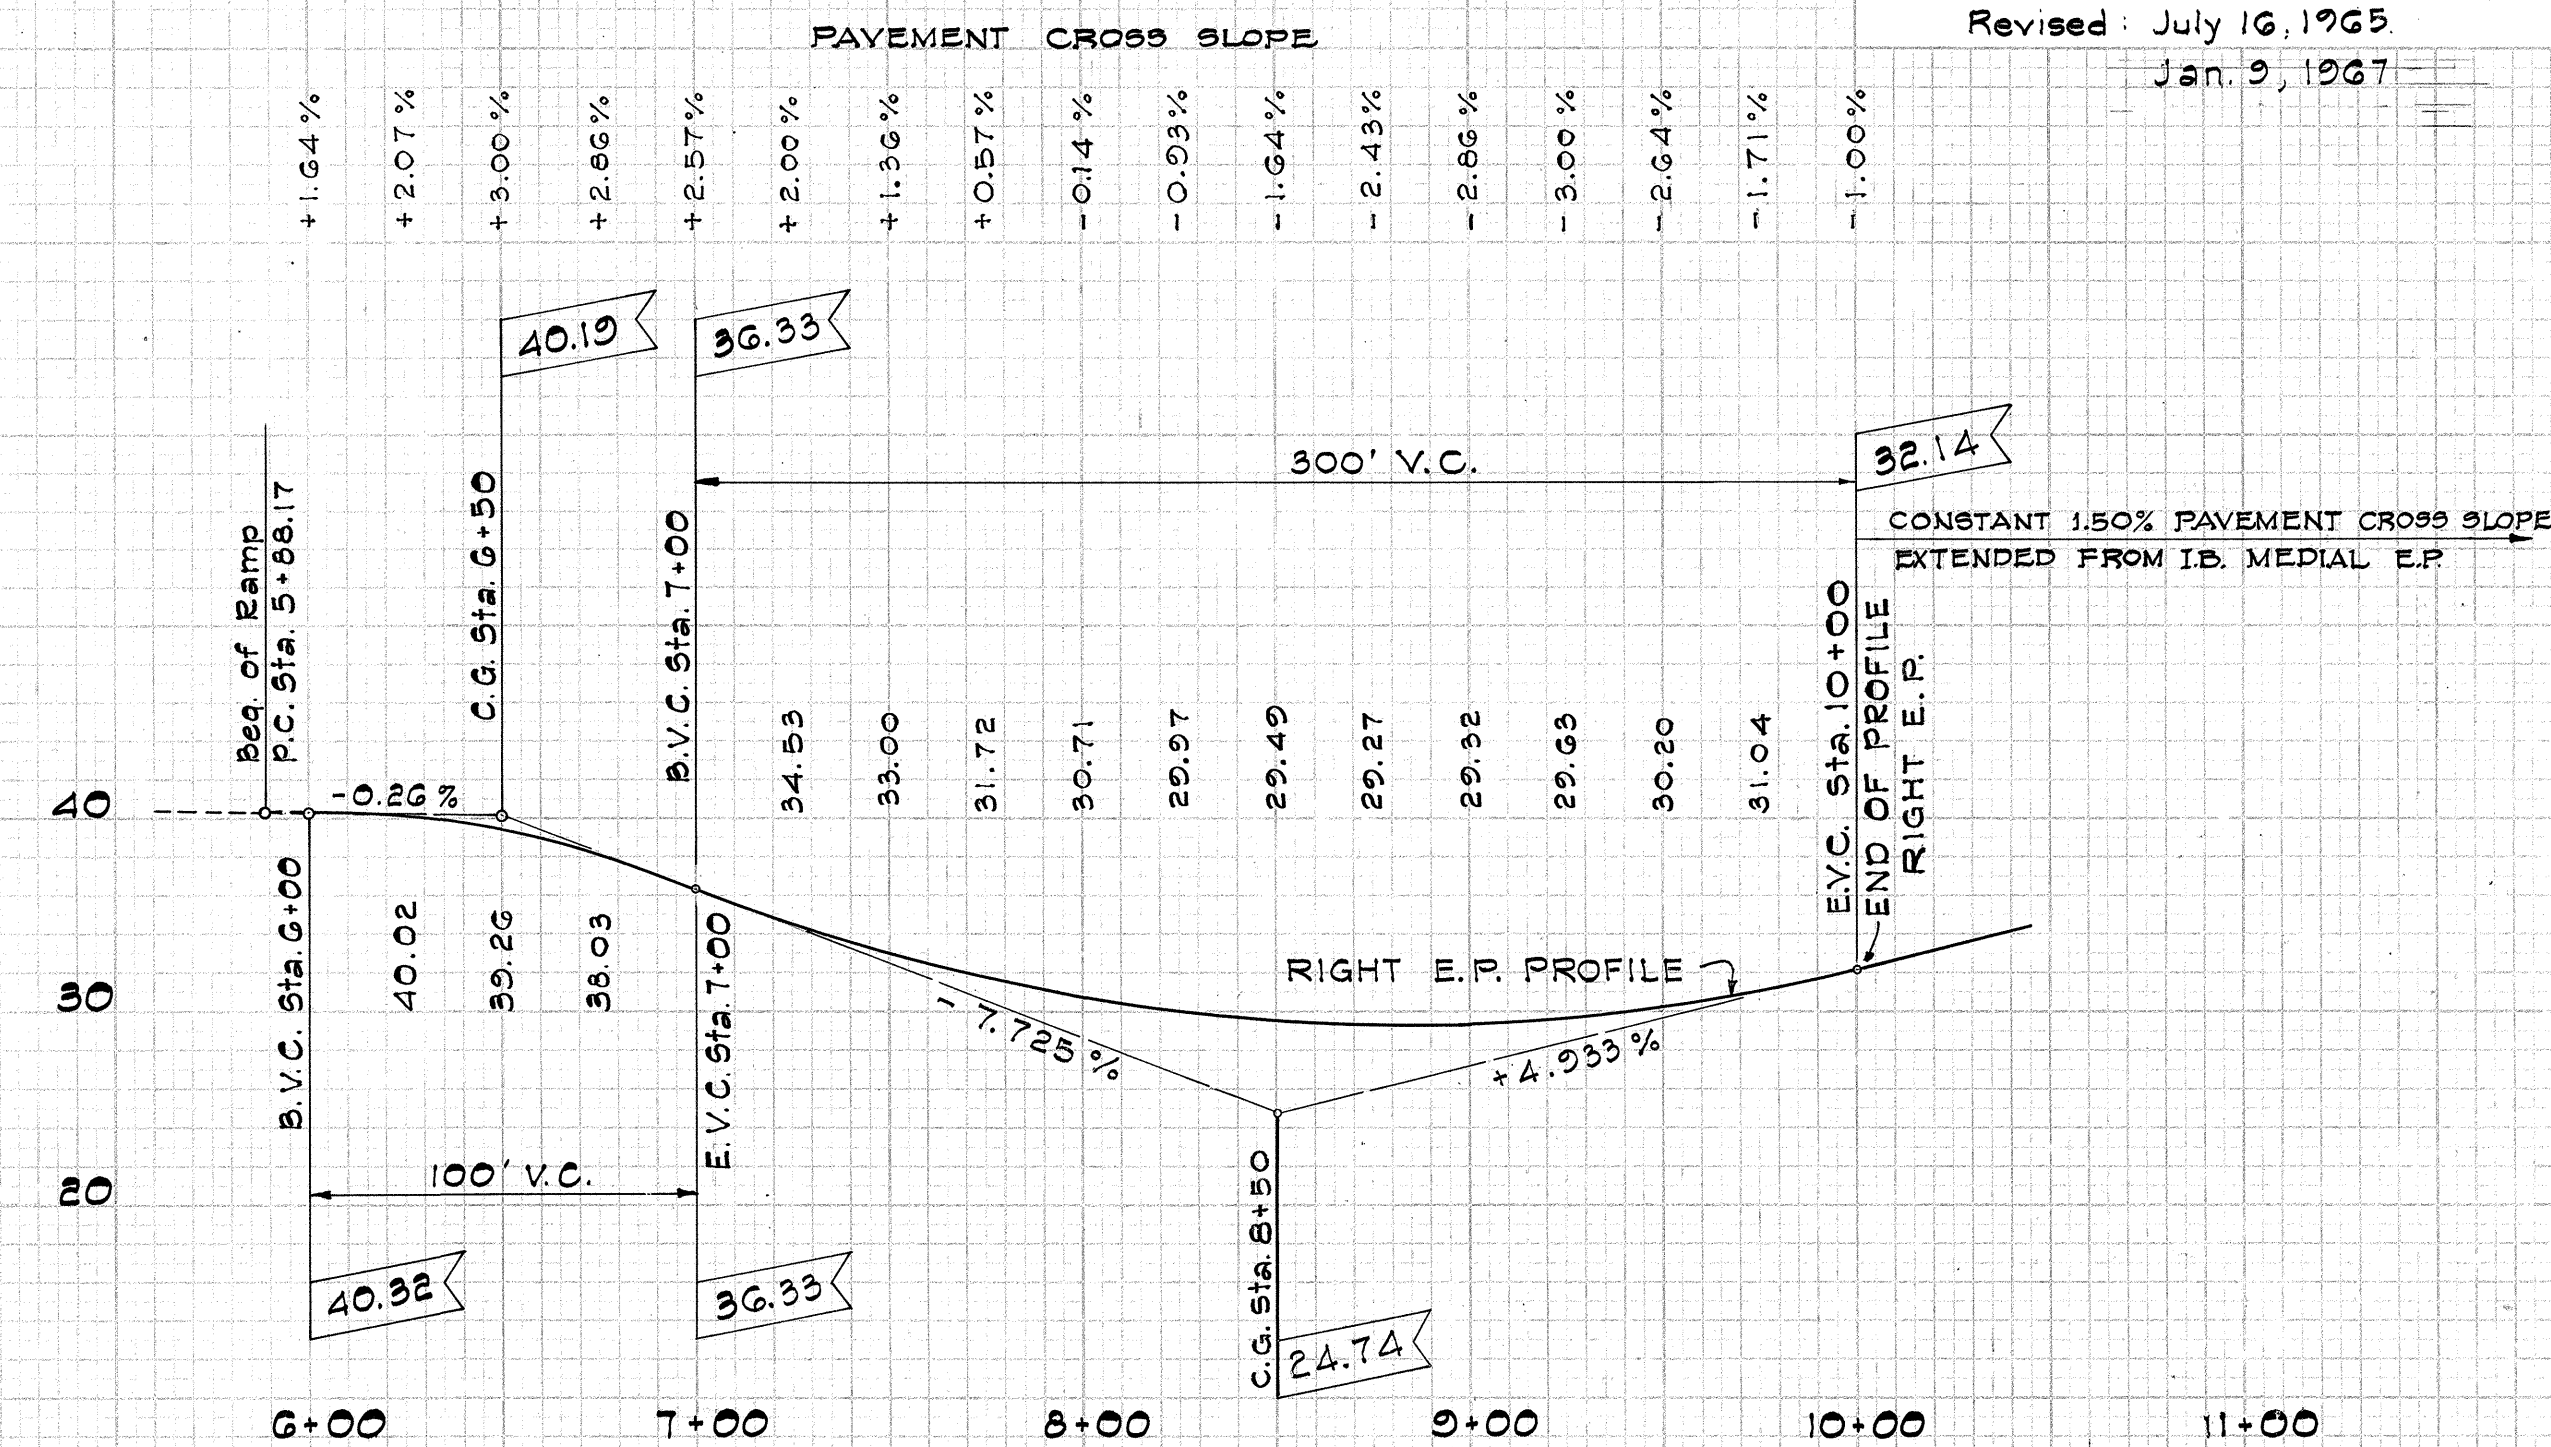


PROFILE RAMP WL-1

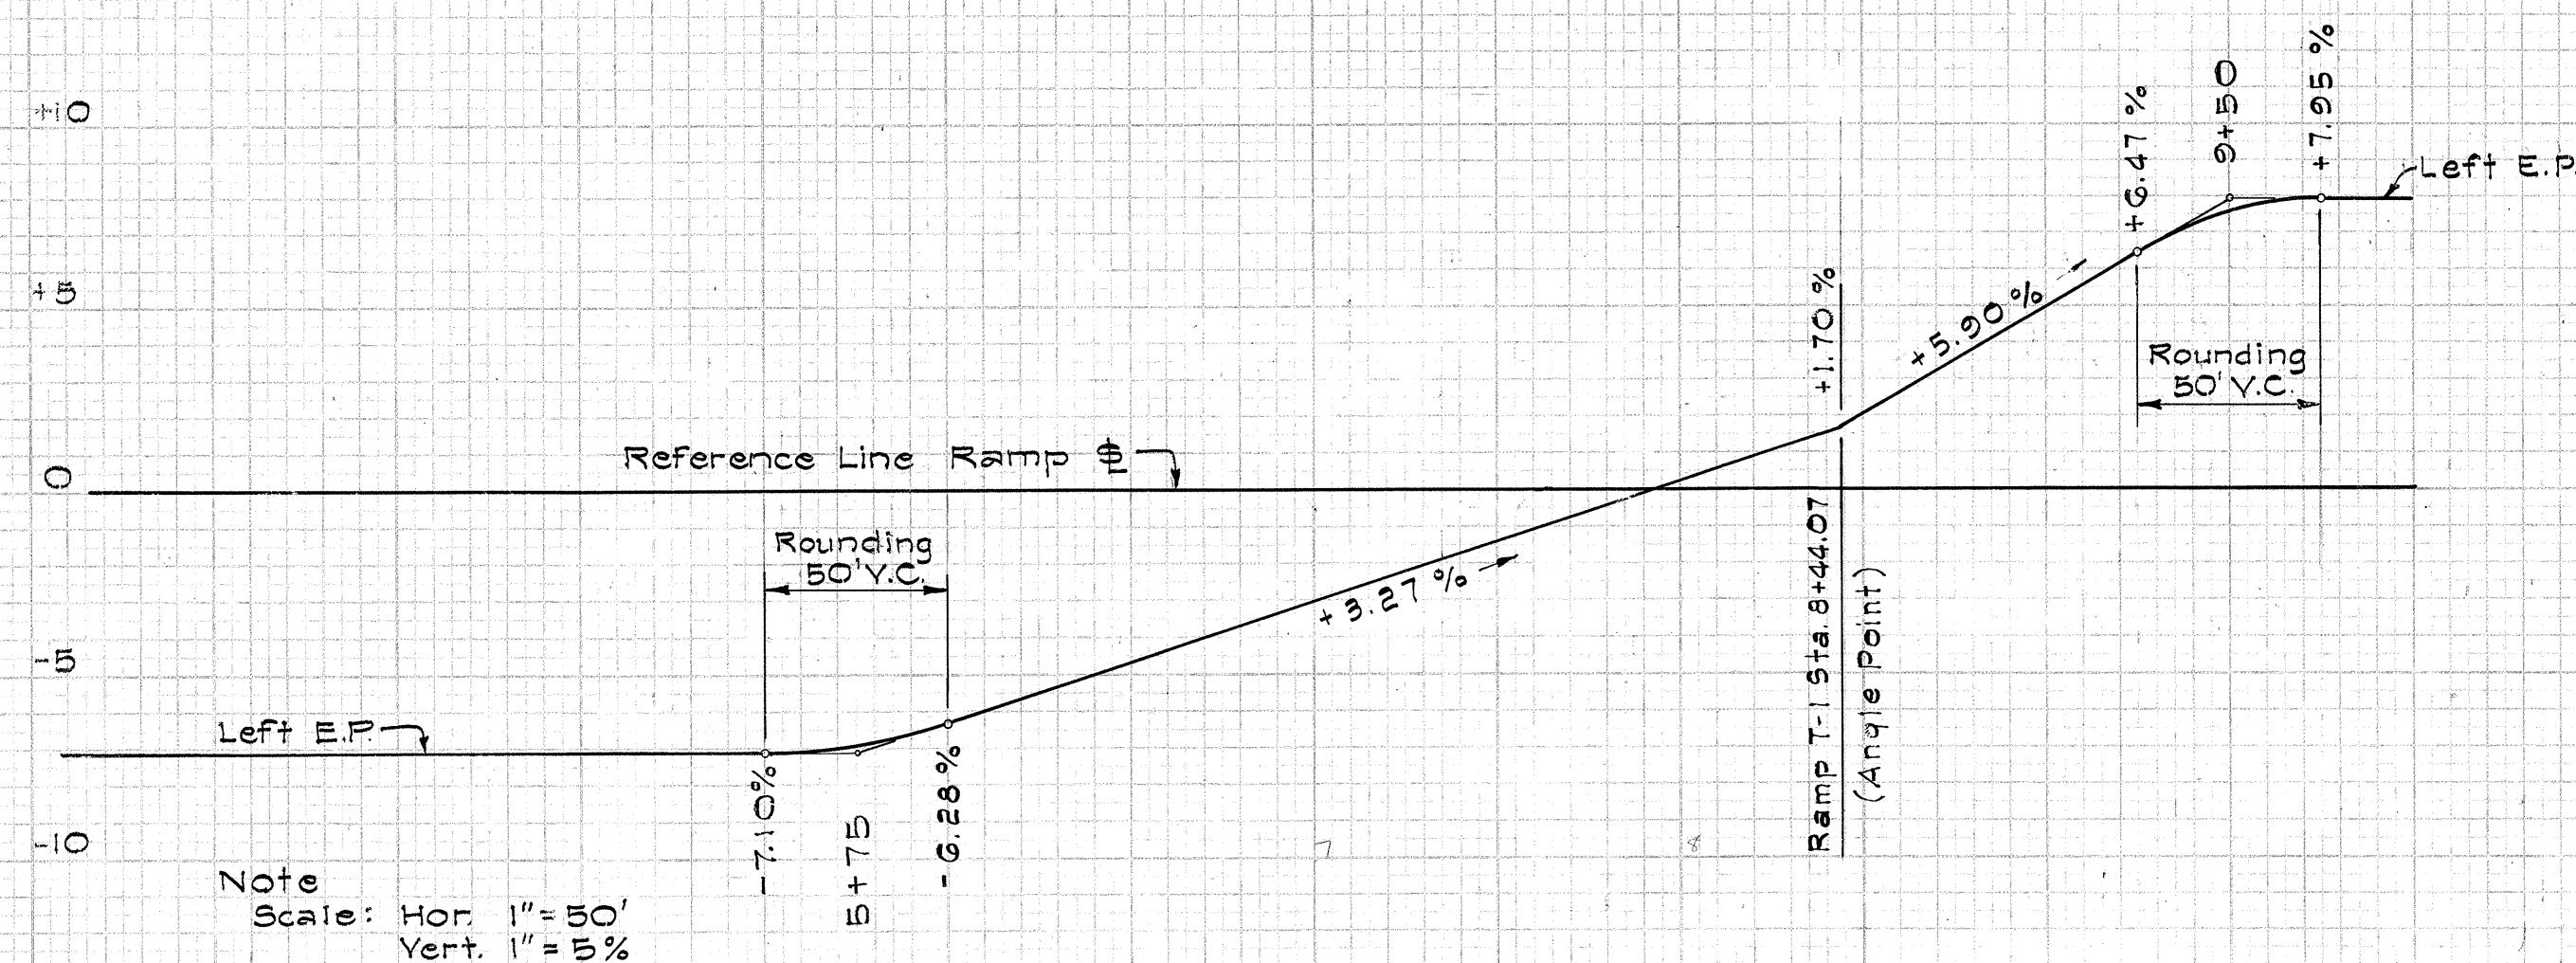

RAMP T-1 SE DIAGRAM



PROFILE RAMP T

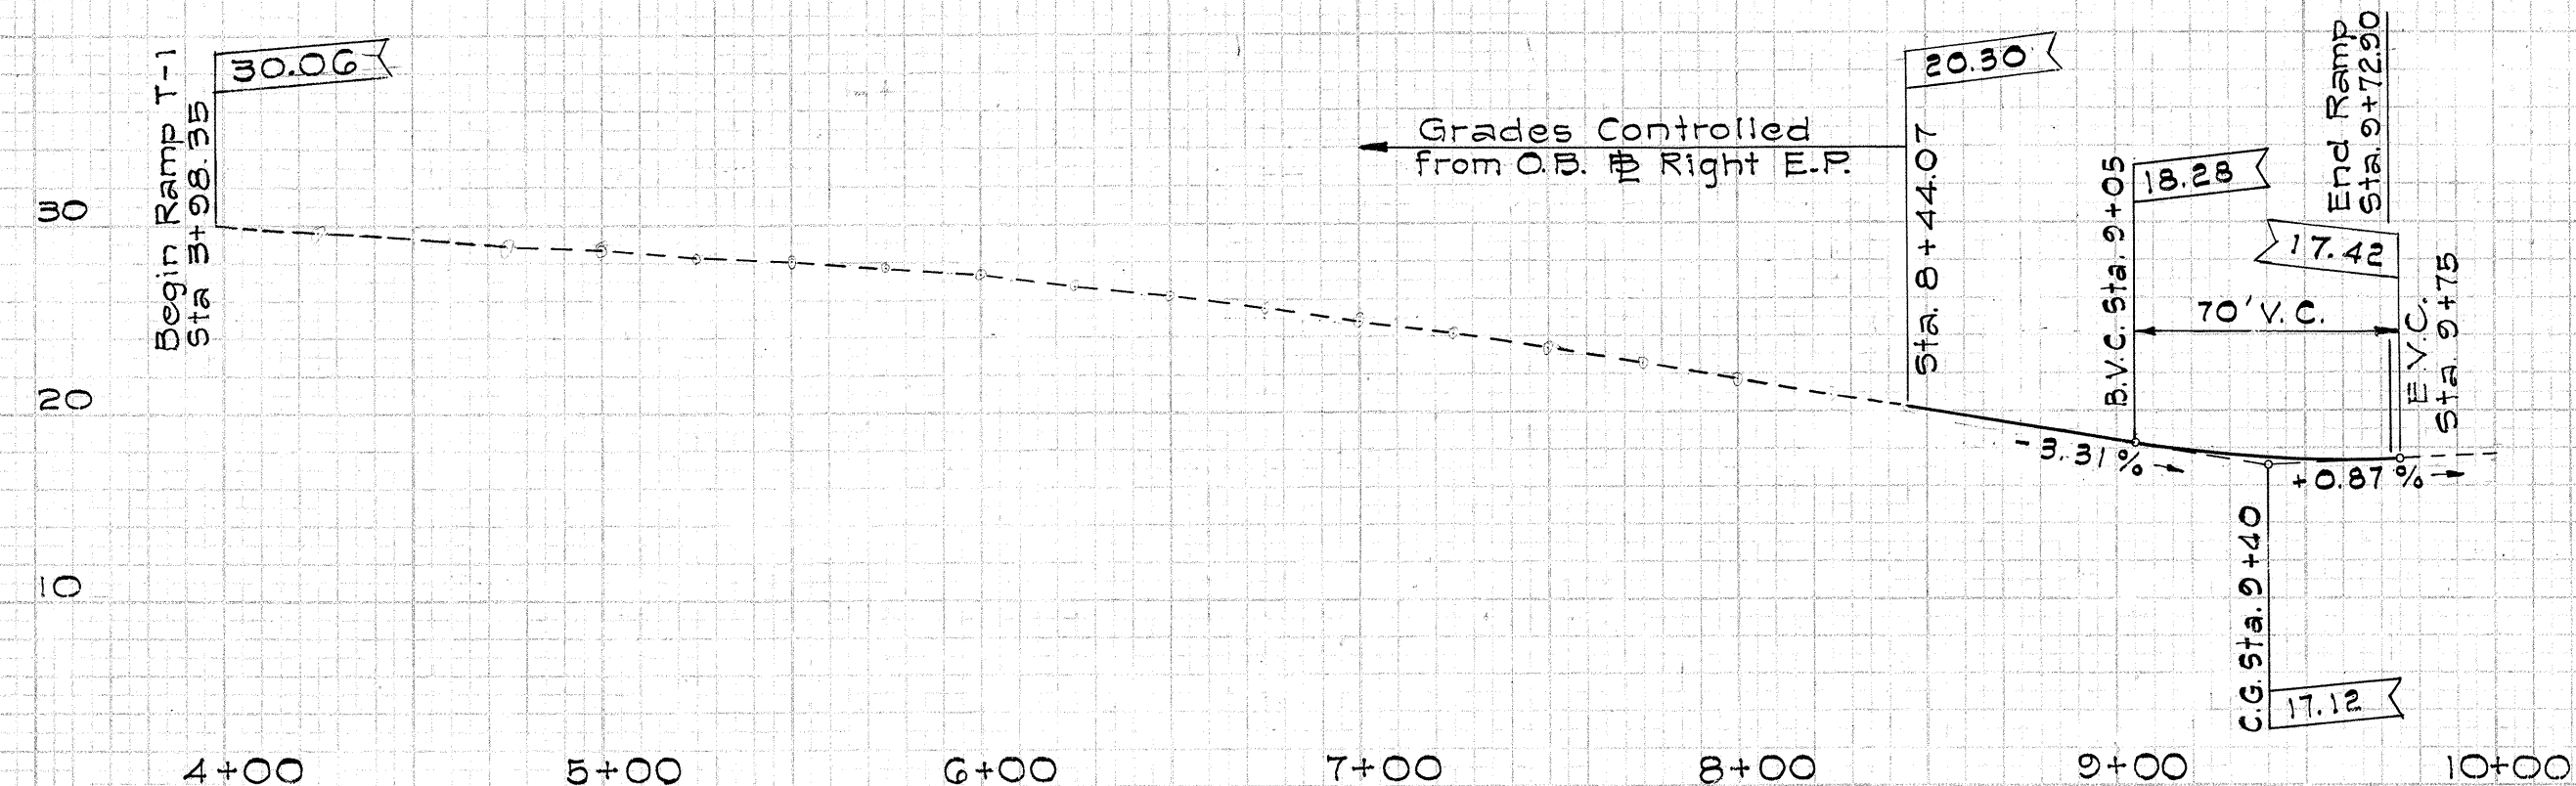

PROFILE RAMP T-1

STATE OF HAWAII
DEPARTMENT OF TRANSPORTATION
HIGHWAYS DIVISION

PROFILES FOR RAMPS
(T), (T-1), (WL-1) and (WL-0)



F.A.I. Project No. I-H1-1(B):24, Unit 2

Scale: Hor. 1" = 50'
Ver. 1" = 10' or As Noted Date: February, 1965

SHEET No. 1 OF 2 SHEETS

PROFILE RAMPS

FED. ROAD DIST. NO.	STATE	FED. AID PROJ. NO.	FISCAL YEAR	SHEET NO.	TOTAL SHEETS
HAWAII	HAW.	1-11-1(5) Unit 2	1965	15	276

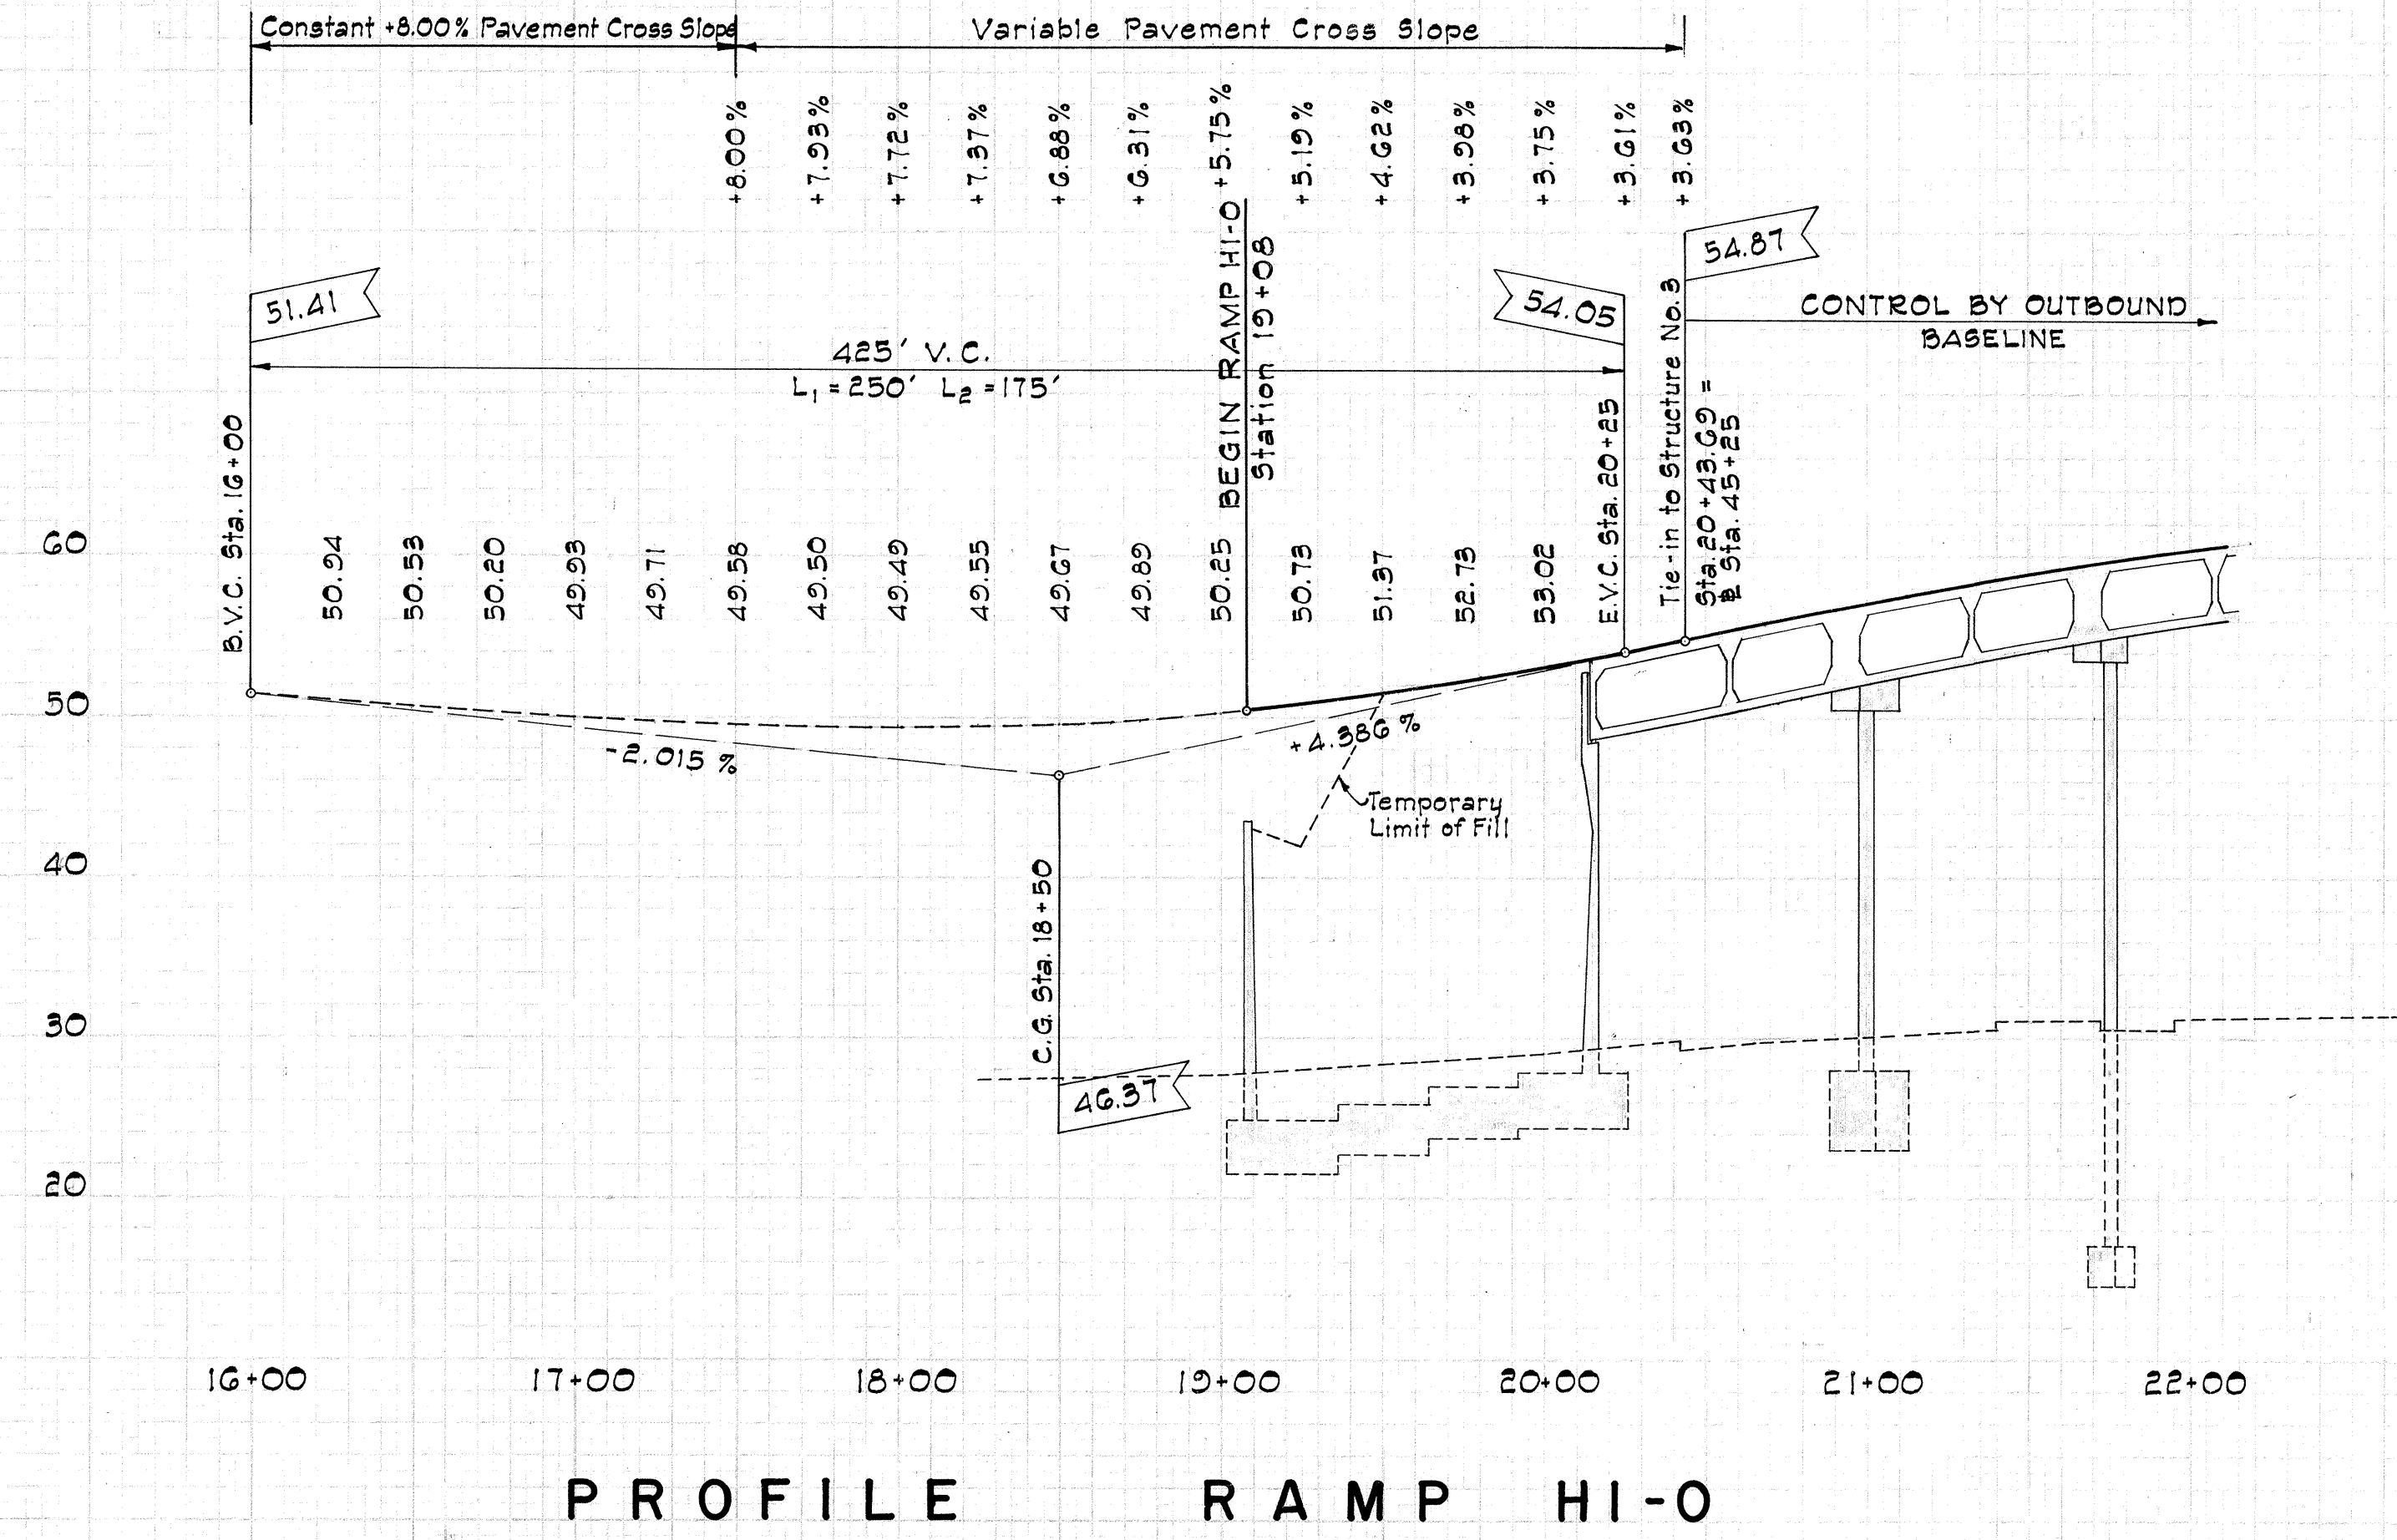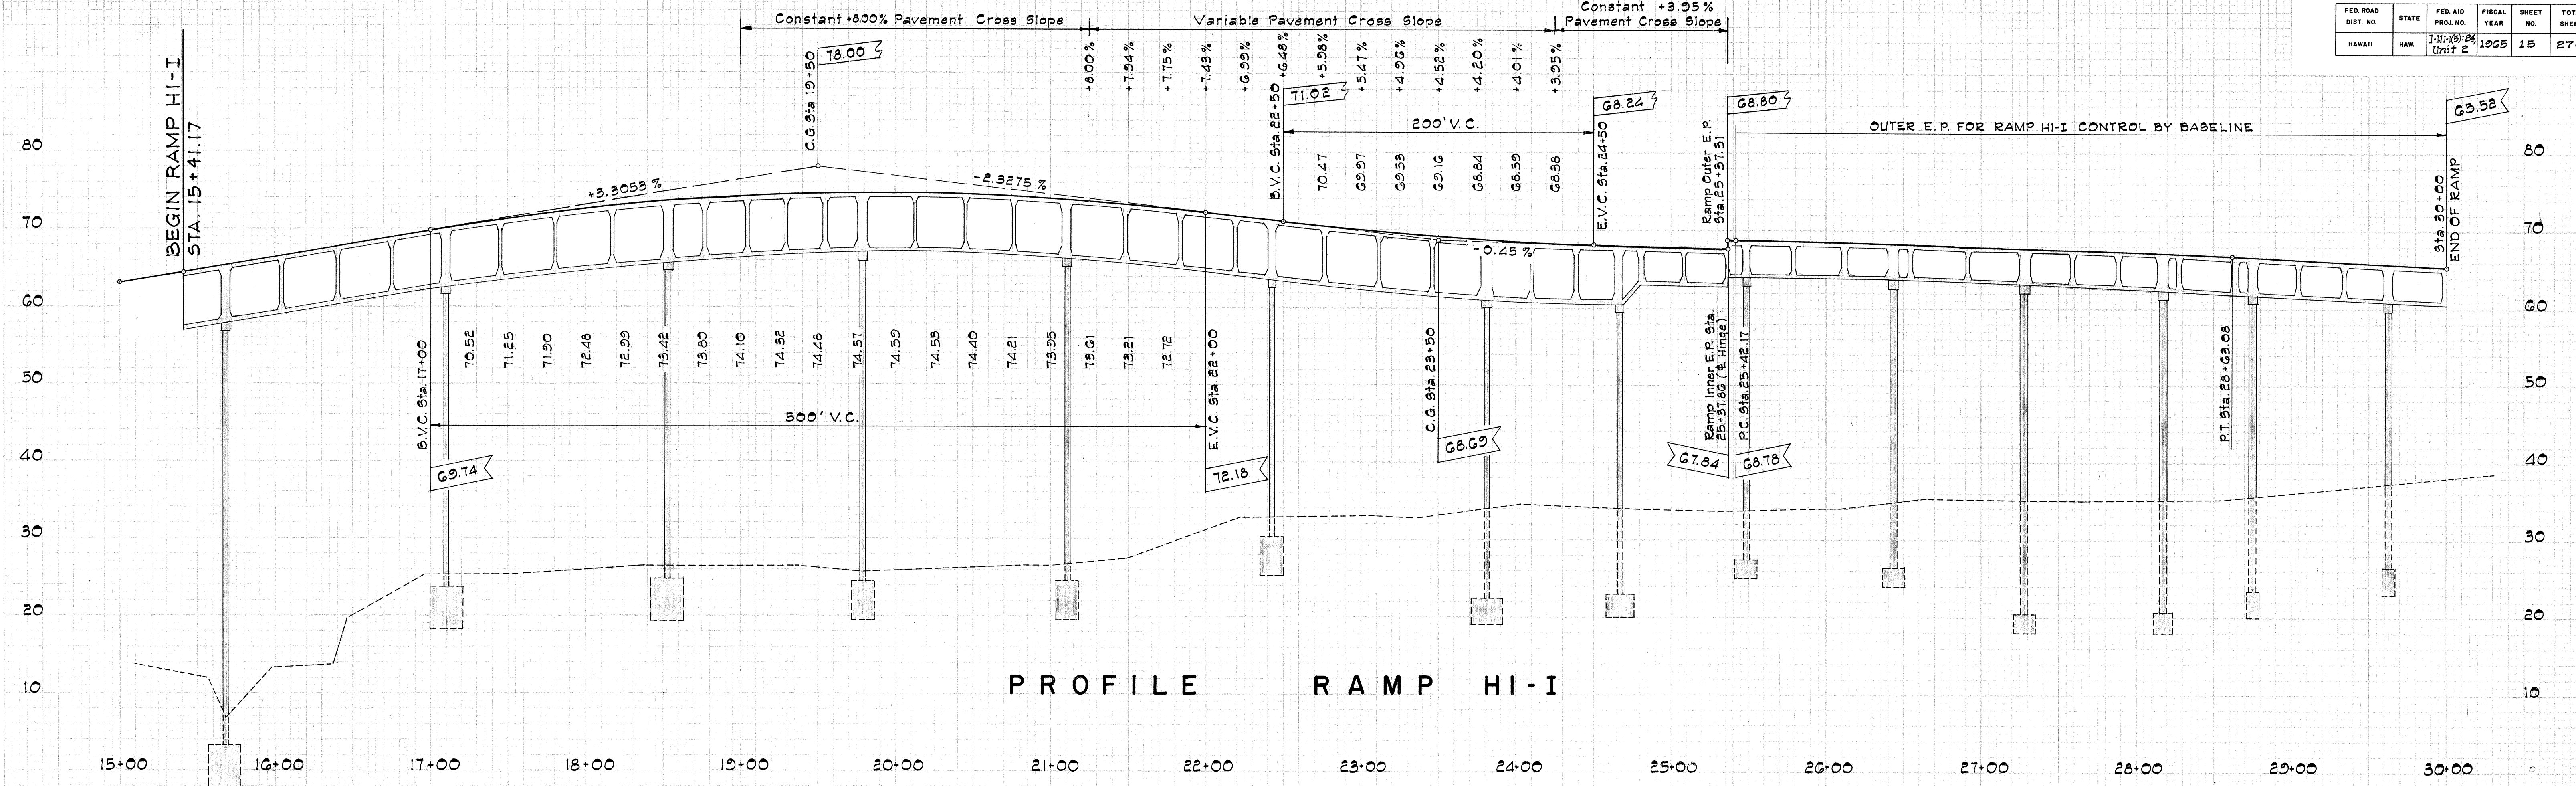

STATE OF HAWAII
DEPARTMENT OF TRANSPORTATION
HIGHWAYS DIVISION

**PROFILES
FOR
RAMPS (HI-I) and (HI-O)**

F.A.I. Project No. I-HI-1(5): 24, Unit 2

Scale: Hor. 1" = 50'
Ver. 1" = 10'

Date: February, 1965

SHEET No. 2 OF 2 SHEETS

Revised: Jan. 9, 1967

