


FED. ROAD DIST. NO.	STATE	FED. AID PROJ. NO.	FISCAL YEAR	SHEET NO.	TOTAL SHEETS
HAWAII	HAW.	HES-0300(21)	1983	3	25

CONDUITS	LF	CABLES	LF
1-2"	370	1-TYPE 3	390



State Maintenance Installed

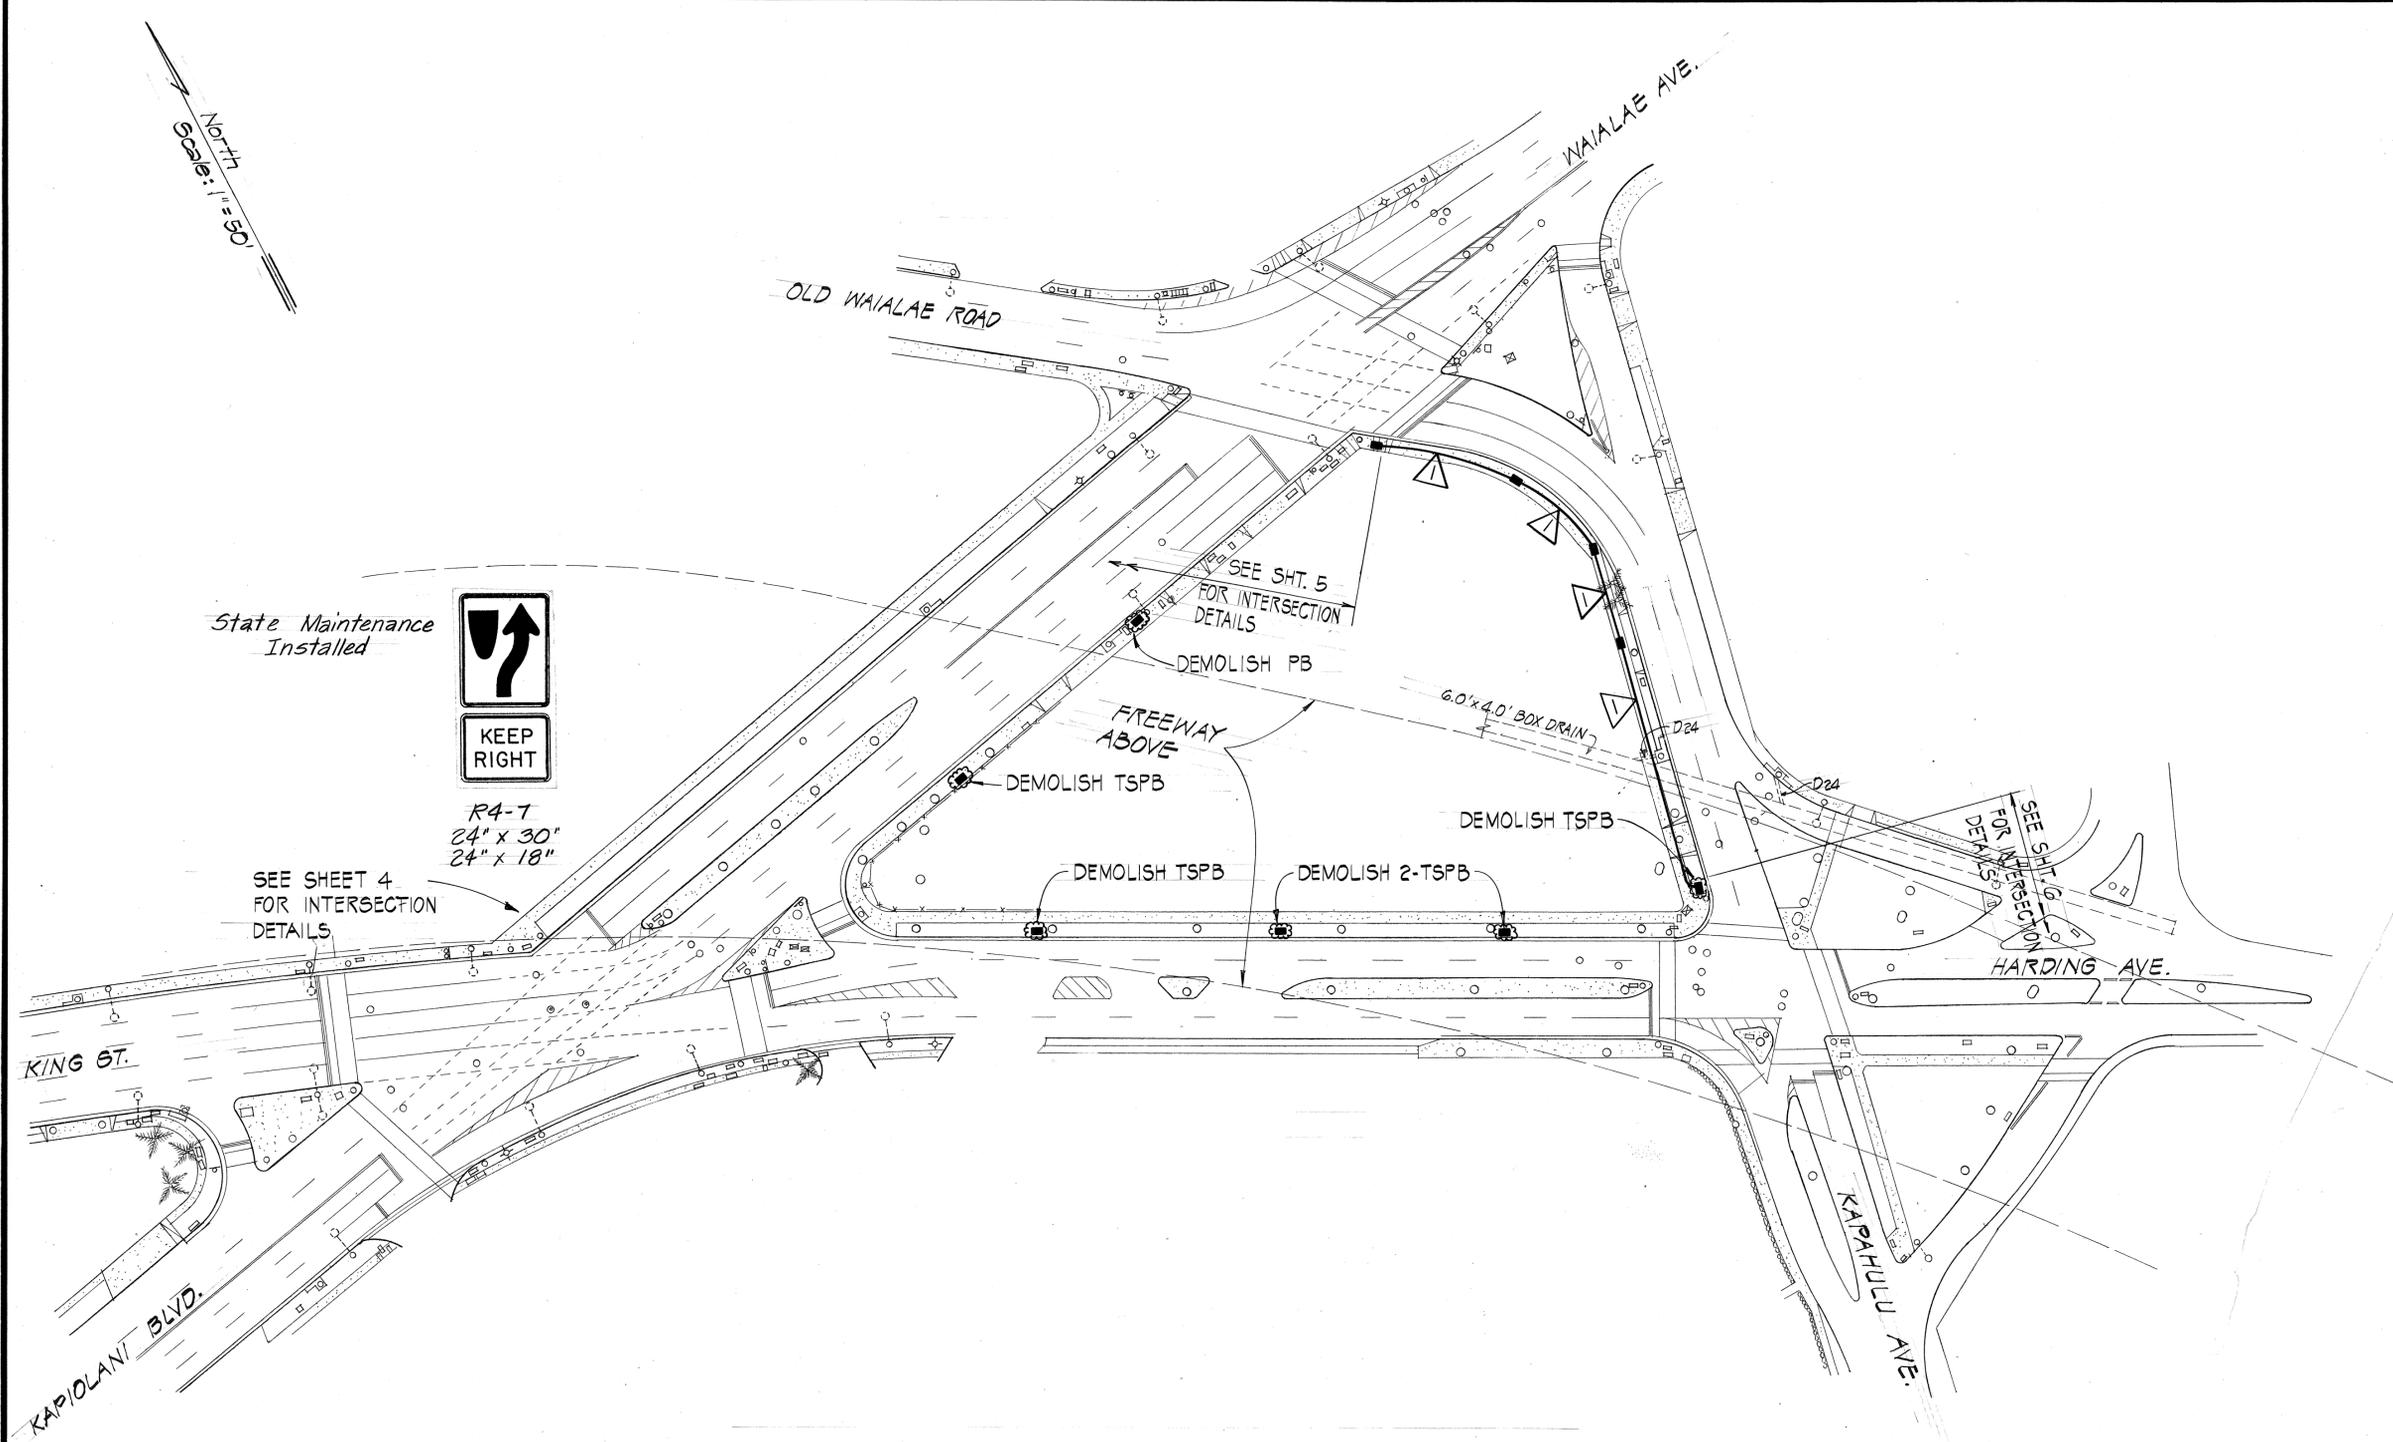

KEEP RIGHT

R4-7
24" x 30"
24" x 18"

SEE SHEET 4 FOR INTERSECTION DETAILS

GENERAL PLAN AND INTERCONNECT SYSTEM
SCALE: 1" = 50'

SURVEY PLOTTED BY	DATE
DRAWN BY	
DESIGNED BY	
QUANTITIES BY	
CHECKED BY	
ORIGINAL PLAN	
NOTE BOOK	
No.	



THIS WORK WAS PREPARED BY ME OR UNDER MY SUPERVISION

Paul T. Taniguchi

STATE OF HAWAII
DEPARTMENT OF TRANSPORTATION
HIGHWAYS DIVISION

GENERAL PLAN AND INTERCONNECT SYSTEM

MODERNIZATION OF TRAFFIC SIGNAL SYSTEMS
KING-KAPIOLANI-HARDING-KAPAEHULU-WAIALAE-OLD WAIALAE
PROJECT NO. HES-0300(21)

SCALE: AS SHOWN DATE: _____

SHEET NO. | OF | SHEETS