



| INDEX TO DRAWINGS |  |
|-------------------|--|
| SHEET NO.         | DESCRIPTION                              |
| 1                 | TITLE SHEET                              |
| 2                 | GENERAL NOTES AND LEGEND                 |
| 3                 | GENERAL PLAN AND INTERCONNECT SYSTEM     |
| 4-6               | TRAFFIC SIGNAL SYSTEM INTERSECTION PLANS |
| * 7               | PAVEMENT MARKING & STRIPING              |
| 8-10              | TRAFFIC CONTROL                          |
| 11-12             | WHEELCHAIR RAMP DETAILS                  |
| 13-25             | STANDARD DETAILS                         |
|                   |  |
| * 6S-1            | PAVEMENT MARKING & STRIPING              |
|                   |  |
|                   |  |
NEW TOTAL: 26 SHEETS

PAUL T. TANIGUCHI, LTD.  
DESIGNED BY  
FRED ABESHIMA  
P. S. & E. BY  
548-4042  
PHONE  
FEBRUARY, 1983  
DATE

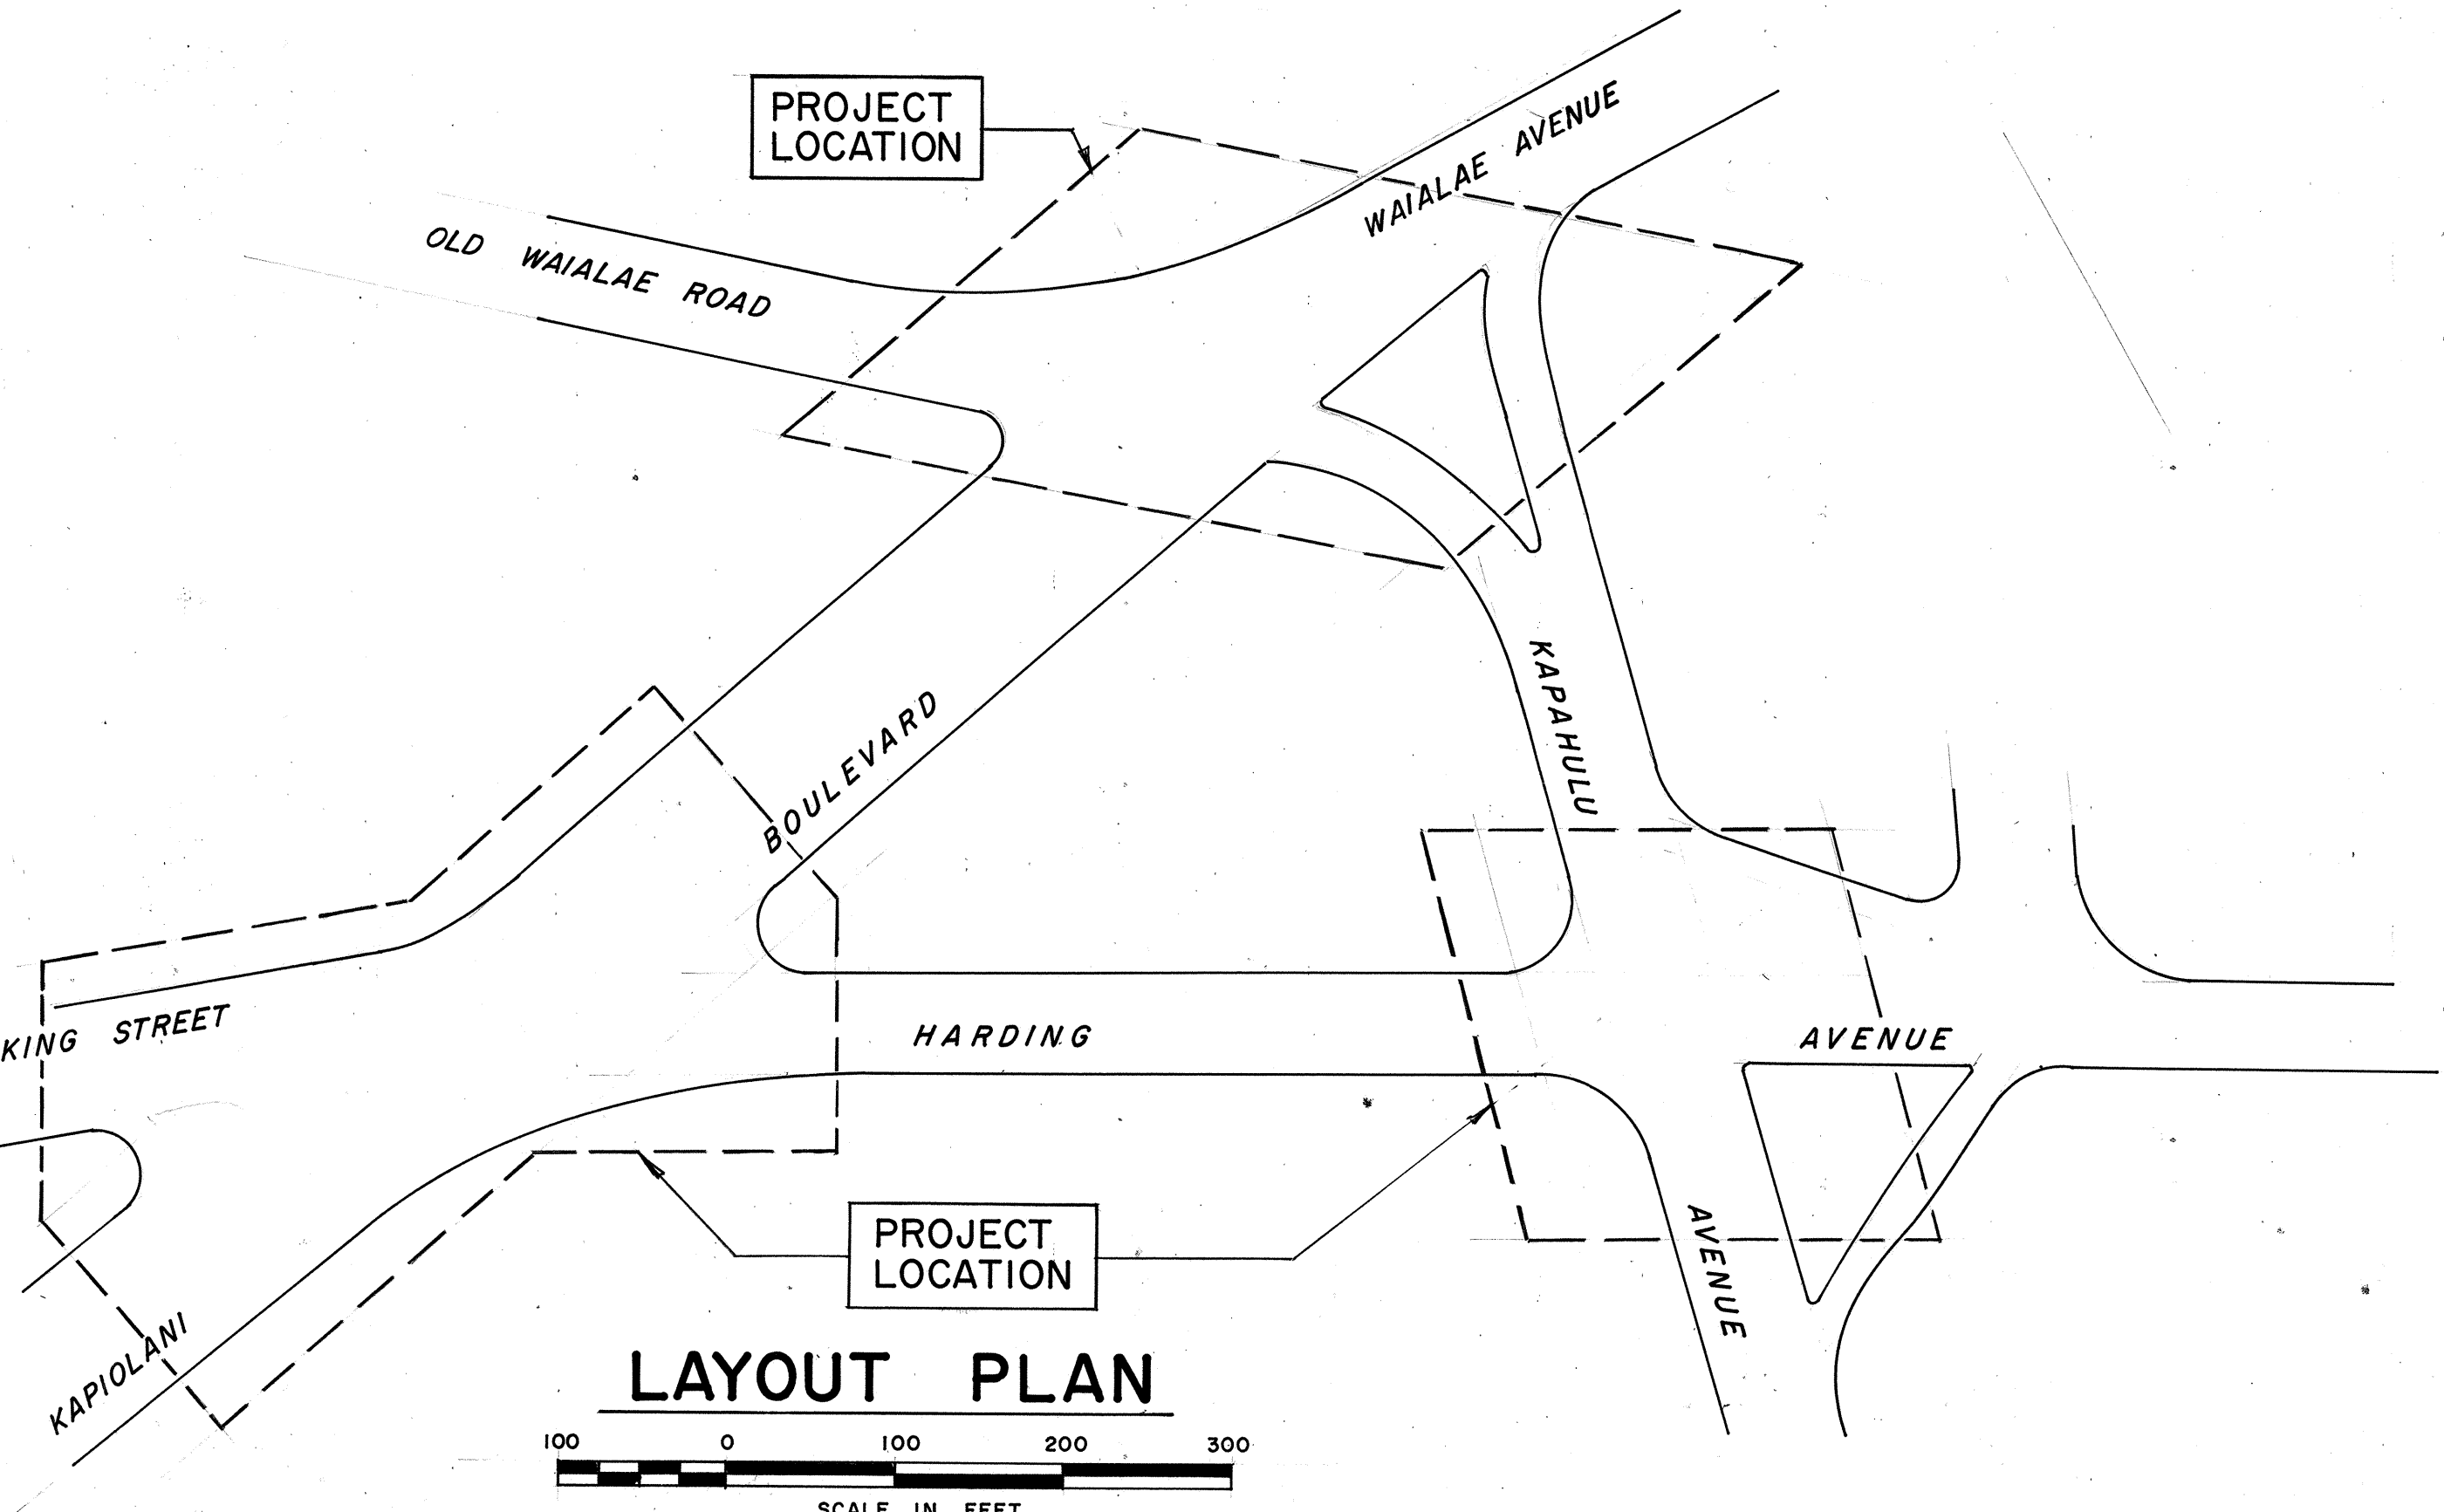

LAYOUT PLAN



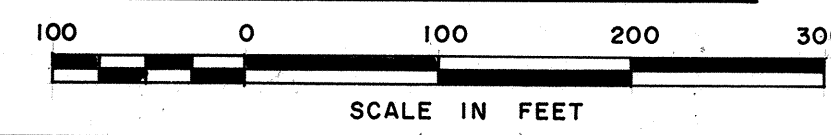


STATE OF HAWAII  
DEPARTMENT OF TRANSPORTATION  
HIGHWAYS DIVISION  
HONOLULU, HAWAII  
"AS BUILT"  
PLANS OF

MODERNIZATION OF TRAFFIC SIGNAL SYSTEMS  
KING-KAPIOLANI-HARDING-KAPAHULU-WAIALAE-OLD WAIALAE  
FEDERAL AID PROJECT NO. HES-0300(21)

DISTRICT OF HONOLULU  
ISLAND OF OAHU

| FED. ROAD DIST. NO. | STATE | FED. AID PROJ. NO. | FISCAL YEAR | SHEET NO. | TOTAL SHEETS |
|---------------------|-------|--------------------|-------------|-----------|--------------|
| HAWAII              | HAW.  | HES-0300(21)       | 1983        | 1         | 25           |

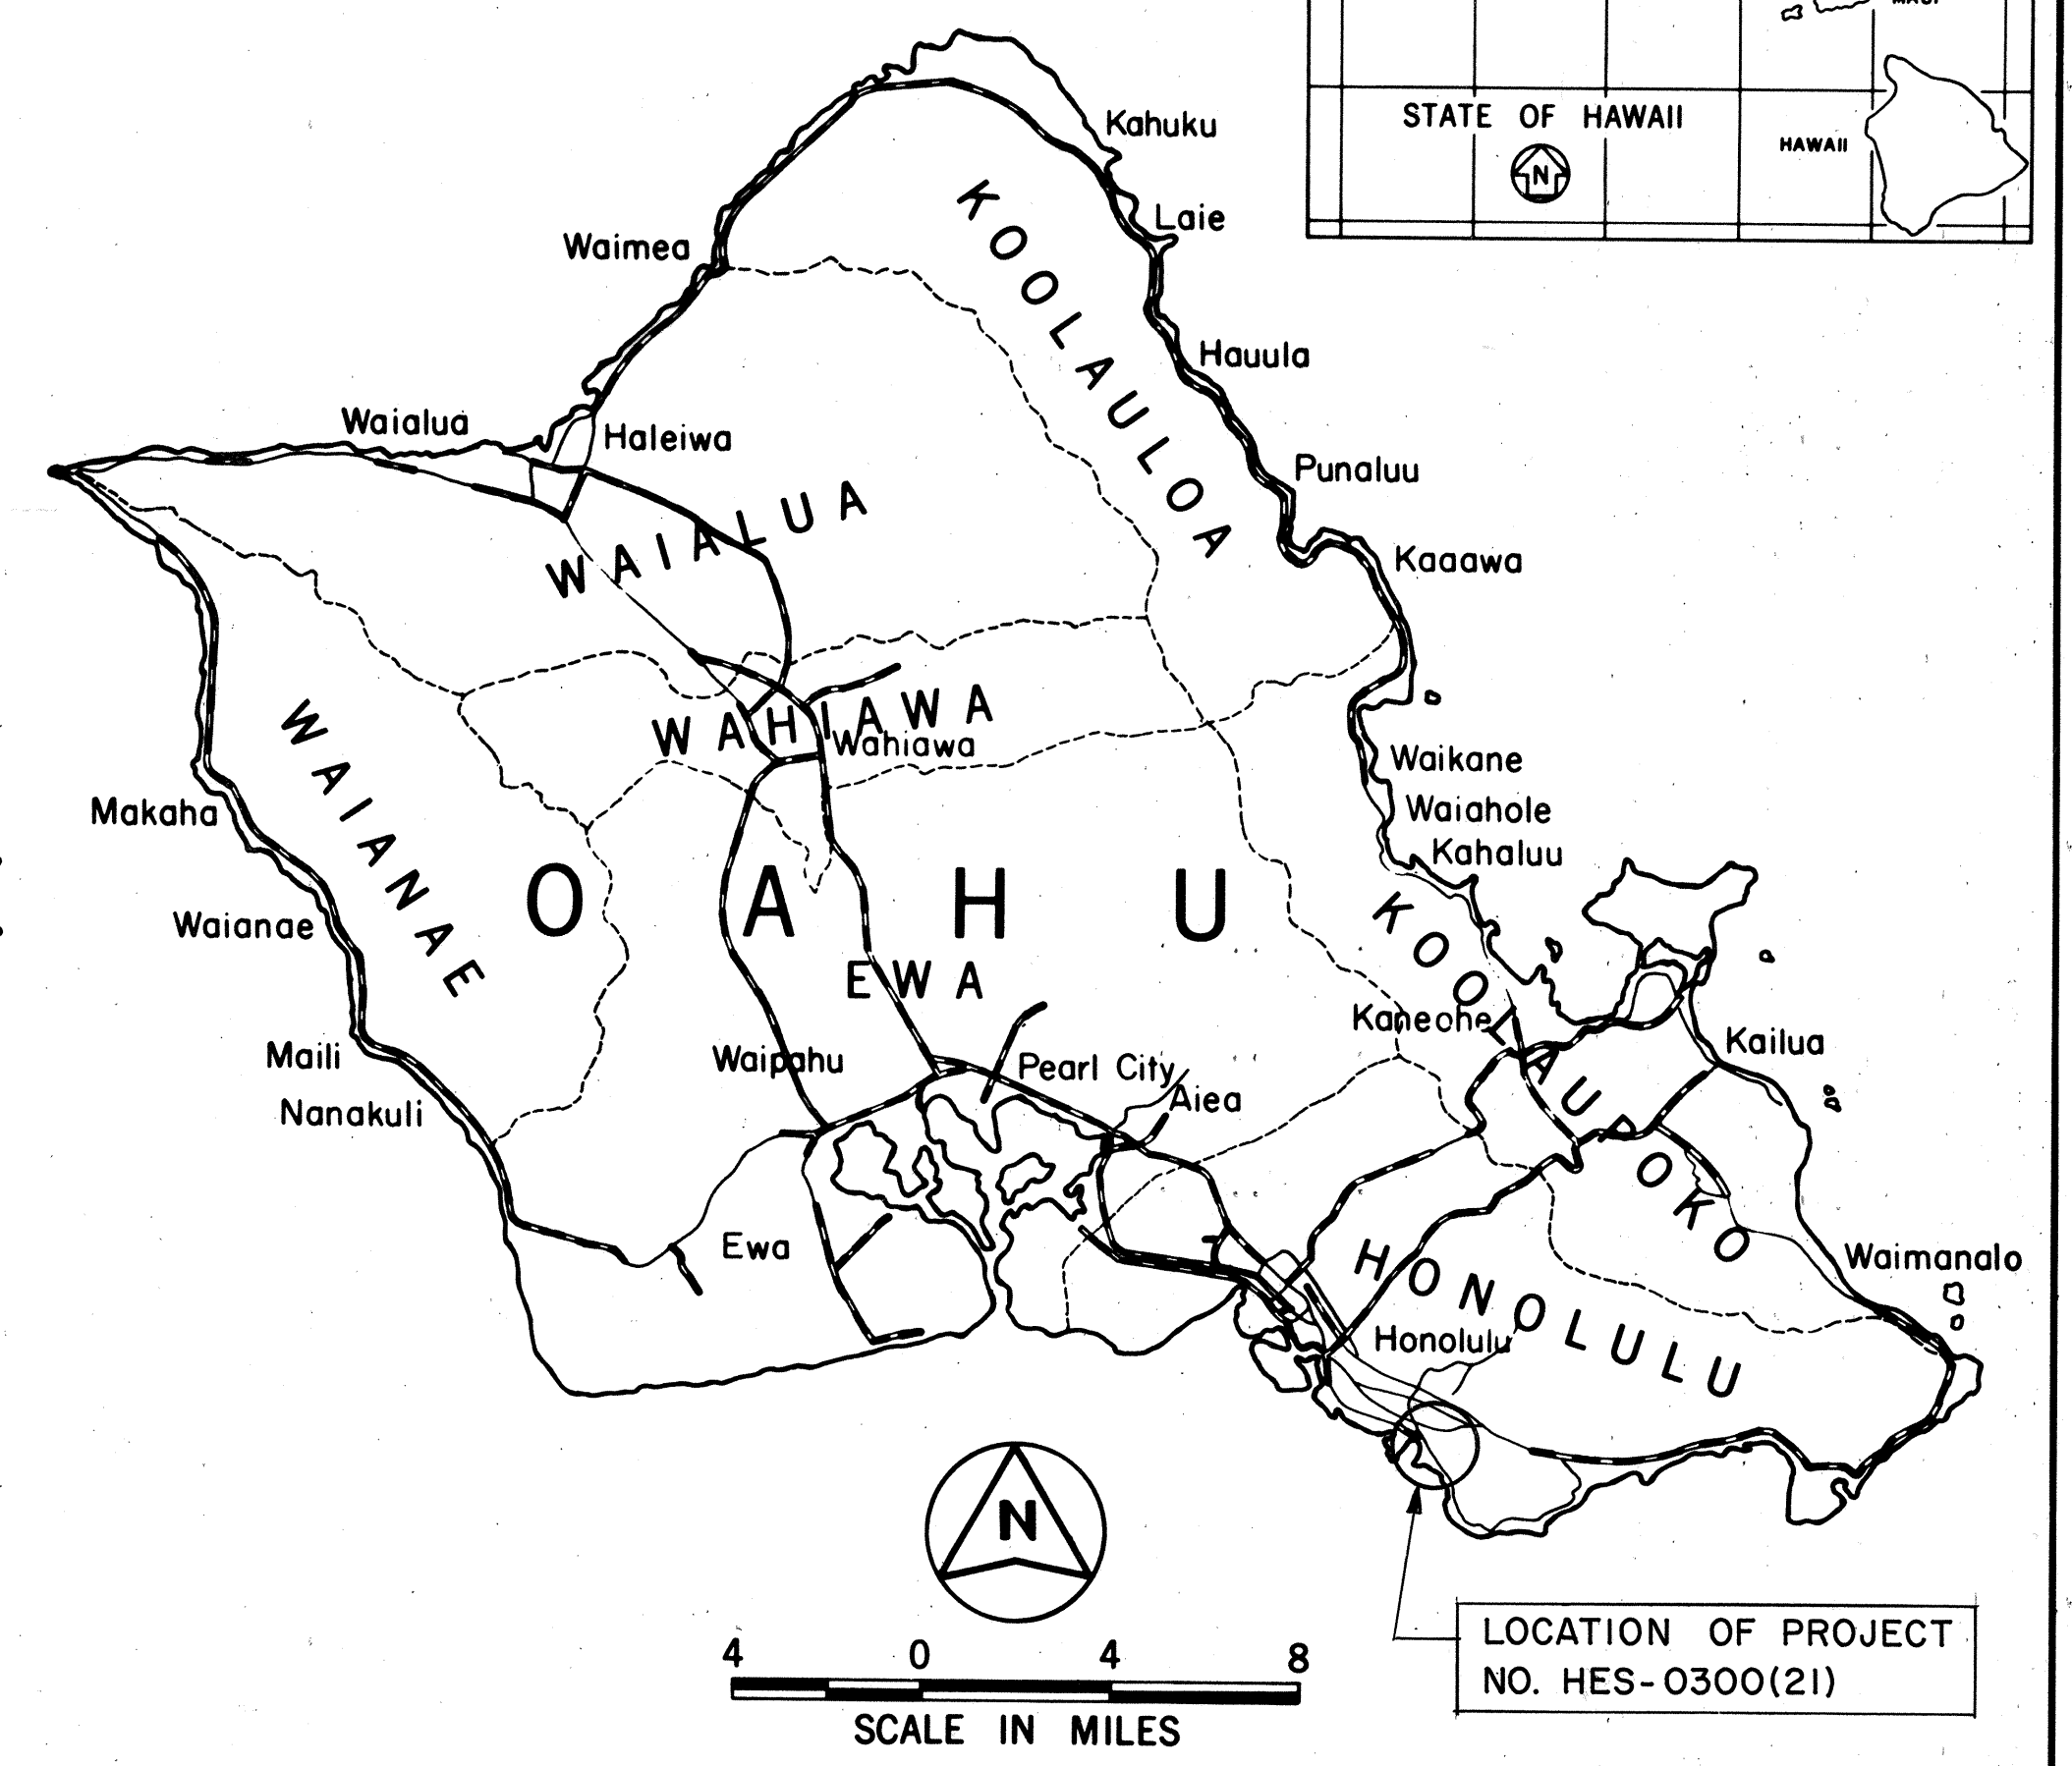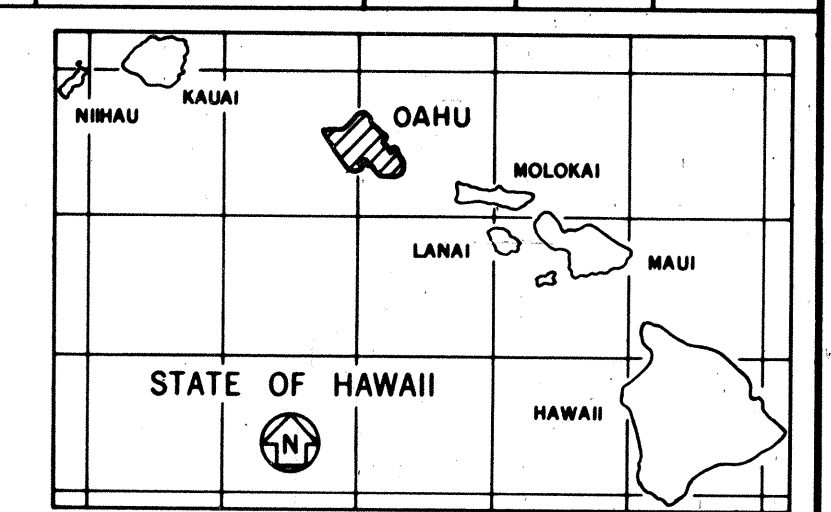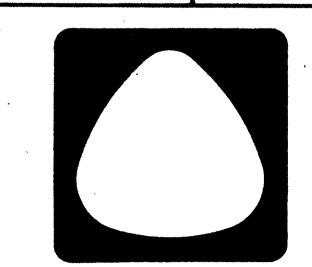

FEDERAL AID PROJECTS PREVIOUSLY CONSTRUCTED OR UNDER CONSTRUCTION

CHANGES MADE DURING CONSTRUCTION HAVE BEEN INCORPORATED ON THESE PLANS EXCEPT CHANGES IN THE ORIGINAL THEORETICAL QUANTITIES. FOR ACTUAL QUANTITIES, REFER TO PROJECT LEDGER AND/OR COMPUTATION BOOK.

Warren Miyashiro  
RESIDENT ENGINEER  
9-18-84  
DATE

DEPARTMENT OF TRANSPORTATION  
FEDERAL HIGHWAY ADMINISTRATION  
APPROVED:  
[Signature]  
DIVISION ADMINISTRATOR  
5/1/83  
DATE

DEPARTMENT OF TRANSPORTATION  
STATE OF HAWAII  
APPROVED:  
R. H. Gashima  
DIR. OF TRANSPORTATION  
4/27/83  
DATE