



FED. ROAD DIST. NO.	STATE	PROJ. NO.	FISCAL YEAR	SHEET NO.	TOTAL SHEETS
HAWAII	HAW.	HWY-0-03-88	1988	5	12

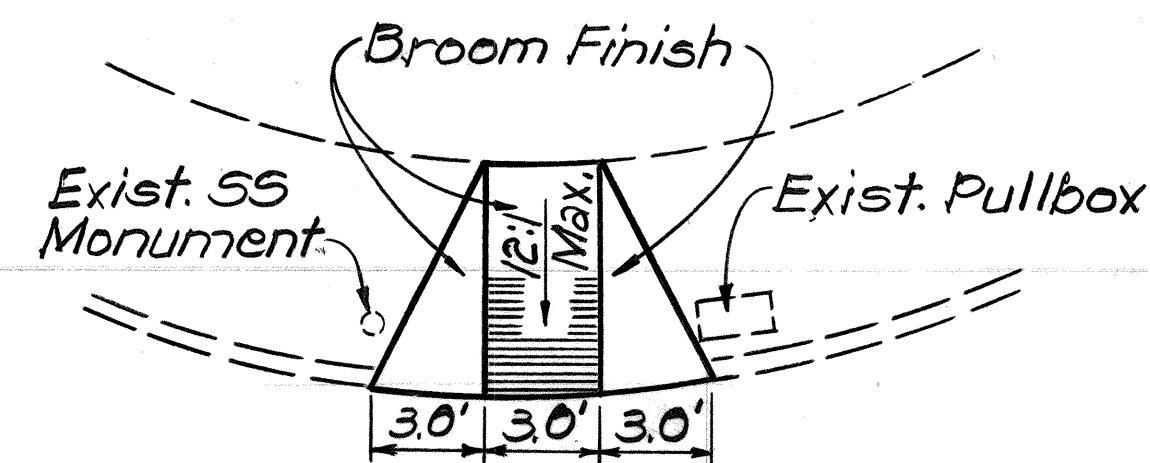

NOTE: Maintain approximately 3" to 4" Clear between wheelchair ramp and existing SS Monument and pullbox.


**WHEELCHAIR RAMP DETAIL
TYPE "A" MODIFIED
(LUNALILO ST. AT KEWALO ST.)**

Scale: 1" = 5'-0"

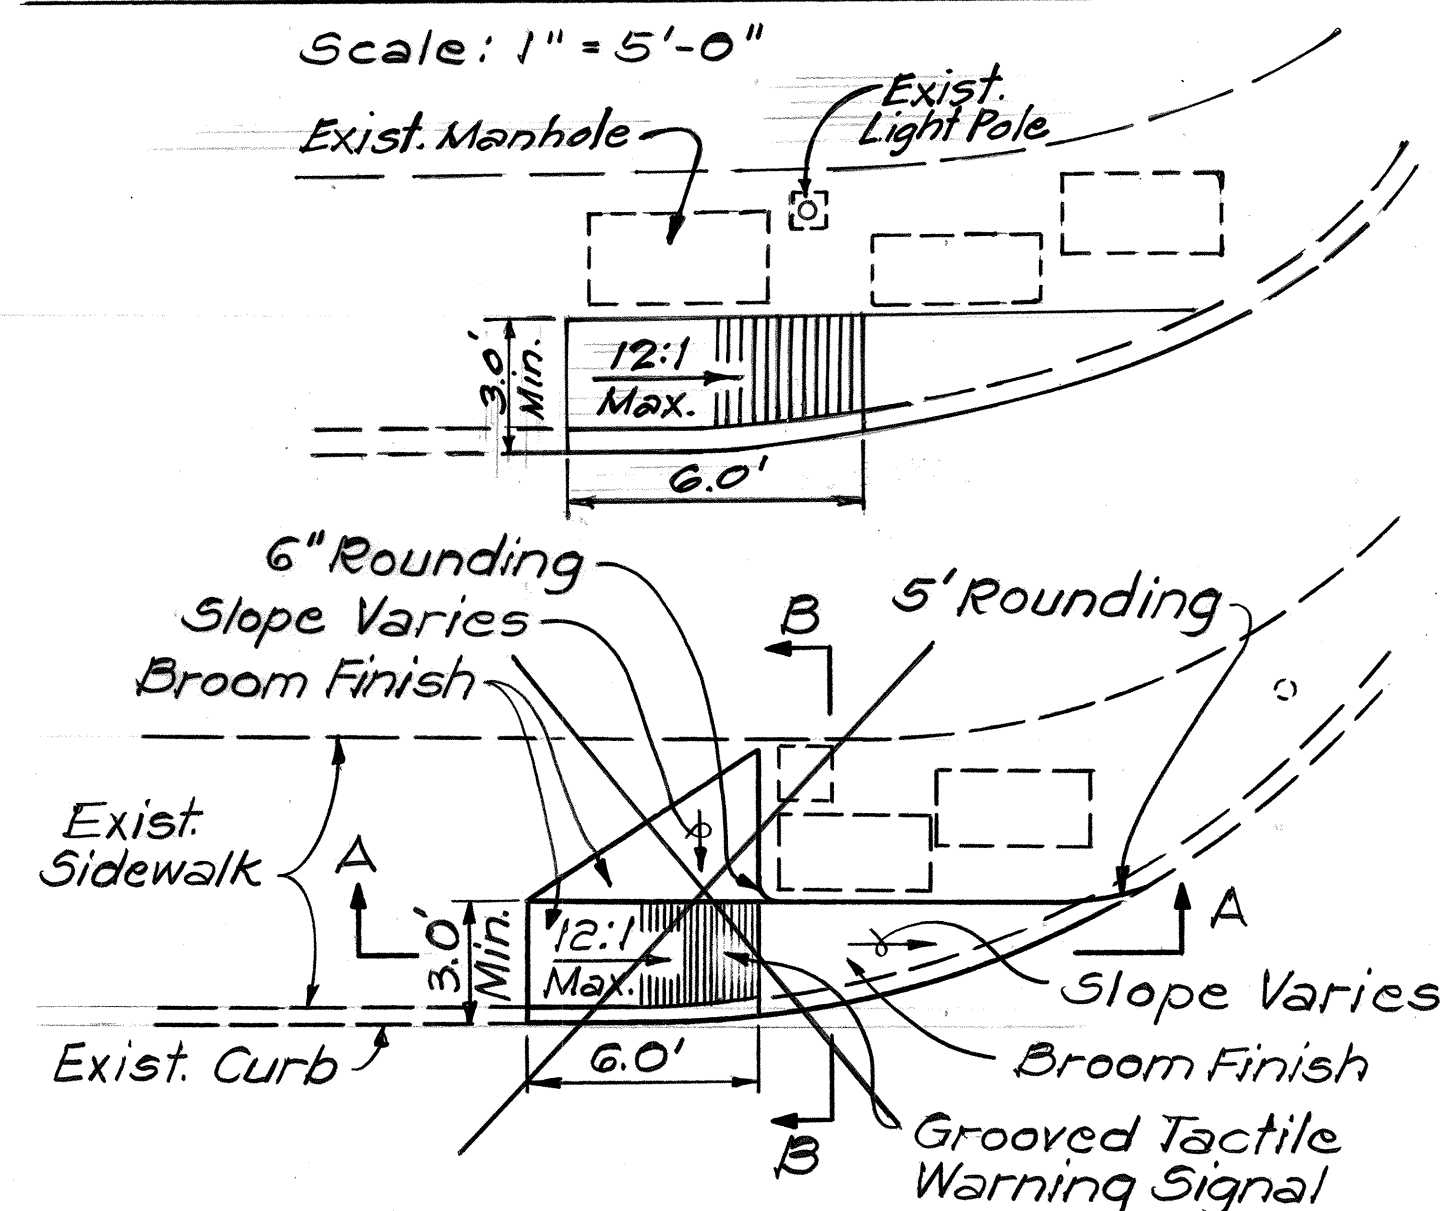

PLAN - PALI HIGHWAY


Scale: 1" = 5'-0"

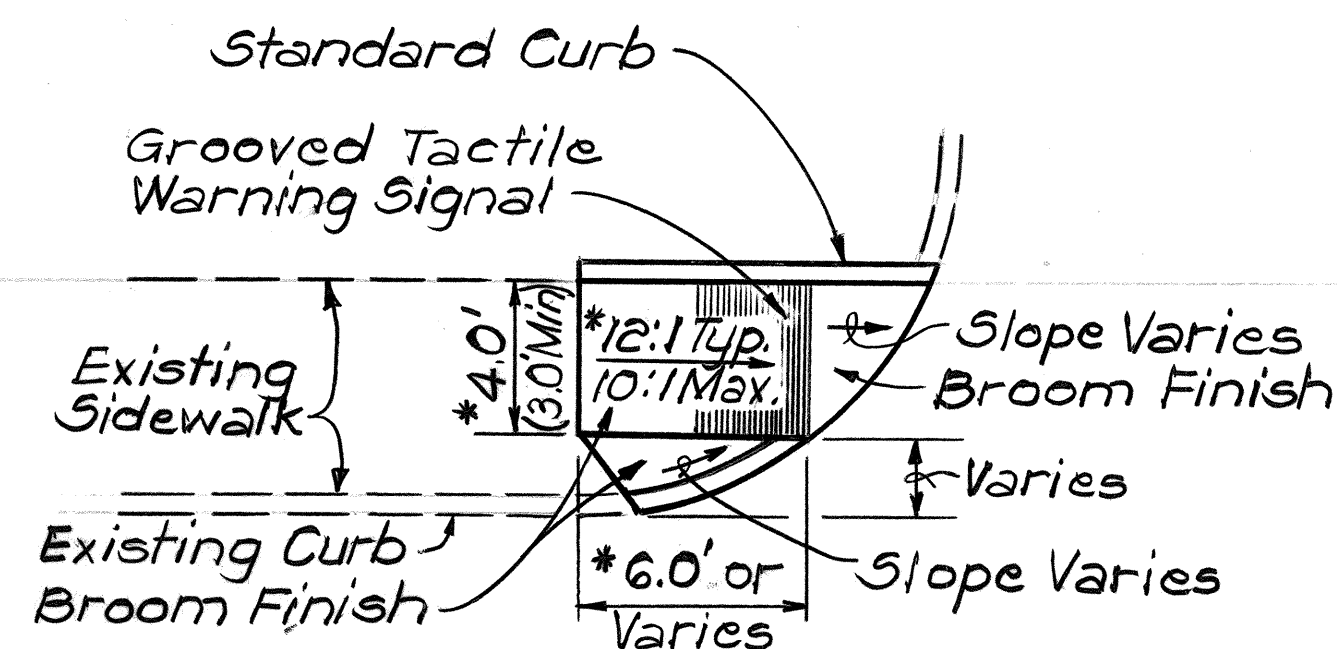

*NOTE: Wheelchair Ramps shall be constructed 4' wide with a 12:1 slope, where practical. The Engineer may permit variation, to a minimum 3' wide ramp with a maximum slope of 10:1 for Special Conditions.


**WHEELCHAIR RAMP - TYPICAL DETAIL
TYPE "E" MODIFIED**

Scale: 1" = 5'-0"

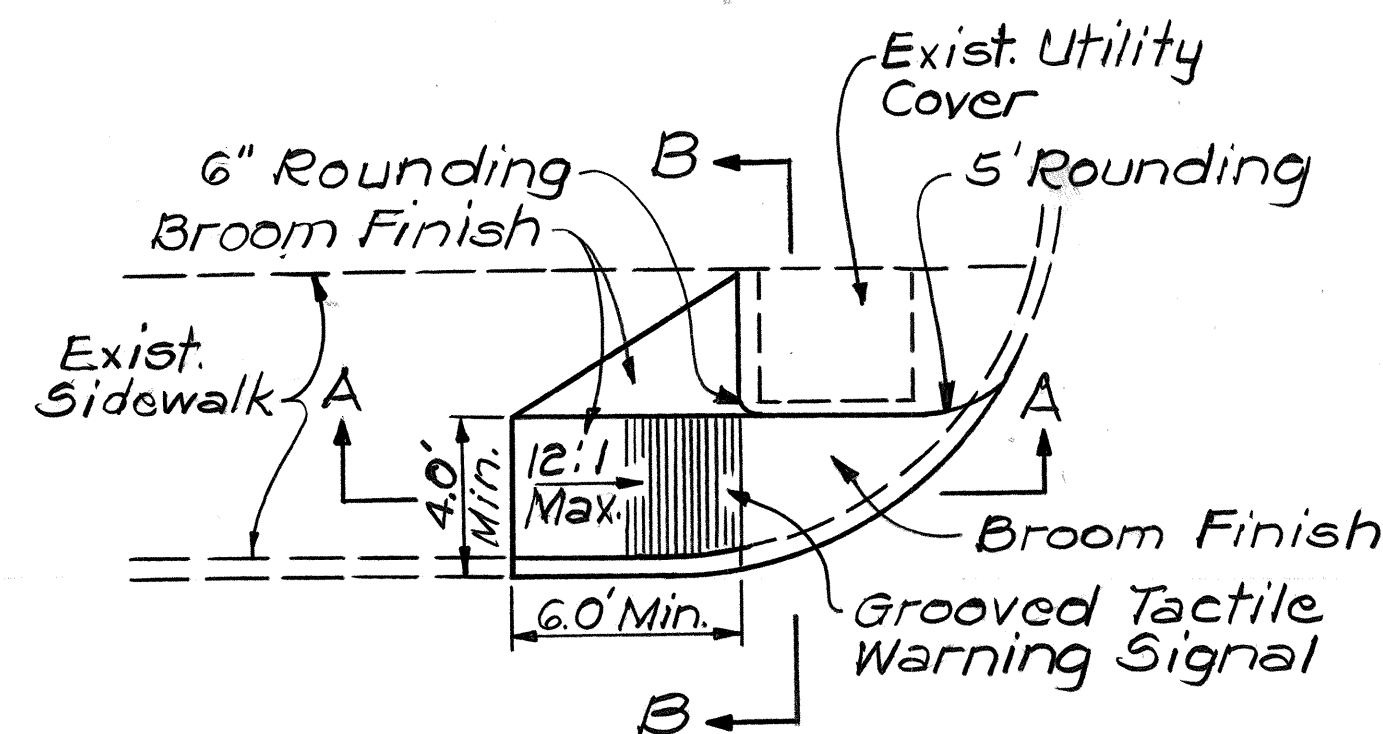


PLAN - UNIVERSITY AVENUE

Scale: 1" = 5'-0"

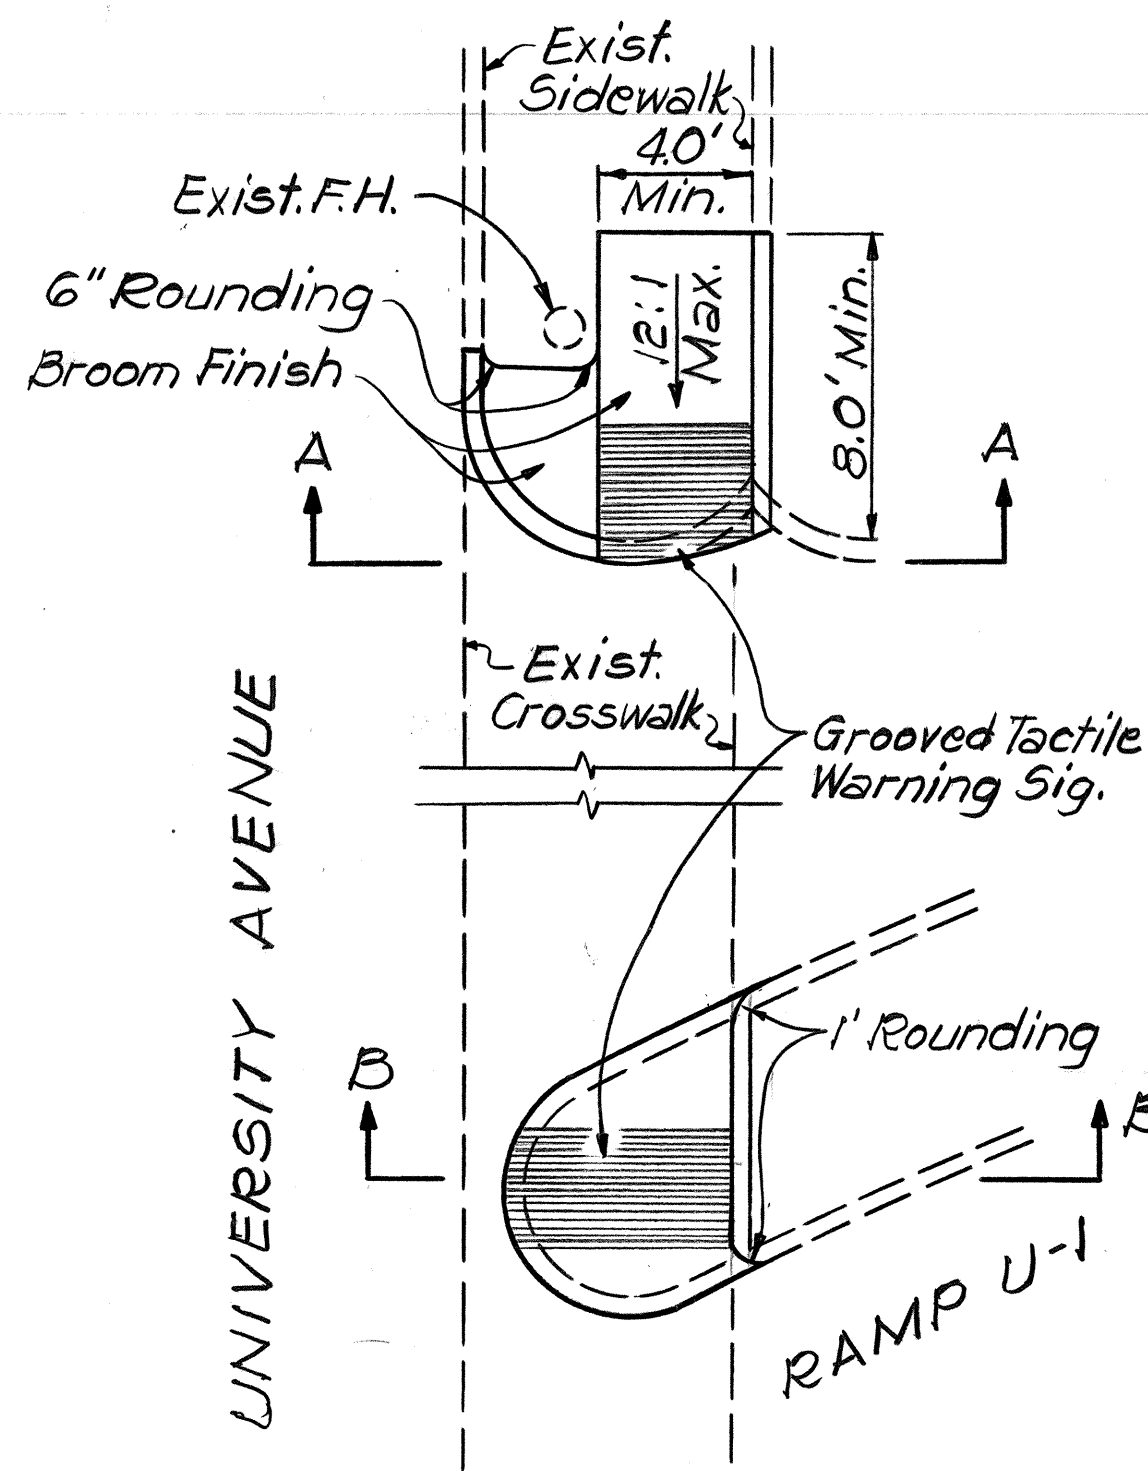


PLAN

Scale: 1" = 5'-0"

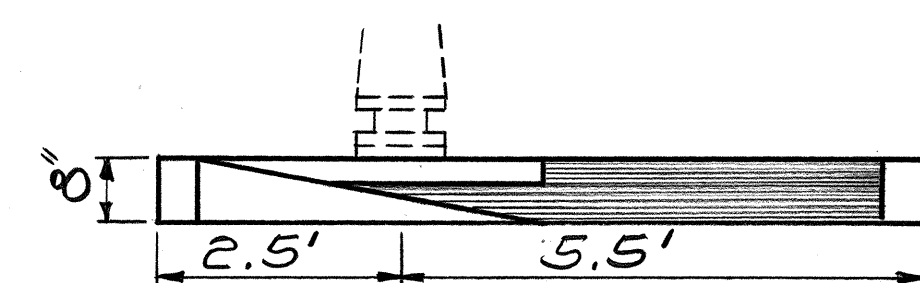

SECTION A-A


Scale: 1" = 2'-0"

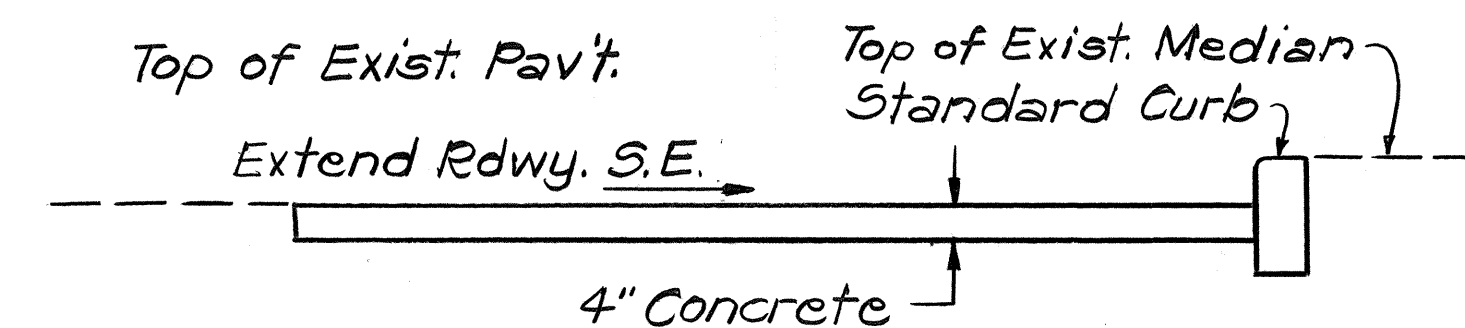

SECTION B-B


Scale: 1/2" = 1'-0"

**WHEELCHAIR RAMPS DETAIL
TYPE "C" MODIFIED & TYPE "G"**

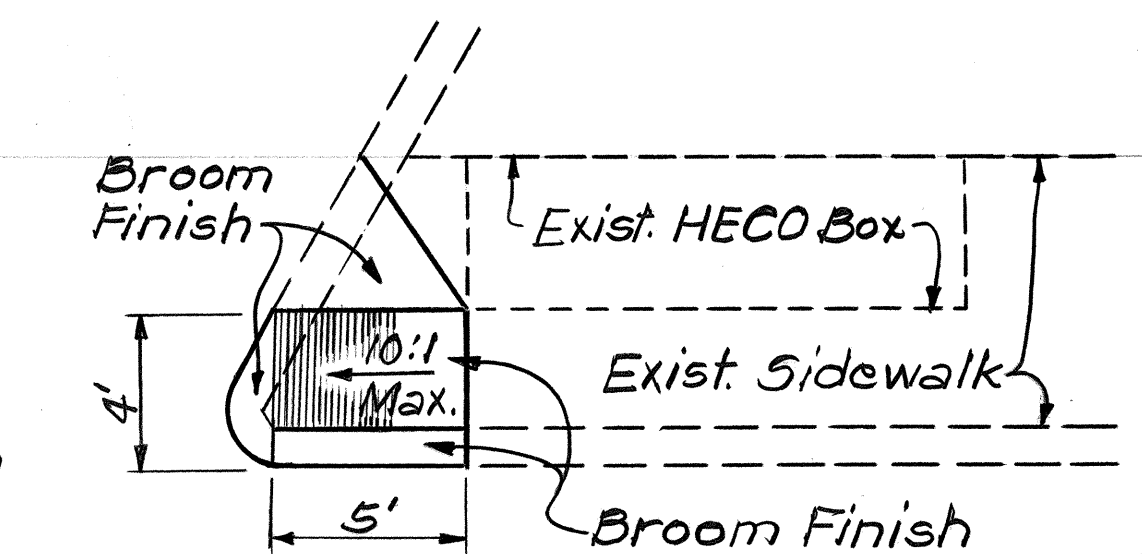


**WHEELCHAIR RAMP DETAIL
TYPE "J"**

Scale: 1" = 5'-0"

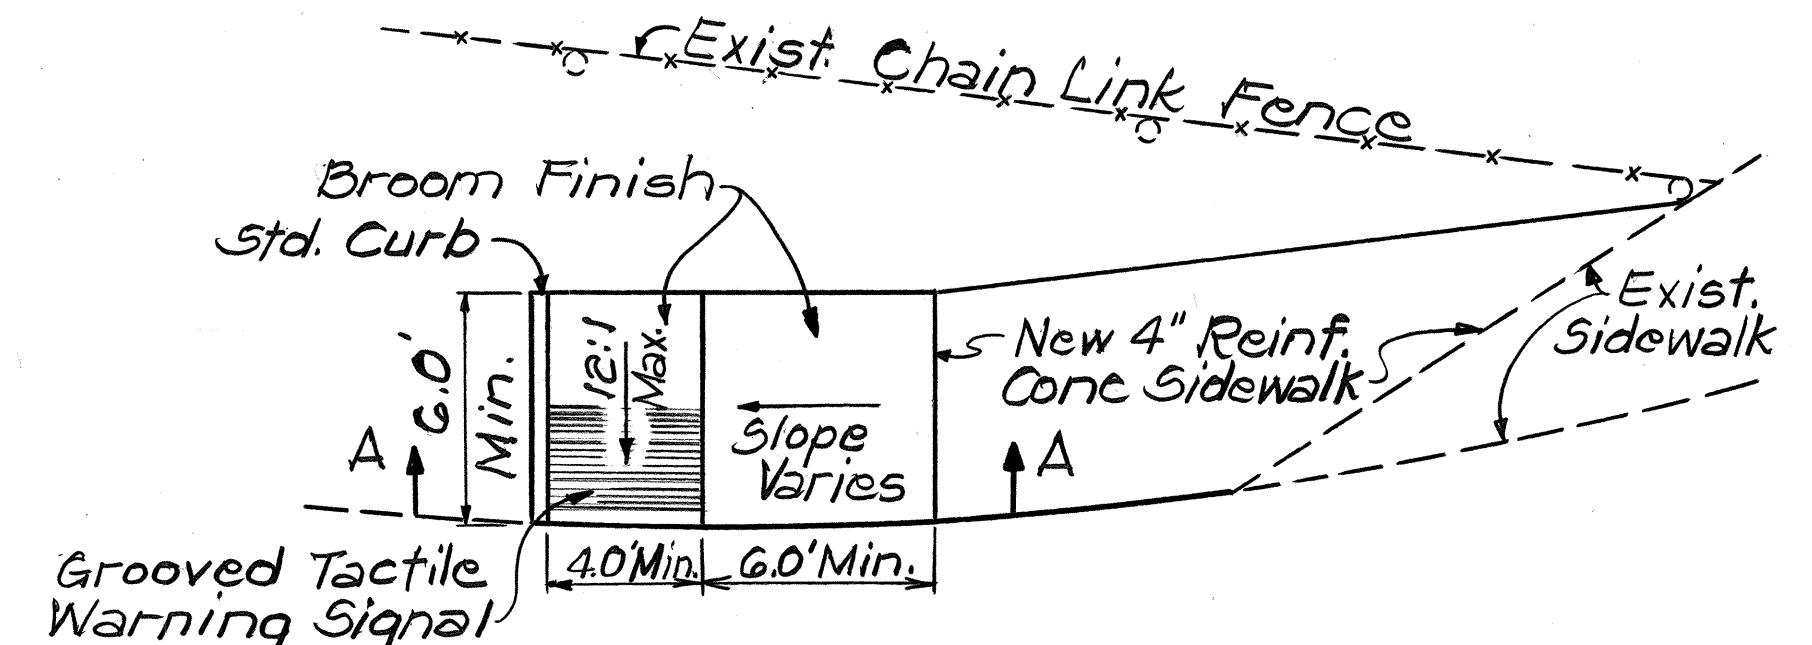

PLAN

Scale: 1" = 5'-0"

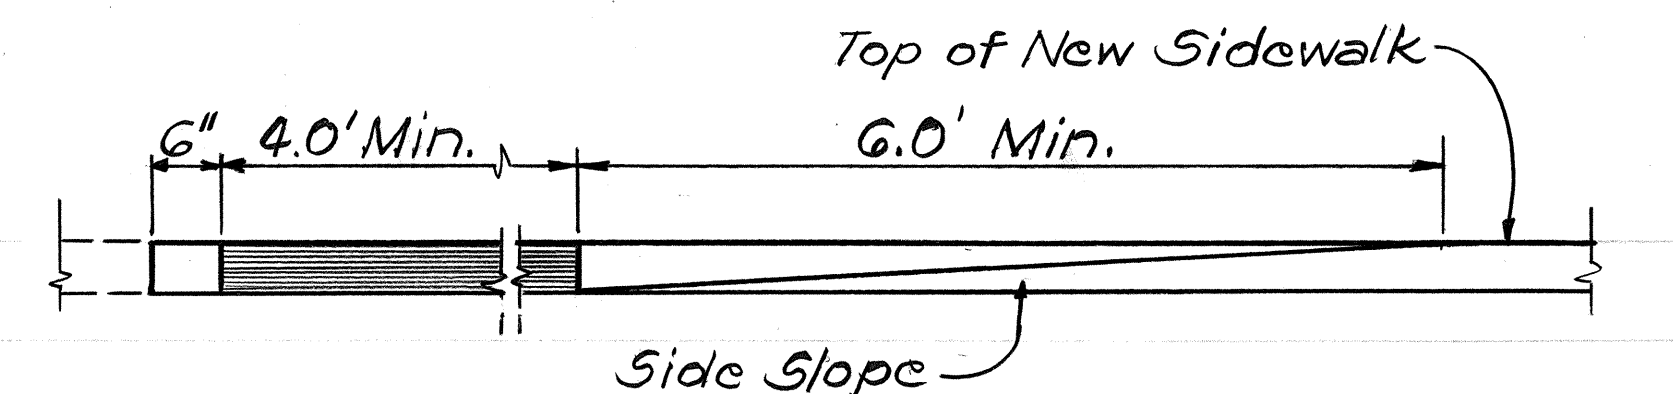

**ELEVATION
SECTION A-A**

Scale: 3/4" = 1'-0"

**WHEELCHAIR RAMP DETAIL
TYPE "K"**

SECTION A-A

Scale: 1/2" = 1'-0"

**WHEELCHAIR RAMP DETAIL
TYPE "F"**

SECTION B-B

Scale: 1" = 1'-0"

STATE OF HAWAII
DEPARTMENT OF TRANSPORTATION
HIGHWAYS DIVISION
DETAILS
WHEELCHAIR RAMPS
AT VARIOUS LOCATIONS ON OAHU
Project No. HWY-0-03-88
Scale: As Noted Date: May, 1988
SHEET No. 1 OF 1 SHEETS