



FED. ROAD DIST. NO.	STATE	FED. AID PROJ. NO.	FISCAL YEAR	SHEET NO.	TOTAL SHEETS
HAWAII	HAW.	STP-0300(30)	1994	4	18

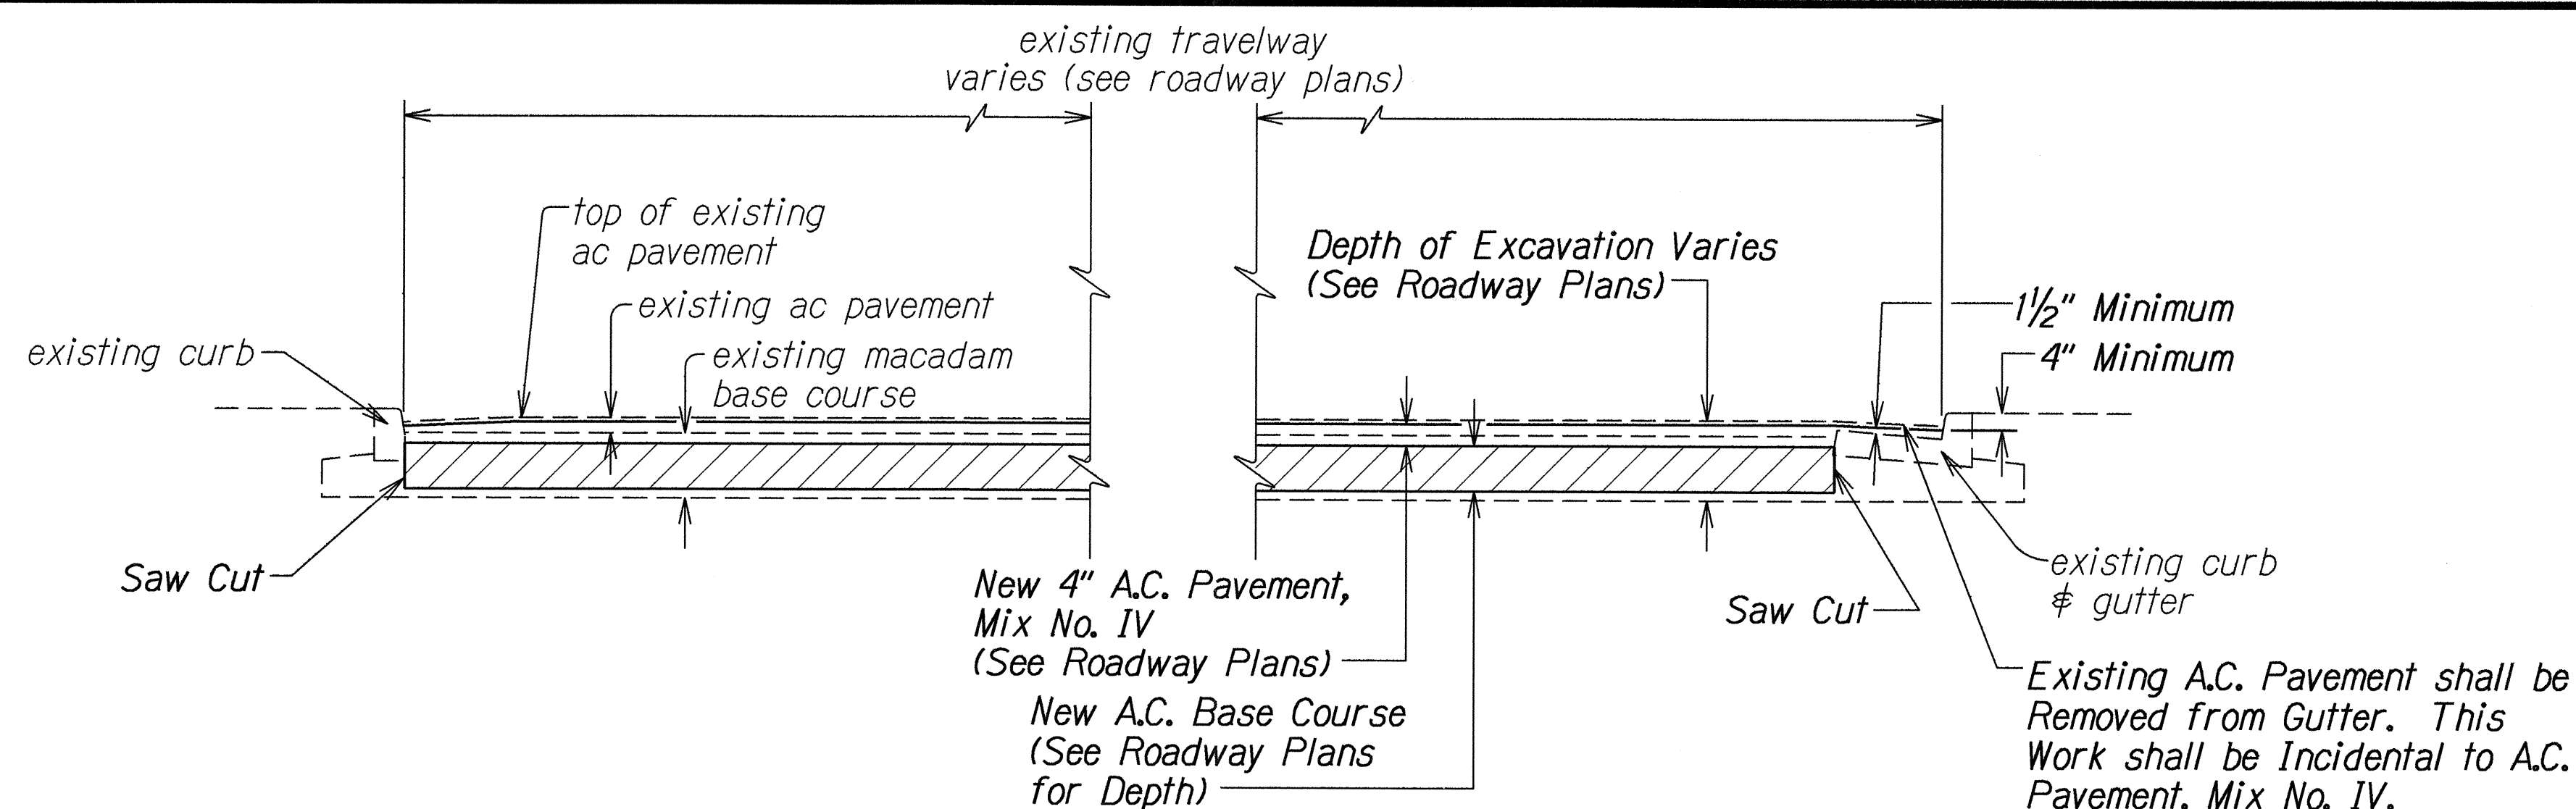


TYPICAL SECTION
RECONSTRUCTION OF WEAKENED
PAVEMENT AREAS 13 1/2" AND 9"

Not to Scale

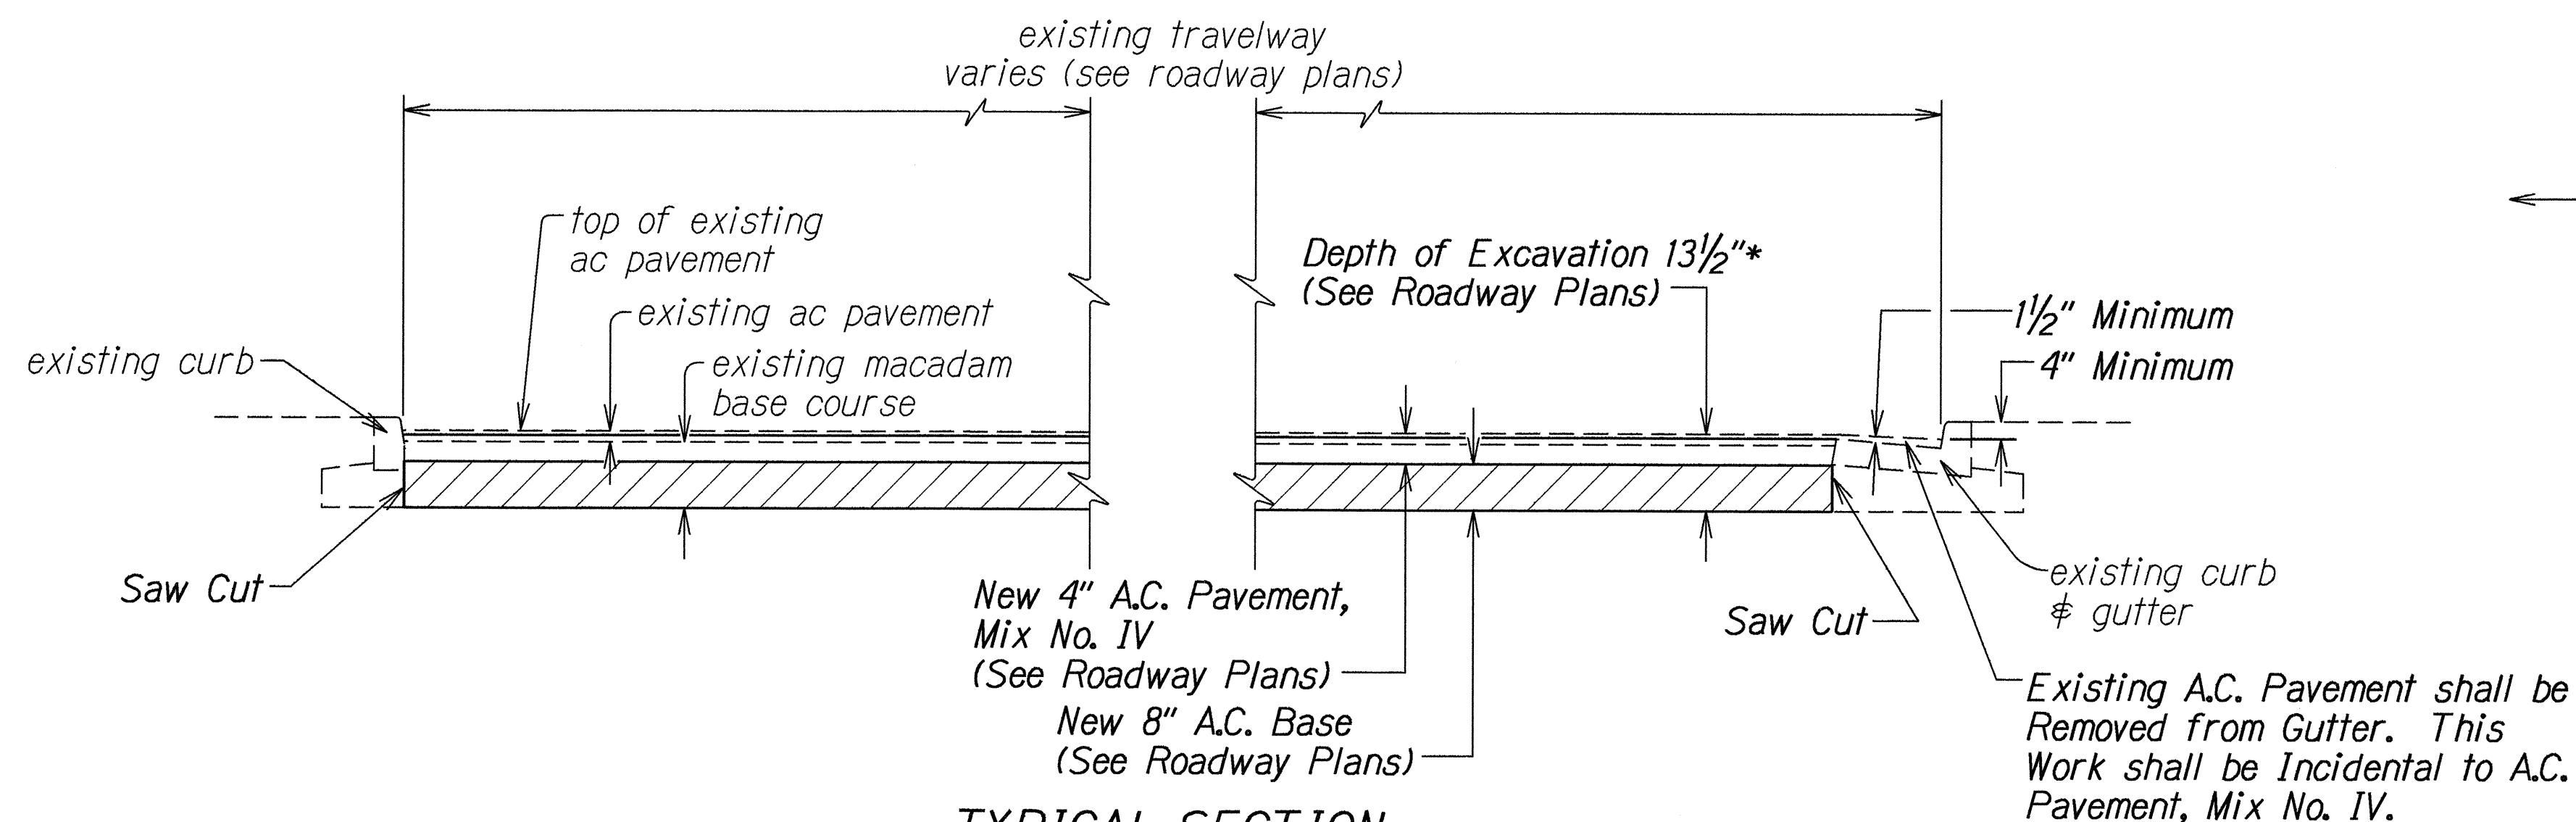


TYPICAL SECTION
RECONSTRUCTION OF WEAKENED
PAVEMENT AREAS, 13 1/2"

Not to Scale

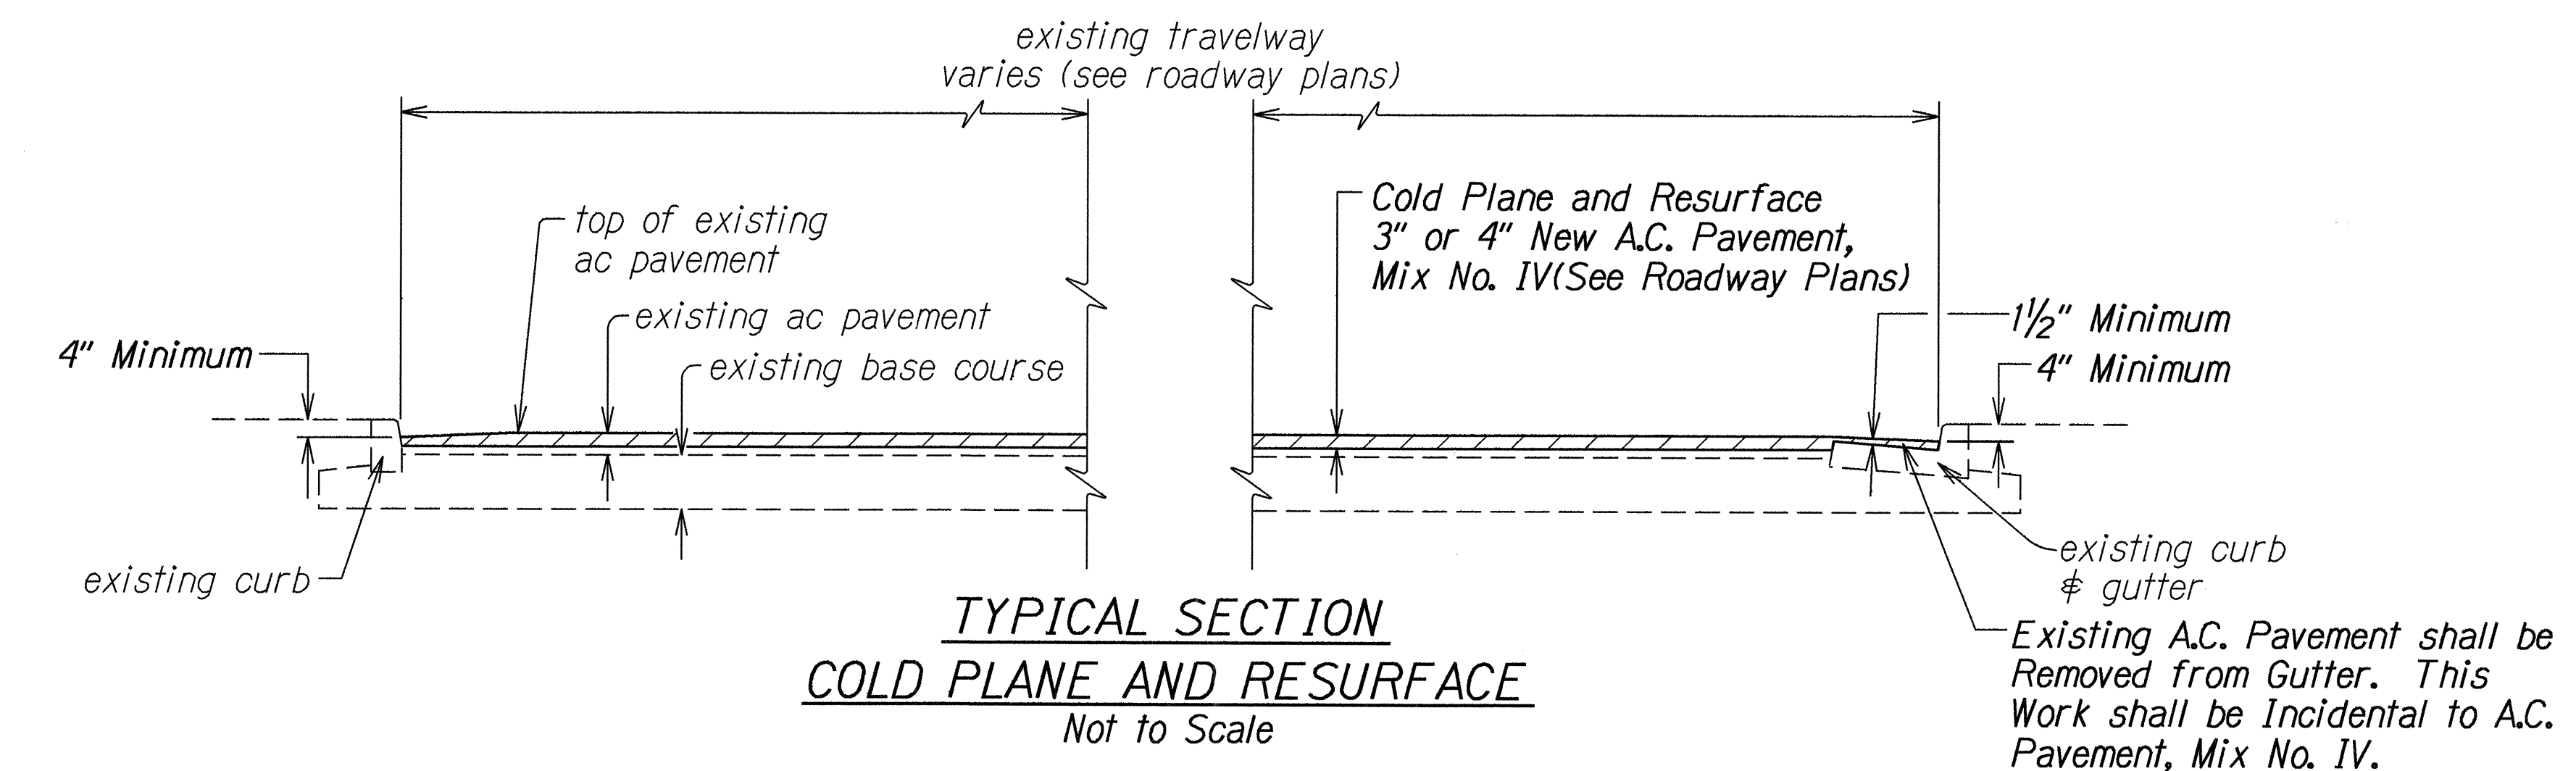

TYPICAL SECTION
COLD PLANE AND RESURFACE

Not to Scale

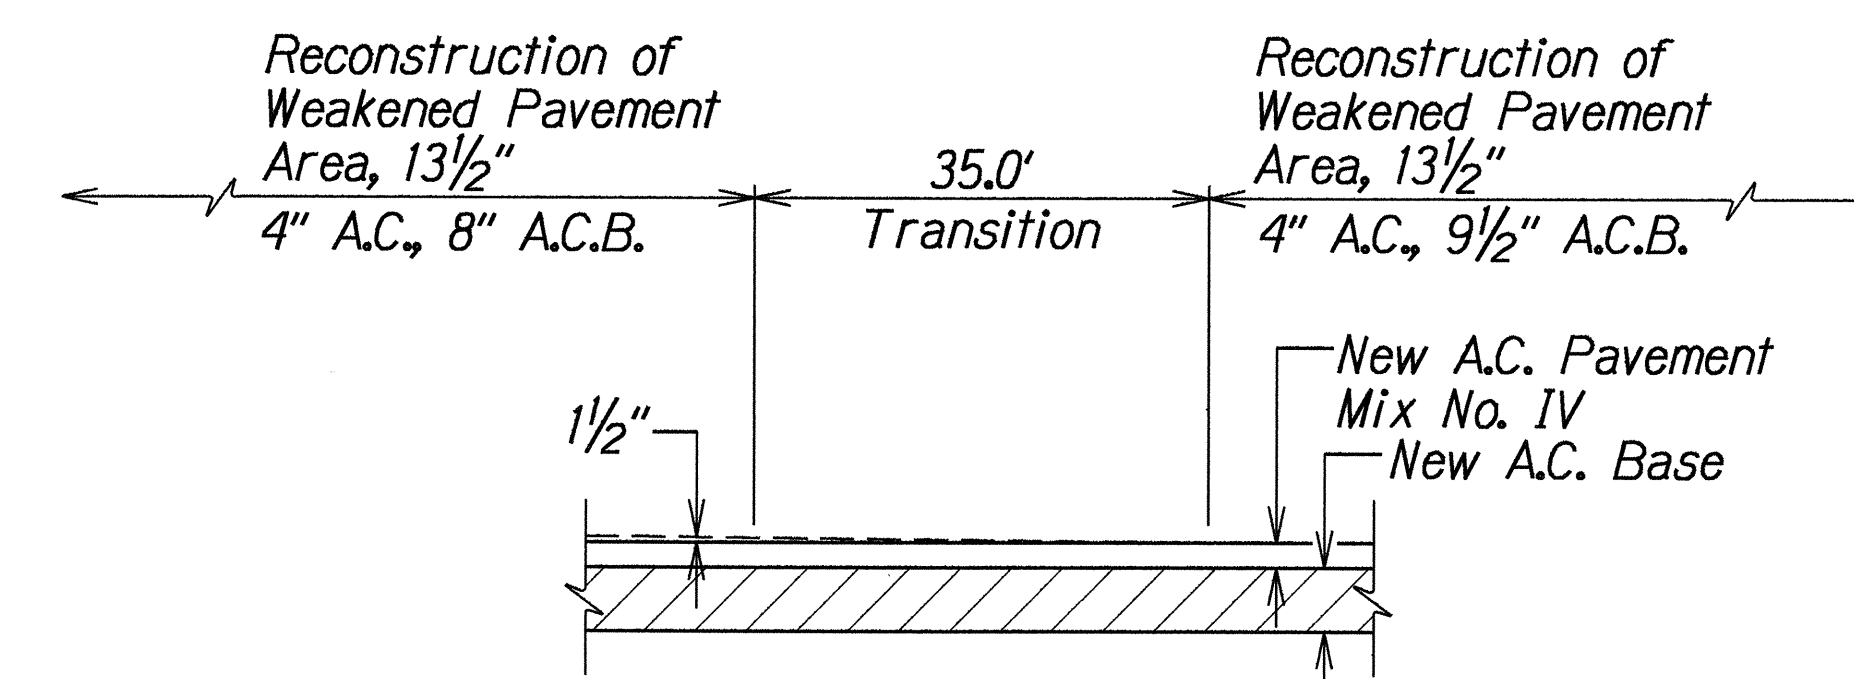

TRANSITION FOR RECONSTRUCTION
OF WEAKENED PAVEMENT AREAS

Not to Scale

*Note: All Reconstruction of Weakened Pavement Areas with the Depth 13 1/2" shall be to the Depth of the Macadam Base course.

SURVEY PLOTTED BY	DATE
DRAWN BY	13-22-94
DESIGNED BY	
CHECKED BY	
NOTED BY	
QUANTITIES BY	
CHECKED BY	

STATE OF HAWAII
DEPARTMENT OF TRANSPORTATION
HIGHWAYS DIVISION


TYPICAL SECTIONS

H-1 KAPIOLANI INERCHANGE RAMPS
OLD WAIALAE ROAD RESURFACING
Federal Aid Project No. STP-0300(30)


Scale: As Shown Date: Oct., 1993

SHEET No. 1 OF 2 SHEETS


FED. ROAD DIST. NO.	STATE	FED. AID PROJ. NO.	FISCAL YEAR	SHEET NO.	TOTAL SHEETS
HAWAII	HAW.	STP-0300(30)	1994	5	18

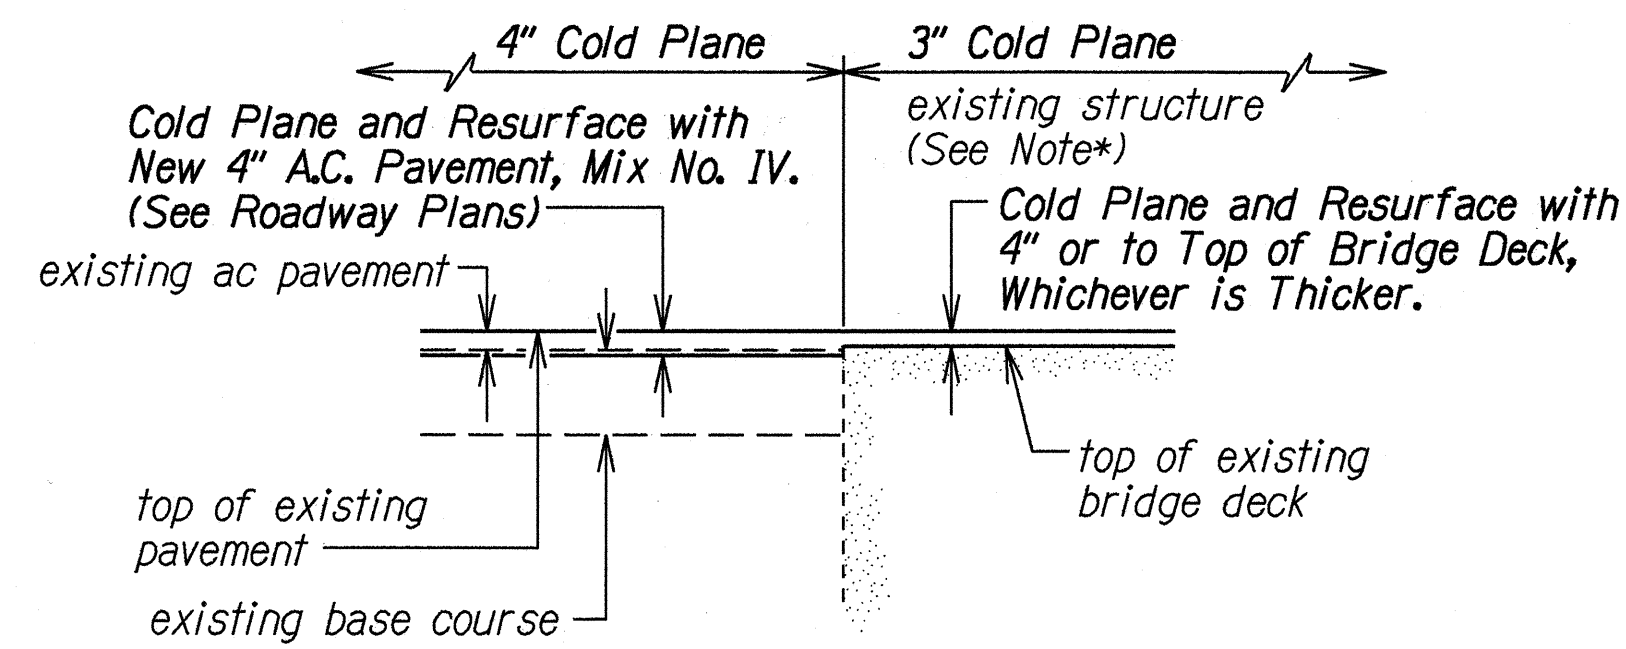

COLD PLANE AND RESURFACE AT EXISTING STRUCTURE
Not to Scale

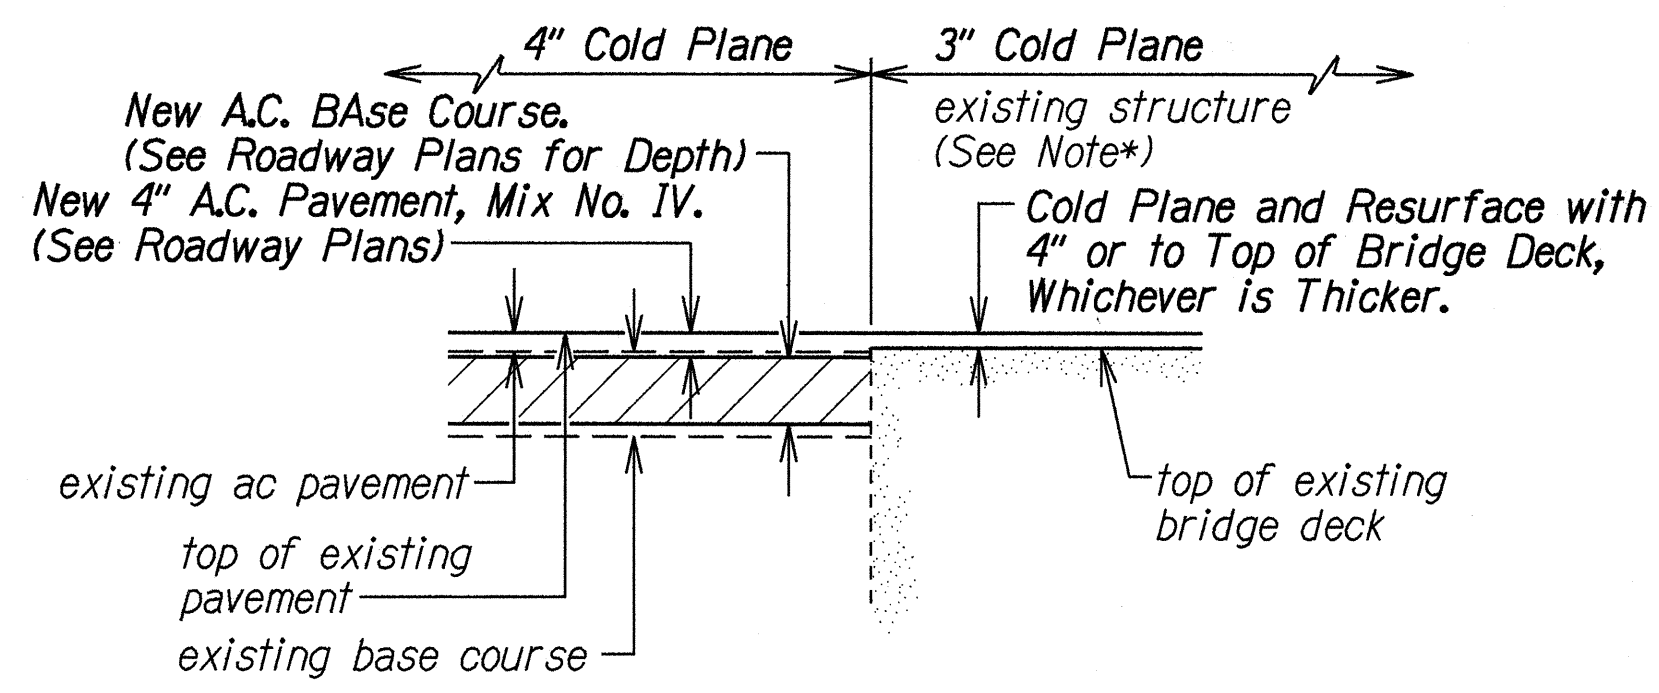


RECONSTRUCTION OF WEAKENED PAVEMENT AREAS AT EXISTING STRUCTURE
Not to Scale

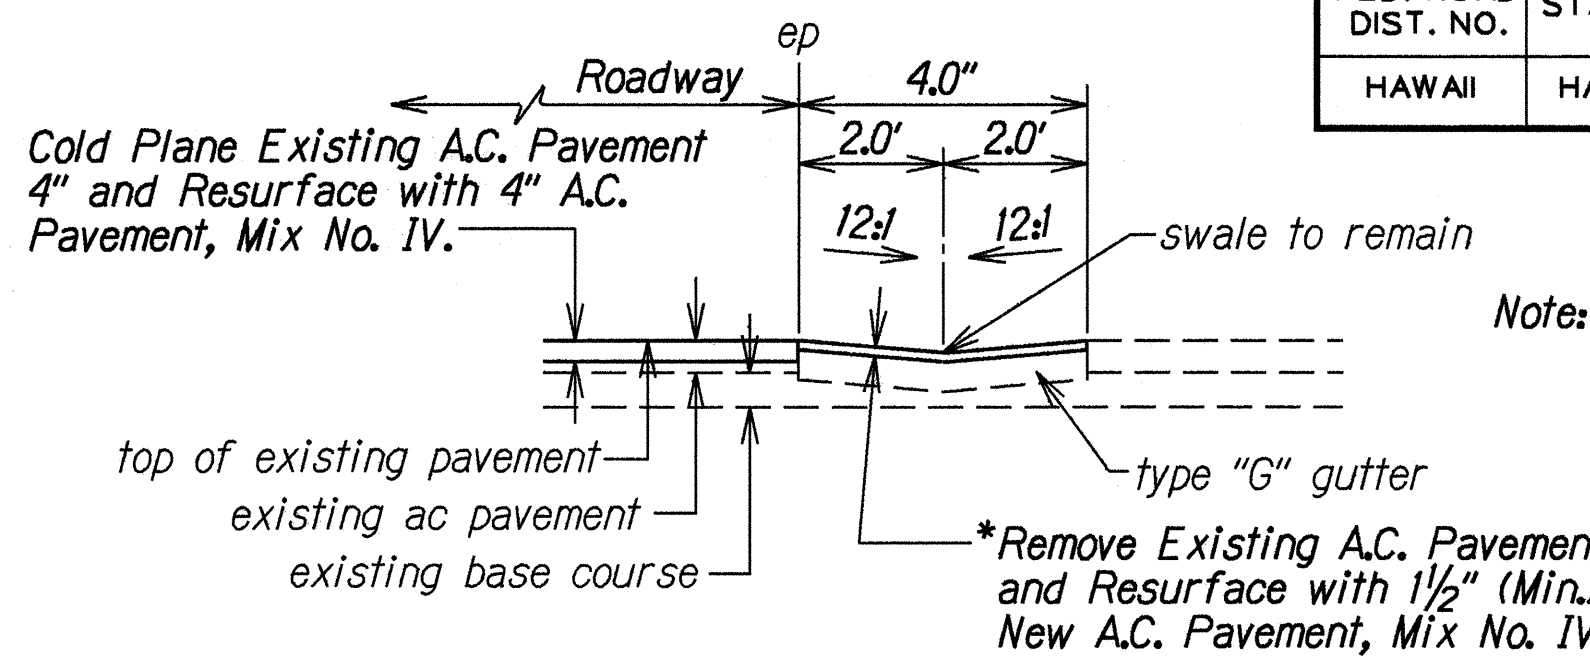


TYPE "G" GUTTER RESURFACING DETAIL
Not to Scale

Note: This work shall be incidental to A.C. Pavement, Mix No. IV. The Contractor shall exercise care not to damage any portion of the gutter.


Note: In cold planing the pavement over the structure, the Contractor shall exercise care not to damage any portion of the structure especially the slab, joints, damage pipes or reinforcement. Any damages to the structure during the cold planing operations shall be repaved by the Contractor at his expense. Repair work shall be directed by the Engineer. The Contractor shall verify the thickness of the pavement by taking several measurements throughout the structure.

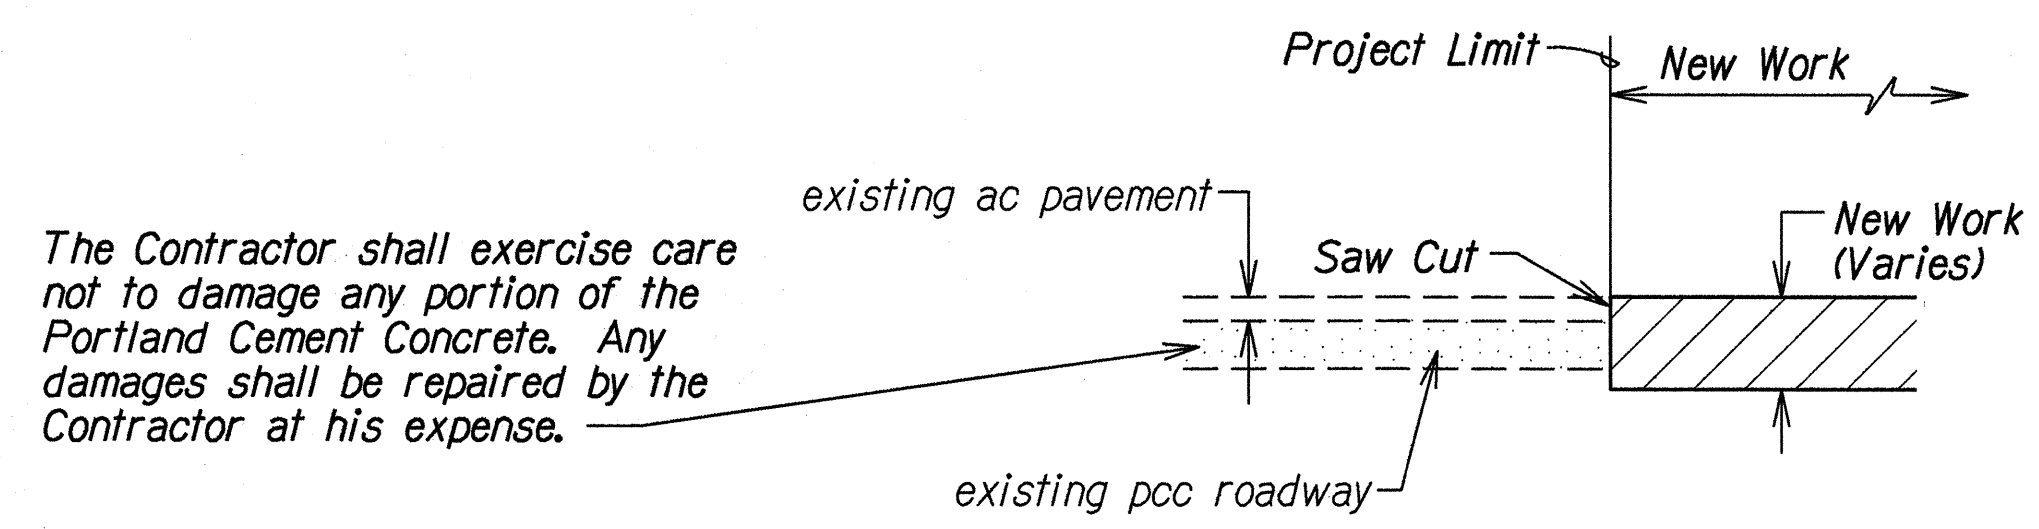

P.C.C. ROADWAY PROJECT LIMIT DETAIL
Not to Scale

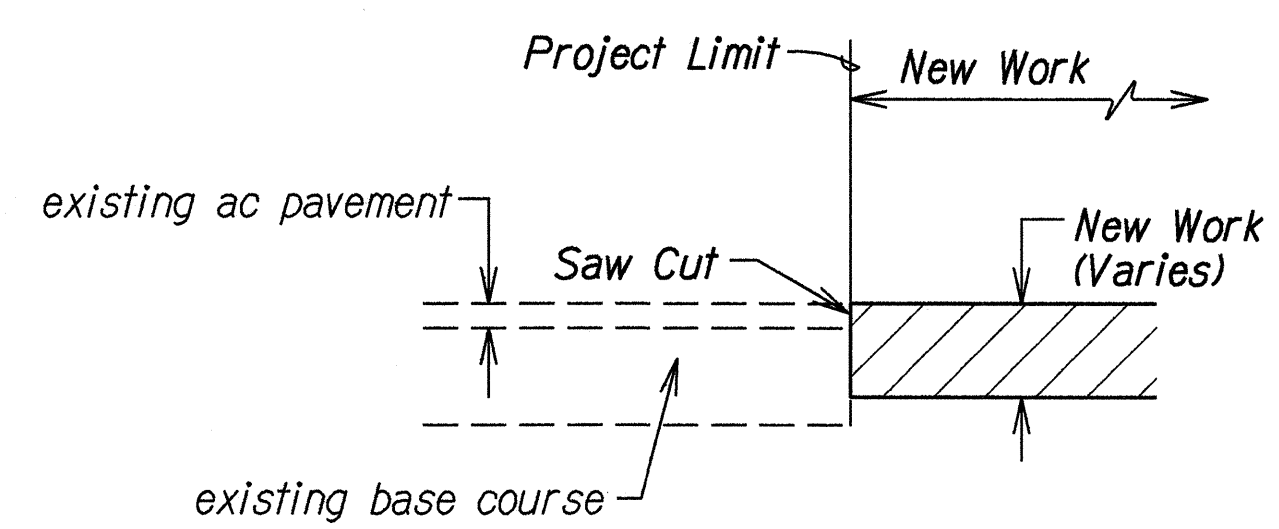

A.C. PAVEMENT PROJECT LIMIT DETAIL
Not to Scale

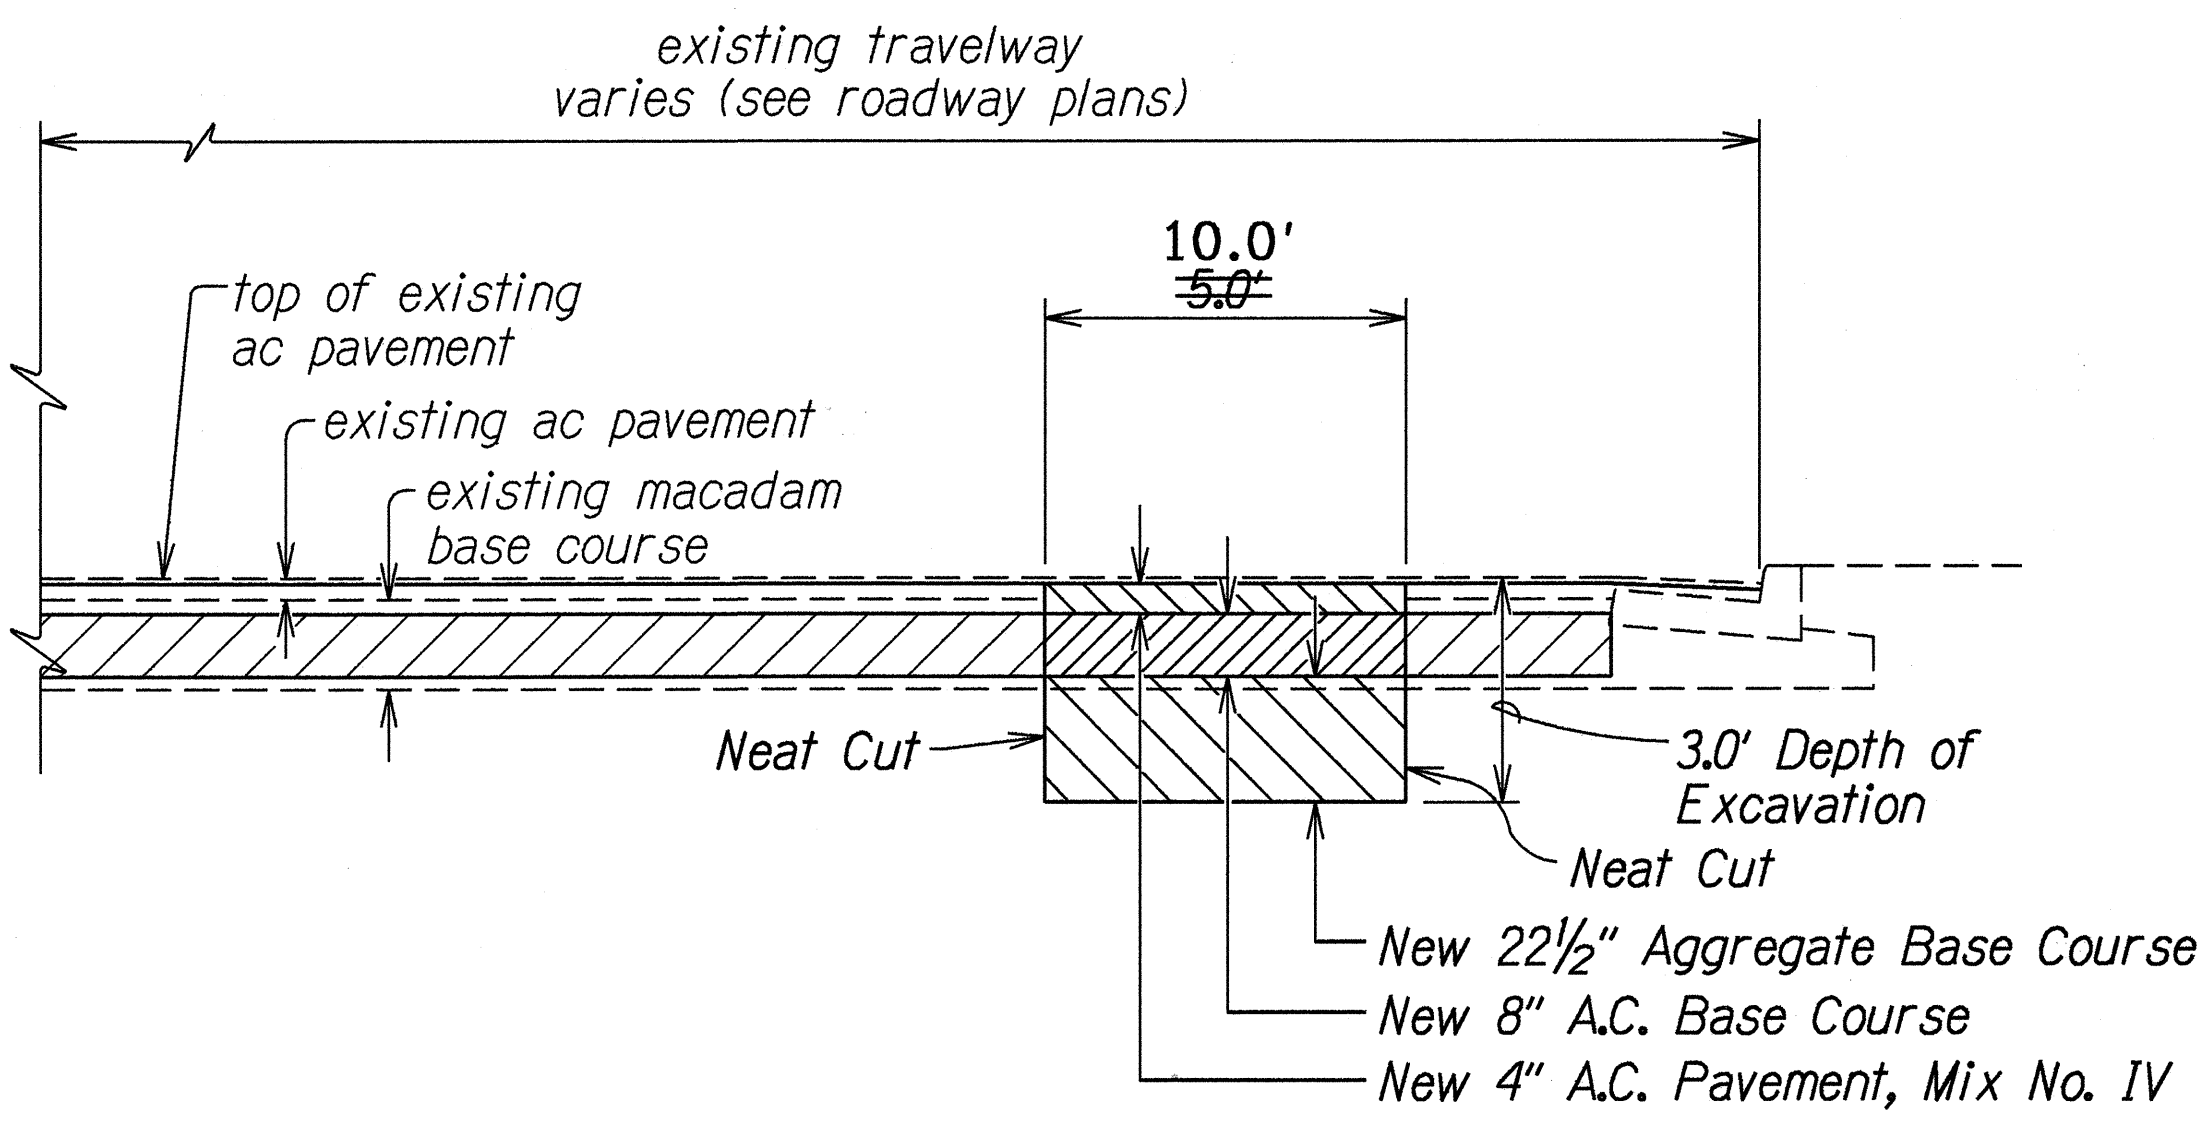

DETAIL - RECONSTRUCT WEAKENED PAVEMENT AREA 15'X5'X3' 10'X15'X3'
Not to Scale

LEGEND FOR AS-BUILT POSTINGS	
~~~~~	Squiggly line for as-built deletion
=====	Double line for as-built deletion
Roadway	Text for as-built posting

STATE OF HAWAII  
DEPARTMENT OF TRANSPORTATION  
HIGHWAYS DIVISION

**TYPICAL DETAILS**  
**H-1 KAPIOLANI INTERCHANGE RAMPS**  
**AND**  
**OLD WAIALAE ROAD RESURFACING**  
Federal Aid Project No. STP-0300(30)

Scale: As Shown
Date: Sept., 1993

SHEET No. 1 OF 1 SHEETS

ORIGINAL PLAN	DATE	7/22/94
SURVEY PLOTTED BY		
DRAWN BY		
NOTED BY		
CHECKED BY		