

DETAILED INDEX


SHT. NO.	DWG. NO.	DESCRIPTION	SHT. NO.	DWG. NO.	DESCRIPTION
1	T-1	TITLE SHEET			
2	C-1	△ DETAILED INDEX			
3	C-2	△ STANDARD PLANS SUMMARY			
4	C-3	NOTES - 1			
5	C-4	NOTES - 2			
6	C-5	NOTES - 3			
7	C-6	LOCATION PLAN			
8	C-7	CURB RAMP DETAILS - 1			
9	C-8	CURB RAMP DETAILS - 2			
10	C-9	CURB RAMP DETAILS - 3			
11	C-10	DETECTABLE WARNING DETAILS			
12	C-11	MISC. DETAILS - 1			
13	C-12	MISC. DETAILS - 2			
		SITE & GRADING PLAN FOR:			
14	C-13	△ SOUTH KING ST. AT 2820 S. KING ST.			
15	C-14	SOUTH KING ST. AT 2825 S. KING ST.			
16	C-15	SOUTH KING ST. SIDEWALK			
17	C-16	SOUTH KING ST. AT H-1 E.B. OFF-RAMP			
18	C-17	△ (SOUTH KING ST.) H-1 OFF-RAMP SIGNING & STRIPING			
19	C-18	SOUTH KING ST. AT 2885 S. KING ST.			
20	C-19	SOUTH KING ST. BRIDGE ABUTMENTS			
21	C-20	HARDING AVE. & FOODLAND			
22	C-21	HARDING AVE. & KAPAHULU AVE.			
23	C-22	KAPAHULU AVE.			
24	C-23	WAIALAE AVE. & KAPAHULU AVE.			
25	C-24	WAIALAE AVE. & PUBLIC STORAGE			
26	C-25	△ WAIALAE AVE. SIDEWALK			
27	C-26	△ WAIALAE AVE. BRIDGE			
28	C-27	WAIALAE AVE. & WAIALAE PLACE CONDO			
29	C-28	WAIALAE AVE. AT 2827 WAIALAE AVE.			
30	C-29	WAIALAE AVE. AT 2826 WAIALAE AVE.			
31	C-30	△ WAIALAE AVE. AT 2805 WAIALAE AVE.			
32	C-31	WAIALAE AVE. & KALELE ROAD			
33	C-32	WAIALAE AVE. AT H-1 W.B. ON-RAMP			
34	C-33	OLD WAIALAE AVE. SEPARATION BRIDGE			
35	C-34	△ HAWAIIAN HUMANE SOCIETY			
36	C-35	△ WAIALAE AVE. & S. KING ST.			
		TRAFFIC CONTROL PLAN FOR:			
37	C-36	SOUTH KING ST. AT H-1 E.B. OFF-RAMP			
38	C-37	(SOUTH KING ST.) H-1 OFF-RAMP SIGNING & STRIPING			
39	C-38	SOUTH KING ST. AT 2885 S. KING ST.			
40	C-39	WAIALAE AVE. & KAPAHULU AVE.			
41	C-40	WAIALAE AVE. AT H-1 W.B. ON-RAMP			

FED. ROAD DIST. NO.	STATE	PROJ. NO.	FISCAL YEAR	SHEET NO.	TOTAL SHEETS
HAWAII	HAW.	7601A-01-09	2010	2	41

LEGEND

52.58	FINISHED SPOT GRADE
51.50 TC	FINISHED TOP OF CURB
51.00 BC	FINISHED BOTTOM OF CURB
~~~~~	FLOW DIRECTION
EP	EDGE OF PAVEMENT
R/W	RIGHT-OF-WAY
-----	EXISTING PROPERTY LINE
⊕ FH	EXISTING FIRE HYDRANT
○ SMH	EXISTING SEWER MANHOLE
○ GMH	EXISTING GAS MANHOLE
⊙ Mon.	EXISTING MONUMENT
---D---	EXISTING DRAIN LINE
○ SDMH	EXISTING STORM DRAIN MANHOLE
○ WMH	EXISTING WATER MANHOLE
CB	EXISTING CATCH BASIN
⊥	EXISTING TRAFFIC SIGN
○ PP	EXISTING POWER POLE
○ GP	EXISTING GUY POLE
☆ LP	EXISTING LIGHT POLE
○ EP/TP	EXISTING ELECT/TEL POLE
○ EMH	EXISTING ELECTRICAL MANHOLE
□ SLB	EXISTING STREET LIGHT BOX
□ TSB	EXISTING TRAFFIC SIGNAL BOX
⊕ TL	EXISTING TRAFFIC LIGHT
○ TP	EXISTING TELEPHONE POLE
○ HTO	EXISTING HAW. TEL. CO. MANHOLE
HECO	EXISTING HAW. ELEC. CO. MANHOLE/BOX
○ WV	EXISTING WATER VALVE
□ WM	EXISTING WATER METER
5.73	EXISTING SPOT ELEV.
□ FAB	EXISTING FIRE ALARM BOX
□ IRR	EXISTING IRRIG. BOX
□ UB	EXISTING UTILITY BOX
⊕ FH	EXISTING FIRE HYFRANT
□ DI	EXISTING DRAIN INLET
□ EB	EXISTING ELECTRICAL BOX
TC=5.88	EXISTING TOP OF CURB (TC)
BC=5.38	EXISTING BOTTOM OF CURB (BC)
TA=5.88	EXISTING TOP OF ASPHALT CONC.
TG=5.38	EXISTING OF GUTTER (TOP)
-*-*-*-*	EXISTING FENCE

SURVEY PLOTTED BY	DATE
DRAWN BY	
TRACED BY	
QUANTITIES BY	
CHECKED BY	
ORIGINAL PLAN	
NOTE BOOK	
No.	

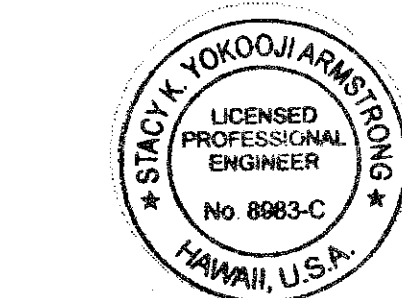

THIS WORK WAS PREPARED BY ME OR UNDER MY SUPERVISION AND CONSTRUCTION OF THIS PROJECT WILL BE UNDER MY OBSERVATION.

*Stacy K. Yokooji* April 30, 2012  
SIGNATURE DATE

"OBSERVATION OF CONSTRUCTION" IS DEFINED IN CHAPTER 16-115, HAWAII ADMINISTRATIVE RULES ENTITLED "PROFESSIONAL ENGINEERS, ARCHITECTS, SURVEYORS AND LANDSCAPE ARCHITECTS".

09/03/2010	△ REVISED SHEETS
DATE	REVISION
STATE OF HAWAII DEPARTMENT OF TRANSPORTATION HIGHWAYS DIVISION	
DETAILED INDEX	
Pedestrian Facilities & ADA Compliance, Vicinity of Old Waiālae Rd. and S. King St. Proj. No. 7601A-01-09	
Scale: None	Date: March 2010
SHEET No. C-1 OF 41 SHEETS	